### **CONCEPT PLAN REQUIREMENTS:**

- SITE PLAN: SEE SUPPLEMENTAL SHEET A0.0 AND A0.3 FOR ZONING DISTRICTS, SITE FEATURES, ADJACENT PROPERTIES. SEE PROJECT TITLE BLOCKS FOR THE NAME AND ADDRESSES OF THE DEVELOPER/OWNERS.
- SEE SHEETS TITLE BLOCKS FOR THE NAMES AND ADDRESSES OF THE ARCHITECTS AND LANDSCAPE ARCHITECTS. SEE SHEET A0.0 FOR SITE BOUNDARIES, SITE ACREAGE, AND SQUARE FOOTAGE, AND DISTANCES TO THE NEAREST CROSS
- SEE SHEET A0.3 FOR LOCATION MAP, NORTH ARROW, TITLE BLOCK.
- SEE SHEET A0.5 FOR A SITE PLAN PLACE OVER AN AERIAL PHOTOGRAPH DEPICTING THE LOCATION OF TREES, AND DRAINAGE CANALS (FLOODPLAINS AND DRAINAGE WAYS) . SEE SHEET A0.3 FOR THE EXISTING LAND USE AND ZONING CLASSIFICATIONS AND EXISTING LAND USES ON
- SEE SHEET A2.1 AND A2.2 FOR ELEVATIONS OF THE BUILDING ENVELOPE WHICH WILL INDICATE MAXIMUM BUILDING
- INTENSITY AND HEIGHTS. SEE SHEET A0.2 FOR DENSITY AND ANY USE RESTRICTIONS.

  SEE SHEET A0.3 FOR FOR PUBLIC STREET AND PRIVATE DRIVES, PAVEMENT WIDTHS, BUFFERS, RIGHT-OF- WAYS, MEDIAN
- OPENINGS, TURN LANES AND DRIVE WAYS.

THERE ARE NO PROPOSED BUFFERS FROM EXISTING USES IN THIS PROJECT. THE PROJECT UTILIZES THE ENTIRE SITE.

- THERE ARE NO DEDICATIONS OR RESERVATIONS OF LAND FOR PUBLIC OR COMMON USE IN THIS PROJECT.
- THERE WILL BE NO EXISTING OR PROPOSED UTILITIES EASEMENTS IN THIS PROJECT. THIS PROJECT WILL NOT BE DEVELOPED IN PHASES.
- SEE SHEET A0.0 FOR CHART OF: ACREAGE OF PROPOSED PHASE:
- TOTAL NUMBER OF DWELLING UNITS **DWELLING UNIT SIZES**
- PROJECT POPULATION TABULATION OF TOTAL GROSS FLOOR AREA FOR NON RESIDENTIAL USES.

### **PROJECT SCOPE OF WORK:**

- 1. THE SCOPE OF WORK DESCRIBED IN THESE INSTRUMENTS OF SERVICE IS THE CONSTRUCTION OF A 17 LEVEL HOTEL AND RESIDENTIAL CONDOMINIUM BUILDING WITH 9 FLOORS OF HOTEL, 5 FLOORS OF PARKING, AND 3 FLOORS OF CONDOMINIUMS.
- 2. THE FOUNDATION WILL BE A PILE SUPPORTED SYSTEM OF AUGER CAST CONCRETE PILES. REFER TO SUBMITTED SOILS REPORT FOR ALLOWABLE PILE CAPACITIES. A SERIES OF CONCRETE PILE CAPS WILL TRANSFER THE VERTICAL LOADS TO THE GROUND. SHEAR WALLS LOCATED INSIDE THE BUILDING, AS WELL AS THE ELEVATOR SHAFTS, WILL TRANSFER LOADS INTRODUCED BY WIND
- 3. THE STRUCTURE OF THE BUILDING WILL BE DESIGNED IN TWO PARTS. THE PODIUM (RETAIL & PARKING) AS TRADITIONAL COLUMNS SYSTEM WITH POST TENSIONED FLAT CONCRETE SLAB, THE LIVING STRUCTURE WILL BE STRUCTURAL STEEL AND WILL BE SEPARATED BY STRUCTURAL STEEL THAT WILL TRANSFER LOADS AND PROVIDE INHERENT FIRE AND SOUND PROTECTION TO THE LIVING AREA WITH GFRC PANELS AS THE EXTERIOR FINISH. OTHER COMPONENTS OF THE EXTERIOR WILL BE GRANITE, ALUMINUM AND GLASS FLOOR TO CEILING CURTAIN WALL SYSTEM (PENTHOUSES). SLIDING AND FIXED ALUMINUM AND GLASS WINDOWS AND ALUMINUM AND GLASS SLIDING DOORS (UNITS). ALL EXTERIOR COMPONENTS WILL BE DESIGNED TO WITHSTAND A
- 4. THE ROOFING COMPONENTS WILL BE A FLUID APPLIED MEMBRANE ROOF SYSTEM OVER CAST IN PLACE CONCRETE AND STANDING SEAM METAL PRE-FORMED METAL SYSTEM.
- 5. THE BUILDING WILL BE FULLY PROTECTED BY AN AUTOMATED FULLY SUPERVISED SPRINKLER SYSTEM AS WELL AS A WET STANDPIPE SYSTEM LOCATED IN TWO SEPARATE LOCATIONS ON EACH FLOOR.
- 6. THE BUILDING WILL BE PROVIDED WITH AN EMERGENCY ELECTRICAL GENERATOR WITH CAPACITY TO PROVIDE SAFE DOCKING OF THE ELEVATOR, OPERATION OF THE EMERGENCY LIGHTING AND THE ALARM SYSTEM AND THE OPERATION OF EMERGENCY
- 7. THE BUIDLING WILL BE PROVIDED WITH PERMANENT SIGNAGE FOR ALL PUBLIC SPACES AND TO LOCATE THE INDIVIDUAL TENANT UNITS. THESE SIGNS WILL BE X'-X" SQUARE SOLID PLASTIC WITH CONTRASTING LETTERS AND BACKGROUND. LETTERING WILL BE PROTECTED BY A CLEAR PLASTIC SHEET LAMINATED TO THE FACE OF THE SIGN. ALL SIGNS WILL BE FURNISHED WITH THE APPROPRIATE BRAILLE COMPONENTS.

### **GENERAL NOTES:**

- 1. THE CONTRACTOR SHALL VISIT THE SITE AND THOROUGHLY ACQUAINT THEMSELVES SHALL WITH ALL ASPECTS OF THE SITE PRIOR TO SUBMITTING A BID. ANY DISCREPANCIES SHALL BE IMMEDIATELY BROUGHT TO THE ATTENTION OF THE
- 2. THE CONTRACTOR IS REQUESTED TO ATTEND THE PRE-BID MEETING AS SCHEDULED IN THE SPECIFICATIONS.
- DO NOT SCALE THESE PLANS.
- 4. THE CONTRACTOR SHALL PROVIDE ALL NECESSARY SAFETY APPARATUS REQUIRED IN ORDER TO ASSURE FOR THE HEALTH AND WELFARE OF THE GENERAL PUBLIC, THE OWNERS, AND ANY WORKERS.
- 5. THE BIDDER SHALL BE RESPONSIBLE FOR THE QUANTITIES IN HIS BID; IN NO WAY DO THE DIMENSIONS SHOWN ON THESE PLANS INDICATE AN EXACT QUANTITY OF MATERIALS.
- 6. THE CONTRACTOR SHALL HAVE THE WORK SITE CLEANED ON A DAILY BASIS. THE DISPOSAL OF ANY WASTE SHALL BE OFF SITE AND IN A MANNER PRESCRIBED UNDER THE LAW.
- 7. THE CONTRACTOR SHALL PROVIDE FOR POSITIVE DRAINAGE AROUND THE BUILDING INCLUDING ANY TEMPORARY
- MEASURES DURING THE CONSTRUCTION SO AS TO ENSURE NO WATER DAMAGE TO THE BUILDING. 8. ALL REMOVED TOPSOIL AND/OR SAND SHALL BE STORED AND USED FOR FINISH GRADING AS REQUIRED. THE CONTRACTOR
- SHALL BE RESPONSIBLE FOR REMOVAL OF ALL EXCESS SOILS AND DEBRIS FROM THE SITE TO AN APPROVED 9. CONTRACTOR SHALL COORDINATE & INSTALL WOOD BLOCKING IN THE METAL FRAMING AS NEEDED TO SUPPORT ANY ITEMS
- 10. ALL PENETRATIONS THROUGH FIRE RATED WALLS ARE TO BE SEALED WITH CODE APPROVED FIRE-STOPPING MATERIAL.

# HARD ROCK HOTEL

1031 CANAL ST. NEW ORLEANS, LA



### VIEW FROM CANAL AT RAMPART LOOKING NORTHEAST TOWARDS MISSISSIPPI RIVER

### **BUILDING DATA**

| ZONING |  |
|--------|--|
|        |  |

**BUILDING HEIGHT** 

**BUILDING STORIES** 

1 - 2 (RETAIL)

3 - 7 (PARKIŃG)

190 FEET MSL

CBD-3

8 - 14 (HOTEL)

15 - 17 (RESIDENTIAL)



### **PROJECT TEAM**

### OWNER

### KAILAS COMPANIES, LLC.

3525 N. CAUSEWAY BLVD. #1040 METAIRIE, LOUISIANA 70002 (504) 828-9700 E-MAIL: KAILASINC@GMAIL.COM

MOHAN KAILAS, MANAGING MEMBER

### <u>ARCHITECTS</u>

### HARRY BAKER SMITH ARCHITECTS II A PROFESSIONAL LLC.

189 MAPLE RIDGE DRIVE METAIRIE, LOUISIANA 70001 (504) 885-4477 FAX: (504) 885-4377 E-MAIL: CENTRAL@HBSAII.COM

HARRY BAKER SMITH JR. (HANK), MANAGING MEMBER

### LANDSCAPE ARCHITECTS

### AL BARCIA - ABLA, LLC.

760 BOSTON RD. BILLERICA, MA 01821

AL BARCIA, MANAGING MEMBER

### **CONTRACTORS**

### CITADEL BUILDERS, LLC.

3516 HESSMER AVENUE METAIRIE, LOUISIANA 70002 (504) 888-9433 E-MAIL: DENZEL@CIADELBUILDERS.COM

DENZEL CLARK JR., MANAGING MEMBER

HOWARD MOSES, P.E. MOSES ENGINEERS, LLC. 909 POYDRAS ST. - SUITE 2150 NEW ORLEANS, LOUISIANA 70112 (504) 586 - 1725

E-MAIL: ADMIN@MOSESENGINEERS.COM HOWARD MOSES, MANAGING MEMBER

MECHANICAL ELECTRICAL ENGINEER

### STRUCTURAL ENGINEERS

### JAMES HEASLIP

3500 N. CAUSEWAY BLVD. #1100 METAIRIE, LOUISIANA 70002 (504) 648-1743 E-MAIL: INFO@HEASLIPENG.COM

### WALTER ZEHNER

4702 TOULOUSE STREET NW ORLEANS, LOUISIANA 70119 (504) 488-1442 E-MAIL: WALTERZEHNER@MSN.COM

# SYMBOLS LEGEND

FLOOR LEVELS ROOM NUMBER

SHEET REFERENCE (XX)DOOR TAG, SEE

WINDOW TAG, SEE INTERIOR ELEVATION, SEE

XX PARTITION TYPE, SEE SHEET

CEILING FURR DOWN/PANELS 3HR. RATED FIRE PARTITION 2HR. RATED FIRE PARTITION

1HR. RATED FIRE PARTITION

2-A:20-B:C FIRE EXTINGUISHER IN RECESSED CABINET, MOUNTING HEIGHT 60" (MAX.) AFF TO TOP EXTINGUISHER 2-A:20-B:C SURFACED MOUNTED,

MOUNTING HEIGHT 60" (MAX.) AFF TO TOP EXTINGUISHER ADA 30"x48" CLEAR FLOOR SPACE

### PROJECT DATA & AREA CALCULATIONS:

**GROUND FLOOR AREA ENTRY DRIVES** PARKING HOTEL FLOORS 8 - 14 CONDO FLOOR 15 PENTHOUSE CONDO FLOORS 16 - 17

253,575 SQFT 242,196 SQFT 31,564 SQFT 63 020 SOFT 663, 967 SQFT 243,192.00 SQFT

40,064 SQFT

40,249 SQFT

350

ALLOWABLE FAR @ 6% PROVIDED FAR (WITH PARKING)

13.7% (14.4 SQFT AS ALLOWED BY WAIVERS)

HOTEL UNITS

CONDO UNITS HOTEL UNIT SQ FT AVERAGE 465 SQFT CONDO SQ FT AVERAGE 837 SQFT NUMBER OF STORIES 17 MAXIMUM BUILDING HEIGHT 190 FEET


DENSITY UNIT PER 1,612 SQ FT PARKING PROVIDED (INDOOR) 368 SPACES ACCESSIBLE PARKING PROVIDED 8 SPACES TOTAL PARKING PROVIDED 376 SPACES

1031 CANAL EW ORLEANS

189 Maple Ridge Drive Metairie, LA 70001 (504)-885-4477 central@hbsaii.com :-: hbsaii.com

SINCE 1961



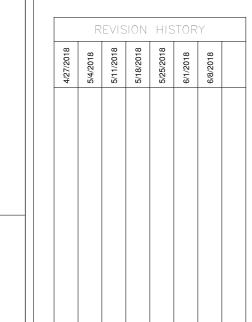

TITLE SHEET PROJECT#: 1709 PHASE: DD TFAM: Author CHECKER: Checker

SCALE: AS NOTE[

SSUED: 4/20/2018

ARCHITECTURAL DRAWING INDEX TITLE SHEET A0.0 TITLE SHEET A0.1-A INDEX OF DRAWINGS A0.1-B INDEX OF DRAWINGS A0.2 BUILDING CODE SUMMARY A0.2.1 FIRE EGRESS PLAN A0.2.2 FIRE EGRESS PLAN A0.2.3 EGRESS AXON A0.3 SITE & UTILITIES PLAN A0.5 SITE LOGISTICS PLAN-CONST. PHASE A1.1 GROUND FLOOR A1.1-A GROUND FLOOR RCP A1.1-B INTERMEDIATE PARKING A1.1-C INTERMEDIATE PARKING RCP A1.1-D INTERMEDIATE PARKING FINISH PLAN A1.2 2ND FLOOR A1.2-A 2ND FLOOR RETAIL RCP A1.2-C 2ND FLOOR MEZZANINE A1.2-D 2ND FLOOR MEZZ. RCP A1.3 PARKING LEVEL 3 A1.3-A PARKING LEVEL 3 RCP A1.4 PARKING LEVEL 4 A1.4-A PARKING LEVEL 4 RCP A1.5 PARKING LEVEL 5 A1.5-A PARKING LEVEL 5 RCP A1.6 PARKING LEVEL 6 A1.6-A PARKING LEVEL 6 RCP A1.7 PARKING LEVEL 7 A1.7-A PARKING LEVEL 7 RCP A1.8 8TH FLOOR UNITS AND COMMON AREAS A1.8-A 8TH FLOOR RCP A1.9 9TH FLOOR A1.9-A 9TH FLOOR RCP A1.10 10TH FLOOR A1.10-A 10TH FLOOR RCP A1.11 11TH FLOOR A1.11-A 11TH FLOOR RCP A1.12 12TH FLOOR A1.12-A 12TH FLOOR RCP A1.13 13TH FLOOR A1.13-A 13TH FLOOR RCP A1.14 14TH FLOOR A1.14-A 14TH FLOOR RCP A1.15 15TH FLOOR A1.15-A 15TH FLOOR RCP A1.16 16TH FLOOR PENTHOUSES A1.16-A 16TH FLOOR RCP A1.17 17TH FLOOR PENTHOUSES A1.17-A 17TH FLOOR RCP A1.18 ROOF DECK PLAN A1.18-A ROOF DECK PLAN RCP A1.18.1 18TH FLOOR ENLARGED PLAN A A1.19 ROOF PLAN DETAILS AND SCHEDULES A2.1 CANAL STREET ELEVATION A2.2 RAMPART STREET ELEVATION A2.3 IBERVILLE STREET ELEVATION A2.4 RIVERSIDE ELEVATION A2.5 ELEVATIONS A3.0.1 TRANSVERSE BUILDING SECTION A3.0.2 TRANSVERSE BUILDING SECTION A3.0.3 LONGITUDINAL BUILDING SECTION A3.0.4 LONGITUDINAL BUILDING SECTION A3.1.1 EXTERIOR WALL SECTIONS A3.1.2 EXTERIOR WALL SECTIONS A3.1.3 EXTERIOR WALL SECTIONS A3.1.4 EXTERIOR WALL SECTIONS A3.1.5 EXTERIOR WALL SECTIONS A3.1.6 EXTERIOR WALL SECTIONS A3.2.1 EXTERIOR DETAILS A3.2.2 EXTERIOR DETAILS A3.2.3 EXTERIOR DETAILS A3.2.4 EXTERIOR DETAILS A3.2.5 EXTERIOR DETAILS A3.2.6 EXTERIOR DETAILS A3.2.7 EXTERIOR DETAILS A3.3.1 ROOF DETAILS A3.4.1 INTERIOR DETAILS A3.5.1 JAMB HEAD, SILL TYPICAL DETAILS A3.5.2 JAMB HEAD, SILL TYPICAL DETAILS A3.6.1 POOL DETAILS A3.7 SECTION DETAILS A3.7.1 MISCELLANEOUS DETAILS A3.7.2 MISCELLANEOUS DETAILS A3.8.2 SECTION DETAILS A3.9 COMMON WALL SECTION DETAILS A3.20 ENTRANCE CANOPIES DETAILS A3.21 MISC DETAILS A4.1.1 GROUND FLOOR ENLARGED PLAN A A4.1.2 GROUND FLOOR ENLARGED PLAN B A4.1.3 GROUND FLOOR ENLARGED PLAN C A4.1.4 GROUND FLOOR ENLARGED PLAN D A4.1.5 INTERMEDIATE PARKING ENLARGED PLAN A A4.1.6 INTERMEDIATE PARKING PLAN B A4.2.1 2ND FLOOR ENLARGED PLAN A A4.2.2 2ND FLOOR ENLARGED PLAN B A4.2.3 2ND FLOOR ENLARGED PLAN C A4.2.4 2ND FLOOR ENLARGED PLAN D A4.2.C.1 2ND FLOOR MEZZ ENLARGED PLAN A A4.2.C.2 2ND FLOOR MEZZ ENLARGED PLAN B A4.2.C.3 2ND FLOOR MEZZ ENLARGED PLAN C A4.8.1 8TH FLOOR ENLARGED PLAN A A4.8.2 8TH FLOOR ENLARGED PLAN B A4.8.3 8TH FLOOR ENLARGED PLAN C A4.8.4 8TH FLOOR ENLARGED PLAN D A4.9.1 9TH FLOOR ENLARGED PLAN A A4.9.2 9TH FLOOR ENLARGED PLAN B A4.9.3 9TH FLOOR ENLARGED PLAN C A4.9.4 9TH FLOOR HOTEL - ENLARGED PLAN D A4.9.5 9TH FLOOR HOTEL - ENLARGED PLAN E A4.10.1 10TH FLOOR ENLARGED PLAN A A4.10.2 10TH FLOOR ENLARGED PLAN B A4.10.3 10TH FLOOR ENLARGED PLAN C A4.10.4 10TH FLOOR ENLARGED PLAN D A4.11.1 11TH FLOOR ENLARGED PLAN A A4.11.2 11TH FLOOR ENLARGED PLAN B A4.11.3 11TH FLOOR ENLARGED PLAN C

A4.11.4 11TH FLOOR ENLARGED PLAN D

A4.12.1 12TH FLOOR ENLARGED PLAN A

A4.12.2 12TH FLOOR ENLARGED PLAN B

A4.12.3 12TH FLOOR ENLARGED PLAN C

A4.12.4 12TH FLOOR ENLARGED PLAN D

|                    | ARCHITECTURAL DRAWING INDEX                              |
|--------------------|--|
| SHEET              | TITLE  |
| A4.13.1            | 13TH FLOOR ENLARGED PLAN A                               |
| A4.13.2<br>A4.13.3 | 13TH FLOOR ENLARGED PLAN B<br>13TH FLOOR ENLARGED PLAN C |
| A4.13.4<br>A4.14.1 | 13TH FLOOR ENLARGED PLAN D<br>14TH FLOOR ENLARGED PLAN A |
| A4.14.1            | 14TH FLOOR ENLARGED PLAN B                               |
| A4.14.3<br>A4.14.4 | 14TH FLOOR ENLARGED PLAN C<br>14TH FLOOR ENLARGED PLAN D |
| A5.0               | TUNNEL SECTION AND ISOMETRIC                             |
| A5.1<br>A5.2       | ENLARGED STAIR PLANS ENLARGED STAIR PLANS                |
| A5.2.A             | ENLARGED STAIR PLANS                                     |
| A5.3<br>A5.3.A     | ENLARGED STAIR PLANS ENLARGED STAIR PLANS                |
| A5.4               | ENLARGED STAIR PLANS                                     |
| A5.5<br>A5.5.A     | ENLARGED STAIR PLANS ENLARGED STAIR PLANS                |
| A5.5.B             | ENLARGED STAIR PLANS                                     |
| A5.6<br>A5.7       | ENLARGED STAIR SECTIONS ENLARGED STAIR SECTIONS          |
| A5.8<br>A5.11      | ENLARGED STAIR SECTIONS RAILING DETAILS                  |
| A6.1               | SCHEDULES  |
| A6.2<br>A6.3       | SCHEDULES<br>SCHEDULES                                   |
| A6.4               | SCHEDULES  |
| A6.5<br>A6.6       | SCHEDULES<br>SCHEDULES                                   |
| A6.7               | SCHEDULES  |
| A6.8<br>A6.9       | SCHEDULES<br>SCHEDULES                                   |
| A6.10              | SCHEDULES  |
| A6.11<br>A6.12     | SCHEDULES<br>SCHEDULES                                   |
| A6.13              | Unnamed  |
| A6.15<br>A6.16     | STOREFRONT SCHEDULES (GROUND FLOOR) STOREFRONT SCHEDULES |
| A6.22              | STOREFRONT GLASS ELEVATIONS                              |
| A7.0-A<br>A7.0-B   | PARTITION TYPES PARTITION TYPES                          |
| A7.1<br>A7.2       | PARTITION TYPES PARTITION TYPES                          |
| A8.0               | PUBLIC POOL LEVEL 8                                      |
| A8.1<br>A8.2       | PRIVATE POOL LEVEL 14 ROOFTOP POOL & DETAILS             |
| A9.0               | ENLARGED SERVICE CORE                                    |
| A9.1<br>A9.2       | ENLARGED SERVICE CORE PLAN ENLARGED SERVICE CORE PLAN    |
| A9.2.A             | ENLARGED ELEVATOR CORE PLAN                              |
| A9.3<br>A9.4       | ENLARGED SERVICE CORE PLAN ENLARGED SERVICE CORE PLAN    |
| A9.5               | ENLARGED SERVICE CORE PLAN                               |
| A9.6<br>A9.7       | ENLARGED SERVICE CORE PLAN SHAFT SECTIONS AND DETAILS    |
| AI-0.00            | HOTEL 901  |
| Al-1.00<br>Al-1.01 | CONDO 1500<br>CONDO 1501                                 |
| AI-1.02            | CONDO 1502   |
| AI-1.03<br>AI-1.04 | CONDO 1503<br>CONDO 1504                                 |
| Al-1.05            | CONDO 1505   |
| Al-1.06<br>Al-1.07 | CONDO 1506<br>CONDO 1507                                 |
| Al-1.08<br>Al-1.09 | CONDO 1508<br>CONDO 1509                                 |
| AI-1.10            | CONDO 1510   |
| Al-1.11<br>Al-1.12 | CONDO 1511<br>CONDO 1512                                 |
| Al-1.12<br>Al-1.13 | CONDO 1512<br>CONDO 1513                                 |
| Al-1.14<br>Al-1.15 | CONDO 1514<br>CONDO 1515                                 |
| AI-1.16            | CONDO 1516   |
| Al-1.17<br>Al-1.18 | CONDO 1517<br>CONDO 1518                                 |
| Al-1.19            | CONDO 1519   |
| Al-1.20<br>Al-1.21 | CONDO 1520<br>CONDO 1521                                 |
| AI-1.23            | CONDO 1600   |
| Al-1.24<br>Al-1.25 | CONDO 1601<br>CONDO 1602                                 |
| AI-1.26            | CONDO 1603   |
| Al-1.27<br>Al-1.28 | CONDO 1604<br>CONDO 1605                                 |
| Al-1.29<br>Al-1.30 | CONDO 1606<br>CONDO 1607                                 |
| AI-1.31            | CONDO 1608   |
| Al-1.32<br>Al-1.33 | CONDO 1609<br>CONDO 1610                                 |
| AI-1.34            | CONDO 1611   |
| Al-1.35<br>Al-1.36 | CONDO 1612<br>CONDO 1613                                 |
| AI-1.37            | CONDO 1614   |
| Al-1.38<br>Al-1.39 | CONDO 1615<br>CONDO 1616                                 |
| AI-1.40            | CONDO 1617   |
| Al-1.41<br>Al-1.42 | CONDO 1618<br>CONDO 1619                                 |
| AI-1.44            | CONDO 1700   |
| Al-1.45<br>Al-1.46 | CONDO 1701<br>CONDO 1702                                 |
| AI-1.47            | CONDO 1703   |
| Al-1.48<br>Al-1.49 | CONDO 1704<br>CONDO 1705                                 |
| AI-1.50            | CONDO 1706   |
| Al-1.51<br>Al-1.52 | CONDO 1707<br>CONDO 1708                                 |
| AI-1.53            | CONDO 1709   |
| Al-1.54<br>Al-1.55 | CONDO 1710<br>CONDO 1711                                 |
| AI-1.55<br>AI-1.56 | CONDO 1712   |
| Al-1.57<br>Al-1.58 | CONDO 1713<br>CONDO 1714                                 |
| AI-1.58<br>AI-1.59 | CONDO 1714<br>CONDO 1715                                 |
| Al-1.60            | CONDO 1716   |

AI-1.60 CONDO 1716

AI-1.61 CONDO 1717

AI-1.62 CONDO 1718

AI-1.63 CONDO 1719

S-1.0 GROUND FLOOR STRUCT

S-1.1 INT. PARKING STRUCT

S-1.2 2ND FLOOR STRUCT

|         | ARCHITECTURAL DRAWING INDEX    |
|---------|--------------------------------|
| SHEET   | TITLE                          |
|         | I                              |
| S-1.3   | 2ND FLOOR MEZZ. STRUCT         |
| S-1.3.1 | 3RD FLOOR STRUCT               |
| S-1.4   | 7TH FLOOR PARKING STRUCT       |
| S-1.5   | 8TH FLOOR HOTEL STRUCT         |
| S-1.11  | 15TH FLOOR STRUCT              |
| S-1.12  | 16TH FLOOR STRUCT              |
| SCH-9   | 9TH FLOOR DOOR SCHEDULE        |
| SCH-15  | 15TH FLOOR DOOR SCHEDULE       |
| SCH-16  | 16TH FLOOR DOOR SCHEDULE       |
| SK4     | SHEER WALL NUMBER 4 ADJUSTMENT |
| SK5     | SHEER WALL NUMBER 6 ADJUSTMENT |
| SK6     | SHEER WALL NUMBER 2 ADJUSTMENT |
| SK7     | SHEER WALL NUMBER 3 ADJUSTMENT |
| SK8     | SHEER WALL NUMBER 1 ADJUSTMENT |
| SK12    | ENTRANCE RAMP @ RAMPART        |
| SK20    | FLOORS 9-14                    |
| SK21    | 15TH FLOOR                     |
| SK22    | 16TH FLOOR                     |
| SK23    | 17TH FLOOR                     |

| INDEX  |     |        |       |
|--------|-----|--------|-------|
|        |     | SHEET  |       |
|        | 1 . |        |       |
|        |     | FS-1   | GRO   |
|        |     | FS-2   | 2ND F |
|        |     | FS-3   | EMPL  |
|        |     | FS-4   | ROOF  |
|        |     |        |       |
| STMENT |     | SHEET  |       |
| STMENT |     | OHLLI  |       |
| STMENT |     | LS-1.1 | LAND  |
| STMENT |     |        |       |
| STMENT |     |        |       |
| •      |     |        |       |
|        |     |        |       |
|        |     |        |       |

| <br>   |                           |
|--------|---------------------------|
|        | KITCHEN DRAWING INDEX     |
| SHEET  | TITLE                     |
|        |                           |
| FS-1   | GROUND FLOOR FOOD SERVICE |
| FS-2   | 2ND FLOOR                 |
| FS-3   | EMPLOYEE CAFETERIA BOH    |
| FS-4   | ROOFTOP BAR               |
|        |                           |
|        | LANDSCAPE DRAWING INDEX   |
| SHEET  | TITLE                     |
| •      |                           |
| LS-1.1 | LANDSCAPE PLAN            |
| •      |                           |
|        |                           |
|        |                           |
|        |                           |

| SHEET  | TITLE                                    |
|--------|--|
| S1.0A  | GENERAL NOTES                            |
| S1.0B  | GENERAL NOTES                            |
| S1.1   | PILE CAP PLAN                            |
| S1.2   | SLAB PLAN                                |
| S1.3   | FOUNDATION PLAN                          |
| S1.4   | CRANE PILE CAP DETAILS                   |
| S1.5   | PILE CAP DETAILS                         |
| S1.6   | PILE CAP DETAILS                         |
| S1.7   | PILE CAP DETAILS                         |
| S1.8   | PILE CAP DETAILS                         |
| S1.9   | PILE CAP DETAILS                         |
| S1.10  | PILE CAP DETAILS                         |
| S1.11  | PILE CAP DETAILS                         |
| S1.12  | FOUNDATION SECTIONS                      |
| S1.13  | FOUNDATION SECTIONS                      |
| S1.14  | FOUNDATION SECTIONS                      |
| S1.15  | FOUNDATION SECTIONS                      |
| S1.16  | FOUNDATION SECTIONS                      |
| S1.17  | STAIR TUNNEL PLAN, SECTION & DETAILS     |
| S1.18  | FOUNDATION SECTIONS                      |
| S1.19  | FOUNDATION SECTIONS                      |
| S1.20  | FOUNDATION SECTION & DETAILS             |
| S1.21  | FOUNDATION DETAILS                       |
| S1.22  | FOUNDATION DETAILS                       |
| S2.0   | COLUMN TYPES - GROUND FLOOR              |
| S2.1   | COLUMN TYPES - 1ST FL STOREFRONT FRAMING |
| S2.2   | COLUMN TYPES - 1ST FLOOR MEZZANINE       |
| S2.3   | COLUMN TYPES - 2ND FLOOR                 |
| S2.4   | COLUMN TYPES - 2ND FLOOR MEZZANINE       |
| S2.5   | COLUMN TYPES - PARKING LEVEL 3 PLAN      |
| S2.6   | COLUMN TYPES - PARKING LEVEL 4 PLAN      |
| S2.7   | COLUMN TYPES - PARKING LEVEL 41 LAN      |
|        |  |
| S2.8   | COLUMN TYPES - PARKING LEVEL 7 PLAN      |
| S2.9   | COLUMN TYPES - PARKING LEVEL 7 PLAN      |
| S2.10  | 8TH FLOOR PLAN - HOTEL                   |
| S2.11  | COLUMN SCHEDULE & DETAILS                |
| S2.12A | SHEAR WALL 1 PLANS                       |
| S2.12B | SHEAR WALL 2 PLANS                       |
| S2.13  | SHEAR WALL 2 PLANS                       |
| S2.14  | SHEAR WALL 3 PLANS                       |
| S2.15  | SHEAR WALL 3, 4, & 6 PLANS               |
| S2.16  | DETAILS                                  |
| S2.17  | DETAILS                                  |
| S2.18  | DETAILS                                  |
| S2.19  | DETAILS                                  |
| S2.20  | DETAILS                                  |
| S2.21  | SHEAR WALL FRAMING PLANS                 |
| S2.22  | SHEAR WALL FRAMING PLANS                 |
| S2.23  | SHEAR WALL FRAMING PLANS                 |
| S2.24  | FRAMING DETAILS                          |
| S3.0   | 9TH & 14TH FLOOR COLUMN PLAN             |
| S3.1   | 9TH & 13TH FLOOR FRAMING PLAN            |
| S3.2   | 14TH FRAMING FLOOR PLAN                  |
| S3.3   | 15TH FRAMING FLOOR PLAN                  |
| S3.4   | 16TH FLOOR ROOF COLUMN PLAN              |
| S3.5A  | 16TH & 17TH FLOOR FRAMING PLAN-OPTION A  |
| S3.5B  | 16TH & 17TH FLOOR FRAMING PLAN-OPTION B  |
| S3.6   | ROOF FRAMING PLAN                        |
| S3.7   | ENLARGED PLANS - ELEVATOR TOWER #1       |
| S3.8   | ENLARGED PLANS - ELEVATOR TOWER #2       |
| S3.9   | ENLARGED PLANS - ELEVATOR TOWER #3       |
| S3.10  | ELEVATIONS                               |
| S3.11  | ELEVATIONS                               |
| S3.12  | ELEVATIONS                               |
| S3.13  | DETAILS                                  |
|        |  |

STRUCTURAL DRAWING INDEX

|         | TECHNICAL DRAWINGS INDEX     |  |
|---------|------------------------------|--|
| SHEET   | TITLE                        |  |
| T1.0    | GENERAL NOTES                |  |
| T2.1    | TECHNICAL GROUND FLOOR       |  |
| T2.1-1  | TECHNICAL INTERMEDIATE FLOOR |  |
| T2.02-1 | TECHNICAL MEZZANINE FLOOR    |  |
| T2.3    | TECHNICAL 3RD FLOOR          |  |
| T2.4    | TECHNICAL 4TH FLOOR          |  |
| T2.5    | TECHNICAL 5TH FLOOR          |  |
| T2.6    | TECHNICAL 6TH FLOOR          |  |
| T2.7    | TECHNICAL 7TH FLOOR          |  |
| T2.8    | TECHNICAL 8TH FLOOR          |  |
| T2.9    | TECHNICAL 9TH FLOOR          |  |
| T2.10   | TECHNICAL 10TH FLOOR         |  |
| T2.11   | TECHNICAL 11TH FLOOR         |  |
| T2.12   | TECHNICAL 12TH FLOOR         |  |
| T2.13   | TECHNICAL 13TH FLOOR         |  |
| T2.14   | TECHNICAL 14TH FLOOR         |  |
| T2.15   | TECHNICAL 15TH FLOOR         |  |
| T2.16   | TECHNICAL 16TH FLOOR         |  |
| T2.17   | TECHNICAL 17TH FLOOR         |  |
| T2.18   | TECHNICAL 18TH FLOOR         |  |

S3.14 DETAILS



SINCE 1961

1031 CANAL S NEW ORLEANS, I

BEEN PREPARED BY ME OR UNDER MY CLOSE PERSONAL SUPERVISION AND TO THE BEST OF MY KNOWLEDGE AND

CERTIFIED CORRECT

DESIGN OR INVENTION ARE RESERVED AND
WILL REMAIN THE SOLE PROPERTY OF HBSA

| II ARI                   | JIIIIE                   | .013                     | A FR                    | OI ES.                  | JIUNA                   | L L.L.                  |  |
|--------------------------|--------------------------|--------------------------|-------------------------|-------------------------|-------------------------|-------------------------|--|
|                          | R                        | EVIS                     | ION                     | HIS                     | TOR                     | Υ                       |  |
| 4/27/2018                | 5/4/2018                 | 5/11/2018                | 5/18/2018               | 5/25/2018               | 6/1/2018                | 6/8/2018                |  |
| s. #2 - CLOUD REVISION 1 | o. #2 - CLOUD REVISION 2 | o. #2 - CLOUD REVISION 3 | . #2 - CLOUD REVISION 4 | . #2 - CLOUD REVISION 5 | . #2 - CLOUD REVISION 6 | . #2 - CLOUD REVISION 7 |  |

- 0 8 4 0 0 V 8 INDEX OF DRAWINGS

PROJECT#: 1709 PHASE: DD TEAM: Author CHECKER: Checker SCALE: AS NOTED ISSUED: 4/20/2018

|                  | Sheet List-HVAC |                                     |  |  |
|------------------|-----------------|-------------------------------------|--|--|
| Sheet Discipline | Sheet #         | Sheet Name                          |  |  |
| 1 - MECHANICAL   |                 | 1ST FLOOR GROUND LEVEL - HVAC       |  |  |
| 1 - MECHANICAL   | M1.2            | INTERMEDIATE PARKING - HVAC         |  |  |
| 1 - MECHANICAL   | M1.2.1          | 2ND FLOOR - HVAC                    |  |  |
| 1 - MECHANICAL   | M1.2.3          | 2ND FLOOR MEZZANINE - HVAC          |  |  |
| 1 - MECHANICAL   | M1.3            | 3RD FLOOR ACCESSIBLE PARKING - HVAC |  |  |
| 1 - MECHANICAL   | M1.3.1          | 4TH FLOOR PARKING - HVAC            |  |  |
| 1 - MECHANICAL   | M1.3.2          | 5TH FLOOR PARKING - HVAC            |  |  |
| 1 - MECHANICAL   | M1.3.3          | 6TH FLOOR PARKING - HVAC            |  |  |
| 1 - MECHANICAL   | M1.3.4          | 7TH FLOOR PARKING - HVAC            |  |  |
| 1 - MECHANICAL   | M1.4            | 8TH FLOOR - HVAC                    |  |  |
| 1 - MECHANICAL   | M1.4.1          | 9TH FLOOR - HVAC                    |  |  |
| 1 - MECHANICAL   | M1.4.2          | 10TH - 12TH FLOORS - HVAC           |  |  |
| 1 - MECHANICAL   | M1.4.3          | 13TH FLOOR - HVAC                   |  |  |
| 1 - MECHANICAL   | M1.4.4          | 14TH FLOOR- HVAC                    |  |  |
| 1 - MECHANICAL   | M1.4.5          | 15TH FLOOR - HVAC                   |  |  |
| 1 - MECHANICAL   | M1.4.6          | 16TH FLOOR - HVAC                   |  |  |
| 1 - MECHANICAL   | M1.4.7          | 17TH FLOOR HVAC                     |  |  |
| 1 - MECHANICAL   | M1.4.8          | 18TH LEVEL - HVAC                   |  |  |
| 1 - MECHANICAL   | M1.5            | ROOF DECK - HVAC                    |  |  |
| 1 - MECHANICAL   | M2.1            | 1ST FLOOR GROUND LEVEL - PIPING     |  |  |
| 1 - MECHANICAL   | M2.2.1          | 2ND FLOOR - PIPING                  |  |  |
| 1 - MECHANICAL   | M2.4.3          | 13TH FLOOR - PIPING                 |  |  |
| 1 - MECHANICAL   | M3.1            | MECHANICAL SECTIONS                 |  |  |
| 1 - MECHANICAL   | M3.2            | MECHANICAL SECTIONS                 |  |  |
| 1 - MECHANICAL   | M5.1            | MECHANICAL DETAILS                  |  |  |
| 1 - MECHANICAL   | M5.2            | MECHANICAL DETAILS                  |  |  |
| 1 - MECHANICAL   | M5.3            | MECHANICAL DETAILS                  |  |  |
| 1 - MECHANICAL   | M6.1            | MECHANICAL SCHEDULES                |  |  |
| 1 - MECHANICAL   | M6.2            | MECHANICAL SCHEDULES                |  |  |
| 1 - MECHANICAL   | M6.3            | MECHANICAL SCHEDULES                |  |  |
| 1 - MECHANICAL   | M7.1            | MECHANICAL CONTROLS 1               |  |  |
| 1 - MECHANICAL   | M7.2            | MECHANICAL CONTROLS 2               |  |  |
| 1 - MECHANICAL   | M7.3            | MECHANICAL CONTROLS 3               |  |  |
| 1 - MECHANICAL   | M7.4            | MECHANICAL CONTROLS 4               |  |  |
| 1 - MECHANICAL   | M7.5            | MECHANICAL CONTROLS 5               |  |  |
| 1 - MECHANICAL   | M8.1            | STAIR PRESSURIZATION RISER DIAGRAM  |  |  |
| 1 - MECHANICAL   | M8.2            | MECHANICAL WATER RISER DIAGRAMS     |  |  |
| 1 - MECHANICAL   | M8.3            | MECHANICAL WATER RISER DIAGRAMS     |  |  |
| 1 - MECHANICAL   | M8.4            | MECHANICAL WATER RISER DIAGRAMS     |  |  |
| 1 - MECHANICAL   | M8.5            | MECHANICALWATER RISER DIAGRAMS      |  |  |

|                              | Snee         | t List-PLUMBING                                 |
|------------------------------|--------------|---|
| Sheet Discipline             | Sheet #      | Sheet Name                                      |
| 2 - PLUMBING                 | P0.1         | GENERAL NOTES, ABBREVIATIONS, & SYMBOLS         |
| 2 - PLUMBING                 | P1.0         | UNDER 1ST FLOOR GROUND LEVEL - PLUMBING         |
| 2 - PLUMBING                 | P1.1         | 1ST FLOOR GROUND FLOOR - PLUMBING               |
| 2 - PLUMBING                 | P1.2         | INTERMEDIATE PARKING - PLUMBING                 |
| 2 - PLUMBING                 | P1.2.1       | 2ND FLOOR - PLUMBING                            |
| 2 - PLUMBING                 | P1.2.3       | 2ND FLOOR MEZZANINE - PLUMBING                  |
| 2 - PLUMBING                 | P1.3         | 3RD FLOOR ACCESSIBLE PARKING - PLUMBING         |
| 2 - PLUMBING                 | P1.3.1       | 4TH FLOOR PARKING - PLUMBING                    |
| 2 - PLUMBING                 | P1.3.2       | 5TH FLOOR PARKING - PLUMBING                    |
| 2 - PLUMBING                 | P1.3.3       | 6TH FLOOR PARKING - PLUMBING                    |
| 2 - PLUMBING                 | P1.3.4       | 7TH FLOOR PARKING - PLUMBING                    |
| 2 - PLUMBING                 | P1.4         | 8TH FLOOR - PLUMBING                            |
| 2 - PLUMBING                 | P1.4.1       | 9TH FLOOR - PLUMBING                            |
| 2 - PLUMBING                 | P1.4.2       | 10TH - 12TH FLOORS - PLUMBING                   |
| 2 - PLUMBING                 | P1.4.3       | 13TH FLOOR - PLUMBING                           |
| 2 - PLUMBING                 | P1.4.4       | 14TH FLOOR - PLUMBING                           |
| 2 - PLUMBING                 | P1.4.5       | 15TH FLOOR - PLUMBING                           |
| 2 - PLUMBING                 | P1.4.6       | 16TH FLOOR - PLUMBING                           |
| 2 - PLUMBING                 | P1.4.7       | 17TH FLOOR - PLUMBING                           |
| 2 - PLUMBING                 | P1.5         | ROOF DECK - PLUMBING                            |
| 2 - PLUMBING                 | P4.1         | PLUMBING ENLARGED PLANS                         |
| 2 - PLUMBING                 | P4.2         | PLUMBING ENLARGED PLANS                         |
| 2 - PLUMBING                 | P4.3         | PLUMBING ENLARGED PLANS                         |
| 2 - PLUMBING                 | P4.4         | PLUMBING ENLARGED PLANS                         |
| 2 - PLUMBING                 | P4.5         | PLUMBING ENLARGED PLANS                         |
| 2 - PLUMBING<br>2 - PLUMBING | P4.6         | PLUMBING ENLARGED PLANS                         |
| 2 - PLUMBING                 | P4.7         | PLUMBING ENLARGED PLANS                         |
| 2 - PLUMBING                 | P4.8         | PLUMBING ENLARGED PLANS                         |
| 2 - PLUMBING                 | P4.9         | PLUMBING ENLARGED PLANS                         |
| 2 - PLUMBING                 | P5.0<br>P5.1 | PLUMBING ENLARGED PLANS PLUMBING ENLARGED PLANS |
| 2 - PLUMBING                 | P6.1         | PLUMBING ENLARGED PLANS PLUMBING DETAILS        |
| 2 - PLUMBING                 | P6.2         | PLUMBING DETAILS  PLUMBING DETAILS              |
| 2 - PLUMBING                 | P6.3         | PLUMBING DETAILS  PLUMBING DETAILS              |
| 2 - PLUMBING                 | P6.4         | PLUMBING DETAILS                                |
| 2 - PLUMBING                 | P8.1         | PLUMBING RISER DIAGRAMS                         |
| 2 - PLUMBING                 | P8.2         | PLUMBING RISER DIAGRAMS                         |
| 2 - PLUMBING                 | P8.3         | PLUMBING RISER DIAGRAMS                         |
| 2 - PLUMBING                 | P8.4         | PLUMBING RISER DIAGRAMS                         |
| 2 - PLUMBING                 | P8.5         | PLUMBING GAS DIAGRAM                            |
| 2 - PLUMBING                 | P8.6         | PLUMBING WATER DIAGRAM 1                        |
| 2 - PLUMBING                 | P8.6.1       | PLUMBING WATER DIAGRAM 2                        |
| 2 - PLUMBING                 | P8.6.2       | PLUMBING WATER DIAGRAM 3                        |
| 2 - PLUMBING                 | P8.7         | PLUMBING WATER DIAGRAMS                         |
| 2 - PLUMBING                 | P8.8         | PLUMBING WATER DIAGRAMS                         |
| 2 - PLUMBING                 | P8.9         | PLUMBING WATER DIAGRAMS                         |
| 2 - PLUMBING                 | P8.10        | PLUMBING WATER DIAGRAMS                         |

|                  | Sheet   | List-ELECTRICAL                                     |
|------------------|---------|---|
| Sheet Discipline | Sheet # | Sheet Name  |
| 3 - ELECTRICAL   |         | INDEX, ABBREVIATIONS, & SYMBOLS                     |
| 3 - ELECTRICAL   |         |   |
| 3 - ELECTRICAL   |         | ABBREVIATIONS, SCHEDULES AND NOTES ELECTRICAL NOTES |
| 3 - ELECTRICAL   |         | LIGHTING NOTES AND SCHEDULES                        |
| 3 - ELECTRICAL   | ⊏0.4    | LIGHTING NOTES AND SCHEDULES                        |
| 3 - ELECTRICAL   | E0.5    | LIGHTING FIXTURE SCHEDULE AND NOTES                 |
| 3 - ELECTRICAL   | E1.1    | 1ST FLOOR GROUND LEVEL - LIGHTING                   |
| 3 - ELECTRICAL   | E1.2    | INTERMEDIATE PARKING - LIGHTING                     |
| 3 - ELECTRICAL   | E1.2.1  | 2ND FLOOR - LIGHTING                                |
| 3 - ELECTRICAL   | E1.2.3  | 2ND FLOOR MEZZANINE - LIGHTING                      |
| 3 - ELECTRICAL   | E1.3    | 3RD FLOOR ACCESSIBLE PARKING -<br>LIGHTING          |
| 3 - ELECTRICAL   | E1.3.1  | 4TH FLOOR PARKING - LIGHTING                        |
| 3 - ELECTRICAL   | E1.3.2  | 5TH FLOOR PARKING - LIGHTING                        |
| 3 - ELECTRICAL   | E1.3.3  | 6TH FLOOR PARKING - LIGHTING                        |
| 3 - ELECTRICAL   | E1.3.4  | 7TH FLOOR PARKING - LIGHTING                        |
| 3 - ELECTRICAL   | E1.4    | 8TH FLOOR - LIGHTING                                |
| 3 - ELECTRICAL   | E1.4.1  | 9TH FLOORS - LIGHTING                               |
| 3 - ELECTRICAL   | E1.4.2  | 10TH-12TH FLOORS - LIGHTING                         |
| 3 - ELECTRICAL   | E1.4.3  | 13TH FLOOR - LIGHTING                               |
| 3 - ELECTRICAL   | E1.4.4  | 14TH FLOOR - LIGHTING                               |
| 3 - ELECTRICAL   | E1.4.5  | 15TH FLOOR - LIGHTING                               |
| 3 - ELECTRICAL   | E1.4.6  | 16TH & 17TH FLOOR - LIGHTING                        |
| 3 - ELECTRICAL   | E1.5    | 18TH FLOOR PENTHOUSE - LIGHTING                     |
| 3 - ELECTRICAL   | E2.1    | 1ST FLOOR GROUND LEVEL - POWER & IT                 |
| 3 - ELECTRICAL   | E2.2    | INTERMEDIATE PARKING - POWER & IT                   |
| 3 - ELECTRICAL   | E2.2.1  | 2ND FLOOR - POWER & IT                              |
| 3 - ELECTRICAL   | E2.2.3  | 2ND FLOOR MEZZANINE - POWER & IT                    |
| 3 - ELECTRICAL   | E2.3    | 3RD FLOOR ACCESSIBLE PARKING - POWER & IT           |
| 3 - ELECTRICAL   | E2.3.1  | 4TH FLOOR PARKING - POWER & IT                      |
| 3 - ELECTRICAL   | E2.3.2  | 5TH FLOOR PARKING - POWER & IT                      |
| 3 - ELECTRICAL   | E2.3.3  | 6TH FLOOR PARKING - POWER & IT                      |
| 3 - ELECTRICAL   | E2.3.4  | 7TH FLOOR PARKING - POWER & IT                      |
| 3 - ELECTRICAL   |         | 8TH FLOOR - POWER & IT                              |
| 3 - ELECTRICAL   | E2.4.1  | 9TH FLOORS - POWER & IT                             |
| 3 - ELECTRICAL   | E2.4.2  | 10TH-12TH FLOORS - POWER & IT                       |
| 3 - ELECTRICAL   | E2.4.3  | 13TH FLOOR - POWER & IT                             |
| 3 - ELECTRICAL   | E2.4.4  | 14TH FLOOR - POWER & IT                             |
| 3 - ELECTRICAL   | E2.4.4  | 15TH FLOOR - POWER & IT                             |
| 3 - ELECTRICAL   | E2.4.5  | 16TH & 17TH FLOOR - POWER & IT                      |
|                  |         |   |
| 3 - ELECTRICAL   | E2.5.1  | ROOF PLAN - POWER & IT                              |

|  | Sheet  | List-ELECTRICAL  |
|--|--|--|
| Sheet Discipline 3 - ELECTRICAL  | Sheet #<br>E3.1  | Sheet Name  1ST FLOOR GROUND LEVEL - SPECIAL SYSTEMS   |
| 3 - ELECTRICAL   | E3.2   | INTERMEDIATE PARKING - SPECIAL SYSTEMS   |
| 3 - ELECTRICAL   | E3.2.1   | 2ND FLOOR - SPECIAL SYSTEMS  |
| 3 - ELECTRICAL   | E3.2.3   | 2ND FLOOR MEZZANINE - SPECIAL  |
| 3 - ELECTRICAL   | E3.3   | SYSTEMS  3RD FLOOR ACCESSIBLE PARKING -  |
| 3 - ELECTRICAL   | E3.3   | SPECIAL SYSTEMS  |
| 3 - ELECTRICAL   | E3.3.1   | 4TH FLOOR PARKING - SPECIAL SYSTEM   |
| 3 - ELECTRICAL   | E3.3.2   | 5TH FLOOR PARKING - SPECIAL SYSTEM   |
| 3 - ELECTRICAL   | E3.3.3   | 6TH FLOOR PARKING - SPECIAL SYSTEM   |
| 3 - ELECTRICAL   | E3.3.4   | 7TH FLOOR PARKING - SPECIAL SYSTEM   |
| 3 - ELECTRICAL   | E3.4.1   | 8TH FLOOR - SPECIAL SYSTEMS  |
| 3 - ELECTRICAL   | E3.4.2   | 9TH-13TH FLOORS - SPECIAL SYSTEMS  |
| 3 - ELECTRICAL   | E3.4.4   | 14TH FLOOR- SPECIAL SYSTEMS  |
| 3 - ELECTRICAL   | E3.4.5   | 15TH FLOOR - SPECIAL SYSTEMS   |
|  |  |  |
| 3 - ELECTRICAL   | E3.4.6   | 16TH & 17TH FLOOR PENTHOUSES -<br>SPECIAL SYSTEMS  |
| 3 - ELECTRICAL   | E3.5   | ROOF DECK - SPECIAL SYSTEMS  |
| 3 - ELECTRICAL   | E4.1   | ENLARGED ELECTRICAL PLANS  |
| 3 - ELECTRICAL   | E4.2   | ENLARGED ELECTRICAL PLANS  |
| 3 - ELECTRICAL   | E4.3   | ENLARGED ELECTRICAL PLANS  |
| 3 - ELECTRICAL   | E4.4   | ENLARGED ELECTRICAL PLANS  |
| 3 - ELECTRICAL   | E4.15  | ENLARGED ELECTRICAL PLANS  |
| 3 - ELECTRICAL   | E5.1   | POWER RISER DIAGRAMS SCHEDULES A NOTES   |
| 3 - ELECTRICAL   | E5.2   | POWER RISER DIAGRAM PART 1   |
| 3 - ELECTRICAL   | E5.3   | POWER RISER DIAGRAM PART 2   |
| 3 - ELECTRICAL   | E5.4   | POWER RISER DIAGRAM PART 3   |
| 3 - ELECTRICAL   | E5.4   | GROUNDING AND RACEWAY RISER  |
| 3 - LLLGTRIGAL   | L3.3   | DIAGRAM - TELECOMMUNICATIONS   |
| 3 - ELECTRICAL   | E6.1   | PANEL SCHEDULES  |
| 3 - ELECTRICAL   | E6.2   | PANEL SCHEDULES  |
| 3 - ELECTRICAL   | E6.3   | PANEL SCHEDULES  |
| 3 - ELECTRICAL   | E6.4   | PANEL SCHEDULES  |
| 3 - ELECTRICAL   | E6.5   | PANEL SCHEDULES  |
| 3 - ELECTRICAL   | E6.6   | PANEL SCHEDULES  |
| 3 - ELECTRICAL   | E6.7   | PANEL SCHEDULES  |
|  | E6.8   | PANEL SCHEDULES  |
| 3 - ELECTRICAL   | +  |  |
| 3 - ELECTRICAL<br>3 - ELECTRICAL   | E6.9   | PANEL SCHEDULES  |
|  | E6.9<br>E6.10  | PANEL SCHEDULES PANEL SCHEDULES  |
| 3 - ELECTRICAL   |  |  |
| 3 - ELECTRICAL<br>3 - ELECTRICAL   | E6.10  | PANEL SCHEDULES  |
| 3 - ELECTRICAL<br>3 - ELECTRICAL<br>3 - ELECTRICAL   | E6.10<br>E6.11   | PANEL SCHEDULES PANEL SCHEDULES  |
| 3 - ELECTRICAL<br>3 - ELECTRICAL<br>3 - ELECTRICAL<br>3 - ELECTRICAL   | E6.10<br>E6.11<br>E6.12  | PANEL SCHEDULES PANEL SCHEDULES PANEL SCHEDULES  |
| 3 - ELECTRICAL   | E6.10 E6.11 E6.12 E6.13 E6.14 E6.15 E6.16 E6.17 E6.18 E6.19 E6.20                      | PANEL SCHEDULES  |
| 3 - ELECTRICAL  | E6.10 E6.11 E6.12 E6.13 E6.14 E6.15 E6.16 E6.17 E6.18 E6.19 E6.20 E6.21                | PANEL SCHEDULES  |
| 3 - ELECTRICAL                | E6.10 E6.11 E6.12 E6.13 E6.14 E6.15 E6.16 E6.17 E6.18 E6.19 E6.20 E6.21 E7.1           | PANEL SCHEDULES  |
| 3 - ELECTRICAL | E6.10 E6.11 E6.12 E6.13 E6.14 E6.15 E6.16 E6.17 E6.18 E6.19 E6.20 E6.21 E7.1 E7.2      | PANEL SCHEDULES PELECTRICAL DETAILS ELECTRICAL DETAILS |
| 3 - ELECTRICAL                | E6.10 E6.11 E6.12 E6.13 E6.14 E6.15 E6.16 E6.17 E6.18 E6.19 E6.20 E6.21 E7.1           | PANEL SCHEDULES  |

189 Maple Ridge Drive Metairie, LA 70001 (504)-885-4477 central@hbsaii.com :∹ hbsaii.com

SINCE 1961

1031 CANAL STREET NEW ORLEANS, LOUISIANA

THESE PLANS AND SPECIFICATIONS HAVE
BEEN PREPARED BY ME OR UNDER MY
CLOSE PERSONAL SUPERVISION AND TO
THE BEST OF MY KNOWLEDGE AND
BELIEF THEY COMPLY WITH ALL CITY,
STATE AND FEDERAL REQUIREMENTS, AND
I AM NOT PROVIDING CONTRACT
ADMINISTRATION. CERTIFIED CORRECT



THIS DRAWING IS CONFIDENTIAL AND NOT BE LOANED, REPRODUCED, COPIED, EITHER WHOLLY OR IN PART, OR MADE PUBLIC IN ANY MANNER WITHOUT THE WRITTEN CONSENT OF HBSA II ARCHITECTS, A PROFESSIONAL L.L.C. ALL RIGHTS OF DESIGN OR INVENTION ARE RESERVED AND WILL REMAIN THE SOLE PROPERTY OF HBSA II ARCHITECTS A PROFESSIONAL L.L.C.

| REVISION HISTORY             |                              |                              |                              |                              |                              |                              |   |  |  |
|------------------------------|------------------------------|------------------------------|------------------------------|------------------------------|------------------------------|------------------------------|---|--|--|
| 4/27/2018                    | 5/4/2018                     | 5/11/2018                    | 5/18/2018                    | 5/25/2018                    | 6/1/2018                     | 6/8/2018                     |   |  |  |
| L.I.S. #2 - CLOUD REVISION 1 | L.I.S. #2 - CLOUD REVISION 2 | L.I.S. #2 - CLOUD REVISION 3 | L.I.S. #2 - CLOUD REVISION 4 | L.I.S. #2 - CLOUD REVISION 5 | L.I.S. #2 - CLOUD REVISION 6 | L.I.S. #2 - CLOUD REVISION 7 |   |  |  |
| -                            | 2                            | 3                            | 4                            | 2                            | 9                            | 7                            | 8 |  |  |

INDEX OF DRAWINGS

PROJECT#: 1709 PHASE: DD TEAM: Author CHECKER: Checker
SCALE: AS NOTED
ISSUED: 4/20/2018
SHEET#:

A0.1-B

MULTI-USE "HIGH RISE" BUIDLING PROPOSED USE: **HOTEL & CONDO SPACE OVER** PARKING, RESTAURANT AND RETAIL

SPACE APPLICABLE CODES

NEC CODE:

**BUILDING CODE:** 2015 INTERNATIONAL BUILDING CODE STRUCTURAL CODE: 2012 INTERNATIONAL BUILDING CODE PLUMBING CODE: 2012 INTERNATIONAL PLUMBING CODE

MECHANICAL CODE: 2015 INTERNATIONAL MECHANICAL CODE

**ENERGY CODE:** ASHRAE 90.1 2007. IECC DOES NOT APPLY TO HIGH-RISE PER LA DEPT OF NATURAL RESOURCES

NFPA 70 2011 EDITION

ACCESSIBILITY CODE: AMERICANS WITH DISABILITIES ACT (ADA) AND ARCHITECTURAL BARRIERS ACT ACCESSIBILITY GUIDELINES JULY 23, 2004, FAIR HOUSING AIR

LIFE SAFETY CODE: NFPA 101, 2015 EDITION

MUNICIPAL CODE OF ORDINANCE: THE CITY OF NEW ORLEANS LAND DEVELOPMENT ORDINANCE

SWIMMING POOL: ICC 2015 INT`L S,P & SPA CODE AND 2011 APSP-14

INT'L FIRE CODE: IFC 2015

OTHER RELATED CODES: ANSI 117.1 SECTION 702)

OCCUPANCY: A-2 - ASSEMBLY M - MERCANTILE S-2 LOW-HAZARD STORAGE R-1 RESIDENTIAL (HOTEL) R-2 RESIDENTIAL (CONDOS)

REQUIRED OCCUPANCY SEPARATION:

IBC 2015 TABLE

NFPA TABLE 6.1.14.4.1 BUILDING IS MULTIPLE OCCUPANT WITH SEPARATED

OCCUPANCIES SPRINKLERED THROUGHOUT.

CONSTRUCTION TYPE: TYPE I-A

SPECIFIC APPLICABLE CODES:

LIFE SAFETY SYSTEMS:

NFPA 13, 14, 20 & 27 SPRINKLER SYSTEM: FIRE ALARM & COMMUNICATION SYSTEM: NFPA 72 SMOKE CONTROL: NFPA 92A, 92B & 101 EMERGENCY POWER & LIGHTING NFPA 110 STAND BY POWER:

DESIGN LOADS:

130 P.S.F. 40 P.S.F. CORRIDORS 100 P.S.F. STAIRS 100 P.S.F. **ROOF** 20 P.S.F.

HANDRAILS: CONCENTRATED LOAD OF 200 LB. APPLIED AT ANY POINT AND IN ANY DIRECTION.

**GUARDRAILS:** CONCENTRATED LOAD OF 200 LB. APPLIED AT ANY POINT AND IN ANY DIRECTION AT THE

**GENERAL CODE DATA:** 

TOP OF THE GUARDRAIL

ALL WALL COVERINGS, FINISHES, FABRICS, WOODS, ACOUSTICAL TILES WILL HAVE A CLASS "A" FLAME SPREAD AND A SMOKE CONTRIBUTION OF 450 OR **GREATER** 

ALL FLOOR PENETRATIONS WILL BE SEALED WITH A FIRE BARRIER AND A FIRE SHAFTING THAT WILL MEET OR EXCEED THE RATING OF THE FLOOR SYSTEM BEING PENETRATED.

ALL HARDWARE IN REQUIRED EGRESS DOORS WITH LOCKS WILL PROVIDED WITH A THUMB LATCH LOCK RELEASE FROM THE INSIDE AS TO PROVIDE AN UNIMPEDED EGRESS. (PANIC BARS IN REQUIRED

ALL EXIT SIGNS WILL BE OF THE EMERGENCY TYPE, 4912 MCS.

TOTAL PARKING COUNT = 406 SPACES (11 OF WHICH ARE ADA EQUALING 2.7%)

### **GENERAL BUILDING LIMITATONS:**

RESIDENTIAL GROUP R-2

SEE PLANS

ZONE 4B - 2009 INTERNATIONAL ENERGY CONSERVATION CODE TABLE 5.5.1

19.45 TOTAL (NOT INCLUDING AIR SPACE, GFRC & METAL PANELS

AS PRE IBC CHAPTER 17 "STRUCTURAL TESTS AND SPECIAL INSPECTION"

THE PROJECT OWNERS WILL CONTRACT WITH A LICENSED THIRD PARTY

CONDUCT TESTS ON PILING, CONCRETE, STEEL, CONNECTIONS, ETC.

PROJECT DAILY REPORTS WILL BE COMPILED AND MAINTAINED AT THE

INDEPENDENT TESTING AND INSPECTION PROFESSIONAL TO INSPECT AND

PROJECT SITE FOR INSPECTION BY THE AUTHORITY HAVING JURISDICTION.

THE BUILDING WILL BE COMPLETELY PROTECTED BY A FULLY SUPERVISED

SECTION 903 "AUTOMATIC SPRINKLER SYSTEMS", AND NFPA 13. INCLUDE

A COMPLETE FIRE ALARM AND DETECTION SYSTEM WILL BE PROVIDED AS

A FIRE PUMP WILL BE PROVIDED TO AUGMENT WATER PRESSURE FOR THE

ELEVATOR LOBBIES TO BE SMOKE COMPARTMENTS WITH AUTOMATIC SELF

CLOSING DOORS CAPABLE OF BEING TRIGGERED BY FIRE ALARM / SMOKE

DETECTOR PER NFPA. ENCLOSED STAIRWELLS AREA ALSO REQUIRED TO BE

AN EMERGENCY GENERATOR WILL BE PROVIDED TO PROVIDE POWER FOR 2

ELEVATORS, EMERGENCY LIGHTING, EXIT LIGHTING, STAIR PRESSURIZATION SYSTEMS, FIRE CONTROL ROOM EQUIPMENT, ALARM SYSTEM, FIRE PUMP AND

OTHER EMERGENCY DEVICES. GENERATOR WILL BE POWERED BY NATURAL

AS PER IBC 2009 SECTION 911 "FIRE COMMAND CENTER" AND NFPA 101 2009

CHAPTER 11 SECTION 11.8.6. A ROOM IS PROVIDED WITH DIRECT ACCESS TO

THE EXTERIOR SEPARATED FROM OTHER SPACES BY A 2 HOUR FIRE RATING.

THE ROOM AREA WILL BE 200 SQUARE FEET AND WILL HAVE THE FOLLOWING FEATURES: 1. EMERGENCY VOICE/ALARM COMMUNICATION SYSTEM: 2. FIRE

ANNUNCIATOR; 4. ANNUNCIATOR UNIT VISUALLY INDICATION THE LOCATION

DEPARTMENT COMMUNICATION SYSTEM: 3. FIRE DETECTION AND ALARM

OF THE ELEVATORS AND WHETHER THEY ARE OPERATIONAL; 5. STATUS

DOORS SIMULTANEOUSLY; 8. SPRINKLER VALVE & WATER FLOW DETECTOR DISPLAY PANELS; 9. EMERGENCY & STANDBY POWER STATUS INDICATORS; 10.

INDICATORS; 12. SCHEMATIC BUILDING PLANS SHOWING EGRESS ROUTS; 13.

RECALL SWITCH; 17. ELEVATOR EMERGENCY OR STANDBY POWER SELECTOR

DEPARTMENT PERSONAL FOR EVACUATION DURING AN EMERGENCY AS FIRE

WORK TABLE; 14. GENERATOR SUPERVISION DEVICES, MANUAL START AND

TRANSFER FEATURES; 15. PUBLIC ADDRESS SYSTEM; 16. ELEVATOR FIRE

ELEVATORS #1 AND #10 ARE ON BACK-UP POWER TO BE USED BY FIRE

SERVICE ACCESS ELEVATORS. PROVIDE THE REQUIRED SIGNAGE PER

\*THIS PLAN IS PROVIDED FOR THE CONVENIENCE OF THE BUILDING

FEATURES OF THE PROJECT INCLUDING THE EXIT FLOW AND FIRE

\*SEE MECHANICAL DRAWINGS FOR LOCATIONS OF FIRE DAMPER

\*SEE PLUMBING DRAWINGS FOR STANDPIPE SYSTEMS

\*SEE ELECTRICAL DRAWINGS FOR LOCATION OF FIRE ALARM SYSTEM

OFFICIAL AND FIRE MARSHAL. IT DOCUMENTS THE MAJOR LIFE SAFETY

SEPARATION. THIS PLAN IS TO BE FOLLOWED IN REGARDS TO LIFE SAFETY

REQUIREMENTS IN DUCTWORK. IN GENERAL ALL DUCTWORK THRU RATED

\*SEE REFLECTED CEILING PLANS AND ELECTRIRCAL DRAWINGS FOR EXIT

INDICATORS AND CONTROLS FOR AIR DISTRIBUTION SYSTEMS; 6. FIRE FIGHTER'S CONTROL PANEL; 7. CONTROLS FOR UNLOCKING STAIRWAY

PUBLIC TELEPHONE FOR FIRE DEPARTMENT; 11. FIRE PUMP STATUS

GAS. AN AUTOMATIC TRANSFER SWITCH WILL BE PROVIDED TO REDIRECT

AUTOMATIC SUPERVISED FIRE SPRINKLER SYSTEM. FIRE PUMP WILL BE

POWERED BY A NATURAL GAS GENERATOR LOCATED ON PREMISES.

BUILT AS SMOKEPROOF ENCLOSURES PER IBC 403.5.4

COMMUNICATION SYSTEMS. PROVIDE AUDIBLE AND VISUAL SIGNALS IN

NFPA CHAPTER 9 SECTION 9.6 "FIRE DETECTION, ALARM, AND

PER CHAPTER 9 SECTION 908 "FIRE ALARM AND DETECTION SYSTEMS" AND

AUTOMATIC SPRINKLER SYSTEM IN ACCORDANCE WITH IBC 2015 CHAPTER 9

AREA ALLOWED: UNLIMITED

HEIGHT ALLOWED: UNLIMITED

STORIES ALLOWED: UNLIMITED

HEIGHT PROVIDED: N/A

STORIES PROVIDED: 10

TYPE OF CONSTRUCTION: TYPE 1-A

AREA PROVIDED: VARIES PER FLOOR

ASSEMBLY: GROUP A-2

TYPE OF CONSTRUCTION: TYPE 1-A AREA ALLOWED: UNLIMITED AREA PROVIDED: VAIRES, SEE PLANS HEIGHT ALLOWED: UNLIMITED HEIGHT PROVIDED: N/A STORIES ALLOWED: UNLIMITED STORIES PROVIDED: 4

**BUSINESS OCCUPANCY: GROUP B** 

TYPE OF CONSTRUCTION: TYPE 1-A AREA ALLOWED: UNLIMITED AREA PROVIDED: N/A HEIGHT ALLOWED: UNLIMITED HEIGHT PROVIDED: N/A STORIES ALLOWED: UNLIMITED STORIES PROVIDED: 1

OPEN PARKING GARAGE GROUP S-2

STORIES PROVIDED: 5

THERMAL ENVELOPE:

5/8" GYP. BOARD (INTERIOR)

1" GFRC & PERFORATED METAL

**6" BATT INSULATION** 

ROOF COMPOSITION

YPE PROVIDED: TPO

TOTAL PROVIDED

SPRINKLERS:

FIRE ALARM:

FIRE PUMP:

POWFR.

SMOKE PROTECTION:

**EMERGENCY GENERATOR:** 

FIRE CONTROL ROOM:

**ELEVATOR EGRESS:** 

**GENERAL NOTES:** 

WALL WILL REQUIRE A DAMPER.

LIGHT LOCATIONS

ISSUES BY THE GENERAL CONTRATOR.

TOTAL MINIMAL REQUIRED

SPECIALTY INSPECTIONS:

STANDPIPE SYSTEM PER IBC 905.3.

ACCORDANCE WITH ANSI 117.1 SECTION 702.

WALL COMPOSITION MINIMUM REQUIRED: R-13

TYPE OF CONSTRUCTION: TYPE 1-A AREA ALLOWED: UNLIMITED AREA PROVIDED: 38,159 SF PER STORY (RAMPS OMITTED) HEIGHT ALLOWED: UNLIMITED HEIGHT PROVIDED: VARIES, SEE PLANS STORIES ALLOWED: UNLIMITED

FIRE RESISTANCE RATINGS FOR TYPE I CONSTRUCTION: T.601

REQUIRED PROVIDED DESIGN # FOR RATED ASSEMBLY **BUILDING ELEMENT** HOURLY HOURLY COLUMNS  $\parallel$  3 HOUR  $\parallel$  3 HOUR +  $\parallel$  IBC TABLE 721.1(1) 5-1.1 = 1.5" MIN. THICKNESS. STRUCTURAL FRAME: GIRDERS | 3 HOUR | 3 HOUR + | IBC TABLE 721.1(1) 4-1.1 = 4.5" MIN. THICKNESS CONCRETE W/ PT SLAB (1ST THRU 8TH LEVEL) FLOORS | 2 HOUR | 2 HOUR + IBC TABLE 721.1(3) 5" MIN. THICK, ...(1) 4-1.1 = 1.5" MIN. COVER STRUCTURAL FRAME: IBC TABLE 721.1(1) 1-1.1 = 2" MIN. THICKNESS. 2" PROVIDED COLUMNS 3 HOUR 3 HOUR STEEL W/ FIREPROOFING GIRDERS 3 HOUR 3 HOUR IBC TABLE 721.1(1) 1-1.1 = 2" MIN. THICKNESS, 2" PROVIDED REINFORCED CONC. DECI FLOORS 2 HOUR 2 HOUR IBC TABLE 721.1(3) 6-4.1 = 2.5" MIN. THICKNESS, 4.5" PROVIDE (9TH THRU 17TH | EVFL) IBC TABLE 721.1(1) 1-1.1 = 2" MIN. THICKNESS. 2" PROVIDED COLUMNS 2 HOUR 2 HOUR STRUCTURAL FRAME IBC TABLE 721.1(1) 1-1.1 = 2" MIN. THICKNESS. 2" PROVIDED (17TH LEVEL SUPPORTING GIRDERS 2 HOUR | 2 HOUR ROOF ONLY) 1.5 HOUR 1.5 HOUR+ BC TABLE 721.1(3) 6-4.1 = 2.5" MIN. THICKNESS, 4.5" PROVIDE EXTERIOR 3 HOUR 3 HOUR UL # U904 **BEARING WALLS** (1ST THRU 17TH LEVEL) INTERIOR 3 HOUR 3 HOUR VARIES, SEE PARTITION SCHEDULE **BEARING WALLS** EXTERIOR 2 HOUR 2 HOUR VARIES, SEE PARTITION SCHEDULE (18TH LEVEL SUPPORTIN **ROOF ONLY**) VARIES, SEE PARTITION SCHEDULE INTERIOR | 2 HOUR | 2 HOUR EXTERIOR VARIES 1 HOUR BASED ON PROXIMITY **EXTERIOR** NON-BEARING WALLS (GFRC) 1 HOUR 1 HOUR IBC TABLE 721.1(2) 15-1.11 INTERIOR .5 HOUR .5 HOUR UL # U419

**AREAS OF REFUGE** 

AREAS OF REFUGE ARE NOT REQUIRED AT STAIRWAYS IN BUILDINGS EQUIPED THROUGHOUT BY AN AUTOMATIC SPRINKLER SYSTEM (IBC 1007.3 EXCEPTION 2)

IN BUILDINGS PROTECTED THROUGHOUT BY AN APPROVED. SUPERVISED AUTOMATIC SPRINKLER SYSTEM. THE TWO ACCESSIBLE ROOMS OR SPACES SEPARATED FROM EACH OTHER BY SMOKE RESISTIVE PARTITIONS IN ACCORDANCE WITH THE DEFINITION OF AREA OF REFUGE IN 3.3.20 SHALL NOT BE REQUIRED (NFPA 30.2.2.12.2). PROVIDE 2-WAY COMMUNICATION ON ALL ELEVATOR LANDINGS PER NFPA 101-SECTION 7.2.12.1.

**ADDITIONAL CODE REQUIRMENTS** 

1. Per LAC 55:V:307 Periodic observation of construction shall be made by a licensed architect or civil engineer. A Certificate of Completion containing the signature(s) of the responsible design professional(s) shall be presented to the State Fire Marshall Inspector at time of final inspection for occupancy.

2. Per LRS 40:1731 Provide access for persons with disabilities in accordance with the ADA-ABA Accessibility Guidelines, July 23, 2004 (also known as the 2010 Standards). Particular deficiencies and paragraph references are noted as follows: a) 302 Floor and ground surfaces shall be stable, firm, and slip-resistant.

d) 216.2 Where signage identifies permanent rooms or spaces OR EXITS, the signage shall comply with Sections 703.1 - 703.5 (raised characters, Braille, visual

b) 303 Thresholds shall comply with requirements of this section regarding changes in level. (Not more than 1/2" height and beveled if over 1/4") c) 404.2.7 Handles, pulls, latches, locks, and other operable parts on doors and gates shall comply with 309.4. Hardware shall not require tight grasping, tight pinching, or twisting of the wrist to operate.

characteristics, height) e) 215.2 and 215.3 Where emergency warning systems are provided, they shall include both audible alarms and visual alarms. (Employee work areas and offices shall be wired such that visible alarms can be installed as needed.)

f) ADA-ABA:407.4 Elevator cars shall comply with 407.4 as follows:: 407.4.1 Inside dimensions of elevator cars and clear width of elevator doors shall comply with Table 407.4.1.

 407.4.2 Floor surfaces in elevator cars shall comply with 302 and 303.  $\sim$  407.4.3 The clearance between the car platform sill and the edge of any hoistway landing shall be 1  $\hat{\mathsf{A}}'$ 4" maximum

407.4.4 Each car shall be equipped with a self-leveling feature.

 $\sim$  407.4.5 The level of illumination at the car controls, platform, car threshold and car landing shall be 5 foot candles minimum. ~ 407.4.6 Where provided, elevator car controls shall comply with 407.4.6.

and at least 6'-8" in nominal height. Where a pair of doors is provided, at least one leaf shall comply with clear width requirement.

407.4.7 Designations and indicators of car controls shall comply with 407.4.7.

~ 407.4.8 Audible and visible car position indicators shall be provided in elevator cars. 407.4.9 Emergency two-way communication systems shall comply with 308. Tactile symbols and characters shal be provided adjacent to the device.

a) ADA-ABA:804.3 In residential dwelling units required to comply with 809, at least one 30 inches (760 mm) wide minimum section 3. Per NFPA101:7.2.1.2.3.2, 101:7.1.5.1, and IBC 1008.1.1 A doorway in a means of egress shall provide at least 32" in clear width (consider installing 36" wide doors)

4. Per NFPA 101:7.2.1.3.1, 101:7.1.6.3, and IBC 1008.1.5 through 1008.1.7 The floor elevation shall not change by more than 1/2" from one side of a door to the other.

5. Per NFPA 101:7.2.1.5.10.2 and IBC 1008.1.9.4 through 1008.1.9.5 Doors shall be openable with ONLY one releasing operation. A two-step release, such as a knob and an independent slide bolt, is NOT acceptable, except under special conditions.

6. Per NFPA 101:7.2.1.5 and IBC 1008.1.9 Locks on doors in means of egress shall not require the use of a key, special device or special knowledge to open in the 7. Per NFPA 101:30.2.2.2 Special locking arrangements shall comply with all the provisions of NFPA 101 Section 7.2.1.6.1 or 7.2.1.6.2. Signage shall comply with

ADA-ABA 216. 8. Per NFPA 101:30.2.2.2 Access-controlled egress doors shall comply with all the provisions of NFPA 101:7.2.1.6.2. Signage shall comply with ADA-ABA 216

9. Per NFPA 101:24.2.4.4 Every closet door latch shall be such that it can be opened from the inside.

10. Per NFPA 101:24.2.4.5 Bathroom door locks shall permit unlocking from outside in an emergency.

11. Per NFPA 101:24.2.4.6 No door in any means of escape shall be locked against egress when the building is occupied.

12. Per NFPA 101:7.2.2.4.4.5 Provide a minimum clearance of 2-1/4" between the handrails and the walls or guards to which they are attached. See notes marked on drawing sheet A7.1.

13. Per NFPA 101:30.2.9 and IBC 1006 Provide emergency lighting according to 101:7.9 and IBC 1006.3.

14. Per NFPA 101:30.2.8 and IBC 1006 Provide illumination of means of egress in accordance with 101:7.8 and IBC 1006.

15. Per NFPA 101:30.2.10 and IBC 1011 Exit signs complying with 101:7.10 and IBC 1011 shall define exits and access to exits where the exit is not immediately

16. Per LAC 55:305 Insulation and insulation assemblies shall meet the requirements of Section 720, International Building Code, 2015 Edition. ~ Concealed and exposed insulation shall have a flame spread of 0-25 and a smoke developed of 0-450 in accordance with IBC 720.

Cellulose fiber thermal insulation shall meet the applicable requirements of IBC 720. Foam plastic insulation shall meet the applicable requirements of IBC 720 and 2603.

Thermal barriers shall protect foam plastic insulation in accordance with IBC 2603.4.

~ Thermal barriers are not required if ignition barriers complying with IBC 2603.4.1.6 protect foam plastic insulation used in attics or crawl spaces, where entry is made only for service of utilities.

17. Per LRS 40:1711 Provide safety glazing in hazardous locations.

local fire department). The two-way communication system shall:

~ be in accordance with ADA-ABA 207 and 216.

18. Per NFPA 101:30.3.3 Interior walls and ceilings shall have a flame spread of 0-200 except in EXITS AND CORRIDORS which shall have a flame spread of 0-75 and a smoke development rating of 0-450.

19. Per NFPA 101:30.3.3 Interior floor finish in corridors and exits shall be Class I or II in accordance with Section 10.2.7.

20. Per NFPA 101:8.2.2.3 Fire compartments shall be formed with fire barriers that comply with Section 8.3 and are continuous in accordance with Section 8.3.1.2 from outside wall to outside wall or from one fire barrier to another, or a combination thereof, including continuity from the floor through all concealed spaces, such as those found above a ceiling, including interstitial spaces. Continuity is permitted to terminate at a ceiling, if the construction assembly of the ceiling has a fire resistance rating not less than that of the fire barrier.

21. Per NFPA 101:8.3.5 Penetrations through rated construction shall be sealed by approved firestop systems or devices tested in accordance with ASTM E-814 or

22. Per NFPA 101:30.3.6 and IBC 1018.1 Separate corridors from use areas with minimum 1-hour construction and self-closing 20 minute labeled opening protection. Wall construction shall be in accordance with 101:8.3 for fire barriers.

23. Per NFPA 101:30.3.4.5.1 and IBC 907.2.11.2 Approved single-station smoke alarms powered by the house electrical service shall be installed in accordance with NFPA 101:9.6.2.10 and the IBC outside every sleeping area in the immediate vicinity of the bedrooms at every living unit and on all levels of the dwelling unit, including basements. (101:9.6.3.6 requires audible and visual alarms in accessible units). (See IM 2016-01 for clarification on low frequency signal requirement). 24. Per NFPA 101:30.3.4.6 and IBC 908.7 Provide carbon monoxide alarms or carbon monoxide detectors in accordance with these sections and NFPA 720 at

facilities classified as Group I or R 25. Per NFPA 101:7.10.1.3, IBC 1007.9 and IBC 1022.9 Provide tactile signage at each exit stair enclosure door complying with ICC/ANSI A117.1 (2009), mounted adjacent to the latch side of the door 60 inches above the finished floor to the centerline of the sign.

26. Per NFPA 101:9.4.3.1 New elevators shall conform to the Fire Fighter's Service Requirements of ASME A17.1/CSA B44, Safety Code for Elevators and Escalators. Elevator recall shall be activated by smoke detection in each elevator lobby and in associated elevator machine rooms. 27. Per NFPA 101:7.2.12.1.1 and IBC 1007.8 Provide two-way communication between the elevator landing(s) and a central point (located in coordination with the

include directions for the use of the two-way communication system ~ instructions for summoning assistance via the two-way communication system  $\sim$  written identification of the location shall be posted adjacent to the two-way communication system.

SIDE REACH FORWARD REACH (KNEE CLEARANC 48" x 56" clear floor space req'd (front access) space req'd (side optional cont. grab bar TYPICAL ACCESSIBLE CODE REQUIRED TOILET CLEARANCES. 30" clear -30"x48" clear ACCESSIBLE URINAL CODE REQUIRED CLEARANCES where door has closer and latch BASIC DOOR APPROACH CODE REQUIRED CLEARANCES wall lantern ctr above frame raised & braille floor level designation elevator call buttons ELEVATOR CALL BUTTONS NOTES: . PROVIDE LUMINOUS EGRESS PATH MARKINGS PER IBC 1025.1 IN ALL ENCLOSED STAIRWELLS

**ADAAG** 

THE ADA/ABA ACCESSIBILITY GUIDELINES, JULY 23, 2004 (2010 STANDARDS) STANDARD MOUNTING HEIGHTS 30" x 48" clear SCALE: 1/4" = 1'-0" DRINKING FOUNTAINS AND WATER COOLERS 4 ADA POLE MOUNTED PARKING SIGN NOTE: EQUIPMENT PERMITTED IN SHADED AREA 30"x48" clea space reg'd. op holder with shelf 30" x 48" clea floor space mop sink TYPICAL SINK CODE REQUIRED TYPICAL HANDICAPPED ACCESSIBLE LAVATORY AND MIRROL **CLEARANCES** TYPICAL JANITOR CLOSET. OT WATER AND DRAIN PIPES TO BE COVERED OR INSULATED O PROTECT AGAINST CONTACT. 3'-0"max. 3'-6" 2'-9" holder TYPICAL TOILET TYPICAL PATIENT ACCESSIBLE HANDICAPPED TOILET '-6"@sidewal door pull PAPER TOWEL FLECTRIC HAND CABINET BASE UNIT/WAL CLOCK TYPICAL URINAL MOUNTING CHALK BOARD, TACK BOARD OR FIRE VALVE CABINET FIRE EXTINGUISHER AND FIRE EXTINGUISHER DRY ERASE BOARD visual signa  $\square$   $\rightarrow$ duplex outlet MISCELLANEOUS DEVICES COAT HOOKS

ACCESSIBLE CLEARANCE DIAGRAMS

NOTE: PROVIDE ACCESS FOR PERSONS WITH DISABILITIES IN ACCORDANCE WITH

# **GENERAL NOTES:**

ENTRANCE PASSAGEWAY ON THE FIRST FLOOR)

. DIMENSIONS ARE TYPICAL UNLESS OTHERWISE NOTED ON PLANS. THE DIMENSIONS DO NOT NECESSARILY SHOW ALL THE DEVICES THAT ARE LOCATED

INTERIOR EXIT RAMPS, AND EXIT PASSAGEWAYS (WITH THE EXCEPTIOON OF THE CONDO

2. SCHEDULE SHOWN IS STANDARD TEMPLATE. ALL ITEMS MAY NOT BE PRESENT ON THIS

STANDARDS ABOVE, BRING TO THE ATTENTION OF THE ARCHITECT BEFORE INSTALLATION OF

PROJECT. IF AN ITEM IS PRESENT ON THIS PROJECT AND DOES NOT COMPLY WITH

2. PROVIDE SOLID BLOCKING BEHIND ALL WALL MOUNTED EQUIPMENT. 3. SEE THE PLANS FOR ALL ADDITIONAL TOILET ACCESSORIES AND ACTUAL ROOM

4. STAIRWAY DOORS, IF LOCKED FROM INSIDE, SHALL HAVE THE CAPABILITY TO BE UNLOCKED FROM FIRE

189 Maple Ridge Drive Metairie, LA 70001 (504)-885-4477 central@hbsaii.com :-: hbsaii.com

SINCE 1961

STREET, LOUISIANA 1031 CANAL NEW ORLEANS

CERTIFIED CORRECT


| 22 | 22 | 22 | 23 | 24 |

SUMMARY PROJECT#: 1709 PHASE DD TFAM· Author HFCKFR: Checker CALE: AS NOTEI

+ 2 8 4 5 9 7 8

BUILDING CODE

SSUED: 4/20/2018

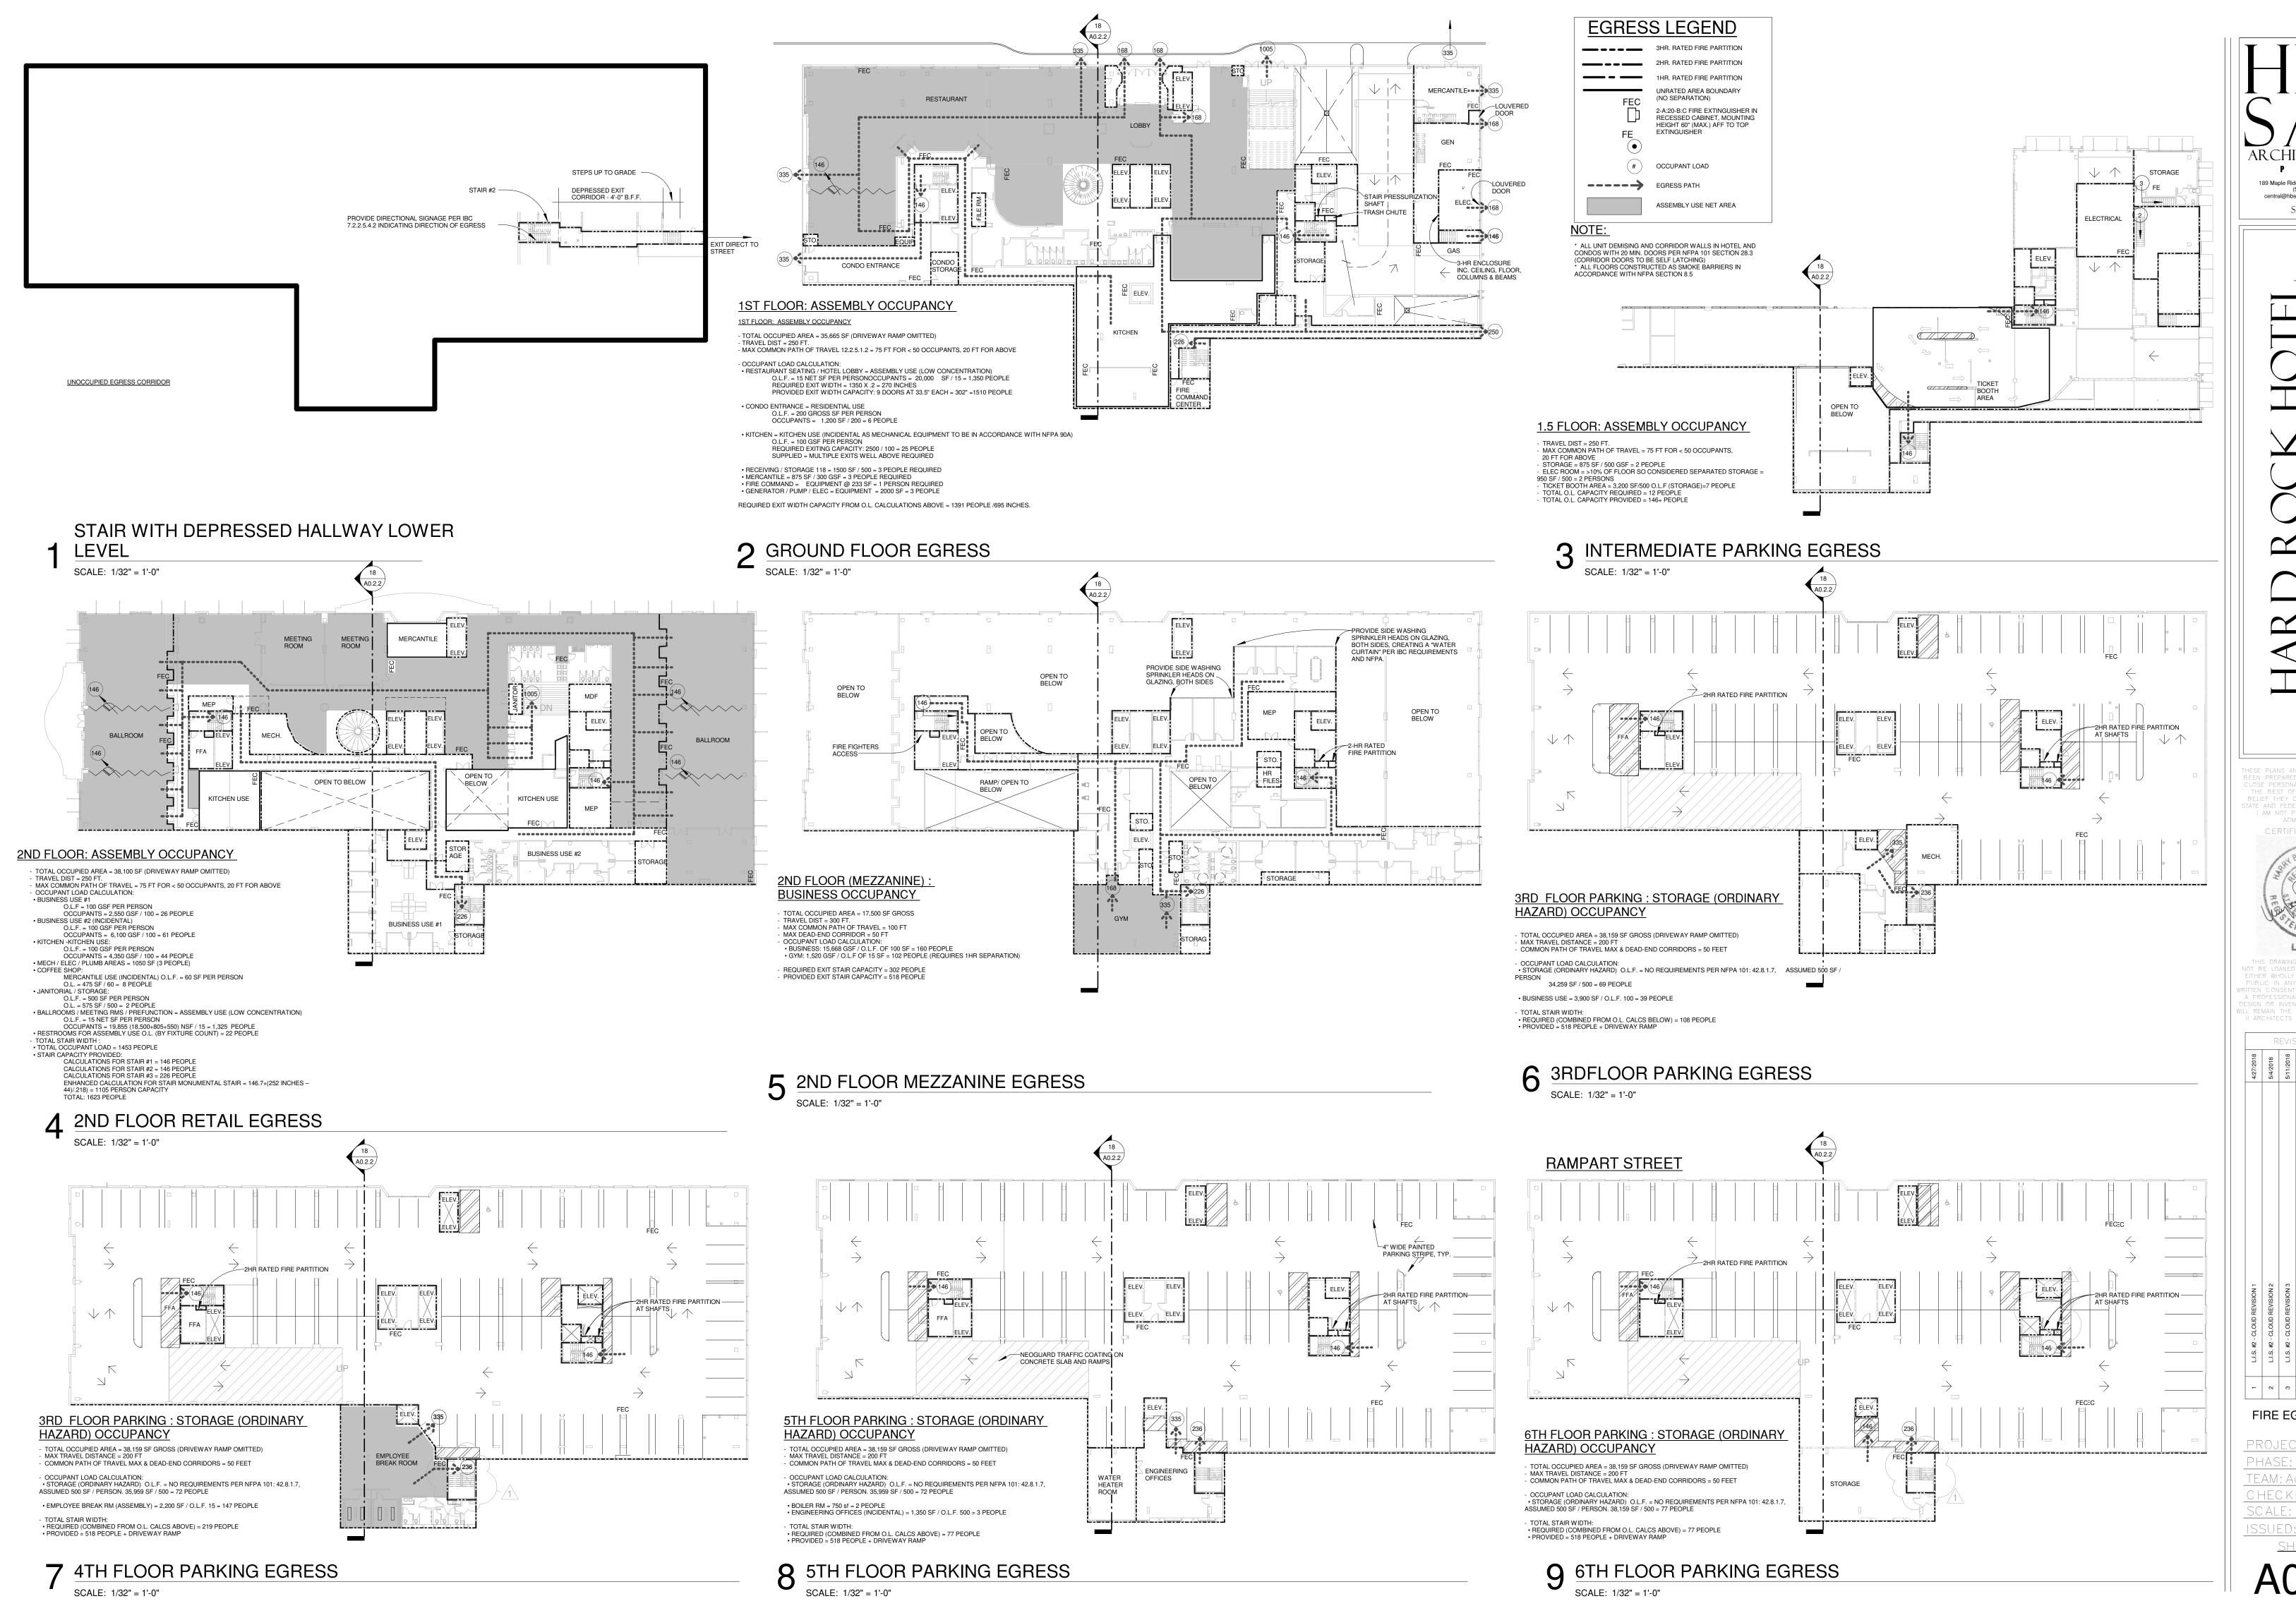

HARRY
BAKER
SMITH
SMITH
ARCHITECTS II
P L C

189 Maple Ridge Drive Metairie, LA 70001
(504)-885-4477
central@hbsaii.com :: hbsaii.com
SINCE 1961

STREET
COUSIANA

1031 CANAL STREE NEW ORLEANS, LOUISI

SE PLANS AND SPECIFICATIONS HAVE
EN PREPARED BY ME OR UNDER MY
OSE PERSONAL SUPERVISION AND TO
THE BEST OF MY KNOWLEDGE AND
ELIEF THEY COMPLY WITH ALL CITY,
TE AND FEDERAL REQUIREMENTS, AND
I AM NOT PROVIDING CONTRACT
ADMINISTRATION.

CERTIFIED CORRECT



THIS DRAWING IS CONFIDENTIAL AND
NOT BE LOANED, REPRODUCED, COPIED,
EITHER WHOLLY OR IN PART, OR MADE
PUBLIC IN ANY MANNER WITHOUT THE
WRITTEN CONSENT OF HBSA II ARCHITECTS,
A PROFESSIONAL LL.C. ALL RIGHTS OF
DESIGN OR INVENTION ARE RESERVED AND

L.I.S. #2 - CLOUD REVISION 1

L.I.S. #2 - CLOUD REVISION 2

L.I.S. #2 - CLOUD REVISION 3

L.I.S. #2 - CLOUD REVISION 4

L.I.S. #2 - CLOUD REVISION 5

L.I.S. #2 - CLOUD REVISION 6

L.I.S. #2 - CLOUD REVISION 6

L.I.S. #2 - CLOUD REVISION 7


L.I.S. #2 - CLOUD REVISION 7

FIRE EGRESS PLAN


PROJECT#: 1709
PHASE: DD
TEAM: Author
CHECKER: Checker
SCALE: AS NOTED
SSUED: 4/20/2018

40.2.1

# 107TH FLOOR PARKING EGRESS SCALE: 1/32" = 1'-0"

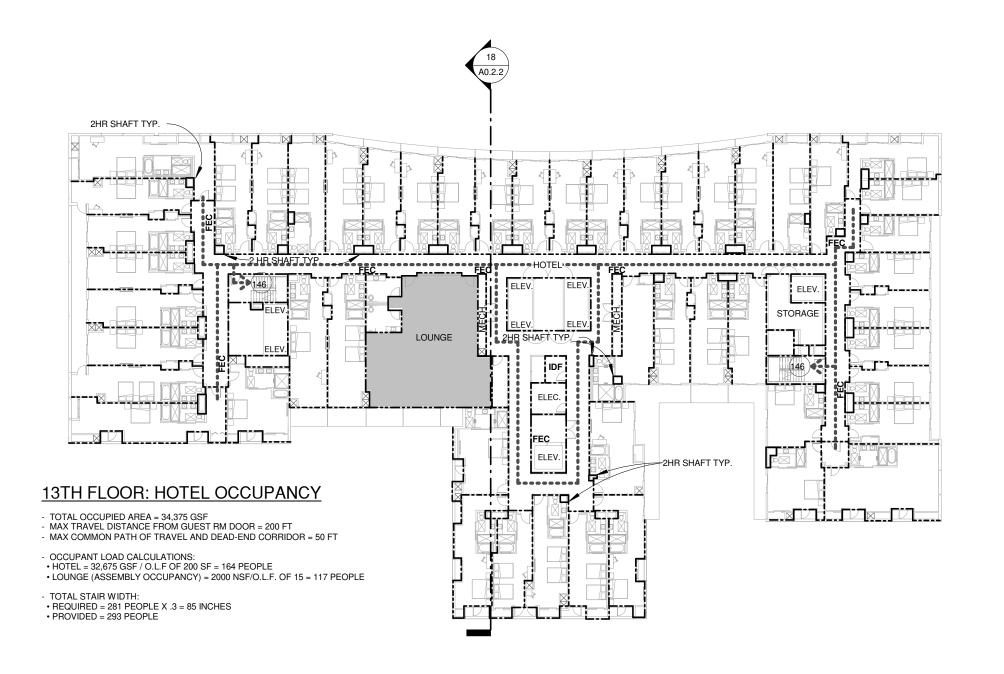


# 13TH FLOOR EGRESS SCALE: 1/32" = 1'-0"

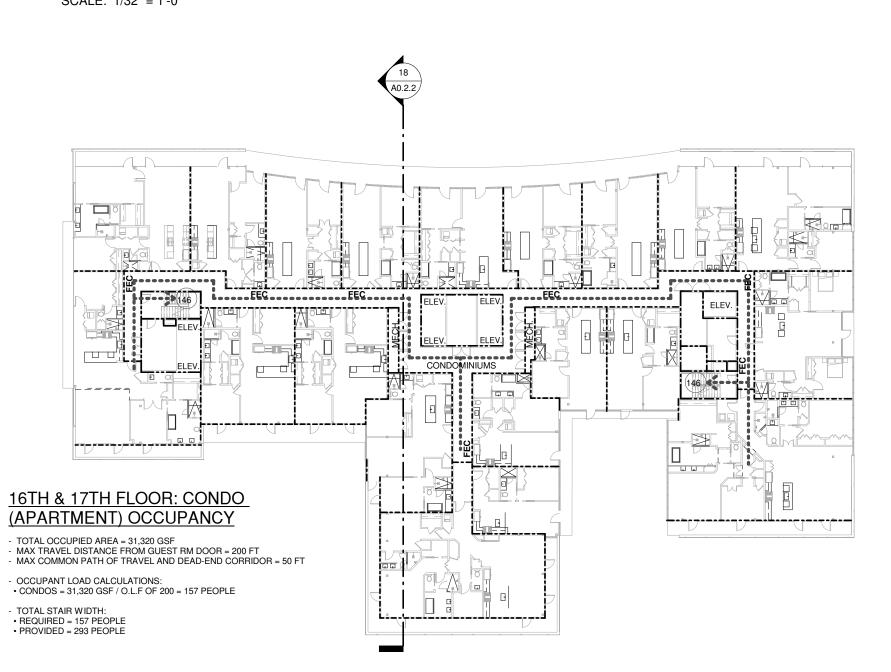


16TH-17TH FLOOR EGRESS

SCALE: 1/32" = 1'-0"

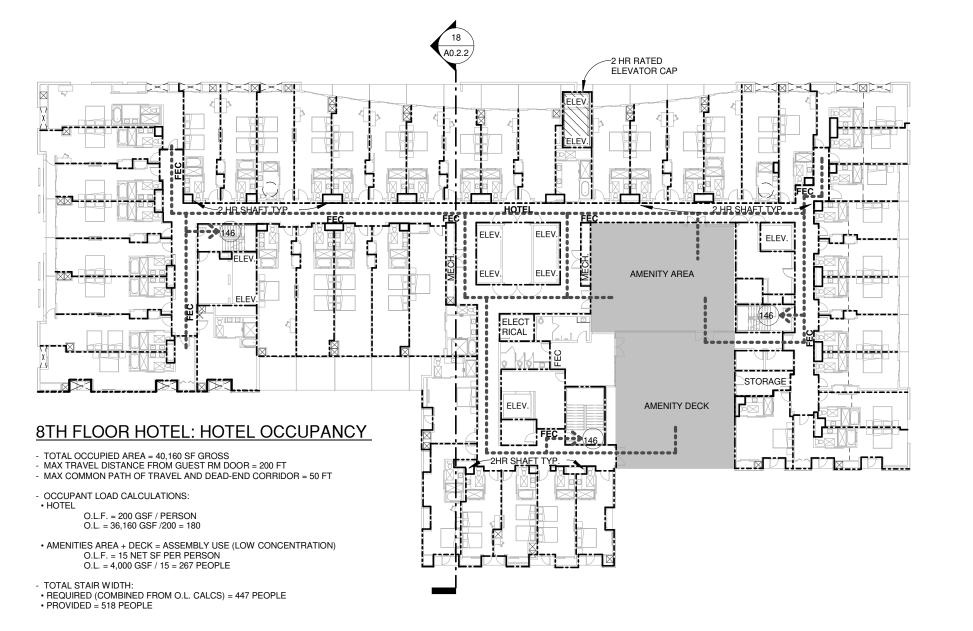


# **1 1** 8TH FLOOR EGRESS

SCALE: 1/32" = 1'-0"

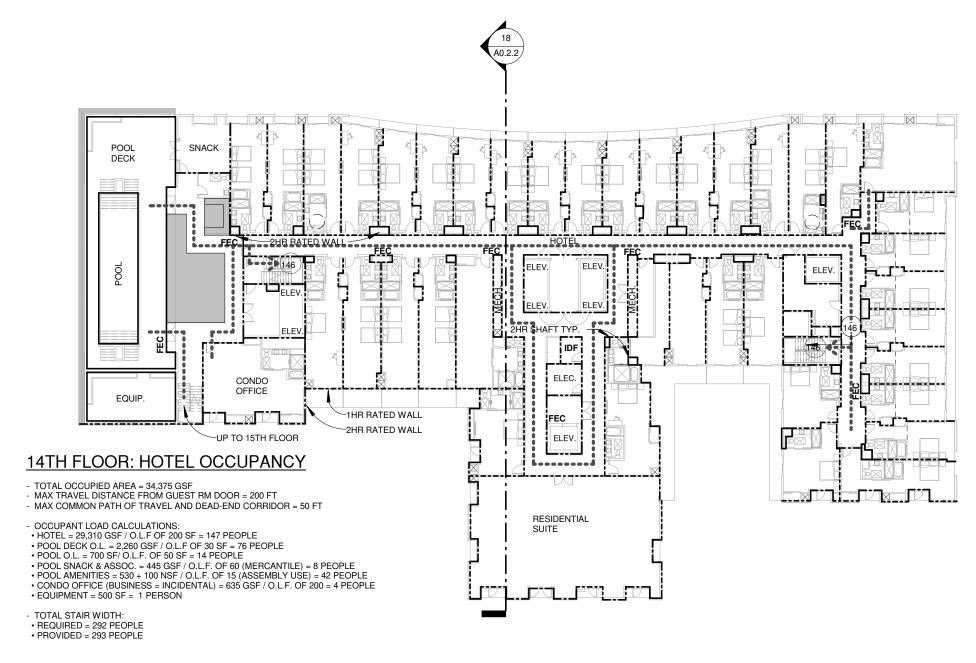


141H FLOOR EGRESS

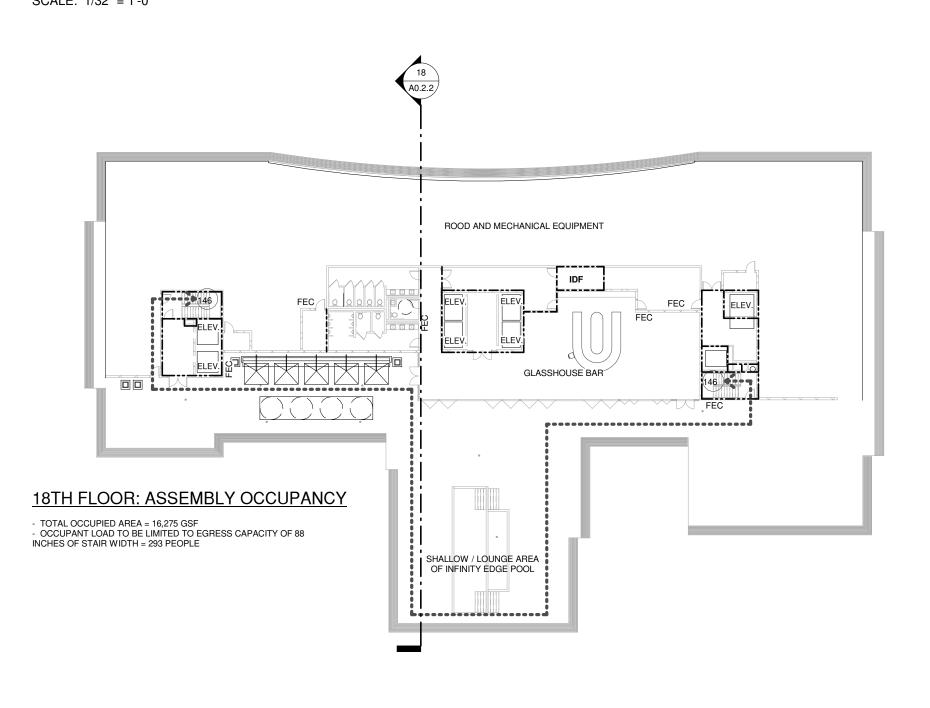


17 18TH FLOOR ROOF DECK EGRESS


SCALE: 1/32" = 1'-0"

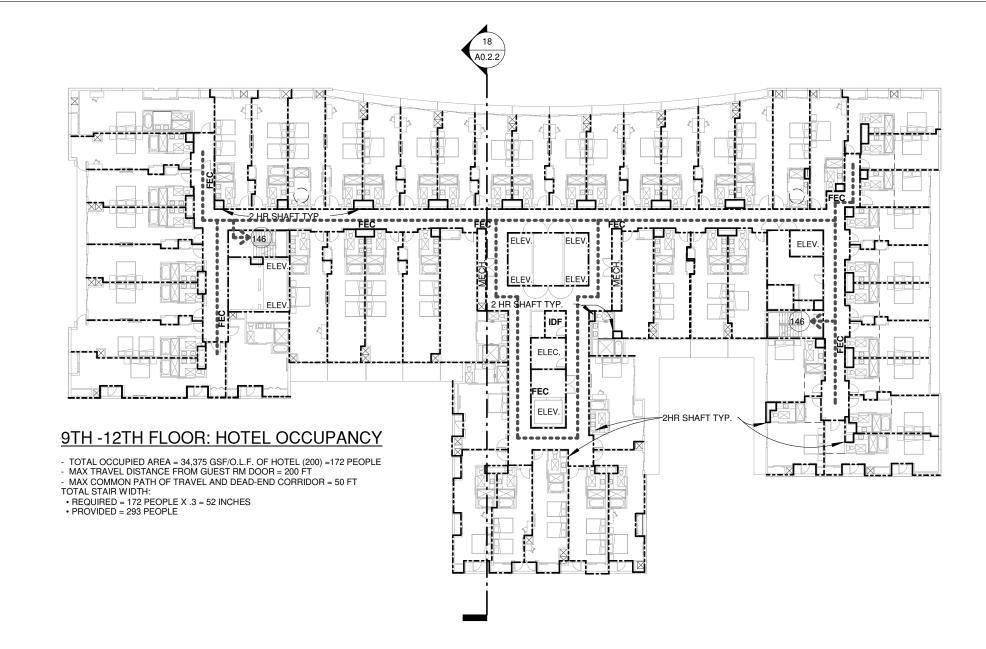

# 129TH-12TH FLOOR EGRESS SCALE: 1/32" = 1'-0"

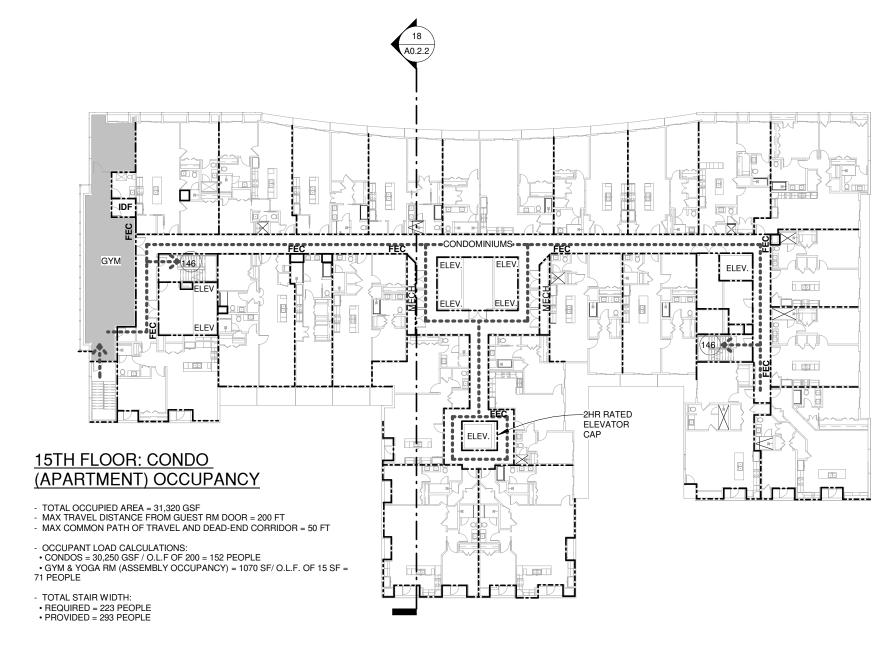

15 15 FIFTEENTH FLOOR CONDOS EGRESS

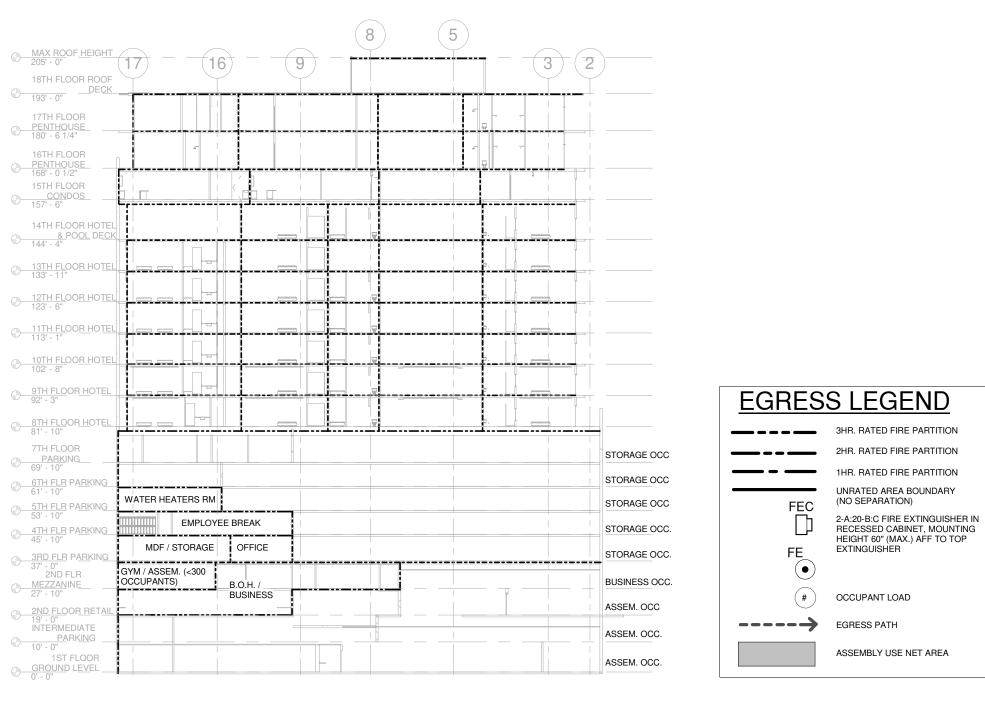

18 TRANSVERSE BUILDING SECTION EGRESS

SCALE: 1/32" = 1'-0" A0.2.1/ A0.2.2

HARRY
BAKER
SMITH
SMITH
ARCHITECTS II
P L C


189 Maple Ridge Drive Metairie, LA 70001
(504)-885-4477
central@hbsaii.com :: hbsaii.com
SINCE 1961

1031 CANAL STREET
NEW ORLEANS, LOUISIANA

THESE PLANS AND SPECIFICATIONS HAVE
BEEN PREPARED BY ME OR UNDER MY
CLOSE PERSONAL SUPERVISION AND TO
THE BEST OF MY KNOWLEDGE AND
BELIEF THEY COMPLY WITH ALL CITY,
STATE AND FEDERAL REQUIREMENTS, AND
I AM NOT PROVIDING CONTRACT
ADMINISTRATION.

CERTIFIED CORRECT

THIS DRAWING IS CONFIDENTIAL AND NOT BE LOANED, REPRODUCED, COPIED, EITHER WHOLLY OR IN PART, OR MADE PUBLIC IN ANY MANNER WITHOUT THE WRITEN CONSENT OF HBSA II ARCHITECTS, A PROFESSIONAL L.L.C. ALL RIGHTS OF

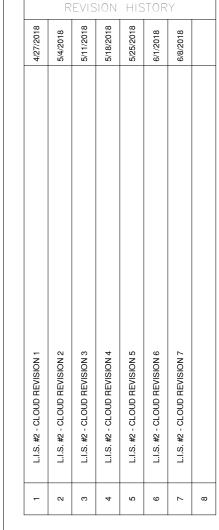

FIRE EGRESS PLAN


PROJECT#: 1709
PHASE: DD
TEAM: Author
CHECKER: Checker
SCALE: AS NOTED
ISSUED: 4/20/2018

A0.2.2

# HARD ROCK HOTEL 1031 CANAL STREET NEW ORLEANS, LOUISIANA

THESE PLANS AND SPECIFICATIONS HAVE BEEN PREPARED BY ME OR UNDER MY CLOSE PERSONAL SUPERVISION AND TO THE BEST OF MY KNOWLEDGE AND BELIEF THEY COMPLY WITH ALL CITY, STATE AND FEDERAL REQUIREMENTS, AND I AM NOT PROVIDING CONTRACT ADMINISTRATION.

CERTIFIED CORRECT

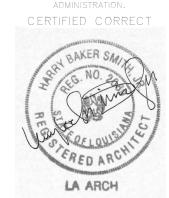

THIS DRAWING IS CONFIDENTIAL AND NOT BE LOANED, REPRODUCED, COPIED, EITHER WHOLLY OR IN PART, OR MADE PUBLIC IN ANY MANNER WITHOUT THE WRITTEN CONSENT OF HBSA II ARCHITECT A PROFESSIONAL L.L.C. ALL RIGHTS OF DESIGN OR INVENTION ARE RESERVED ANY WILL REMAIN THE SOLE PROPERTY OF HBS II ARCHITECTS A PROFESSIONAL L.L.C.


|  |                              | R                            | EVIS                         | ION                          | HIS                          | TOR                          | Υ                            |  |  |  |
|--|------------------------------|------------------------------|------------------------------|------------------------------|------------------------------|------------------------------|------------------------------|--|--|--|
|  | 4/27/2018                    | 5/4/2018                     | 5/11/2018                    | 5/18/2018                    | 5/25/2018                    | 6/1/2018                     | 6/8/2018                     |  |  |  |
|  | L.I.S. #2 - CLOUD REVISION 1 | L.I.S. #2 - CLOUD REVISION 2 | L.I.S. #2 - CLOUD REVISION 3 | L.I.S. #2 - CLOUD REVISION 4 | L.I.S. #2 - CLOUD REVISION 5 | L.I.S. #2 - CLOUD REVISION 6 | L.I.S. #2 - CLOUD REVISION 7 |  |  |  |

EGRESS AXON

PROJECT#: 1709
PHASE: DD
TEAM: Author
CHECKER: Checker
SCALE: AS NOTED
ISSUED: 4/20/2018

ISSUED: 4/20/2018
SHEET#:

A0.2.3

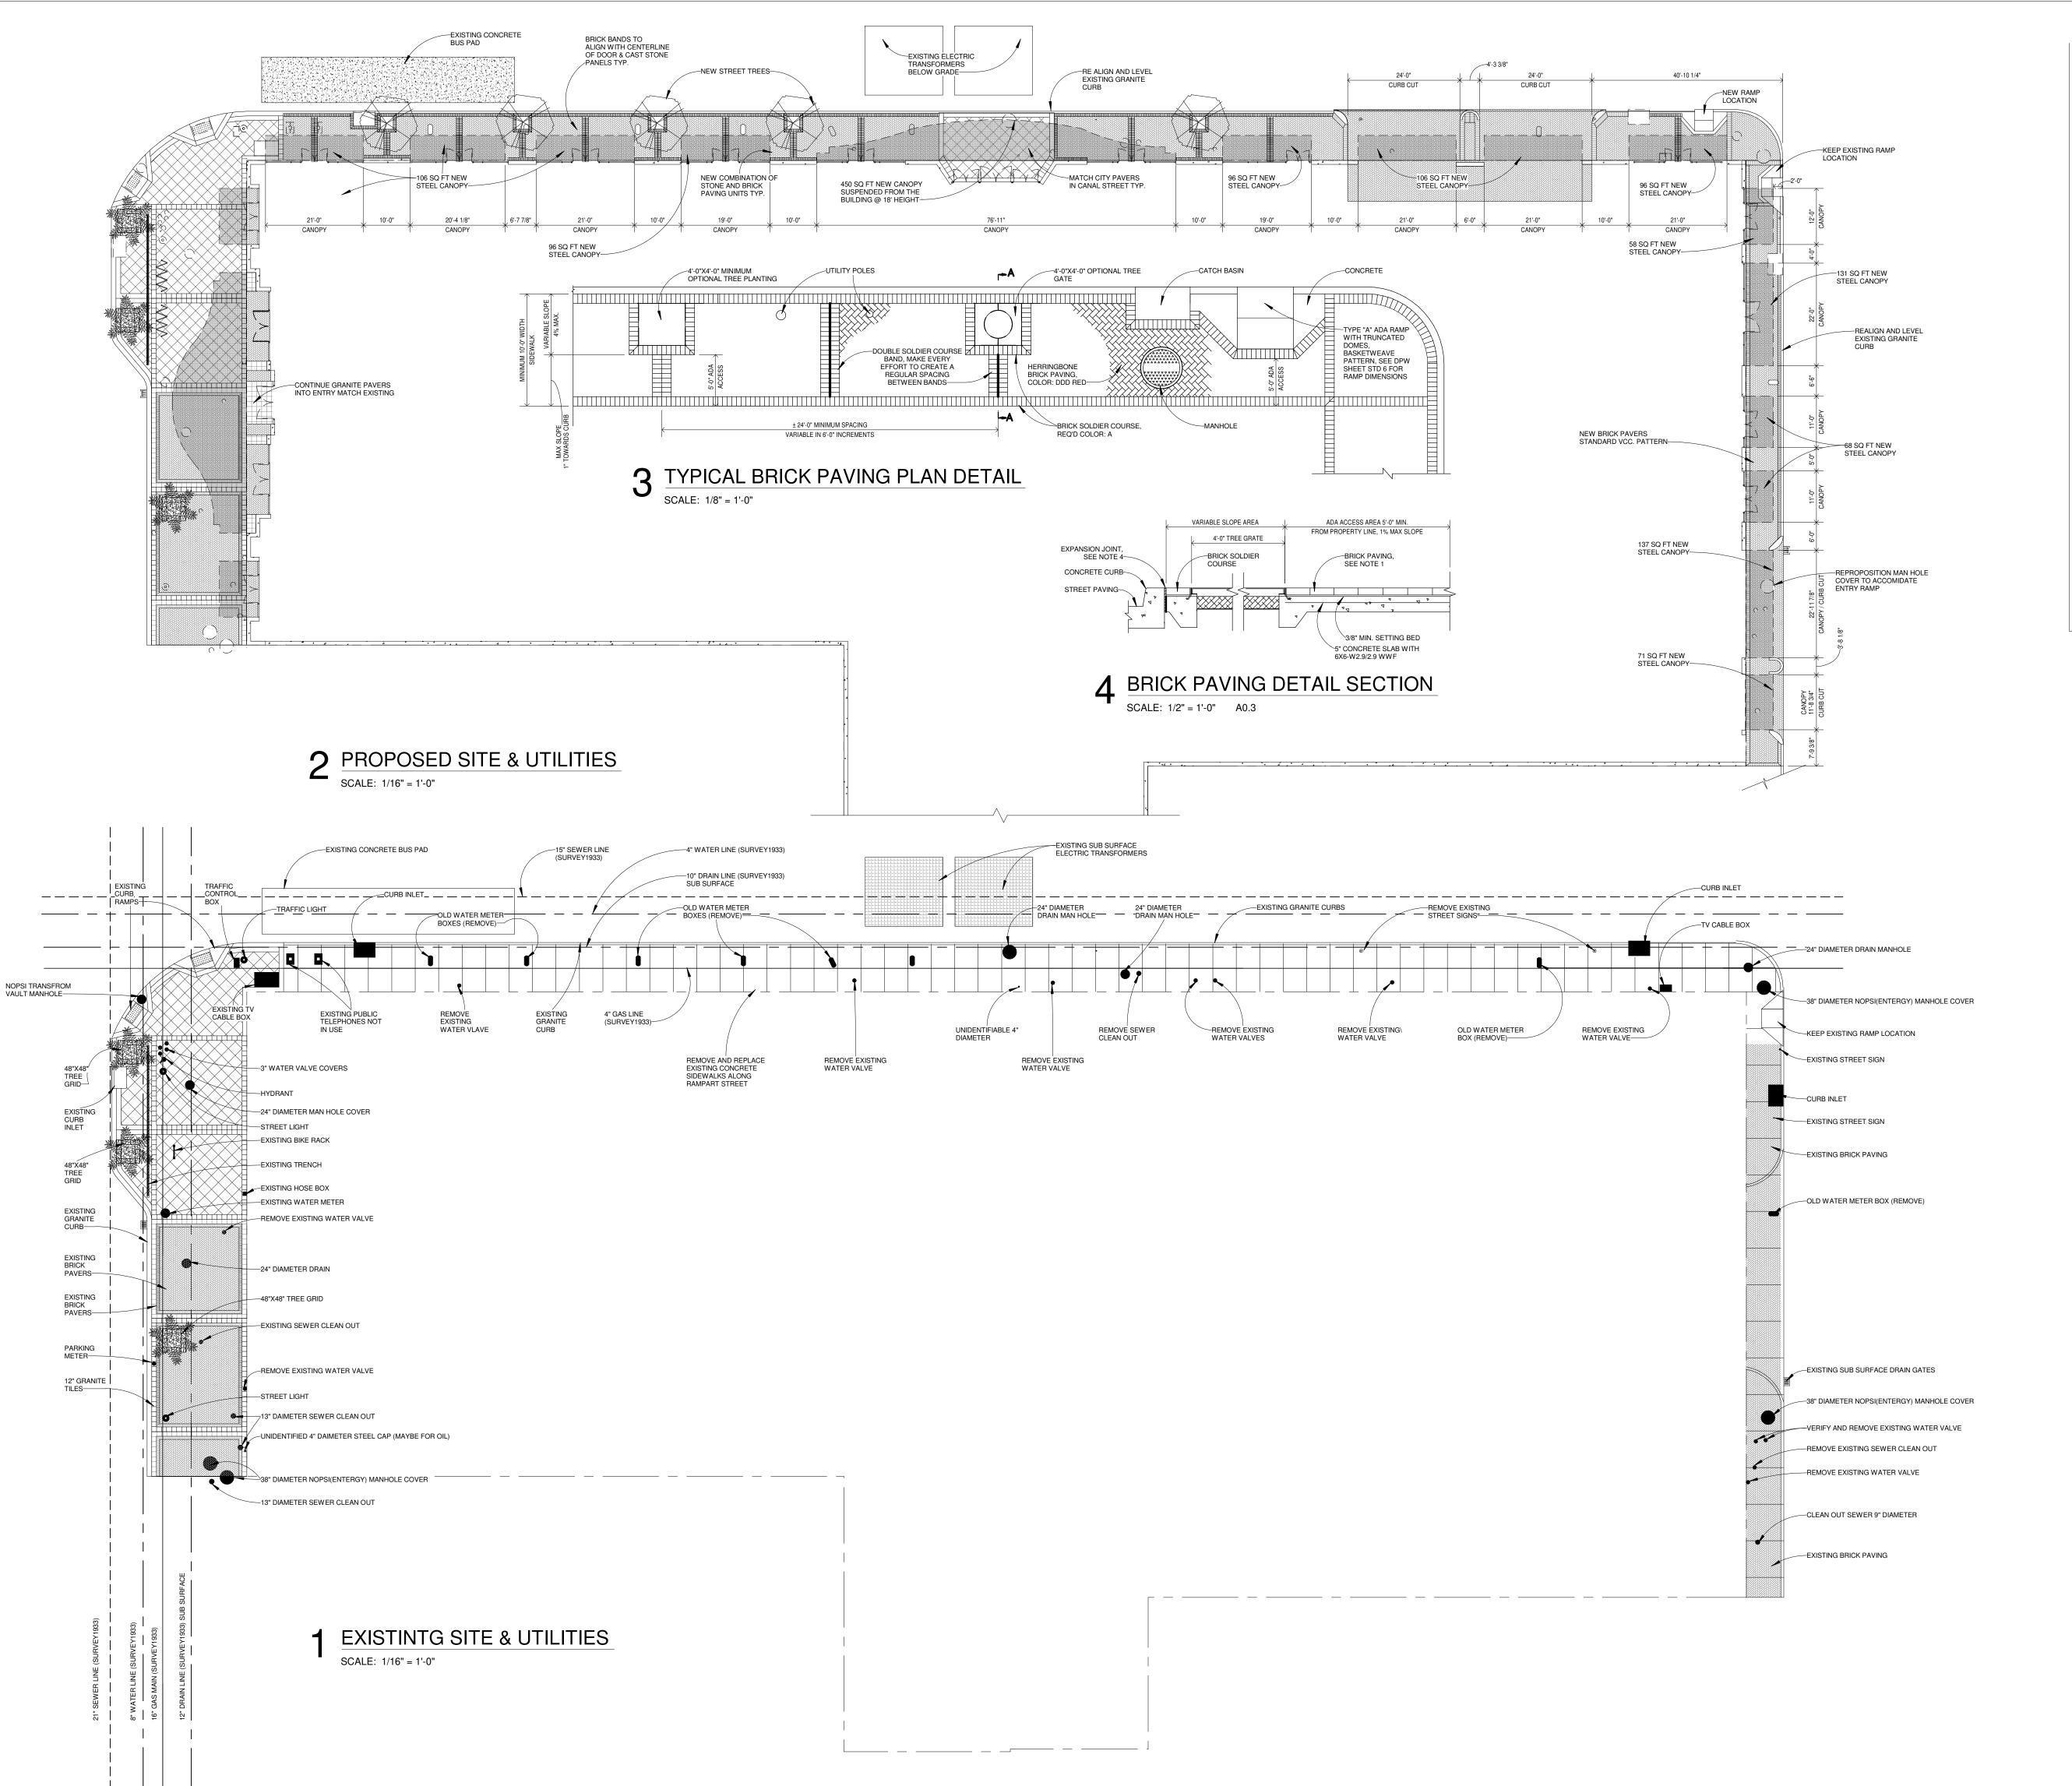

### **GENERAL NOTES:**

1. BRICK PAVING SHALL BE HERRINGBONE PATTERN. BRICKS SHALL BE HARD FIRED WITH A NON-SLIP FINISH. BRICKS USED SHALL HAVE A WIDTH THAT IS HALF OF ITS LENGTH AND LAYED WITH MORTARED JOINTS.

2. ALL CONCRETE SIDEWALKS ARE TO BE 5" AND SHALL RECEIVE BROOM FINISH 90° TO DIRECTION OF PEDESTRIAN TRAFFIC AND RECEIVE CONTROL JOINTS AS INDICATED.

3. EXPANSION JOINTS IN BRICK PAVING TO BE FULL DEPTH OF CONCRETE SLAB AND SETTING BED. TOP THICKNESS OF BRICK TO BE CAULKED WITH SILICONE FILLER TO MATCH COLOR OF BRICK AT EXPANSION JOINTS.

4. EXPANSION JOINTS IN CONCRETE PAVING TO BE 1/2" PREMOLDED BITUMINOUS COMPOSITION STRIPS. TOP 1/2" OF JOINT TO BE CAULKED WITH SILICONE FILLER, LIGHT GRAY IN COLOR, EXPANSION JOINT TO BE DEPTH OF

5. SIDEWALK TO DRAIN AWAY FROM BUILDINGS TOWARDS CURB WITH SUFFICIENT SLOPE TO CREATE POSITIVE DRAINAGE. 6. EITHER OF THE ACCESSIBLE RAMPS (TYPE 'A' OR 'B') SHOWN MAY BE USED,

DEPENDANT ON EXISTING CONDITIONS, UTILITIES AND OTHER RAMPS AT THE CORNER.

7. ALL HANDICAP RAMPS SHOULD INCLUDE DETECTABLE WARNING AND BE CONSTRUCTED IN ACCORDANCE WITH THE DEPARTMENT OF PUBLIC WORKS STANDARD PLAN AND THE LATEST ADA REQUIREMENTS.

8. DETECTABLE WARNINGS SHALL BE HARD FIRED CLAY BRICKS WITH TRUNCATED DOMES THAT VISUALLY CONTRAST IN COLOR WITH SURROUNDING AREA AS PER DDD STANDARDS.

9. IF REPAIRS MUST BE MADE CONTRACTOR TO REMOVE CONCRETE WITHIN CONTROL JOINT LINES TO MAINTAIN THE PATTERNING ON THE WALK. 10. STONE PAVING (AS SHOWN ON STD18) SHALL BE LAYED IN CONTINENTAL PAVING PATTERN. A MINIMUM OF THREE WIDTHS OF STONE, VARYING BY 4" IN

WIDTH REQUIRED. NO STONES OF THE SAME WIDTH ALLOWED SIDE BY SIDE. STONE SHALL BE A MINIMUM OF 1" THICKNESS AND HAVE A NON-SLIP FINISH. MORTAR JOINTS SHALL BE 1/4" TO 1/2" FLUSH WITH SURFACE. 11. PERMITS FROM THE DEPARTMENT OF PUBLIC WORKS ARE REQUIRED BEFORE ANY CONSTRUCTION STARTED ON THE CITY RIGHT OF WAYS. WORK ON SIDEWALKS AND STREETS SHALL BE PERFORMED IN ACCORDANCE WITH THE CITY STANDARD DRAWINGS (STD-1 THRU STD-15) AND GEN. SPECIFICATIONS (LATEST EDITION).

12. CURB CUT PERMIT AND RESTORATION OF EXISTING CURBS: THE CONTRACTOR (OR DEVELOPER) MUST APPLY FOR A CURB CUT PERMIT FOR ANY NEW DRIVEWAY OR CURB CUT ON CITY RIGHT OF WAY, AT THE TIME OF CONSTRUCTION, ANY CURB CUTS IN FRONT OF COMMERCIAL PROPERTIES THAT ARE WIDER THAN 24 FEET MUST BE RESTORED TO 24 FEET OR LESS. EXISTING CURB CUTS THAT ARE NOT USED FOR DRIVEWAYS MUST BE REMOVED AND THE CURB AREA RESTORED ACCORDING TO CITY STANDARD DWGS. & SPECIFICATIONS.

13. SERVICE CUT PERMIT: THE CONTRACTOR (OR DEVELOPER) MUST OBTAIN A SERVICE CUT PERMIT BEFORE ANY EXCAVATION IN THE CITY RIGHT OF WAYS
(SEE NOTE A ABOVE) AND NOTIFY THE DEPARTMENT OF PUBLIC WORKS MAINTENANCE DIVISION FOR UTILITY TIE-IN.

14. SIDEWALK AND ADA RAMPS: SIDEWALKS AND ADA RAMPS ARE TO BE IN COMPLIANCE WITH THE ADA FEDERAL REGULATIONS. THE CONTRACTOR (OR DEVELOPER) MUST COMPLETE SIDEWALK NOTIFICATION FORM WITH THE DEPARTMENT OF PUBLIC WORKS BEFORE THE CONSTRUCTION. PERMIT IS REQUIRED FOR TEMPORARY SIDEWALK CLOSURE DURING CONSTRUCTION.

189 Maple Ridge Drive Metairie, LA 70001 (504)-885-4477 central@hbsaii.com :-: hbsaii.com

SINCE 1961

STREET, LOUISIANA 1031 CANAL 8 NEW ORLEANS,

BEEN PREPARED BY ME OR UNDER MY CLOSE PERSONAL SUPERVISION AND THE BEST OF MY KNOWLEDGE AND CERTIFIED CORRECT



|                              | R                            | EVIS                         | SION                         | HIS                          | TOR                          | Υ                            |   |
|------------------------------|------------------------------|------------------------------|------------------------------|------------------------------|------------------------------|------------------------------|---|
| 4/27/2018                    | 5/4/2018                     | 5/11/2018                    | 5/18/2018                    | 5/25/2018                    | 6/1/2018                     | 6/8/2018                     |   |
| L.I.S. #2 - CLOUD REVISION 1 | L.I.S. #2 - CLOUD REVISION 2 | L.I.S. #2 - CLOUD REVISION 3 | L.I.S. #2 - CLOUD REVISION 4 | L.I.S. #2 - CLOUD REVISION 5 | L.I.S. #2 - CLOUD REVISION 6 | L.I.S. #2 - CLOUD REVISION 7 |   |
| -                            | 2                            | 3                            | 4                            | 2                            | 9                            | 7                            | 8 |

SITE & UTILITIES PLAN

PROJECT#: 1709 PHASE: DD TFAM: Author CHECKER: Checker SCALE: AS NOTED

ISSUED: 4/20/2018

) ROCK HOTEL

THESE PLANS AND SPECIFICATIONS HAV BEEN PREPARED BY ME OR UNDER MY CLOSE PERSONAL SUPERVISION AND TO THE BEST OF MY KNOWLEDGE AND BELIEF THEY COMPLY WITH ALL CITY, STATE AND FEDERAL REQUIREMENTS, AN I AM NOT PROVIDING CONTRACT ADMINISTRATION.

CERTIFIED CORRECT



THIS DRAWING IS CONFIDENTIAL AND NOT BE LOANED, REPRODUCED, COPIED, EITHER WHOLLY OR IN PART, OR MADE PUBLIC IN ANY MANNER WITHOUT THE WRITTEN CONSENT OF HBSA II ARCHITECTS, A PROFESSIONAL L.L.C. ALL RIGHTS OF DESIGN OR INVENTION ARE RESERVED AND WILL REMAIN THE SOLE PROPERTY OF HBSA II ARCHITECTS A PROFESSIONAL L.L.C.

|  |                              | R                            | EVIS                         | SION                         | HIS                          | TOR                          | Υ                            |   |
|--|------------------------------|------------------------------|------------------------------|------------------------------|------------------------------|------------------------------|------------------------------|---|
|  | 4/27/2018                    | 5/4/2018                     | 5/11/2018                    | 5/18/2018                    | 5/25/2018                    | 6/1/2018                     | 6/8/2018                     |   |
|  | L.I.S. #2 - CLOUD REVISION 1 | L.I.S. #2 - CLOUD REVISION 2 | L.I.S. #2 - CLOUD REVISION 3 | L.I.S. #2 - CLOUD REVISION 4 | L.I.S. #2 - CLOUD REVISION 5 | L.I.S. #2 - CLOUD REVISION 6 | L.I.S. #2 - CLOUD REVISION 7 |   |
|  | -                            | 2                            | က                            | 4                            | 2                            | 9                            | 7                            | 8 |

SITE LOGISTICS
PLAN-CONST. PHASE

PROJECT#: 1709
PHASE: DD


TEAM: Author


CHECKER: Checker


SCALE: AS NOTED

ISSUED: 4/20/2018

A0.5

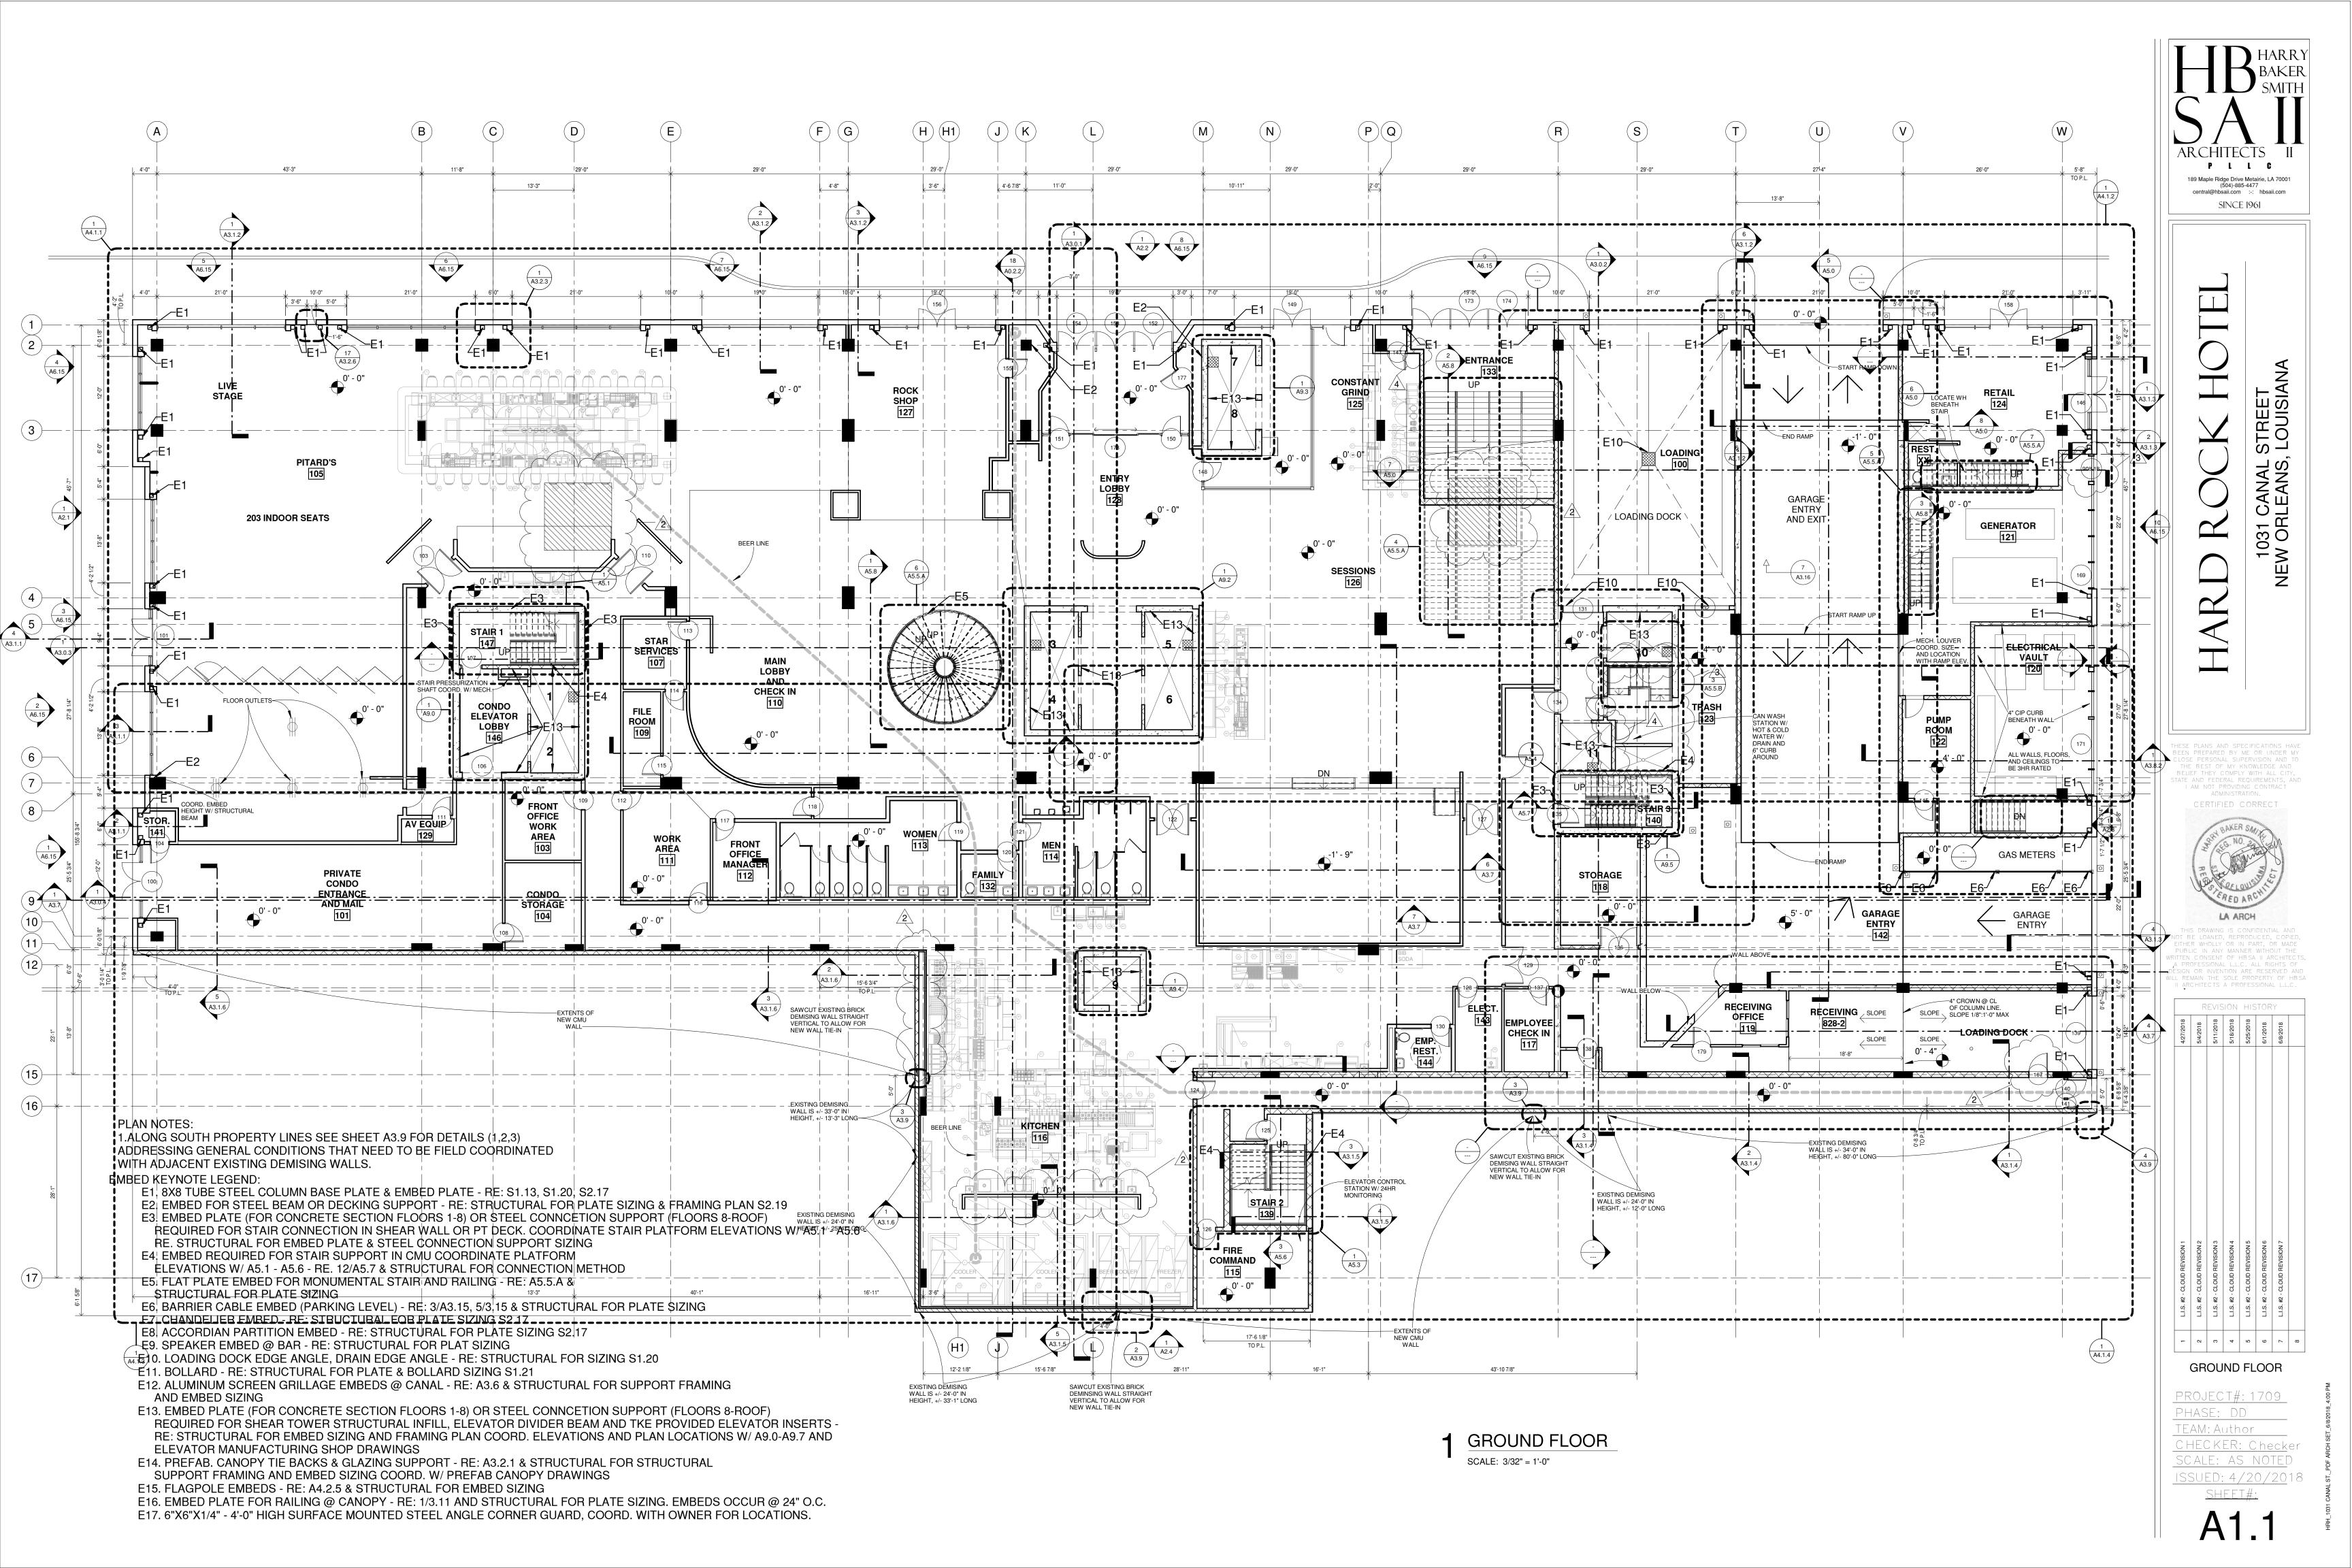

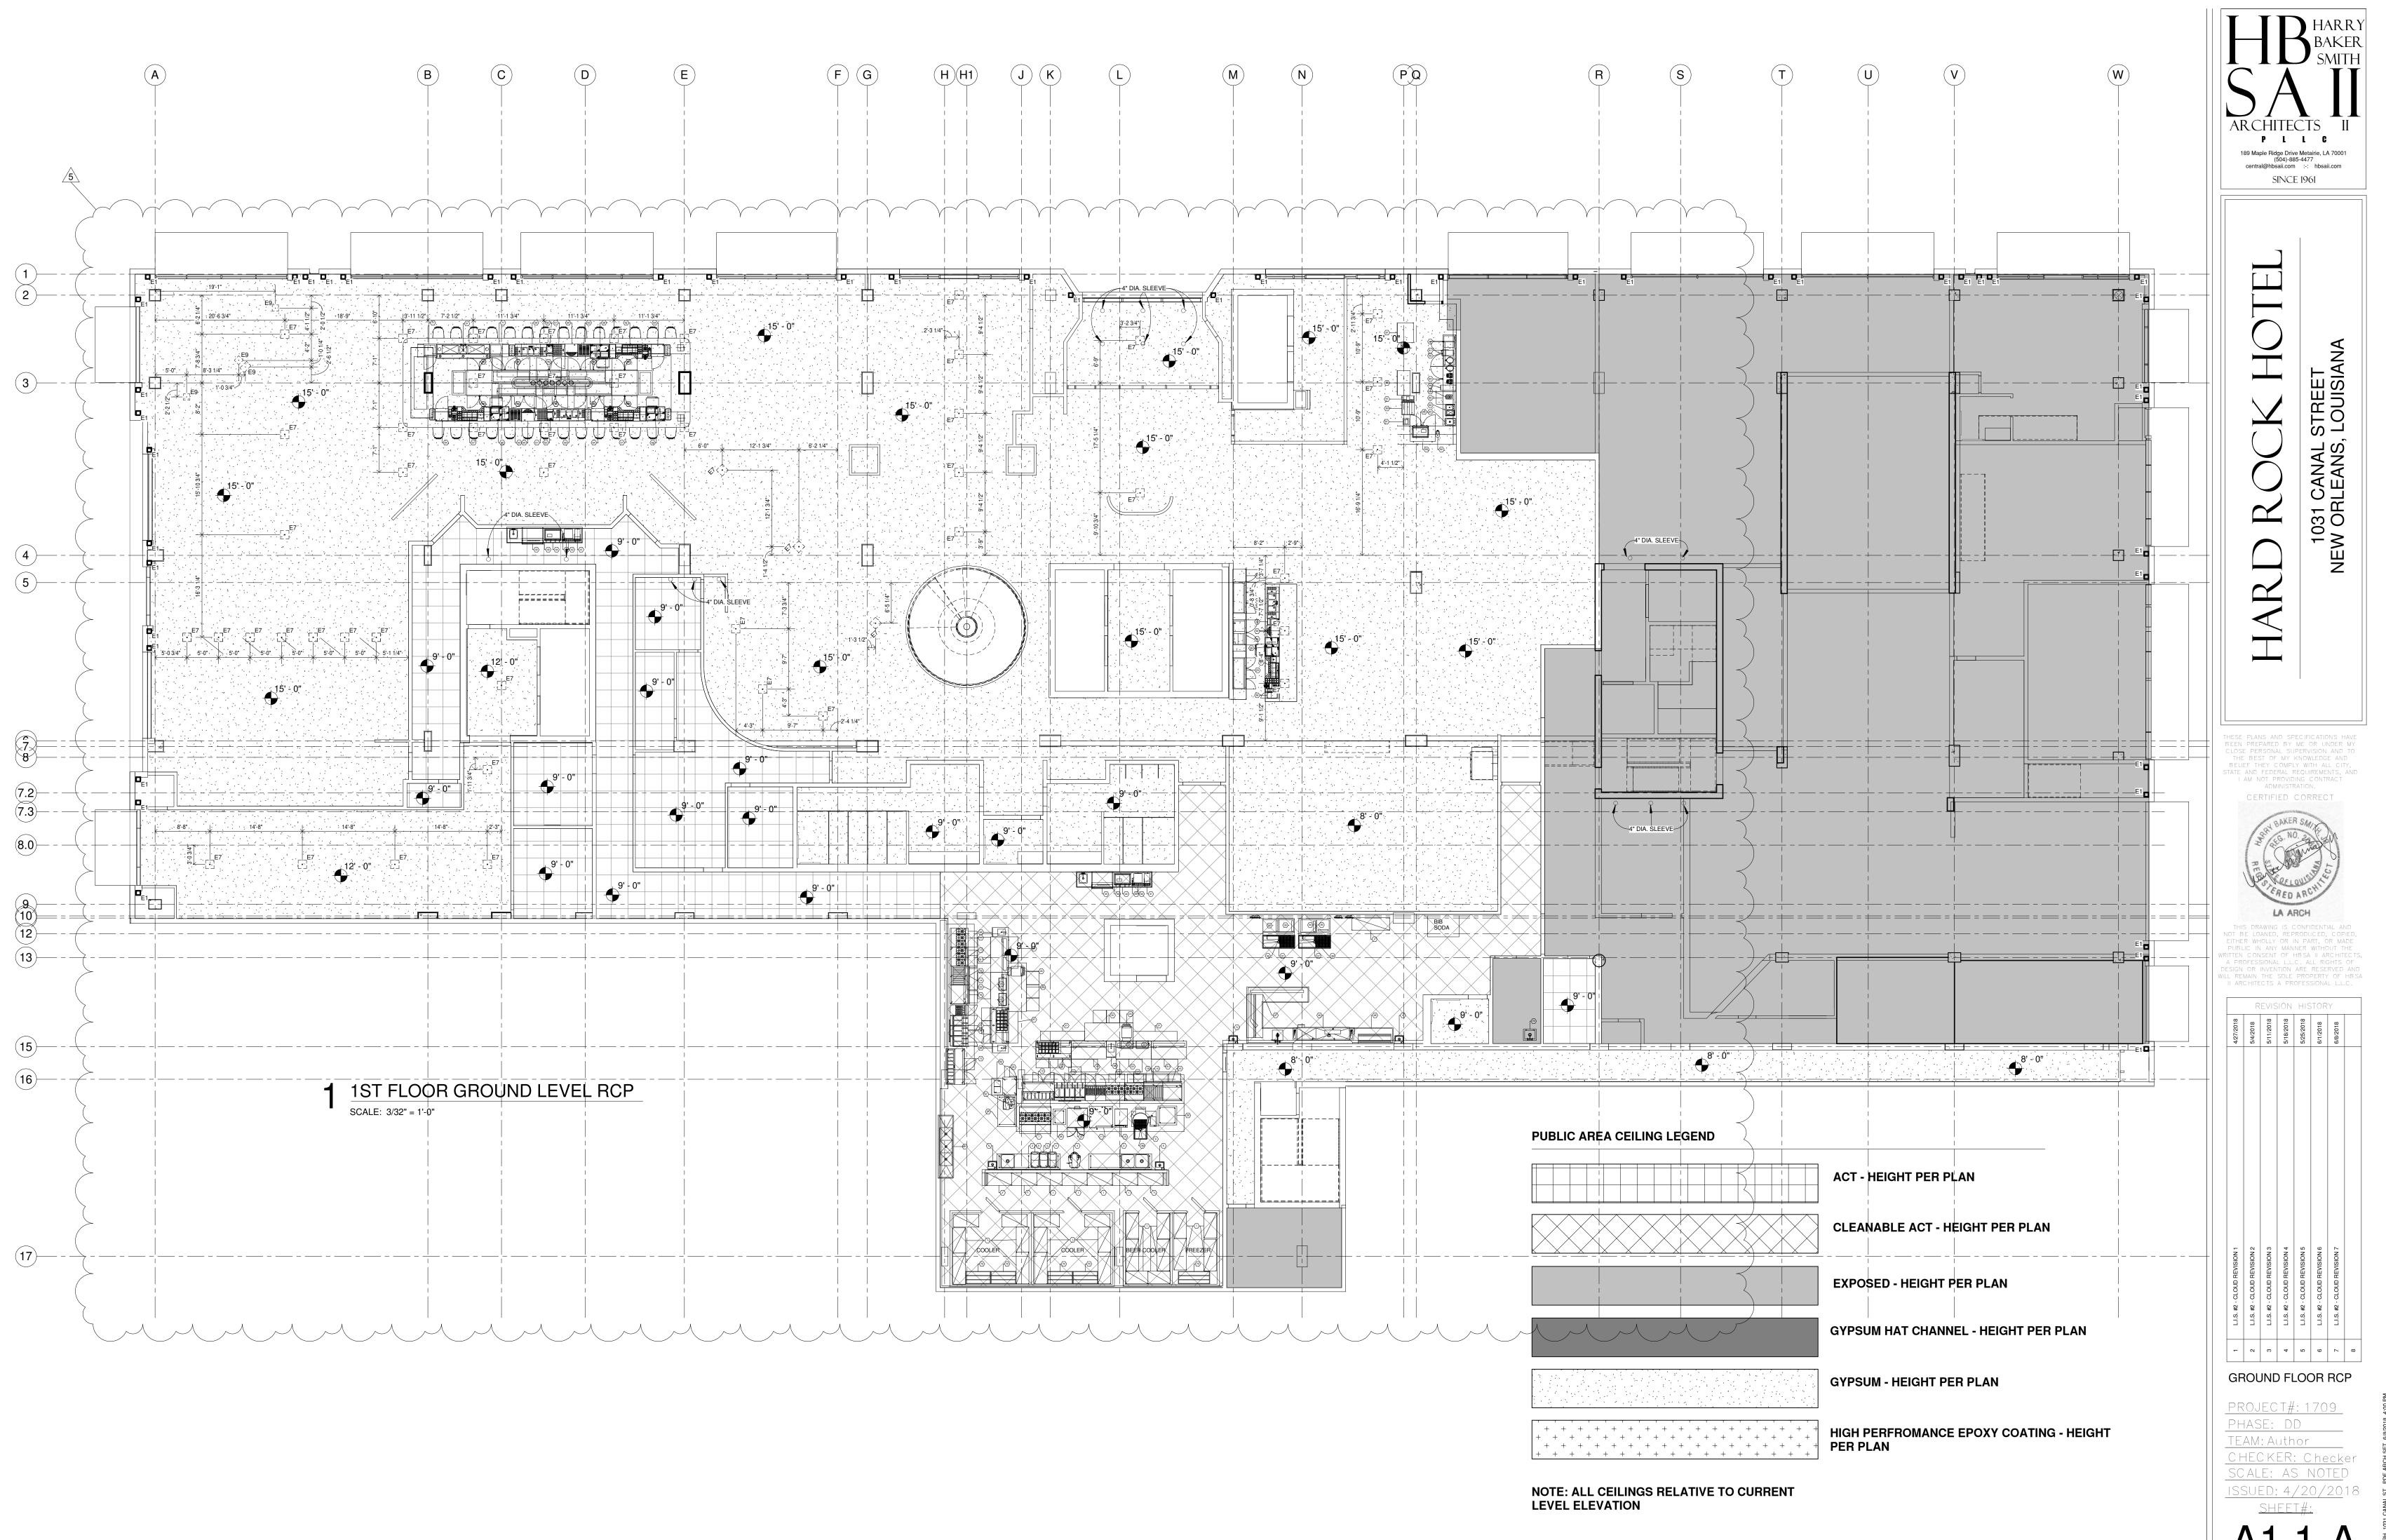

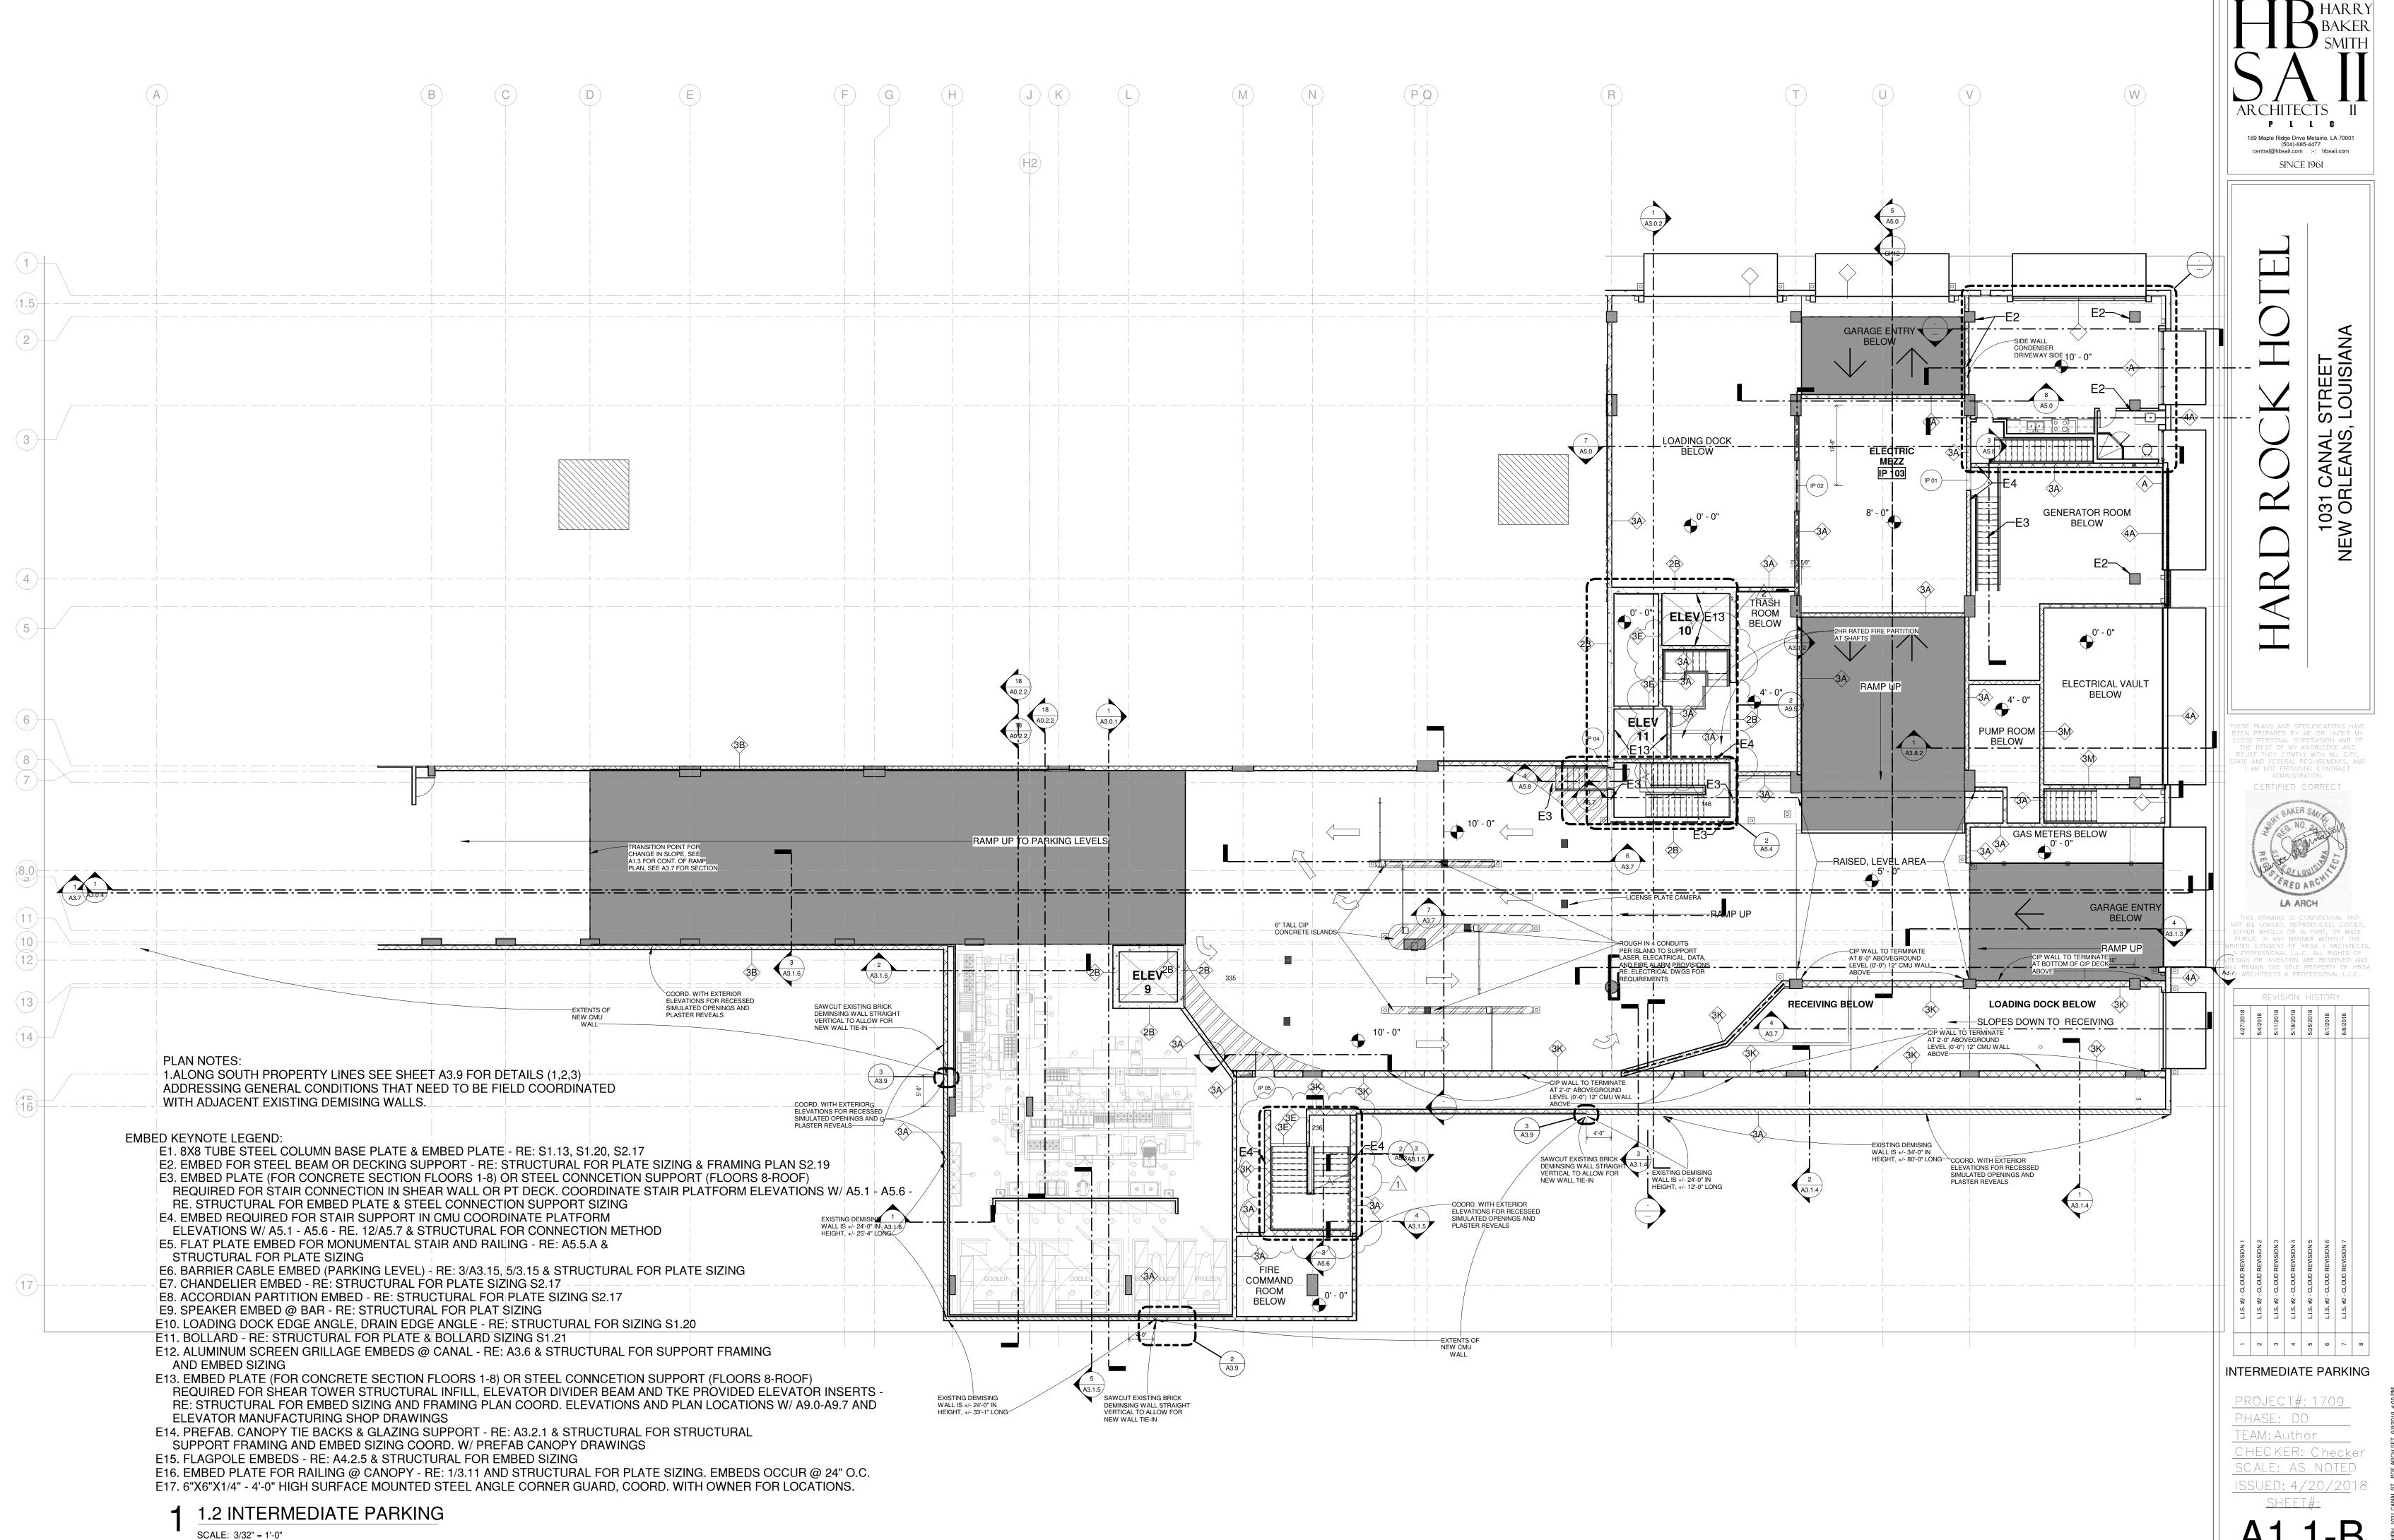

NOTE: ALL CEILINGS RELATIVE TO CURRENT LEVEL ELEVATION

HARRY
BAKER
SMITH
SMITH
ARCHITECTS II
P 1 C

189 Maple Ridge Drive Metairie, LA 70001
(504)-885-4477
central@hbsaii.com :: hbsaii.com
SINCE 1961

HARD ROCK HOTEL

THESE PLANS AND SPECIFICATIONS HAVE BEEN PREPARED BY ME OR UNDER MY CLOSE PERSONAL SUPERVISION AND TO THE BEST OF MY KNOWLEDGE AND BELIEF THEY COMPLY WITH ALL CITY, STATE AND FEDERAL REQUIREMENTS, AND I AM NOT PROVIDING CONTRACT ADMINISTRATION.

CERTIFIED CORRECT




THIS DRAWING IS CONFIDENTIAL AND NOT BE LOANED, REPRODUCED, COPIED, EITHER WHOLLY OR IN PART, OR MADE PUBLIC IN ANY MANNER WITHOUT THE WRITTEN CONSENT OF HBSA II ARCHITECTS, A PROFESSIONAL L.L.C. ALL RIGHTS OF DESIGN OR INVENTION ARE RESERVED AND WILL REMAIN THE SOLE PROPERTY OF HBSA


| REVISION HISTORY             |                              |                              |                              |                              |                              |                              |     |  |  |  |
|------------------------------|------------------------------|------------------------------|------------------------------|------------------------------|------------------------------|------------------------------|-----|--|--|--|
| 4/27/2018                    | 5/4/2018                     | 5/11/2018                    | 5/18/2018                    | 5/25/2018                    | 6/1/2018                     | 6/8/2018                     |     |  |  |  |
| L.I.S. #2 - CLOUD REVISION 1 | L.I.S. #2 - CLOUD REVISION 2 | L.I.S. #2 - CLOUD REVISION 3 | L.I.S. #2 - CLOUD REVISION 4 | L.I.S. #2 - CLOUD REVISION 5 | L.I.S. #2 - CLOUD REVISION 6 | L.I.S. #2 - CLOUD REVISION 7 |     |  |  |  |
| _                            | 8                            | က                            | 4                            | 2                            | 9                            |                              | _ & |  |  |  |


INTERMEDIATE PARKING RCP
PROJECT#: 1709

PROJECT#: 1709
PHASE: DD
TEAM: Author
CHECKER: Checker
SCALE: AS NOTED
ISSUED: 4/20/2018

A1.1-C

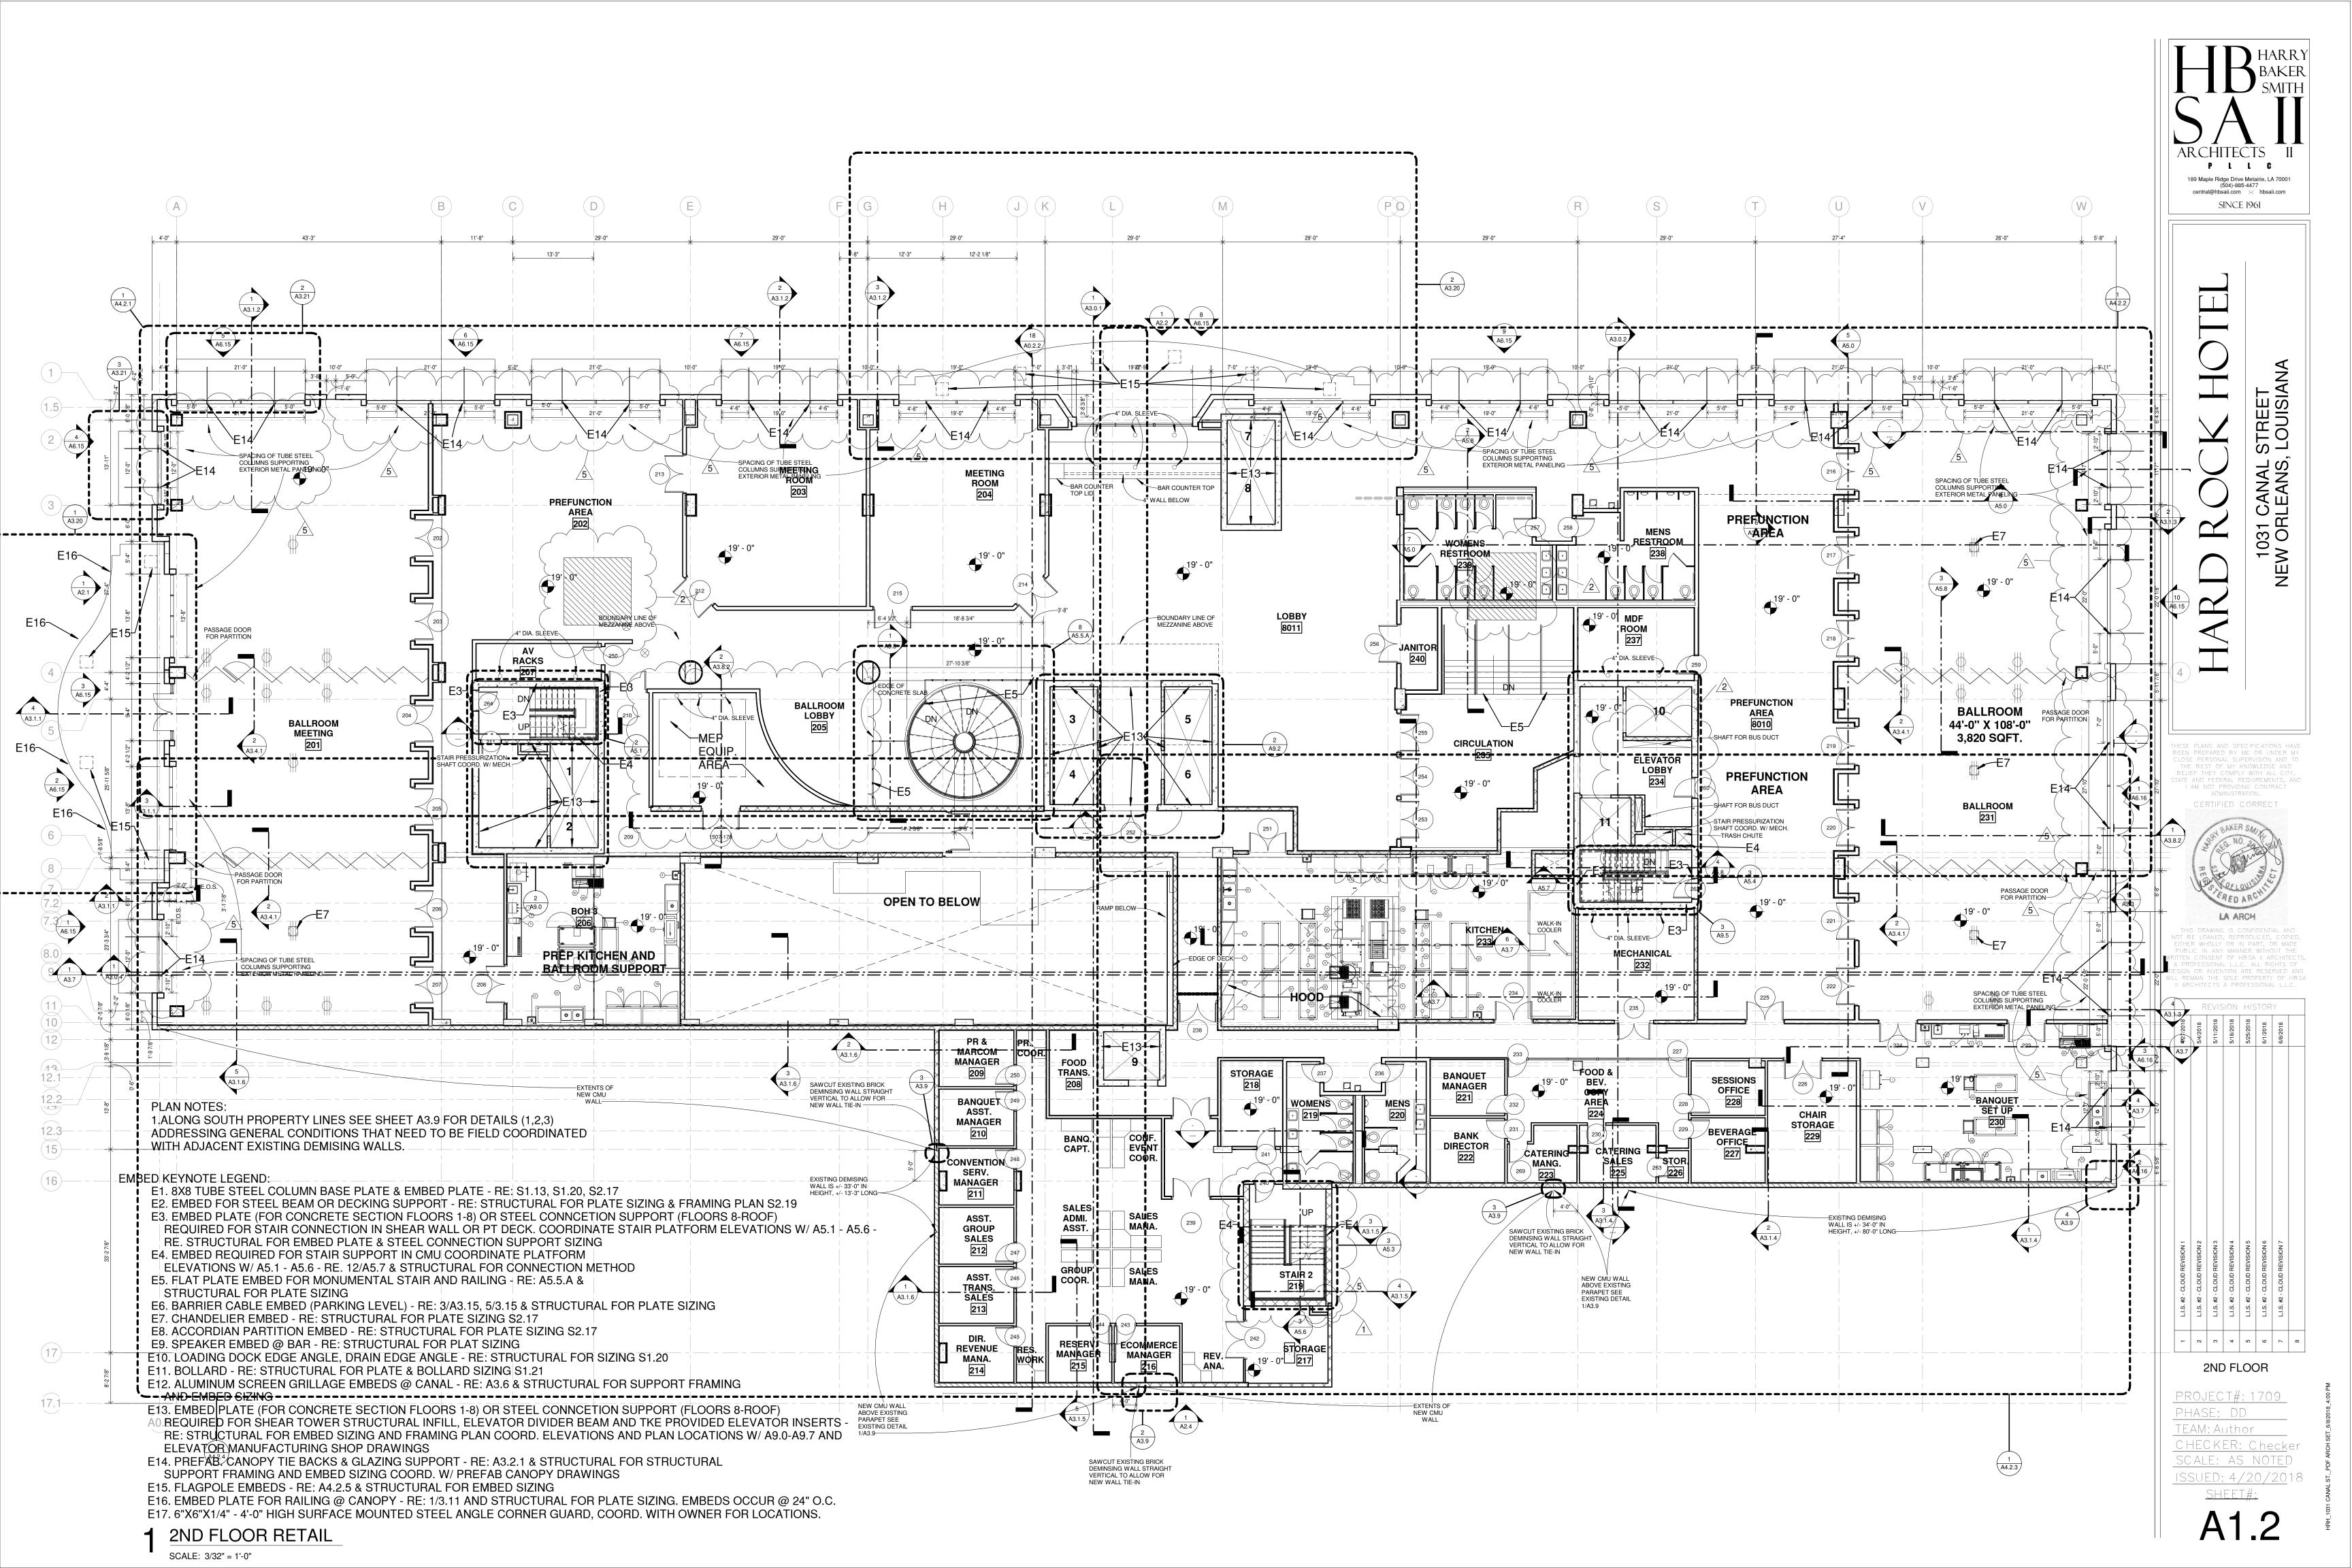

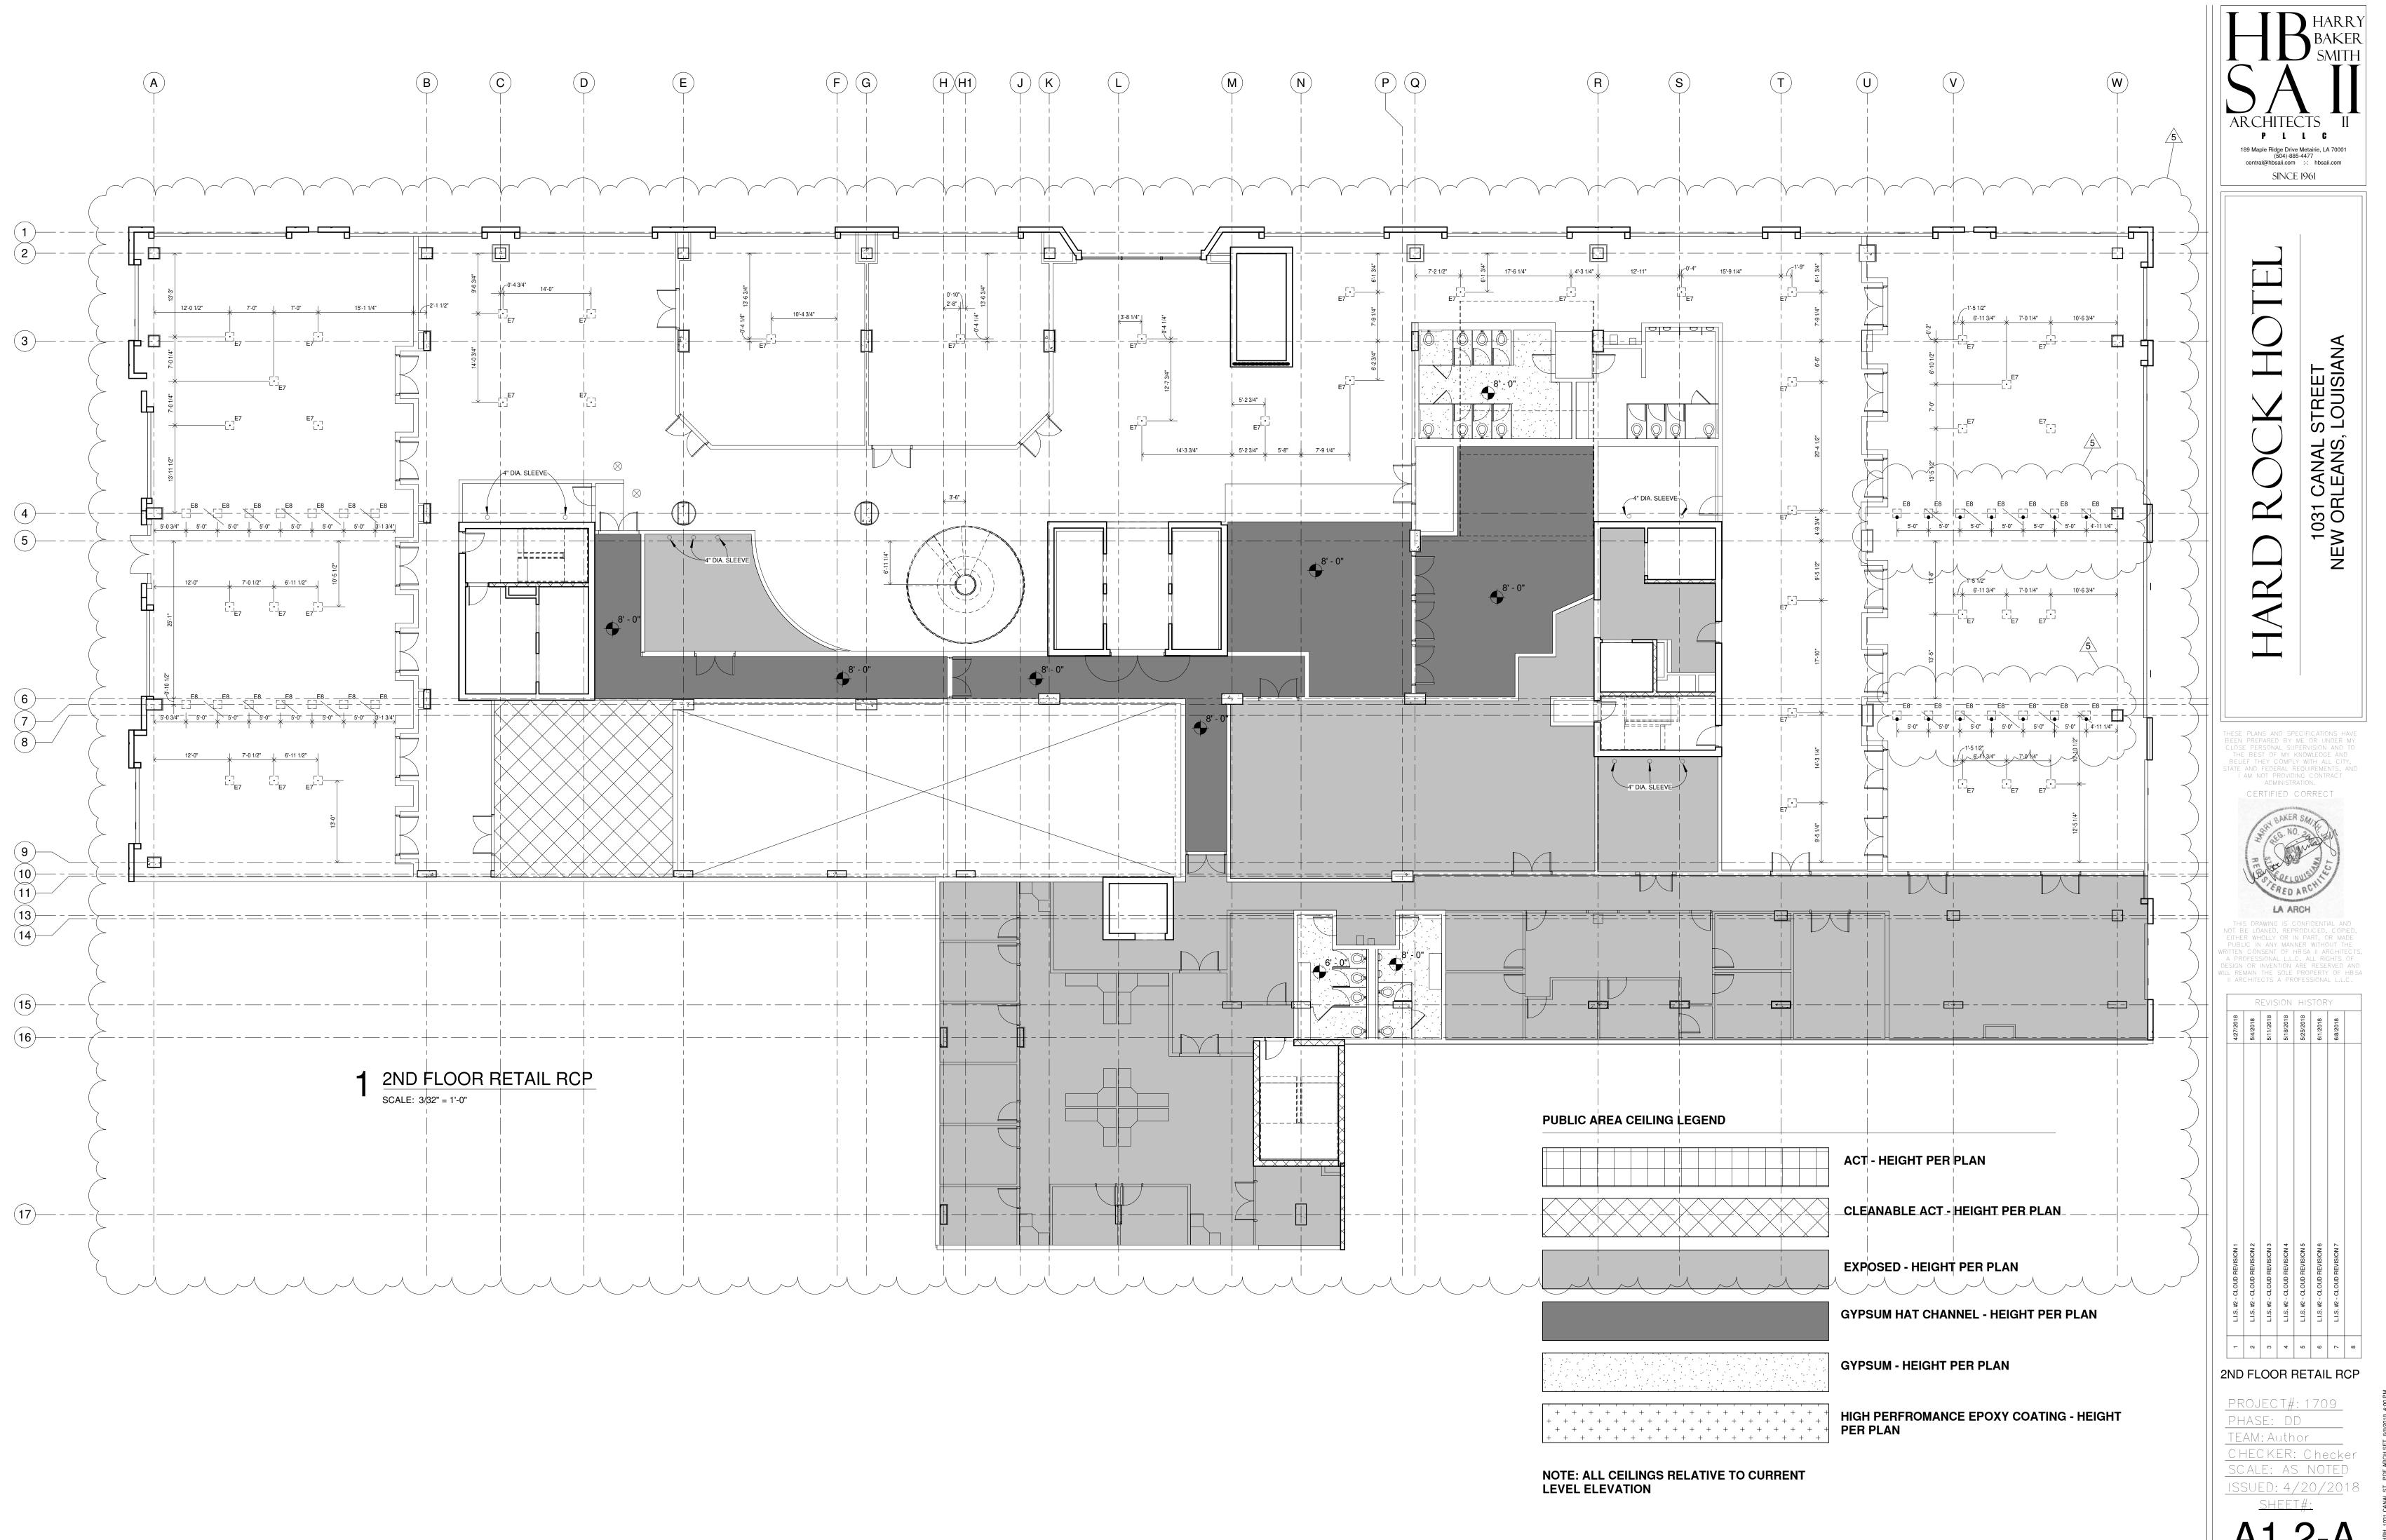

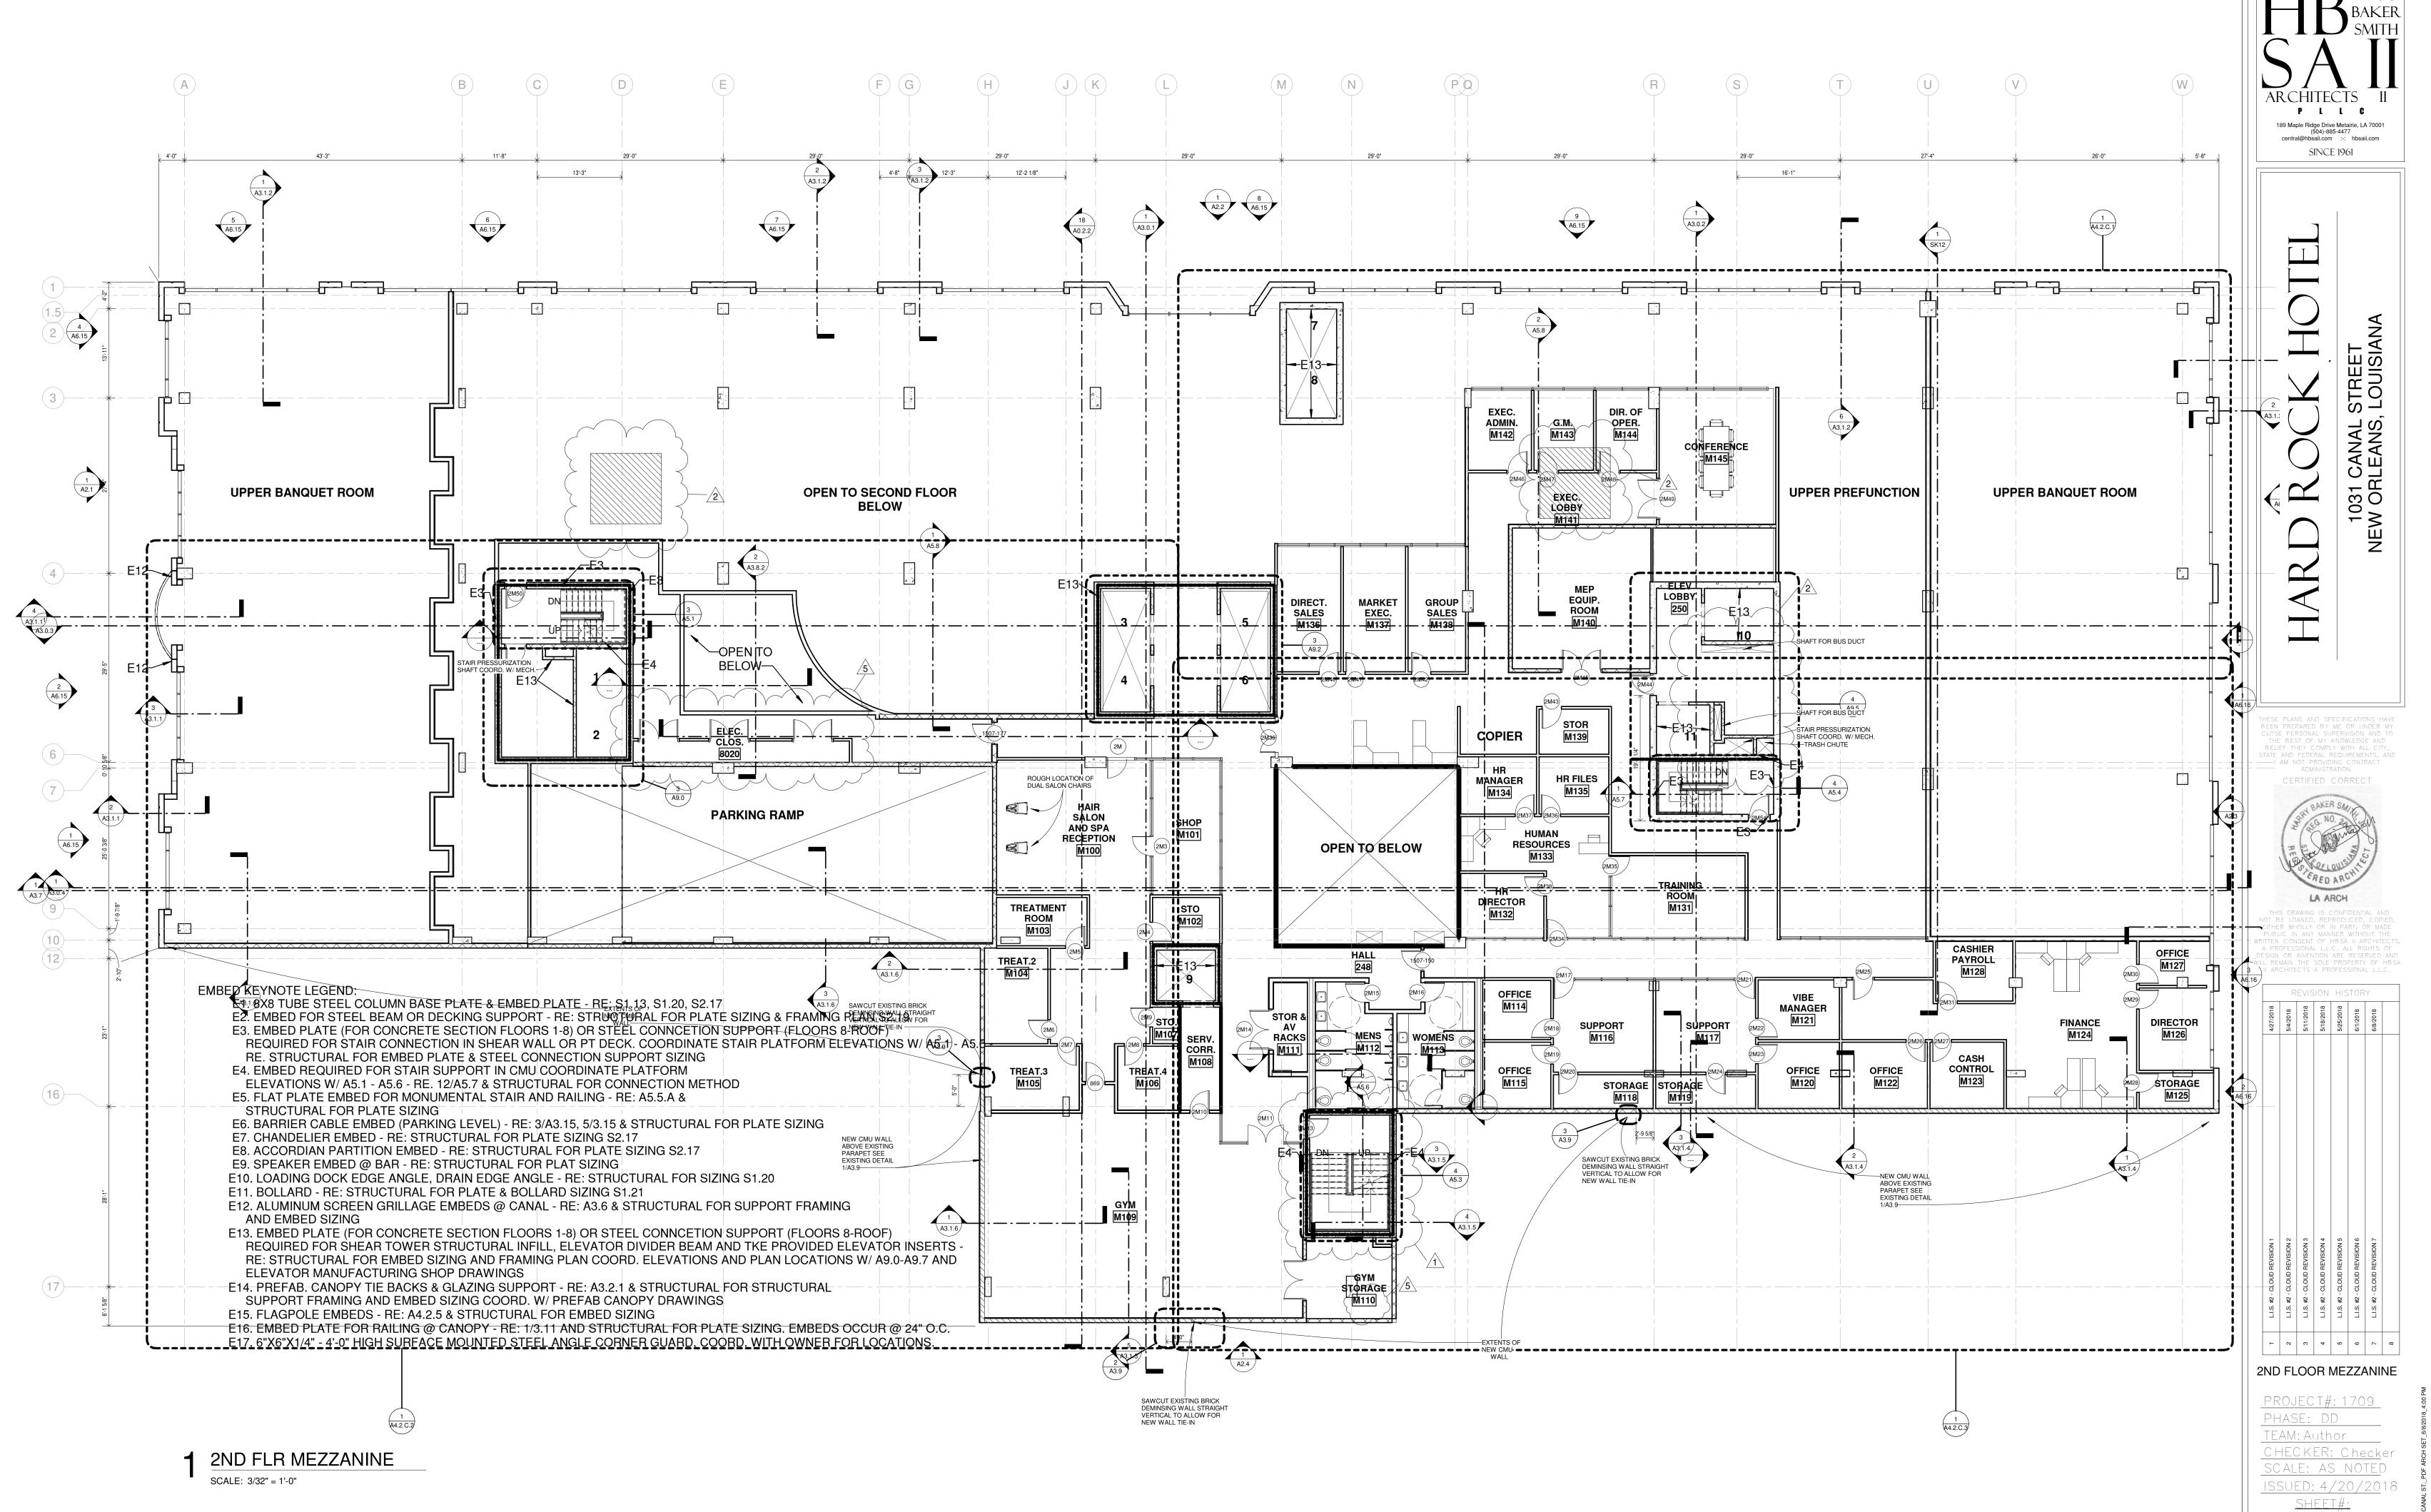

A1 2-C

HARRY
BAKER
SMITH
SMITH
ARCHITECTS II
P L C

189 Maple Ridge Drive Metairie, LA 70001
(504)-885-4477
central@hbsaii.com :: hbsaii.com
SINCE 1961

NRD ROCK HOTEI

THESE PLANS AND SPECIFICATIONS HAVE BEEN PREPARED BY ME OR UNDER MY CLOSE PERSONAL SUPERVISION AND TO THE BEST OF MY KNOWLEDGE AND BELIEF THEY COMPLY WITH ALL CITY, STATE AND FEDERAL REQUIREMENTS, AND I AM NOT PROVIDING CONTRACT ADMINISTRATION.

CERTIFIED CORRECT



THIS DRAWING IS CONFIDENTIAL AND NOT BE LOANED, REPRODUCED, COPIED, EITHER WHOLLY OR IN PART, OR MADE PUBLIC IN ANY MANNER WITHOUT THE WRITTEN CONSENT OF HBSA II ARCHITECT! A PROFESSIONAL L.L.C. ALL RIGHTS OF DESIGN OR INVENTION ARE RESERVED ANI WILL REMAIN THE SOLE PROPERTY OF HBS

| II AR                    | II ARCHITECTS A PROFESSIONAL L.L.C. |                          |                          |                          |                          |                          |  |  |  |  |  |
|--------------------------|-------------------------------------|--------------------------|--------------------------|--------------------------|--------------------------|--------------------------|--|--|--|--|--|
|                          | REVISION HISTORY                    |                          |                          |                          |                          |                          |  |  |  |  |  |
| 4/27/2018                | 5/4/2018                            | 5/11/2018                | 5/18/2018                | 5/25/2018                | 6/1/2018                 | 6/8/2018                 |  |  |  |  |  |
| 3, #2 - CLOUD REVISION 1 | s. #2 - CLOUD REVISION 2            | 5. #2 - CLOUD REVISION 3 | s, #2 - CLOUD REVISION 4 | s, #2 - CLOUD REVISION 5 | s, #2 - CLOUD REVISION 6 | s, #2 - CLOUD REVISION 7 |  |  |  |  |  |

2ND FLOOR MEZZ. RCP


PROJECT#: 1709
PHASE: DD
TEAM: Author
CHECKER: Checker
SCALE: AS NOTED

NOTE: ALL CEILINGS RELATIVE TO CURRENT


**LEVEL ELEVATION** 

Δ1 2-D

ISSUED: 4/20/2018

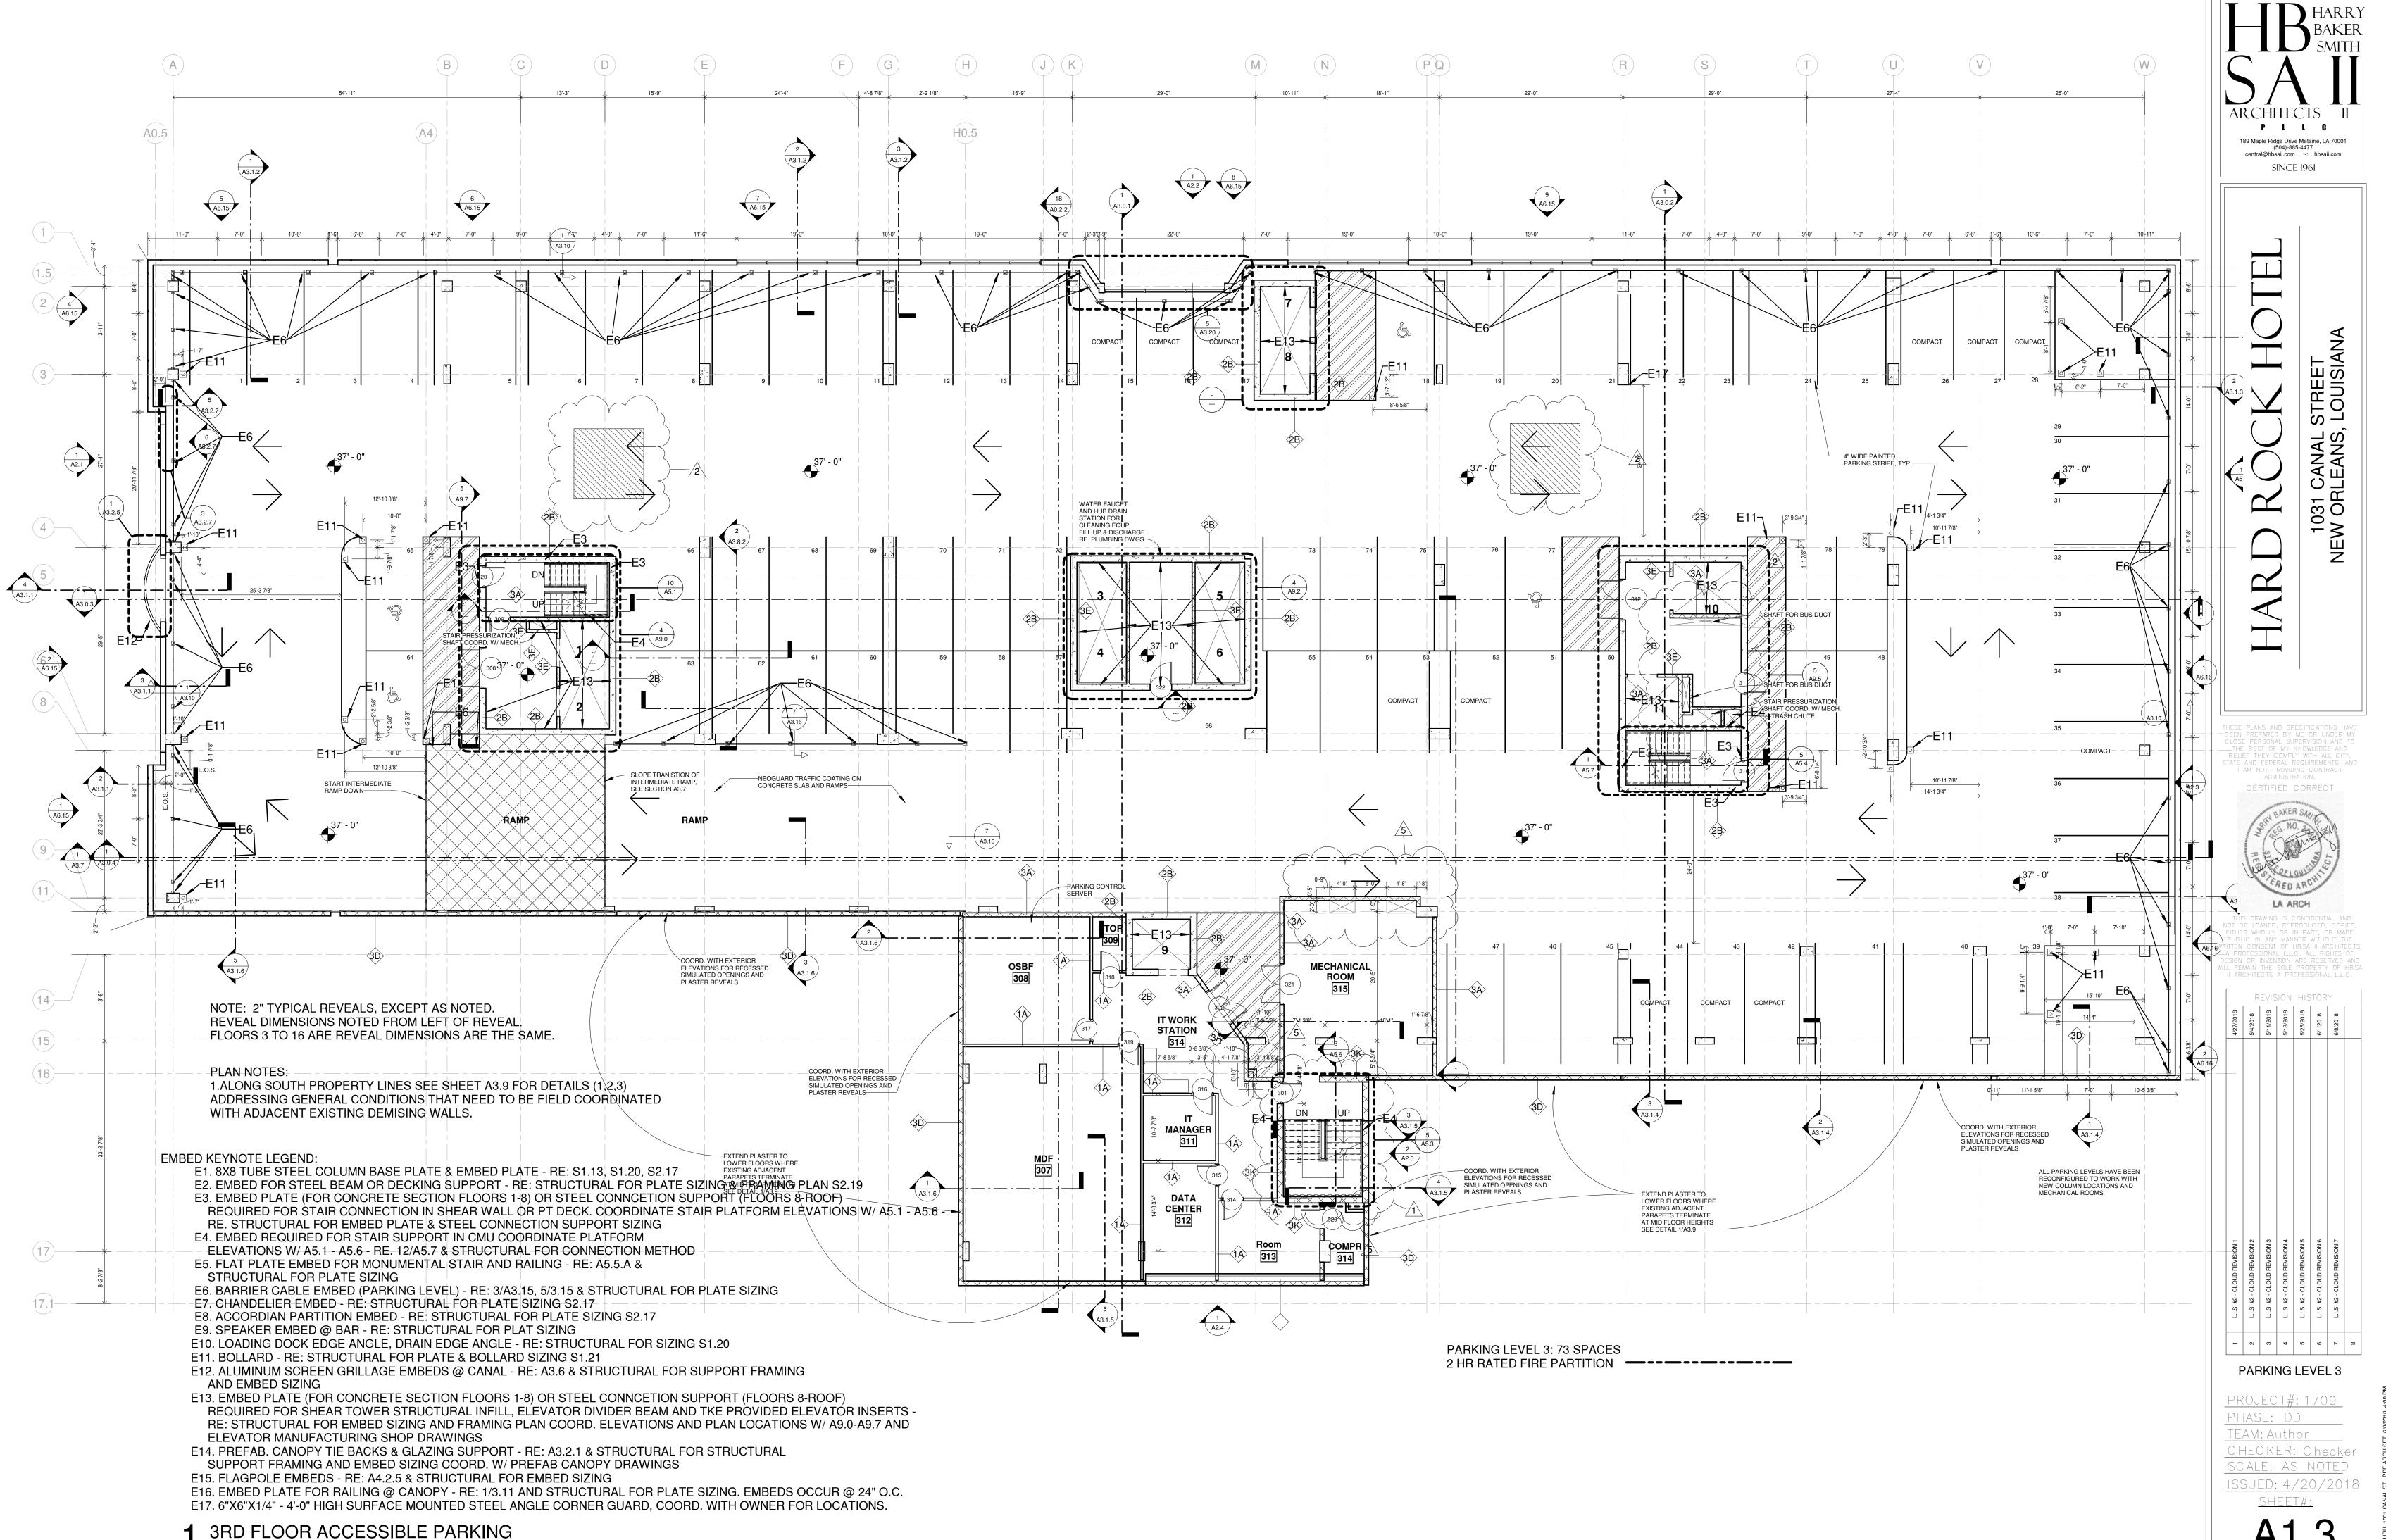

SCALE: 3/32" = 1'-0"

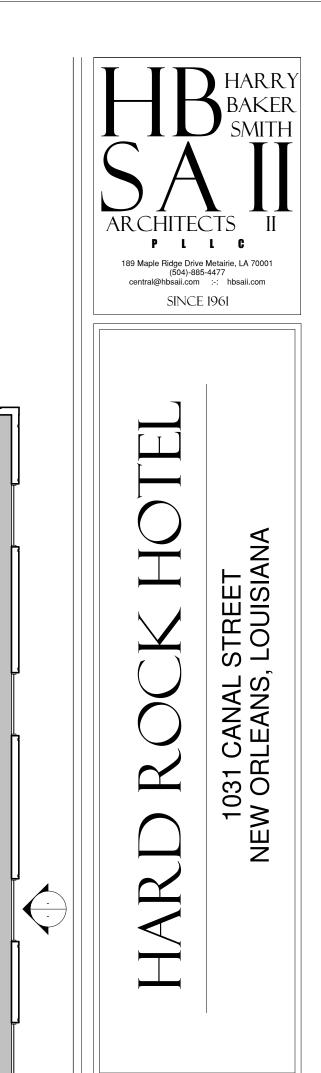

THESE PLANS AND SPECIFICATIONS HAVE BEEN PREPARED BY ME OR UNDER MY CLOSE PERSONAL SUPERVISION AND TO THE BEST OF MY KNOWLEDGE AND BELIEF THEY COMPLY WITH ALL CITY, STATE AND FEDERAL REQUIREMENTS, AND I AM NOT PROVIDING CONTRACT ADMINISTRATION. CERTIFIED CORRECT

REVISION HISTORY


PARKING LEVEL 3 RCP


PROJECT#:<u>1709</u> PHASE: DD TEAM: Author CHECKER: Checker SCALE: AS NOTED ISSUED: 4/20/2018

PER PLAN


NOTE: ALL CEILINGS RELATIVE TO CURRENT

LEVEL ELEVATION

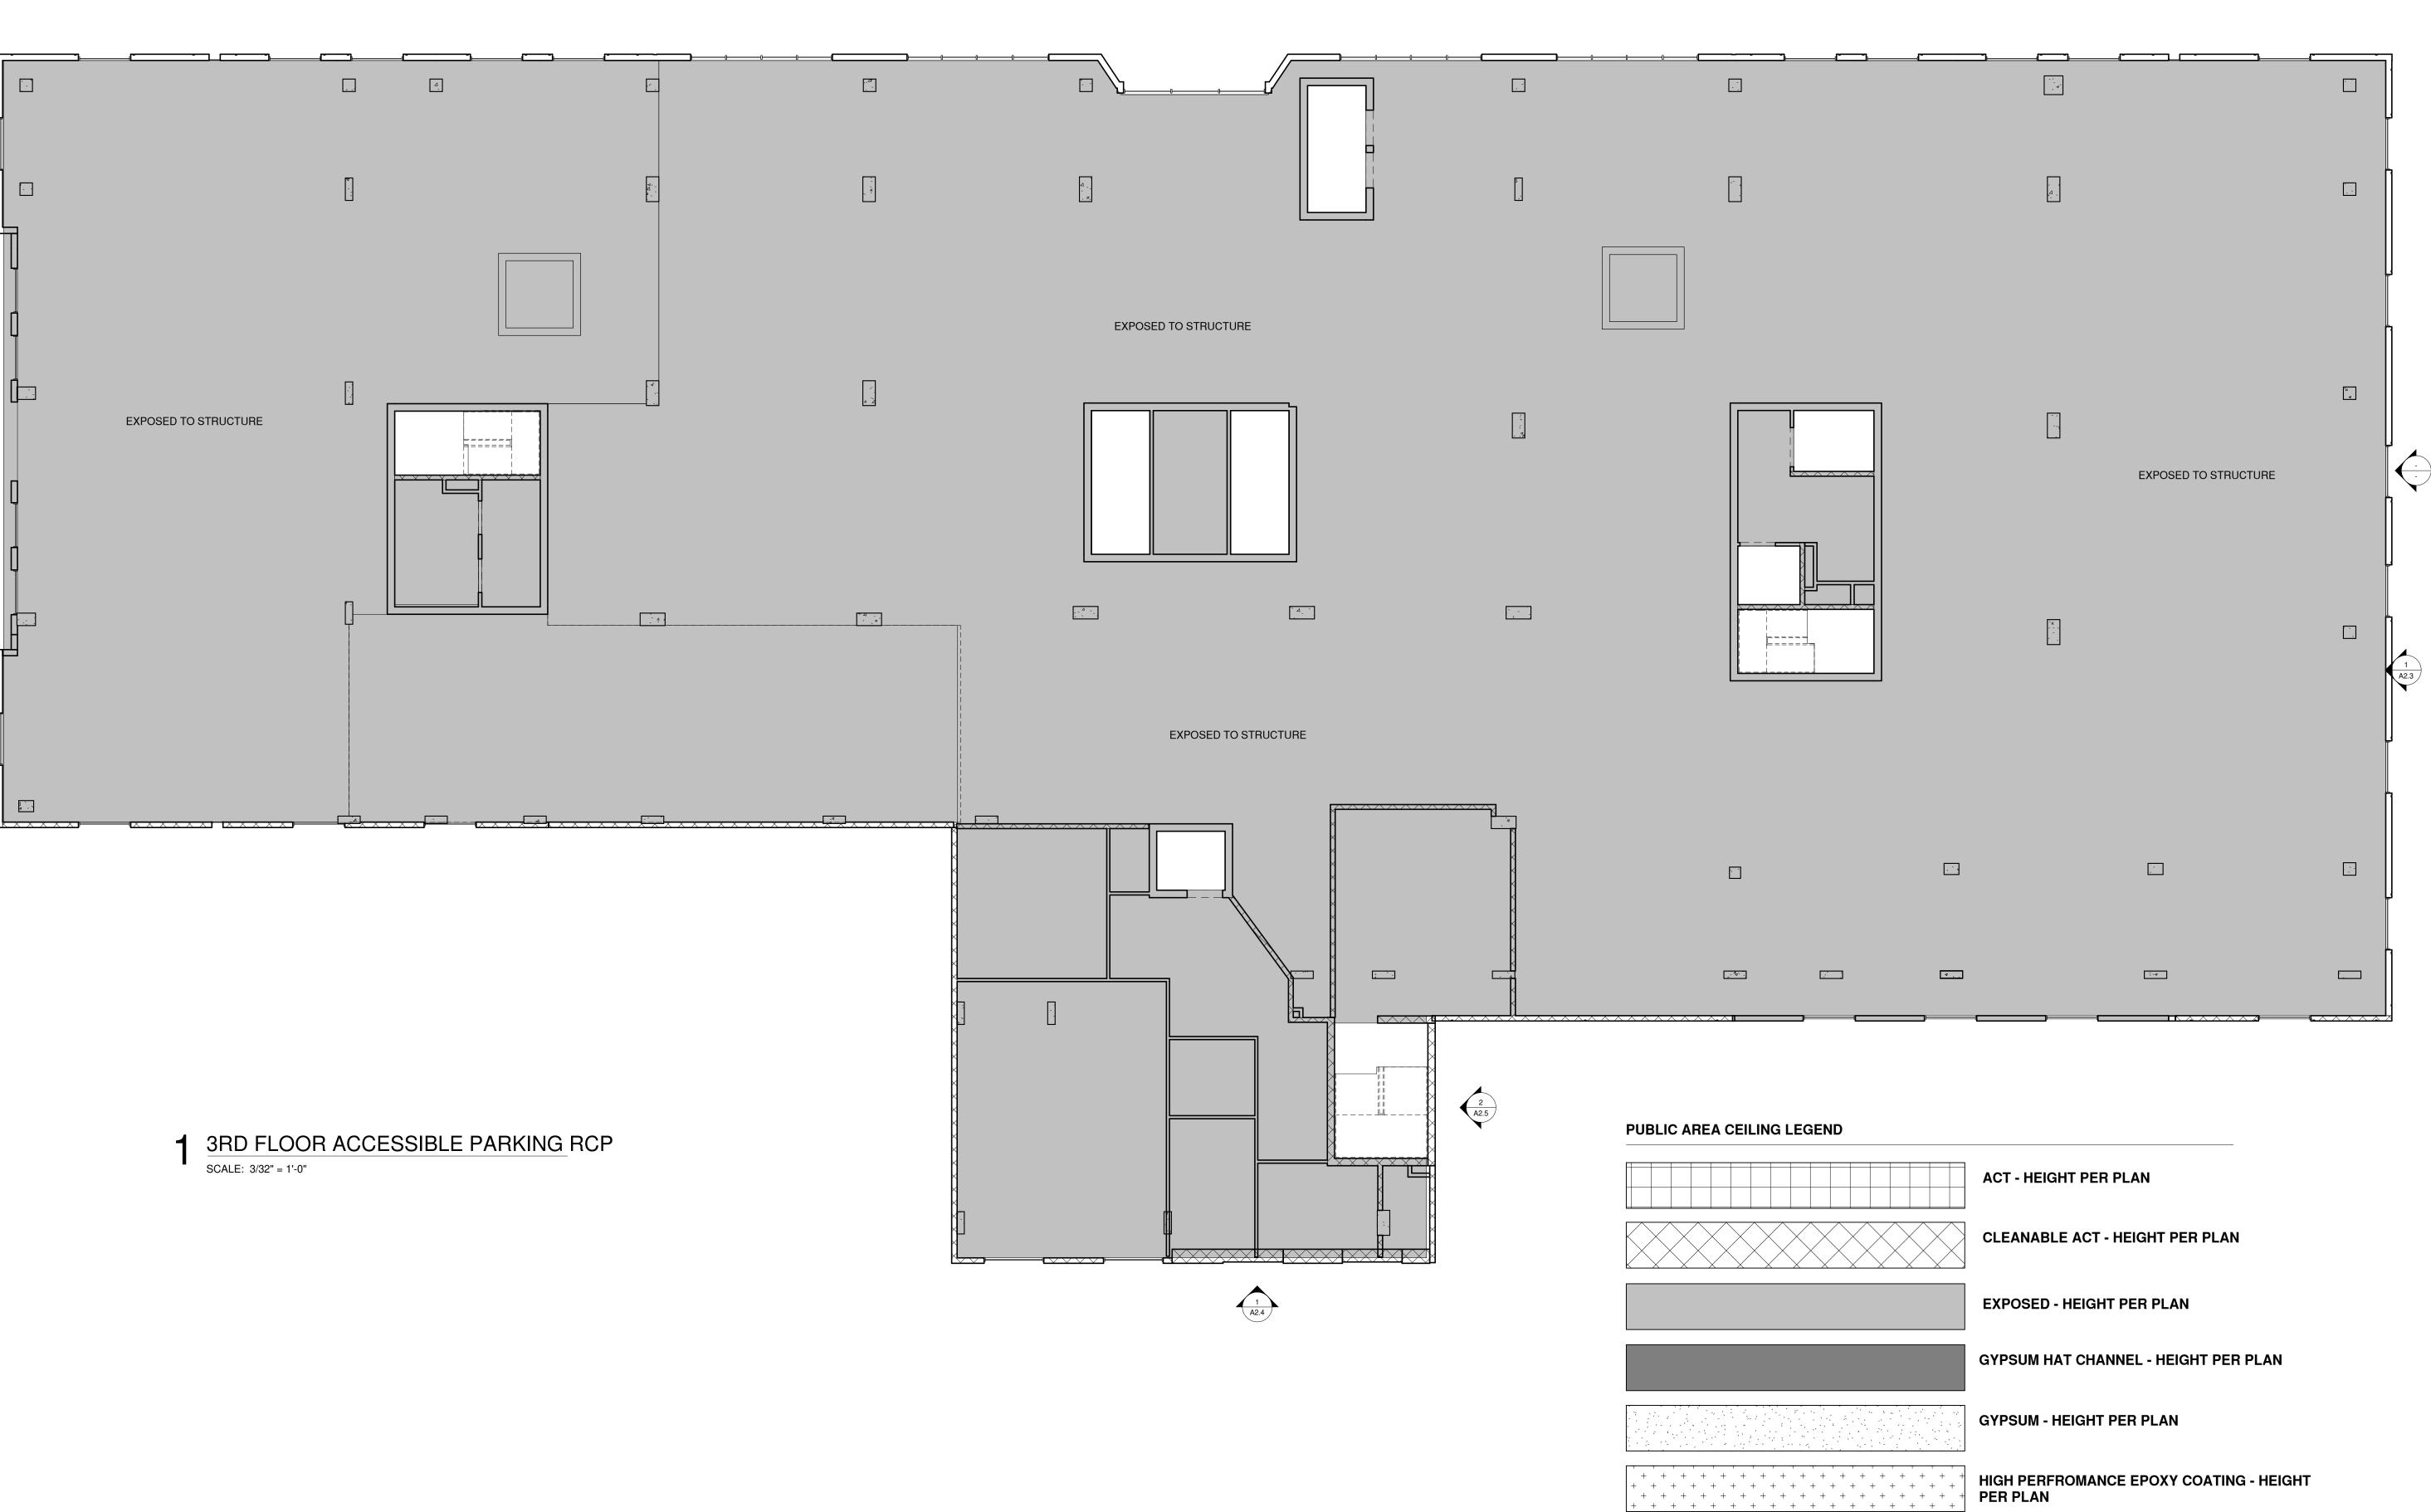

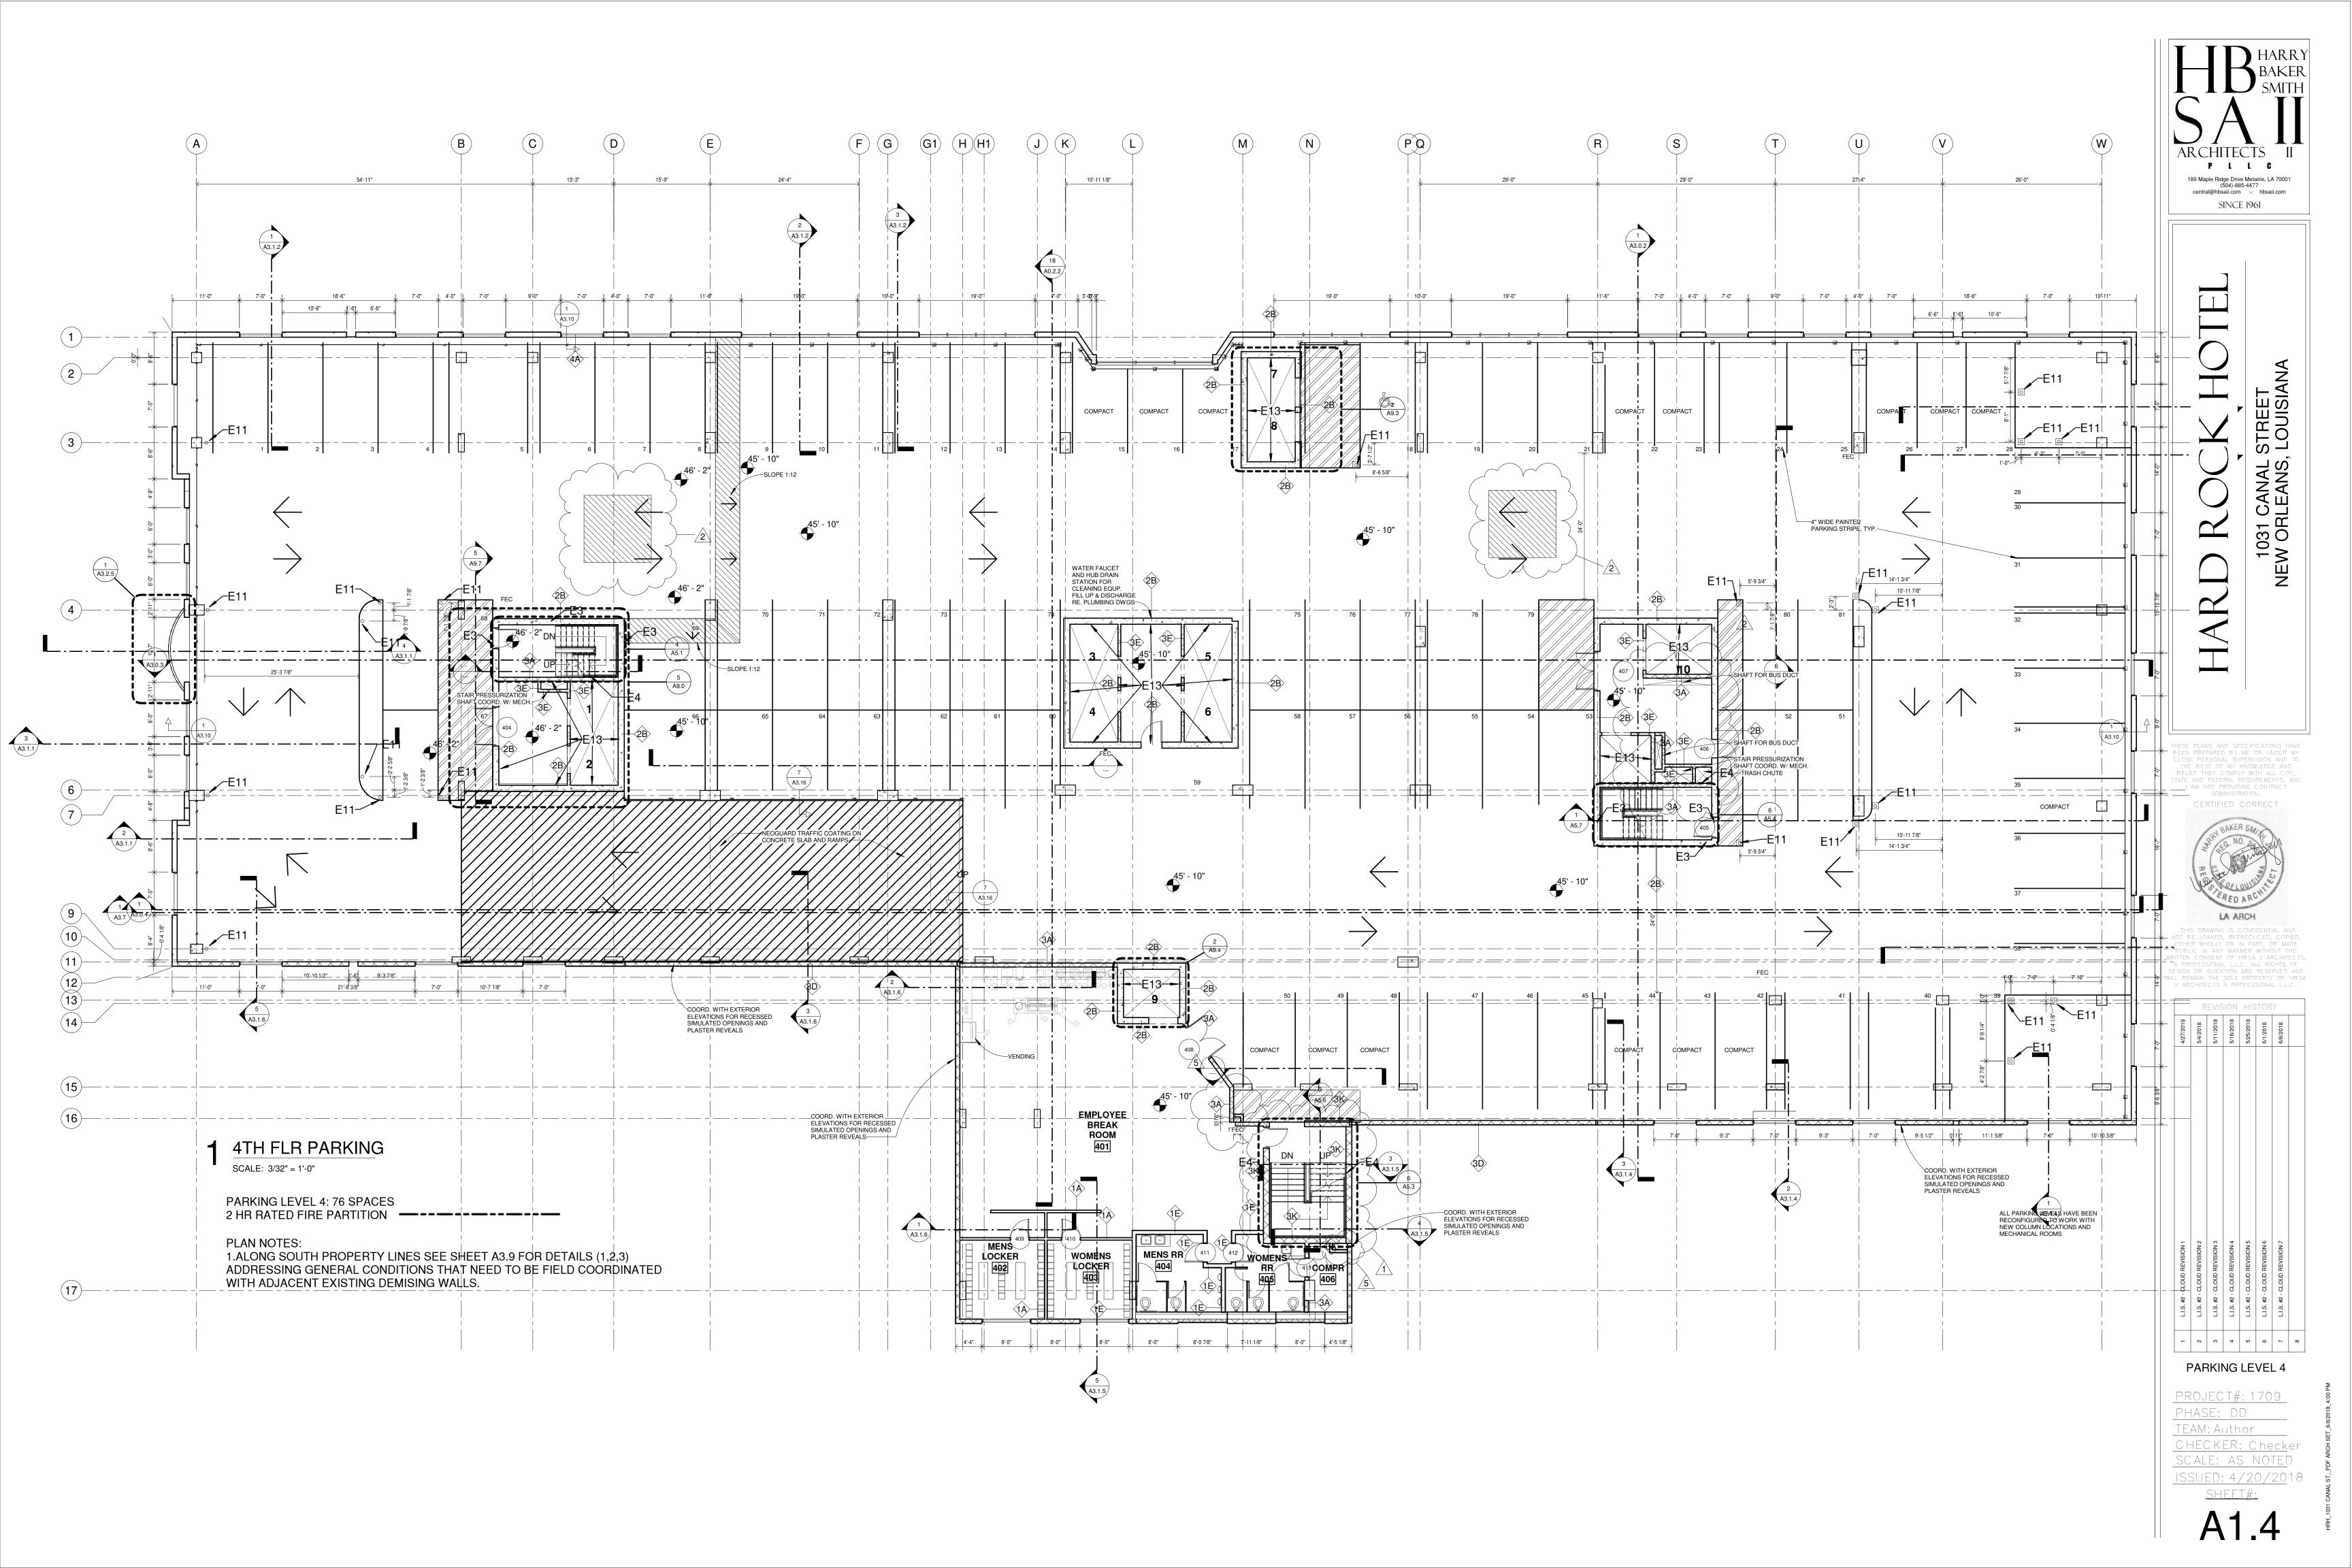

THESE PLANS AND SPECIFICATIONS HAVE
BEEN PREPARED BY ME OR UNDER MY
CLOSE PERSONAL SUPERVISION AND TO
THE BEST OF MY KNOWLEDGE AND
BELIEF THEY COMPLY WITH ALL CITY,
STATE AND FEDERAL REQUIREMENTS, AND
I AM NOT PROVIDING CONTRACT
ADMINISTRATION.
CERTIFIED CORRECT

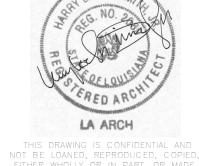

THIS DRAWING IS CONFIDENTIAL AND NOT BE LOANED, REPRODUCED, COPIED, EITHER WHOLLY OR IN PART, OR MADE PUBLIC IN ANY MANNER WITHOUT THE WRITTEN CONSENT OF HBSA II ARCHITECTS, A PROFESSIONAL L.L.C. ALL RIGHTS OF DESIGN OR INVENTION ARE RESERVED AND WILL REMAIN THE SOLE PROPERTY OF HBSA II ARCHITECTS A PROFESSIONAL L.L.C.

|  |           | R        | EVIS      | SION      | HIS       | TOR      | Υ        |  |
|--|-----------|----------|-----------|-----------|-----------|----------|----------|--|
|  | 4/27/2018 | 5/4/2018 | 5/11/2018 | 5/18/2018 | 5/25/2018 | 6/1/2018 | 6/8/2018 |  |
|  |           |          |           |           |           |          |          |  |
|  |           |          |           |           |           |          |          |  |
|  | SION 1    | SION 2   | SION 3    | SION 4    | SION 5    | 9 NOIS   | SION 7   |  |

L.I.S. #2 - CLOUD REVISION 1
L.I.S. #2 - CLOUD REVISION 2
L.I.S. #2 - CLOUD REVISION 4
L.I.S. #2 - CLOUD REVISION 5
L.I.S. #2 - CLOUD REVISION 6
L.I.S. #2 - CLOUD REVISION 6
L.I.S. #2 - CLOUD REVISION 7

PARKING LEVEL 4 RCP


PROJECT#: 1709
PHASE: DD
TEAM: Author
CHECKER: Checker
SCALE: AS NOTED
ISSUED: 4/20/2018


NOTE: ALL CEILINGS RELATIVE TO CURRENT

LEVEL ELEVATION

HIGH PERFROMANCE EPOXY COATING - HEIGHT

A1.4-A

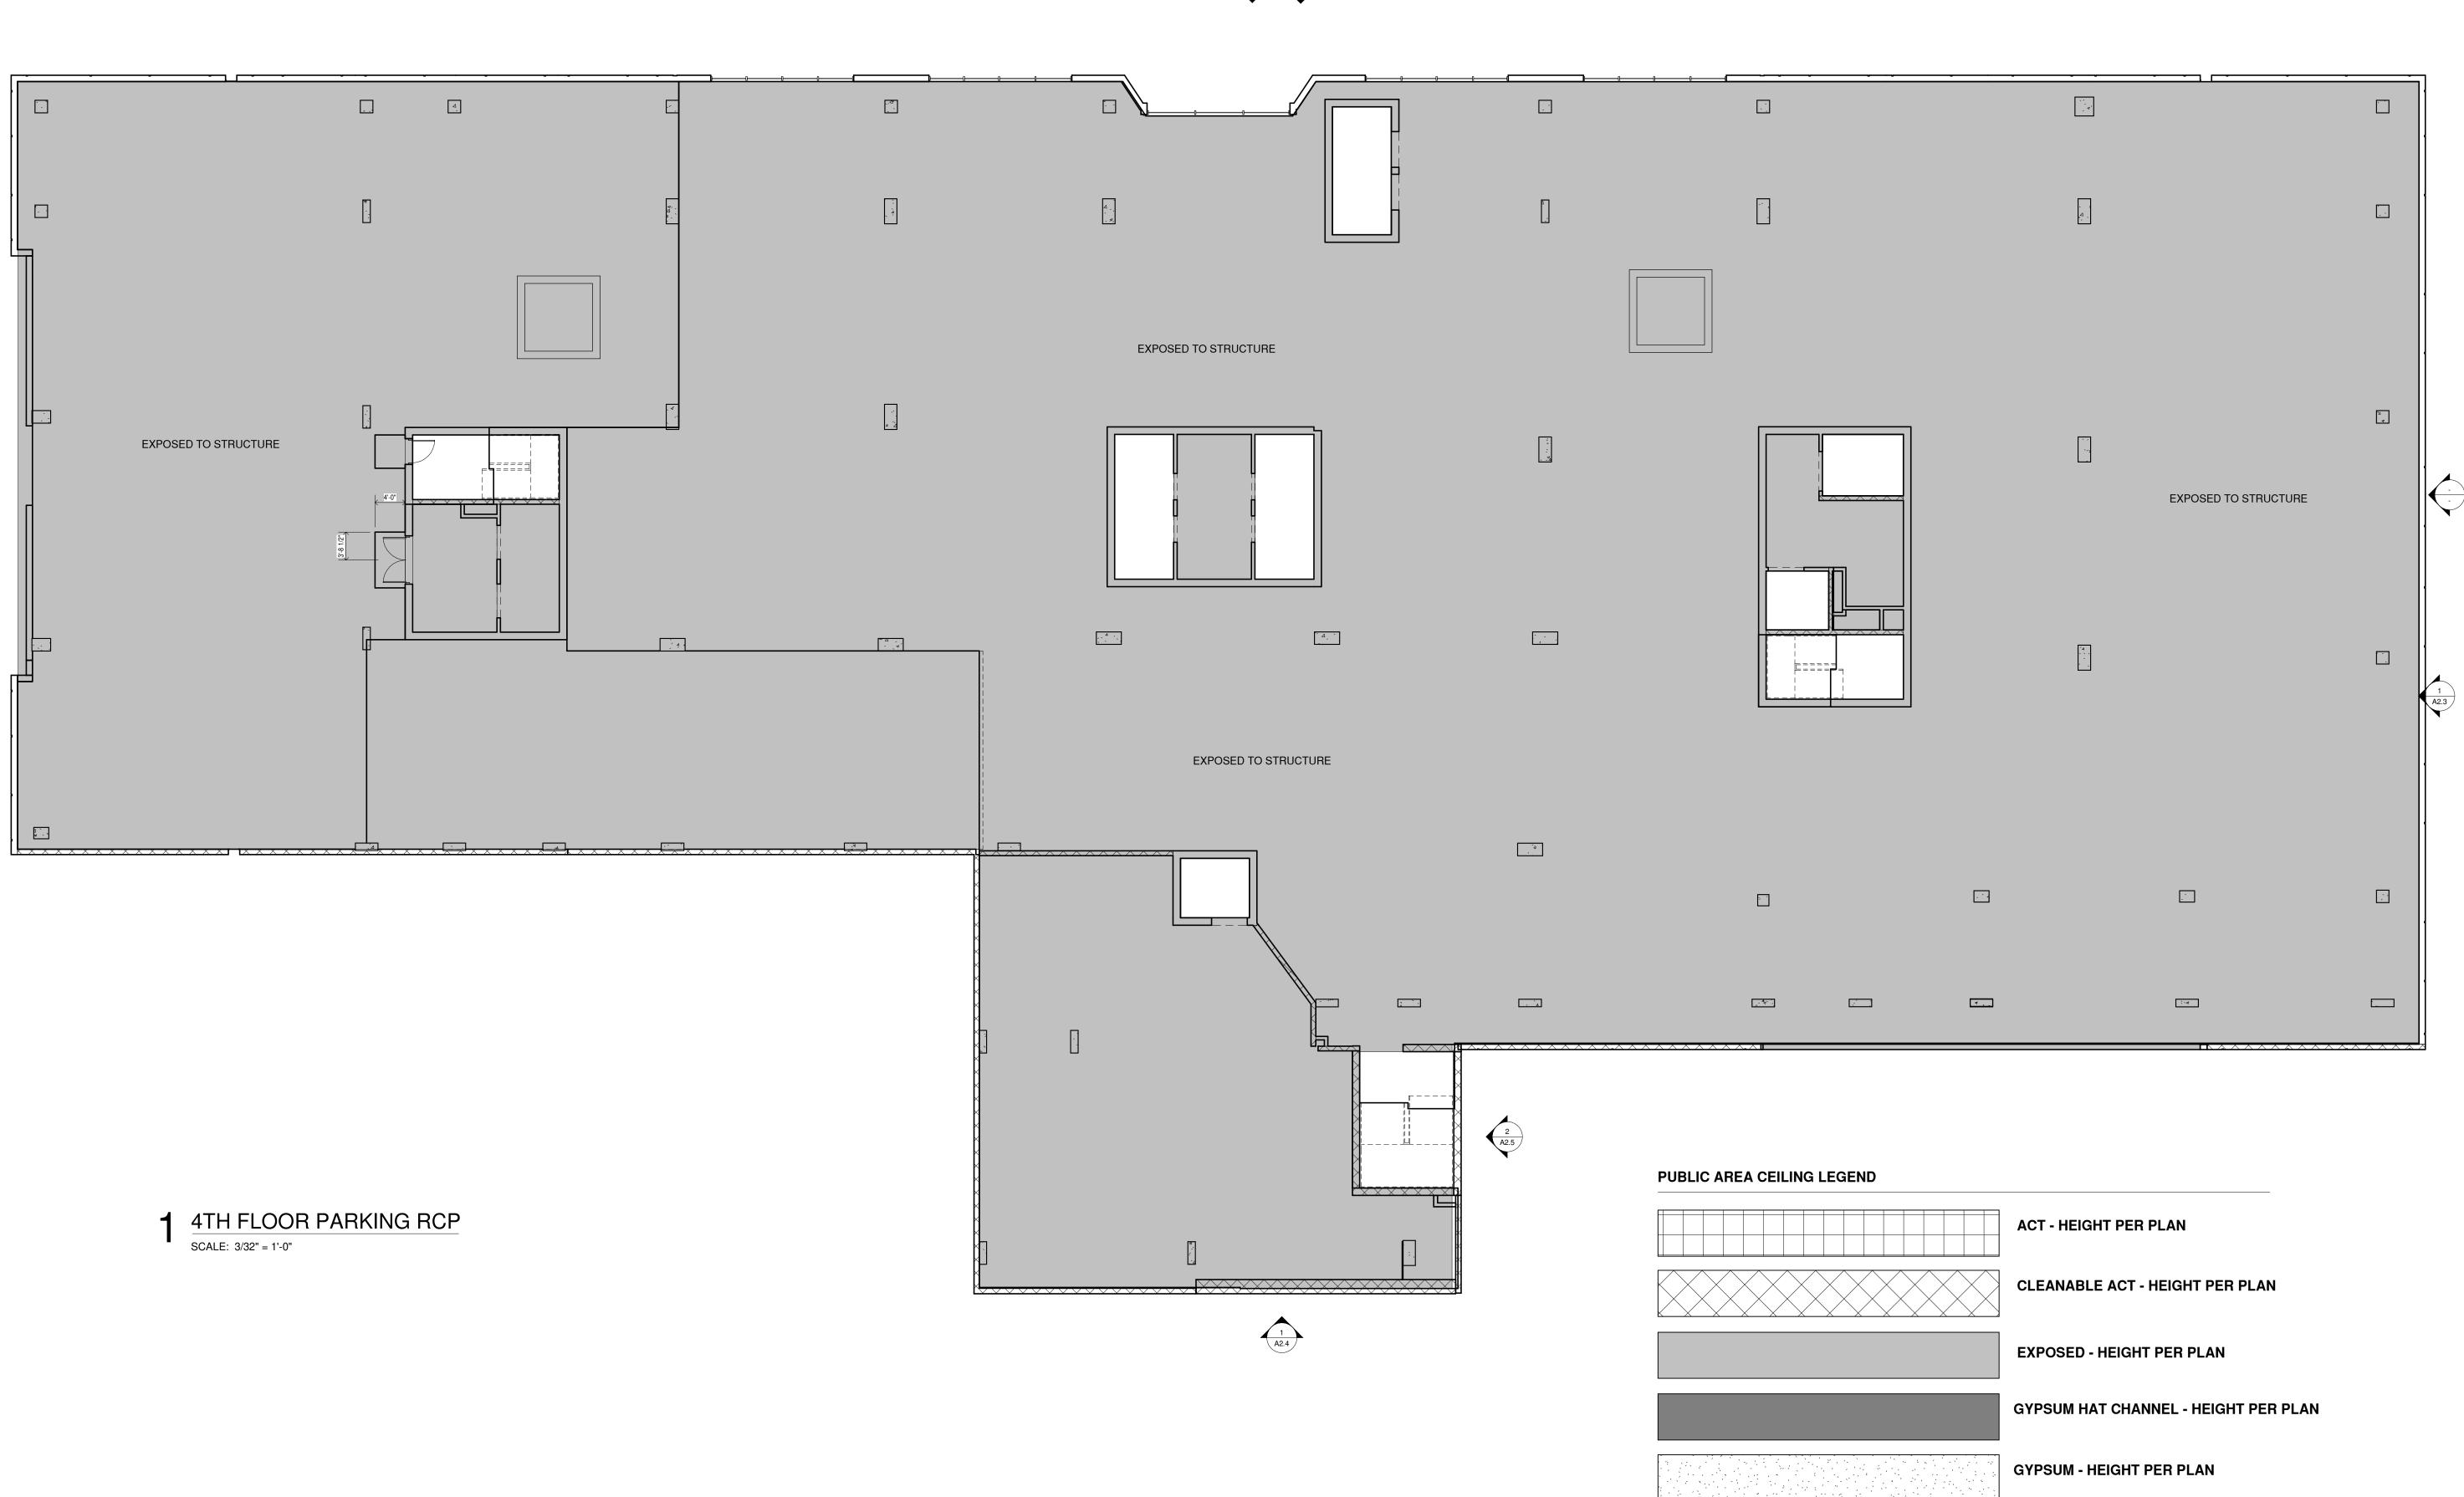

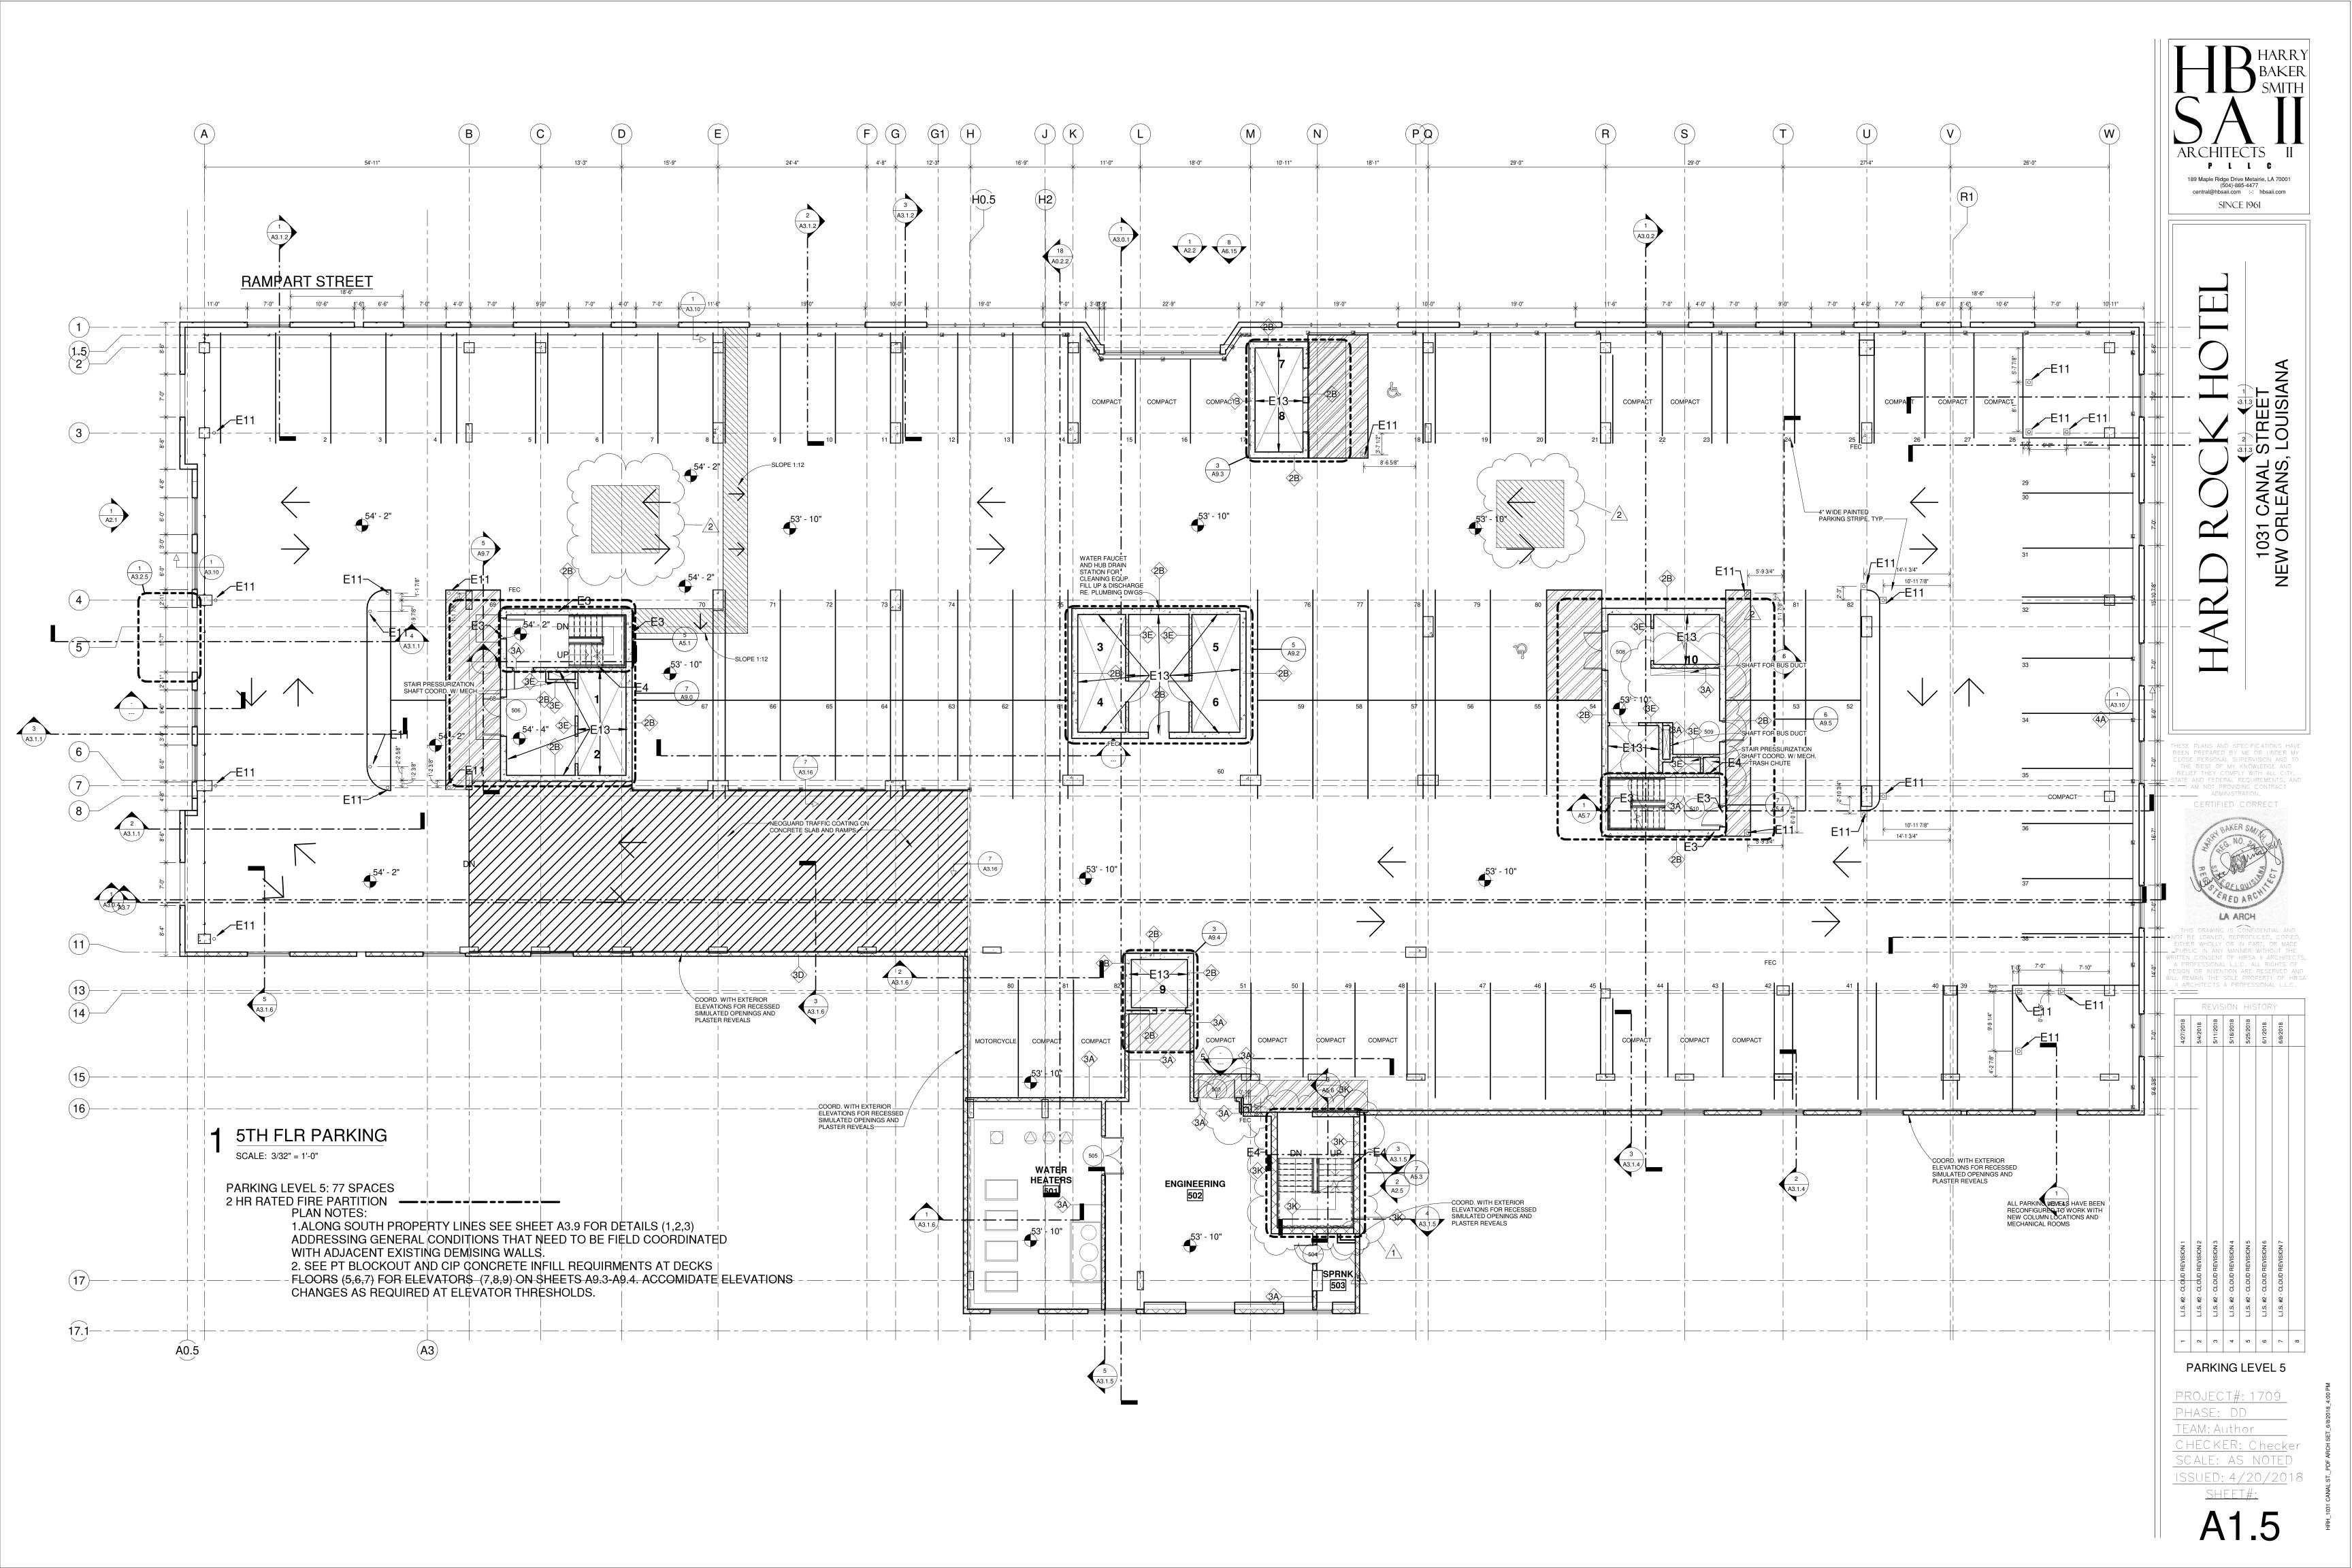

THESE PLANS AND SPECIFICATIONS HAVE BEEN PREPARED BY ME OR UNDER MY CLOSE PERSONAL SUPERVISION AND TO THE BEST OF MY KNOWLEDGE AND BELIEF THEY COMPLY WITH ALL CITY, STATE AND FEDERAL REQUIREMENTS, AND I AM NOT PROVIDING CONTRACT ADMINISTRATION. CERTIFIED CORRECT




|           | R        | EVIS      | NOI       | HIS       | TOR      | Υ        |  |
|-----------|----------|-----------|-----------|-----------|----------|----------|--|
| 4/27/2018 | 5/4/2018 | 5/11/2018 | 5/18/2018 | 5/25/2018 | 6/1/2018 | 6/8/2018 |  |
|           |          |           |           |           |          |          |  |
|           |          |           |           |           |          |          |  |
1 L.I.S. #2 - CLOUD R
2 L.I.S. #2 - CLOUD R
4 L.I.S. #2 - CLOUD R
5 L.I.S. #2 - CLOUD R
7 L.I.S. #2 - CLOUD R
8


PARKING LEVEL 5 RCP


PROJECT#: 1709 PHASE: DD TEAM: Author CHECKER: Checker SCALE: AS NOTED ISSUED: 4/20/2018

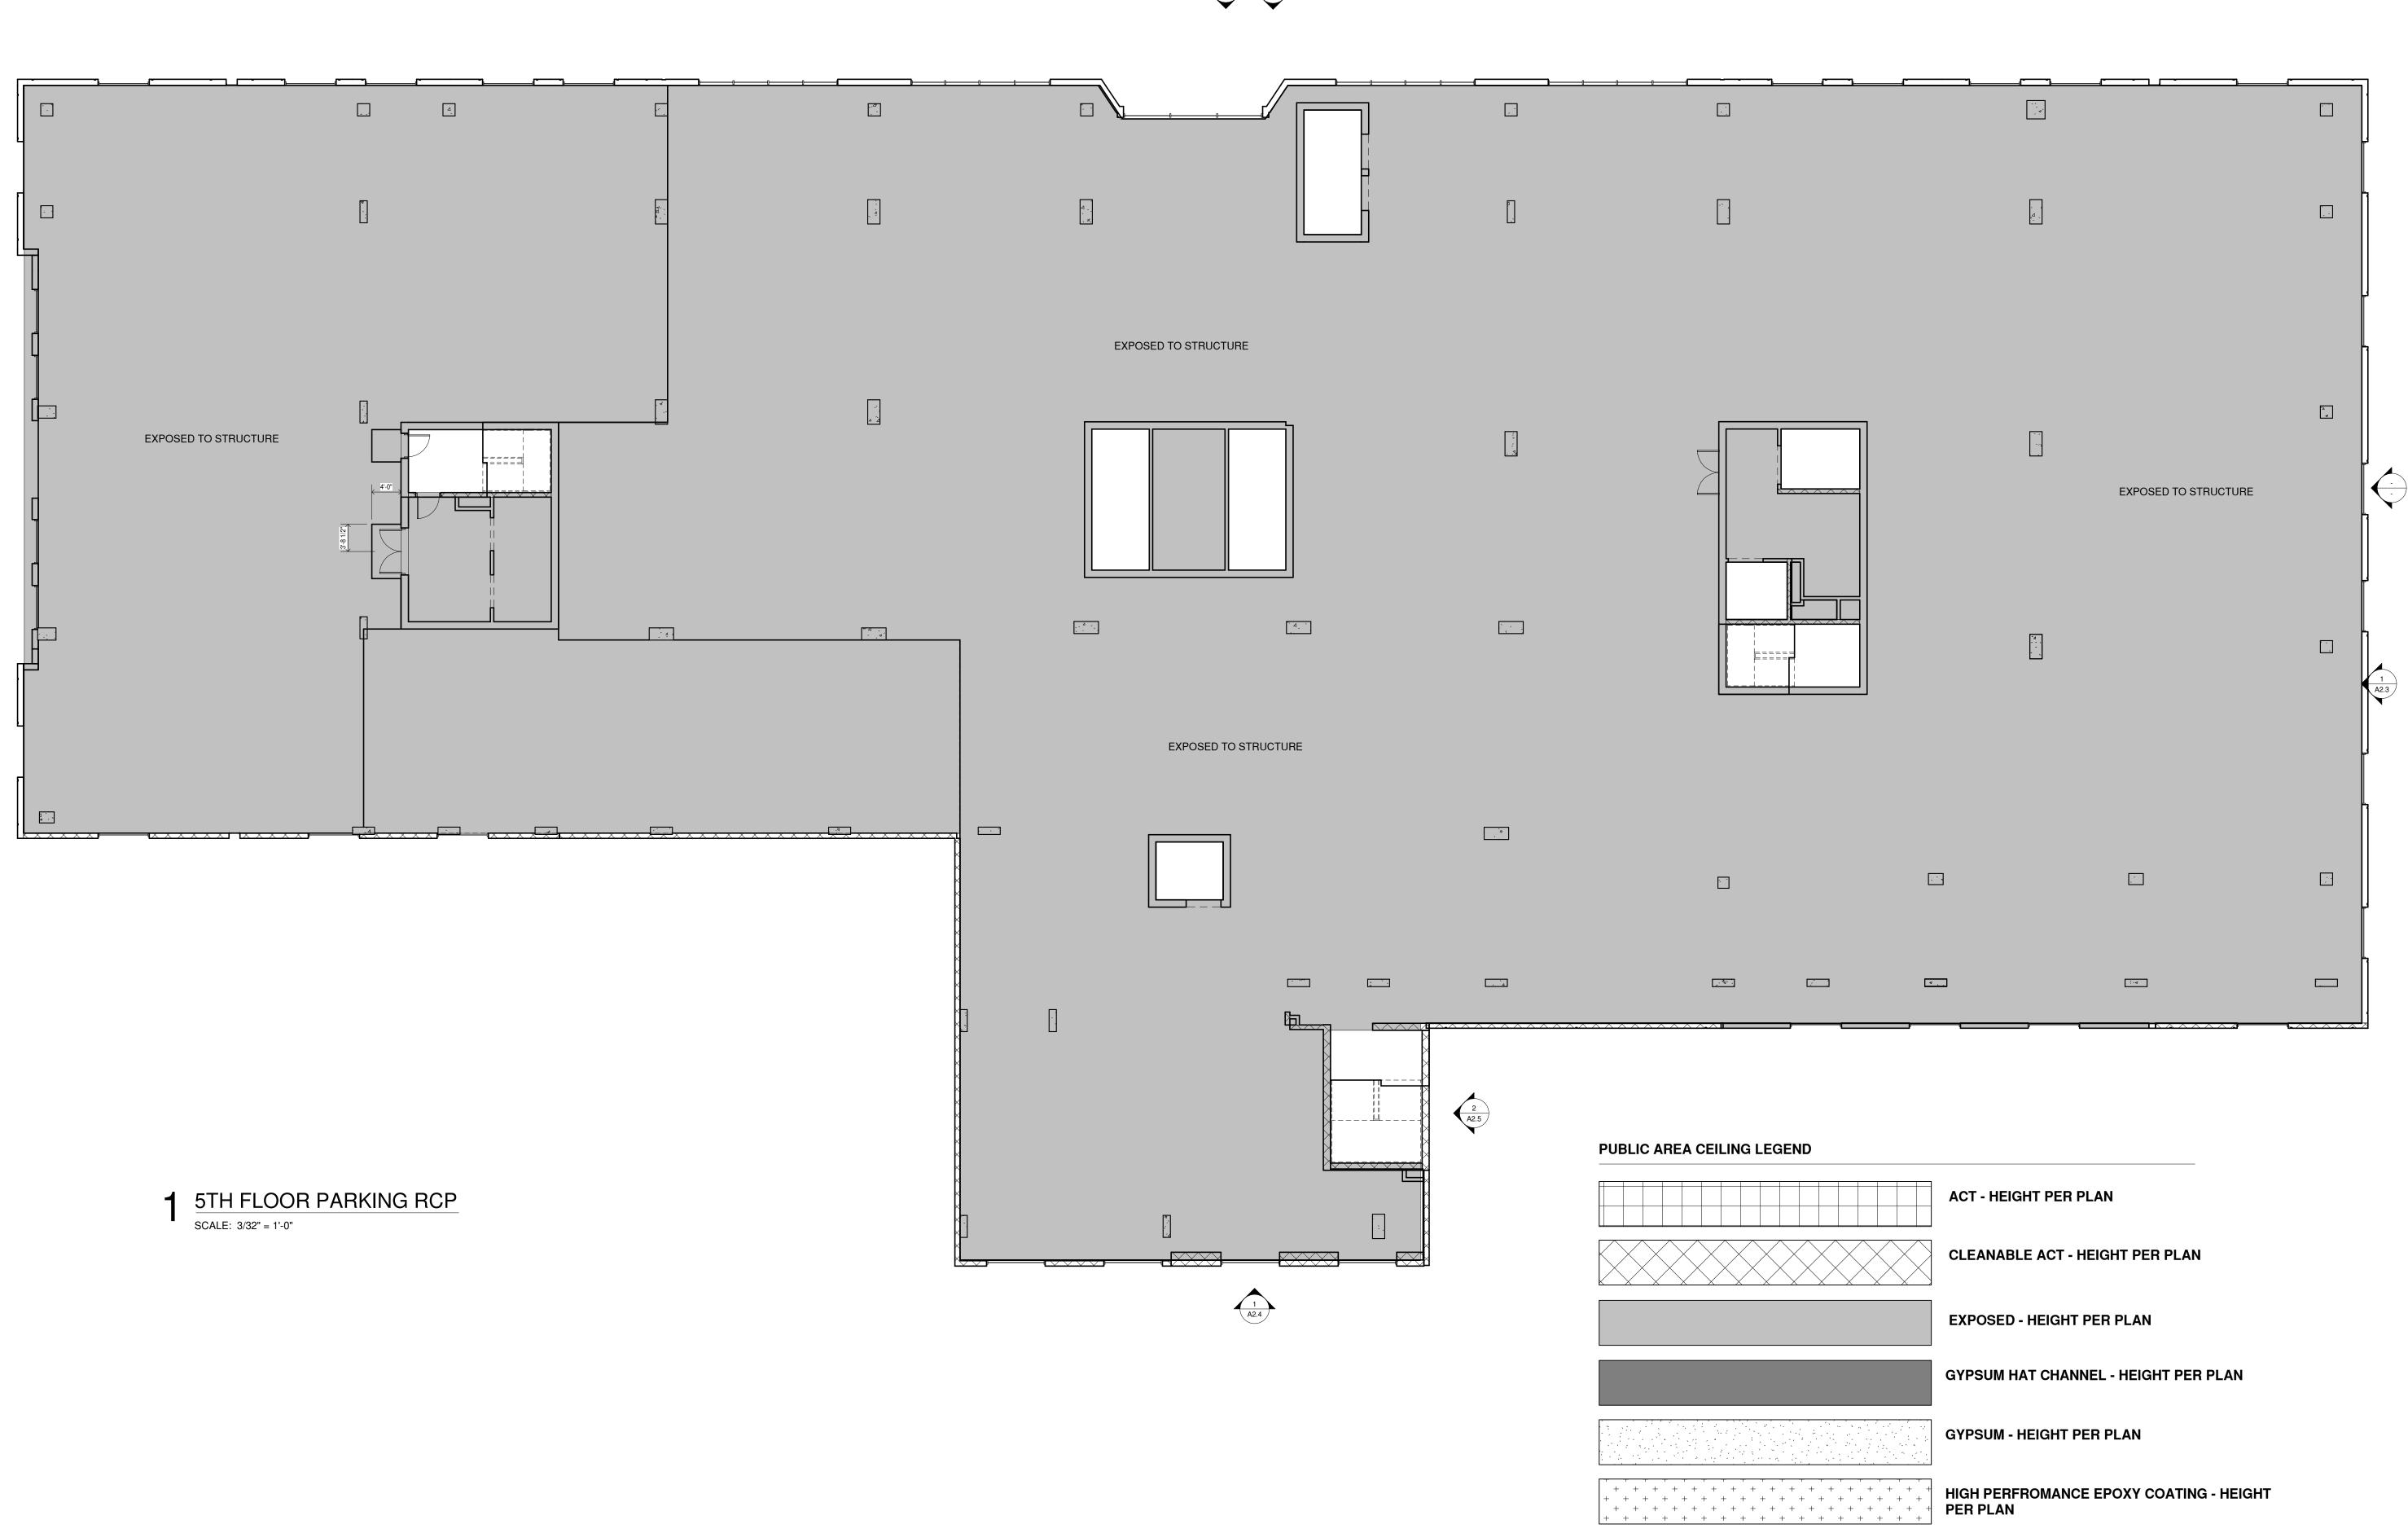

NOTE: ALL CEILINGS RELATIVE TO CURRENT LEVEL ELEVATION

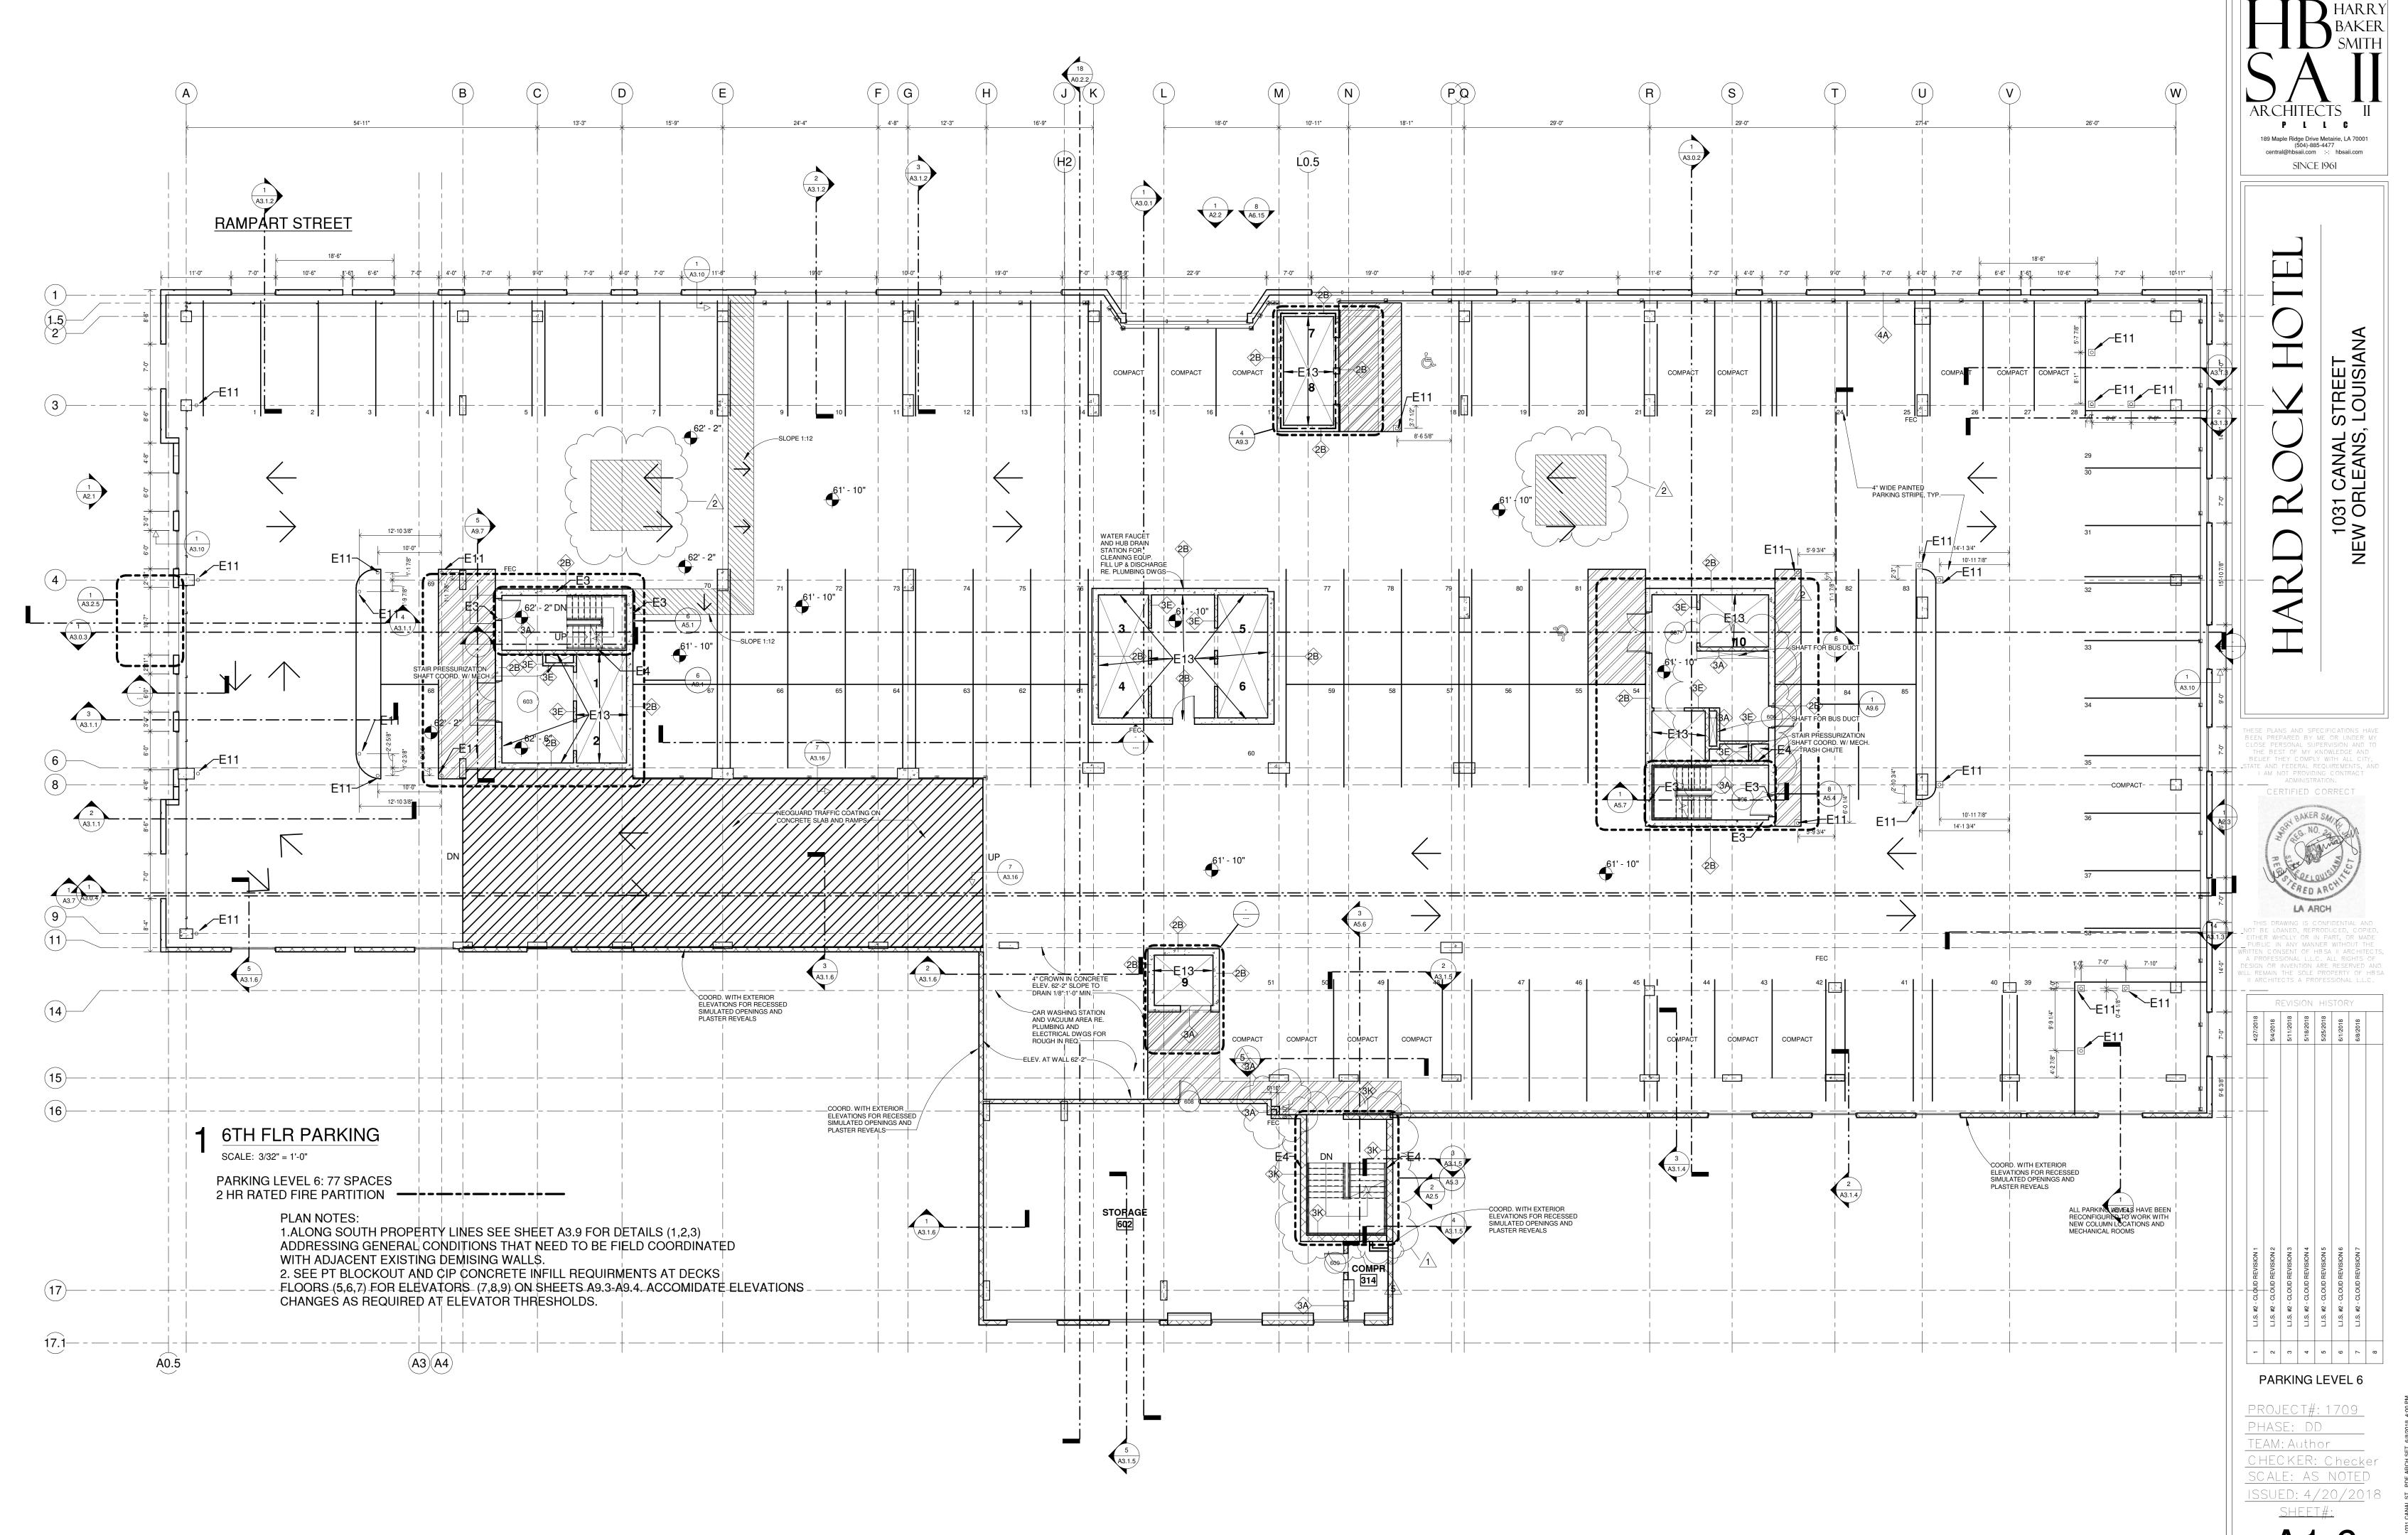

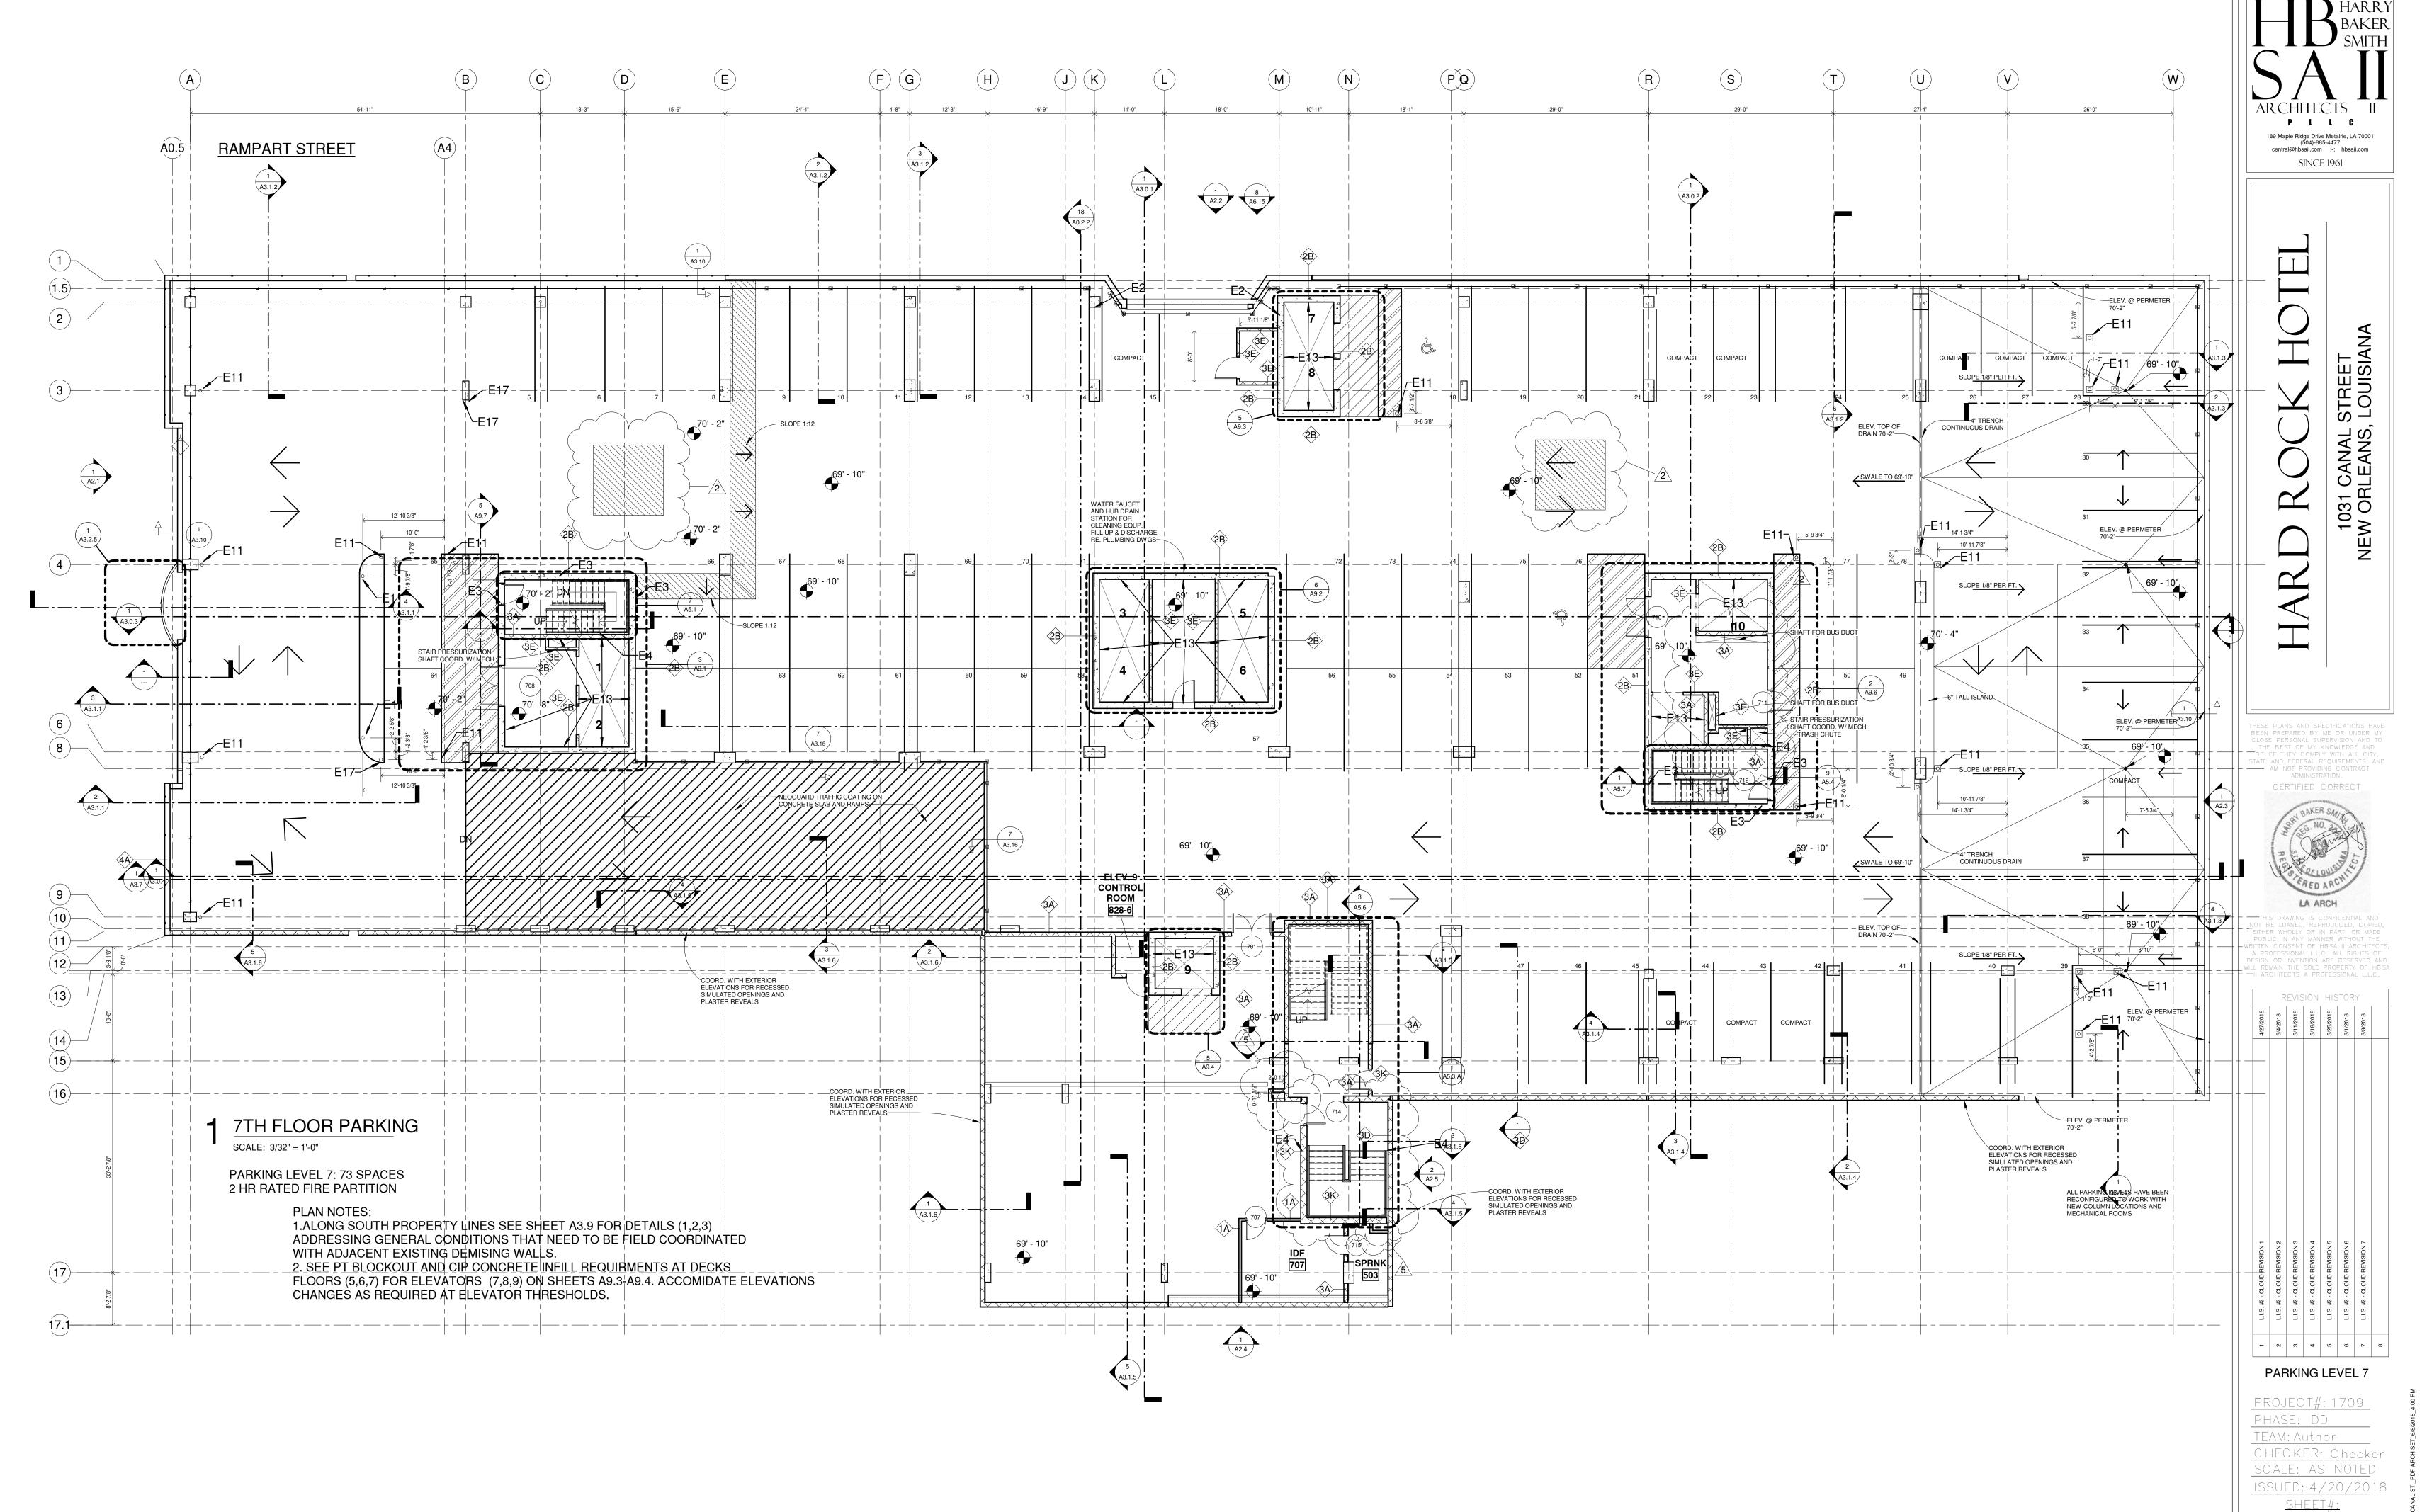

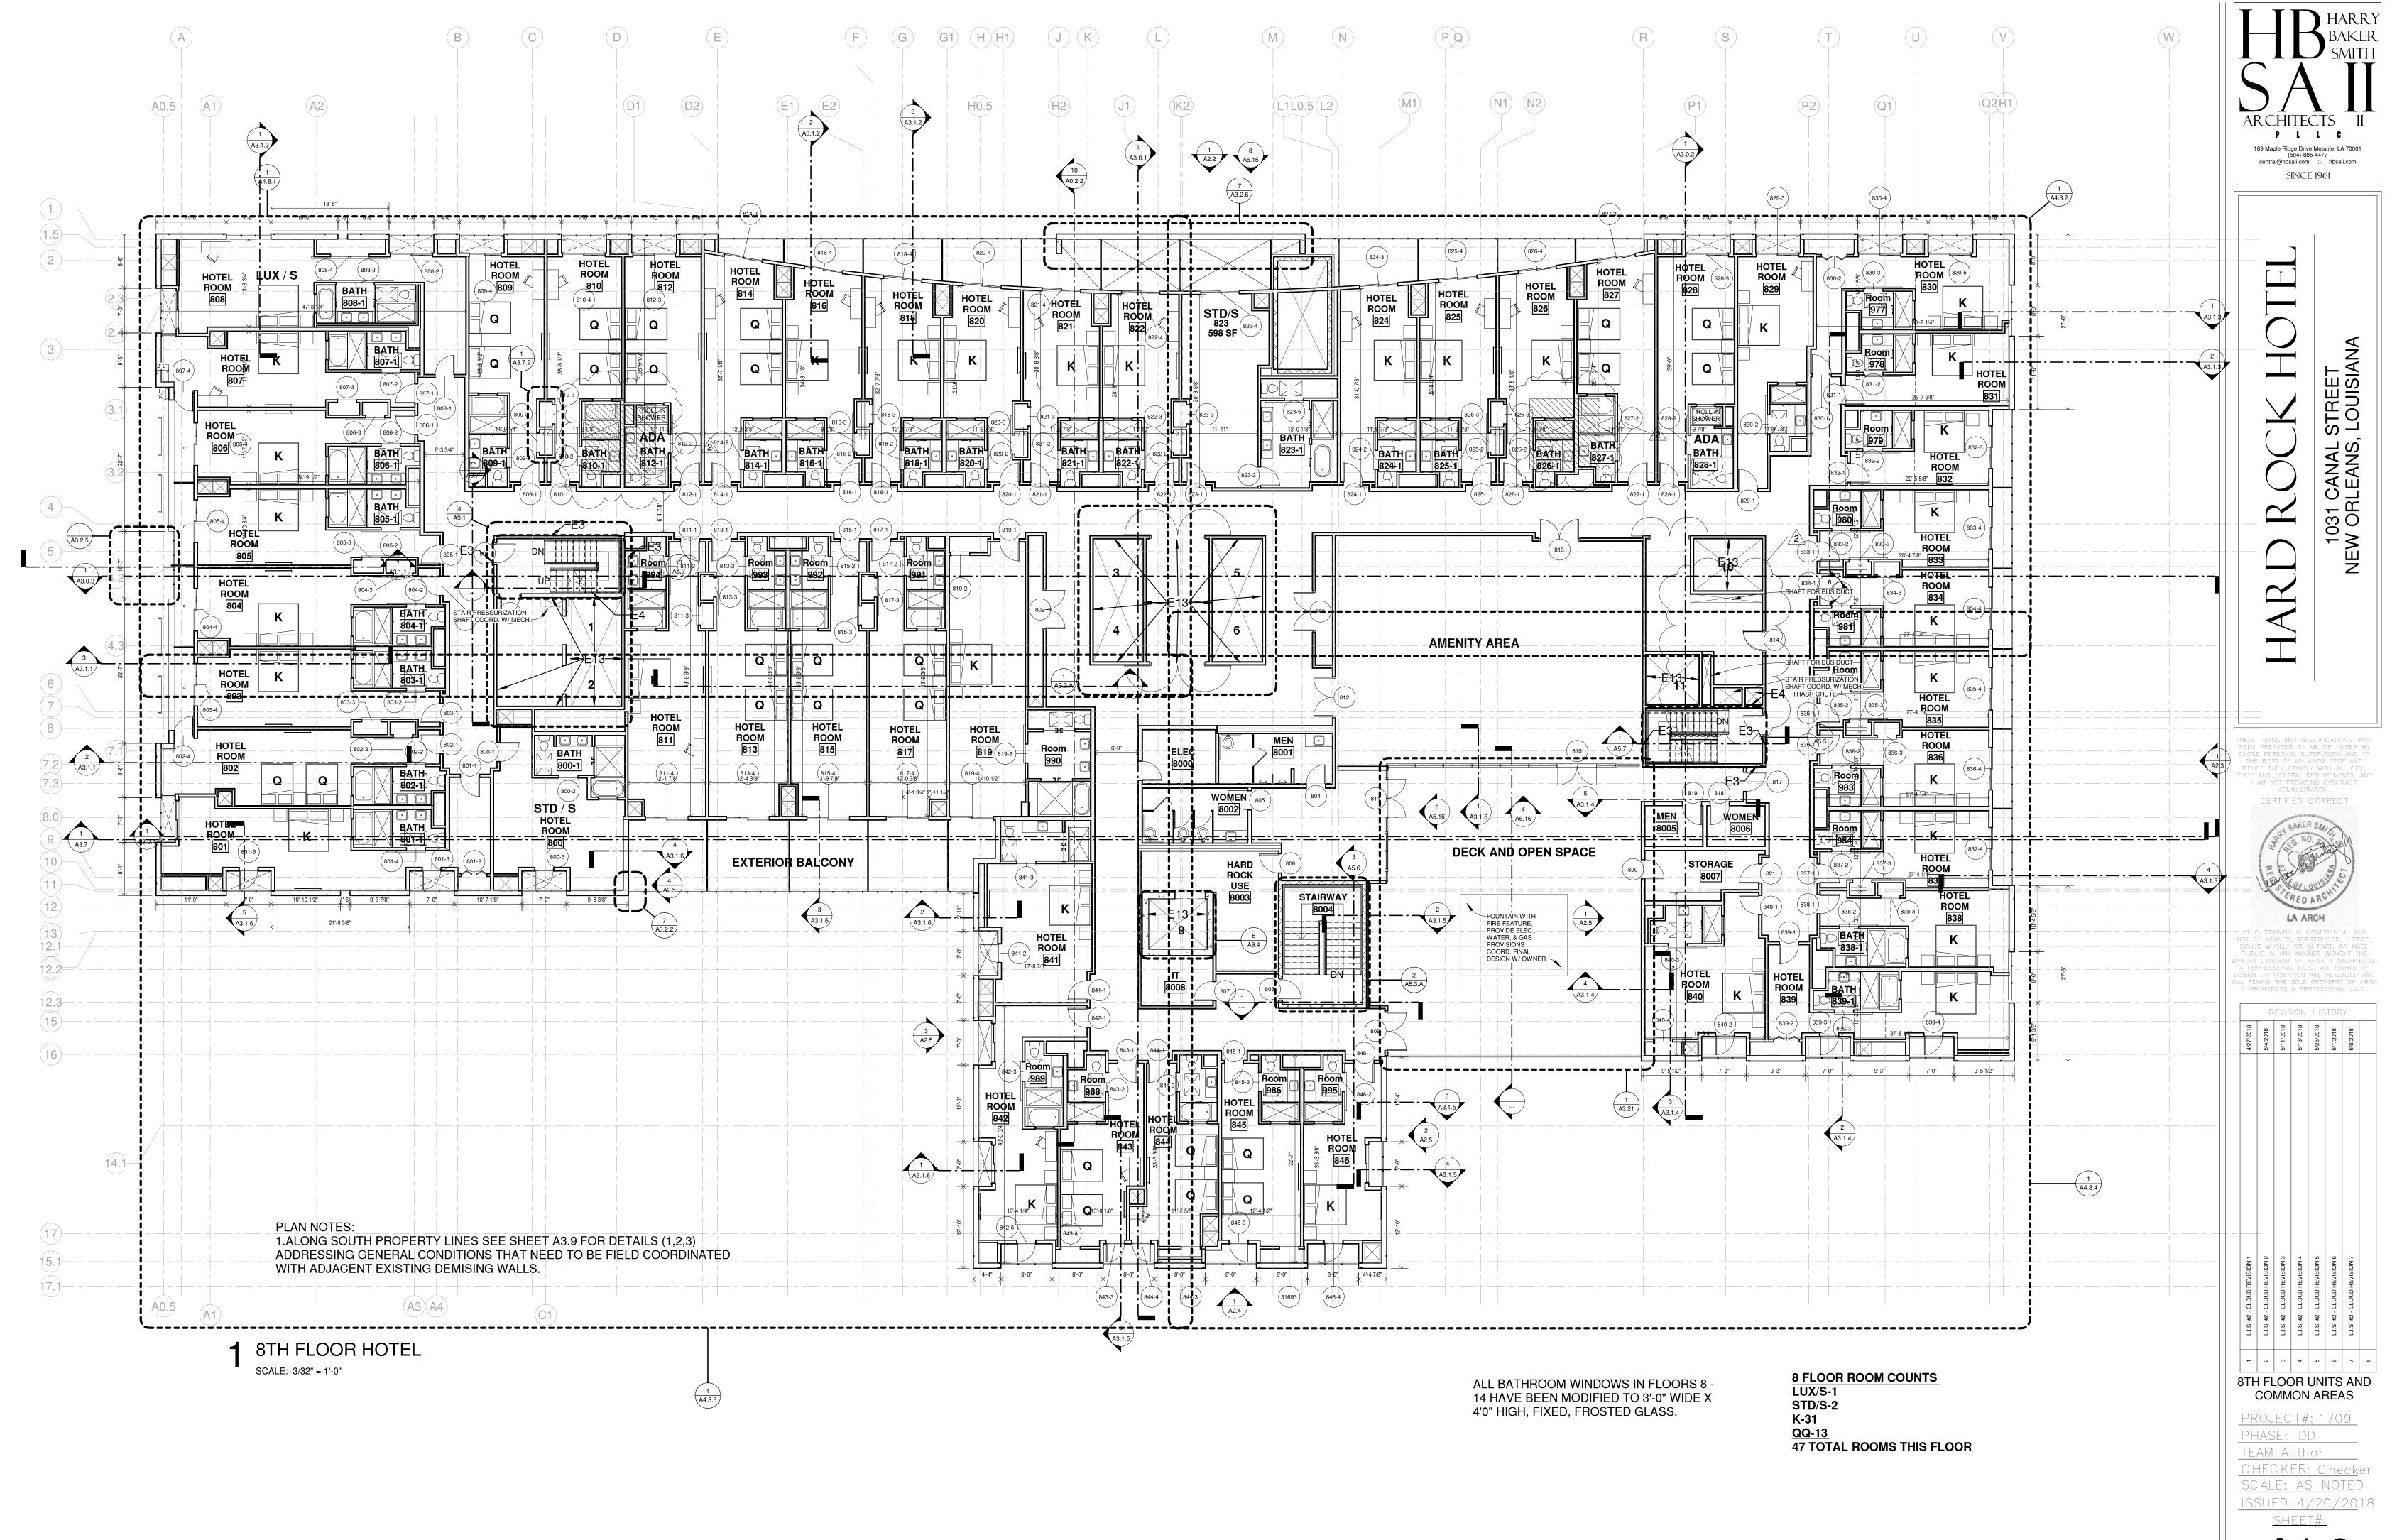


|           | R        | EVIS      | NOI       | HIS       | TOR      | Υ        |  |
|-----------|----------|-----------|-----------|-----------|----------|----------|--|
| 4/27/2018 | 5/4/2018 | 5/11/2018 | 5/18/2018 | 5/25/2018 | 6/1/2018 | 6/8/2018 |  |
|           |          |           |           |           |          |          |  |
|           |          |           |           |           |          |          |  |
L.I.S. #2 - CLOUD REVISION 1
L.I.S. #2 - CLOUD REVISION 2
L.I.S. #2 - CLOUD REVISION 4
L.I.S. #2 - CLOUD REVISION 5
L.I.S. #2 - CLOUD REVISION 6
L.I.S. #2 - CLOUD REVISION 6
L.I.S. #2 - CLOUD REVISION 7

8TH FLOOR RCP

PROJECT#: 1709
PHASE: DD
TEAM: Author
CHECKER: Checker
SCALE: AS NOTED
ISSUED: 4/20/2018

A1.8-A

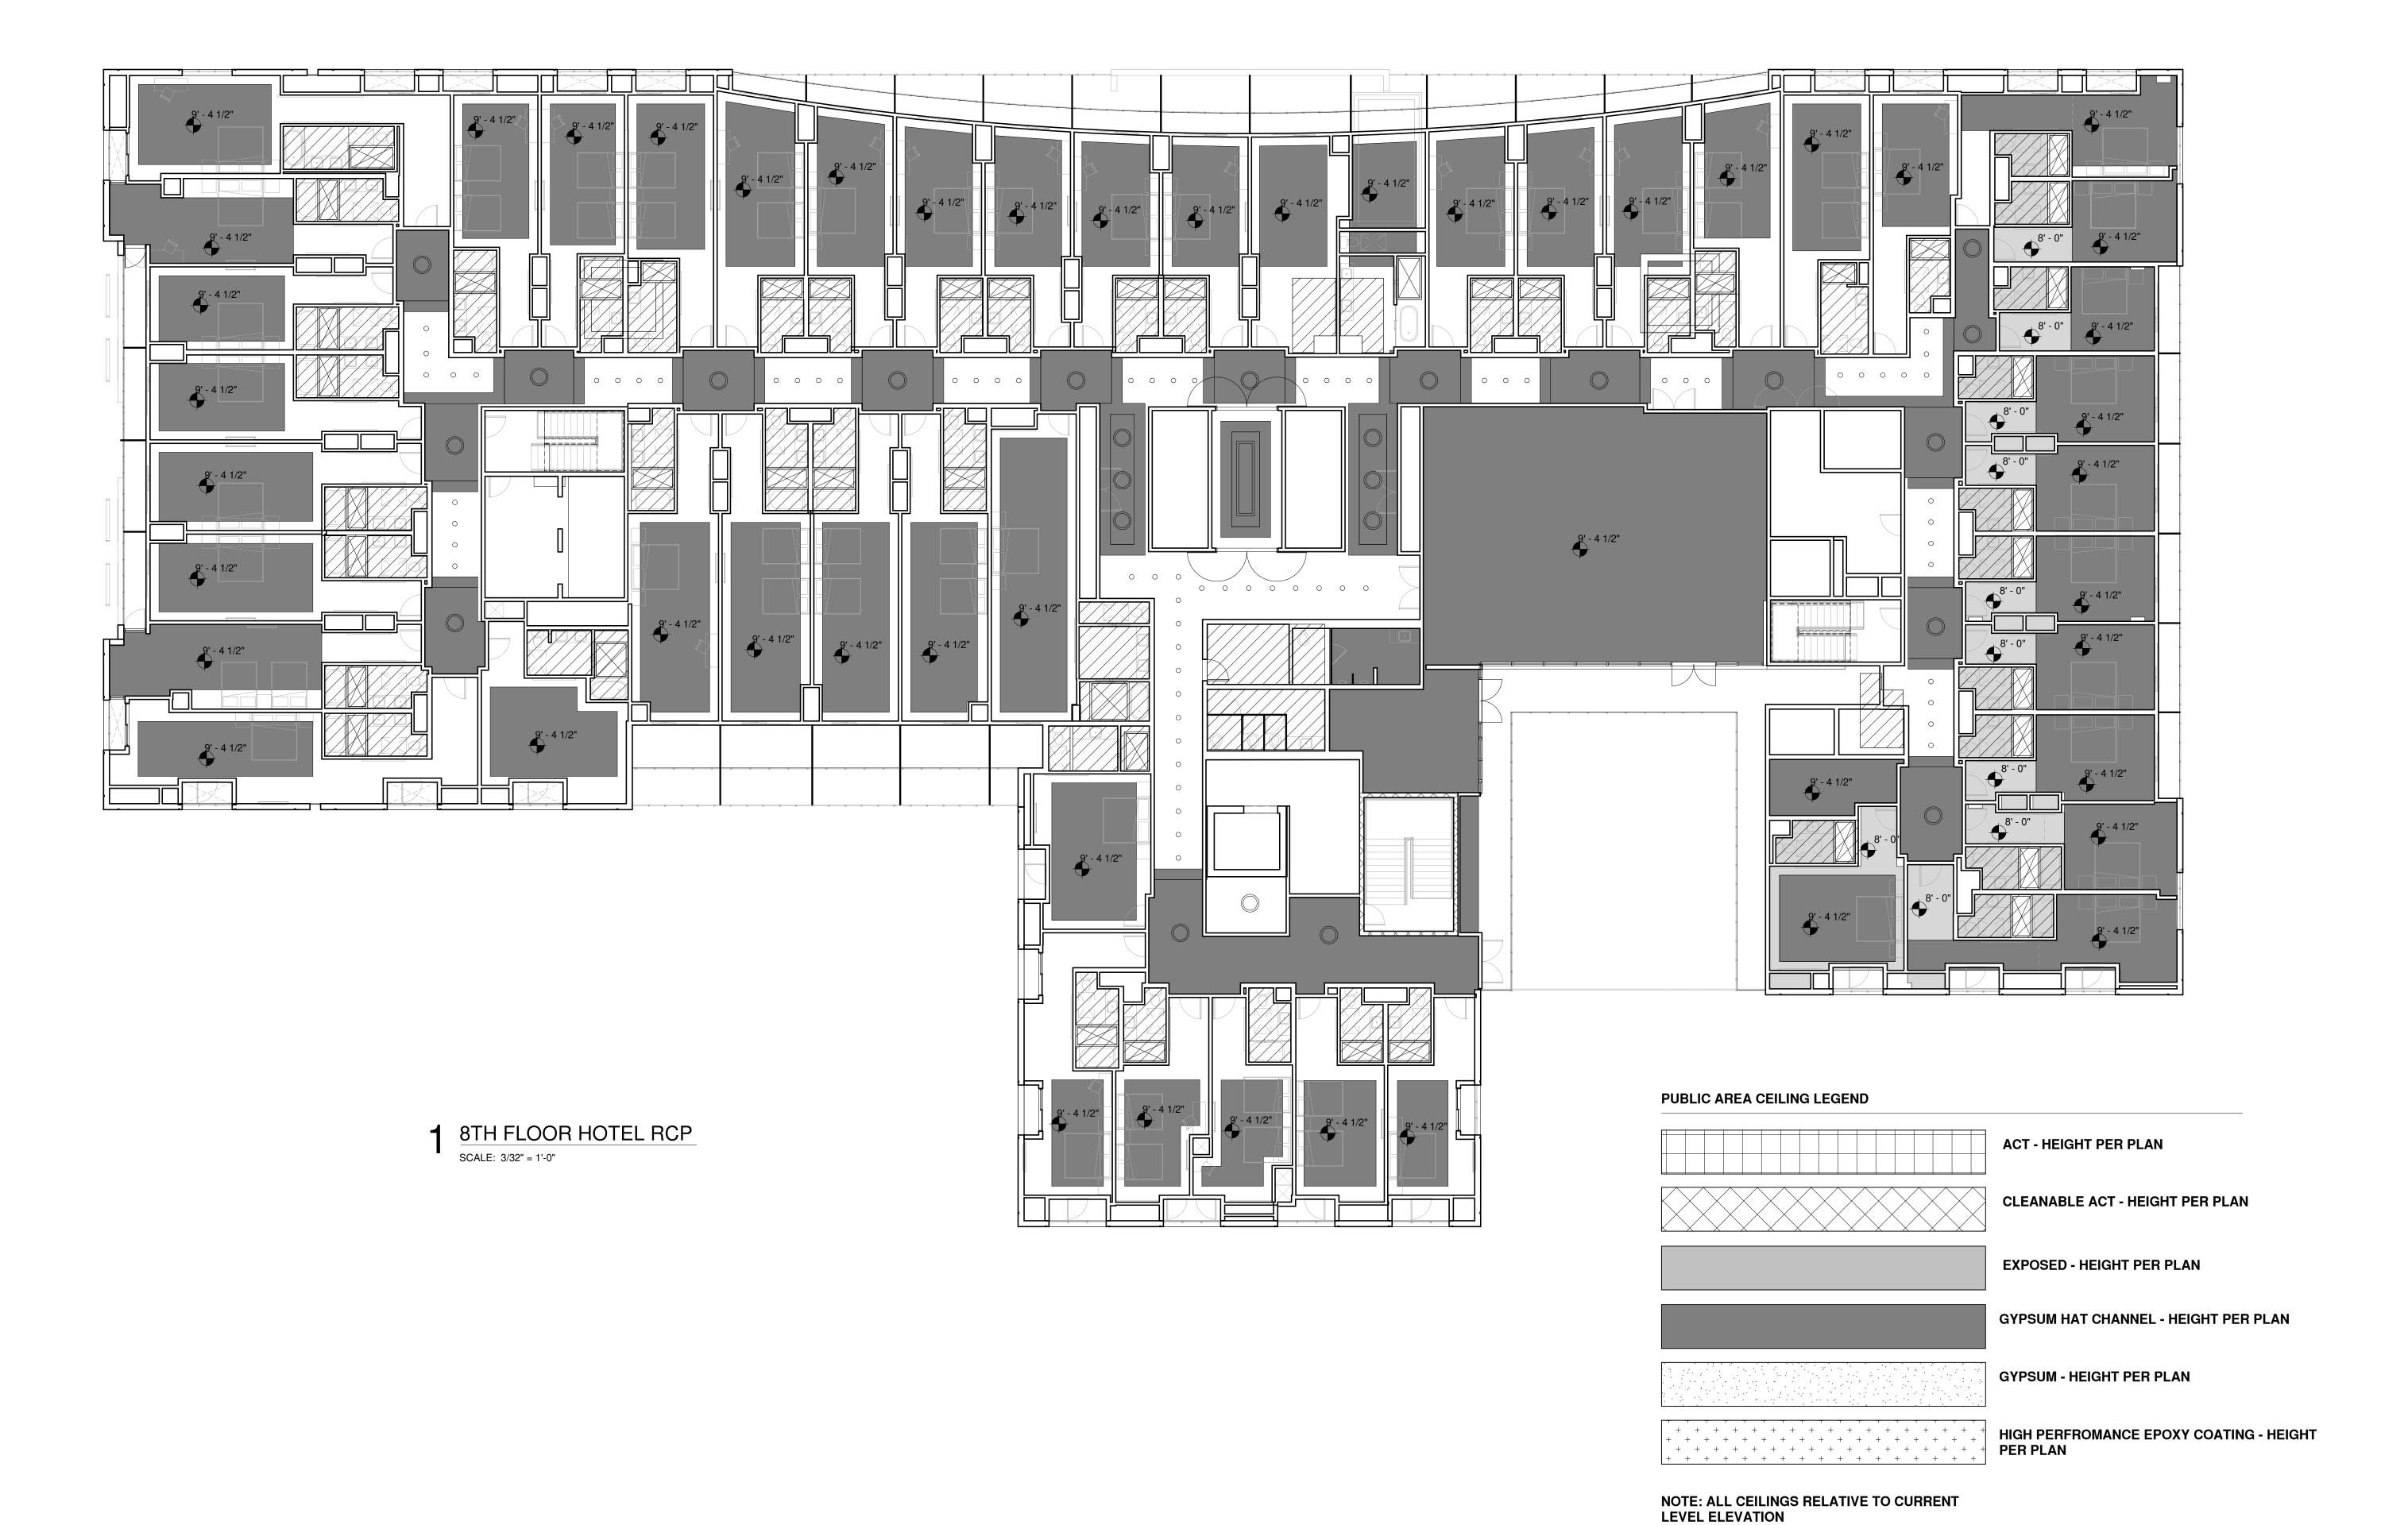

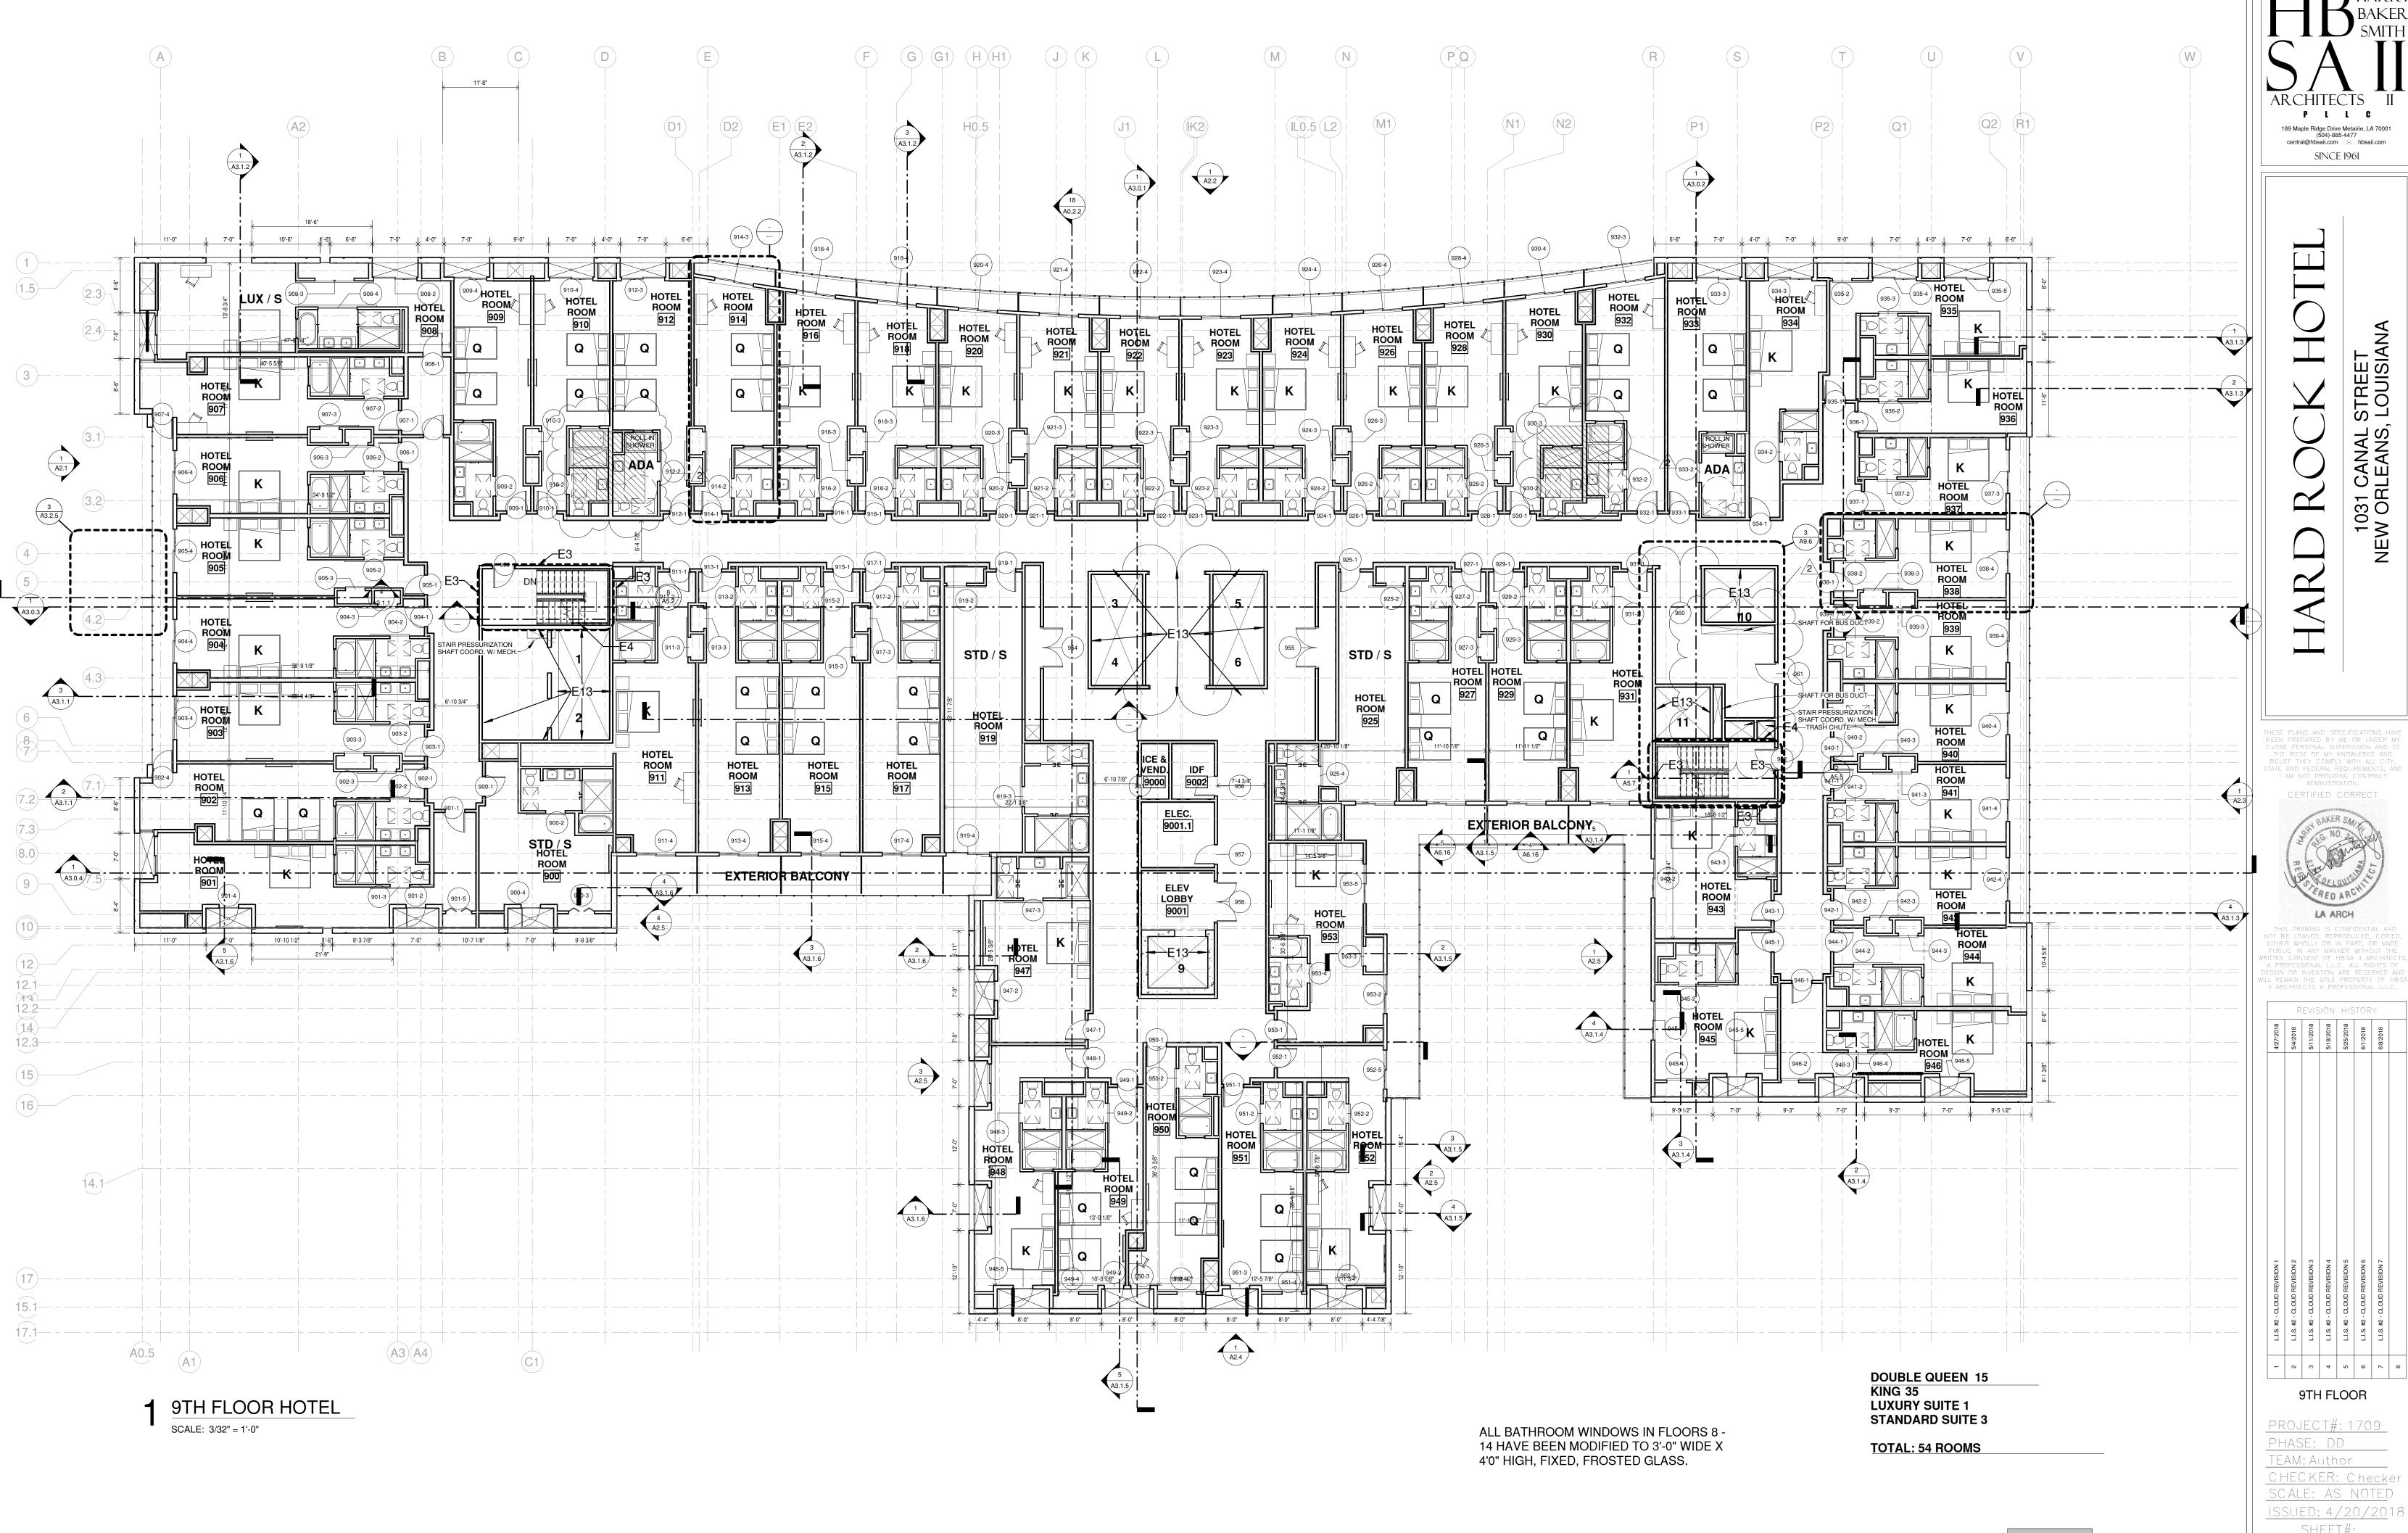



189 Maple Ridge Drive Metairie, LA 70001 (504)-885-4477 central@hbsaii.com :-: hbsaii.com SINCE 1961


1031 CANAL STREET NEW ORLEANS, LOUISIANA


9TH FLOOR


PROJECT#: 1709 PHASE: DD TEAM: Author HECKER: Checker SCALE: AS NOTED

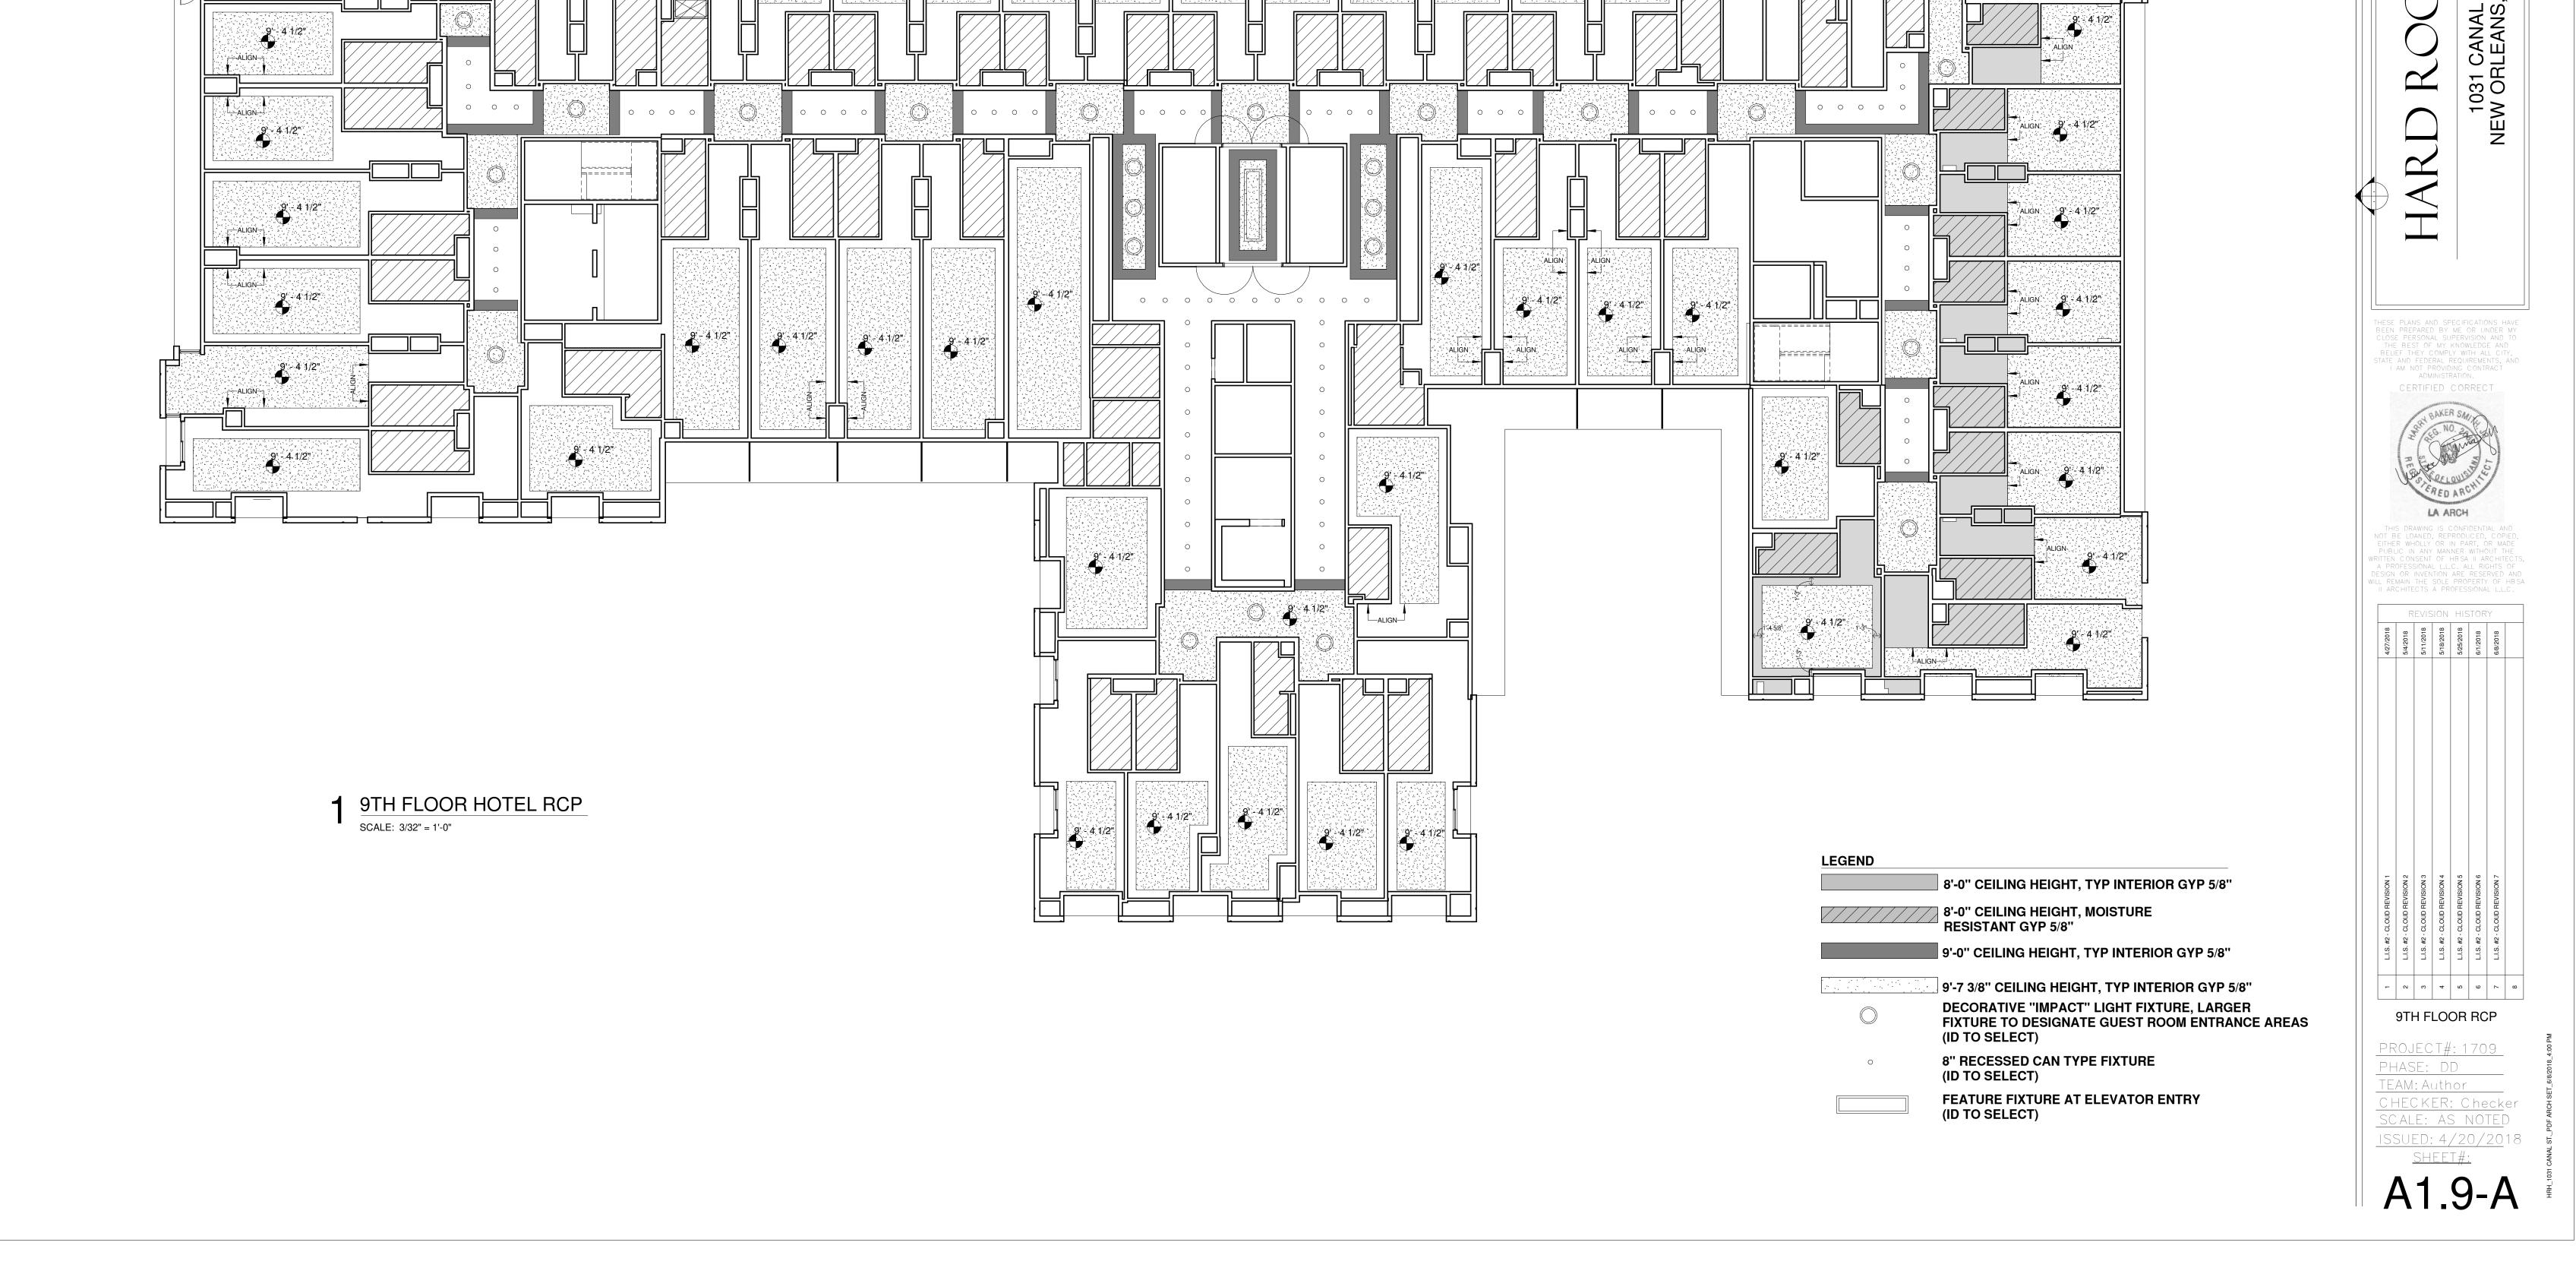


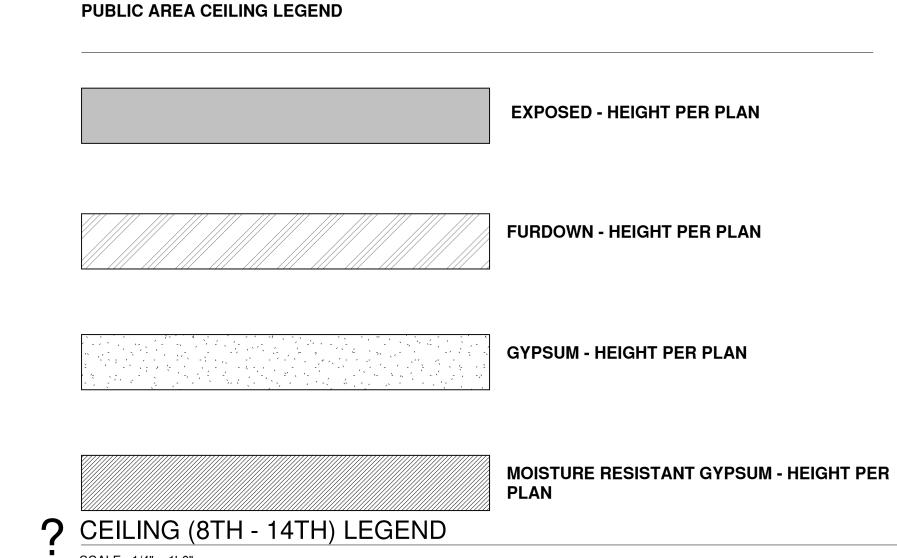


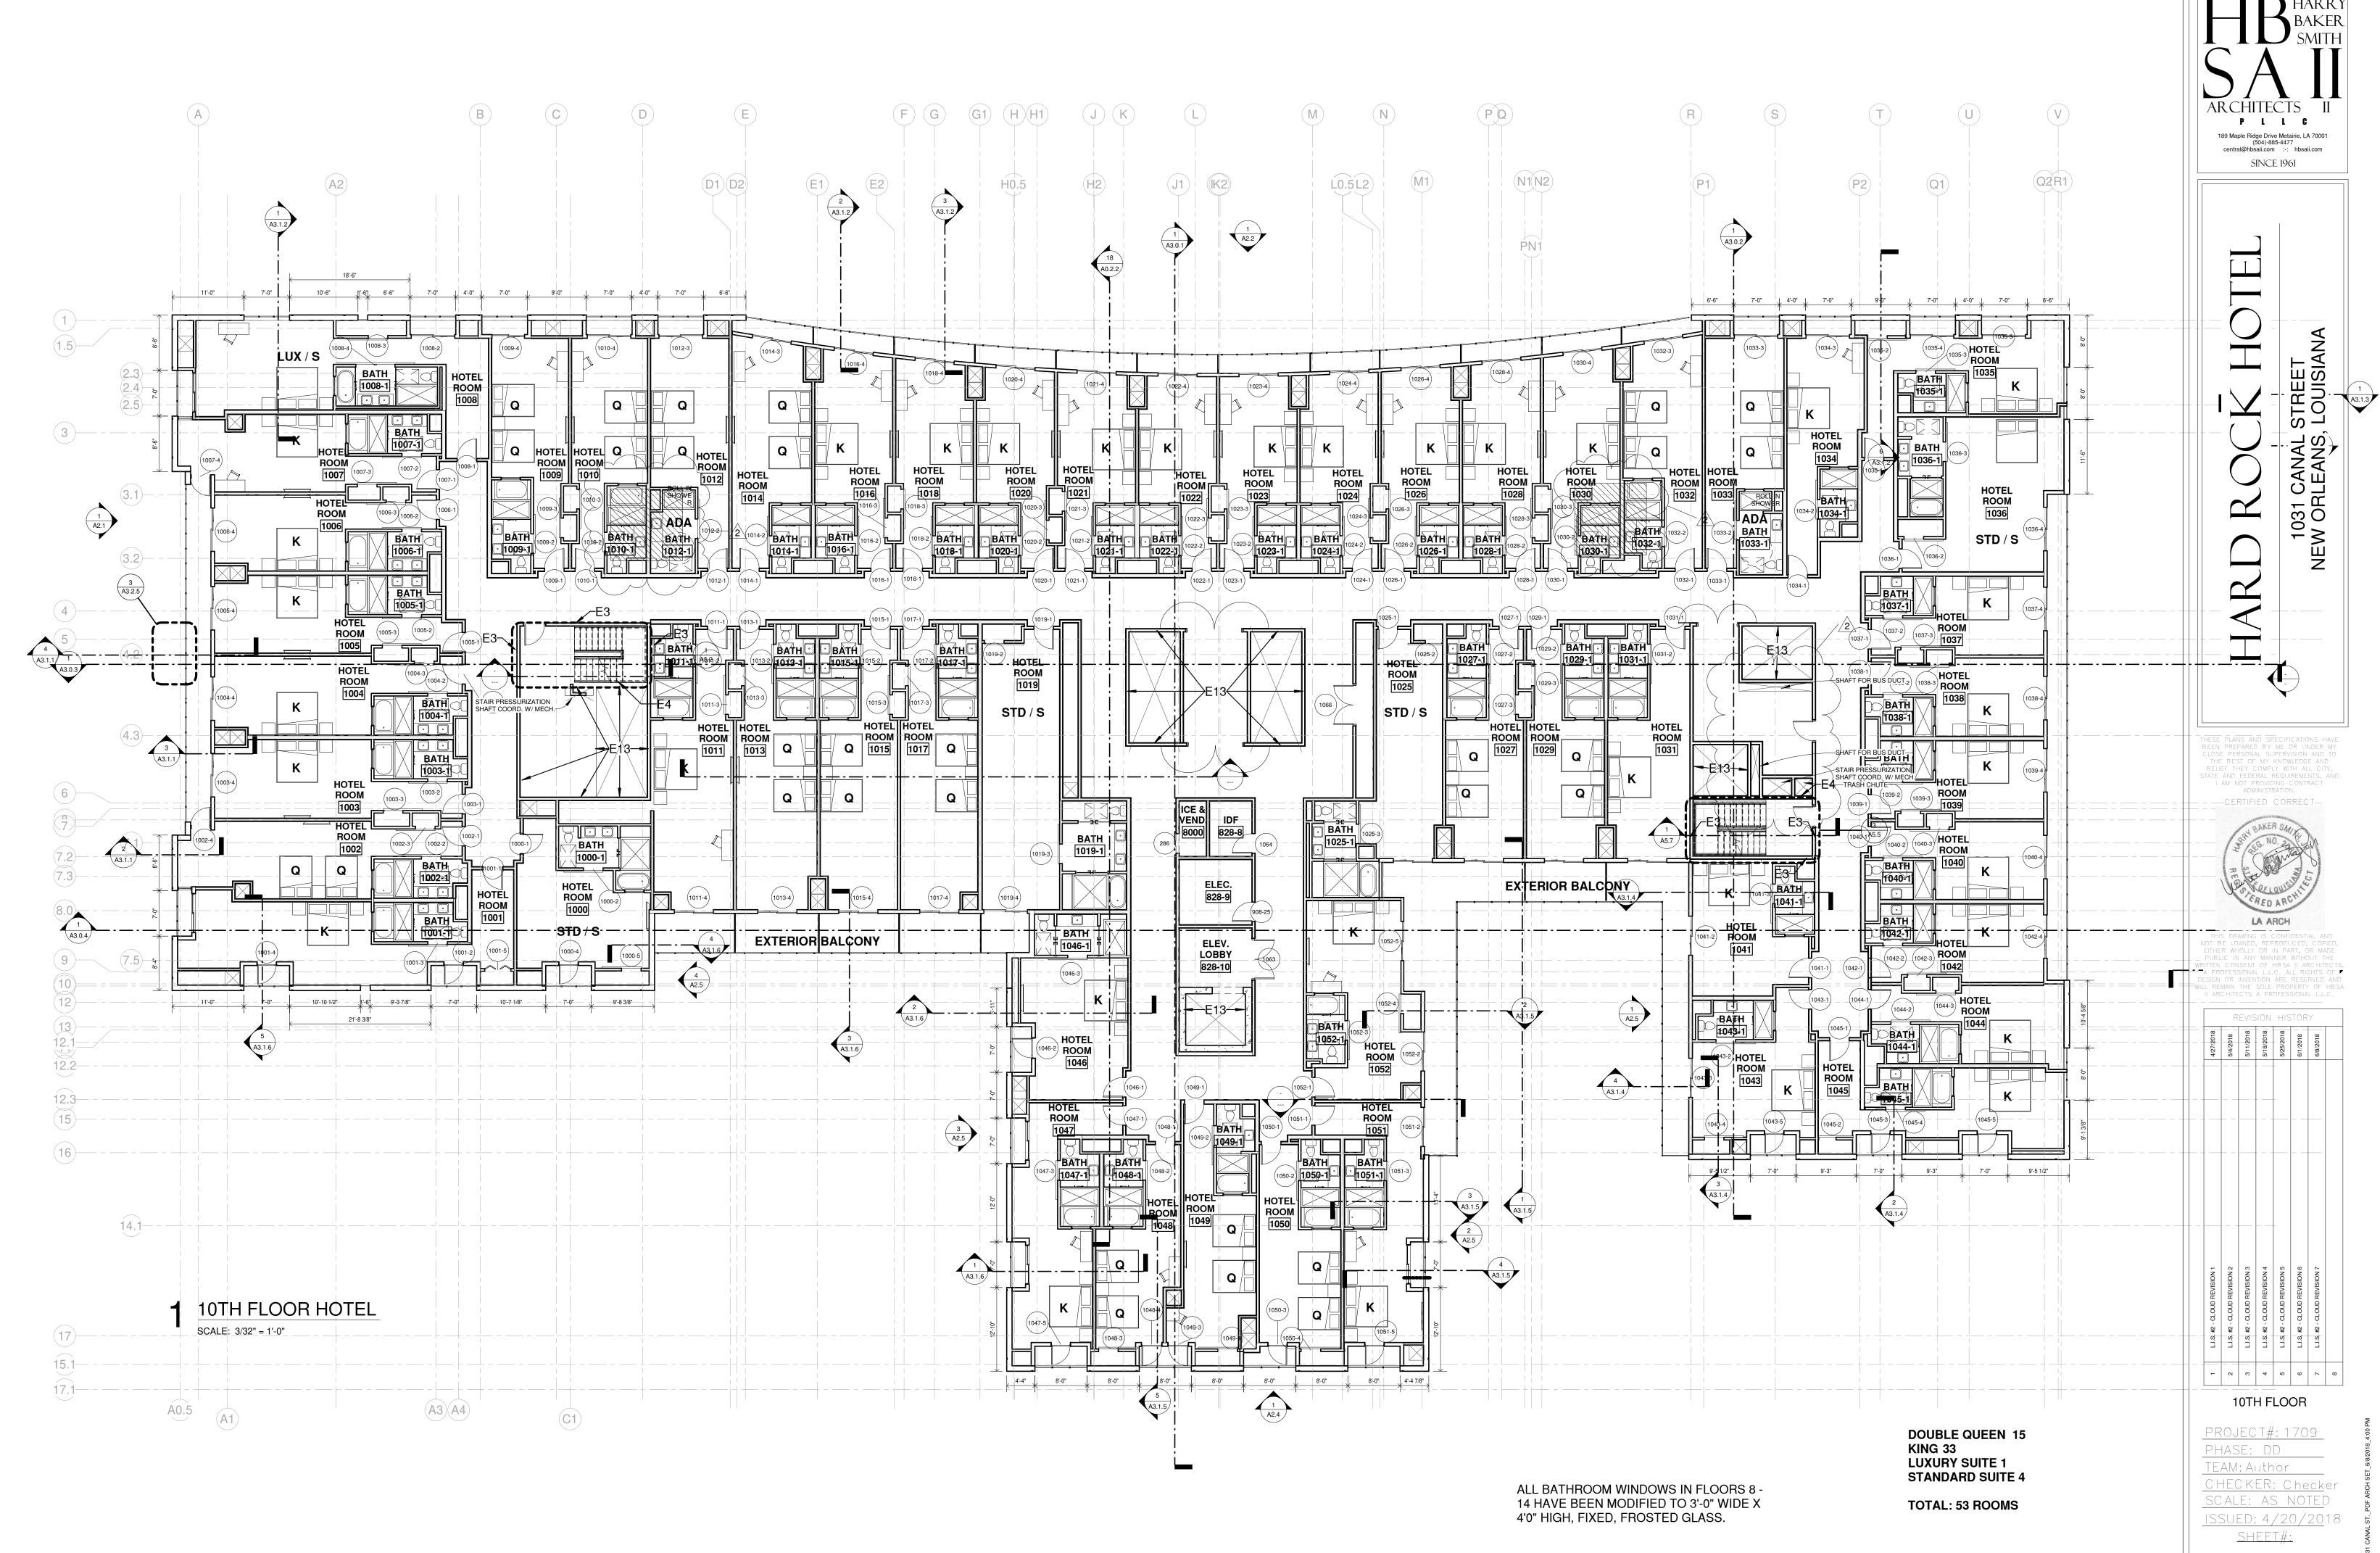


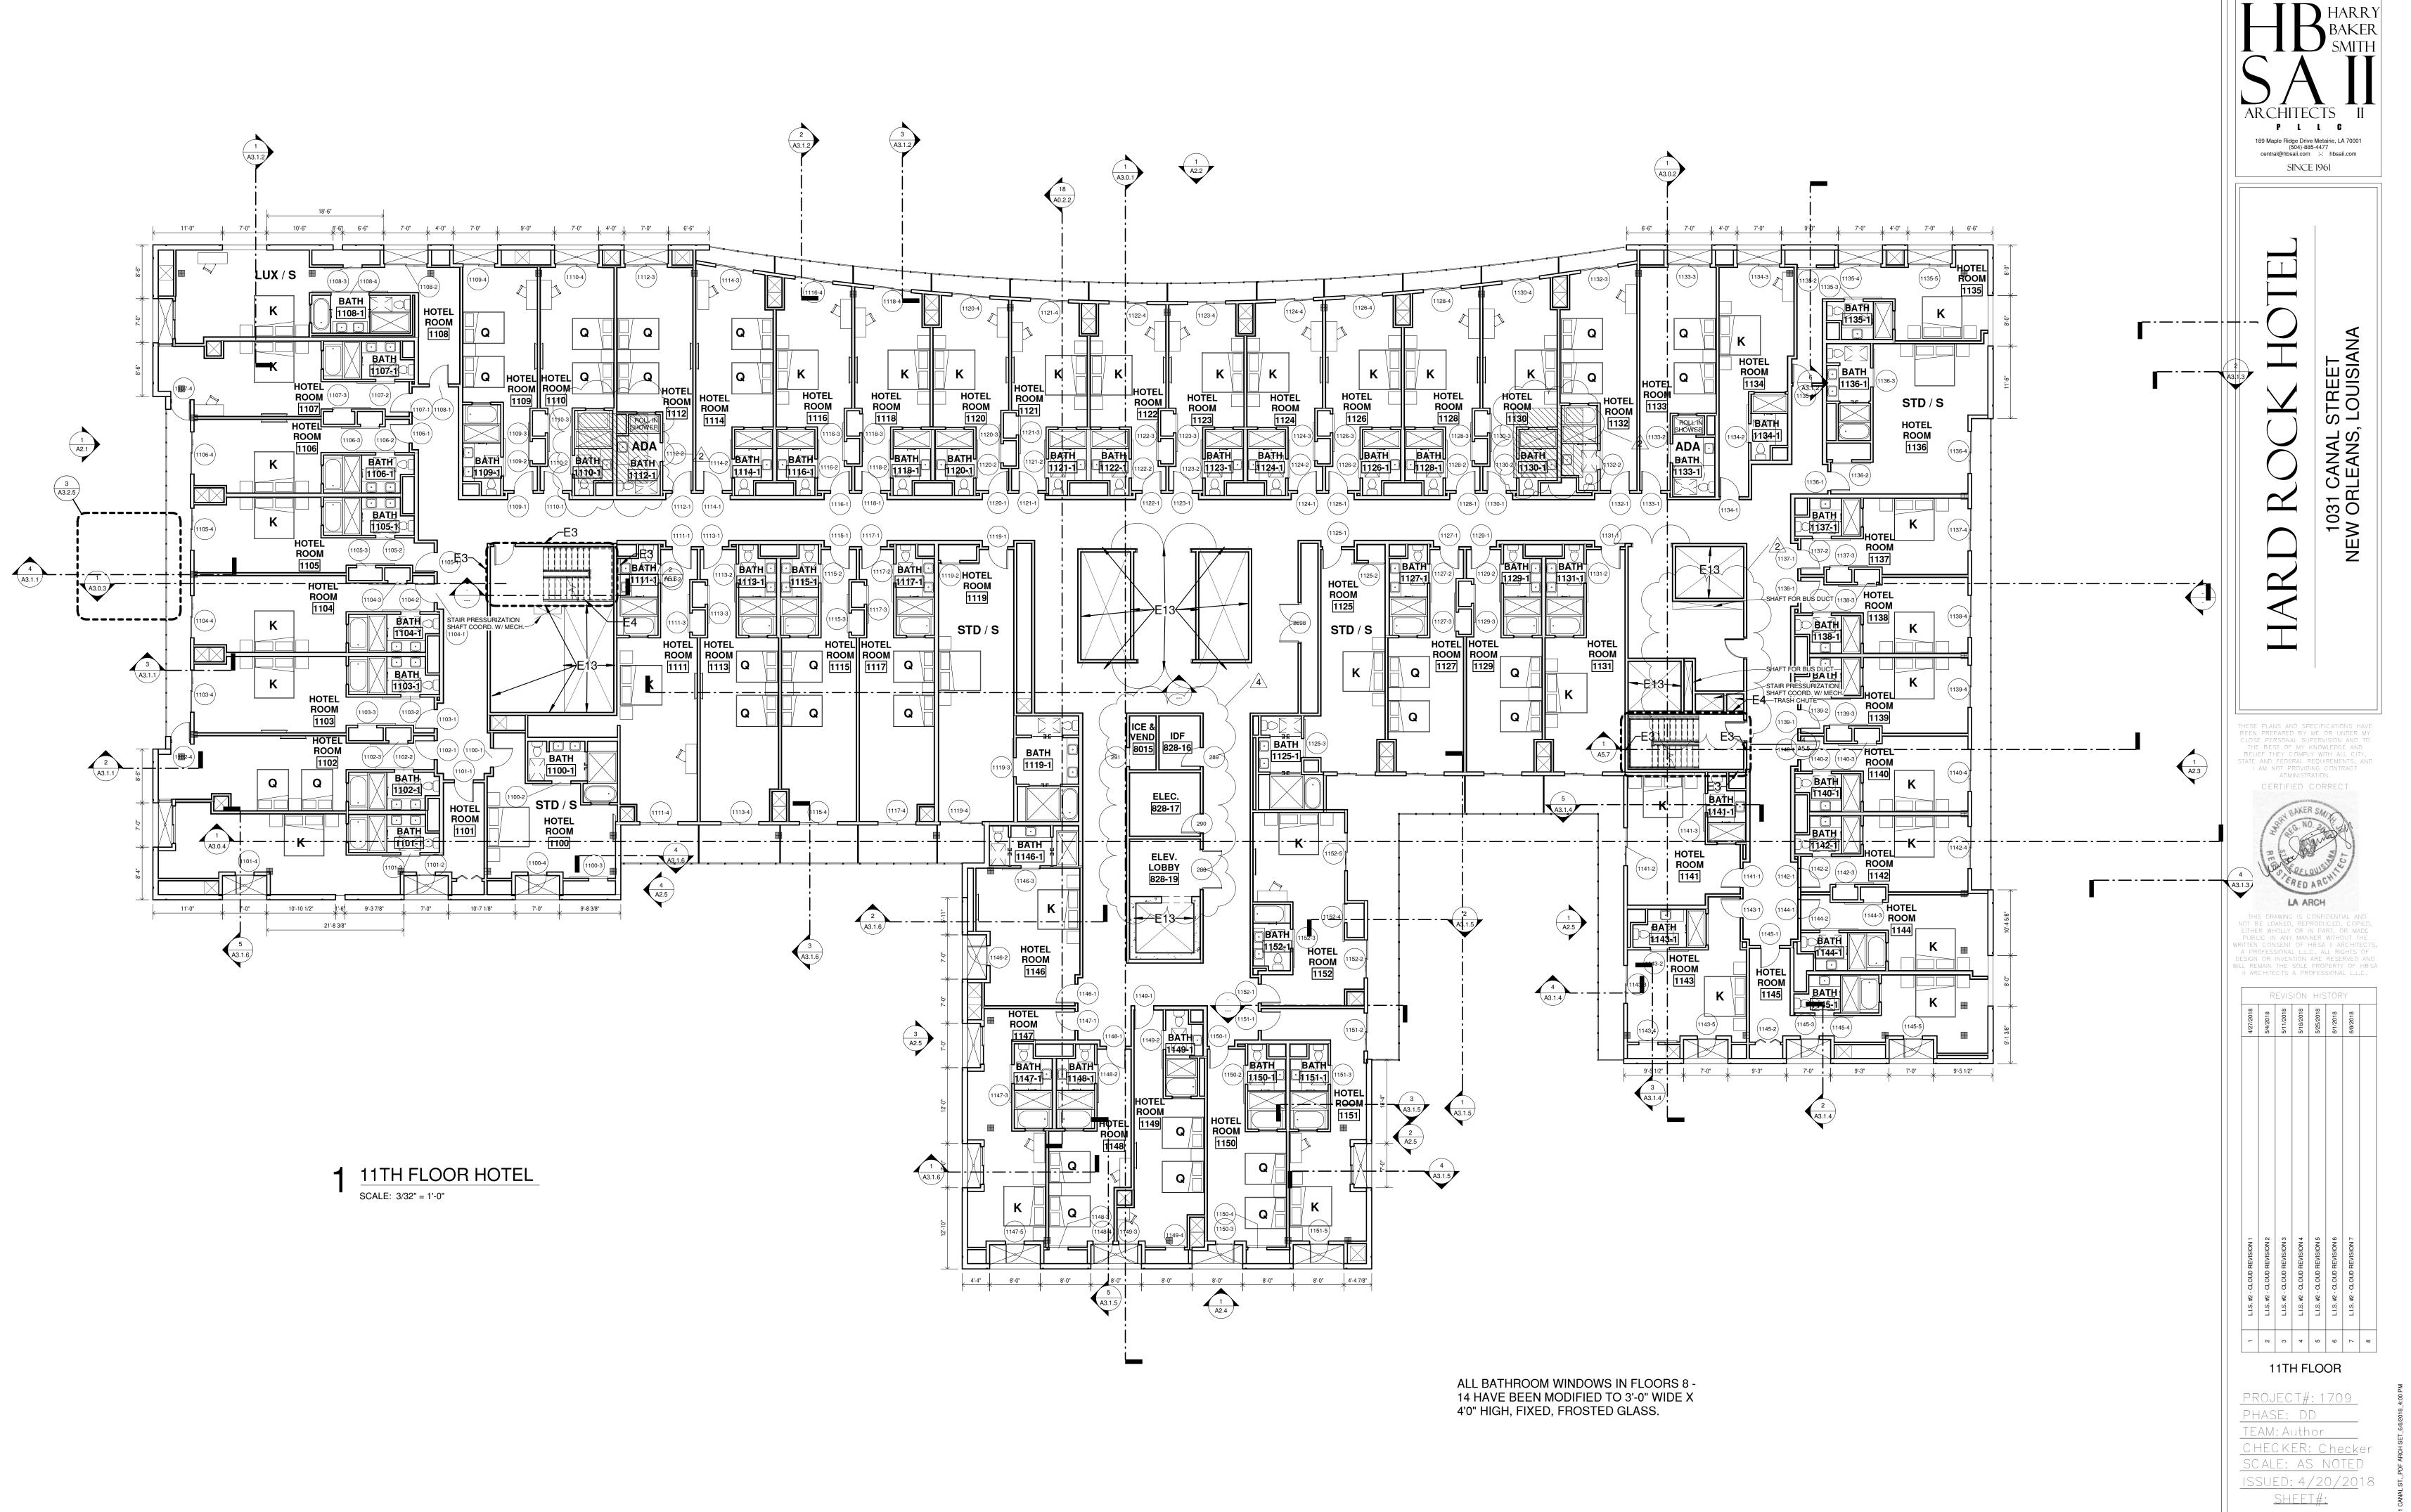


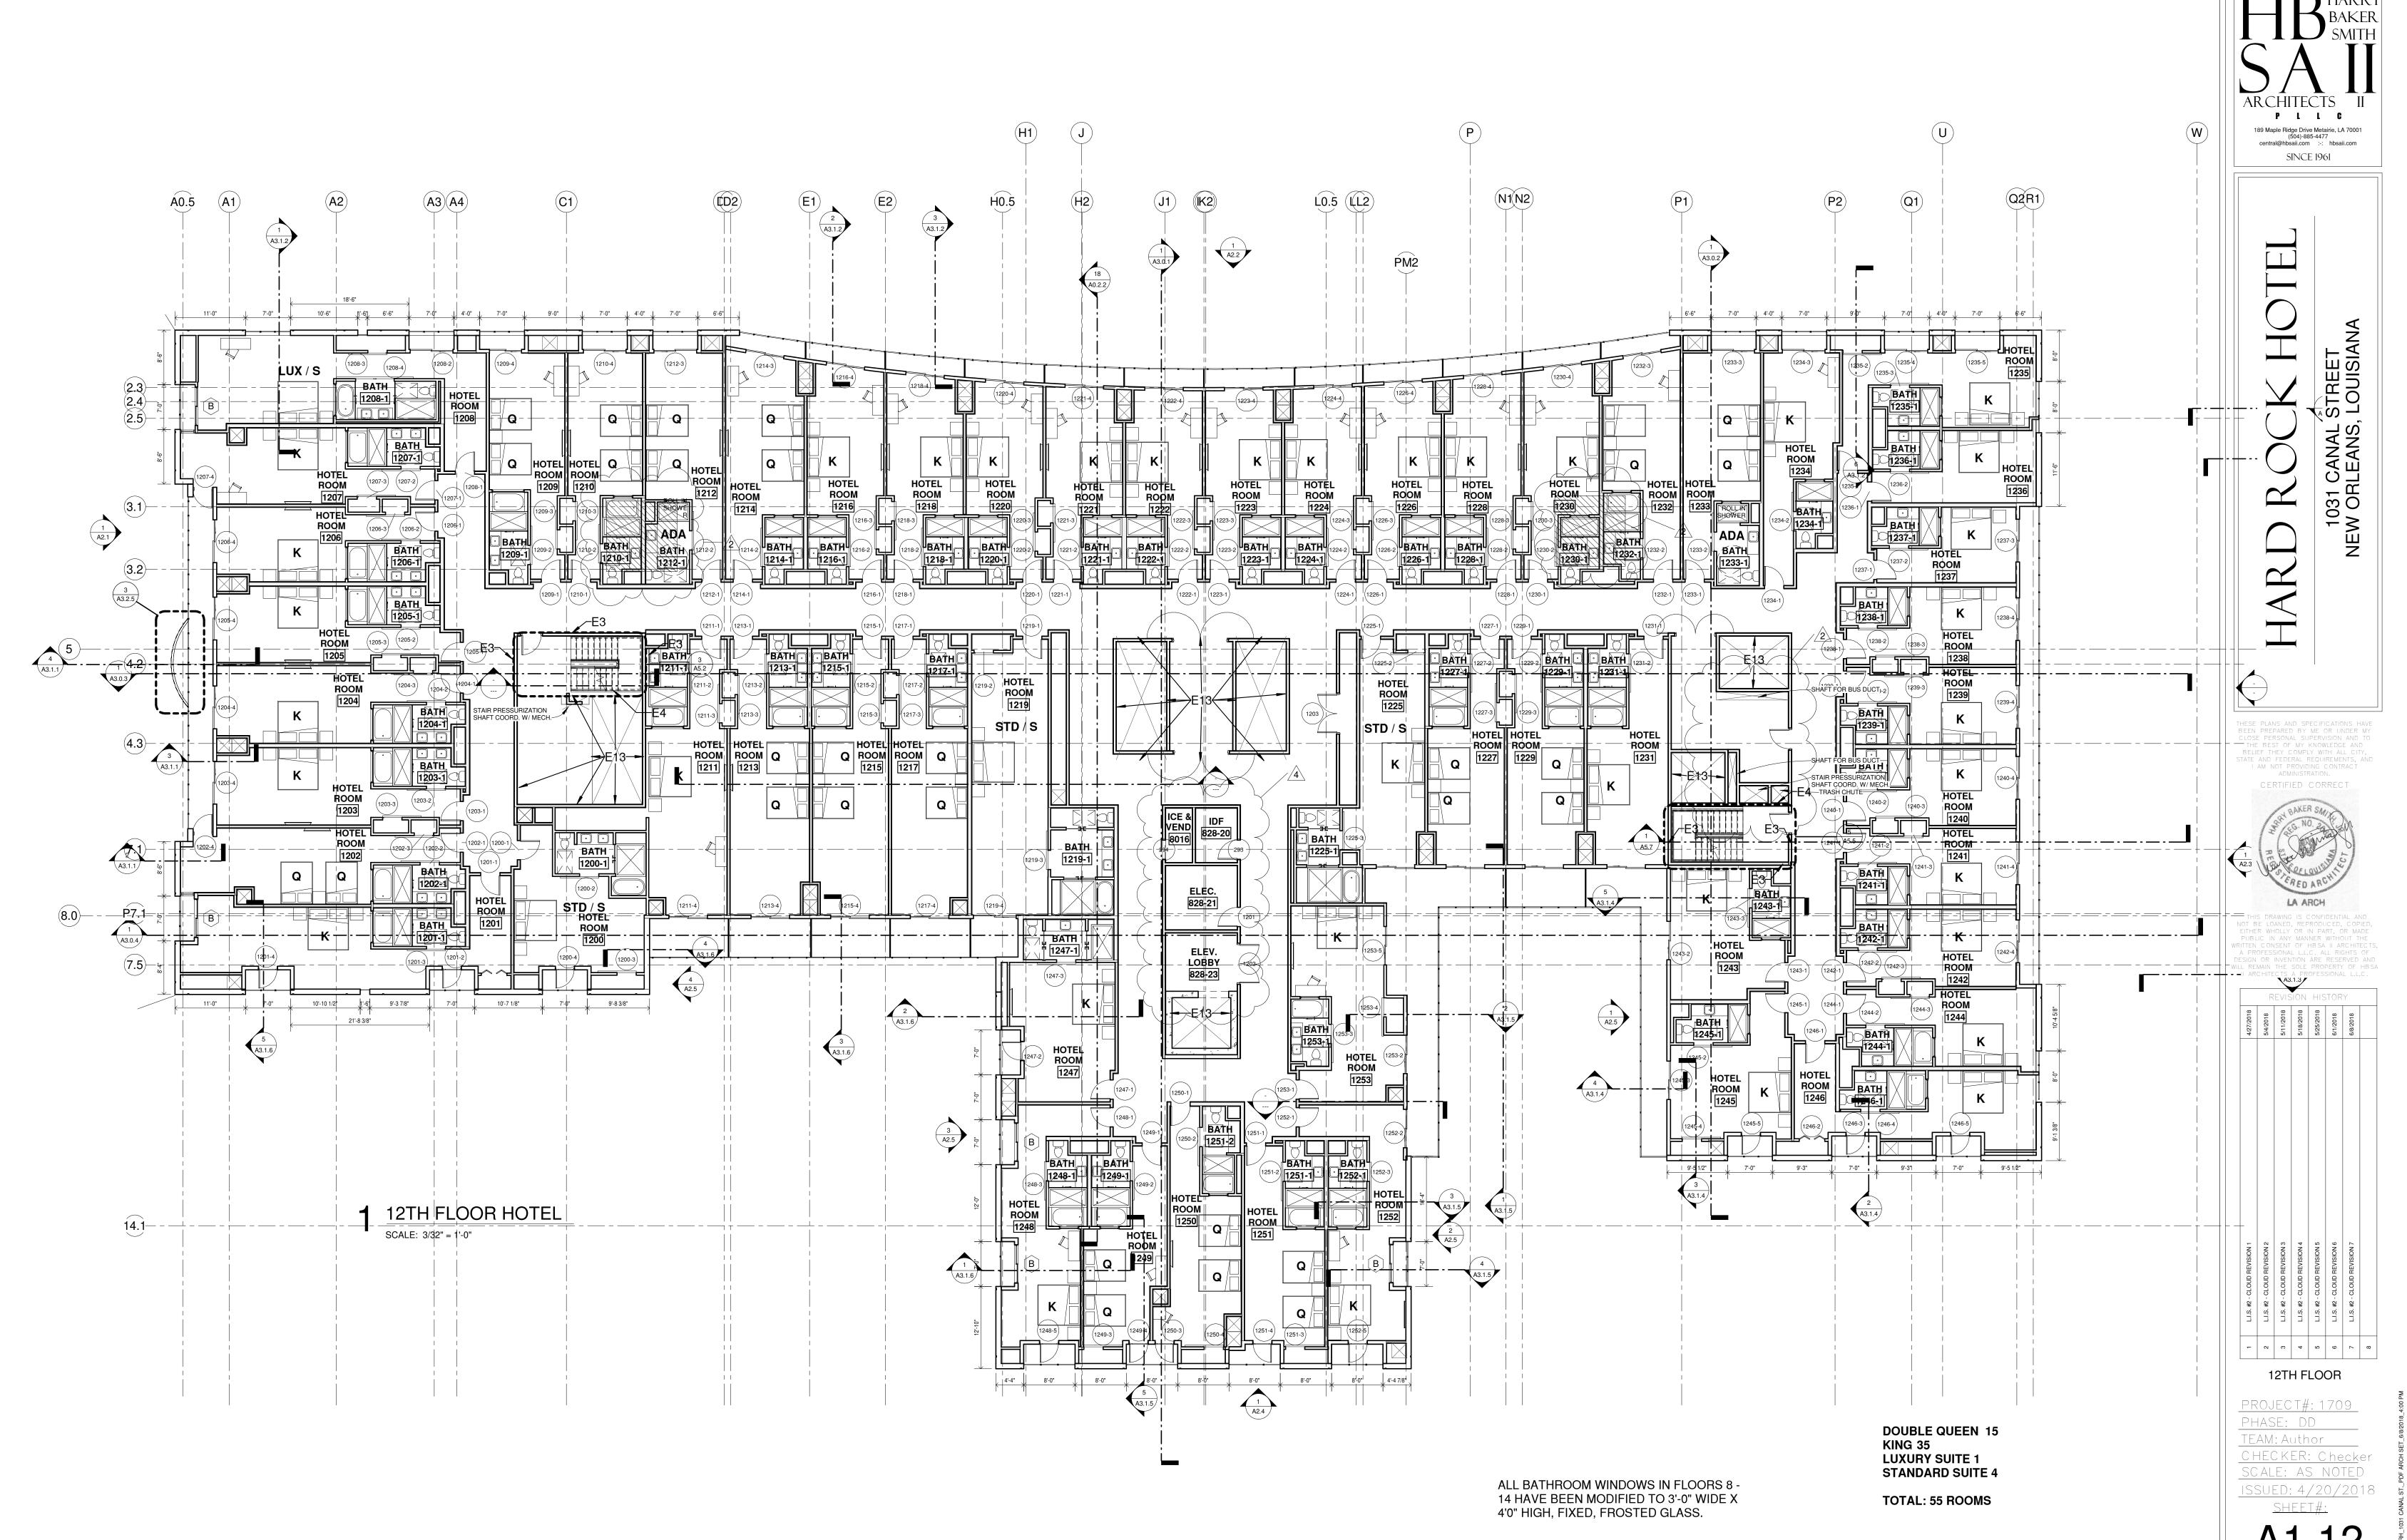


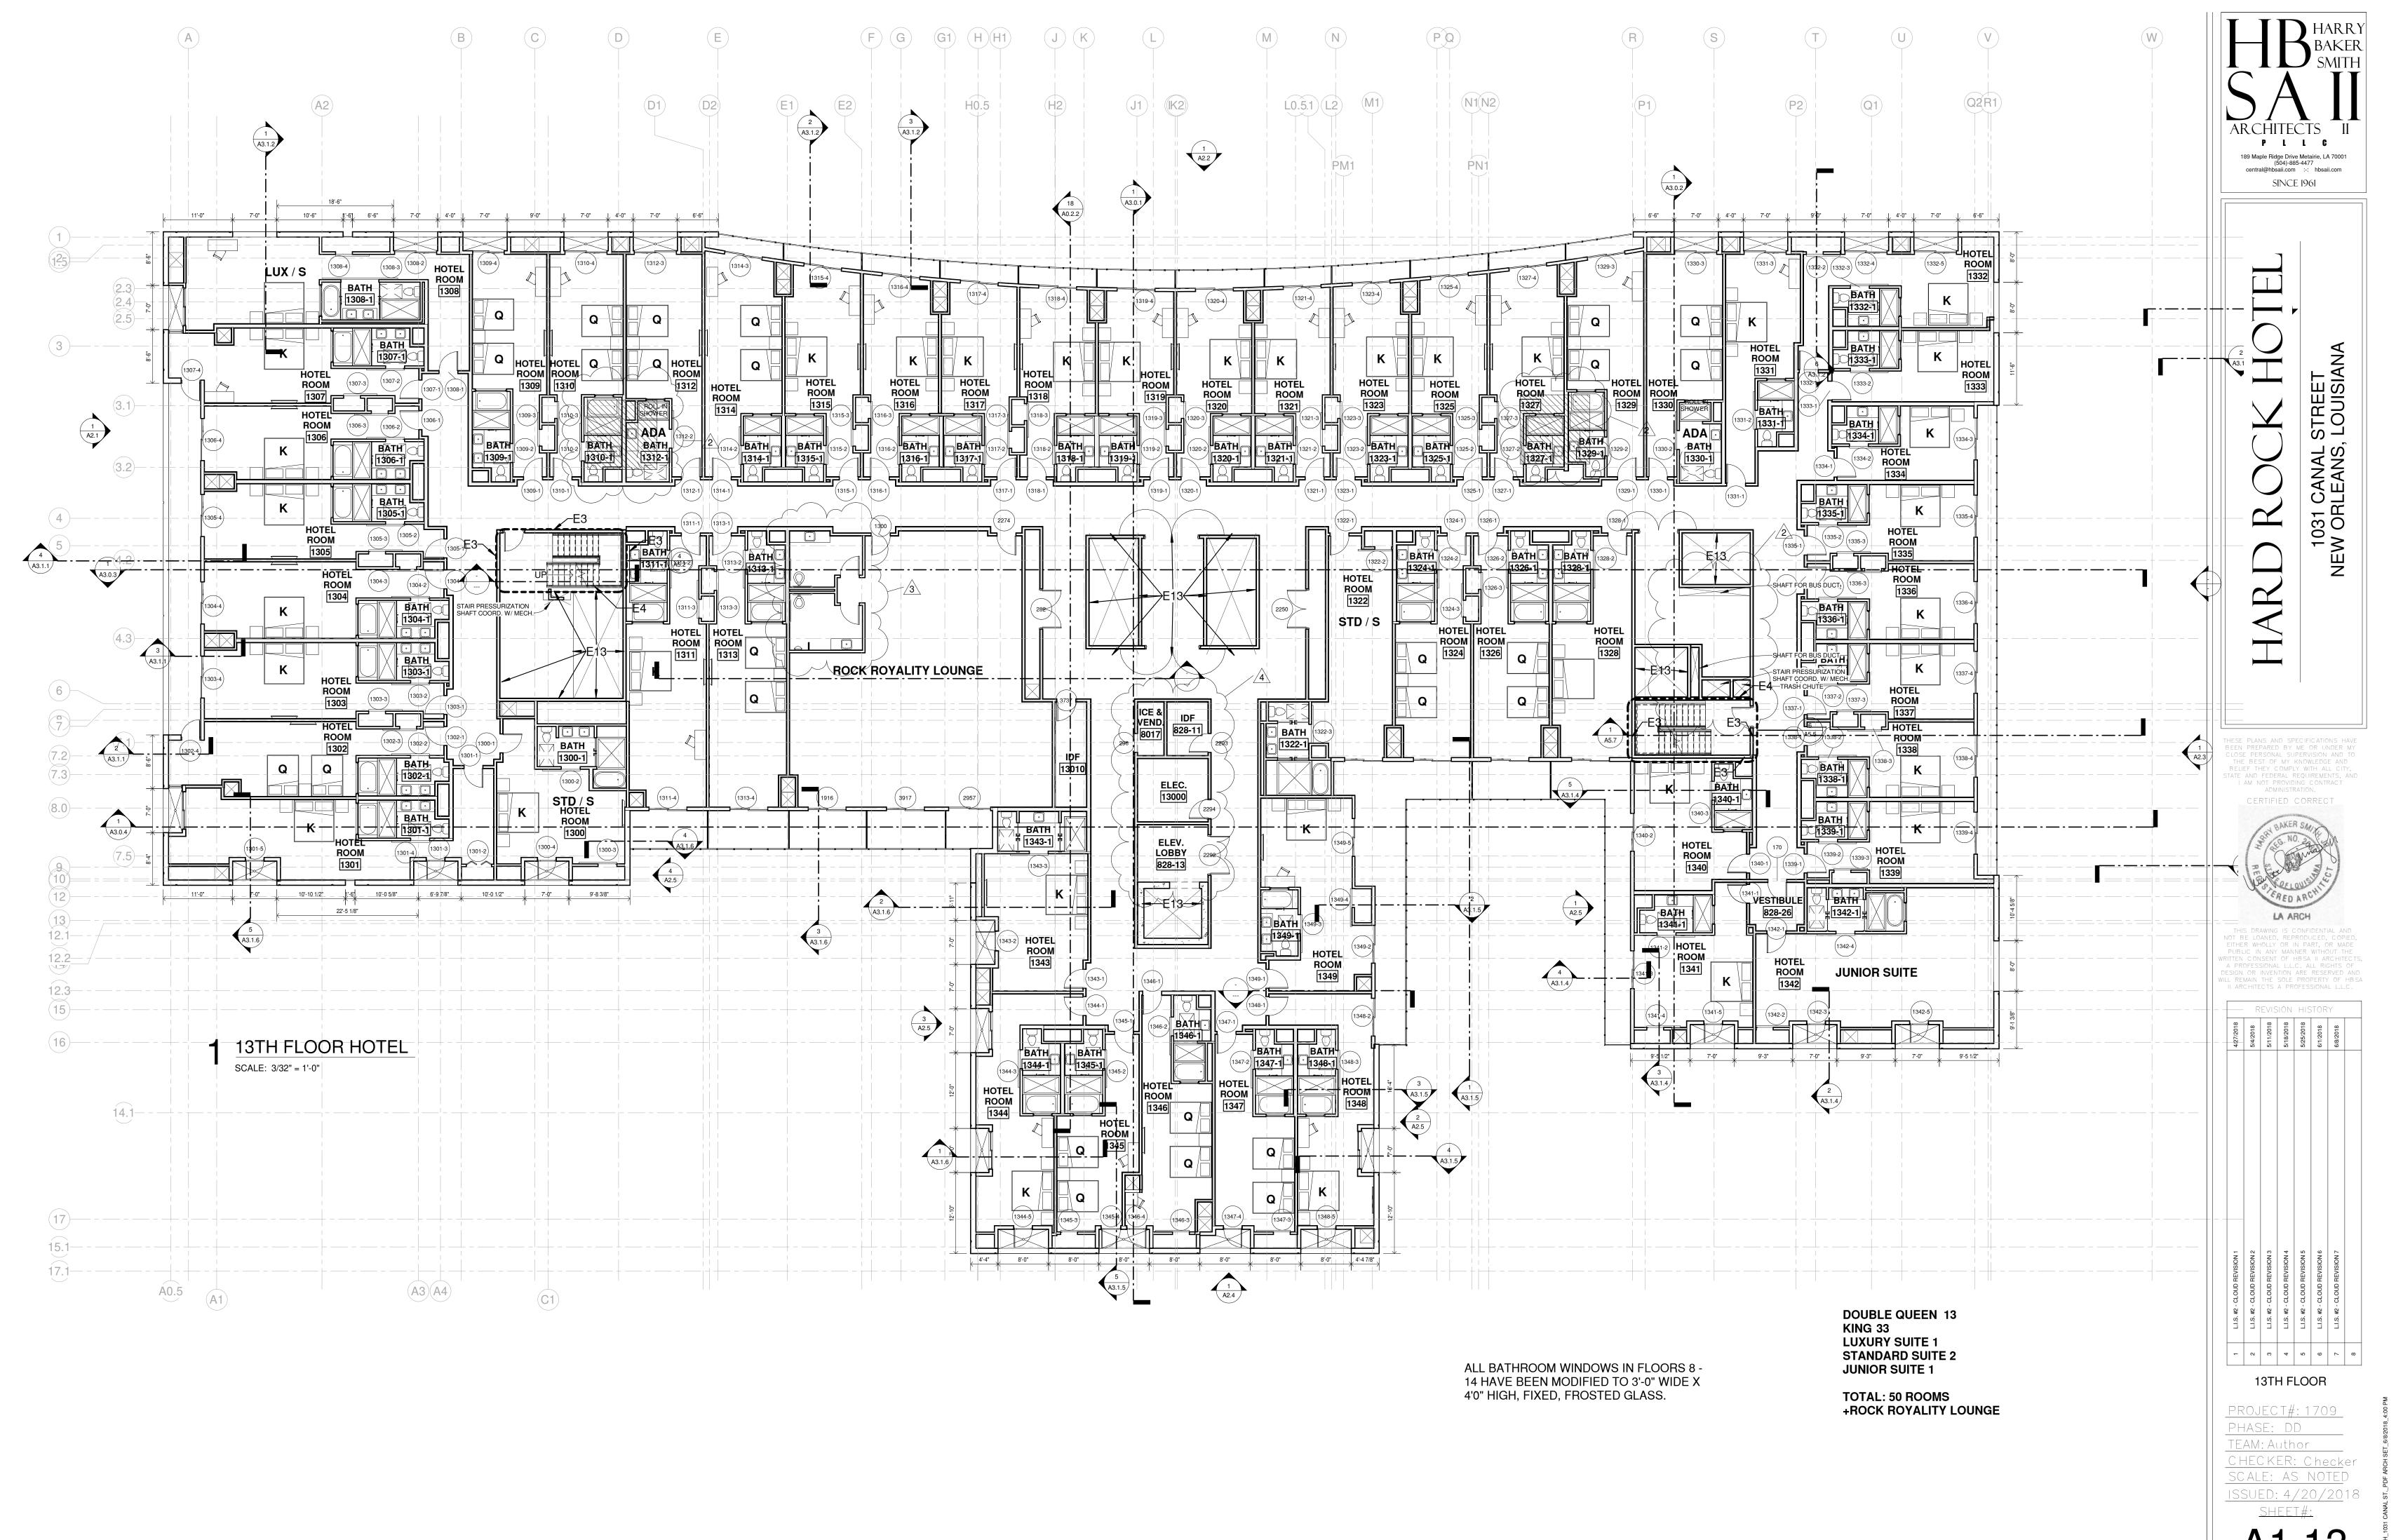

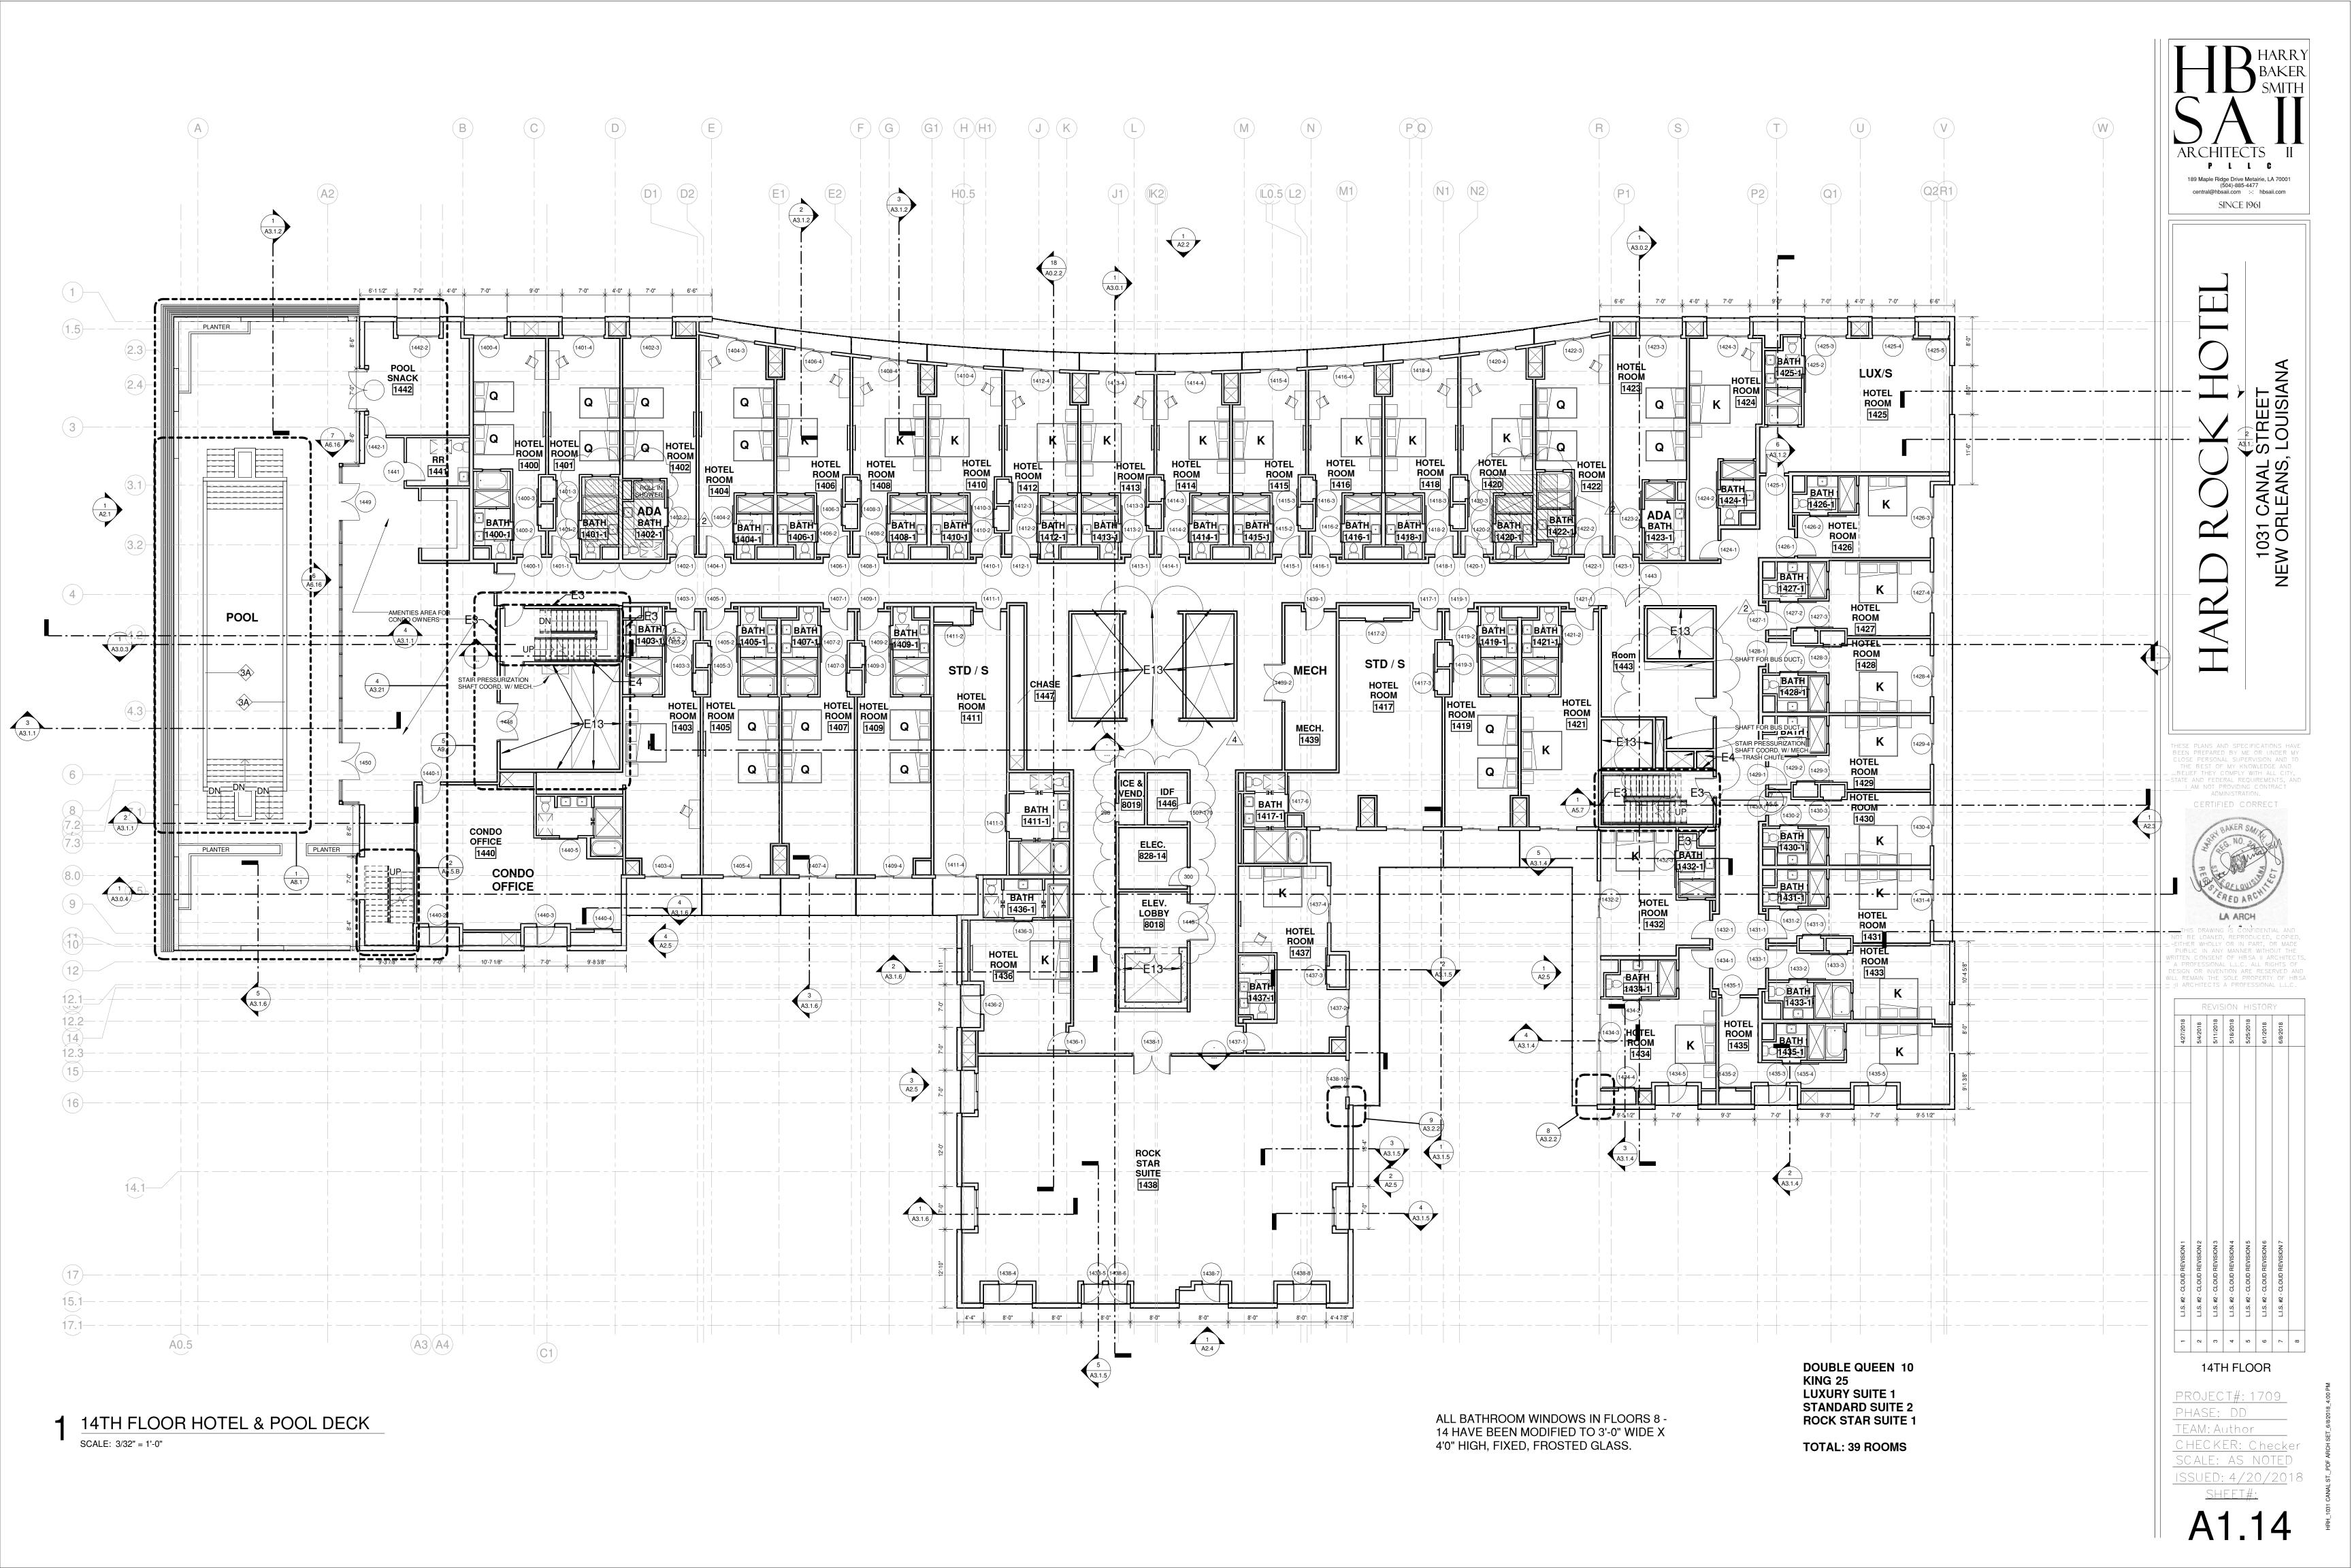


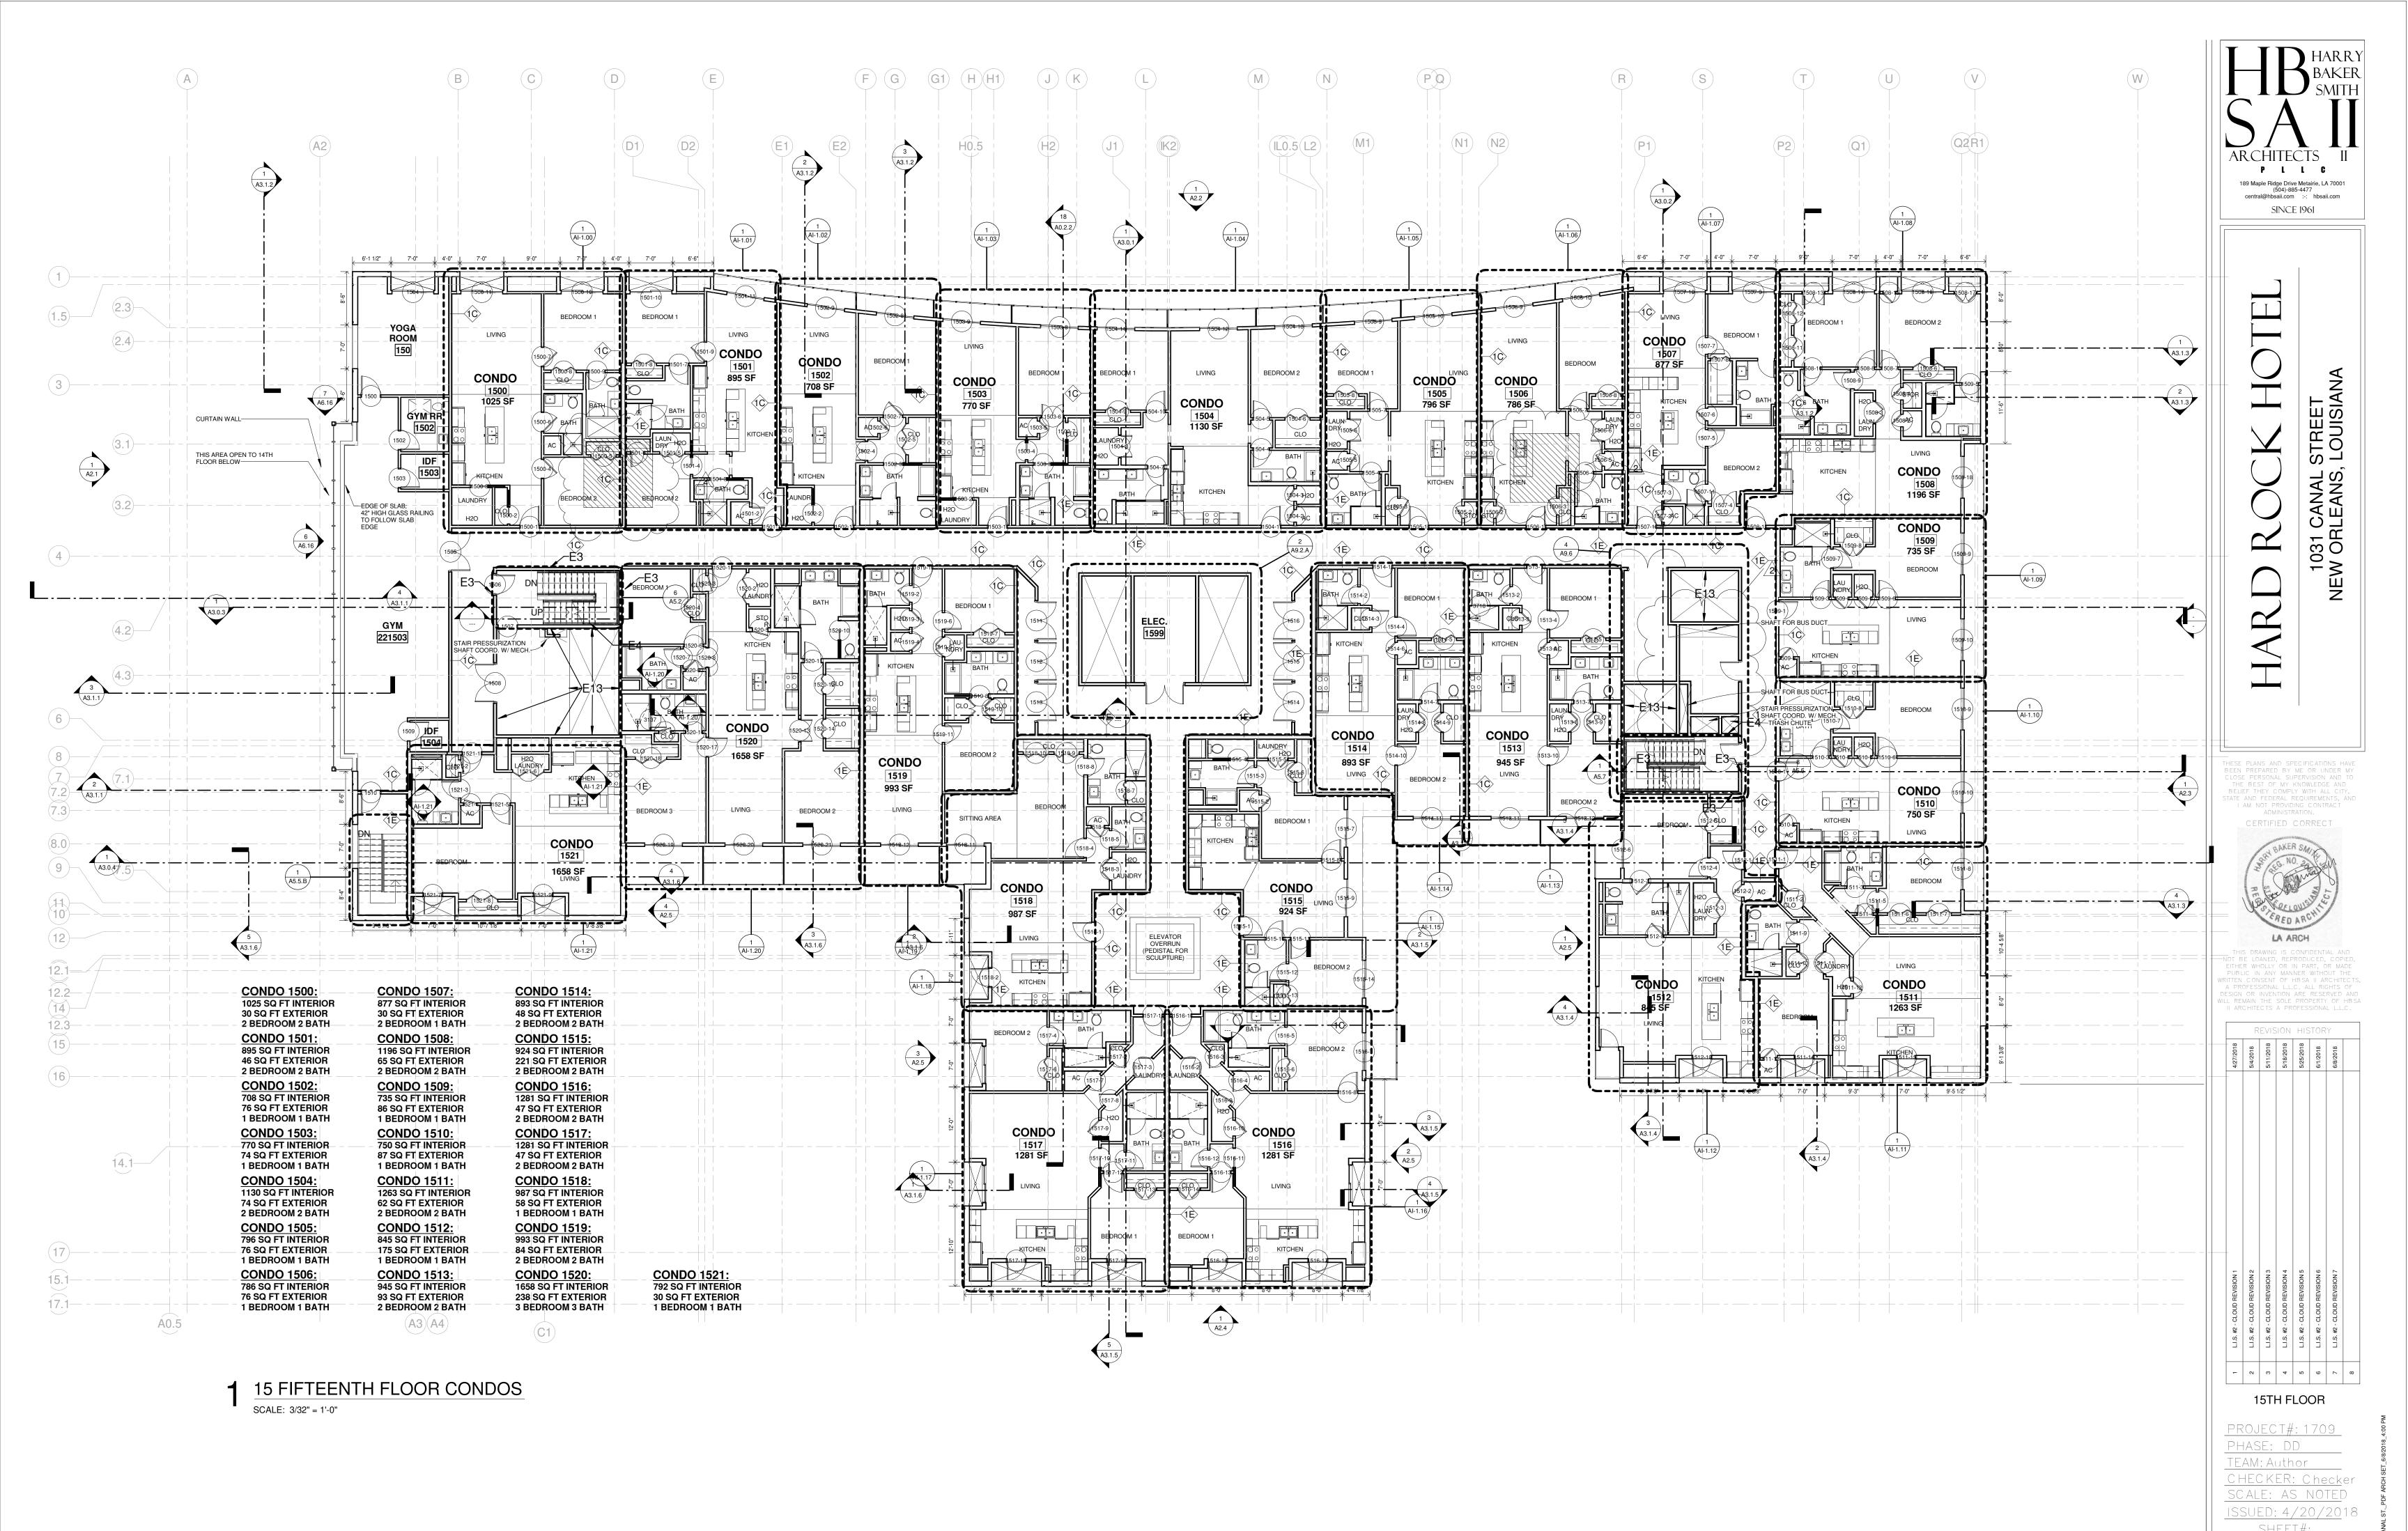


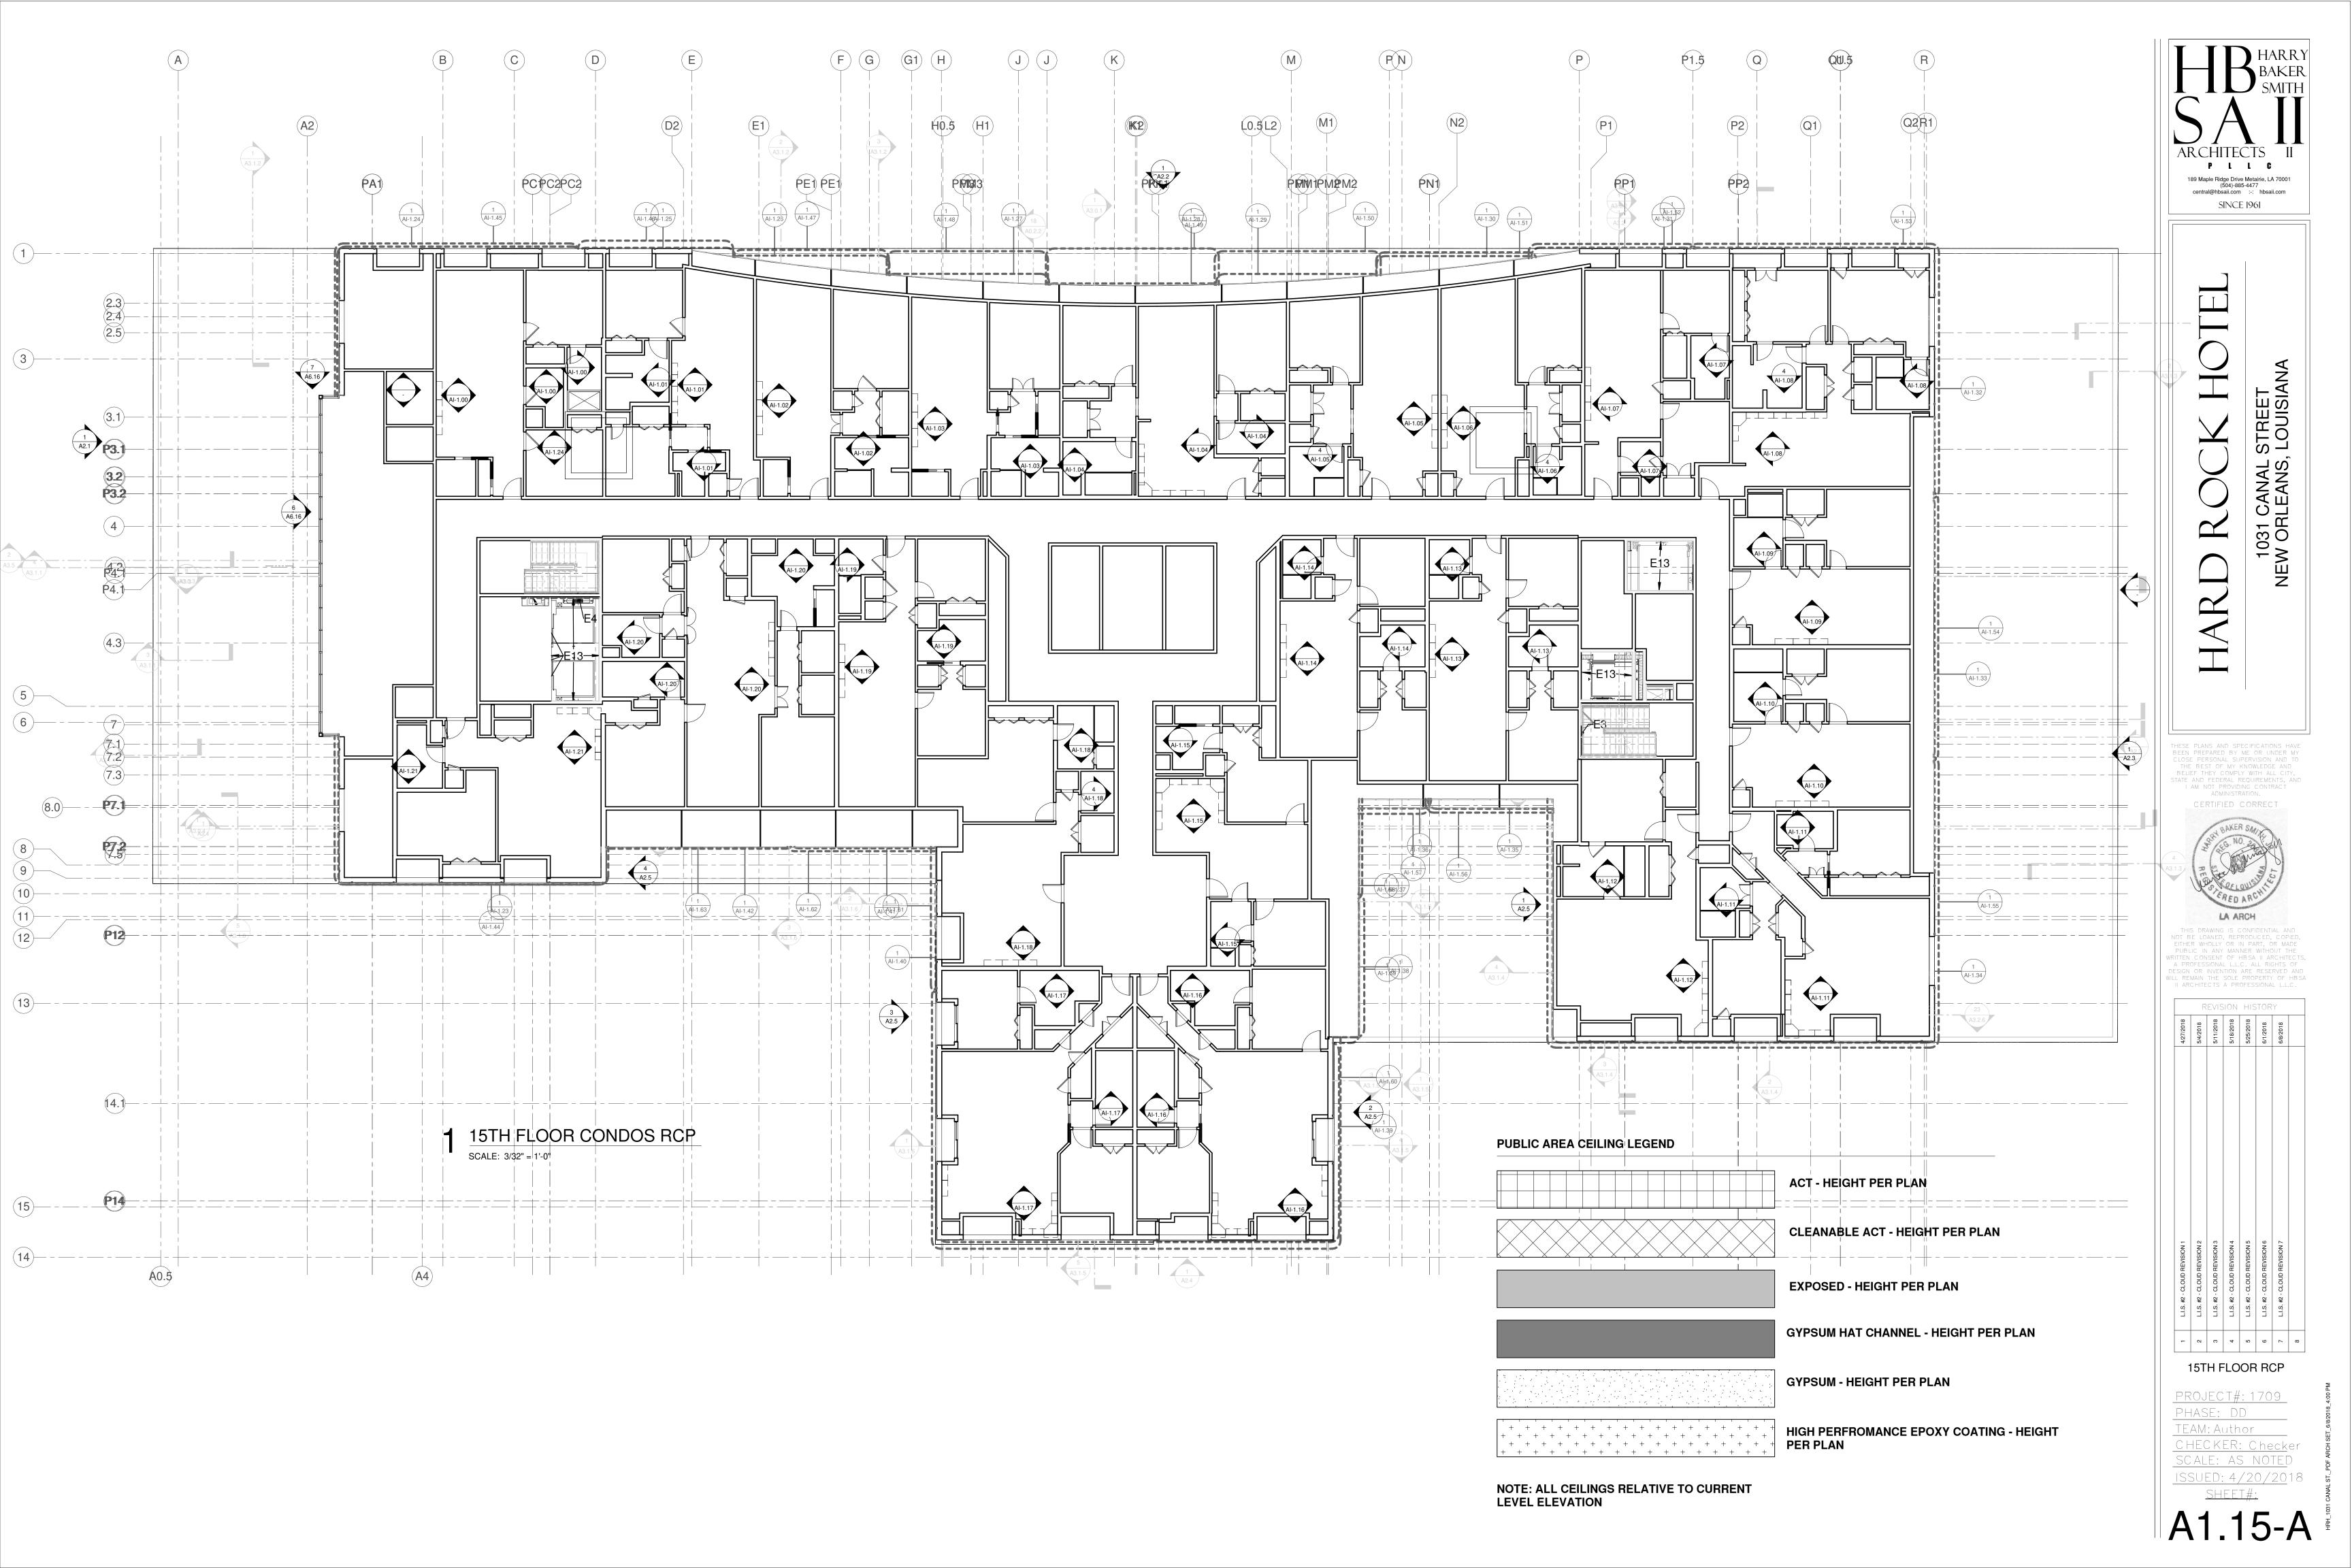


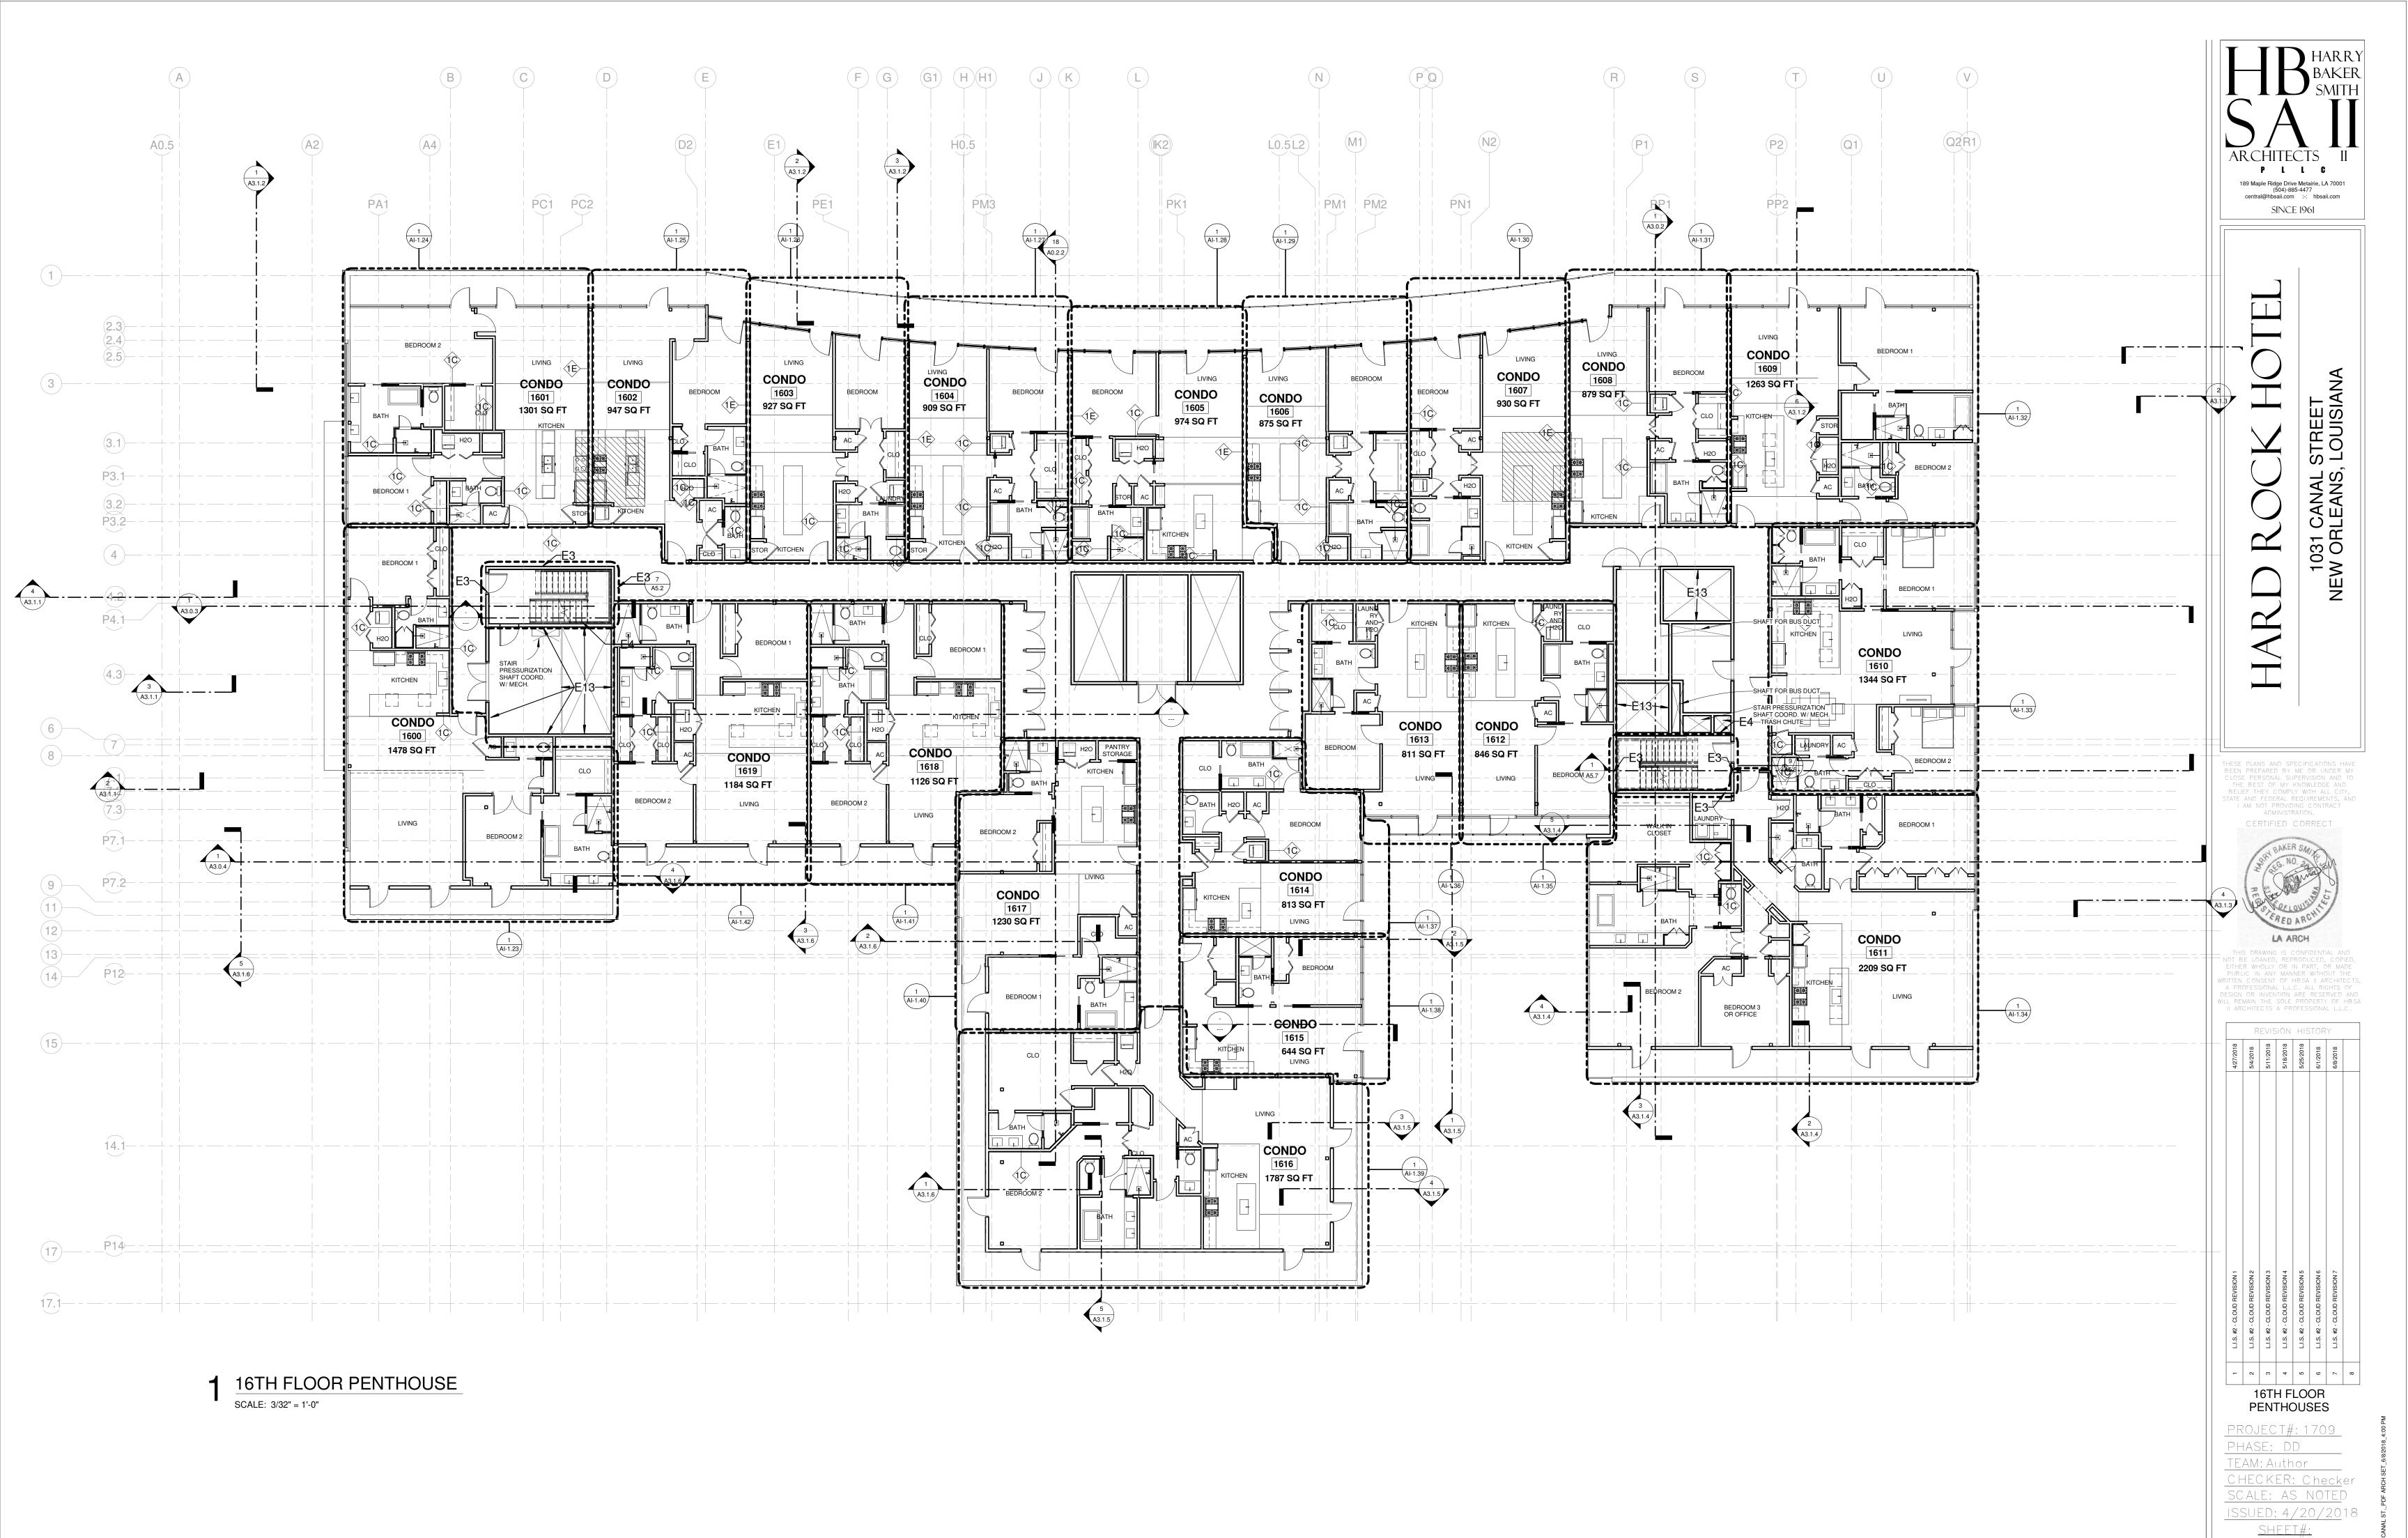

A1 16

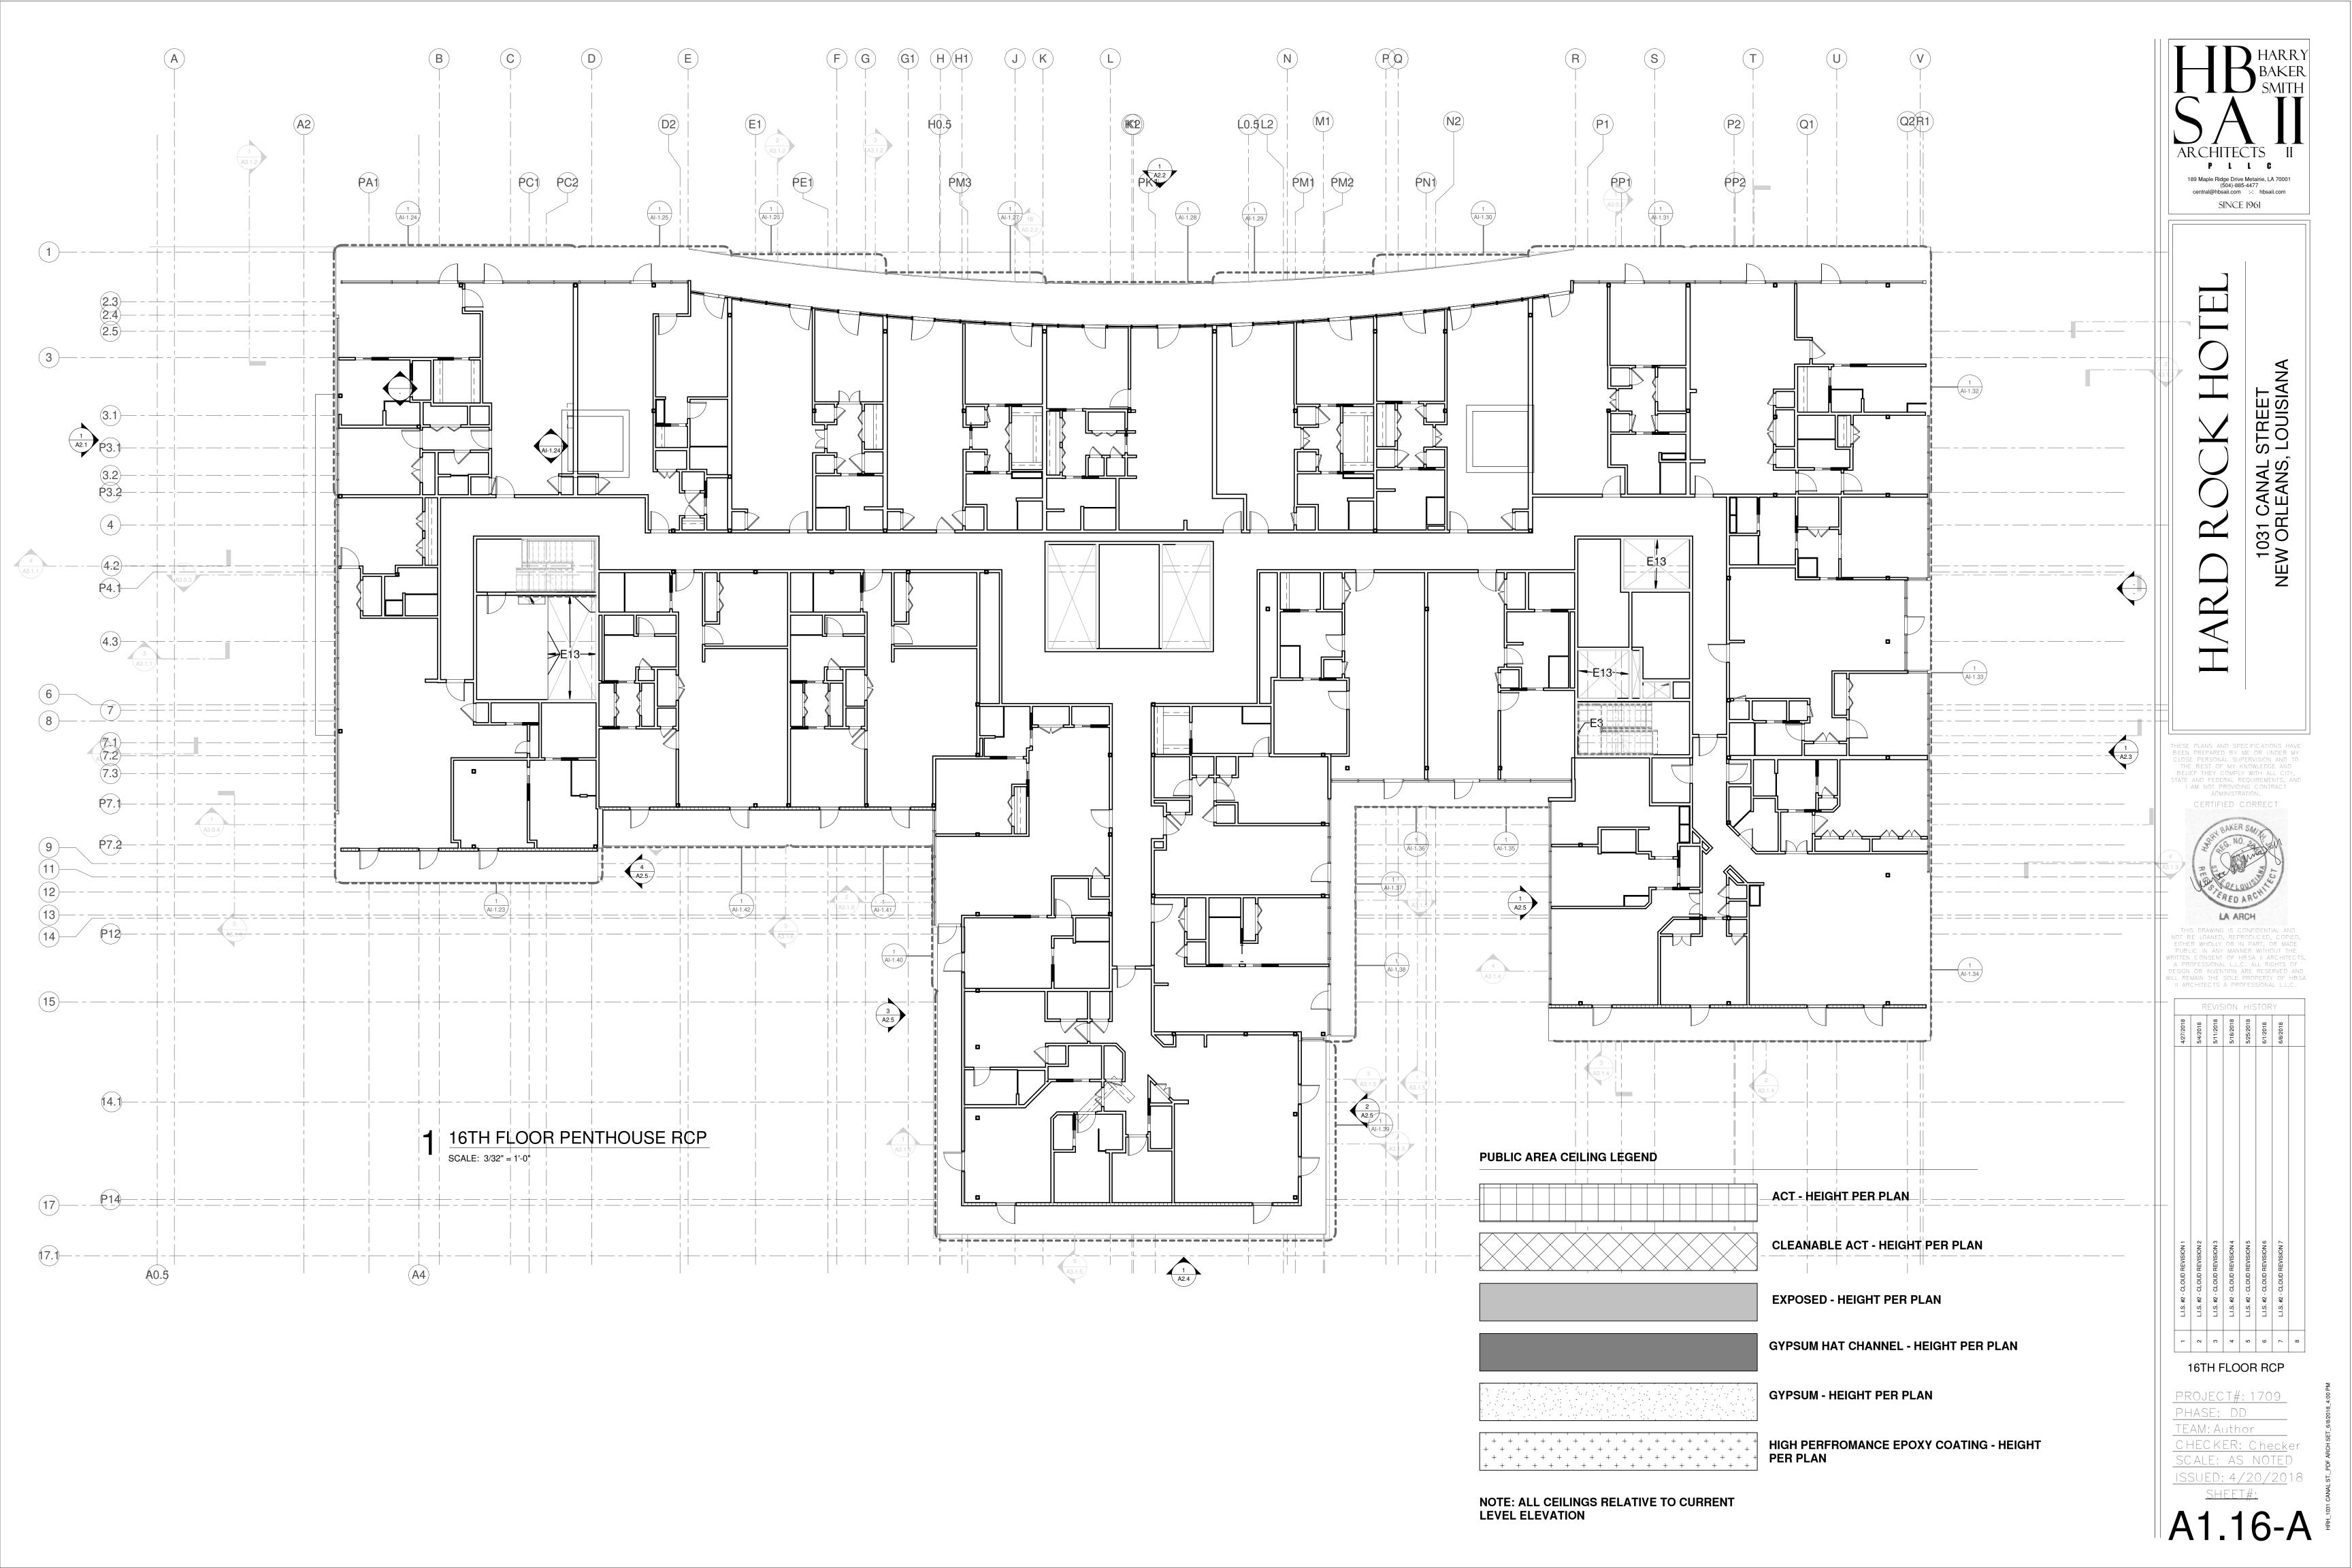

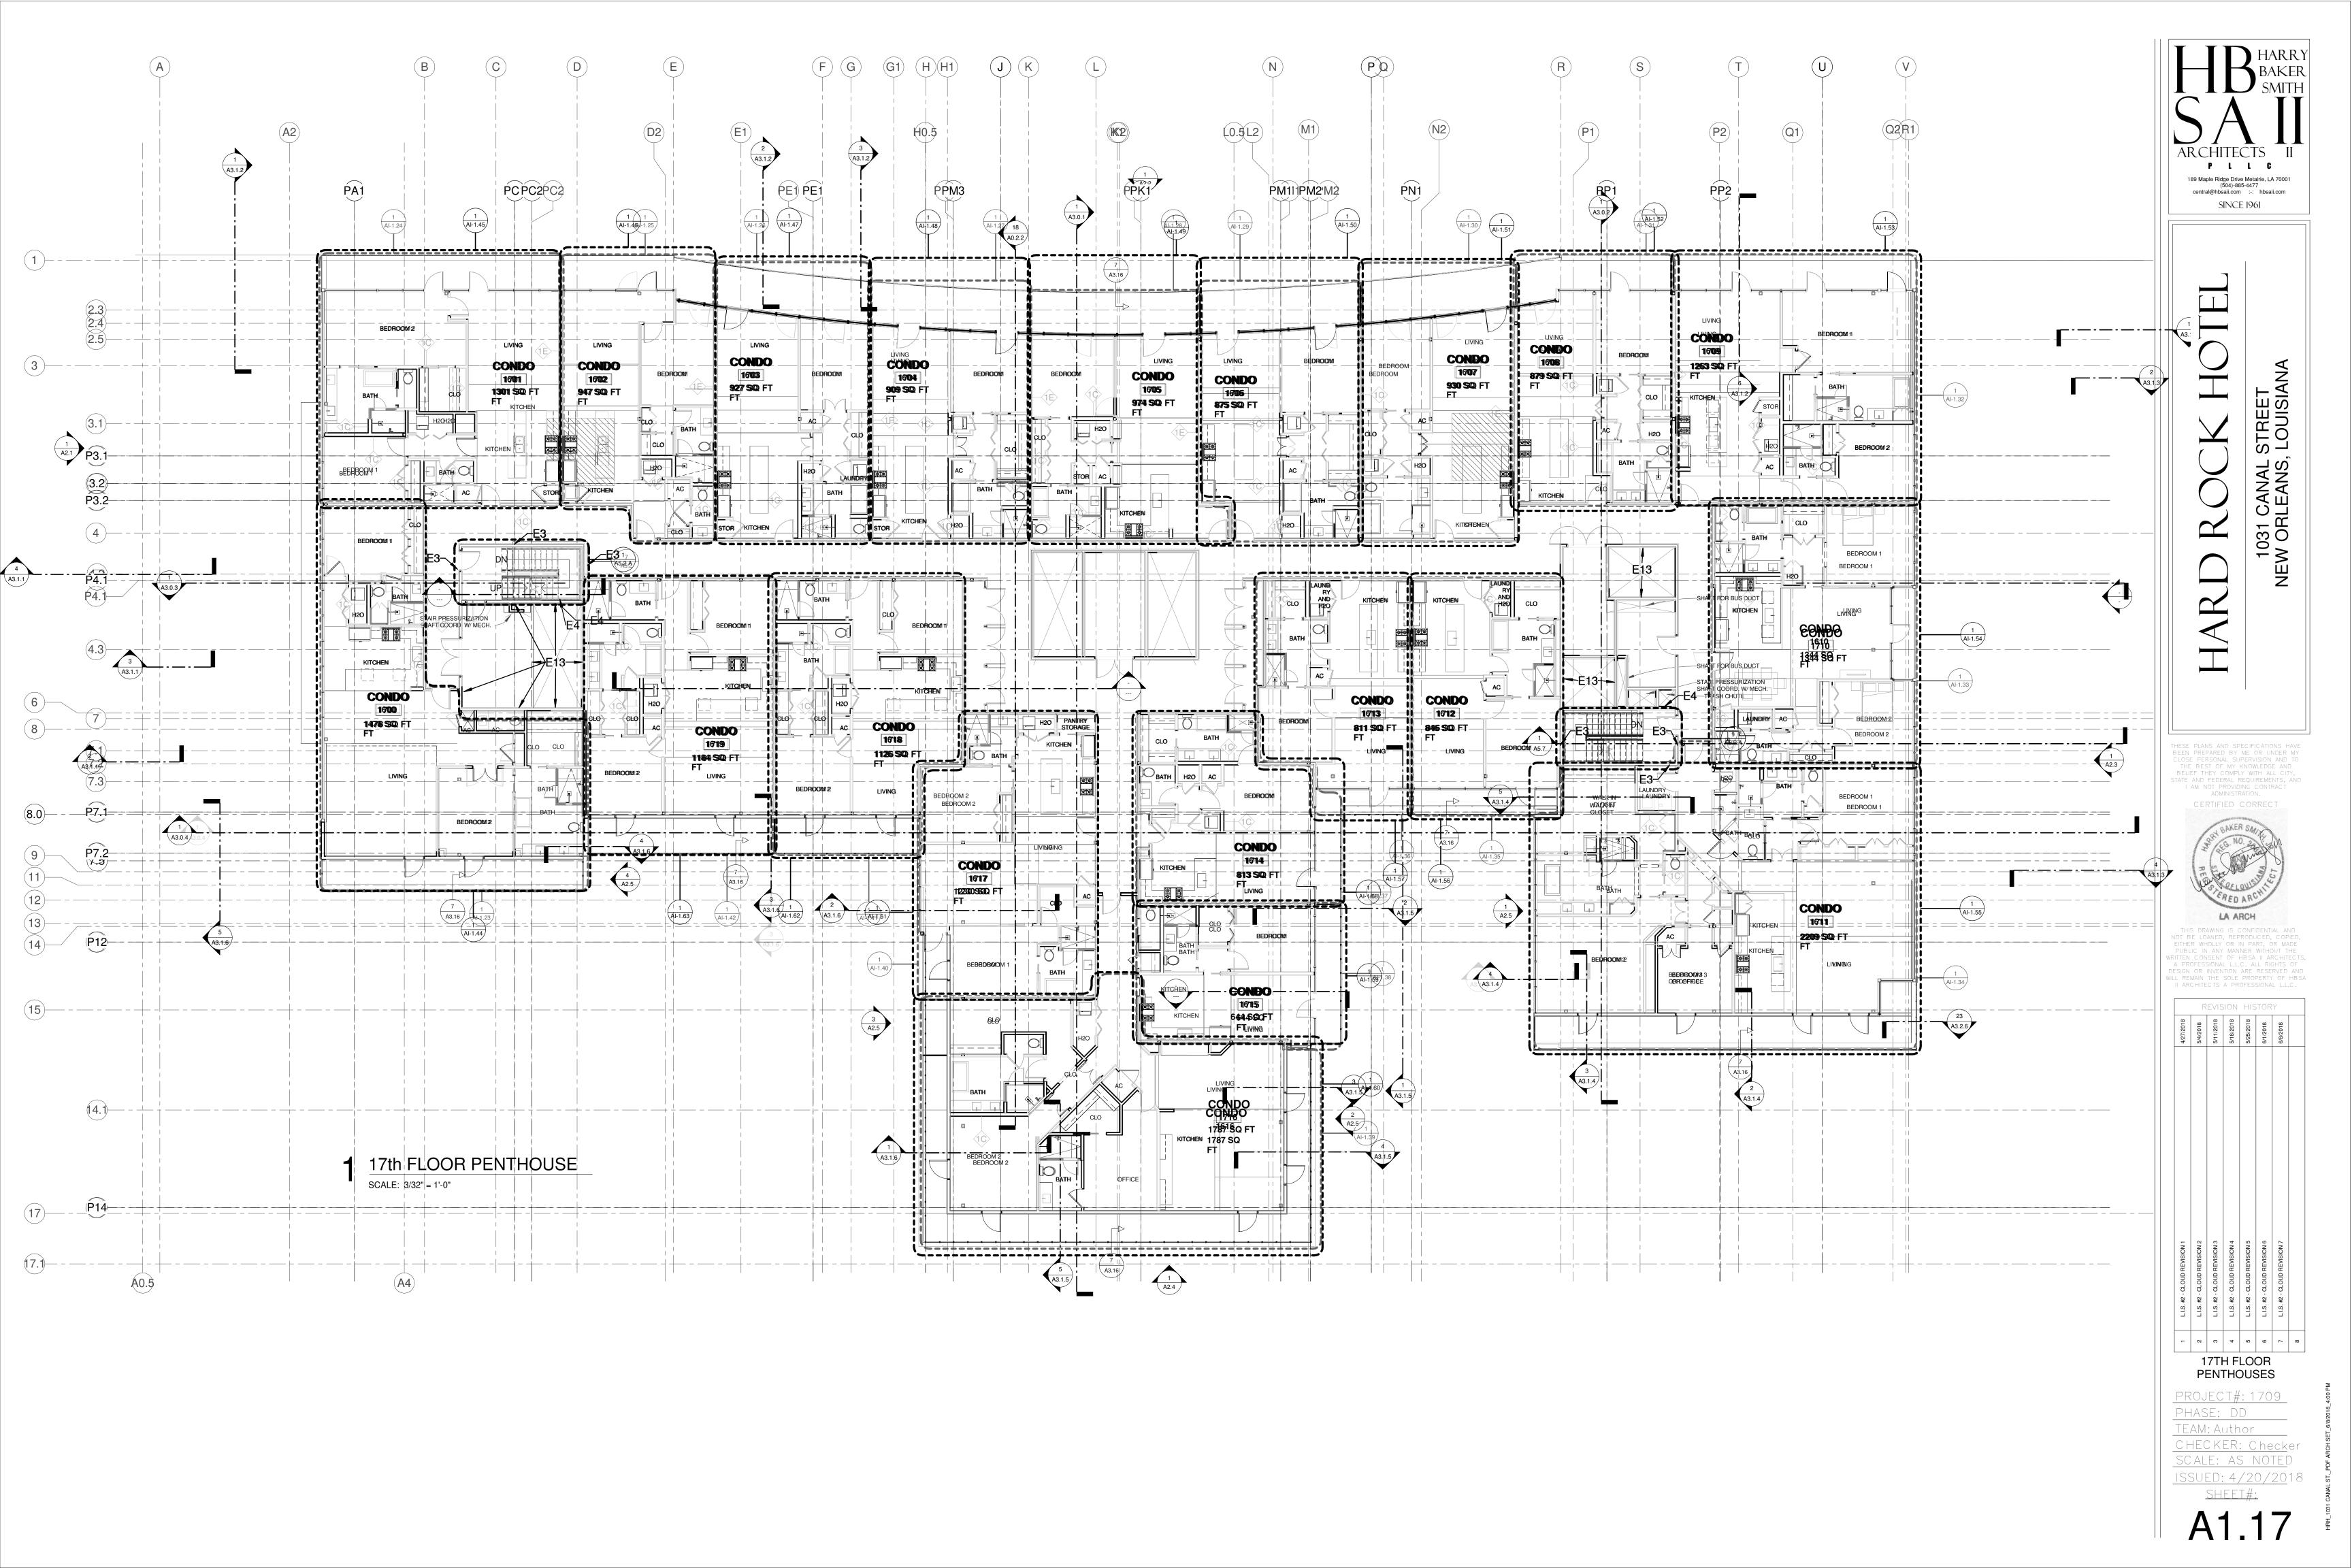

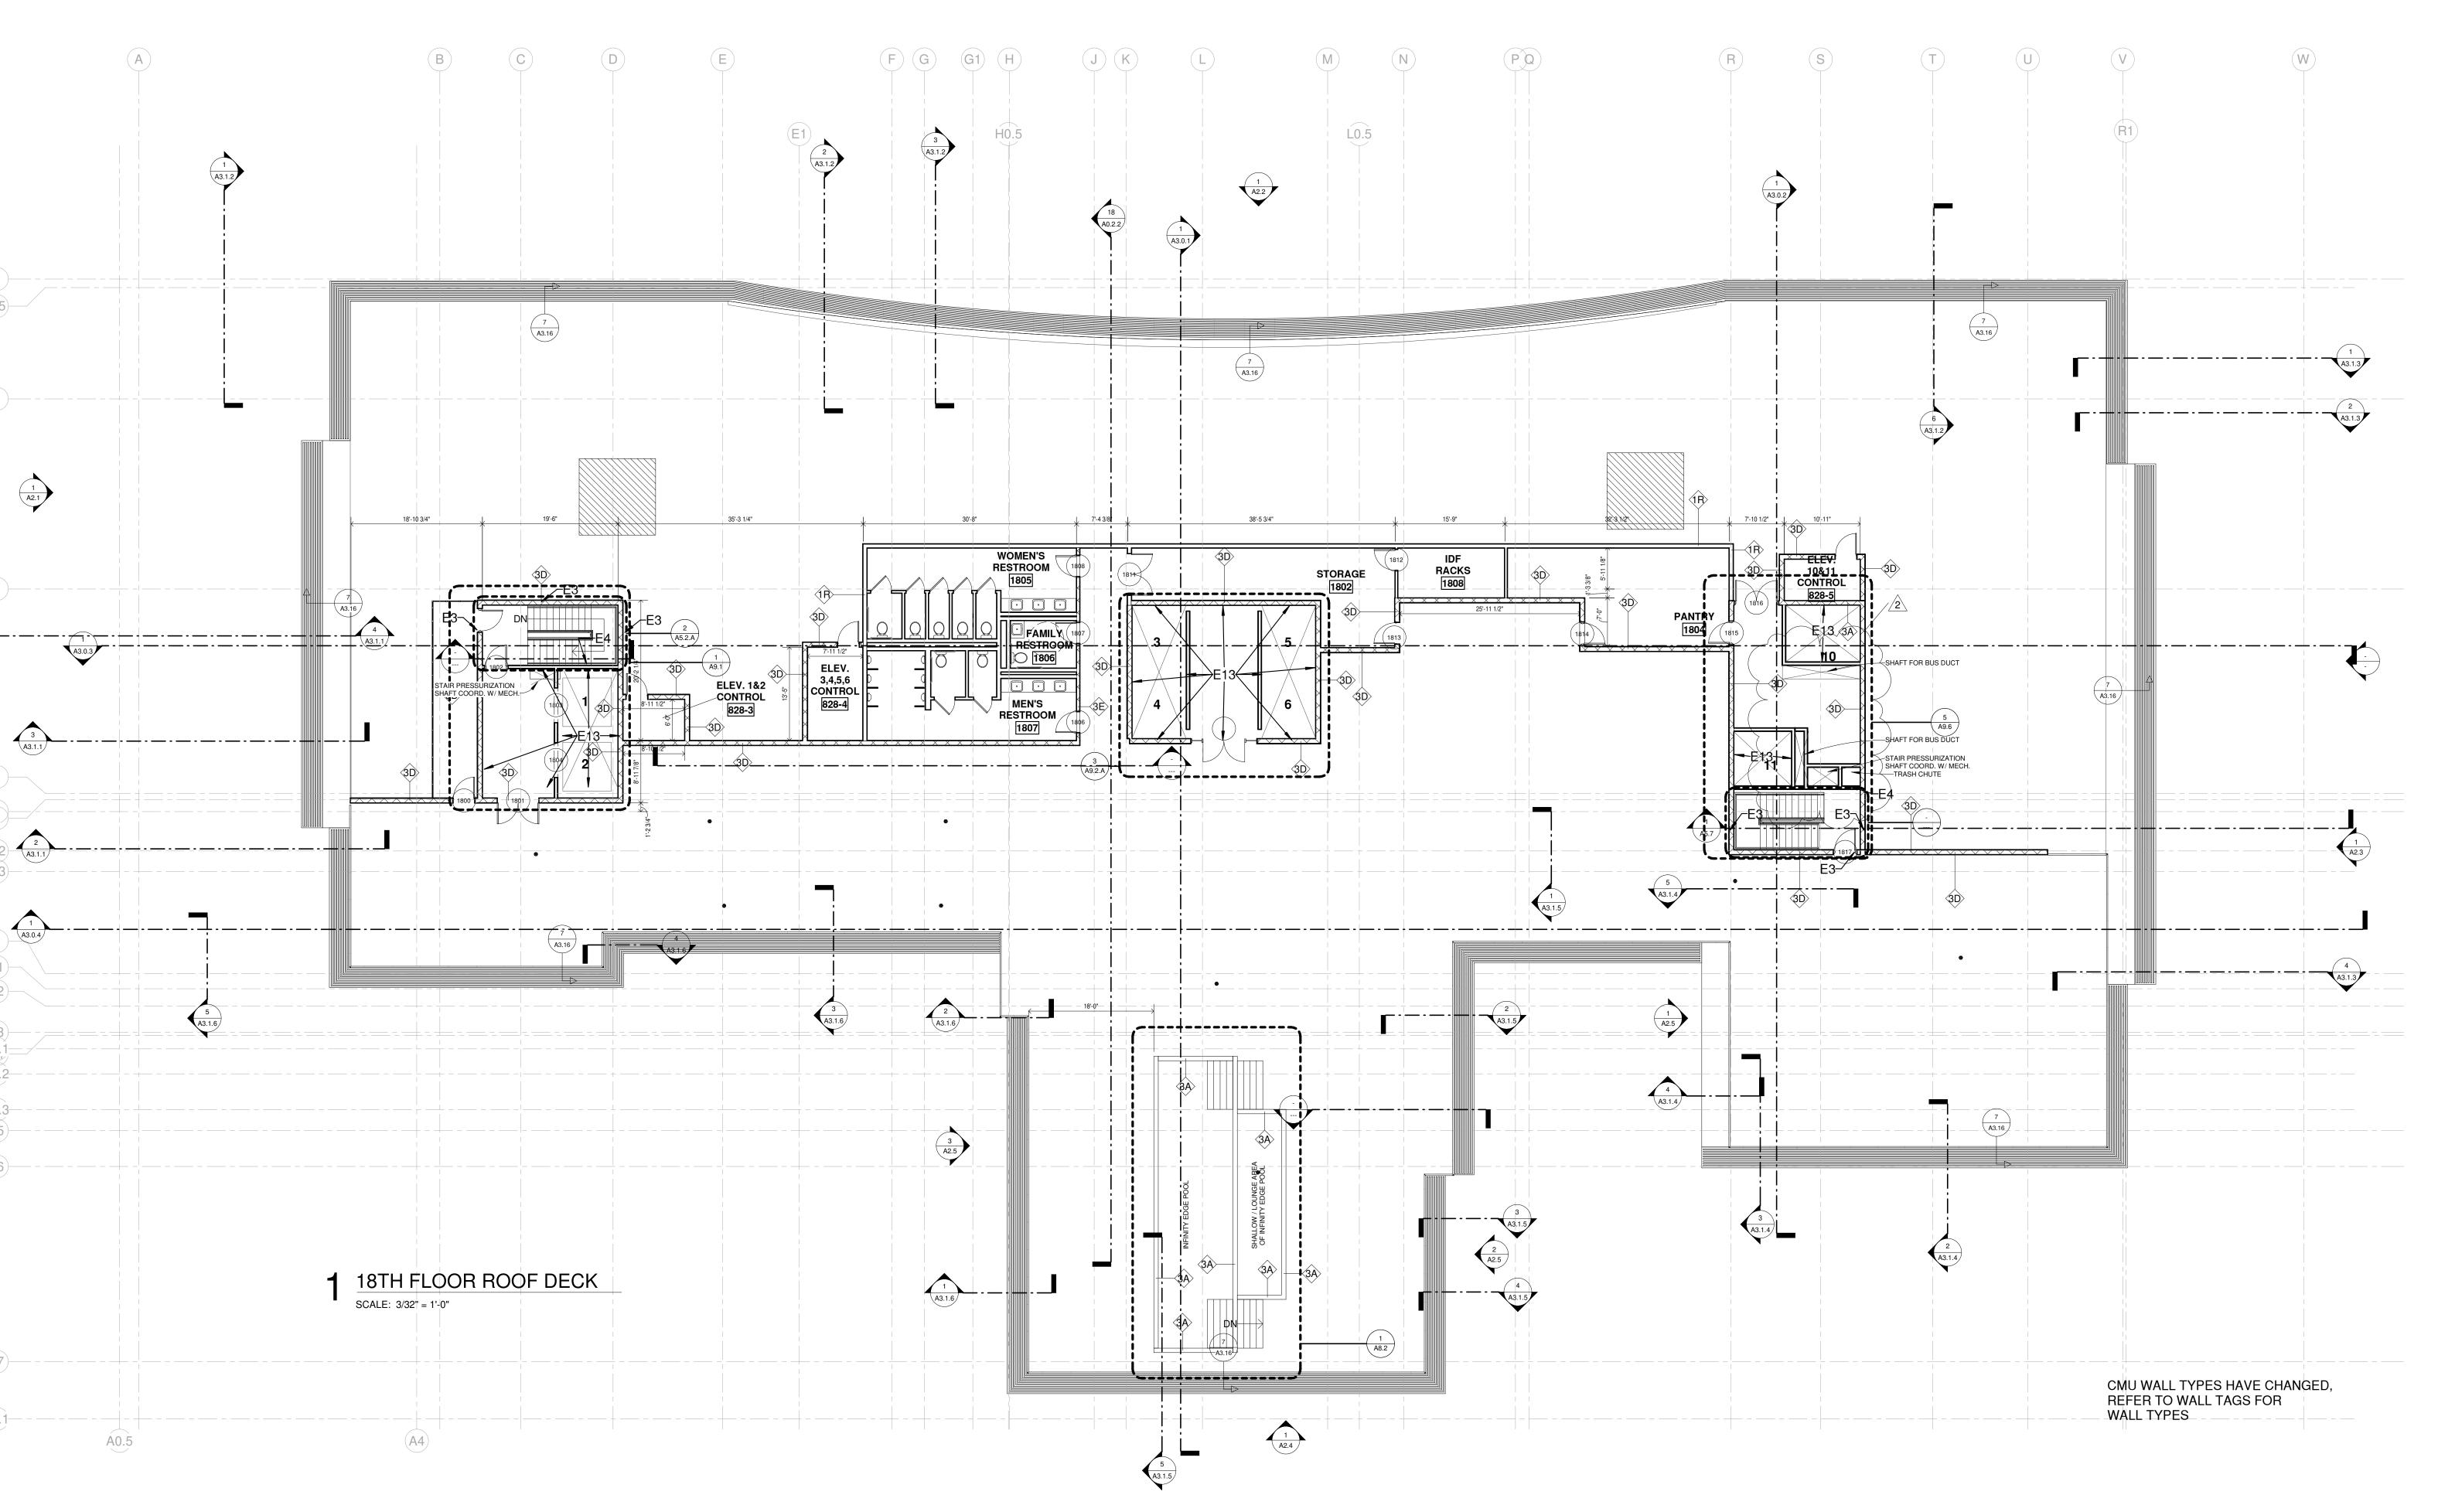



HARD ROCK HOTEL

1031 CANAL STREET

MEW ORLEANS LOUISIANA

HESE PLANS AND SPECIFICATIONS HAVE
EEN PREPARED BY ME OR UNDER MY
CLOSE PERSONAL SUPERVISION AND TO
THE BEST OF MY KNOWLEDGE AND
BELIEF THEY COMPLY WITH ALL CITY,
TATE AND FEDERAL REQUIREMENTS, AND
I AM NOT PROVIDING CONTRACT
ADMINISTRATION.

CERTIFIED CORRECT


THIS DRAWING IS CONFIDENTIAL AND
NOT BE LOANED, REPRODUCED, COPIED,
EITHER WHOLLY OR IN PART, OR MADE
PUBLIC IN ANY MANNER WITHOUT THE
RITTEN CONSENT OF HBSA II ARCHITECTS,
A PROFESSIONAL L.L.C. ALL RIGHTS OF

1 L.I.S. #2 - CLOUD REVISION 1
2 L.I.S. #2 - CLOUD REVISION 2
3 L.I.S. #2 - CLOUD REVISION 3
4 L.I.S. #2 - CLOUD REVISION 4
5 L.I.S. #2 - CLOUD REVISION 5
6 L.I.S. #2 - CLOUD REVISION 6
7 L.I.S. #2 - CLOUD REVISION 7
8 Sinstance of the control of


ROOF DECK PLAN

PROJECT#: 1709
PHASE: DD
TEAM: Author
CHECKER: Checker
SCALE: AS NOTED
ISSUED: 4/20/2018

A1.18

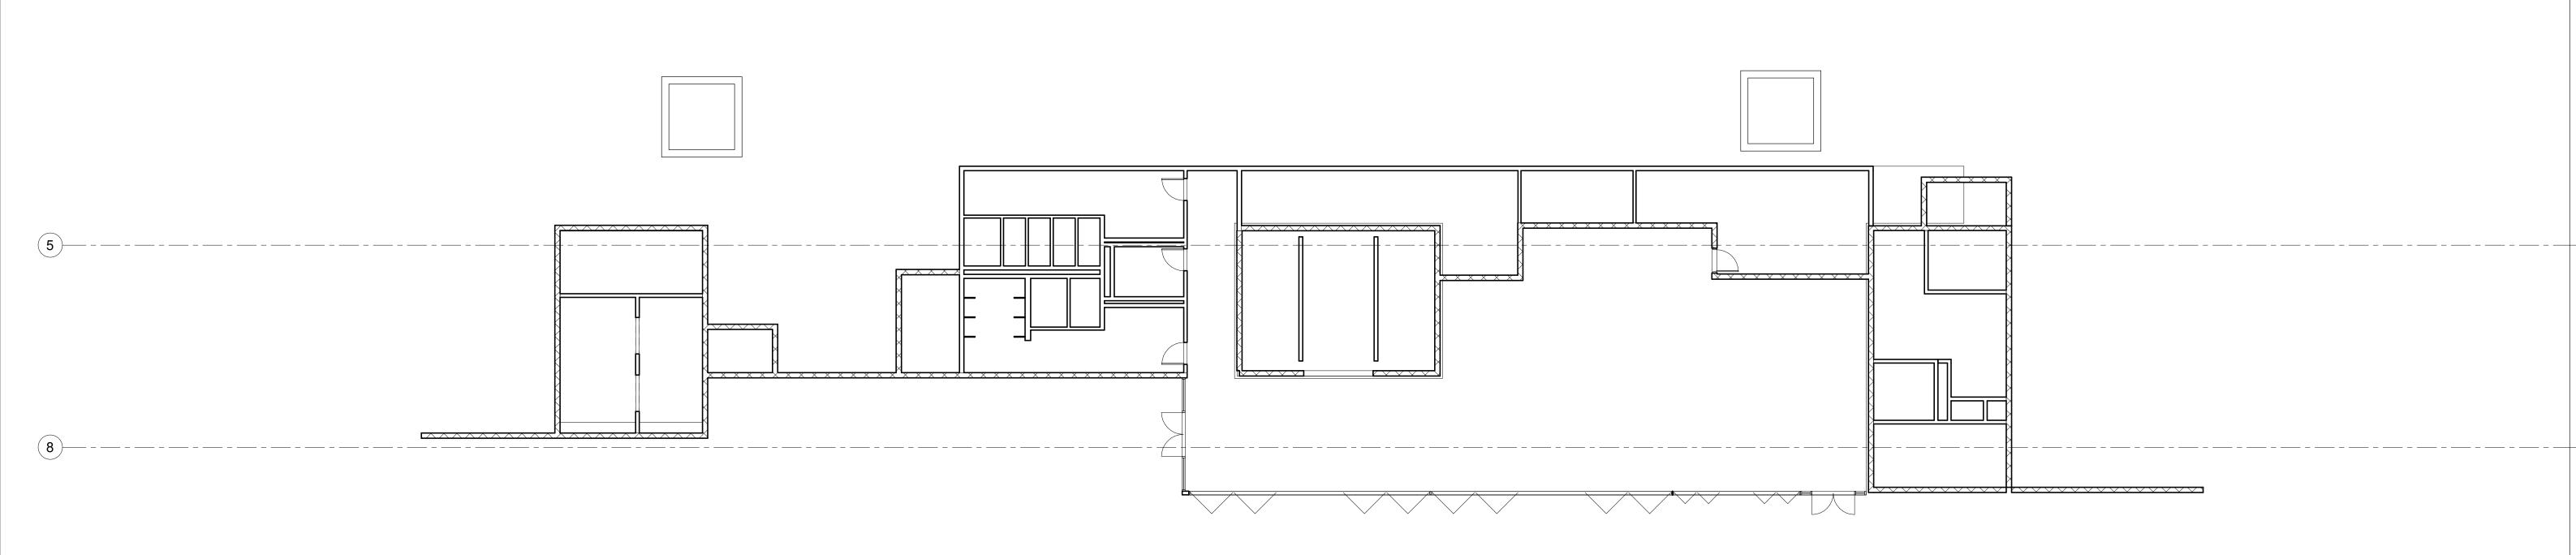

1 18TH FLOOR ROOF DECK SCALE: 3/32" = 1'-0"

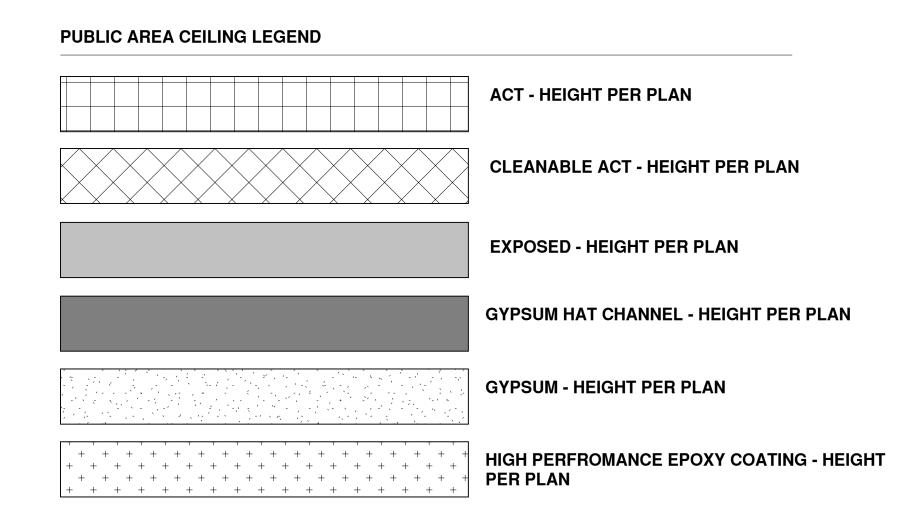

NOTE: ALL CEILINGS RELATIVE TO CURRENT LEVEL ELEVATION

HARRY
BAKER
SMITH
SMITH
ARCHITECTS II
P L C

189 Maple Ridge Drive Metairie, LA 70001
(504)-885-4477
central@hbsaii.com :: hbsaii.com
SINCE 1961

HARD ROCK HOTEL

THESE PLANS AND SPECIFICATIONS HAVE BEEN PREPARED BY ME OR UNDER MY CLOSE PERSONAL SUPERVISION AND TO THE BEST OF MY KNOWLEDGE AND BELIEF THEY COMPLY WITH ALL CITY, STATE AND FEDERAL REQUIREMENTS, AND I AM NOT PROVIDING CONTRACT ADMINISTRATION.

CERTIFIED CORRECT



THIS DRAWING IS CONFIDENTIAL AND
NOT BE LOANED, REPRODUCED, COPIED,
EITHER WHOLLY OR IN PART, OR MADE
PUBLIC IN ANY MANNER WITHOUT THE
WRITTEN CONSENT OF HBSA II ARCHITECTS
A PROFESSIONAL L.L.C. ALL RIGHTS OF
DESIGN OR INVENTION ARE RESERVED AND
WILL REMAIN THE SOLE PROPERTY OF HBS


| WIL |                              | MAIN<br>C HITE               | THE<br>CTS                   | SOLE<br>A PR                 |                              | PERTY<br>SIONA               |                              | HB SA<br>.C . |
|-----|------------------------------|------------------------------|------------------------------|------------------------------|------------------------------|------------------------------|------------------------------|---------------|
|     |                              | R                            | EVIS                         | SION                         | HIS                          | TOR                          | Υ                            |               |
|     | 4/27/2018                    | 5/4/2018                     | 5/11/2018                    | 5/18/2018                    | 5/25/2018                    | 6/1/2018                     | 6/8/2018                     |               |
|     | L.i.S. #2 - CLOUD REVISION 1 | L.i.S. #2 - CLOUD REVISION 2 | L.i.S. #2 - CLOUD REVISION 3 | L.i.S. #2 - CLOUD REVISION 4 | L.i.S. #2 - CLOUD REVISION 5 | L.i.S. #2 - CLOUD REVISION 6 | L.i.S. #2 - CLOUD REVISION 7 |               |
|     | -                            | 7                            | က                            | 4                            | 2                            | 9                            | 7                            | 8             |

ROOF DECK PLAN RCP


PROJECT#: 1709
PHASE: DD
TEAM: Author
CHECKER: Checker
SCALE: AS NOTED

ISSUED: 4/20/2018
SHEET#:

A1.18-A

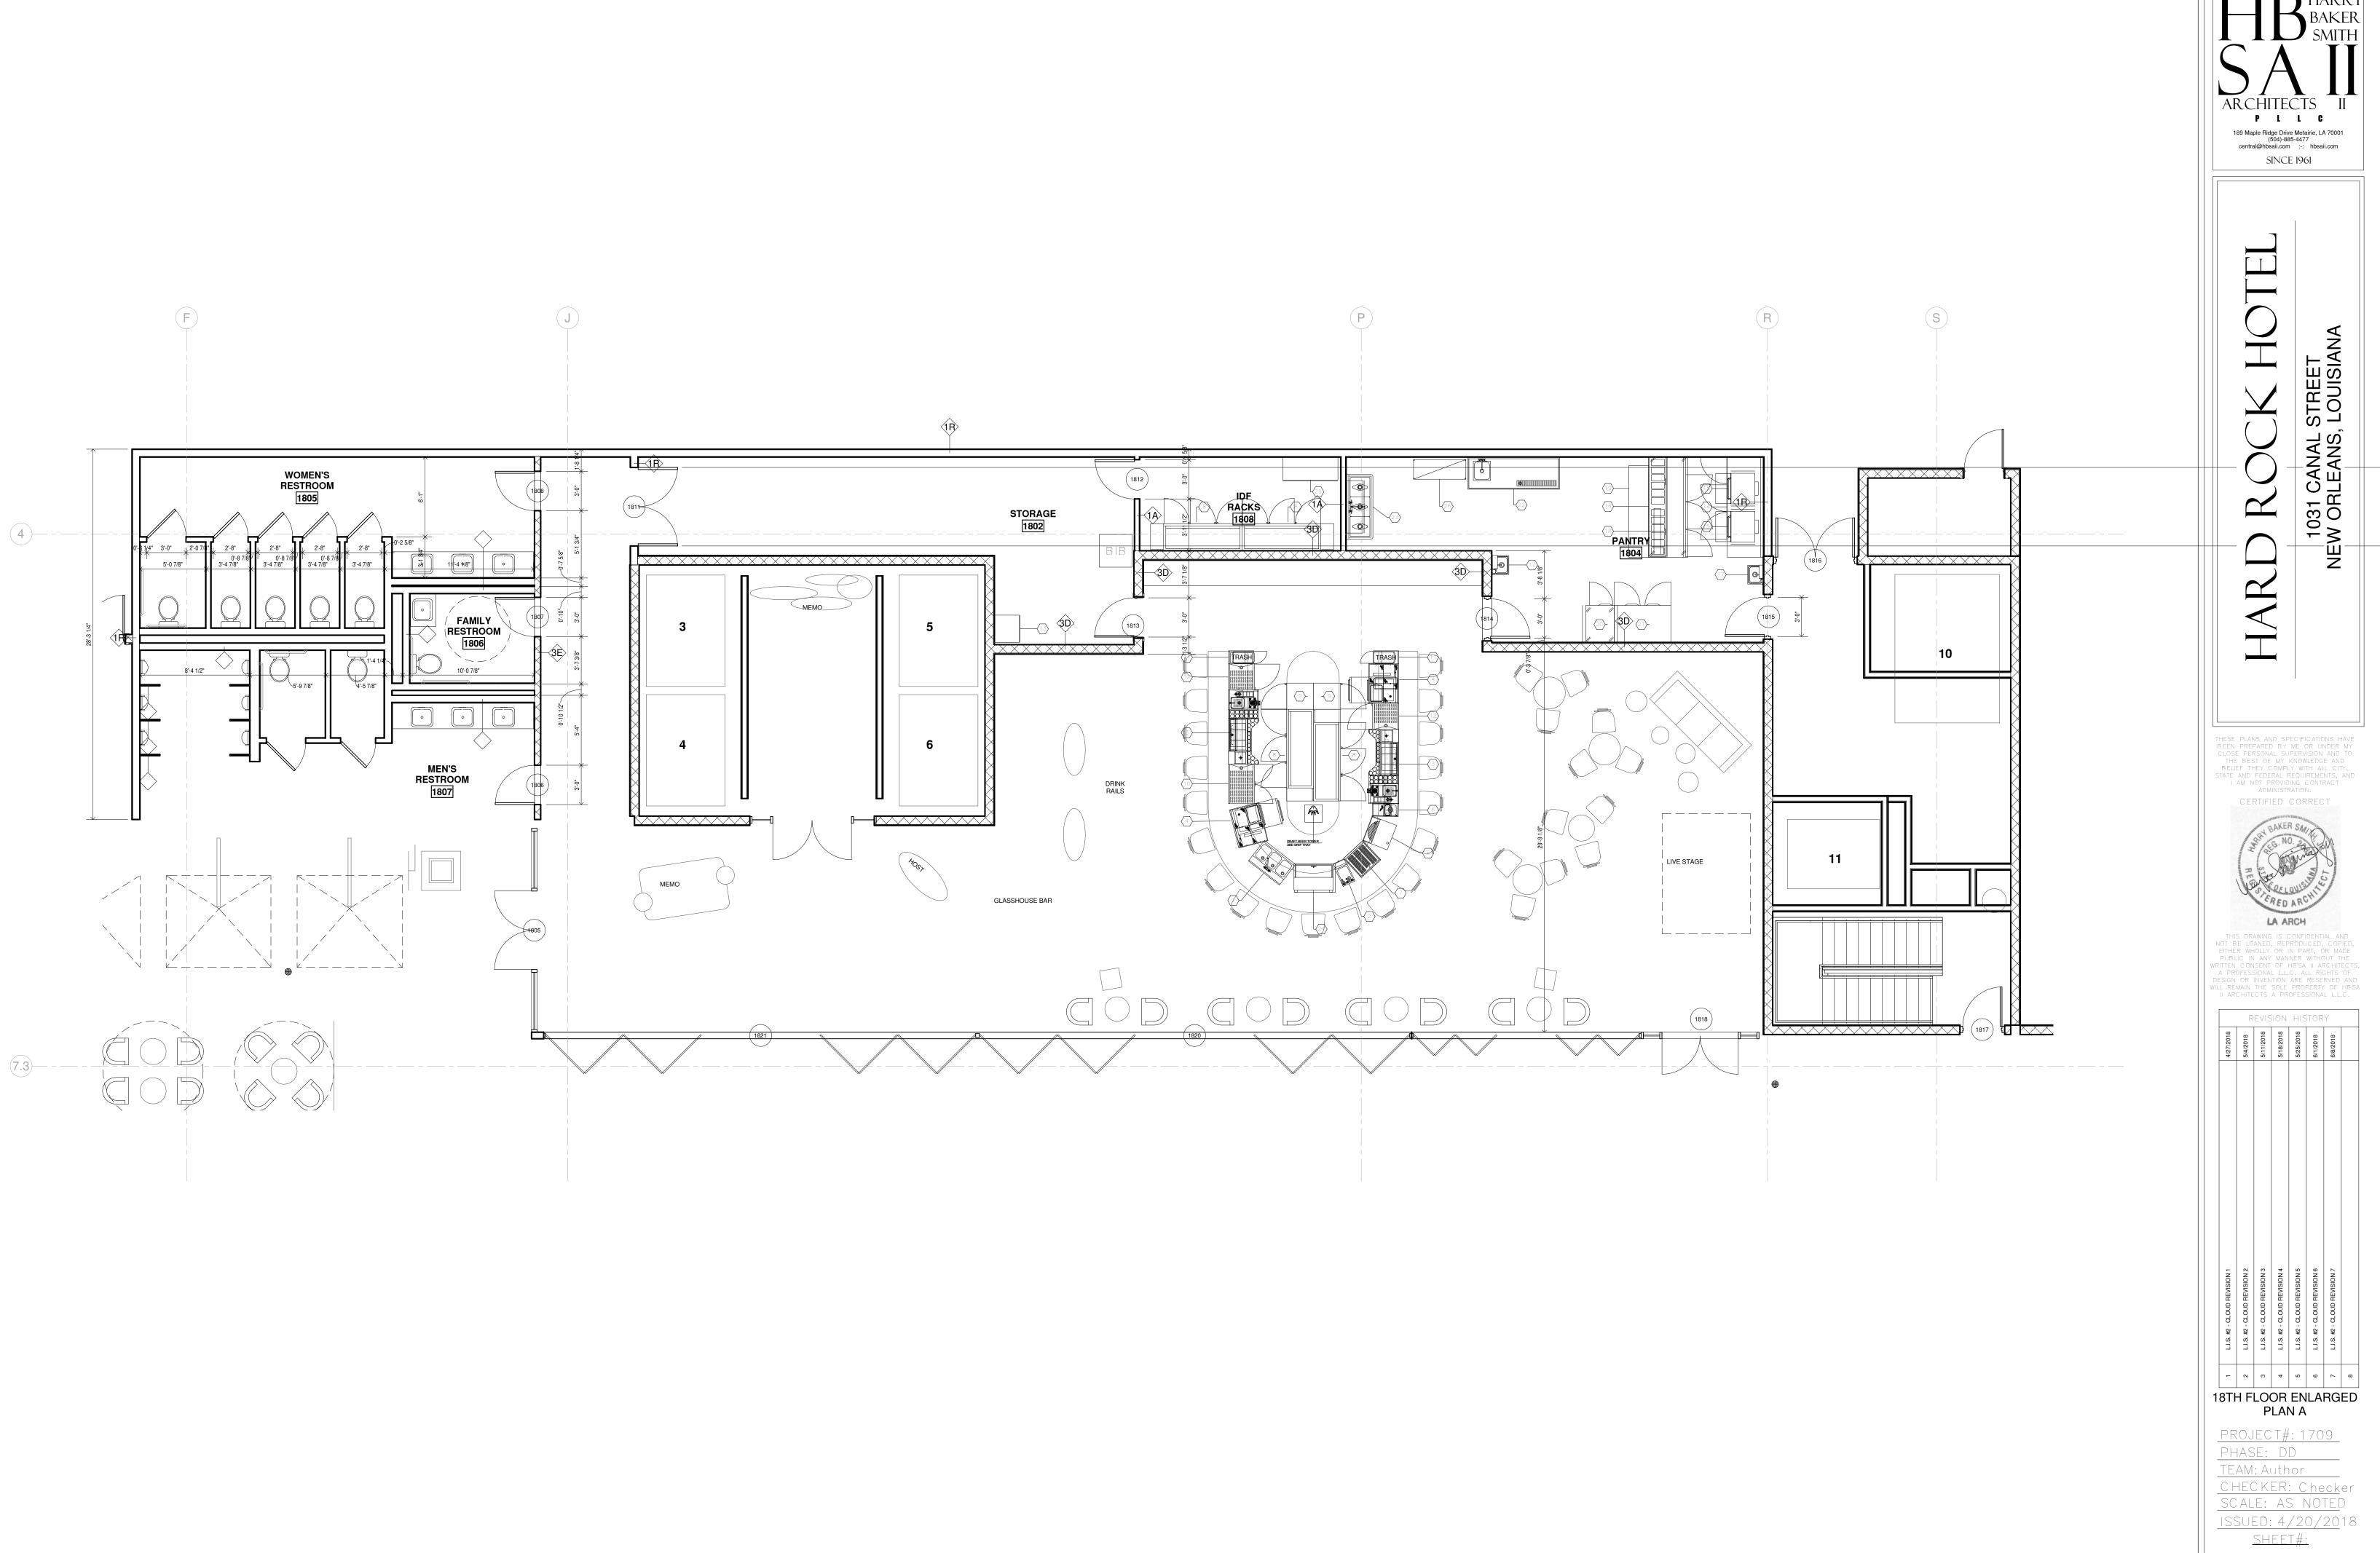

A1.18.1

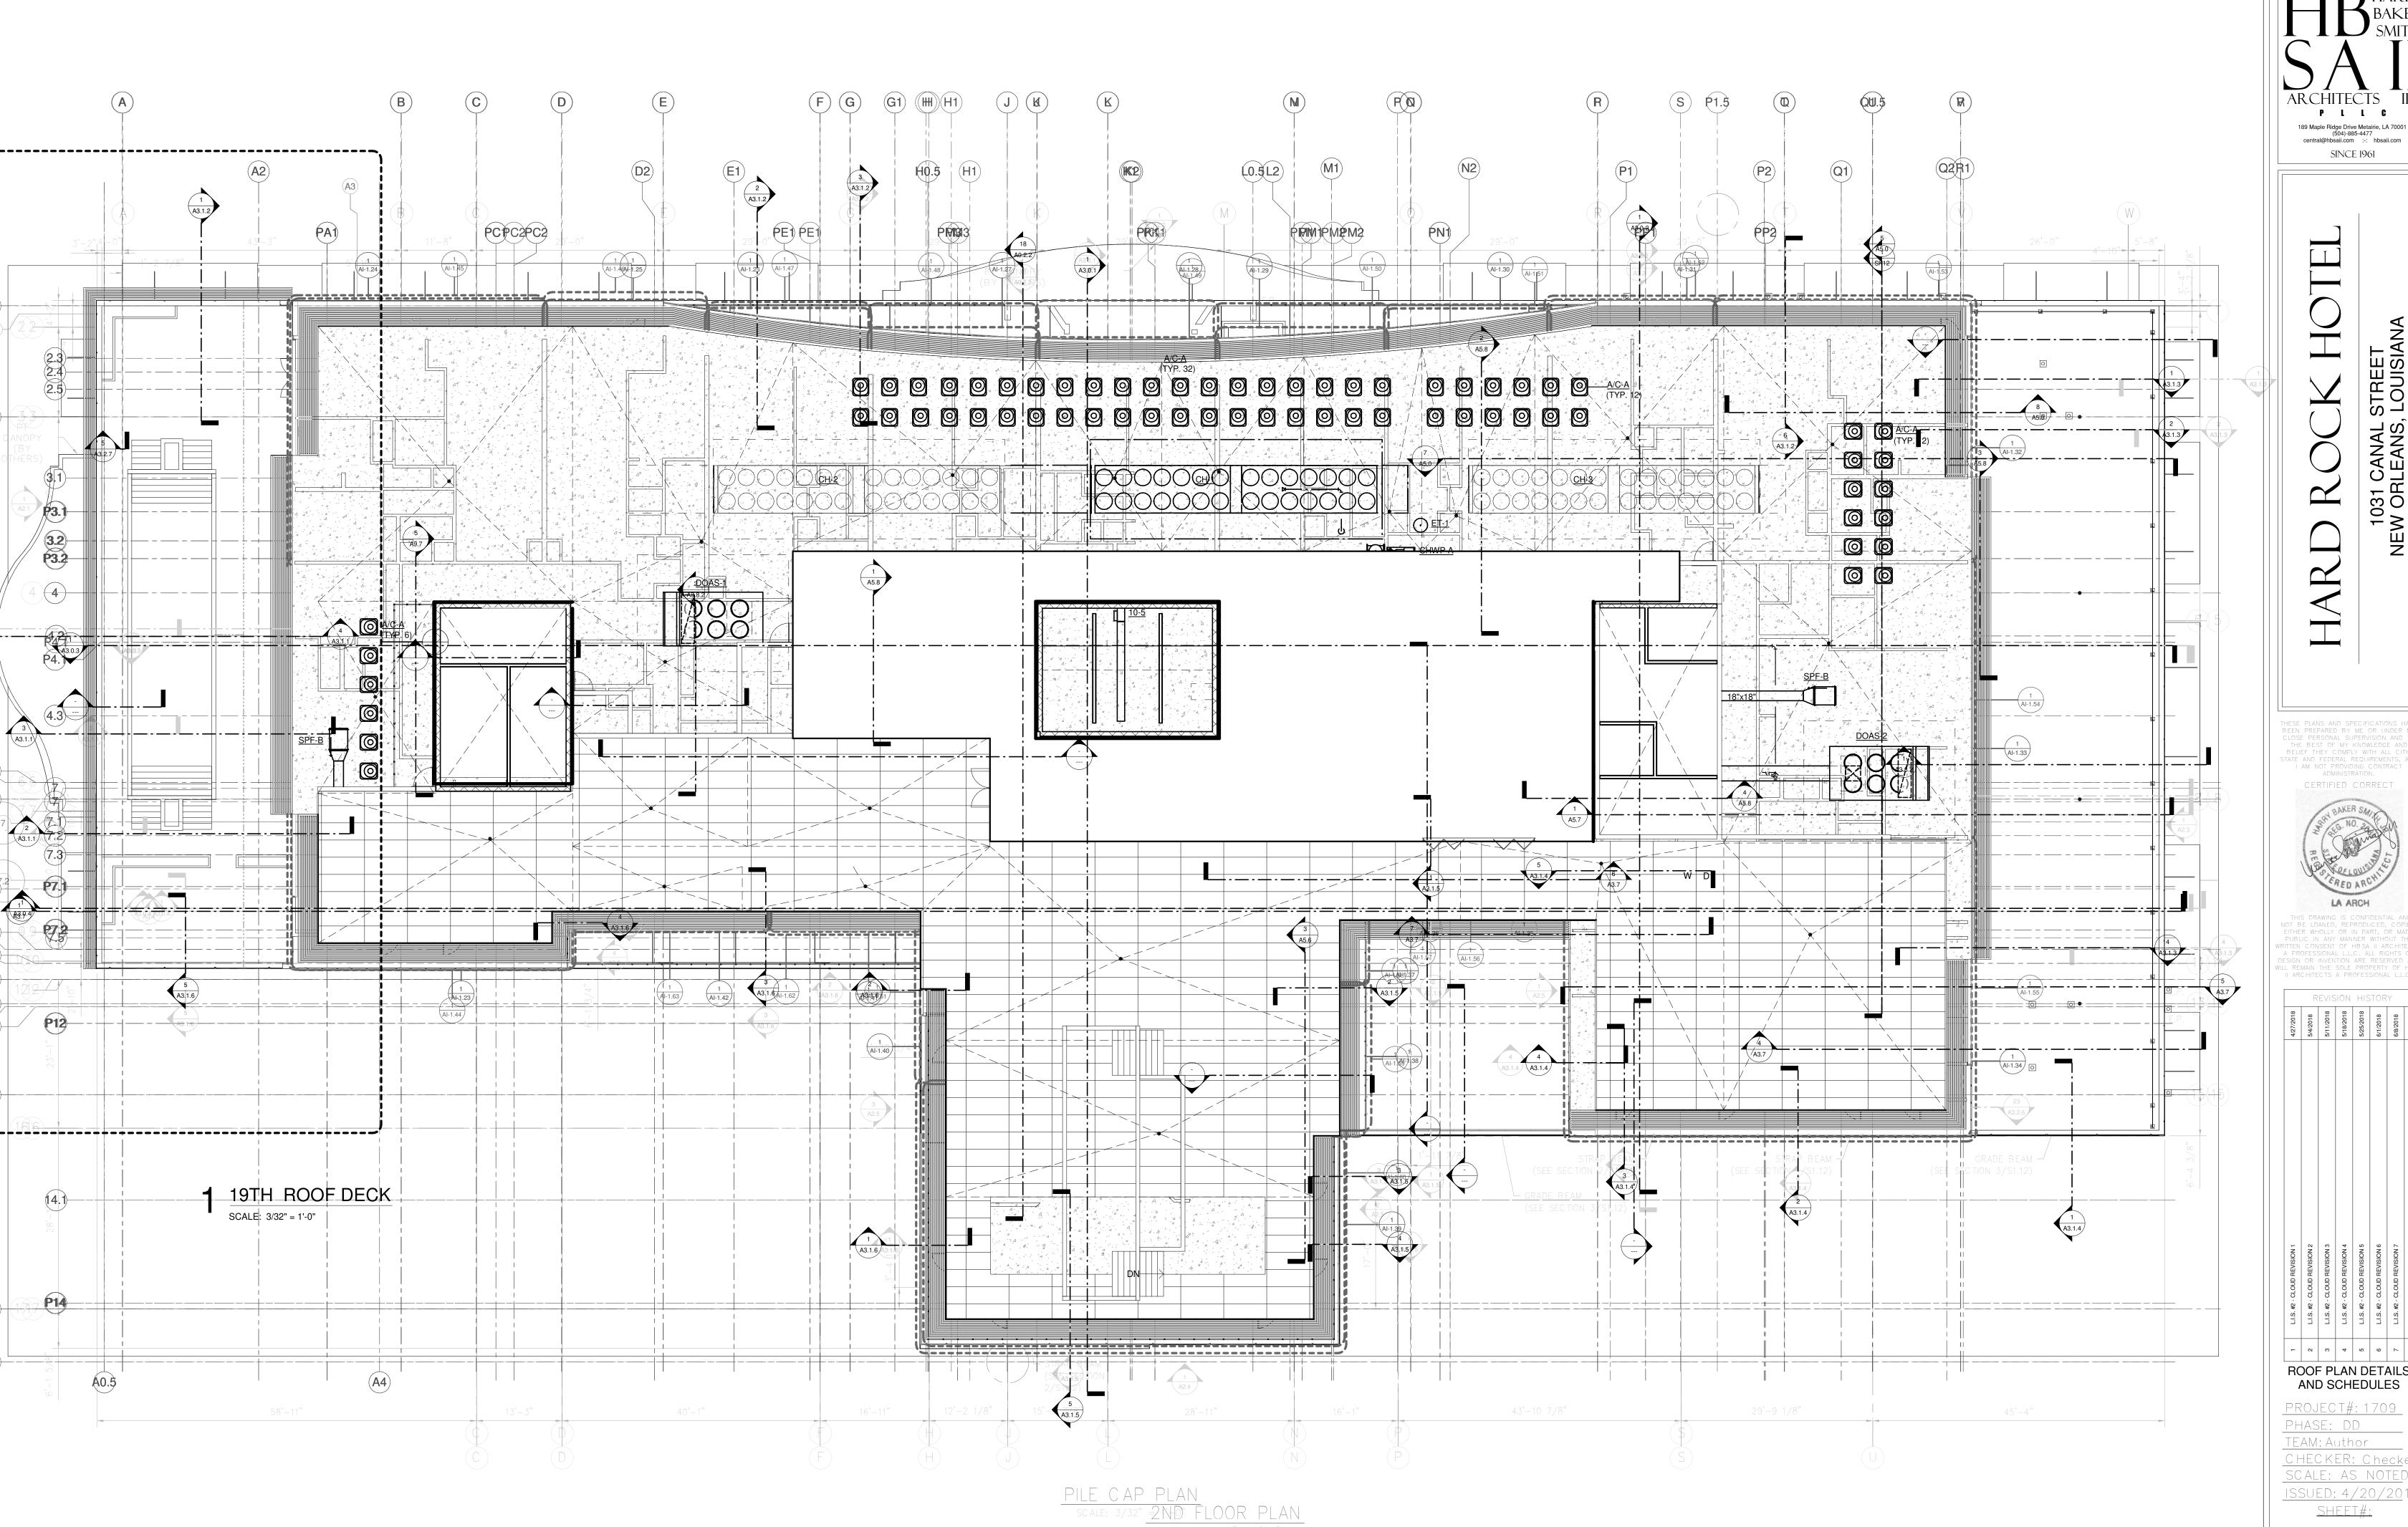

1031 CANAL STREET NEW ORLEANS, LOUISIANA

REVISION HISTORY

ROOF PLAN DETAILS

AND SCHEDULES PROJECT#: 1709 PHASE: DD TEAM: Author CHECKER: Checker

ISSUED: 4/20/2018

DROCKHOTE

1031 CANAL STREET

NEW ORLEANS, LOUISIANA

THESE PLANS AND SPECIFICATIONS HAVE BEEN PREPARED BY ME OR UNDER MY CLOSE PERSONAL SUPERVISION AND TO THE BEST OF MY KNOWLEDGE AND BELIEF THEY COMPLY WITH ALL CITY, STATE AND FEDERAL REQUIREMENTS, AND I AM NOT PROVIDING CONTRACT ADMINISTRATION.

CERTIFIED CORRECT




THIS DRAWING IS CONFIDENTIAL AND NOT BE LOANED, REPRODUCED, COPIED, EITHER WHOLLY OR IN PART, OR MADE PUBLIC IN ANY MANNER WITHOUT THE WRITTEN CONSENT OF HBSA II ARCHITECTS, A PROFESSIONAL L.L.C. ALL RIGHTS OF DESIGN OR INVENTION ARE RESERVED AND WILL REMAIN THE SOLE PROPERTY OF HBSA II ARCHITECTS A PROFESSIONAL I.I.C.

|                              | R                            | EVIS                         |                              |                              | TOR                          | Y                            |    |
|------------------------------|------------------------------|------------------------------|------------------------------|------------------------------|------------------------------|------------------------------|----|
| 4/27/2018                    | 5/4/2018                     | 5/11/2018                    | 5/18/2018                    | 5/25/2018                    | 6/1/2018                     | 6/8/2018                     |    |
| L.I.S. #2 - CLOUD REVISION 1 | L.I.S. #2 - CLOUD REVISION 2 | L.I.S. #2 - CLOUD REVISION 3 | L.I.S. #2 - CLOUD REVISION 4 | L.I.S. #2 - CLOUD REVISION 5 | L.I.S. #2 - CLOUD REVISION 6 | L.I.S. #2 - CLOUD REVISION 7 |    |
| -                            | 5                            | က                            | 4                            | 2                            | 9                            | 7                            | 80 |
|                              | CA                           | NA                           | LS                           | TR                           | ΕĒ                           | Т                            |    |


PROJECT#: 1709
PHASE: DD
TEAM: Author
CHECKER: Checker
SCALE: AS NOTED

A2.1

ISSUED: 4/20/2018

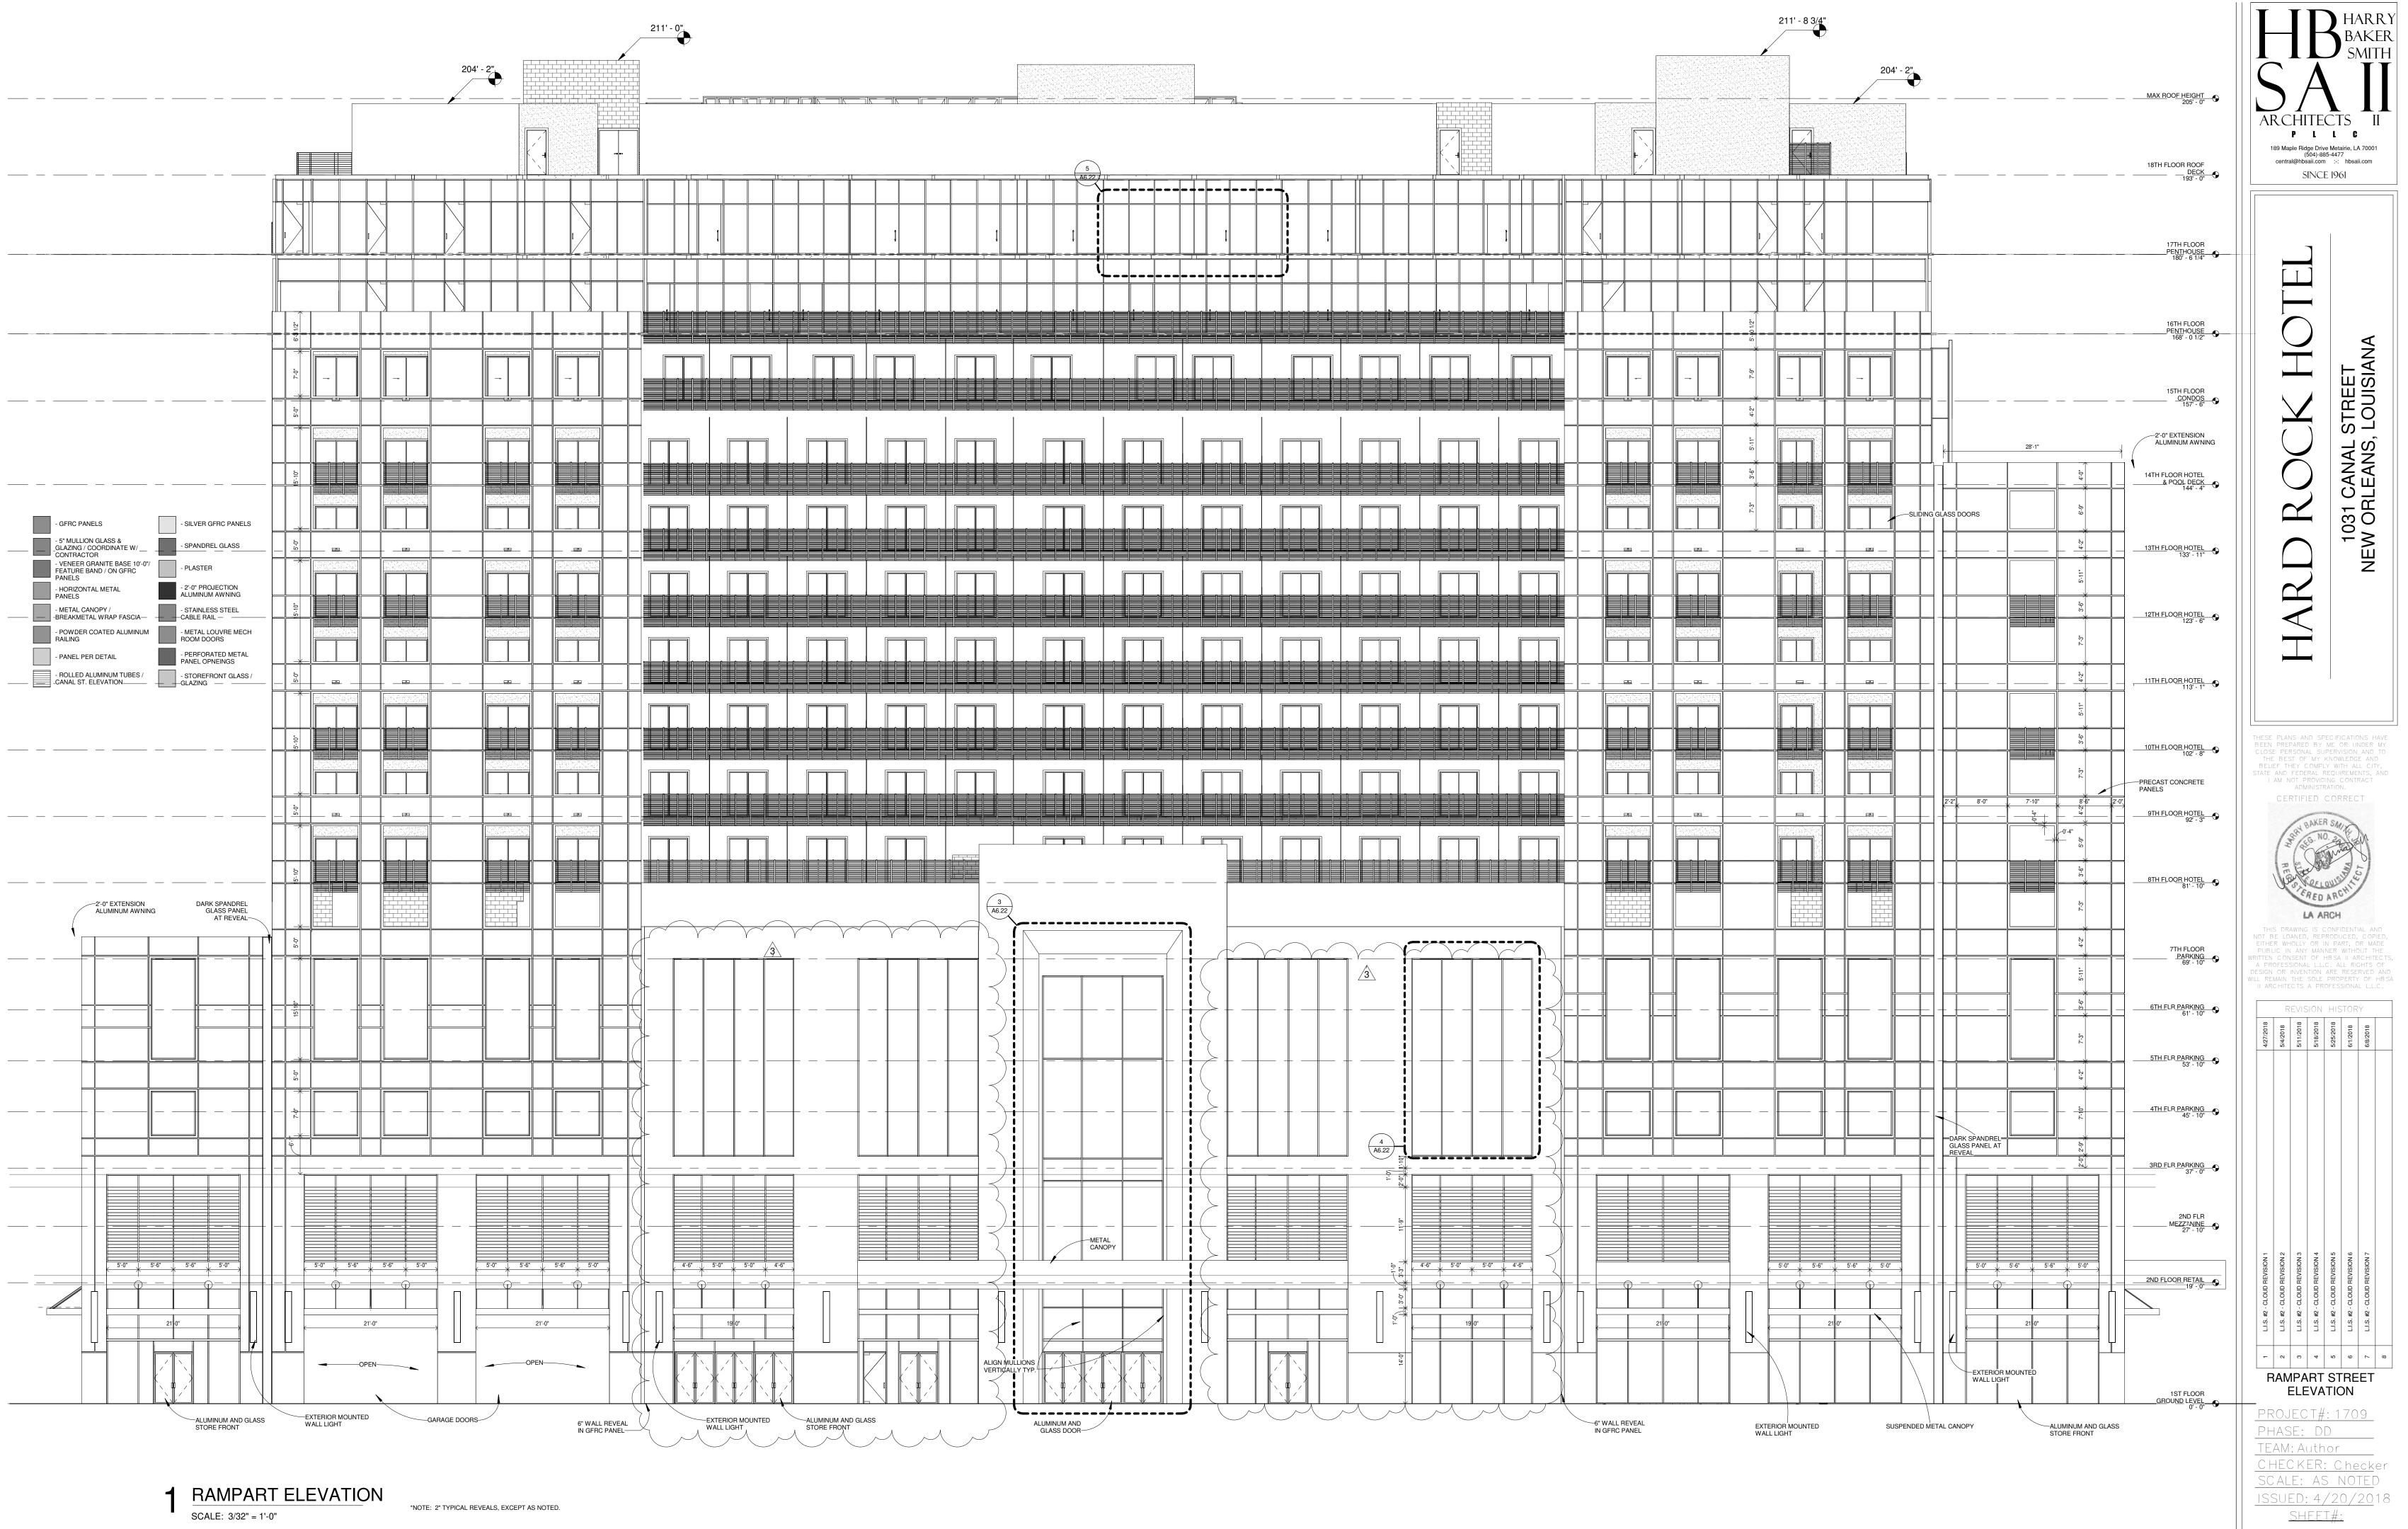

A2.2

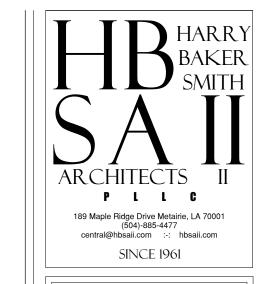

ARD ROCK HOTEI

1031 CANAL STREET

NEW ORLEANS, LOUISIANA

THESE PLANS AND SPECIFICATIONS HAVE
BEEN PREPARED BY ME OR UNDER MY
CLOSE PERSONAL SUPERVISION AND TO
THE BEST OF MY KNOWLEDGE AND
BELIEF THEY COMPLY WITH ALL CITY,
STATE AND FEDERAL REQUIREMENTS, AND
I AM NOT PROVIDING CONTRACT
ADMINISTRATION.
CERTIFIED CORRECT



THIS DRAWING IS CONFIDENTIAL AND
NOT BE LOANED, REPRODUCED, COPIED
EITHER WHOLLY OR IN PART, OR MADE
PUBLIC IN ANY MANNER WITHOUT THE
WRITTEN CONSENT OF HBSA II ARCHITECT
A PROFESSIONAL L.L.C. ALL RIGHTS OF
DESIGN OR INVENTION ARE RESERVED AN
WILL REMAIN THE SOLE PROPERTY OF HB

|                              | R                            | EVIS                         | ION                          | HIS                          | TOR                          | Υ                            |   |
|------------------------------|------------------------------|------------------------------|------------------------------|------------------------------|------------------------------|------------------------------|---|
| 4/27/2018                    | 5/4/2018                     | 5/11/2018                    | 5/18/2018                    | 5/25/2018                    | 6/1/2018                     | 6/8/2018                     |   |
| L.I.S. #2 - CLOUD REVISION 1 | L.I.S. #2 - CLOUD REVISION 2 | L.I.S. #2 - CLOUD REVISION 3 | L.I.S. #2 - CLOUD REVISION 4 | L.I.S. #2 - CLOUD REVISION 5 | L.I.S. #2 - CLOUD REVISION 6 | L.I.S. #2 - CLOUD REVISION 7 |   |
|                              |                              |                              |                              |                              |                              |                              | l |

- VENEER GRANITE BASE 10'-0"/
FEATURE BAND / ON GFRC
PANELS

- HORIZONTAL METAL
PANELS

- METAL CANOPY /
BREAKMETAL WRAP FASCIA

- POWDER COATED ALUMINUM
RAILING

- PANEL PER DETAIL

- PORFORATED METAL
PANEL OPNEINGS

- ROLLED ALUMINUM TUBES /
CANAL ST. ELEVATION

- PLASTER

- PLASTER

- PROJECTION
ALUMINUM AWNING

- STAINLESS STEEL
CABLE RAIL

- METAL LOUVRE MECH
ROOM DOORS

- PERFORATED METAL
PANEL OPNEINGS

- STOREFRONT GLASS /
GLAZING

- SILVER GFRC PANELS


- SPANDREL GLASS


- 5" MULLION GLASS & GLAZING / COORDINATE W/ CONTRACTOR

PROJECT#: 1709
PHASE: DD
TEAM: Author
CHECKER: Checker
SCALE: AS NOTED

ISSUED: 4/20/2018

IBERVILLE STREET

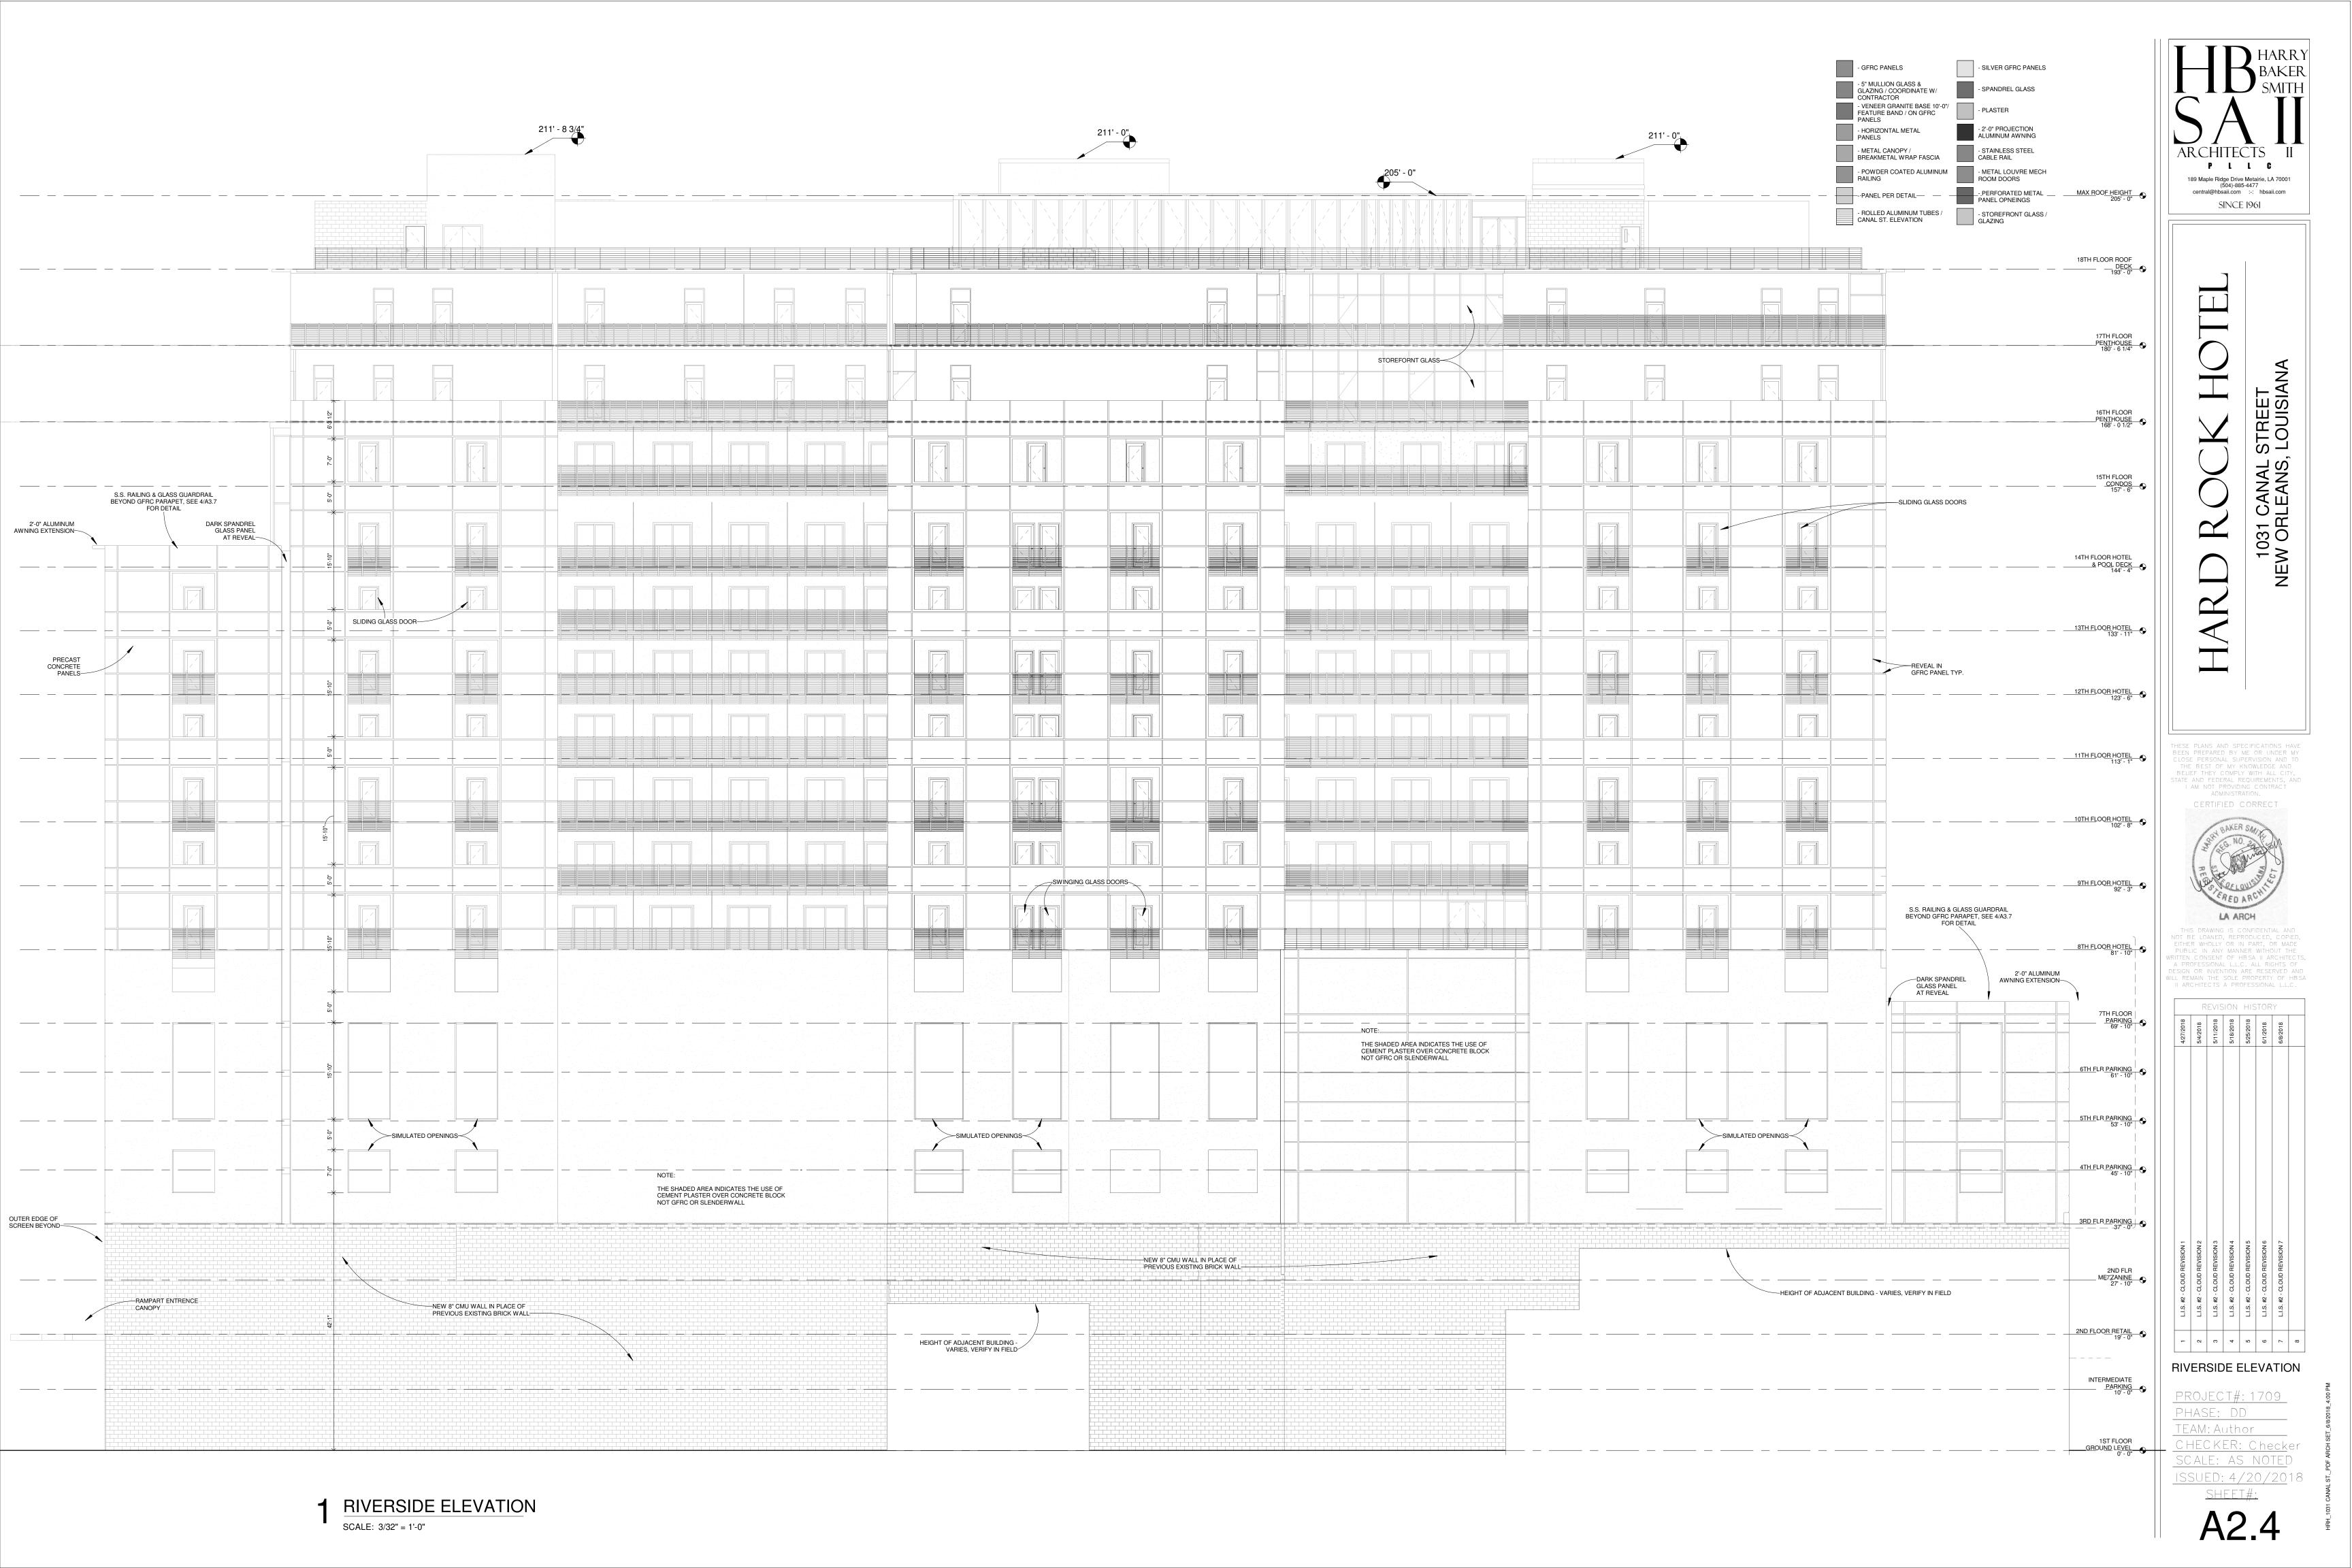

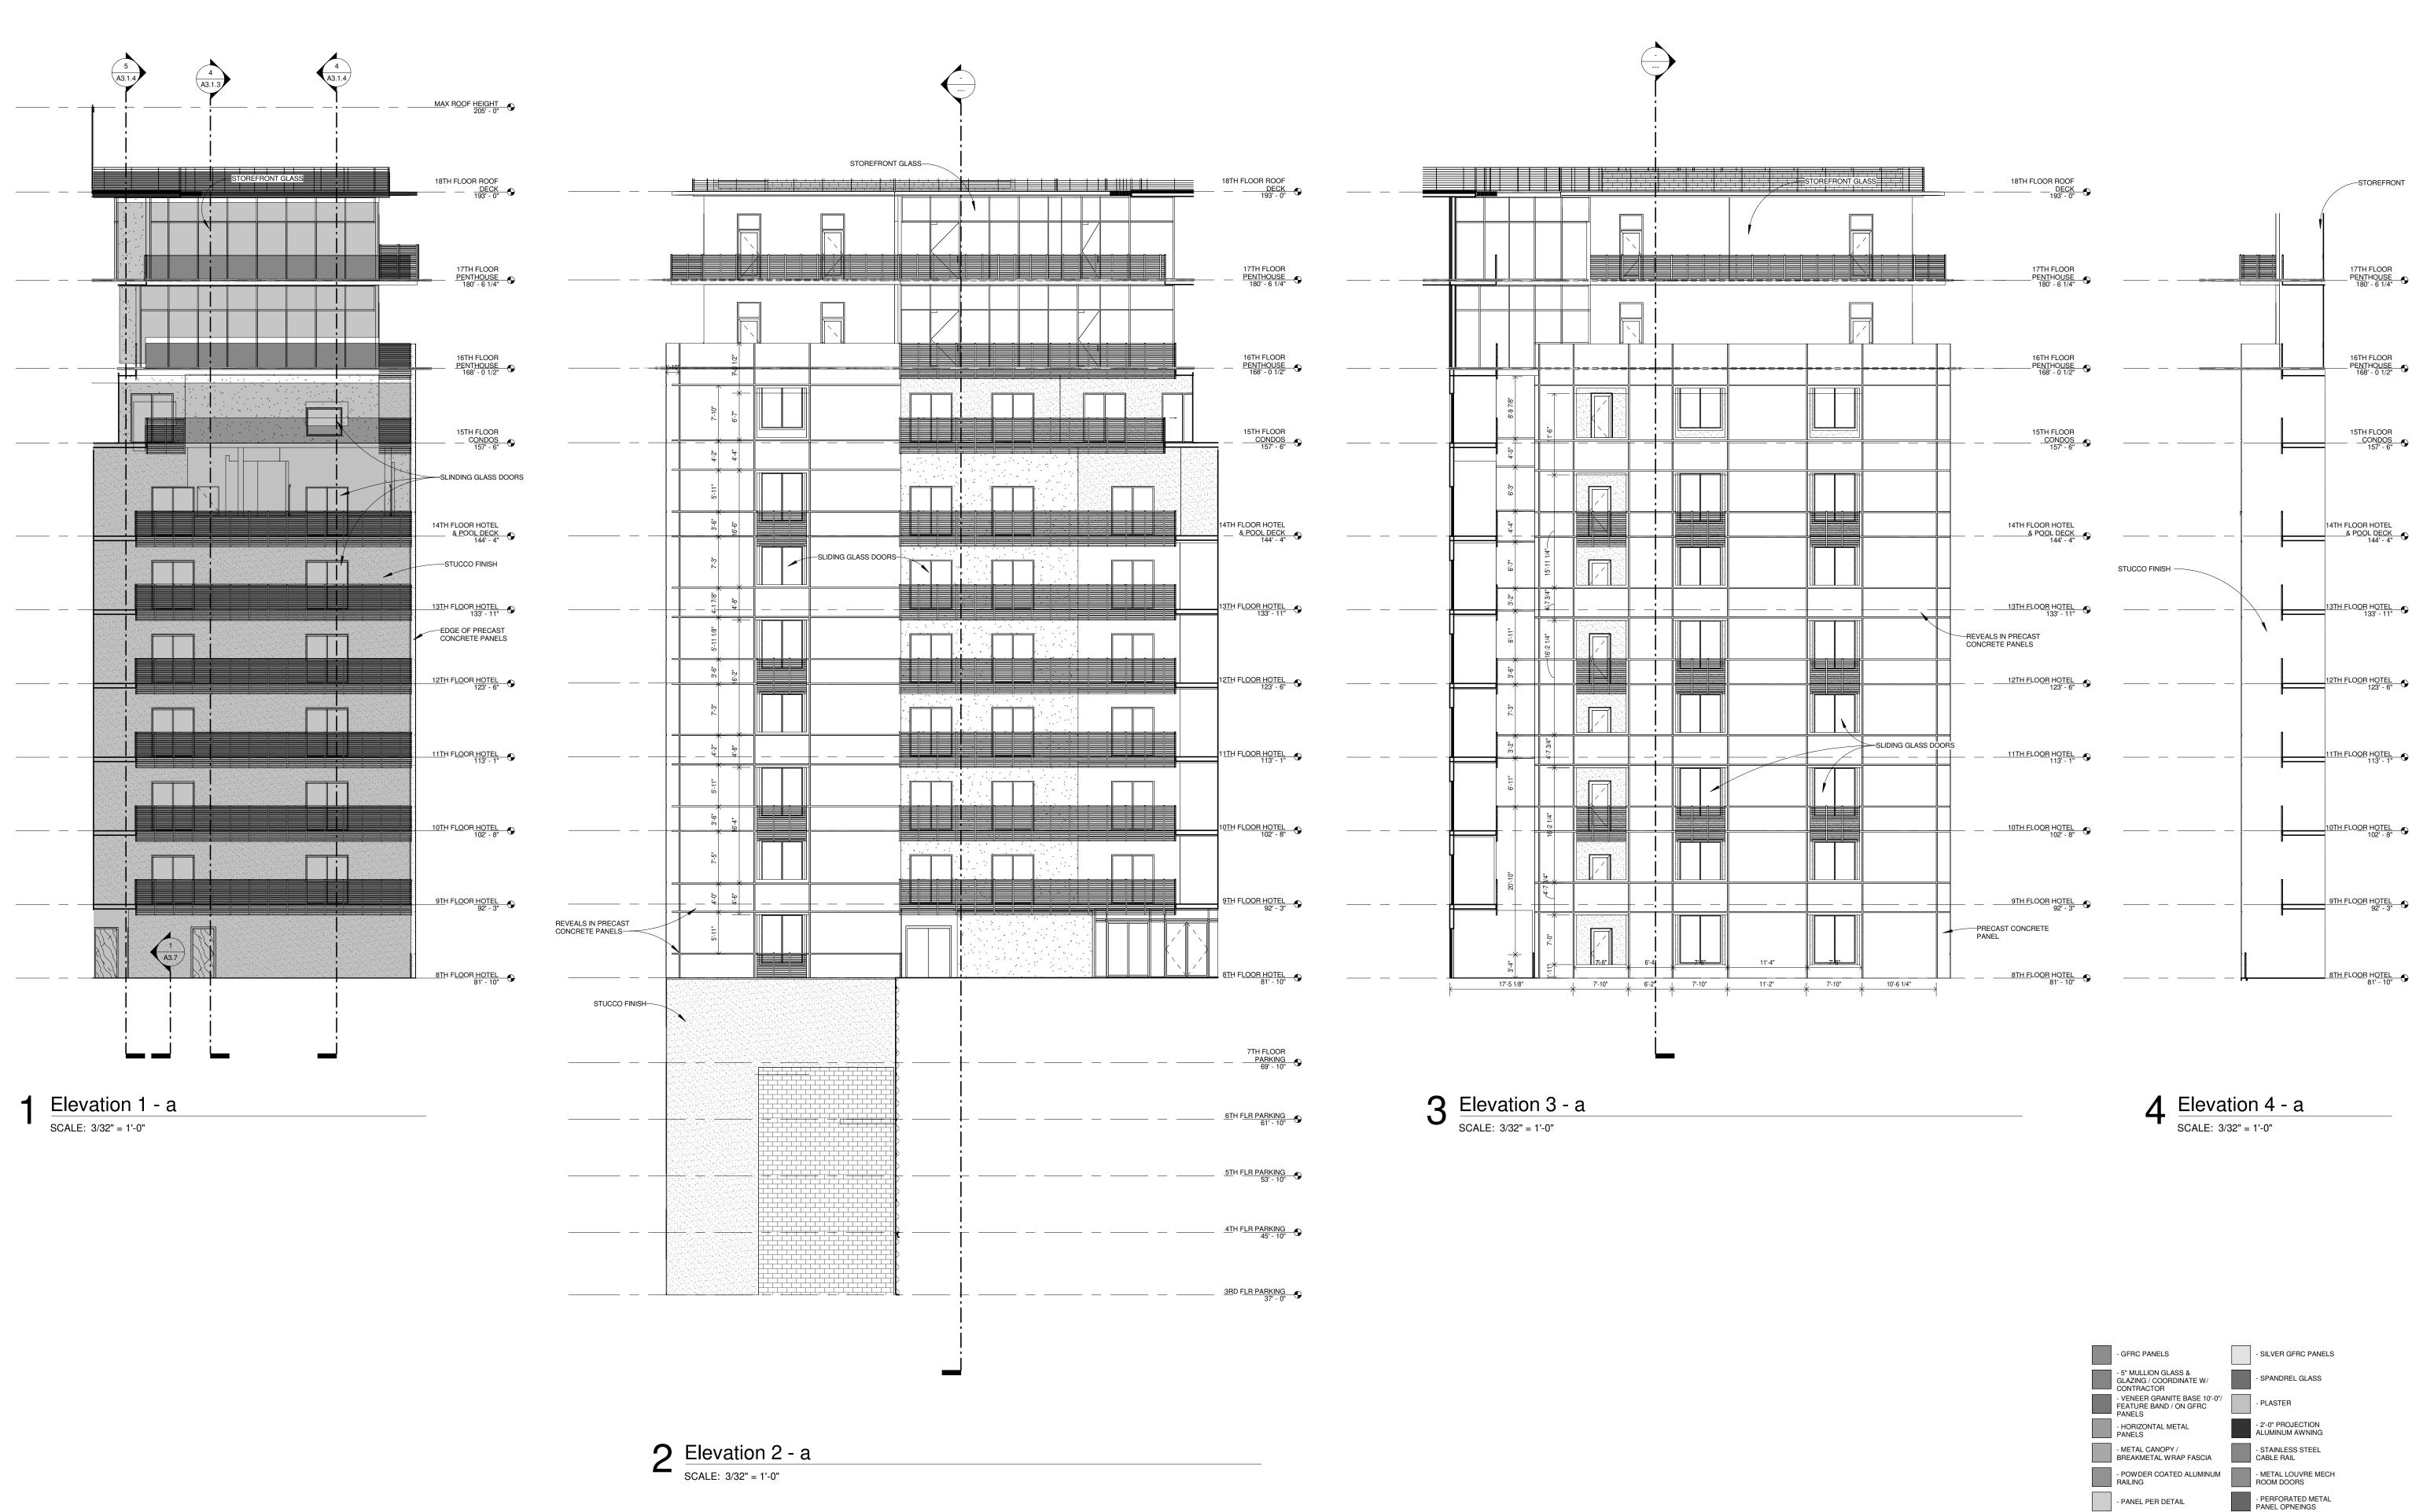


2D ROCK HOTEL


1031 CANAL STREET
NEW ORLEANS, LOUISIANA

SE PLANS AND SPECIFICATIONS HAVE
N PREPARED BY ME OR UNDER MY
USE PERSONAL SUPERVISION AND TO
HE BEST OF MY KNOWLEDGE AND
CLIEF THEY COMPLY WITH ALL CITY,
E AND FEDERAL REQUIREMENTS, AND
I AM NOT PROVIDING CONTRACT
ADMINISTRATION.

CERTIFIED CORRECT

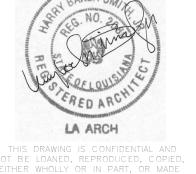

THIS DRAWING IS CONFIDENTIAL AND NOT BE LOANED, REPRODUCED, COPIED, EITHER WHOLLY OR IN PART, OR MADE PUBLIC IN ANY MANNER WITHOUT THE WRITTEN CONSENT OF HBSA II ARCHITECTS A PROFESSIONAL L.L.C. ALL RIGHTS OF DESIGN OR INVENTION ARE RESERVED AND WILL REMAIN THE SOLE PROPERTY OF HBSA II ARCHITECTS A PROFESSIONAL L.L.C.

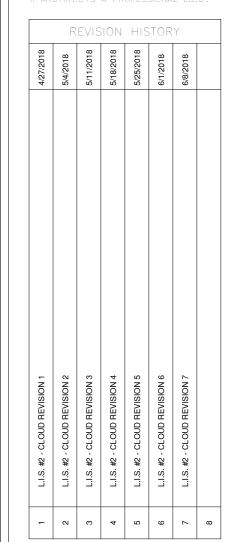

ELEVATIONS

PROJECT#: 1709
PHASE: DD

TEAM: Author
CHECKER: Checker
SCALE: AS NOTED
ISSUED: 4/20/2018

- ROLLED ALUMINUM TUBES / CANAL ST. ELEVATION

- STOREFRONT GLASS / GLAZING

A2.5

189 Maple Ridge Drive Metairie, LA 70001 (504)-885-4477 central@hbsaii.com :: hbsaii.com SINCE 1961

1031 CANAL STREET NEW ORLEANS, LOUISIANA

BEEN PREPARED BY ME OR UNDER MY
CLOSE PERSONAL SUPERVISION AND TO
THE BEST OF MY KNOWLEDGE AND
BELIEF THEY COMPLY WITH ALL CITY,
STATE AND FEDERAL REQUIREMENTS, AND
I AM NOT PROVIDING CONTRACT
ADMINISTRATION. CERTIFIED CORRECT



TRANSVERSE BUILDING SECTION PROJECT#: 1709 PHASE: DD TEAM: Author CHECKER: Checker SCALE: AS NOTED

IS<u>SUED: 4/20/20</u>18

TRANSVERSE BUILDING SECTION

SCALE: 3/32" = 1'-0" A1.1/ A3.0.2

HARD ROCK HOTEI 1031 CANAL STREET NEW ORLEANS, LOUISIANA

THESE PLANS AND SPECIFICATIONS HAVE BEEN PREPARED BY ME OR UNDER MY CLOSE PERSONAL SUPERVISION AND TO THE BEST OF MY KNOWLEDGE AND BELIEF THEY COMPLY WITH ALL CITY, STATE AND FEDERAL REQUIREMENTS, AND I AM NOT PROVIDING CONTRACT ADMINISTRATION.

CERTIFIED CORRECT



THIS DRAWING IS CONFIDENTIAL AND
NOT BE LOANED, REPRODUCED, COPIED,
EITHER WHOLLY OR IN PART, OR MADE
PUBLIC IN ANY MANNER WITHOUT THE
WRITTEN CONSENT OF HBSA II ARCHITECTS,
A PROFESSIONAL L.L.C. ALL RIGHTS OF
DESIGN OR INVENTION ARE RESERVED AND
WILL REMAIN THE SOLE PROPERTY OF HBSA

|                              |                              | EV/IC                        | 101                          | 1110                         | TAR                          | · · · · · ·                  |   |
|------------------------------|------------------------------|------------------------------|------------------------------|------------------------------|------------------------------|------------------------------|---|
|                              | K                            | EVIS                         |                              |                              | TOR                          | Ϋ́                           |   |
| 4/27/2018                    | 5/4/2018                     | 5/11/2018                    | 5/18/2018                    | 5/25/2018                    | 6/1/2018                     | 6/8/2018                     |   |
| L.I.S. #2 - CLOUD REVISION 1 | L.I.S. #2 - CLOUD REVISION 2 | L.I.S. #2 - CLOUD REVISION 3 | L.I.S. #2 - CLOUD REVISION 4 | L.I.S. #2 - CLOUD REVISION 5 | L.I.S. #2 - CLOUD REVISION 6 | L.I.S. #2 - CLOUD REVISION 7 |   |
| -                            | 2                            | က                            | 4                            | 2                            | 9                            | 7                            | 8 |

TRANSVERSE BUILDING SECTION

PROJECT#: 1709
PHASE: DD


TEAM: Author

CHECKER: Checker

SCALE: AS NOTED


ISSUED: 4/20/2018

A3.0.2

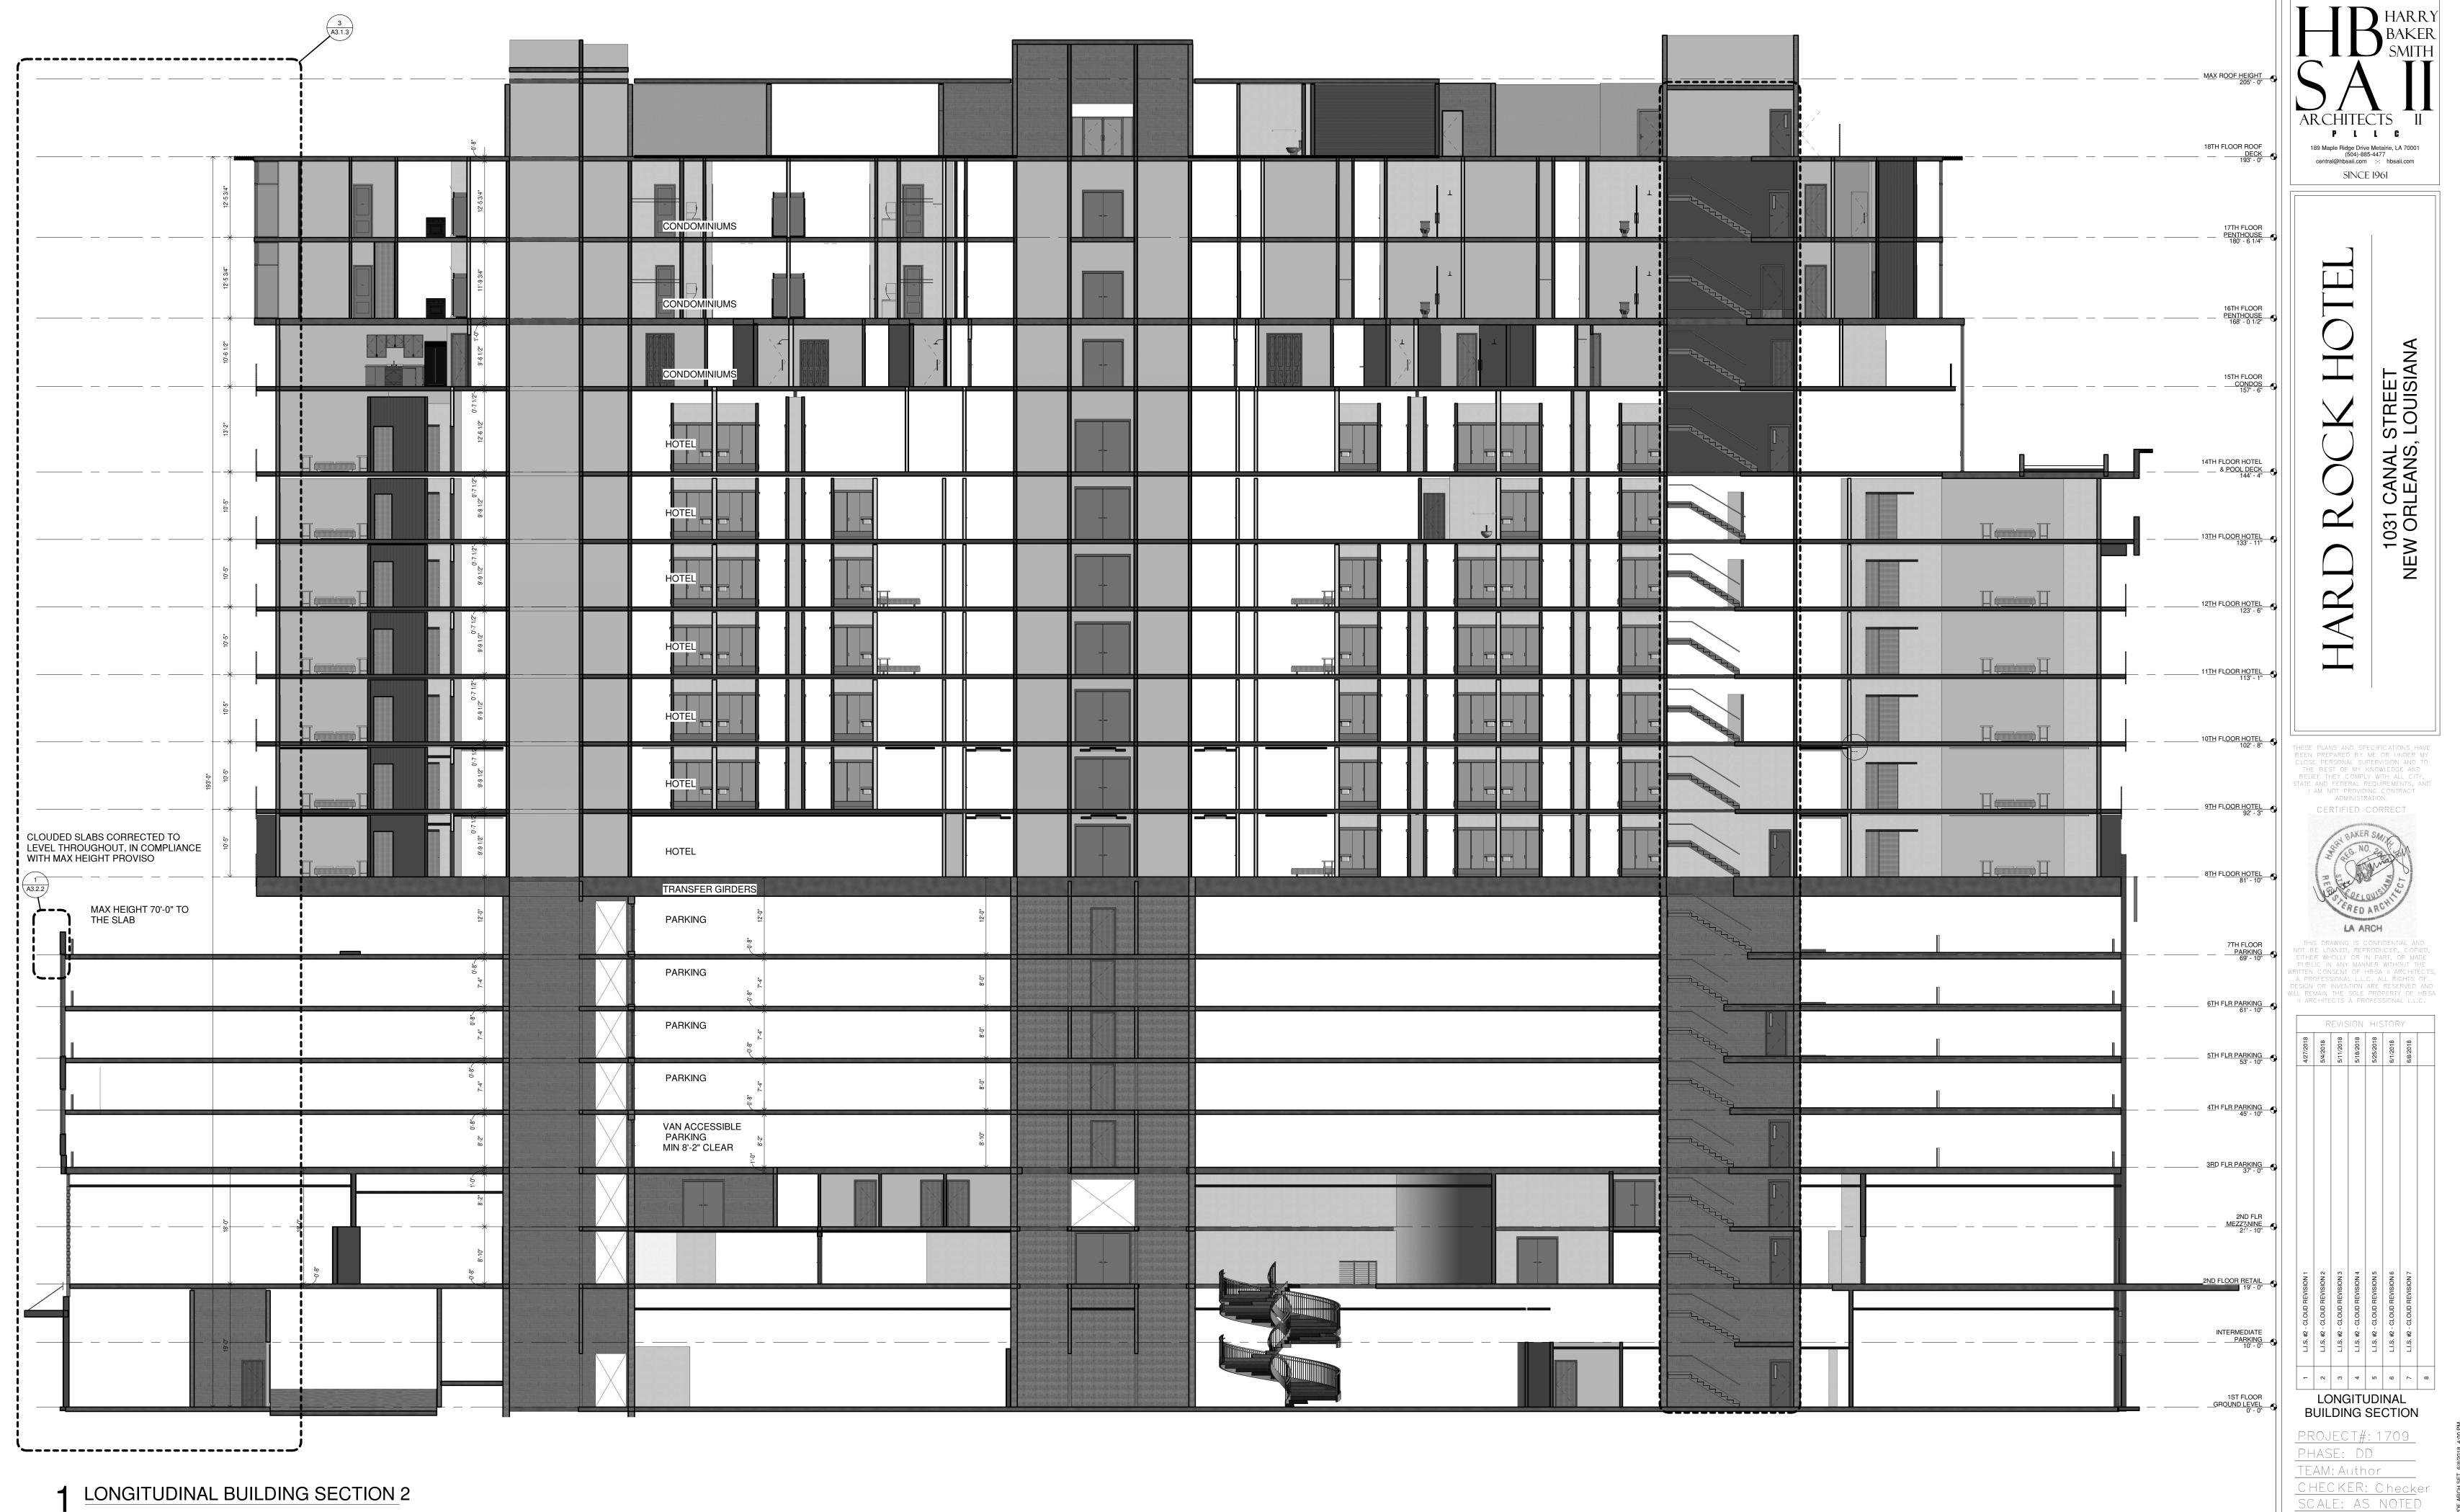

LONGITUDINAL BUILDING SECTION 2 SCALE: 3/32" = 1'-0"

ISSUED: 4/20/2018

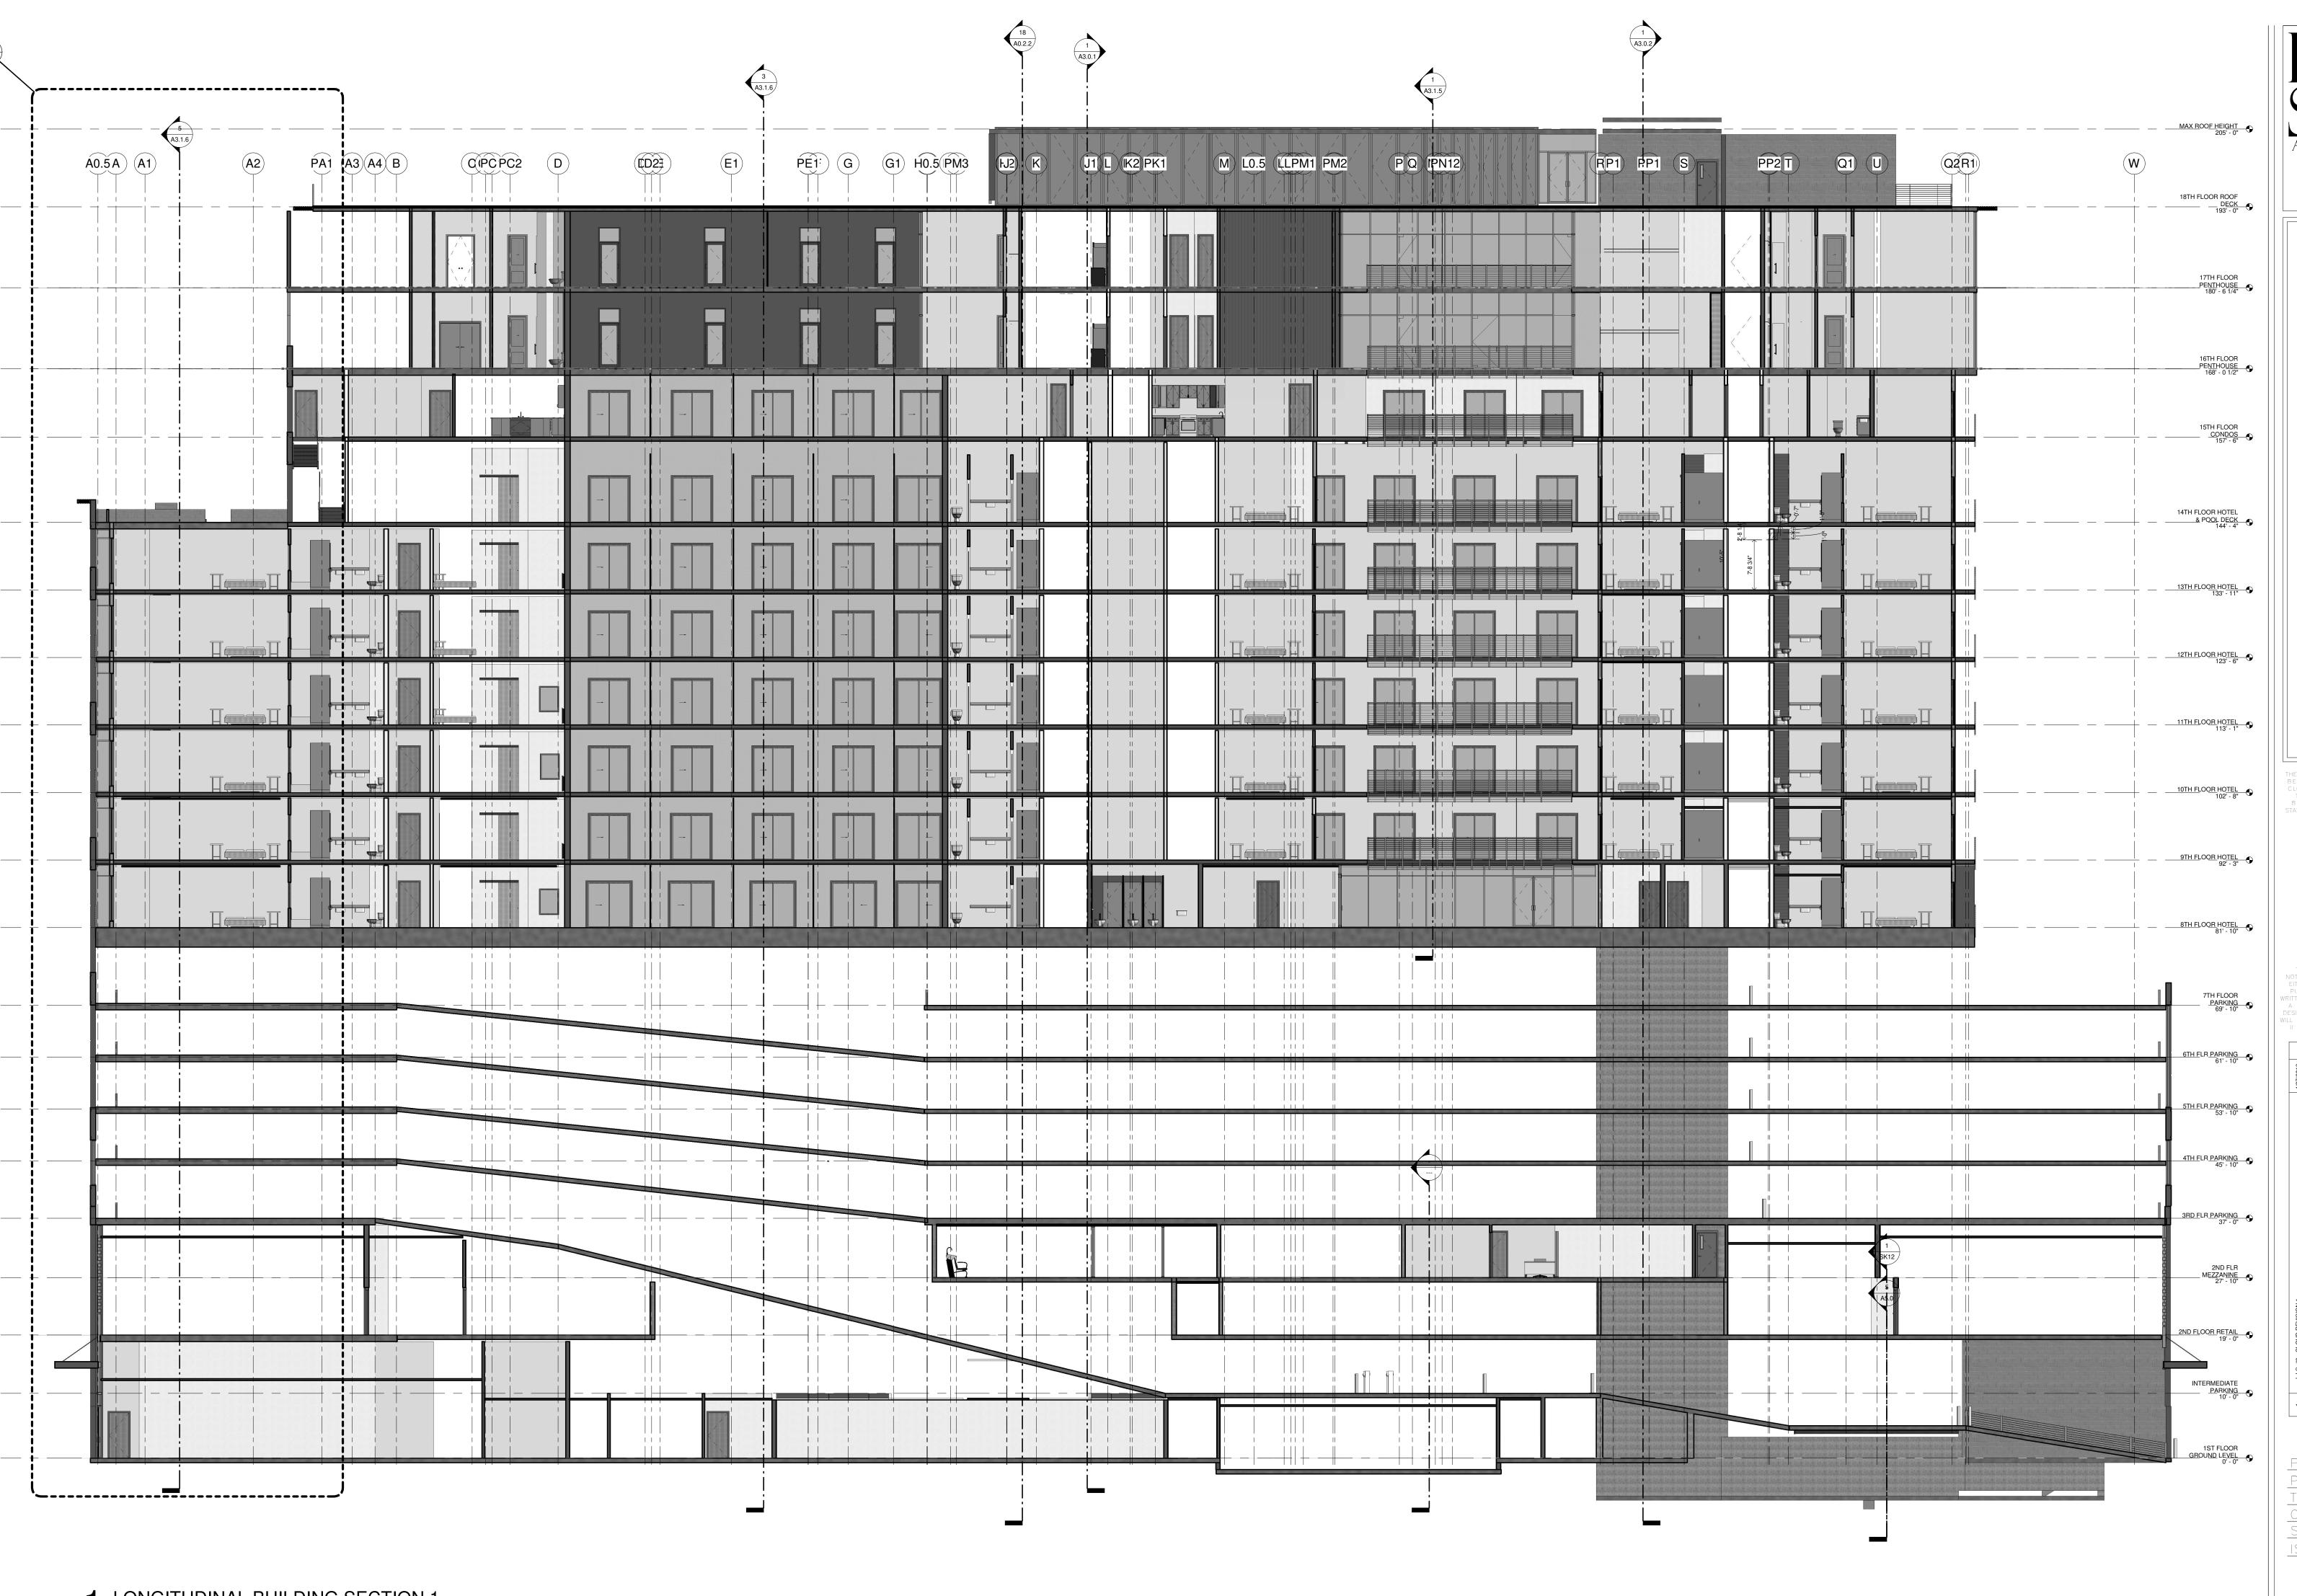

HARD ROCK HOTEL

1031 CANAL STREET

NEW ORLEANS, LOUISIANA

THESE PLANS AND SPECIFICATIONS HAVE
BEEN PREPARED BY ME OR UNDER MY
CLOSE PERSONAL SUPERVISION AND TO
THE BEST OF MY KNOWLEDGE AND
BELIEF THEY COMPLY WITH ALL CITY,
STATE AND FEDERAL REQUIREMENTS, AND
I AM NOT PROVIDING CONTRACT
ADMINISTRATION.
CERTIFIED CORRECT




THIS DRAWING IS CONFIDENTIAL AND NOT BE LOANED, REPRODUCED, COPIE! EITHER WHOLLY OR IN PART, OR MADE PUBLIC IN ANY MANNER WITHOUT THE WRITTEN CONSENT OF HBSA II ARCHITEC A PROFESSIONAL L.L.C. ALL RIGHTS OF DESIGN OR INVENTION ARE RESERVED A WILL REMAIN THE SOLE PROPERTY OF HE

|                          | R                        | EVIS                     | ION                      | HIS                      | TOR                      | Υ                        |  |
|--------------------------|--------------------------|--------------------------|--------------------------|--------------------------|--------------------------|--------------------------|--|
| 4/27/2018                | 5/4/2018                 | 5/11/2018                | 5/18/2018                | 5/25/2018                | 6/1/2018                 | 6/8/2018                 |  |
| 4                        | E.                       | E)                       | E)                       | E.                       | 9                        | 9                        |  |
| 3, #2 - CLOUD REVISION 1 | 3, #2 - CLOUD REVISION 2 | 3. #2 - CLOUD REVISION 3 | 3. #2 - CLOUD REVISION 4 | 3. #2 - CLOUD REVISION 5 | 3. #2 - CLOUD REVISION 6 | s. #2 - CLOUD REVISION 7 |  |

LONGITUDINAL BUILDING SECTION

PROJECT#: 1709
PHASE: DD
TEAM: Author
CHECKER: Checker
SCALE: AS NOTED
ISSUED: 4/20/2018

A3 0 4

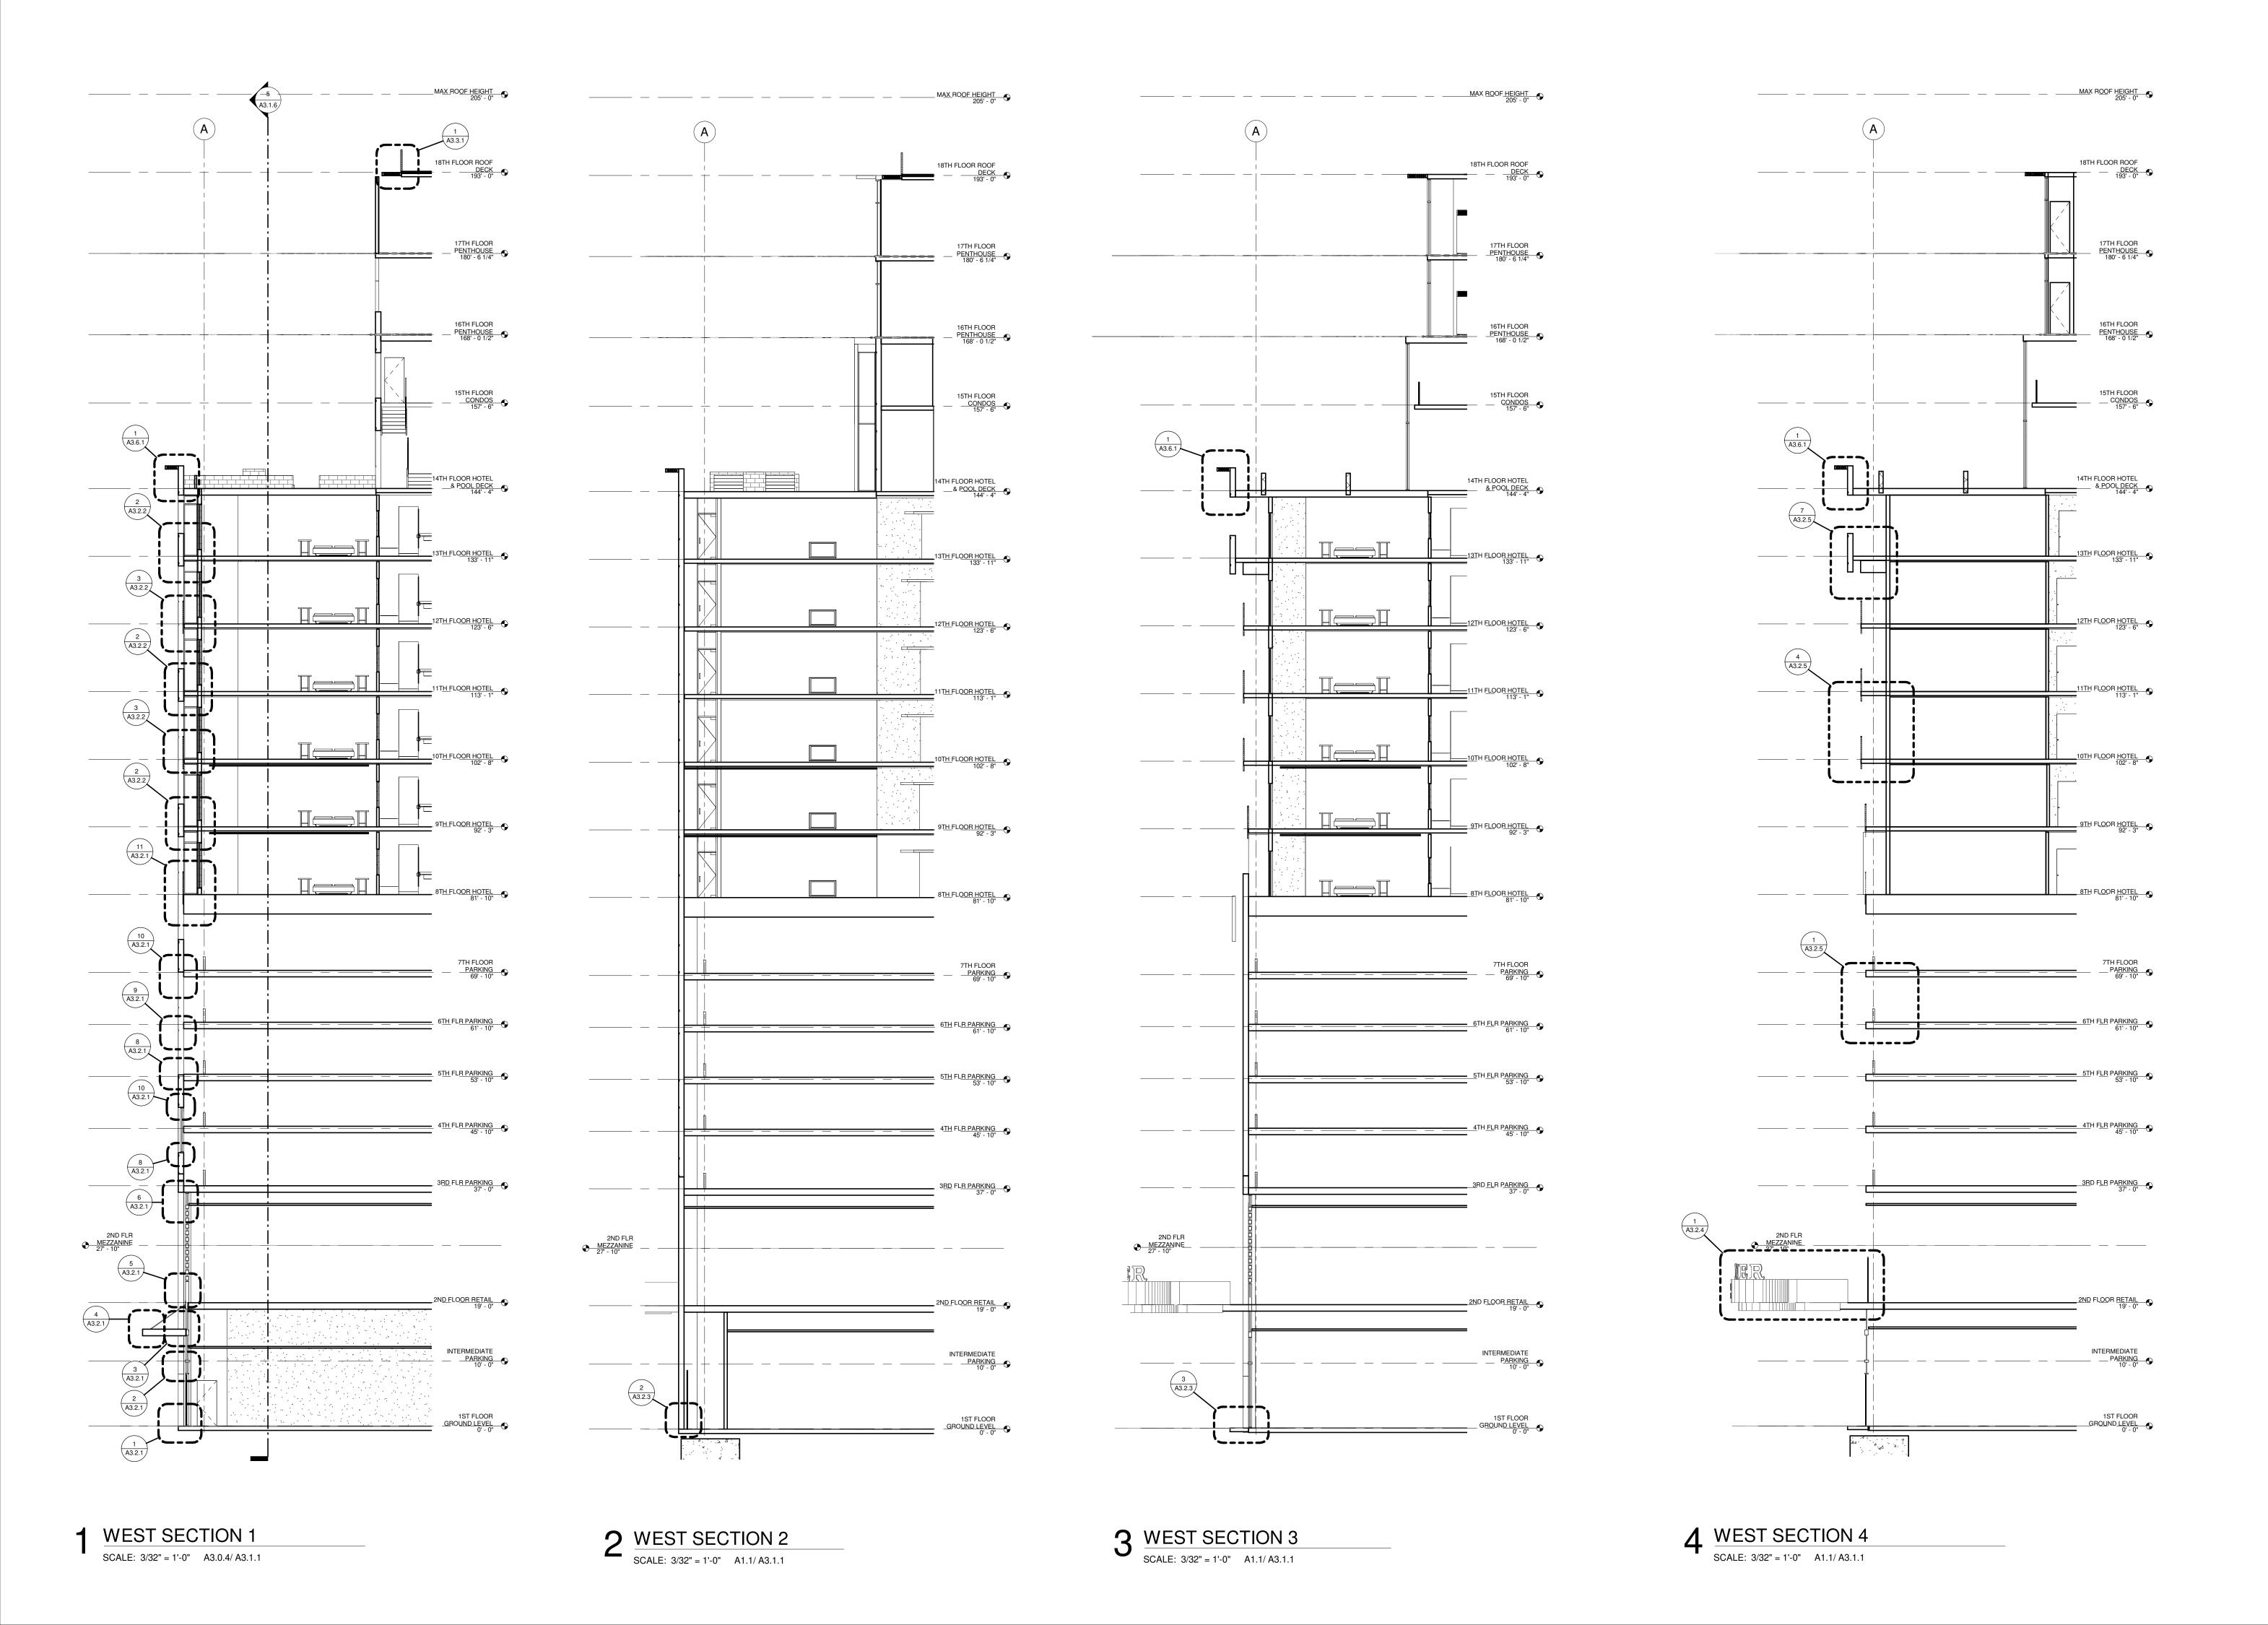

ROCKHOTE

1031 CANAL STREET

NEW ORLEANS, LOUISIANA

THESE PLANS AND SPECIFICATIONS HAVE BEEN PREPARED BY ME OR UNDER MY CLOSE PERSONAL SUPERVISION AND TO THE BEST OF MY KNOWLEDGE AND BELIEF THEY COMPLY WITH ALL CITY, STATE AND FEDERAL REQUIREMENTS, AND I AM NOT PROVIDING CONTRACT ADMINISTRATION.

CERTIFIED CORRECT




THIS DRAWING IS CONFIDENTIAL AND NOT BE LOANED, REPRODUCED, COPIED, EITHER WHOLLY OR IN PART, OR MADE PUBLIC IN ANY MANNER WITHOUT THE WRITTEN CONSENT OF HBSA II ARCHITECTS, A PROFESSIONAL L.L.C. ALL RIGHTS OF DESIGN OR INVENTION ARE RESERVED AND WILL REMAIN THE SOLE PROPERTY OF HBSA II ARCHITECTS A PROFESSIONAL L.L.C.

| - | L.I.S. #2 - CLOUD REVISION 1 | 4/27/2018 |
|---|------------------------------|-----------|
| 0 | L.I.S. #2 - CLOUD REVISION 2 | 5/4/2018  |
| က | L.I.S. #2 - CLOUD REVISION 3 | 5/11/2018 |
| 4 | L.I.S. #2 - CLOUD REVISION 4 | 5/18/2018 |
| 2 | L.I.S. #2 - CLOUD REVISION 5 | 5/25/2018 |
| 9 | L.I.S. #2 - CLOUD REVISION 6 | 6/1/2018  |
| _ | L.I.S. #2 - CLOUD REVISION 7 | 6/8/2018  |
| ω |                              |           |

SECTIONS

PROJECT#: 1709
PHASE: DD
TEAM: Author
CHECKER: Checker
SCALE: AS NOTED
ISSUED: 4/20/2018

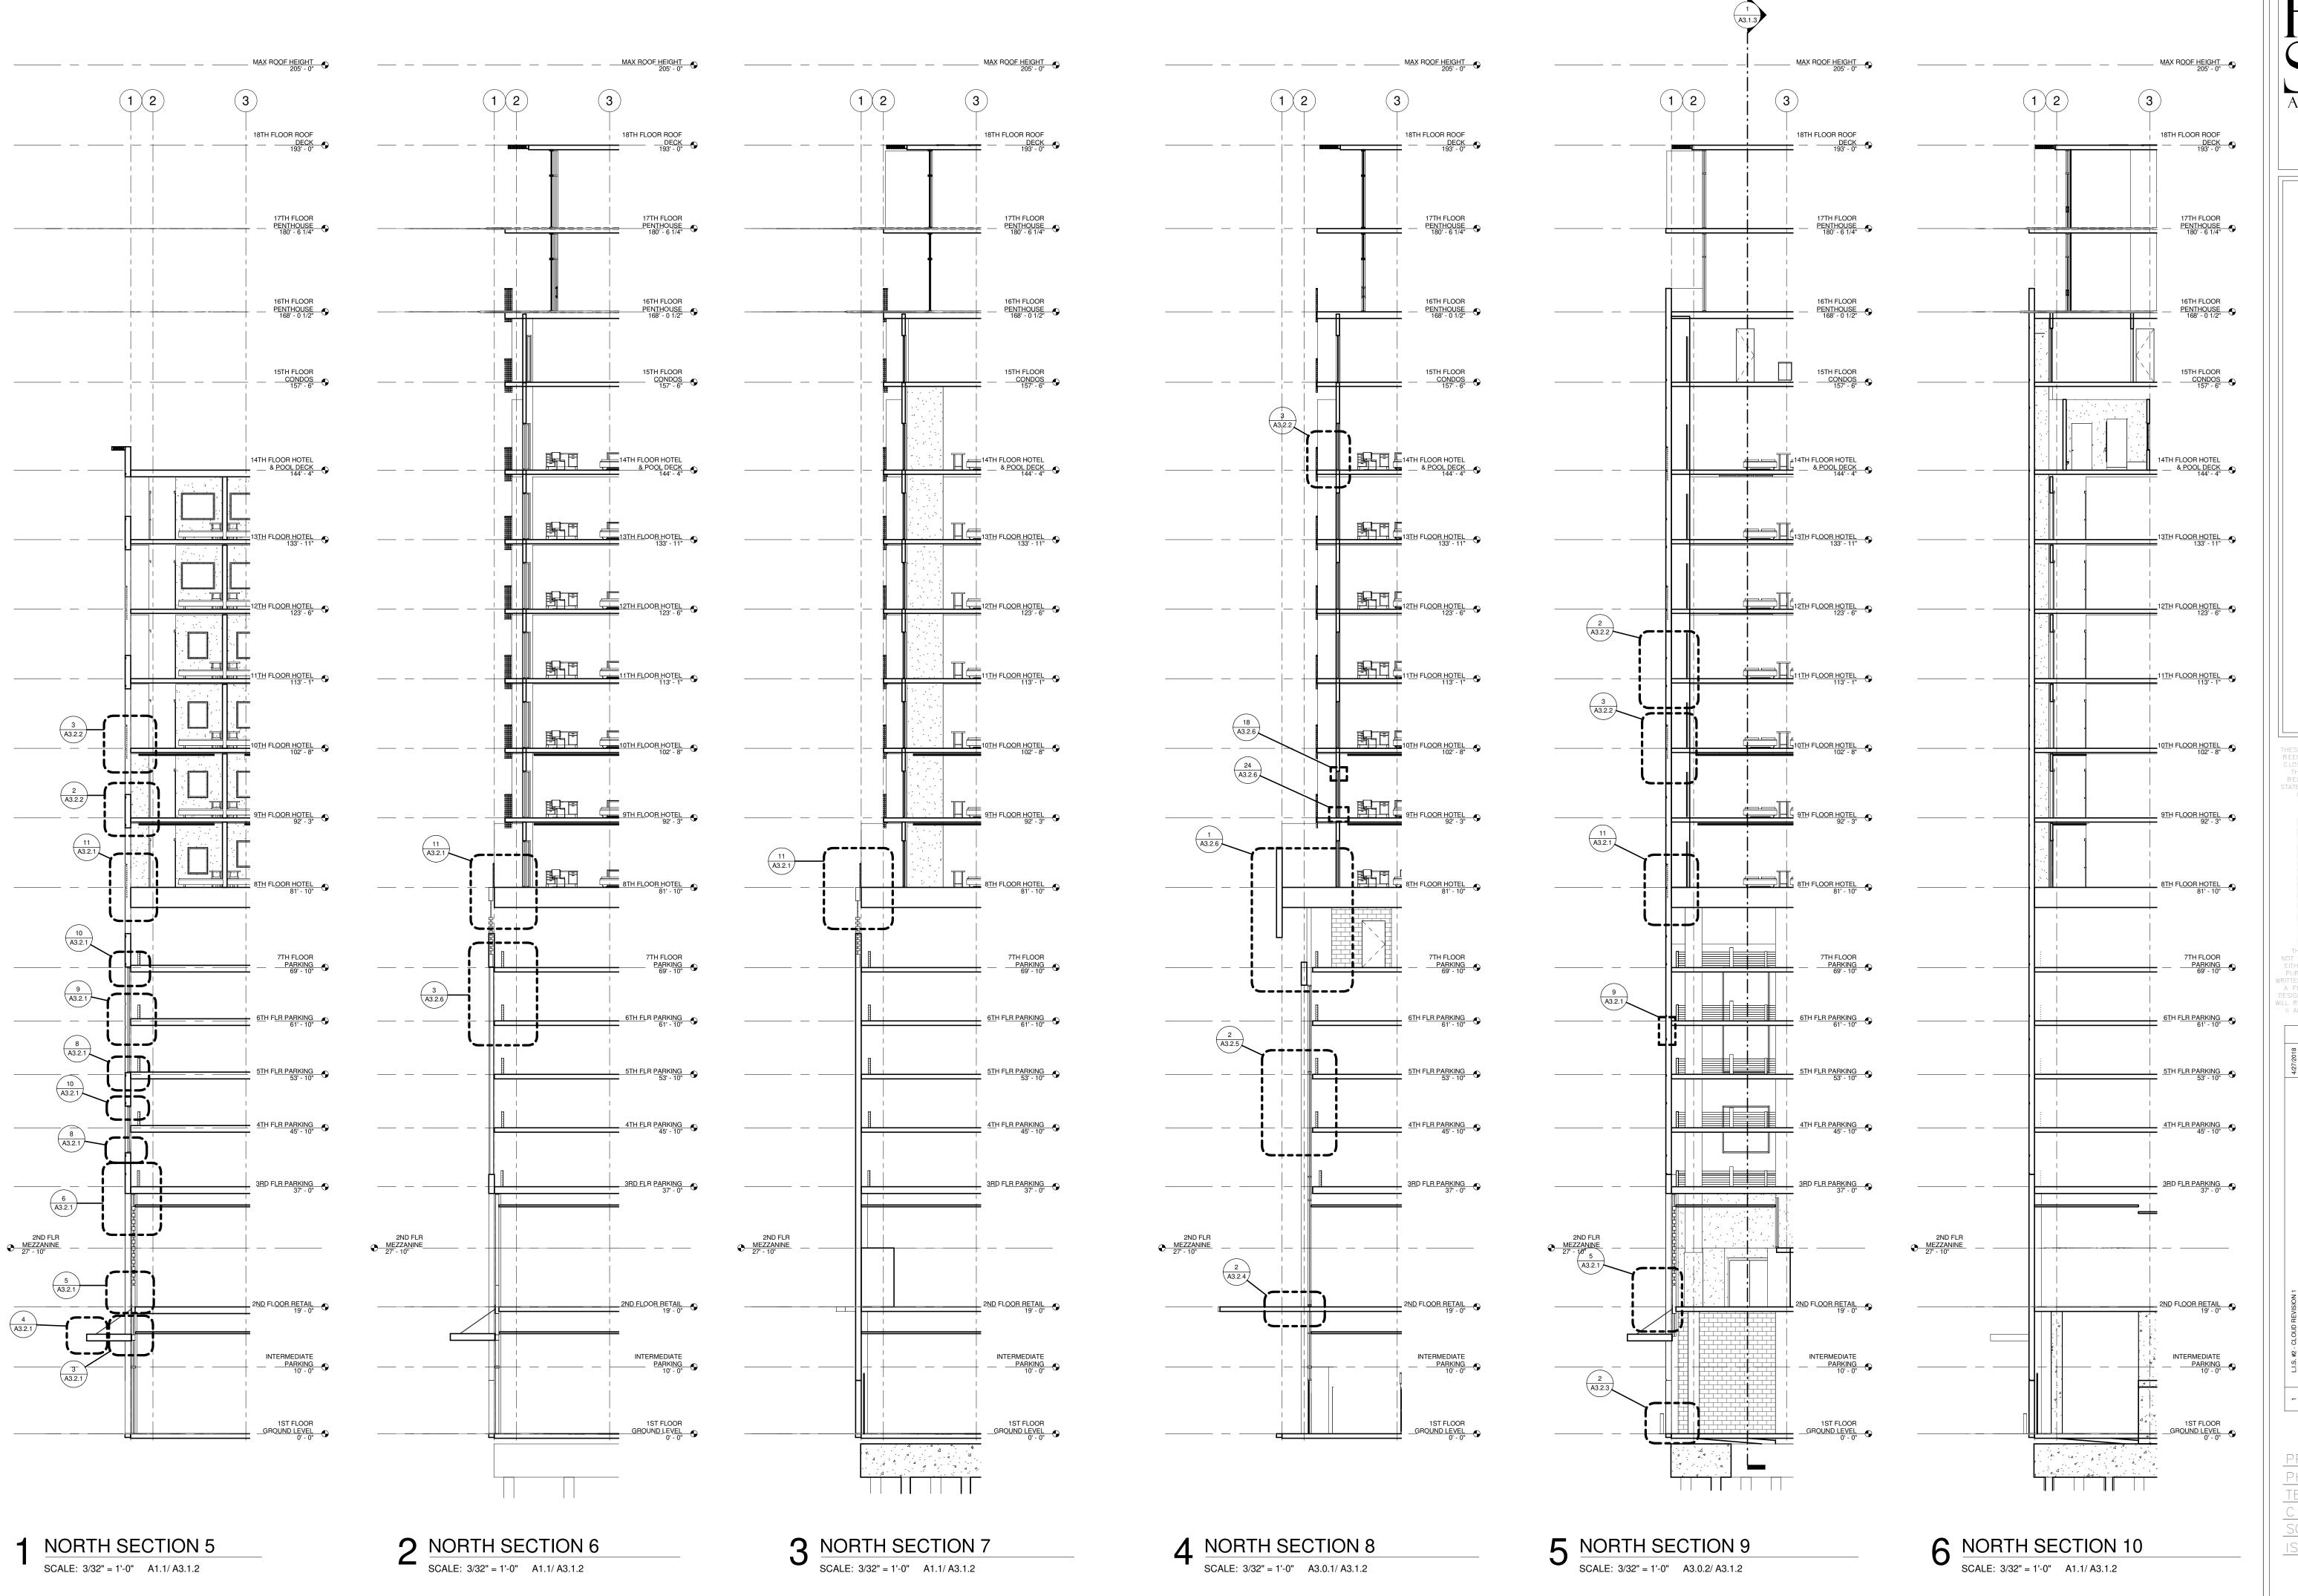

RD ROCK HOTEL

1031 CANAL STREET

NEW ORLEANS, LOUISIANA


ESE PLANS AND SPECIFICATIONS HAVE
EEN PREPARED BY ME OR UNDER MY
OSE PERSONAL SUPERVISION AND TO
THE BEST OF MY KNOWLEDGE AND
SELIEF THEY COMPLY WITH ALL CITY,
ATE AND FEDERAL REQUIREMENTS, AND
I AM NOT PROVIDING CONTRACT
ADMINISTRATION.

CERTIFIED CORRECT


THIS DRAWING IS CONFIDENTIAL AND NOT BE LOANED, REPRODUCED, COPIED, EITHER WHOLLY OR IN PART, OR MADE PUBLIC IN ANY MANNER WITHOUT THE WRITTEN CONSENT OF HBSA II ARCHITECT:

A PROFESSIONAL L.L.C. ALL RIGHTS OF DESIGN OR INVENTION ARE RESERVED AND MILL PROMED TO BE HESS OF THE SOLE PROPERTY OF HES

REVISION HISTORY

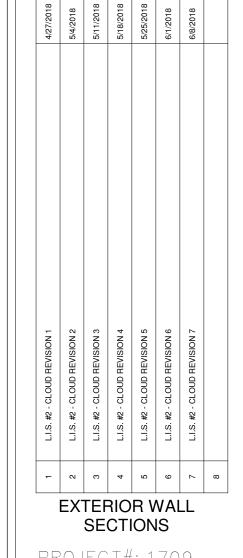

PROJECT#: 1709
PHASE: DD
TEAM: Author
CHECKER: Checker
SCALE: AS NOTED
ISSUED: 4/20/2018

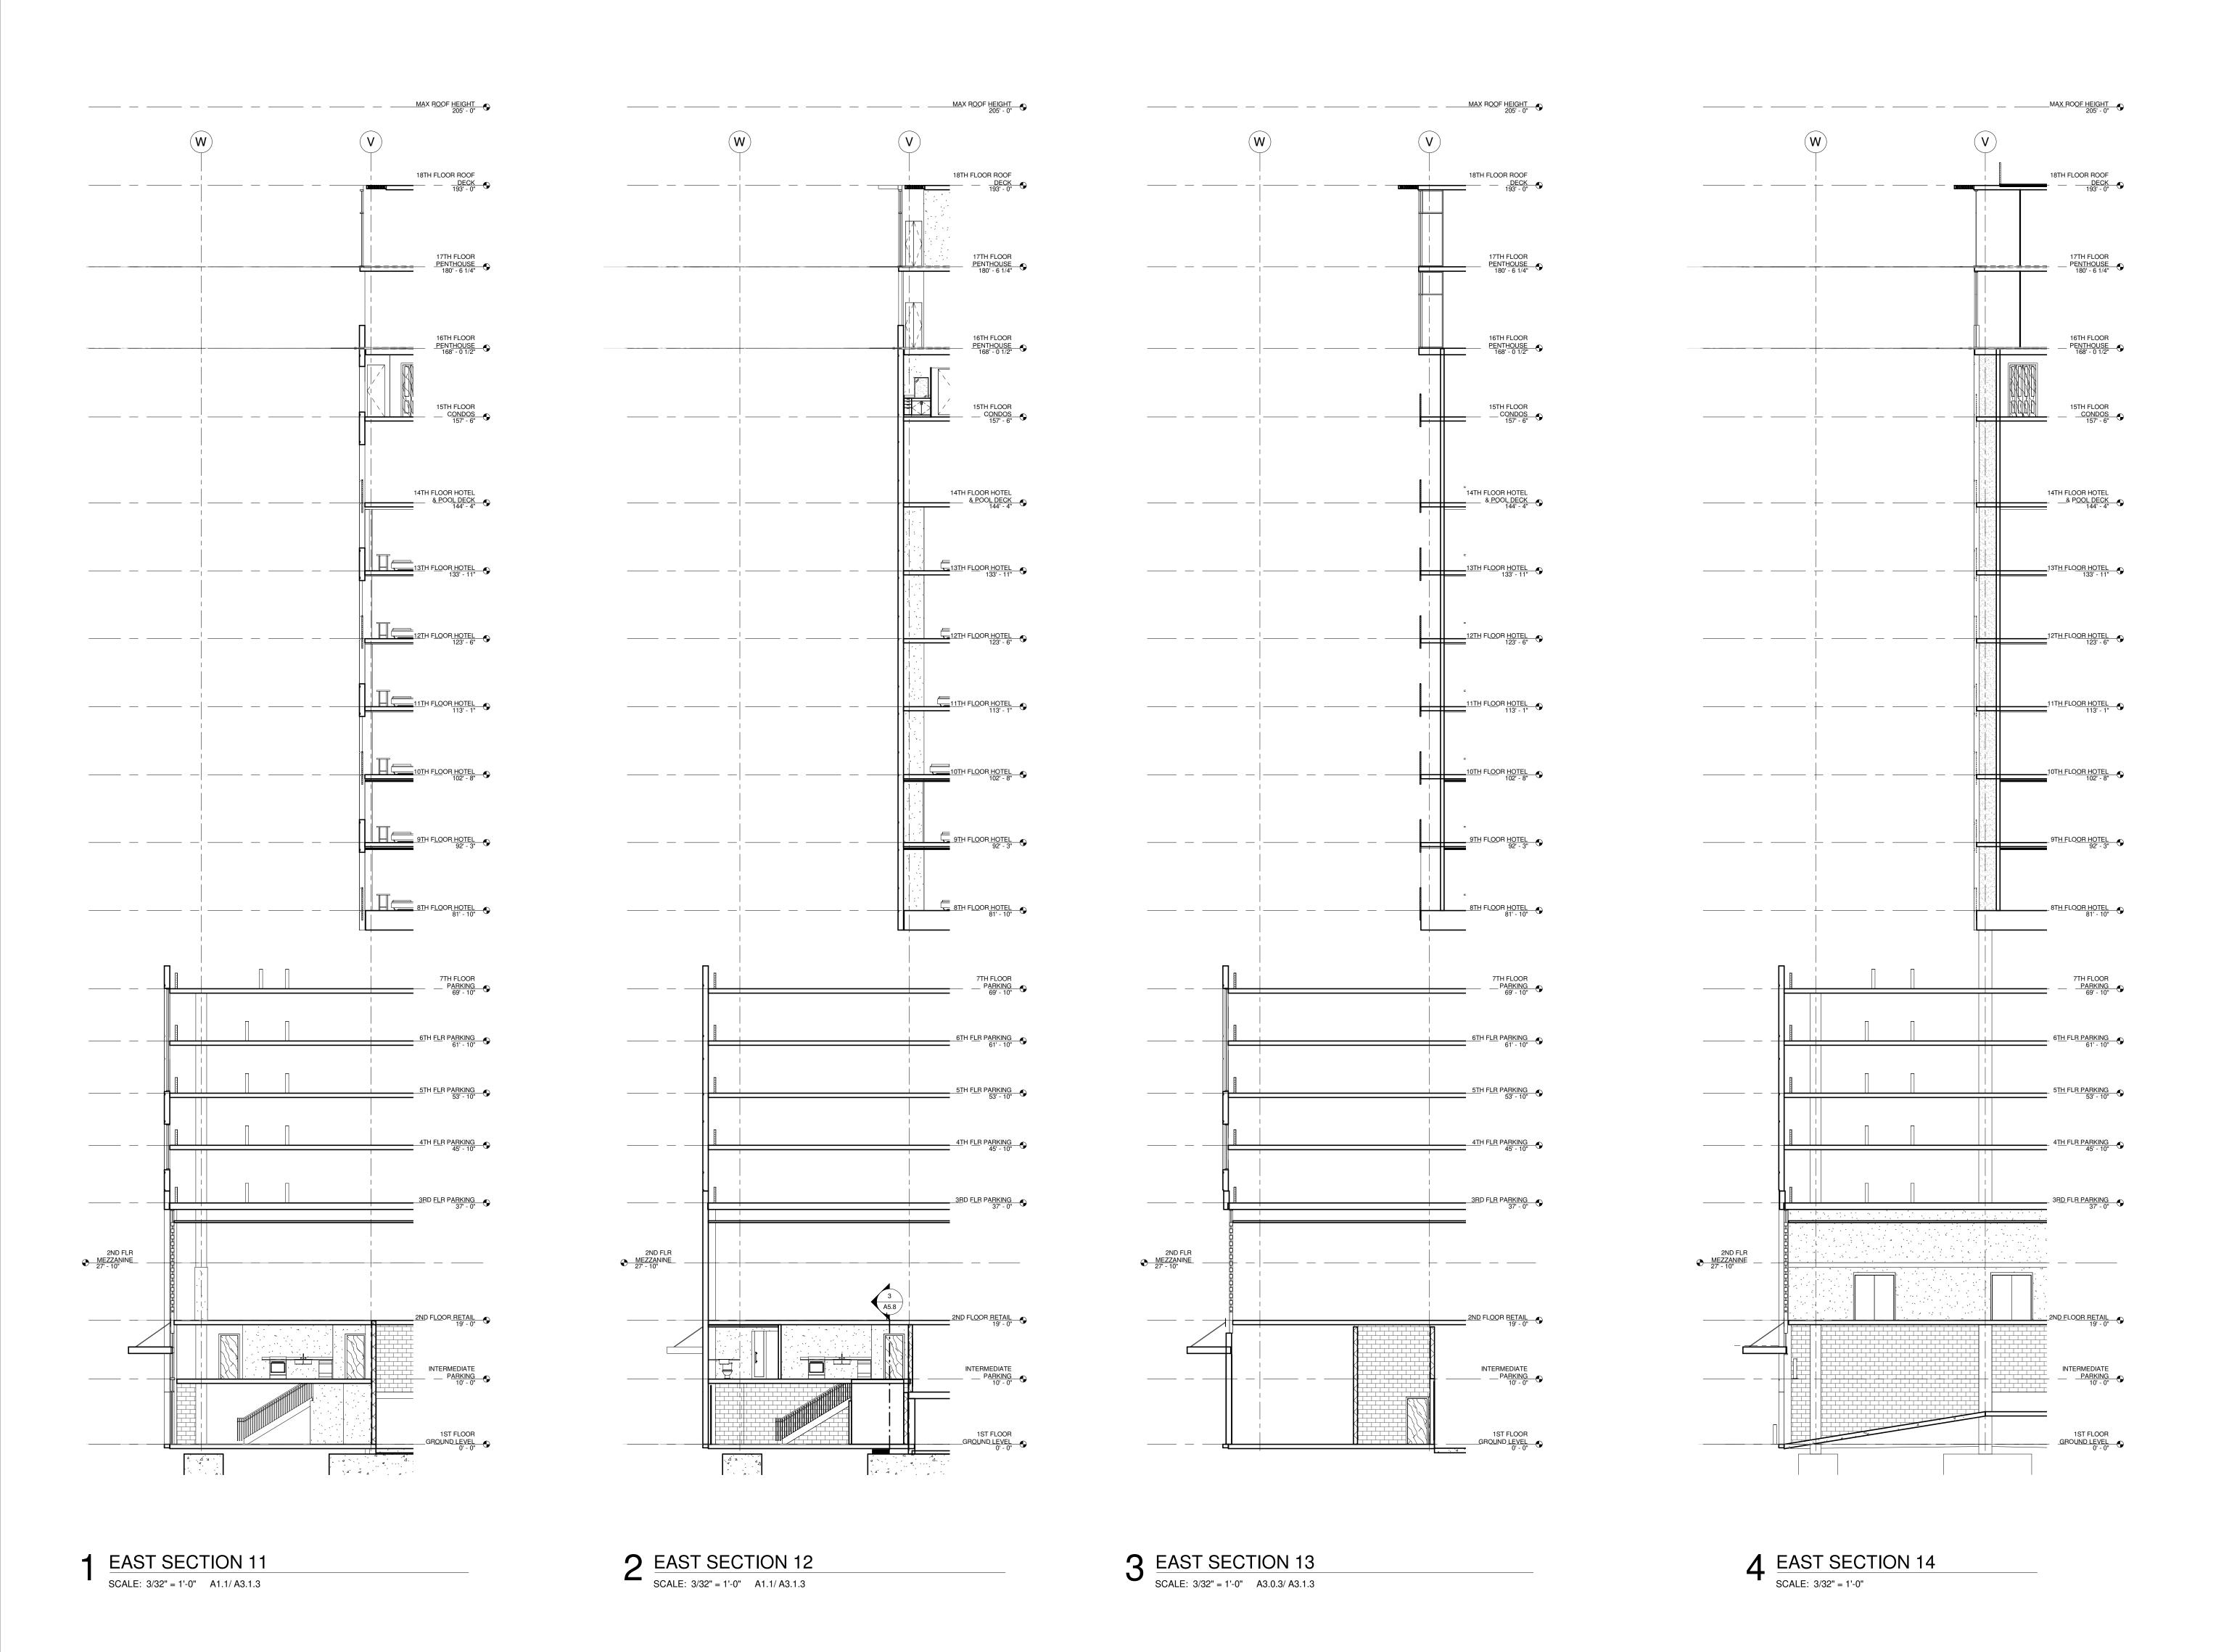

1031 CANAL STREET NEW ORLEANS, LOUISIANA


THESE PLANS AND SPECIFICATIONS HAVE
BEEN PREPARED BY ME OR UNDER MY
CLOSE PERSONAL SUPERVISION AND TO
THE BEST OF MY KNOWLEDGE AND
BELIEF THEY COMPLY WITH ALL CITY,
STATE AND FEDERAL REQUIREMENTS, AND
I AM NOT PROVIDING CONTRACT
ADMINISTRATION.
CERTIFIED CORRECT




THIS DRAWING IS CONFIDENTIAL AND
NOT BE LOANED, REPRODUCED, COPIED,
EITHER WHOLLY OR IN PART, OR MADE
PUBLIC IN ANY MANNER WITHOUT THE
WRITTEN CONSENT OF HBSA II ARCHITECTS,
A PROFESSIONAL L.L.C. ALL RIGHTS OF
DESIGN OR INVENTION ARE RESERVED AND
WILL REMAIN THE SOLE PROPERTY OF HBSA
II ARCHITECTS A PROFESSIONAL L.L.C.

| $\neg$ |           |                              | ω  |     |
|--------|-----------|------------------------------|----|-----|
| 118    | 6/8/2018  | L.I.S. #2 - CLOUD REVISION 7 | 7  | _L  |
| 118    | 6/1/2018  | L.I.S. #2 - CLOUD REVISION 6 | 9  | VAL |
| 9018   | 5/25/2018 | L.I.S. #2 - CLOUD REVISION 5 | D. | R V |
| 9018   | 5/18/2018 | L.I.S. #2 - CLOUD REVISION 4 | 4  |     |
| 9018   | 5/11/2018 | L.I.S. #2 - CLOUD REVISION 3 | က  | TEF |
| 118    | 5/4/2018  | L.I.S. #2 - CLOUD REVISION 2 | 7  | EX  |
| 9118   | 4/27/2018 | L.I.S. #2 - CLOUD REVISION 1 | -  |     |
|        |           |                              |    |     |
|        |           |                              |    |     |

PROJECT#: 1709
PHASE: DD
TEAM: Author
CHECKER: Checker
SCALE: AS NOTED
ISSUED: 4/20/2018

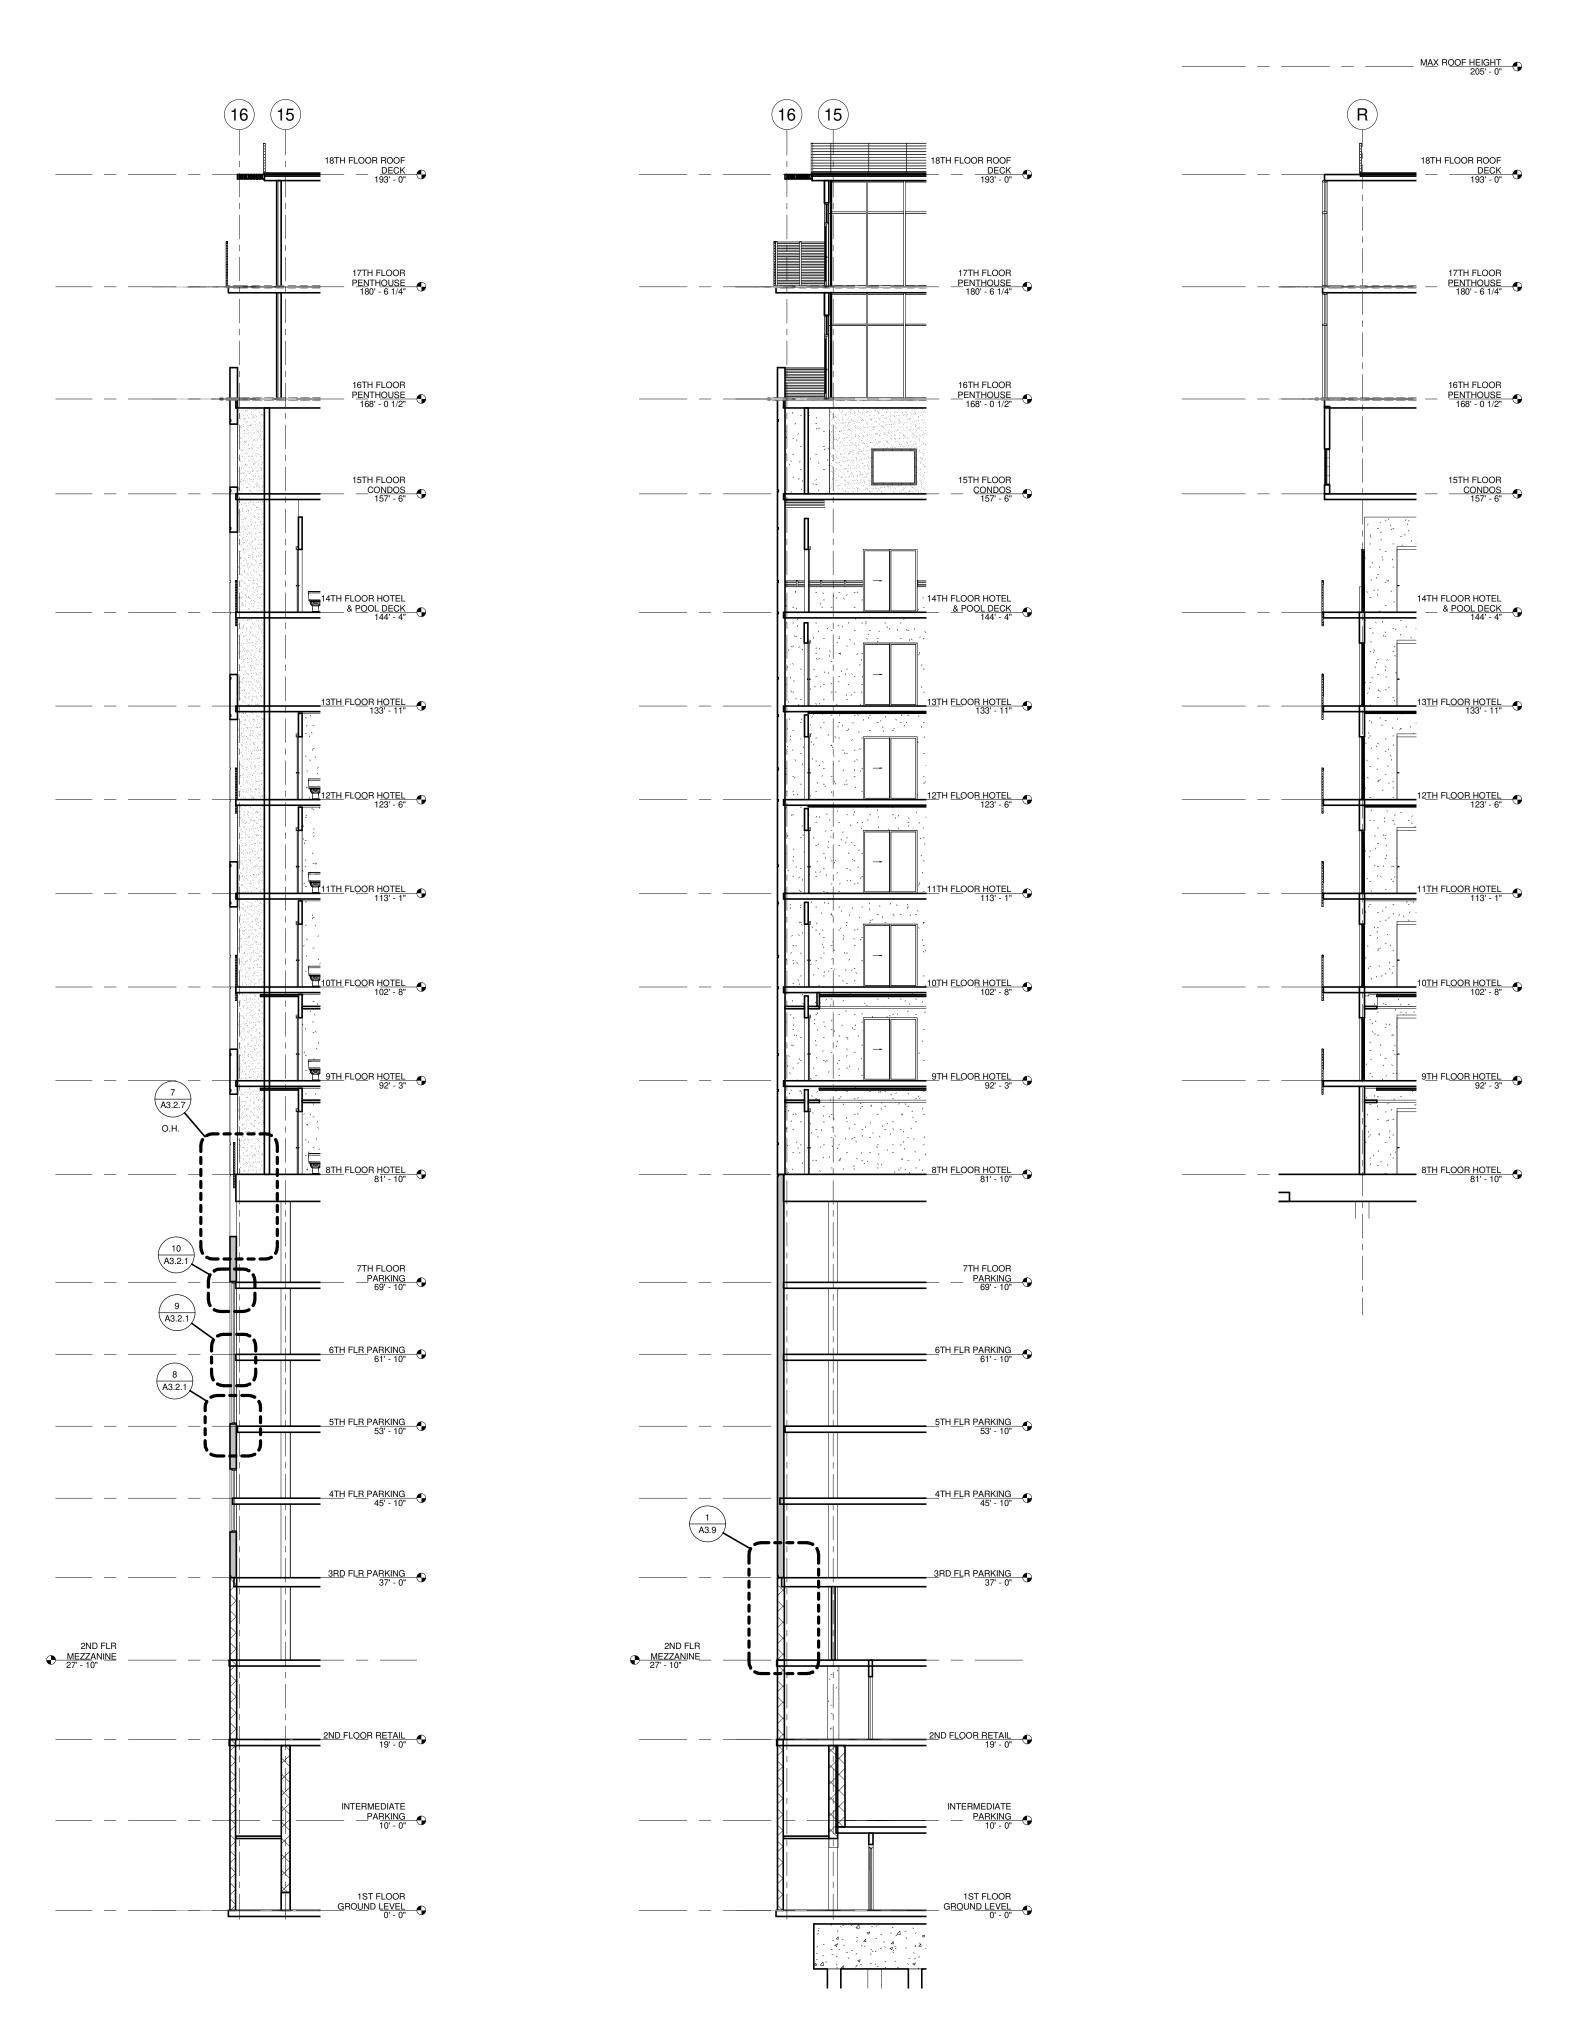

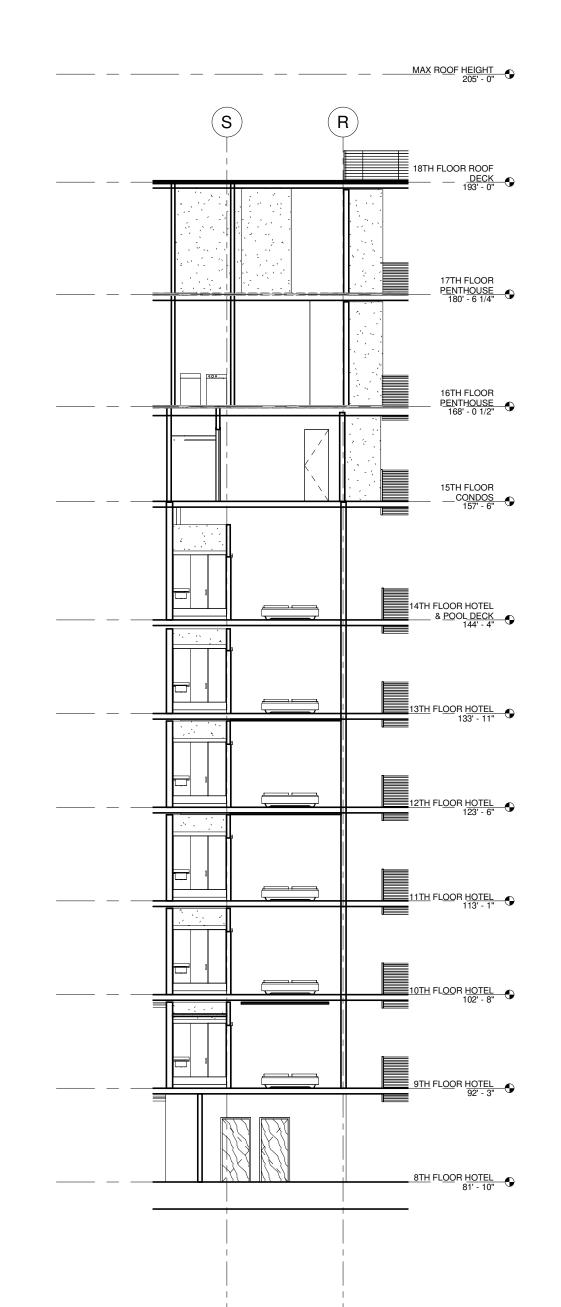

KEET REET

1031 CANAL STREET
NEW ORLEANS, LOUISIANA

THESE PLANS AND SPECIFICATIONS HAVE BEEN PREPARED BY ME OR UNDER MY CLOSE PERSONAL SUPERVISION AND TO THE BEST OF MY KNOWLEDGE AND BELIEF THEY COMPLY WITH ALL CITY, STATE AND FEDERAL REQUIREMENTS, AND I AM NOT PROVIDING CONTRACT ADMINISTRATION.

CERTIFIED CORRECT



THIS DRAWING IS CONFIDENTIAL AND
NOT BE LOANED, REPRODUCED, COPIED,
EITHER WHOLLY OR IN PART, OR MADE
PUBLIC IN ANY MANNER WITHOUT THE
WRITTEN CONSENT OF HBSA II ARCHITECTS
A PROFESSIONAL L.L.C. ALL RIGHTS OF
DESIGN OR INVENTION ARE RESERVED AND
WILL REMAIN THE SOLE PROPERTY OF HBS

| ω                            | I                            |                              |                              |                              |                              |                              |    |  |
|------------------------------|------------------------------|------------------------------|------------------------------|------------------------------|------------------------------|------------------------------|----|--|
| 4/27/2018                    | 5/4/2018                     | 5/11/2018                    | 5/18/2018                    | 5/25/2018                    | 6/1/2018                     | 6/8/2018                     |    |  |
| L.I.S. #2 - CLOUD REVISION 1 | L.I.S. #2 - CLOUD REVISION 2 | L.I.S. #2 - CLOUD REVISION 3 | L.I.S. #2 - CLOUD REVISION 4 | L.I.S. #2 - CLOUD REVISION 5 | L.I.S. #2 - CLOUD REVISION 6 | L.I.S. #2 - CLOUD REVISION 7 |    |  |
| -                            | 8                            | က                            | 4                            | 5                            | 9                            | 7                            | 80 |  |

SECTIONS

PROJECT#: 1709

PHASE: DD

TEAM: Author

CHECKER: Checker

SCALE: AS NOTED

ISSUED: 4/20/2018

A3.1.4

2ND FLR

MEZZANINE \_
27' - 10"


16 (15)

8TH FLOOR HOTEL 81' - 10"

> 2ND FLOOR RETAIL 19' - 0"

> > INTERMEDIATE
> > PARKING
> > 10' - 0"

1ST FLOOR GROUND LEVEL 0' - 0"

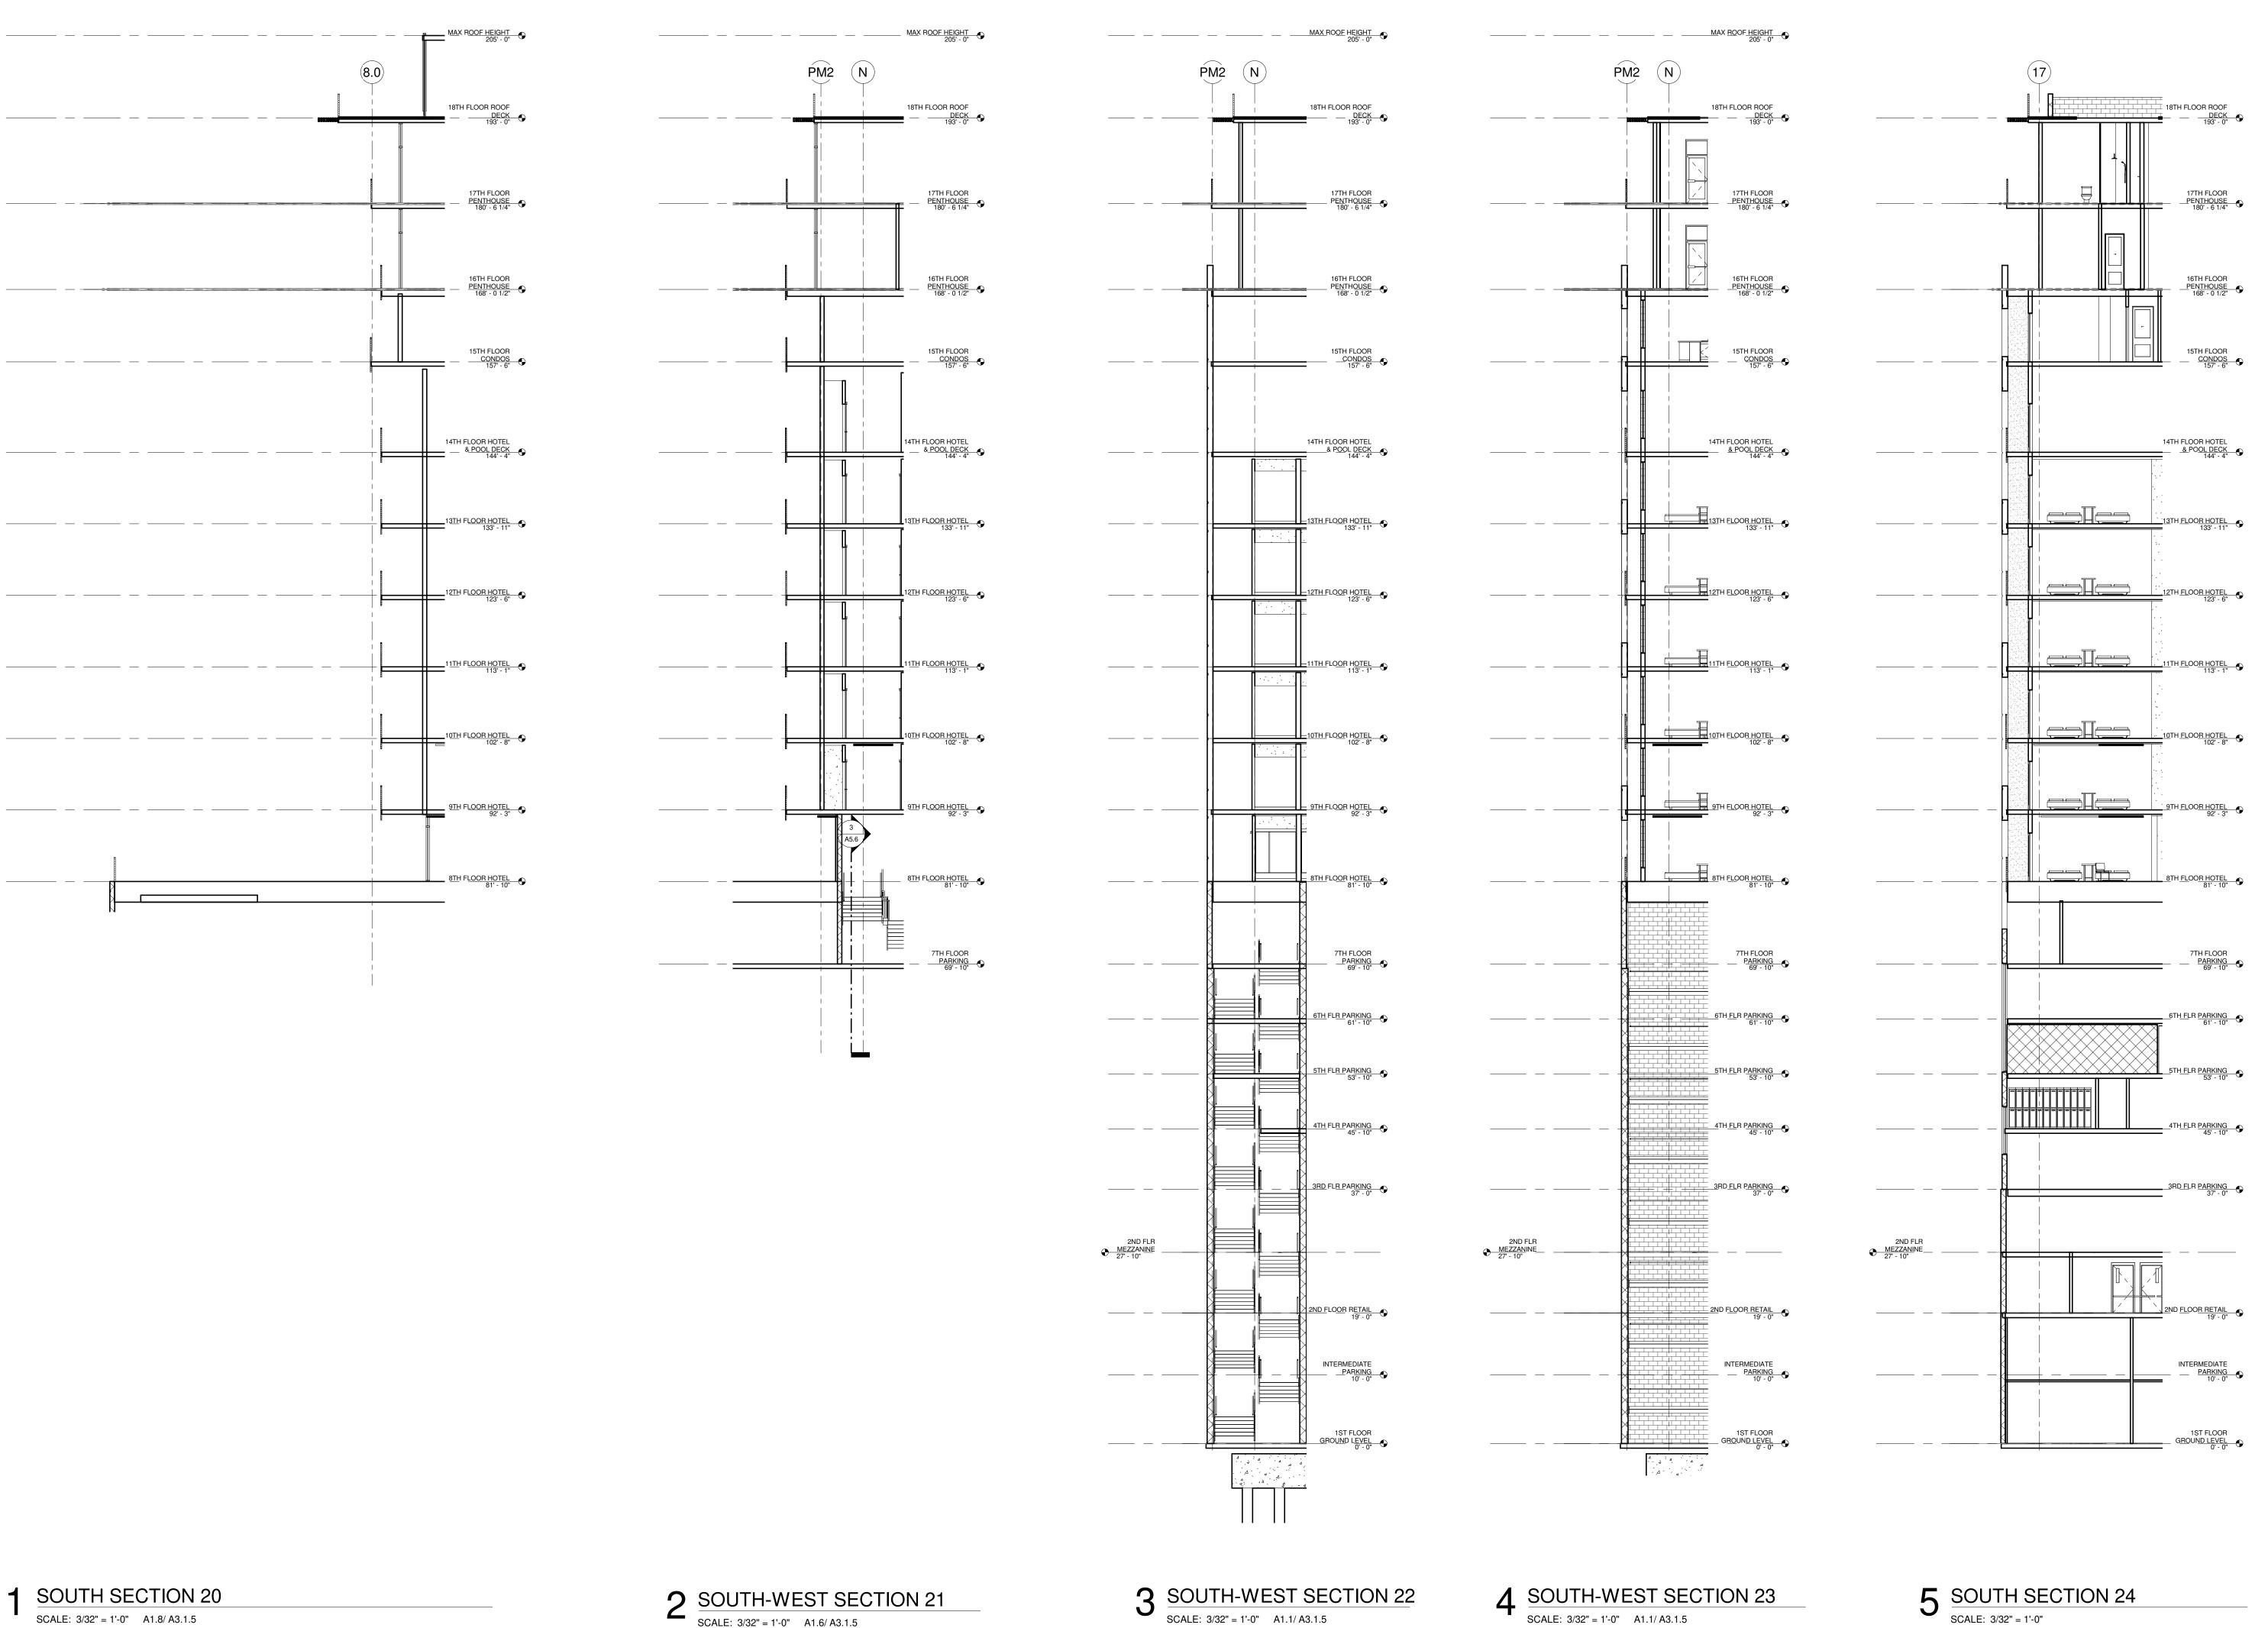


189 Maple Ridge Drive Metairie, LA 70001 (504)-885-4477 central@hbsaii.com :-: hbsaii.com SINCE 1961

HOTEL


1031 CANAL STREET NEW ORLEANS, LOUISIANA

BEEN PREPARED BY ME OR UNDER MY CLOSE PERSONAL SUPERVISION AND TO THE BEST OF MY KNOWLEDGE AND STATE AND FEDERAL REQUIREMENTS, AND
I AM NOT PROVIDING CONTRACT
ADMINISTRATION. CERTIFIED CORRECT

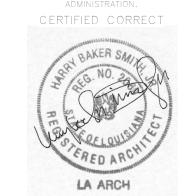

|                              | R                            | EVIS                         | ION                          | HIS                          | TOR                          | Υ                            |   |
|------------------------------|------------------------------|------------------------------|------------------------------|------------------------------|------------------------------|------------------------------|---|
| 4/27/2018                    | 5/4/2018                     | 5/11/2018                    | 5/18/2018                    | 5/25/2018                    | 6/1/2018                     | 6/8/2018                     |   |
|                              |                              |                              |                              |                              |                              |                              |   |
| L.I.S. #2 - CLOUD REVISION 1 | L.I.S. #2 - CLOUD REVISION 2 | L.I.S. #2 - CLOUD REVISION 3 | L.I.S. #2 - CLOUD REVISION 4 | L.I.S. #2 - CLOUD REVISION 5 | L.I.S. #2 - CLOUD REVISION 6 | L.I.S. #2 - CLOUD REVISION 7 |   |
| -                            | 2                            | က                            | 4                            | 2                            | 9                            | 7                            | 8 |
|                              | EX                           | TEF                          | RIO                          | R V                          | VAI                          | L                            |   |

SECTIONS PROJECT#: 1709 PHASE: DD TEAM: Author CHECKER: Checker SCALE: AS NOTED ISSUED: 4/20/2018

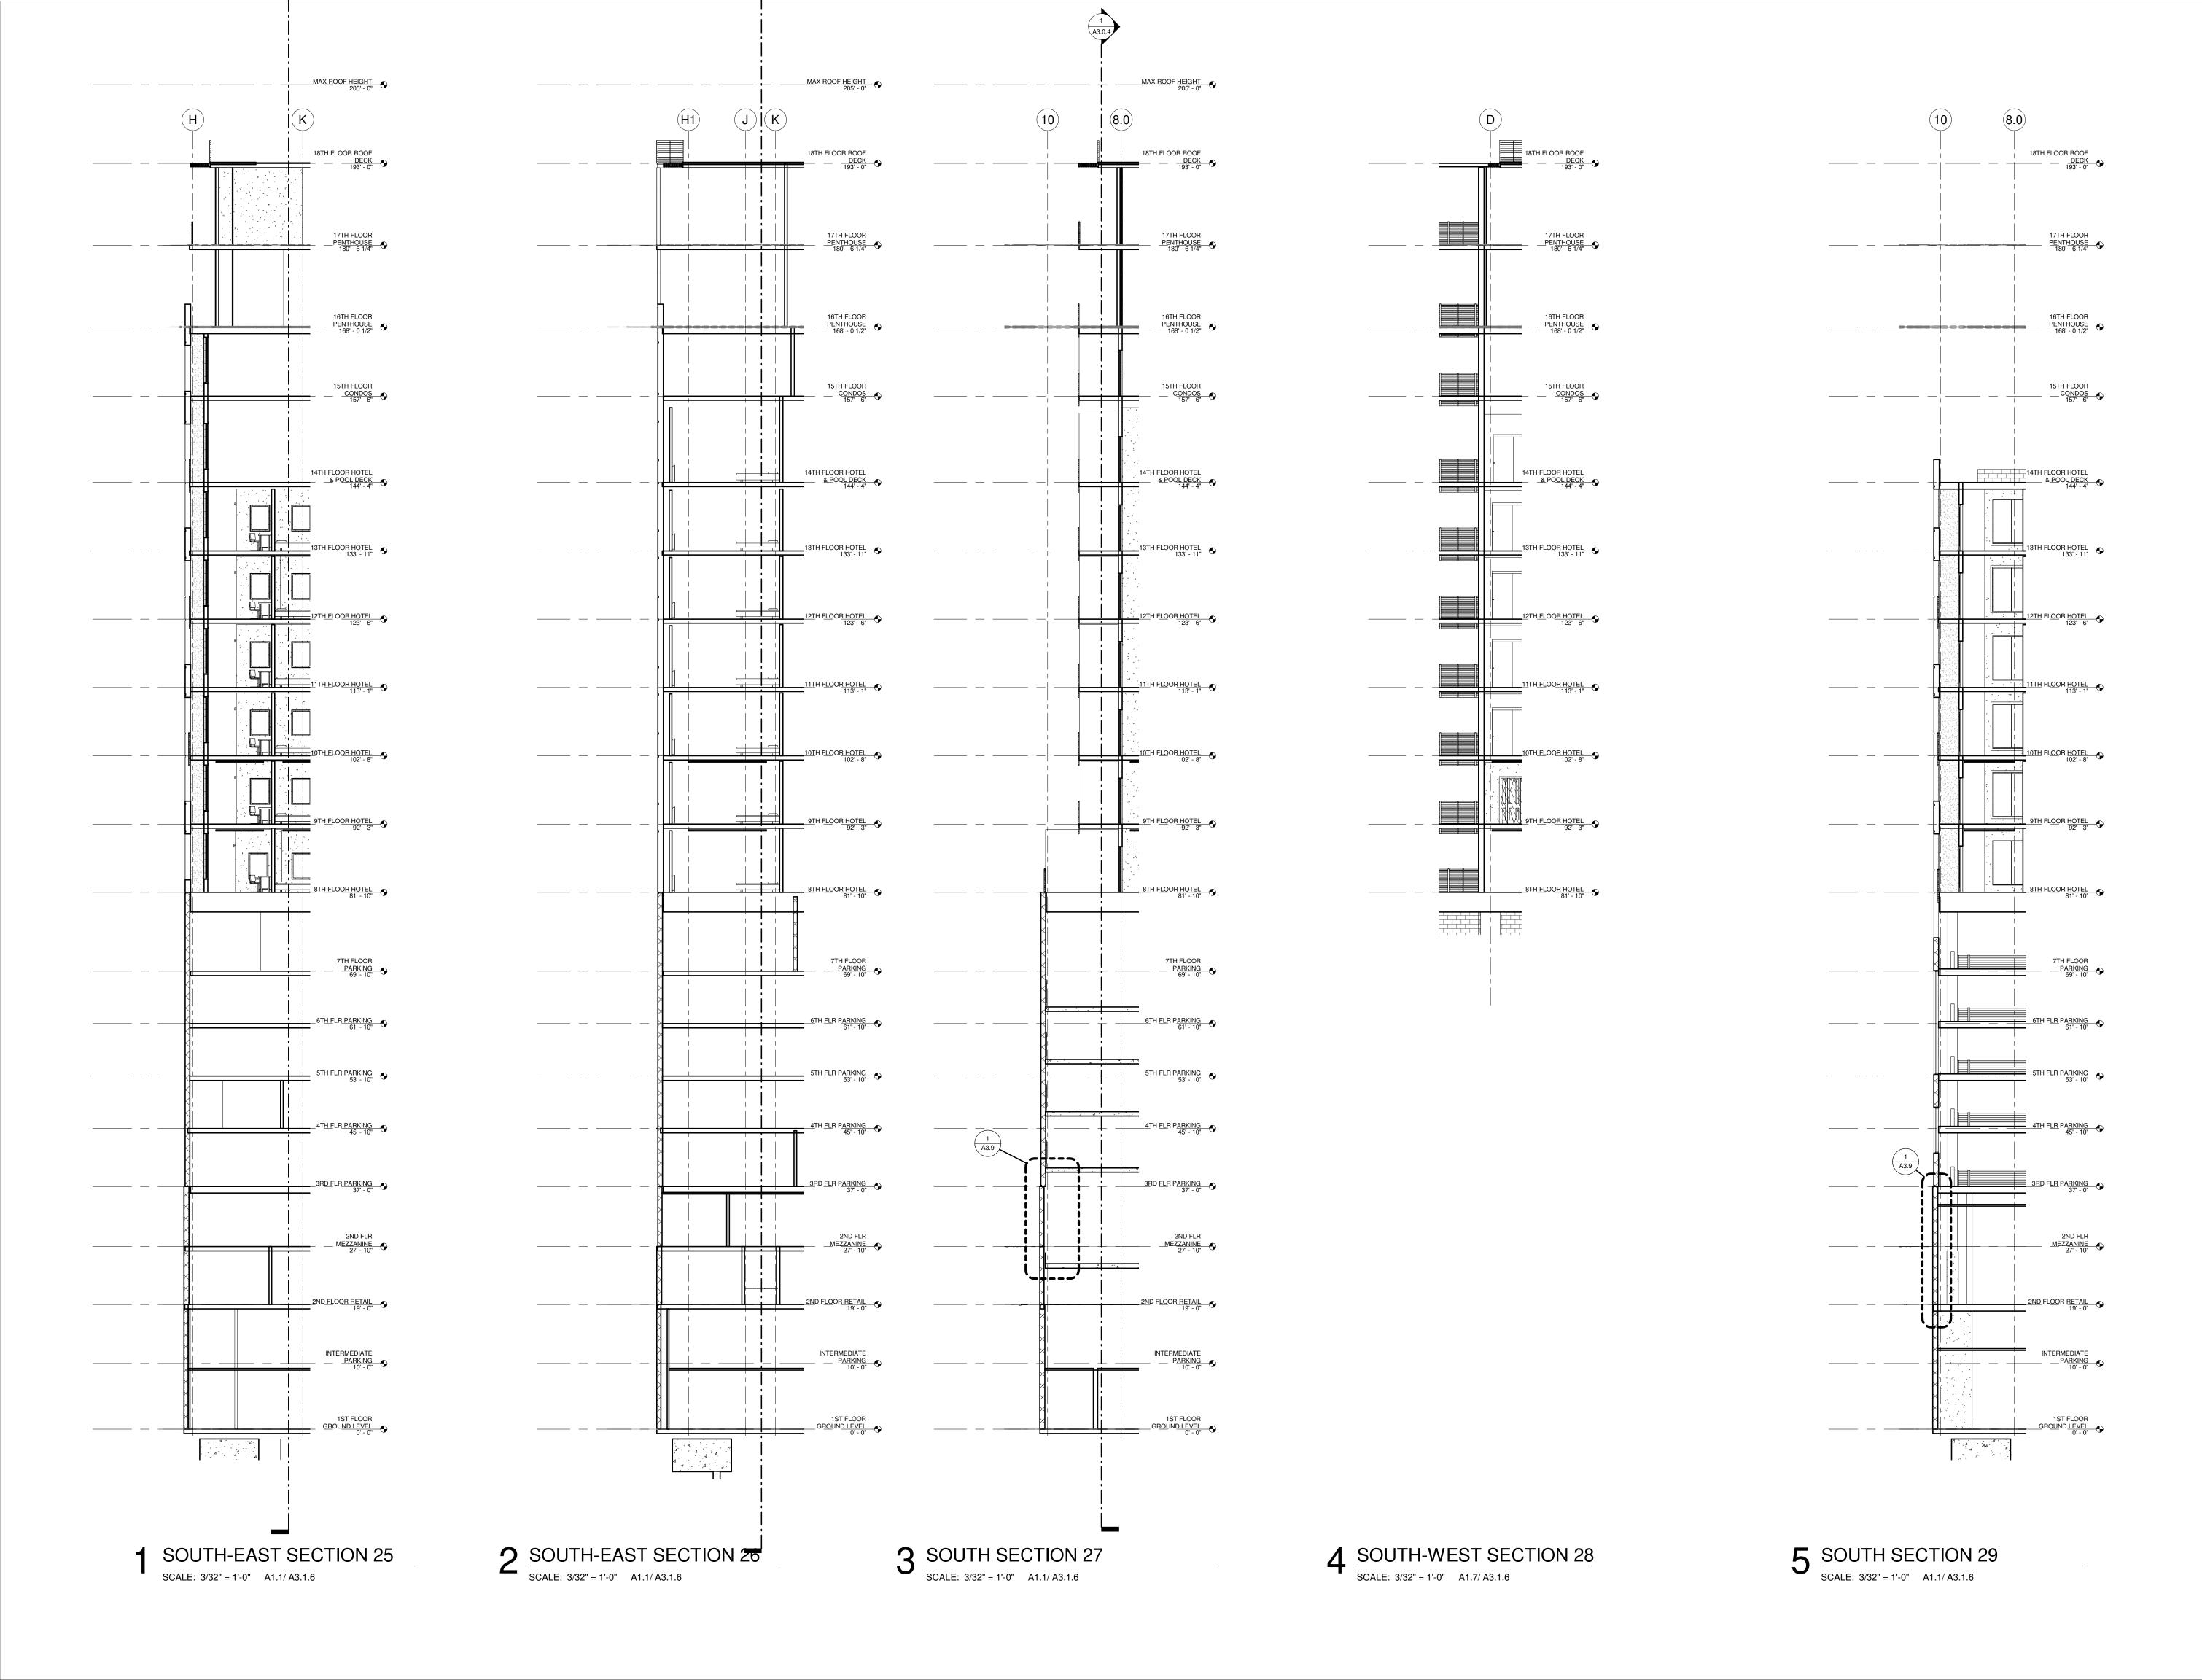

ARD ROCK HOTI 1031 CANAL STREET NEW ORLEANS, LOUISIANA

THESE PLANS AND SPECIFICATIONS HAVE BEEN PREPARED BY ME OR UNDER MY CLOSE PERSONAL SUPERVISION AND TO THE BEST OF MY KNOWLEDGE AND BELIEF THEY COMPLY WITH ALL CITY, STATE AND FEDERAL REQUIREMENTS, AND I AM NOT PROVIDING CONTRACT ADMINISTRATION.


CERTIFIED CORRECT



THIS DRAWING IS CONFIDENTIAL AND NOT BE LOANED, REPRODUCED, COPIED, EITHER WHOLLY OR IN PART, OR MADE PUBLIC IN ANY MANNER WITHOUT THE WRITTEN CONSENT OF HBSA II ARCHITECT: A PROFESSIONAL L.L.C. ALL RIGHTS OF DESIGN OR INVENTION ARE RESERVED AND WILL REMAIN THE SOLE PROPERTY OF HBS II ARCHITECTS A PROFESSIONAL L.L.C.

| 4/27/2018                    | 5/4/2018                     | 5/11/2018                    | 5/18/2018                    | 5/25/2018                    | 6/1/2018                     | 6/8/2018                     |   |
|------------------------------|------------------------------|------------------------------|------------------------------|------------------------------|------------------------------|------------------------------|---|
|                              |                              |                              |                              |                              |                              |                              |   |
| ISION 1                      | ISION 2                      | ISION 3                      | ISION 4                      | ISION 5                      | ISION 6                      | ISION 7                      |   |
| L.I.S. #2 - CLOUD REVISION 1 | L.I.S. #2 - CLOUD REVISION 2 | L.I.S. #2 - CLOUD REVISION 3 | L.I.S. #2 - CLOUD REVISION 4 | L.I.S. #2 - CLOUD REVISION 5 | L.I.S. #2 - CLOUD REVISION 6 | L.I.S. #2 - CLOUD REVISION 7 |   |
|                              | 2                            | 8                            | 4                            | 5                            | 9                            | 7                            | 8 |
|                              | 1 L.I.S. #2 - C              |                              |                              |                              |                              |                              |   |

PROJECT#: 1709
PHASE: DD
TEAM: Author
CHECKER: Checker
SCALE: AS NOTED
ISSUED: 4/20/2018

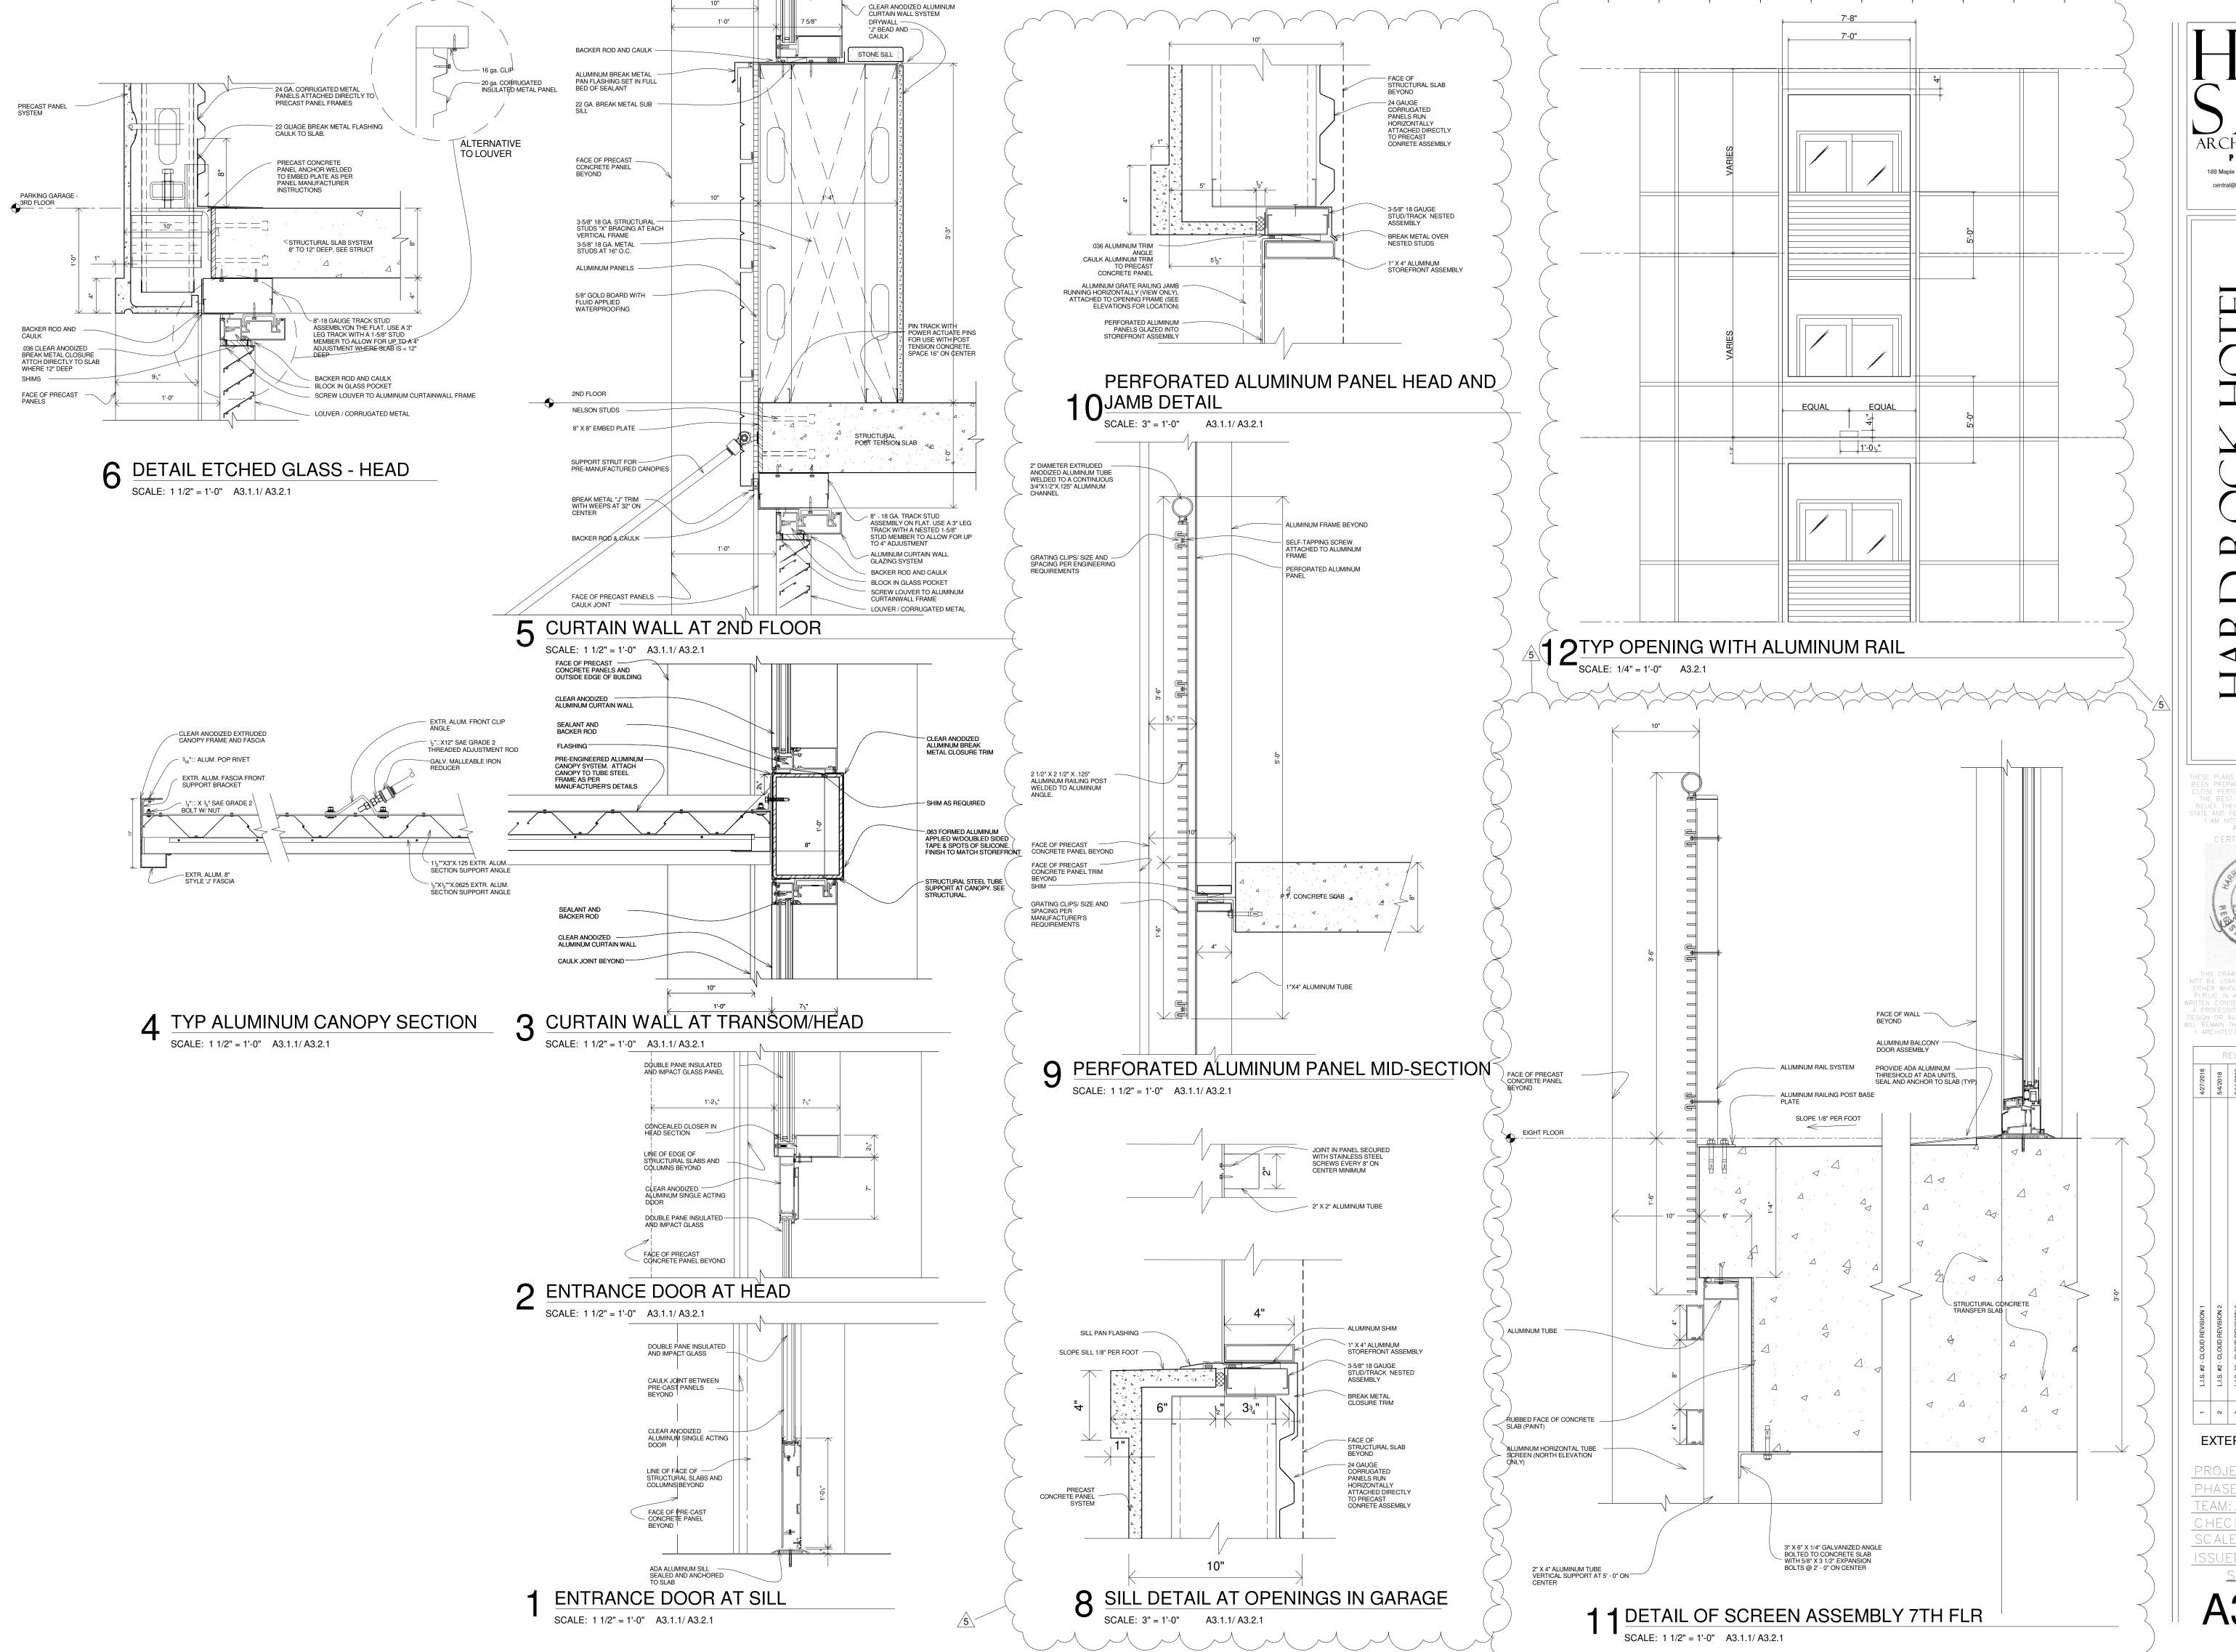

DROCKHOTE

1031 CANAL STREET

NEW ORLEANS, LOUISIANA

THESE PLANS AND SPECIFICATIONS HAVE BEEN PREPARED BY ME OR UNDER MY CLOSE PERSONAL SUPERVISION AND TO THE BEST OF MY KNOWLEDGE AND BELIEF THEY COMPLY WITH ALL CITY, STATE AND FEDERAL REQUIREMENTS, AND I AM NOT PROVIDING CONTRACT ADMINISTRATION.


CERTIFIED CORRECT


THIS DRAWING IS CONFIDENTIAL AND NOT BE LOANED, REPRODUCED, COPIED, EITHER WHOLLY OR IN PART, OR MADE PUBLIC IN ANY MANNER WITHOUT THE WRITTEN CONSENT OF HBSA II ARCHITECTS A PROPESSIONAL LL.C. ALL RIGHTS OF DESIGN OR INVENTION. APER PESSENSE AND PROPESSIONAL LL.C. ALL RIGHTS OF DESIGN OR INVENTION. APER PESSENSE AND PROPESSIONAL LL.C. ALL RIGHTS OF DESIGN OR INVENTION. APER PESSENSE AND PROPESSIONAL LL.C. ALL RIGHTS OF DESIGN OR INVENTION. APER PESSENSE AND PROPESSIONAL LL.C. ALL RIGHTS OF DESIGN OR INVENTION. APER PESSENSE AND PROPESSIONAL LL.C. ALL RIGHTS OF DESIGN OR INVENTION. APER PESSENSE AND PROPESSIONAL LL.C. ALL RIGHTS OF DESIGN OR INVENTION. APER PESSENSE AND PROPESSIONAL LL.C. ALL RIGHTS OF DESIGN OR INVENTION. APER PESSENSE AND PROPESSIONAL LL.C. ALL RIGHTS OF DESIGN AND PROPERSIONAL APER PESSENSE AND PROPERSIONAL PROPERSIONAL APER PESSENSE AND PROPERSIONAL PR

EXTERIOR DETAILS

PROJECT#: 1709
PHASE: DD
TEAM: Author
CHECKER: Checker
SCALE: AS NOTED
ISSUED: 4/20/2018

A3.2.1

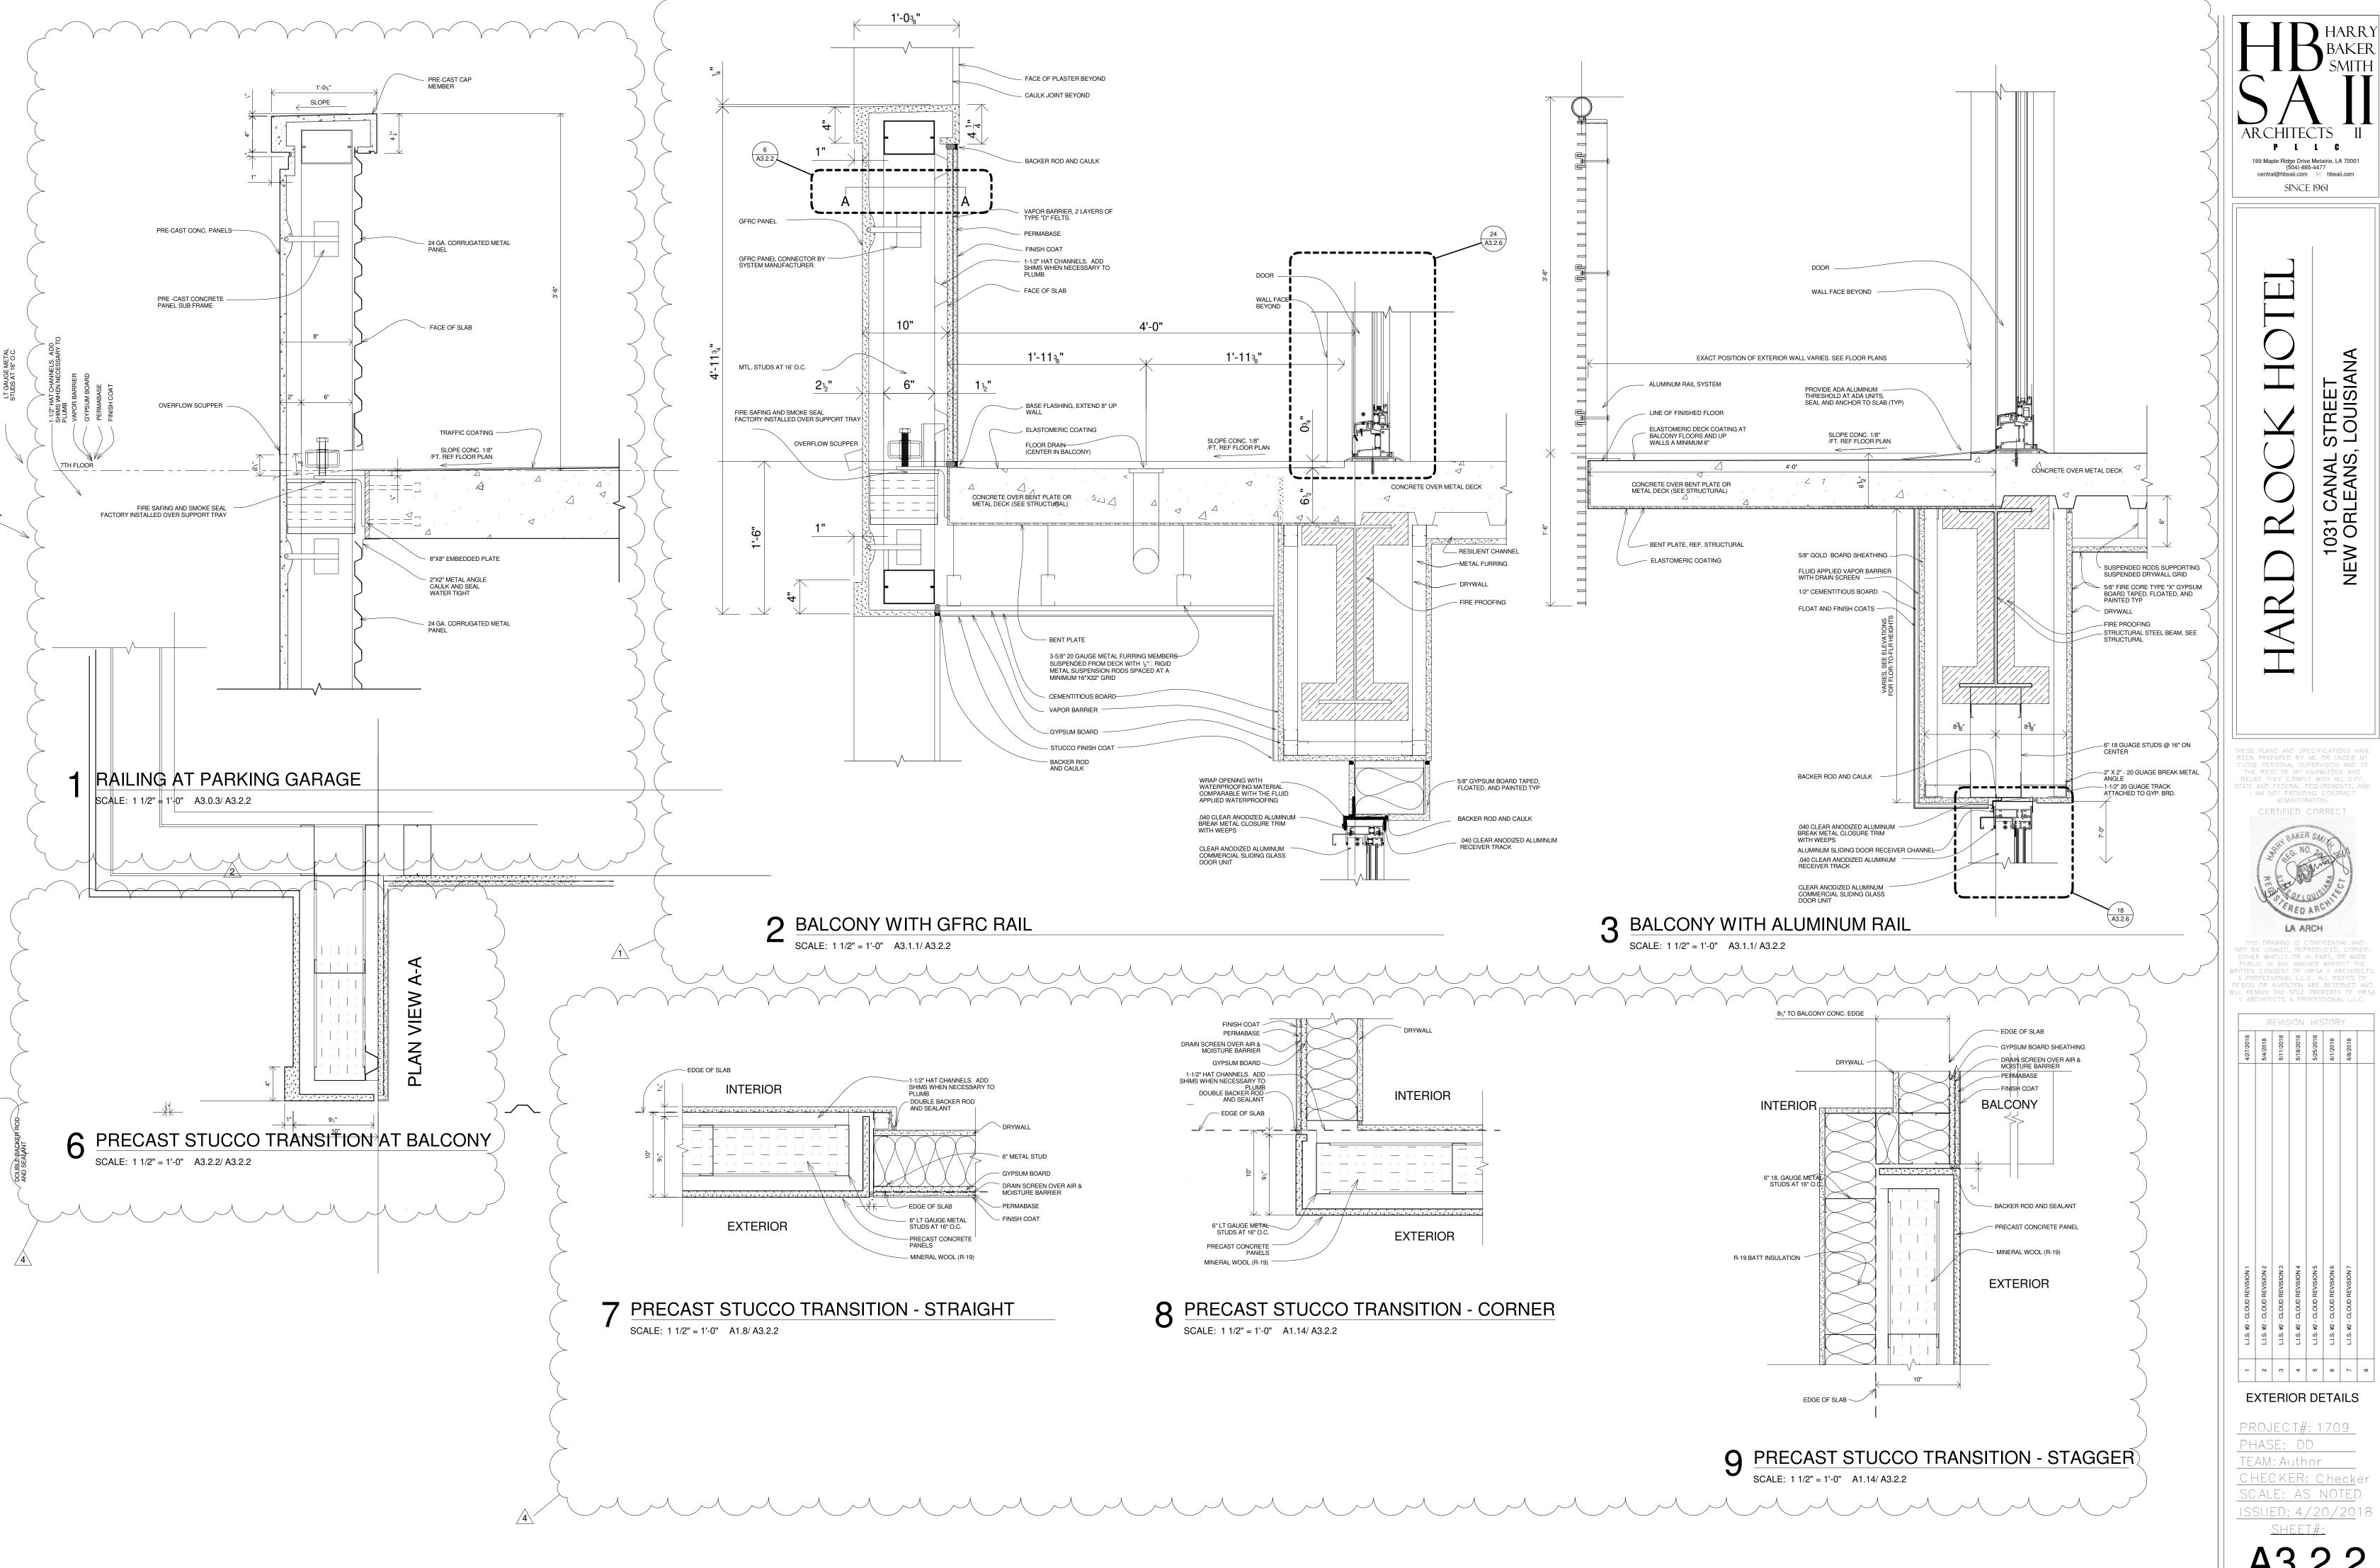

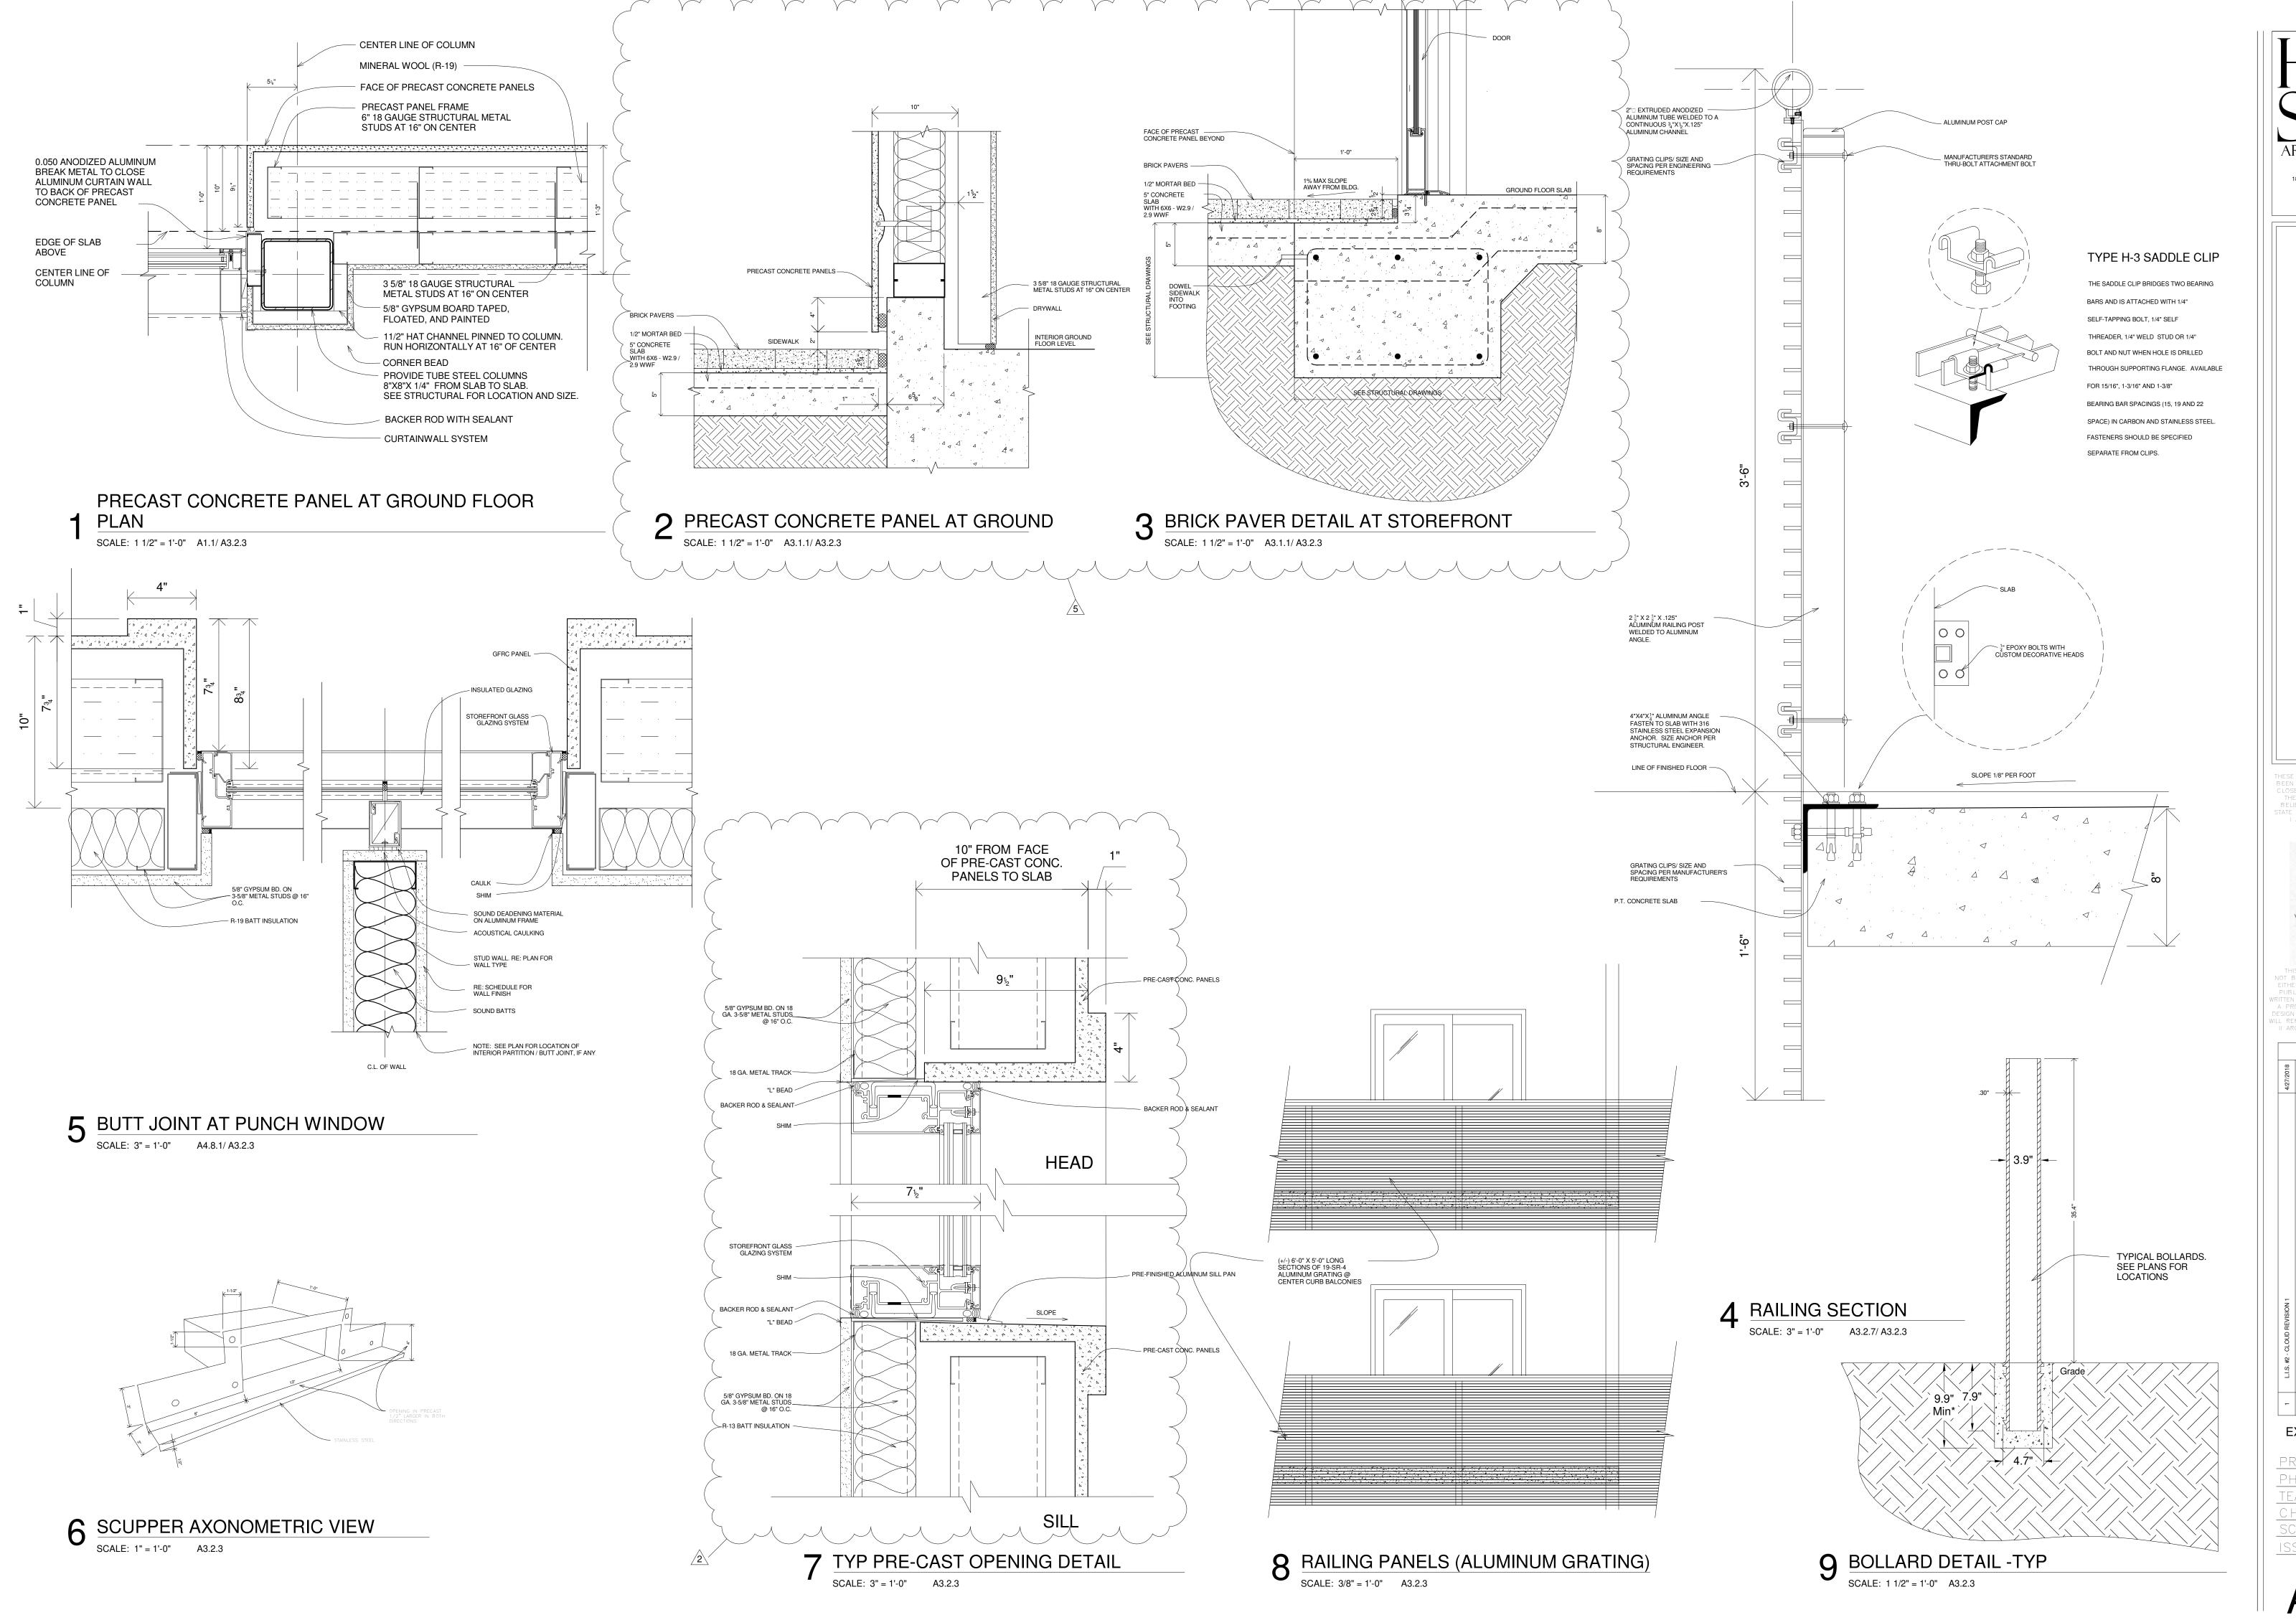

ROCK HOTEL

1031 CANAL STREET

NEW ORLEANS, LOUISIANA

ESE PLANS AND SPECIFICATIONS HAVE
EEN PREPARED BY ME OR UNDER MY
OSE PERSONAL SUPERVISION AND TO
THE BEST OF MY KNOWLEDGE AND
BELIEF THEY COMPLY WITH ALL CITY,
ATE AND FEDERAL REQUIREMENTS, AND
I AM NOT PROVIDING CONTRACT
ADMINISTRATION.
CERTIFIED CORRECT



THIS DRAWING IS CONFIDENTIAL AND
NOT BE LOANED, REPRODUCED, COPIED,
EITHER WHOLLY OR IN PART, OR MADE
PUBLIC IN ANY MANNER WITHOUT THE
WRITTEN CONSENT OF HBSA II ARCHITECTS,
A PROFESSIONAL LL.C. ALL RIGHTS OF
DESIGN OR INVENTION ARE RESERVED AND

1 L.I.S. #2 - CLOUD REVISION 1
2 L.I.S. #2 - CLOUD REVISION 2
3 L.I.S. #2 - CLOUD REVISION 3
4 L.I.S. #2 - CLOUD REVISION 4
5 L.I.S. #2 - CLOUD REVISION 5
6 L.I.S. #2 - CLOUD REVISION 6
7 L.I.S. #2 - CLOUD REVISION 7
8
8


EXTERIOR DETAILS

PROJECT#: 1709
PHASE: DD
TEAM: Author
CHECKER: Checker
SCALE: AS NOTED
ISSUED: 4/20/2018

A3.2.3

CONCRETE CANOPY SECTION AT CANAL ST.


SCALE: 1 1/2" = 1'-0" A3.1.1/ A3.2.4

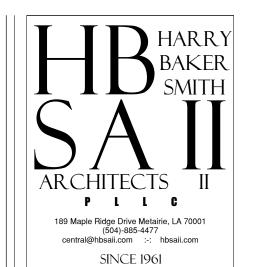

1031 CANAL STREET NEW ORLEANS, LOUISIANA


CERTIFIED CORRECT




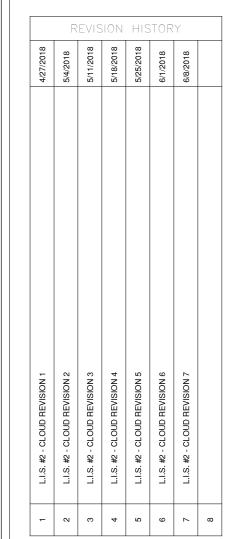


EXTERIOR DETAILS

PROJECT#: 1709 PHASE: DD TEAM: Author CHECKER: Checker SCALE: AS NOTED ISSUED: 4/20/2018

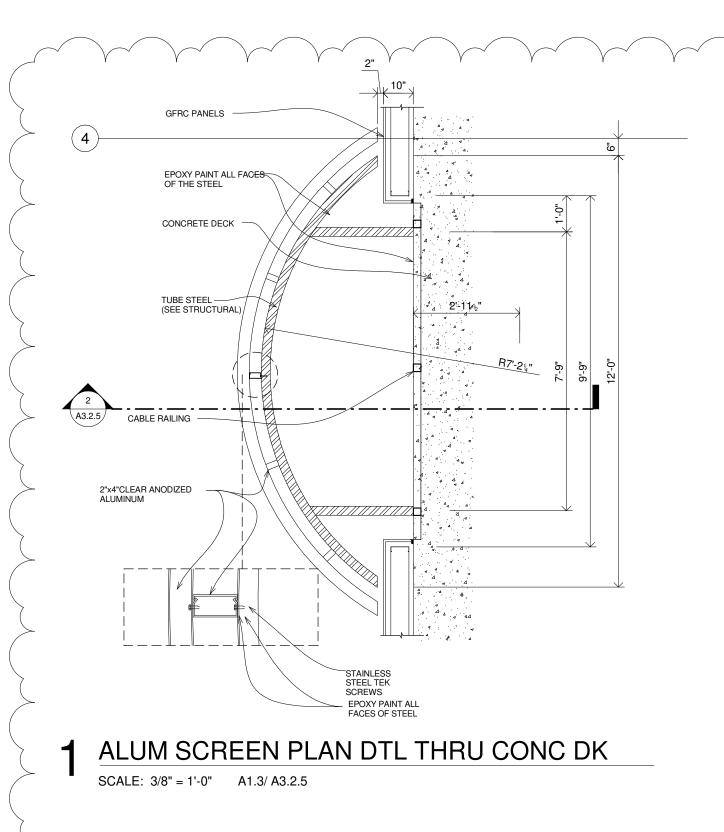


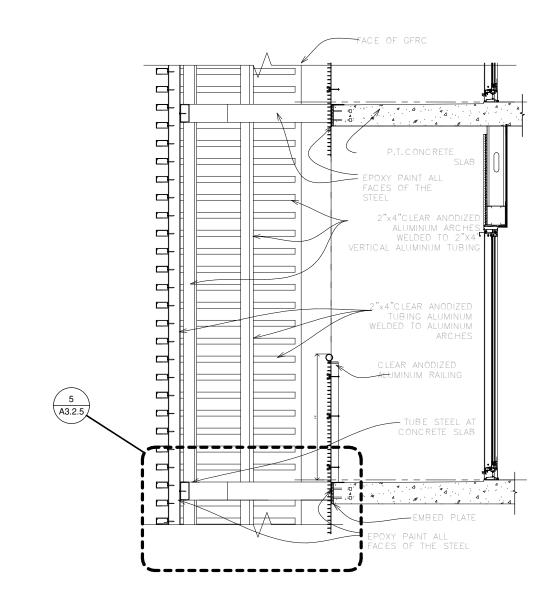


2 ALUM SCREEN DTL FLR-TO-FLR THRU P.T. SLAB SCALE: 3/8" = 1'-0" A3.1.2/ A3.2.5

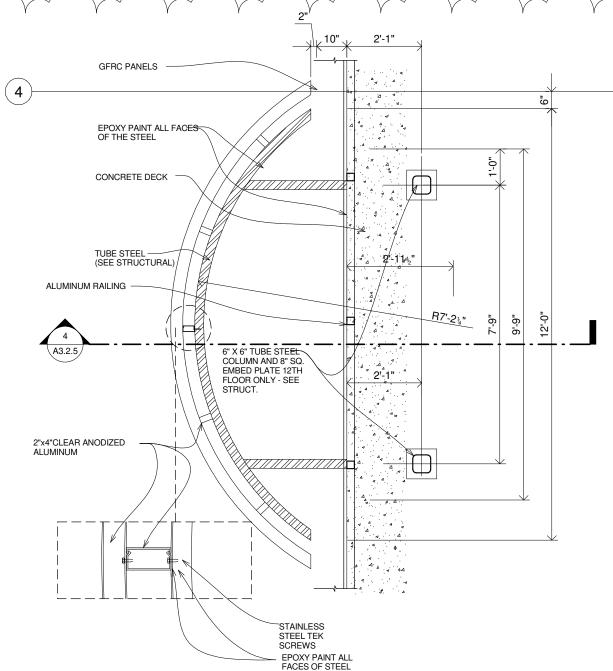

3 ALUM SCREEN PLAN DTL AT MTL DECK

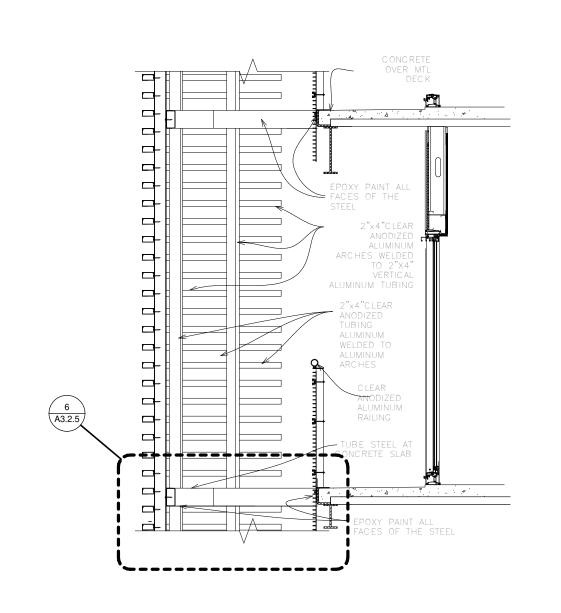


**ALUM SCREEN DTL FLR-TO-FLR METAL DECK** SCALE: 3/8" = 1'-0" A3.1.1/ A3.2.5

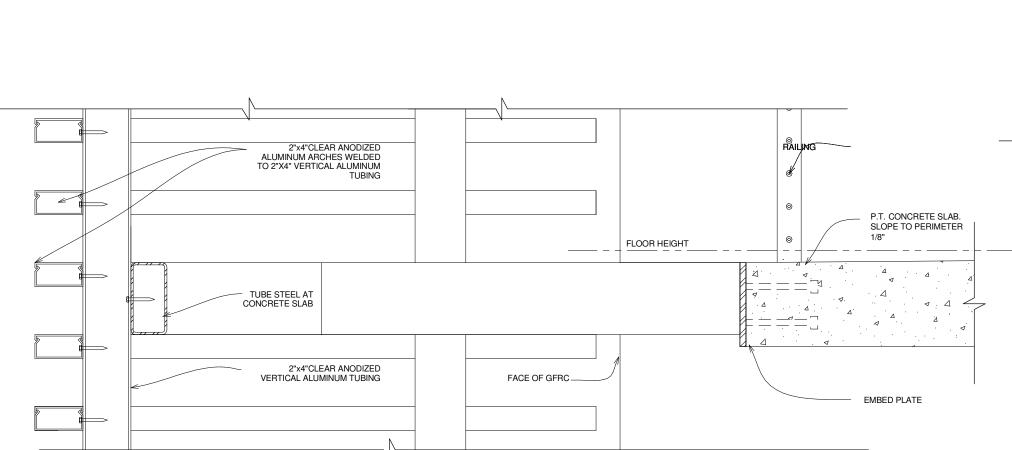


ALUM SCREEN BOTTOM SECTION DETAIL AT 5 CONC DK

SCALE: 1 1/2" = 1'-0" A3.2.5/ A3.2.5

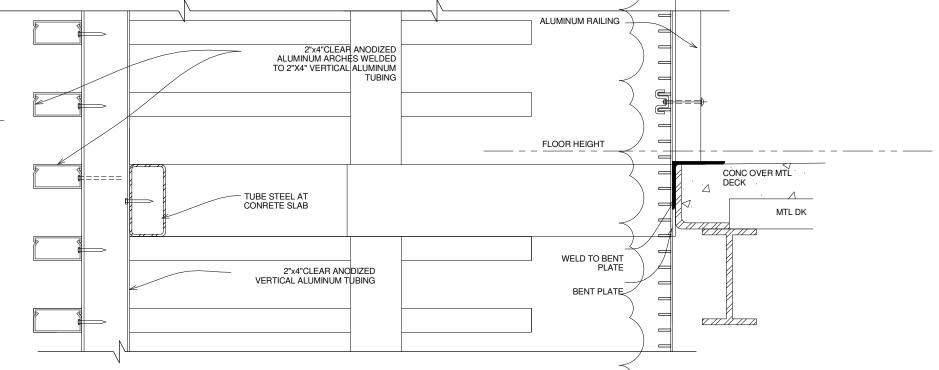


ALUM SCREEN BOTTOM SECTION DTL AT MTL

6 DECK SCALE: 1 1/2" = 1'-0" A3.2.5/ A3.2.5

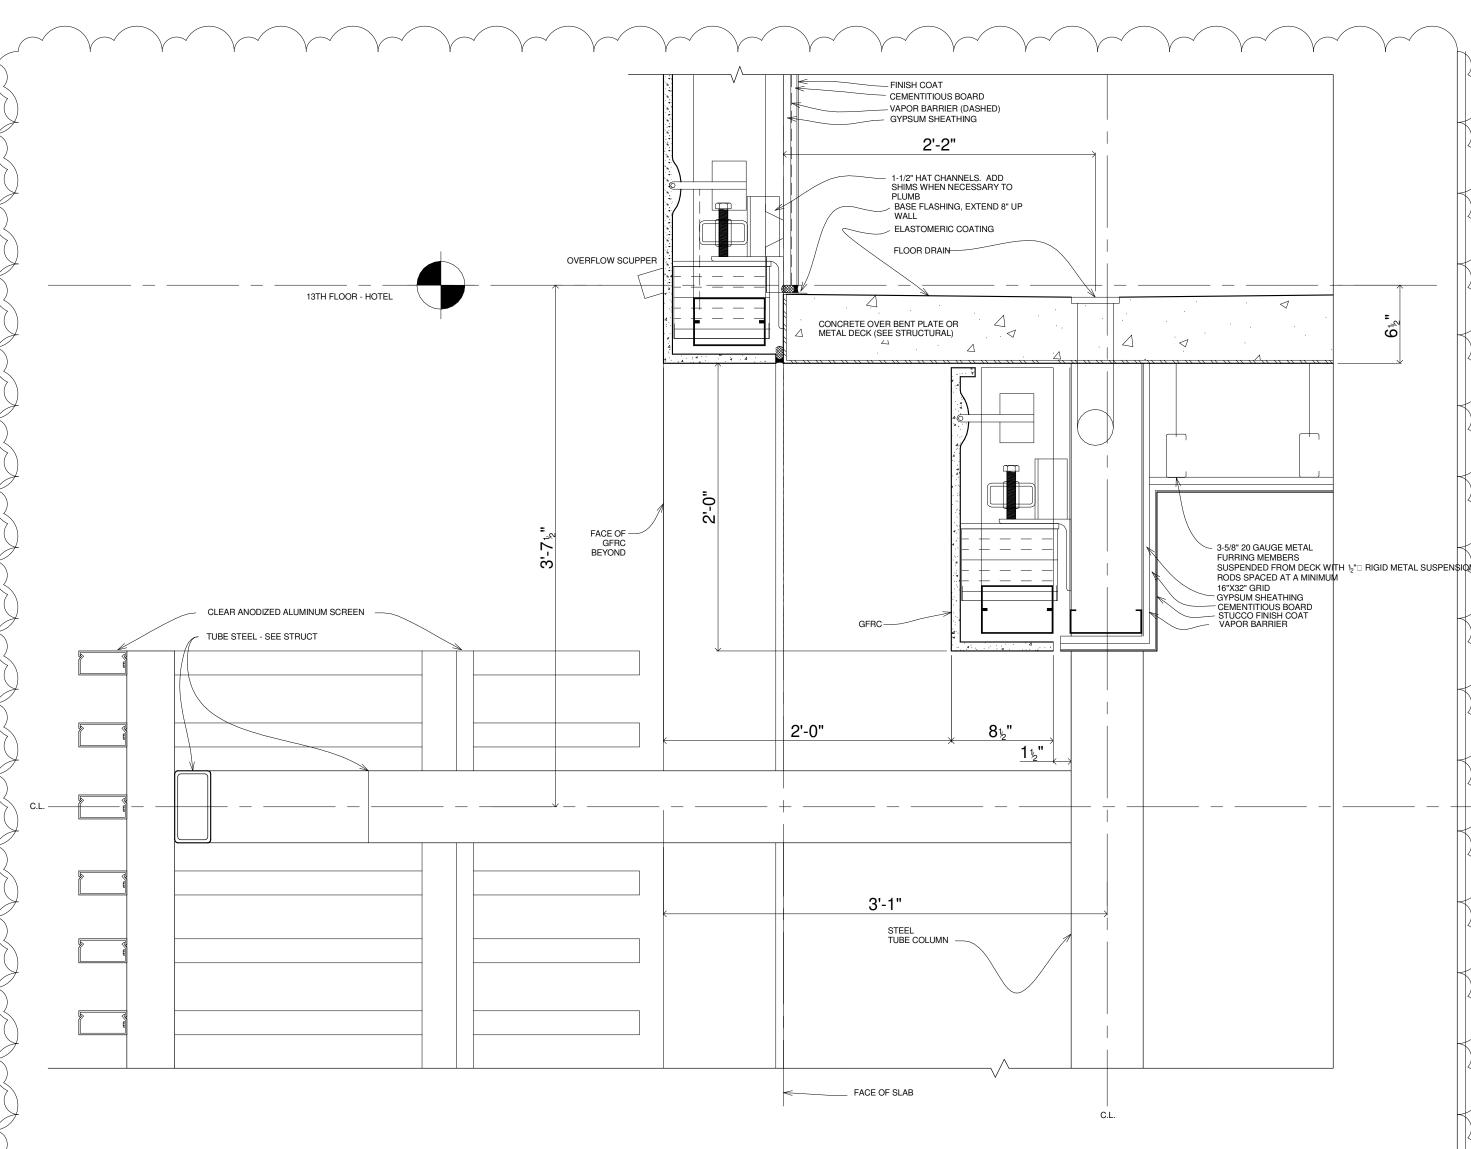


7 ALUM SCREEN TOP SECTION SCALE: 1 1/2" = 1'-0" A3.1.1/ A3.2.5

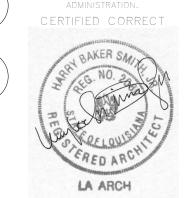


189 Maple Ridge Drive Metairie, LA 70001 (504)-885-4477 central@hbsaii.com :-: hbsaii.com


SINCE 1961

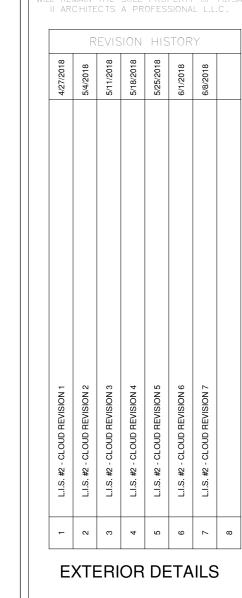

PROJECT#: 1709 PHASE: DD

TEAM: Author CHECKER: Checker SCALE: AS NOTED ISSUED: 4/20/2018

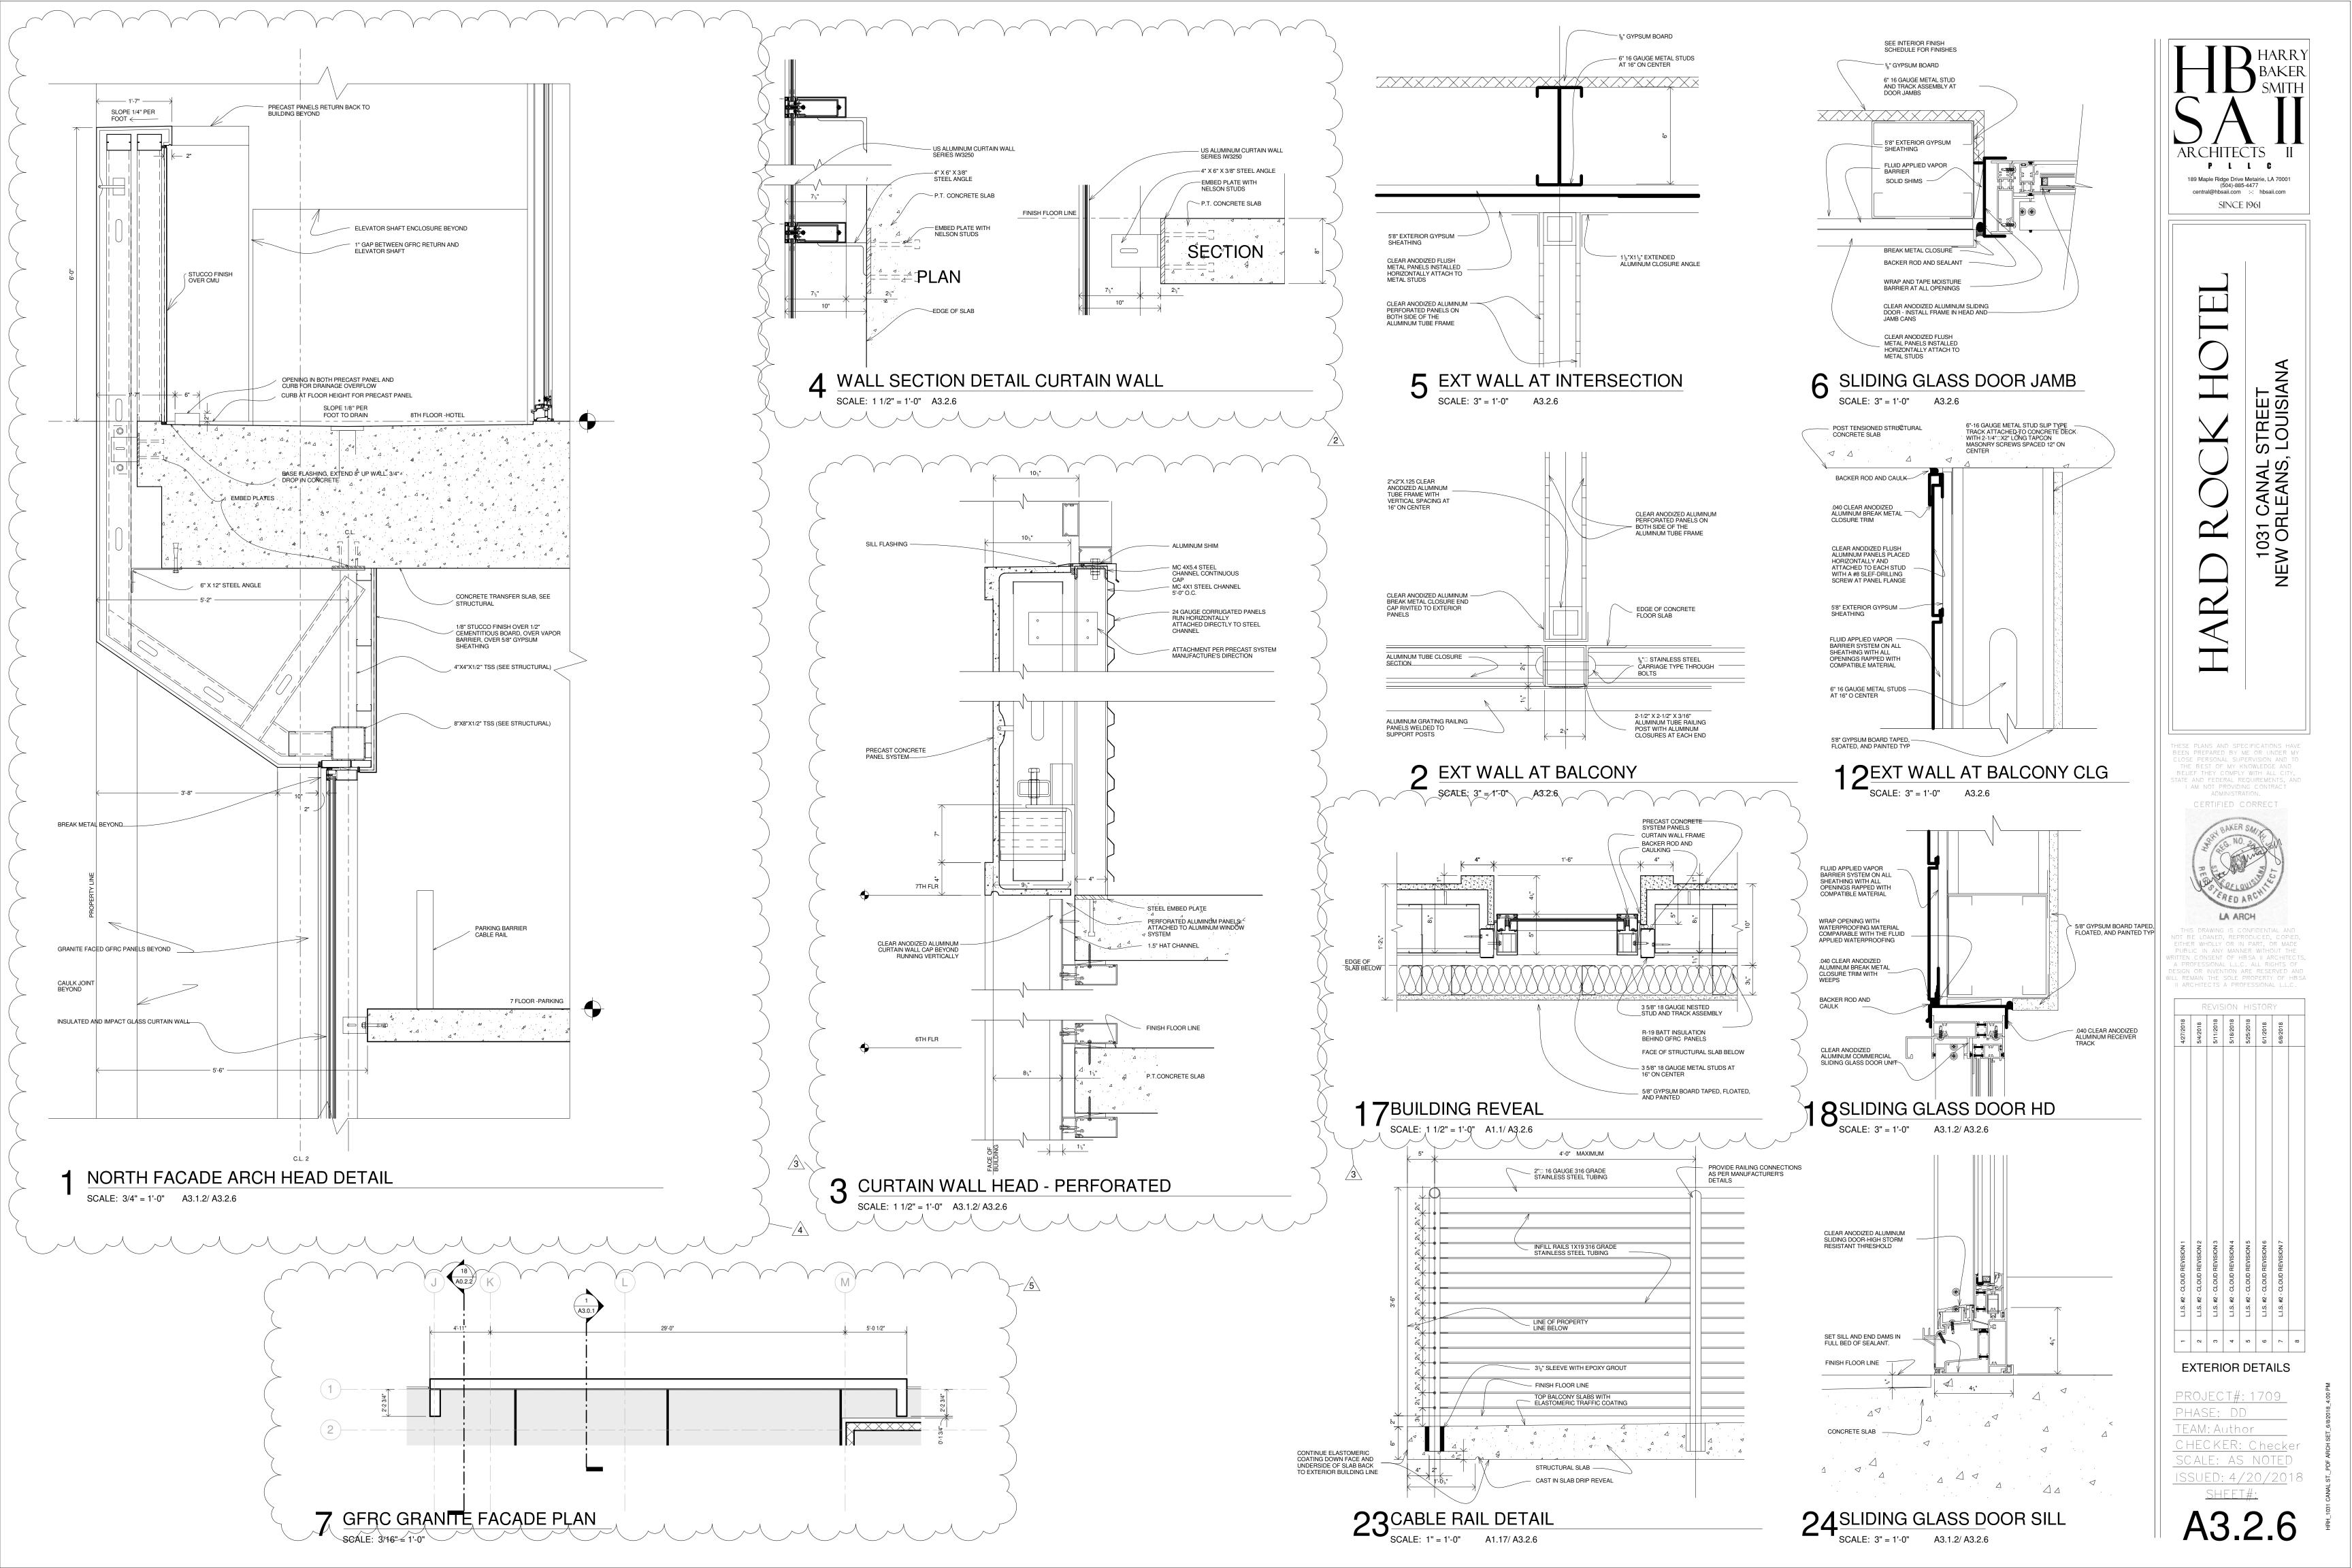

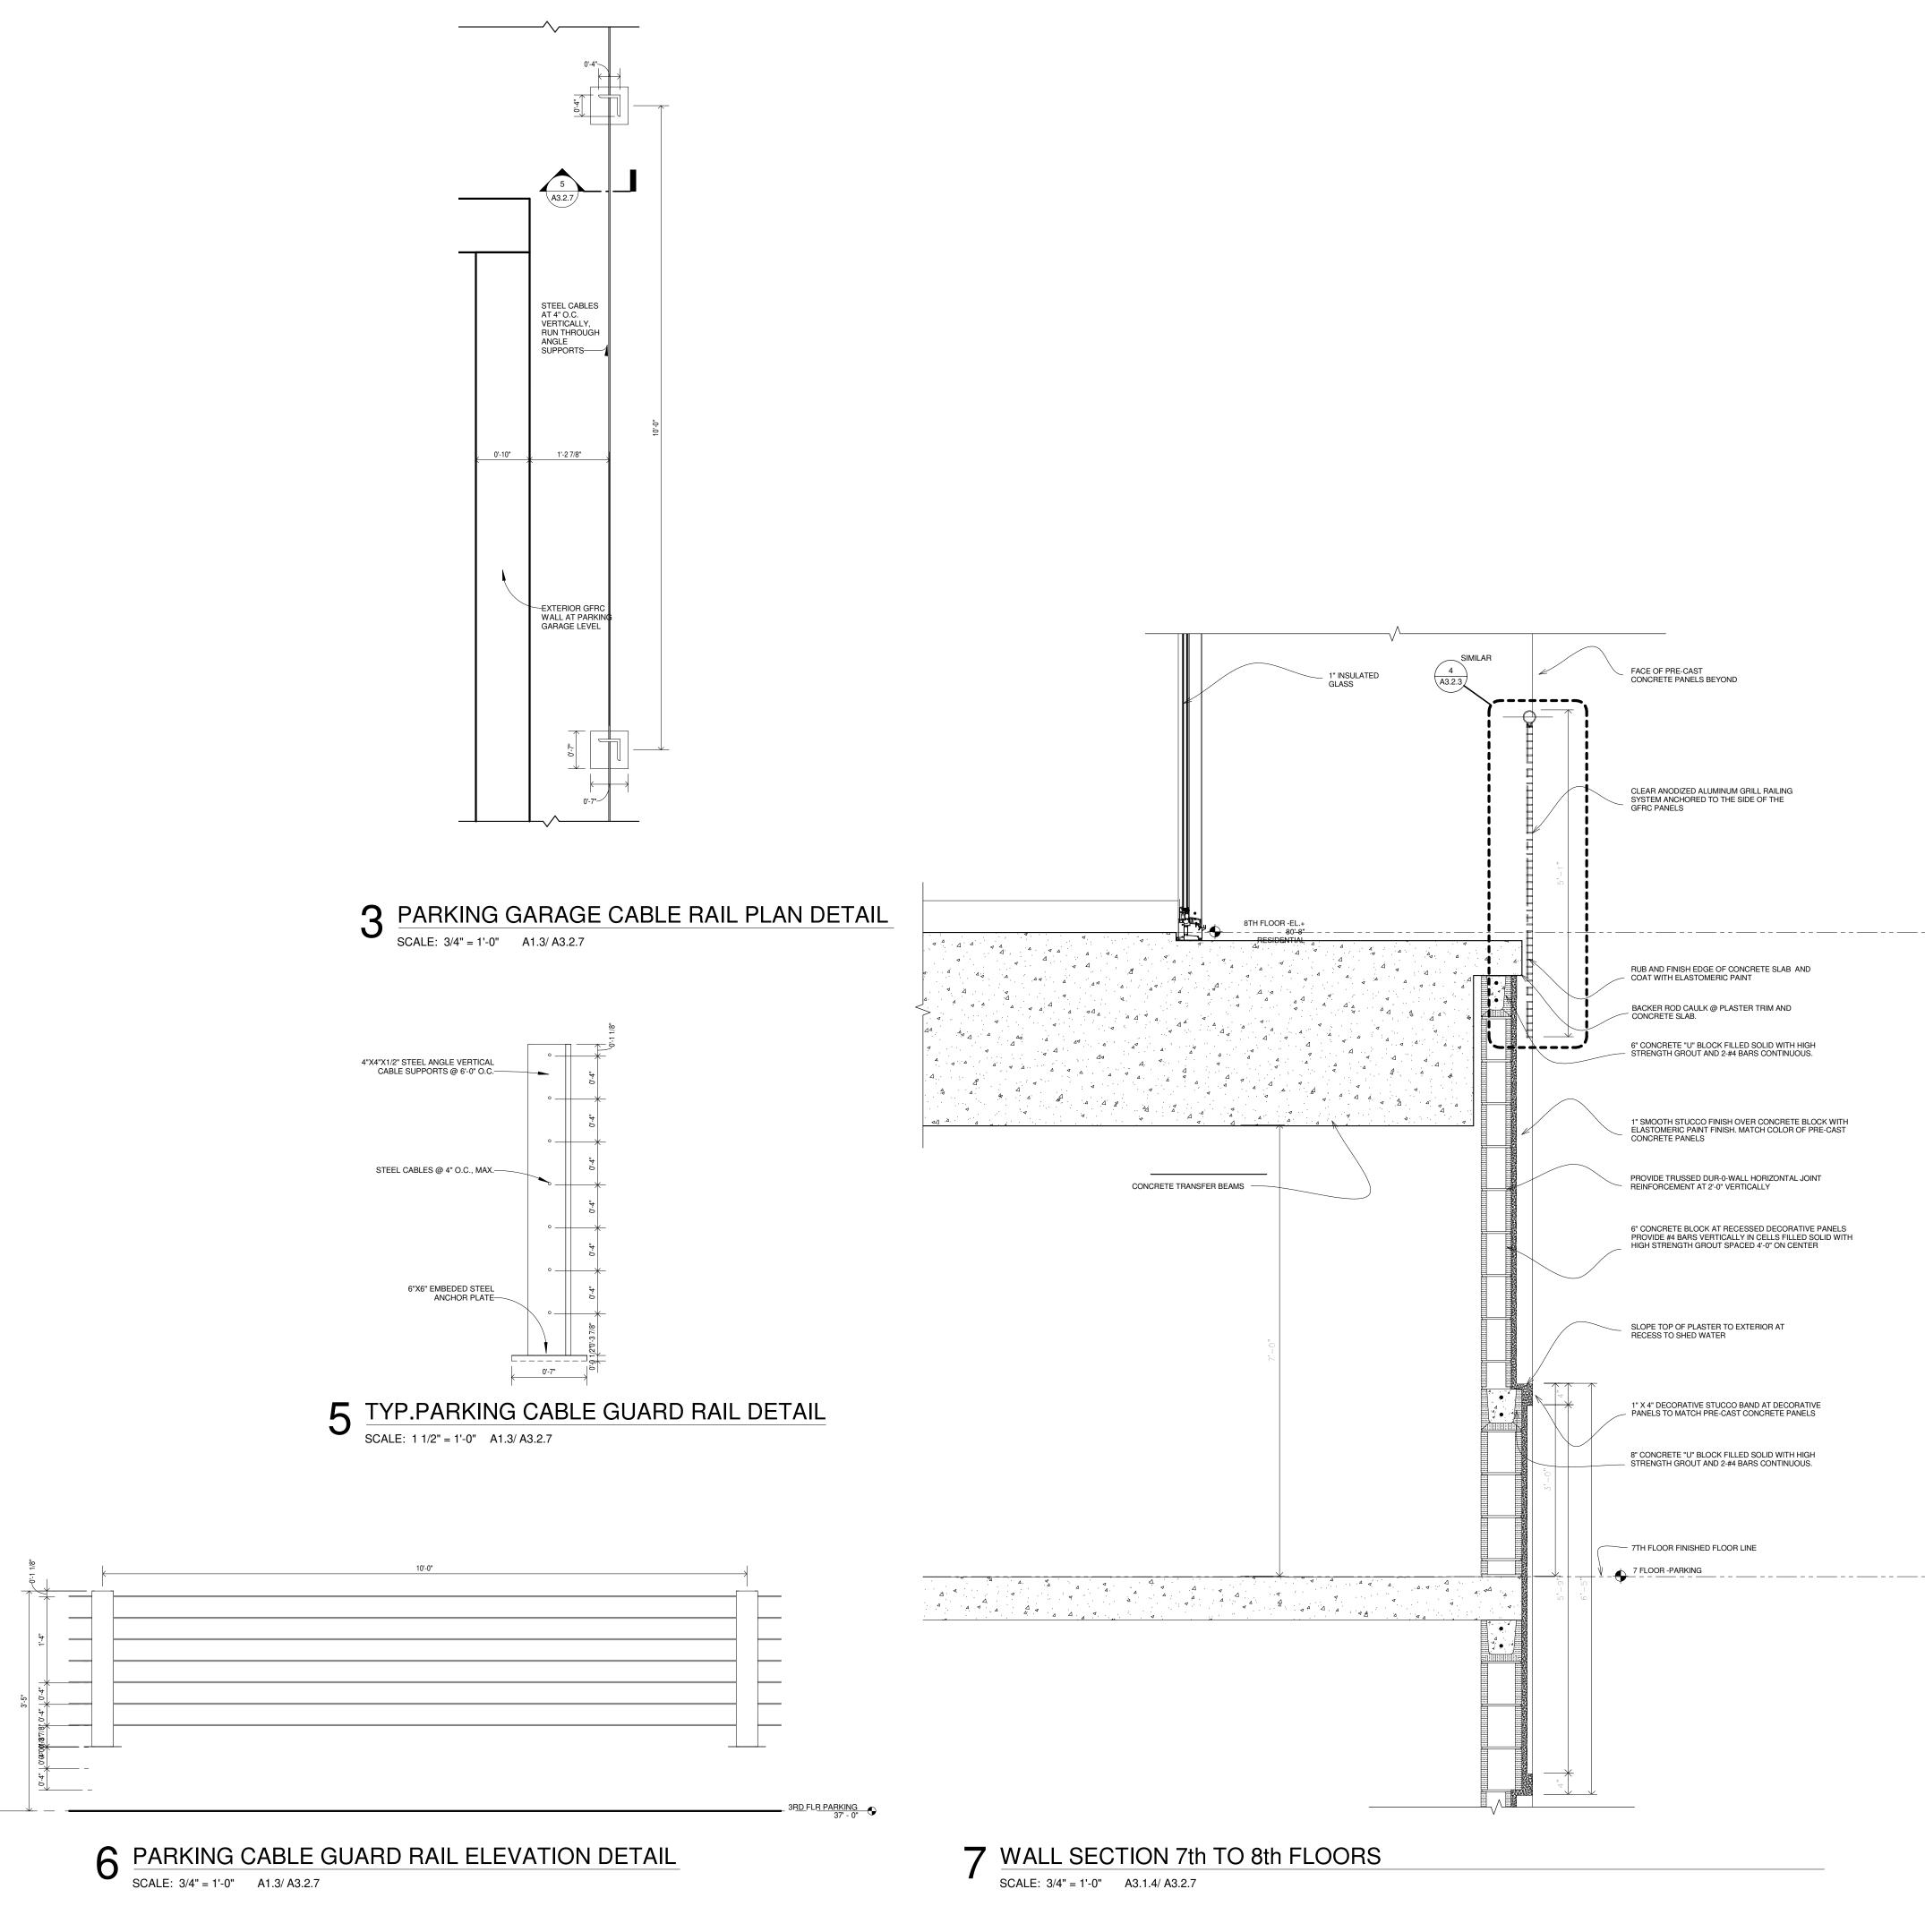

CANAL STREET

HESE PLANS AND SPECIFICATIONS HAVE
BEEN PREPARED BY ME OR UNDER MY
CLOSE PERSONAL SUPERVISION AND TO
THE BEST OF MY KNOWLEDGE AND
BELIEF THEY COMPLY WITH ALL CITY,
TATE AND FEDERAL REQUIREMENTS, AND
I AM NOT PROVIDING CONTRACT
ADMINISTRATION.

CERTIFIED CORRECT



THIS DRAWING IS CONFIDENTIAL AND
NOT BE LOANED, REPRODUCED, COPIED,
EITHER WHOLLY OR IN PART, OR MADE
PUBLIC IN ANY MANNER WITHOUT THE
WRITTEN CONSENT OF HBSA II ARCHITECTS,
A PROFESSIONAL LL.C. ALL RIGHTS OF
DESIGN OR INVENTION ARE RESERVED AND
WILL REMAIN THE SOLE PROPERTY OF HBSA

. #2 - CLOUD REVISION 1
. #2 - CLOUD REVISION 2
. #2 - CLOUD REVISION 3
. #2 - CLOUD REVISION 4
. #2 - CLOUD REVISION 6
. #2 - CLOUD REVISION 6
. #2 - CLOUD REVISION 7

EXTERIOR DETAILS

PROJECT#: 1709
PHASE: DD
TEAM: Author
CHECKER: Checker
SCALE: AS NOTED
ISSUED: 4/20/2018

A3.2.7

ROOF EDGE DETAIL

SCALE: 1" = 1'-0" A3.1.1/ A3.3.1

189 Maple Ridge Drive Metairie, LA 70001 (504)-885-4477 central@hbsaii.com :-: hbsaii.com SINCE 1961

1031 CANAL STREET NEW ORLEANS, LOUISIANA

THESE PLANS AND SPECIFICATIONS HAVE BEEN PREPARED BY ME OR UNDER MY CLOSE PERSONAL SUPERVISION AND TO THE BEST OF MY KNOWLEDGE AND BELIEF THEY COMPLY WITH ALL CITY, STATE AND FEDERAL REQUIREMENTS, AND I AM NOT PROVIDING CONTRACT ADMINISTRATION. CERTIFIED CORRECT




|                              | R                            | EVIS                         | ION                          | HIS                          | TOR                          | Υ                            |  |
|------------------------------|------------------------------|------------------------------|------------------------------|------------------------------|------------------------------|------------------------------|--|
| 4/27/2018                    | 5/4/2018                     | 5/11/2018                    | 5/18/2018                    | 5/25/2018                    | 6/1/2018                     | 6/8/2018                     |  |
|                              |                              |                              |                              |                              |                              |                              |  |
|                              |                              |                              |                              |                              |                              |                              |  |
| ION 1                        | ION 2                        | ion 3                        | ION 4                        | ION 5                        | 9 NOI                        | NOI 7                        |  |
| L.I.S. #2 - CLOUD REVISION 1 | L.I.S. #2 - CLOUD REVISION 2 | L.I.S. #2 - CLOUD REVISION 3 | L.I.S. #2 - CLOUD REVISION 4 | L.I.S. #2 - CLOUD REVISION 5 | L.I.S. #2 - CLOUD REVISION 6 | L.I.S. #2 - CLOUD REVISION 7 |  |
| 고                            | #2 - CI                      | #2 - CI                      | #2 - Cl                      | #2 - CI                      | #2 - CI                      | #2 - CI                      |  |

ROOF DETAILS

PROJECT#: 1709 PHASE: DD TEAM: Author CHECKER: Checker SCALE: AS NOTED

ISSUED: 4/20/2018
SHEET#:

A3.3.1

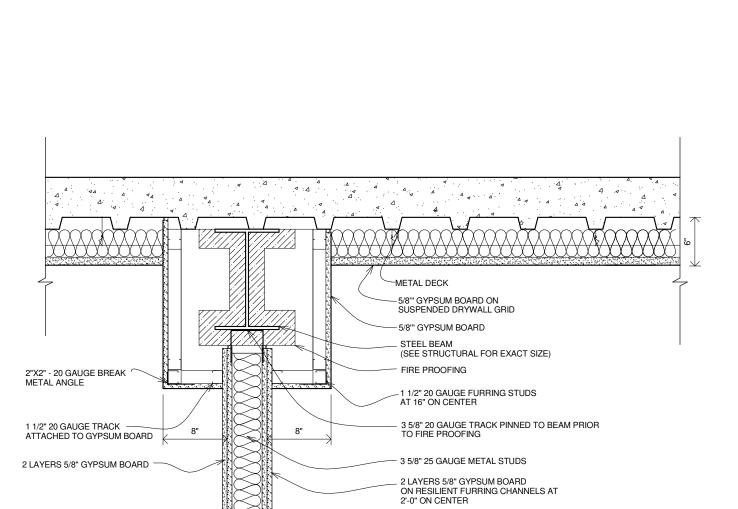

### 1 TYP. HOTEL DEMISING WALL SECTION

SCALE: 1" = 1'-0" A7.0-A/ A3.4.1

ANGLE 2 AT END-TLEE STEEL - SCOLT C-NNEL BLANCHTCH

FRIORET GET MO - SCOLT C-N

2ND FLOOR RETAIL HARRY
BAKER
SMITH
SMITH
ARCHITECTS II
P L C

189 Maple Ridge Drive Metairie, LA 70001
(504)-885-4477
central@hbsaii.com :: hbsaii.com
SINCE 1961

HARD ROCK HOTE

1031 CANAL STREET

NEW ORLEANS, LOUISIANA

THESE PLANS AND SPECIFICATIONS HAVE
BEEN PREPARED BY ME OR UNDER MY
CLOSE PERSONAL SUPERVISION AND TO
THE BEST OF MY KNOWLEDGE AND
BELIEF THEY COMPLY WITH ALL CITY,
STATE AND FEDERAL REQUIREMENTS, AND
I AM NOT PROVIDING CONTRACT
ADMINISTRATION.
CERTIFIED CORRECT




THIS DRAWING IS CONFIDENTIAL AND NOT BE LOANED, REPRODUCED, COPIED, EITHER WHOLLY OR IN PART, OR MADE PUBLIC IN ANY MANNER WITHOUT THE WRITTEN CONSENT OF HBSA II ARCHITECTS, A PROFESSIONAL L.L.C. ALL RIGHTS OF DESIGN OR INVENTION ARE RESERVED AND WILL REMAIN THE SOLE PROPERTY OF HBSA

|                              | REVISION HISTORY             |                              |                              |                              |                              |                              |    |  |  |
|------------------------------|------------------------------|------------------------------|------------------------------|------------------------------|------------------------------|------------------------------|----|--|--|
| 4/27/2018                    | 5/4/2018                     | 5/11/2018                    | 5/18/2018                    | 5/25/2018                    | 6/1/2018                     | 6/8/2018                     |    |  |  |
|                              |                              |                              |                              |                              |                              |                              |    |  |  |
| L.I.S. #2 - CLOUD REVISION 1 | L.I.S. #2 - CLOUD REVISION 2 | L.I.S. #2 - CLOUD REVISION 3 | L.I.S. #2 - CLOUD REVISION 4 | L.I.S. #2 - CLOUD REVISION 5 | L.I.S. #2 - CLOUD REVISION 6 | L.I.S. #2 - CLOUD REVISION 7 |    |  |  |
| -                            | 2                            | ε                            | 4                            | 5                            | 9                            | 7                            | 80 |  |  |

INTERIOR DETAILS

PROJECT#: 1709
PHASE: DD
TEAM: Author
CHECKER: Checker
SCALE: AS NOTED
ISSUED: 4/20/2018

A3.4.1

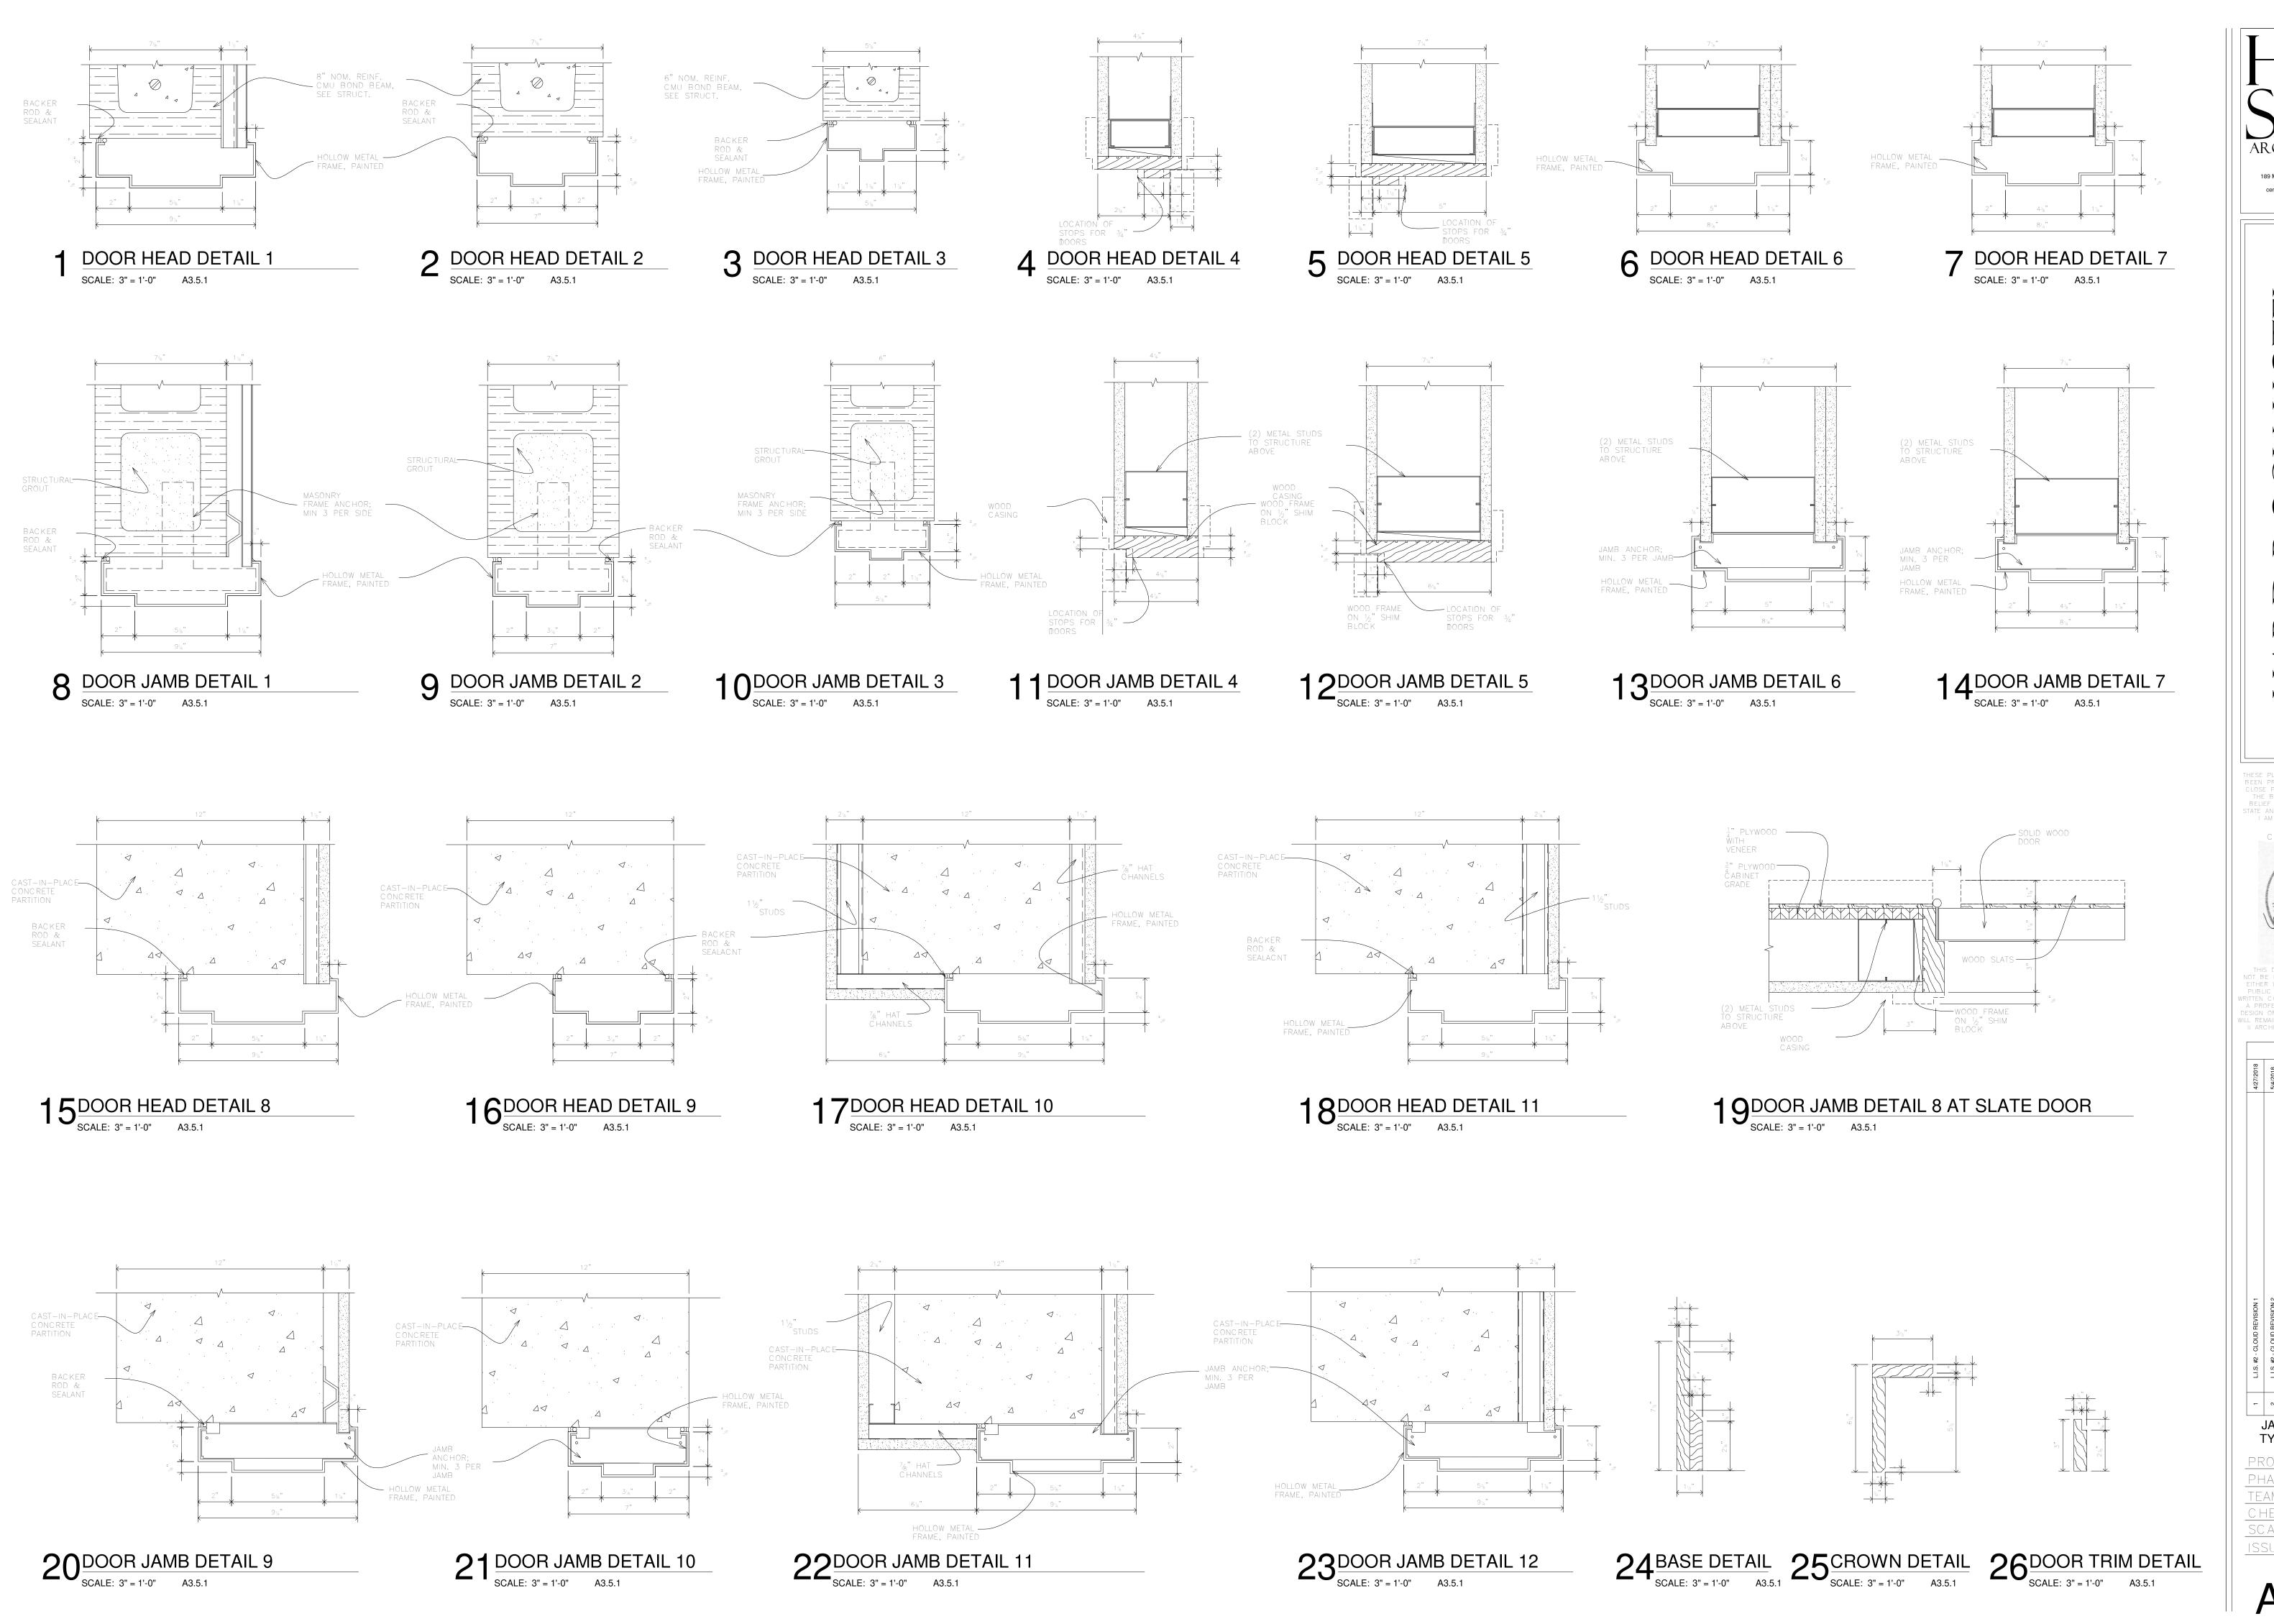

HARD ROCK HOTEL

1031 CANAL STREET


NEW ORLEANS, LOUISIANA

THESE PLANS AND SPECIFICATIONS HAVE BEEN PREPARED BY ME OR UNDER MY CLOSE PERSONAL SUPERVISION AND TO THE BEST OF MY KNOWLEDGE AND BELIEF THEY COMPLY WITH ALL CITY, STATE AND FEDERAL REQUIREMENTS, AND I AM NOT PROVIDING CONTRACT ADMINISTRATION.

CERTIFIED CORRECT



THIS DRAWING IS CONFIDENTIAL AND
NOT BE LOANED, REPRODUCED, COPIED,
EITHER WHOLLY OR IN PART, OR MADE
PUBLIC IN ANY MANNER WITHOUT THE
WRITTEN CONSENT OF HBSA II ARCHITECTS
A PROFESSIONAL L.L.C. ALL RIGHTS OF
DESIGN OR INVENTION ARE RESERVED AND
WILL REMAIN THE SOLE PROPERTY OF HBS
II ARCHITECTS A PROFESSIONAL L.L.C.

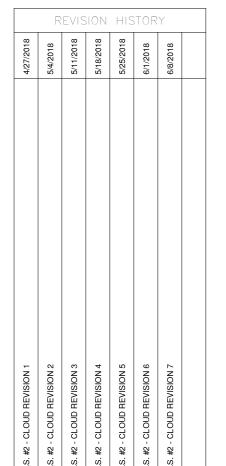


JAMB HEAD, SILL TYPICAL DETAILS

PROJECT#: 1709
PHASE: DD
TEAM: Author
CHECKER: Checker
SCALE: AS NOTED
ISSUED: 4/20/2018

SHEET#:
A3.5.1



THIS DRAWING IS CONFIDENTIAL AND NOT BE LOANED, REPRODUCED, COPIED, EITHER WHOLLY OR IN PART, OR MADE PUBLIC IN ANY MANNER WITHOUT THE WRITTEN CONSENT OF HBSA II ARCHITECTS, A PROFESSIONAL L.L.C. ALL RIGHTS OF DESIGN OR INVENTION ARE RESERVED AND WILL REMAIN THE SOLE PROPERTY OF HBSA

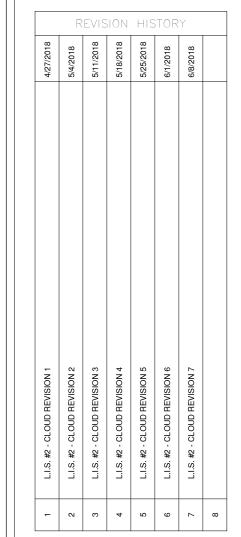


JAMB HEAD, SILL
TYPICAL DETAILS

PROJECT#: 1709
PHASE: DD
TEAM: Author
CHECKER: Checker
SCALE: AS NOTED

ISSUED: 4/20/2018

A3.5.2

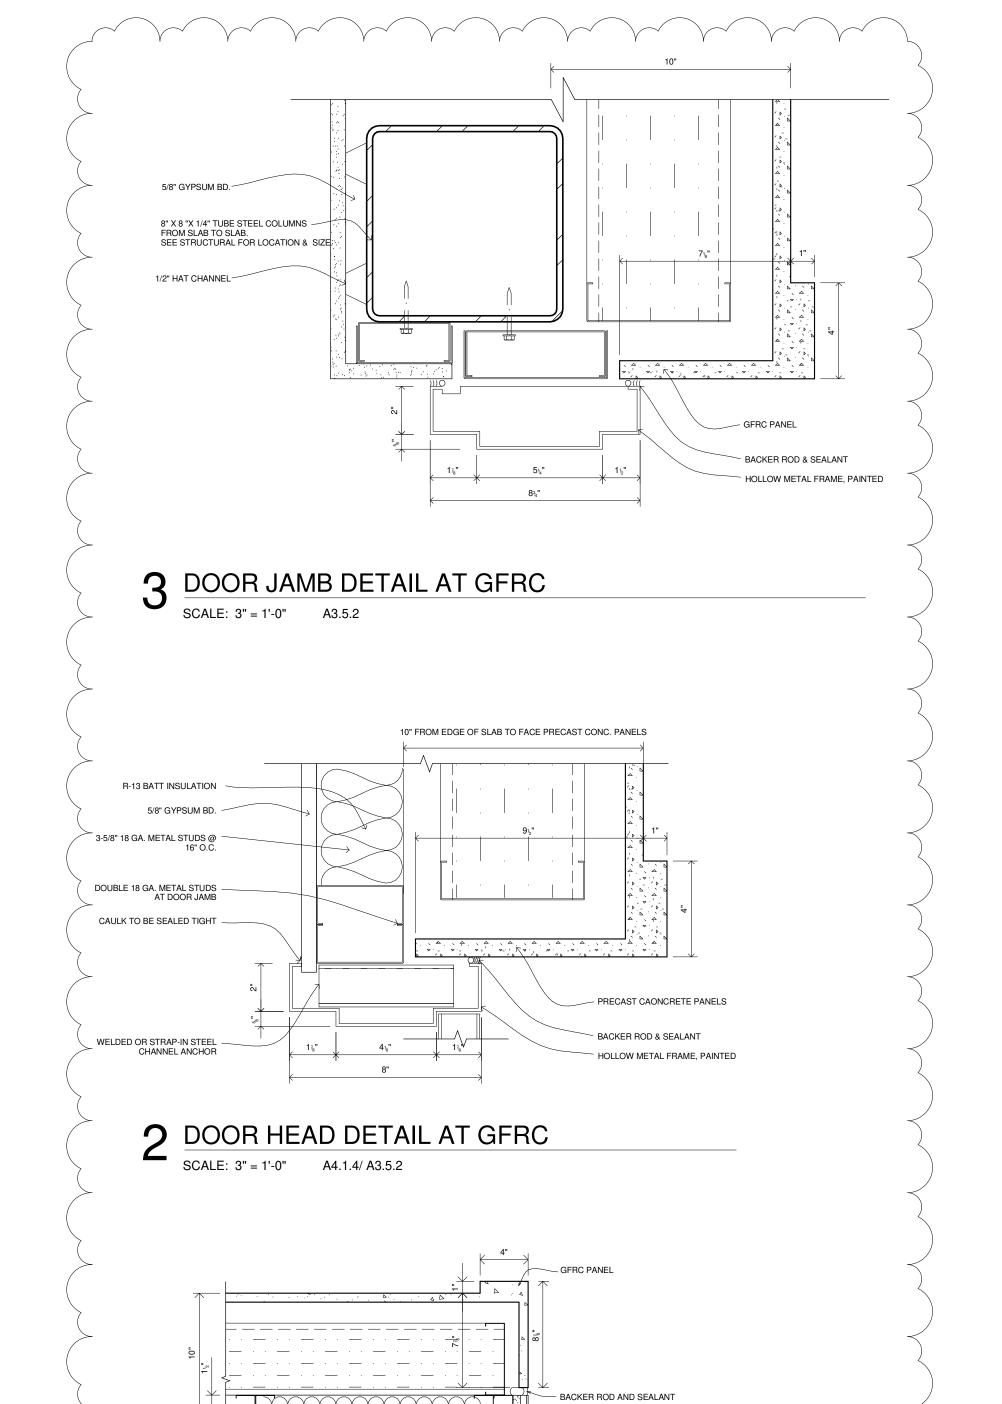

1/8" STUCCO FINISH
1/2" CEMENT BOARD
5/8" GYPSUM BD. ON 3-5/8"
METAL STUDS @ 16" O.C.

GFRC STUCCO BACK WINDOW JAMB

— STOREFRONT GLASS GLAZING SYSTEM



THIS DRAWING IS CONFIDENTIAL AND
NOT BE LOANED, REPRODUCED, COPIED,
EITHER WHOLLY OR IN PART, OR MADE
PUBLIC IN ANY MANNER WITHOUT THE
WRITTEN CONSENT OF HBSA II ARCHITECTS,
A PROFESSIONAL L.L.C. ALL RIGHTS OF
DESIGN OR INVENTION ARE RESERVED AND
WILL REMAIN THE SOLE PROPERTY OF HBSA


|  | REVISION HISTORY |                              |                              |                              |                              |                              |                              |                              |  |
|--|------------------|------------------------------|------------------------------|------------------------------|------------------------------|------------------------------|------------------------------|------------------------------|--|
|  |                  | 4/27/2018                    | 5/4/2018                     | 5/11/2018                    | 5/18/2018                    | 5/25/2018                    | 6/1/2018                     | 6/8/2018                     |  |
|  |                  | L.I.S. #2 - CLOUD REVISION 1 | L.I.S. #2 - CLOUD REVISION 2 | L.I.S. #2 - CLOUD REVISION 3 | L.I.S. #2 - CLOUD REVISION 4 | L.I.S. #2 - CLOUD REVISION 5 | L.I.S. #2 - CLOUD REVISION 6 | L.I.S. #2 - CLOUD REVISION 7 |  |


POOL DETAILS

PROJECT#: 1709
PHASE: DD
TEAM: Author
CHECKER: Checker
SCALE: AS NOTED


Δ361

ISSUED: 4/20/2018

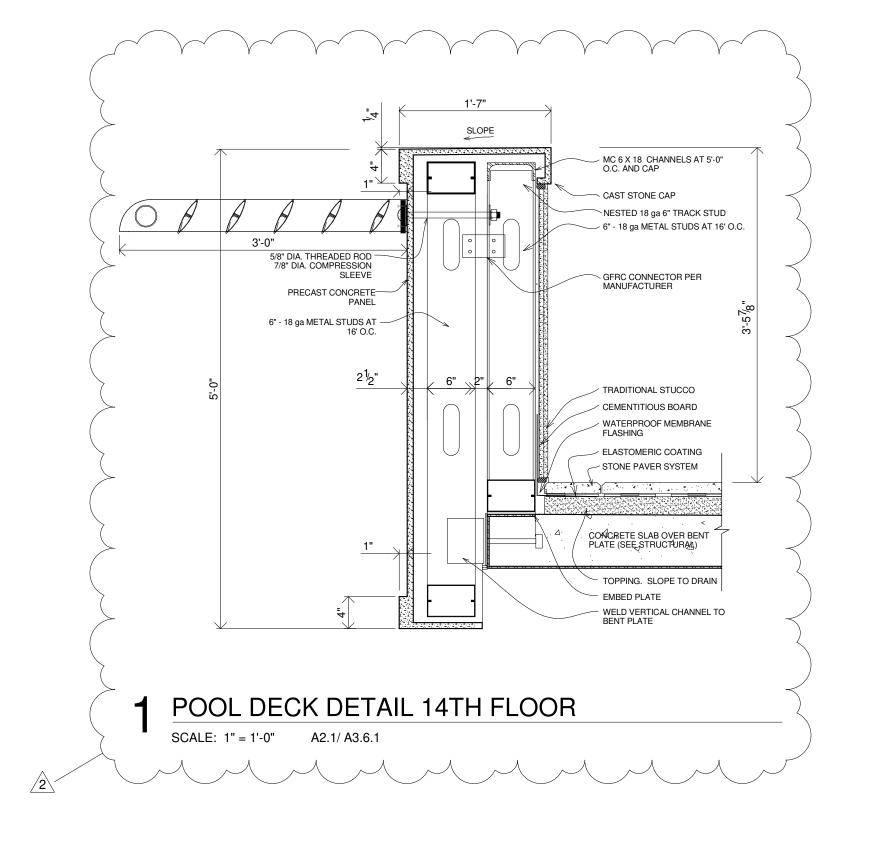

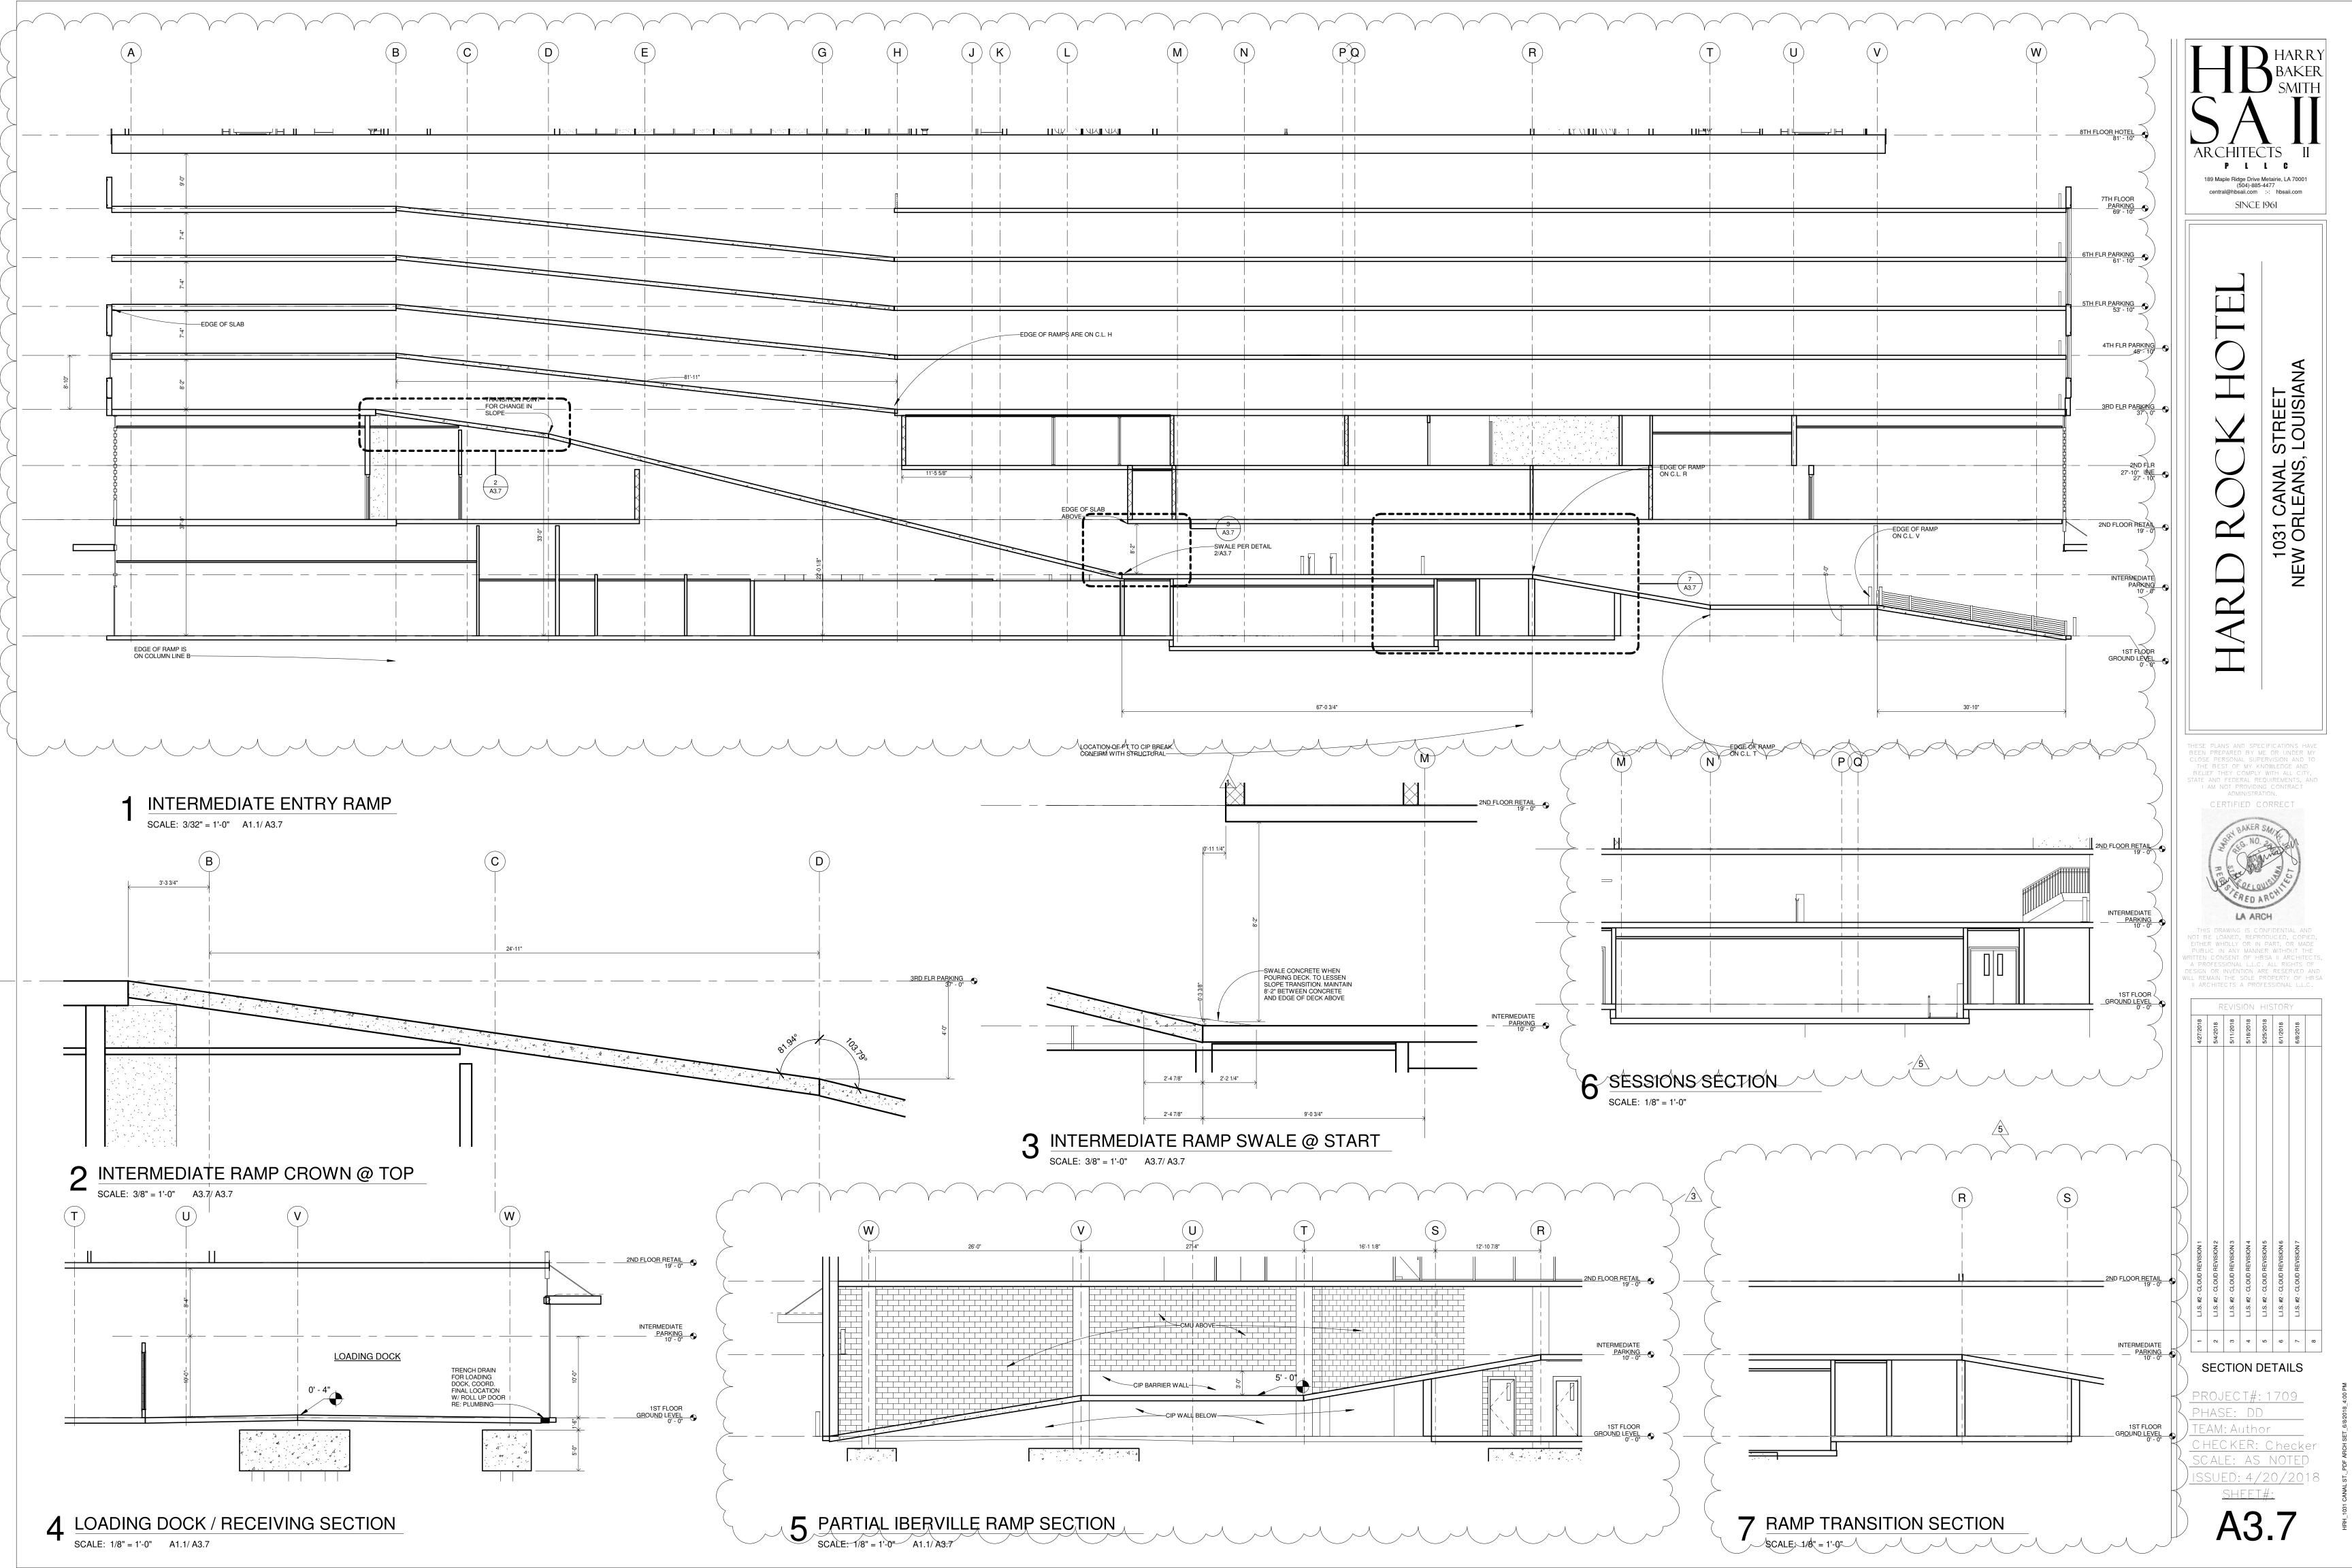


#### PEDESTAL PAVER DETAIL 1

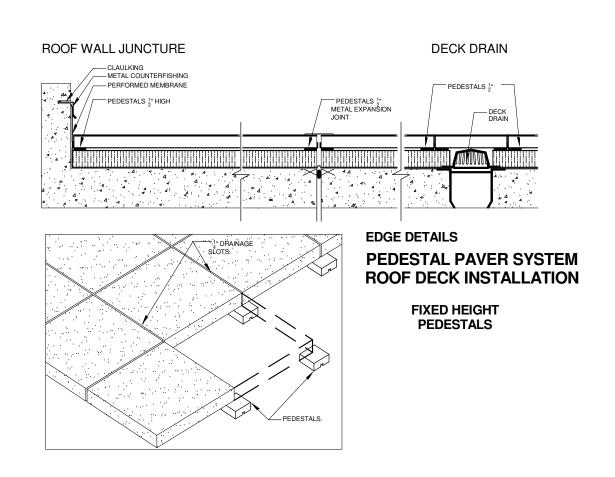

# 2 PEDESTAL PAVER DETAIL 2

\_\_\_ TILE TECH PAVERS PEDESTAL PAVER SYSTEM WATERPROOFING MEMBRANE **INSTALLATION DETAILS** \_\_ SLIP SHEET **DRAIN DETAIL**  ELEVATE PAVERS WITH TILE TECH
 APPROVED PEDESTAL SYSTEM **TYPICAL** 


## PEDESTAL PAVER DETAIL 3 SCALE: 1" = 1'-0" A3.7.1

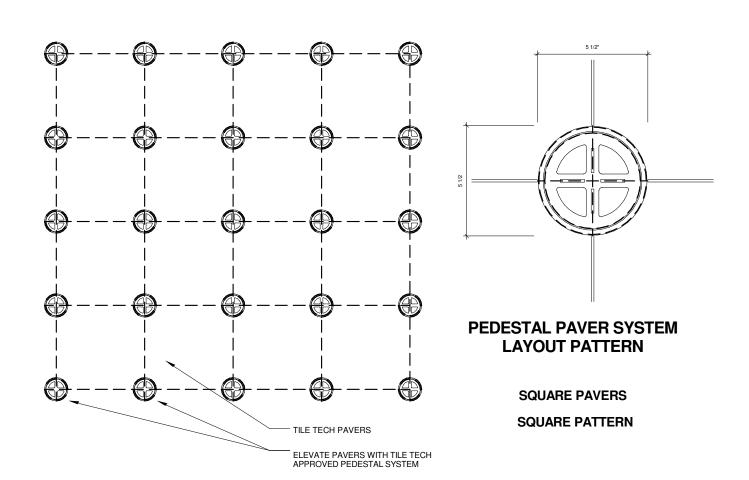


# 4 PEDESTAL PAVER DETAIL 4

PEDESTAL PAVER SYSTEM **INSTALLATION DETAILS** SLOPE DETAILS WATERPROOFING MEMBRANE \_\_ SLIP SHEET - INSULATION 60psl. LEVEL SURFACE OVER SLOPE \_ TILE TECH PAVERS ELEVATE PAVERS WITH TILE TECH APPROVED PEDESTAL SYSTEMS


## 5 PEDESTAL PAVER DETAIL 5

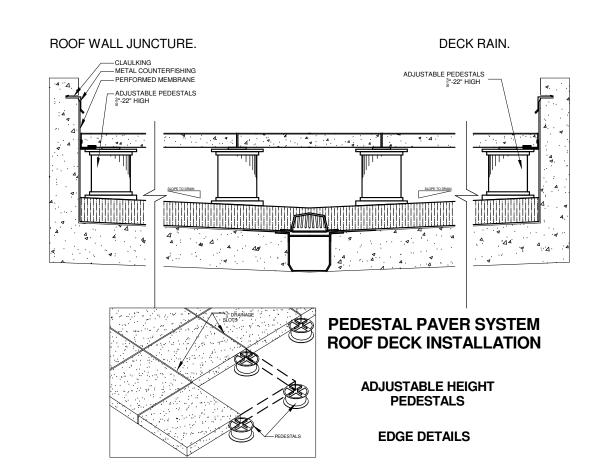


## 6 PEDESTAL PAVER DETAIL 6

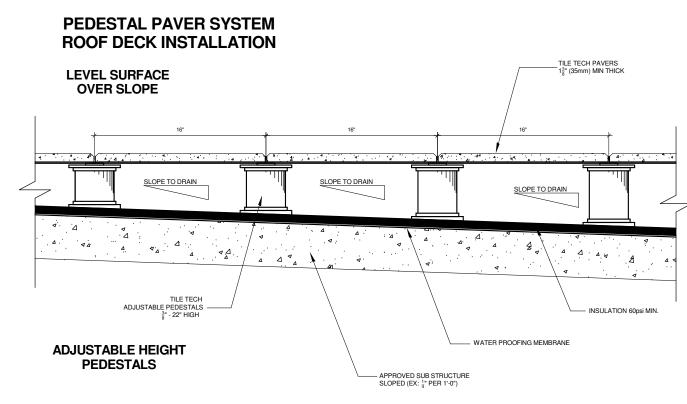


#### PEDESTAL PAVER DETAIL 7 SCALE: 1" = 1'-0" A3.7.1

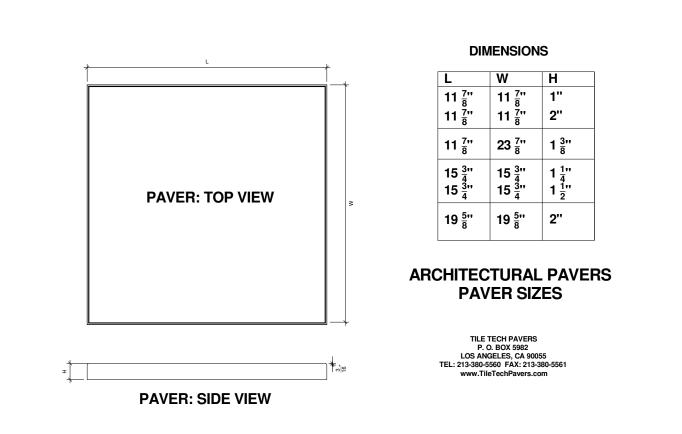


#### 8 PEDESTAL PAVER DETAIL 8 SCALE: 1" = 1'-0" A3.7.1

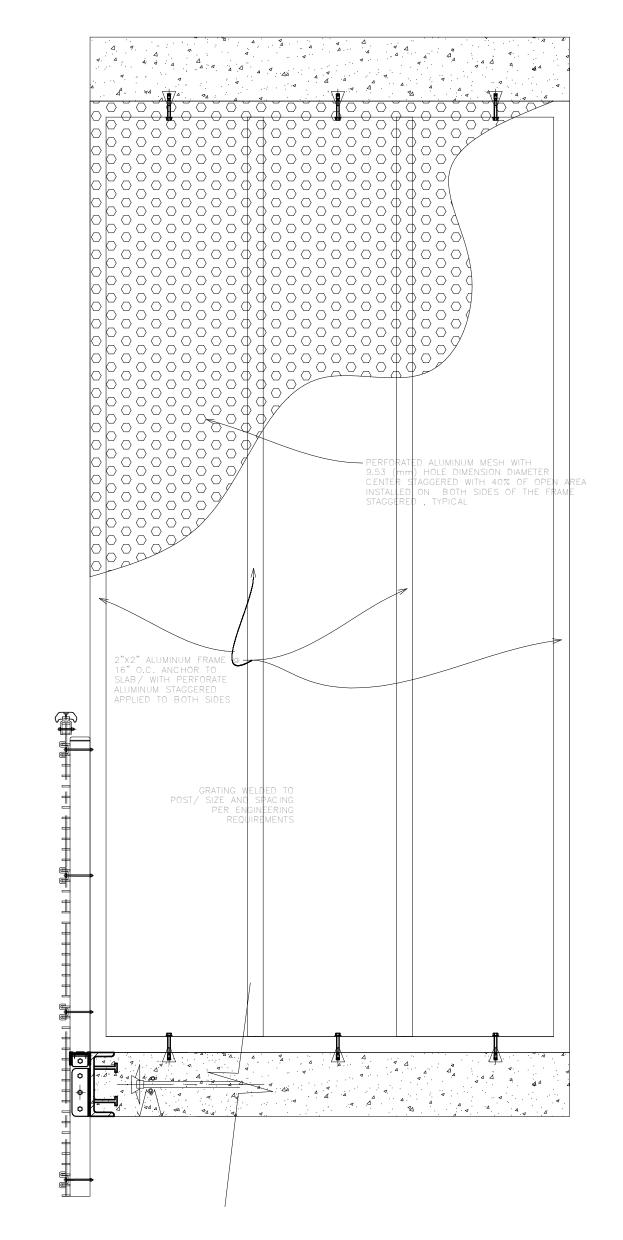

9 TYP BALCONY PARTITIONS SCALE: 1" = 1'-0" A3.7.1

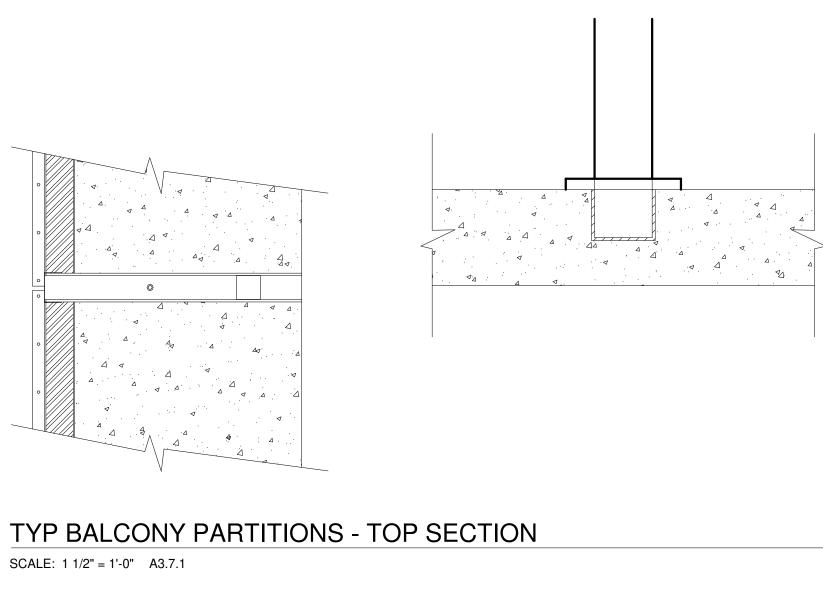


1 TYP BALCONY PARTITIONS - TOP SECTION

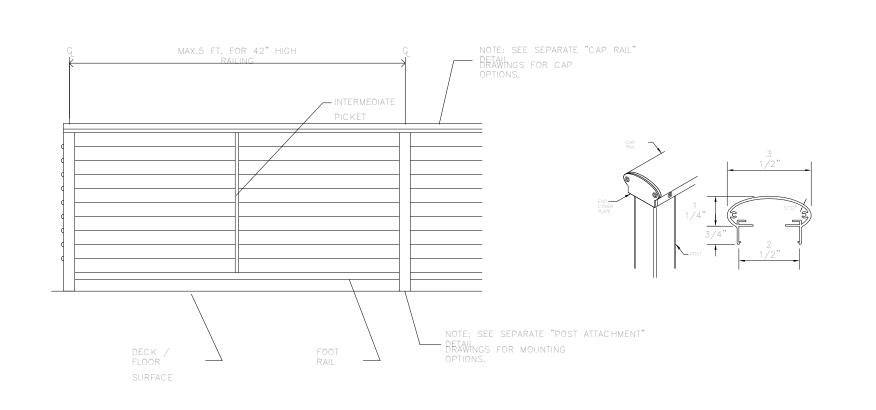


12TYP RAILING AT ROOF RAILING


SCALE: 1/2" = 1'-0" A3.7.1

13 TYP RAILING AT ROOF - CAP SCALE: 3" = 1'-0" A3.7.1

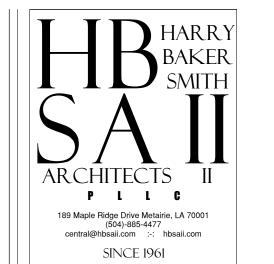

CERTIFIED CORRECT

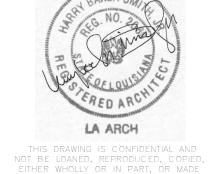

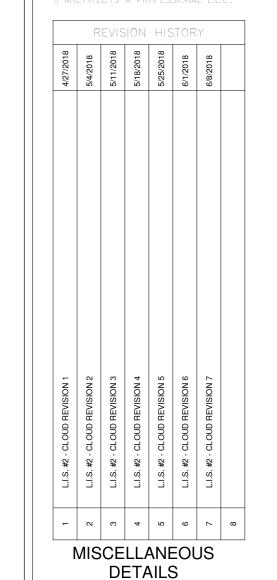

CHECKER: Checker SCALE: AS NOTED

ISSUED: 4/20/2018

PROJECT#: 1709

PHASE: DD

TEAM: Author



# HARD ROCK HOTE 1031 CANAL STREET NEW ORLEANS, LOUISIANA

THESE PLANS AND SPECIFICATIONS HAVE BEEN PREPARED BY ME OR UNDER MY CLOSE PERSONAL SUPERVISION AND TO THE BEST OF MY KNOWLEDGE AND BELIEF THEY COMPLY WITH ALL CITY, STATE AND FEDERAL REQUIREMENTS, AND I AM NOT PROVIDING CONTRACT ADMINISTRATION.

CERTIFIED CORRECT



THIS DRAWING IS CONFIDENTIAL AND
NOT BE LOANED, REPRODUCED, COPIED,
EITHER WHOLLY OR IN PART, OR MADE
PUBLIC IN ANY MANNER WITHOUT THE
WRITTEN CONSENT OF HBSA II ARCHITECTS
A PROFESSIONAL L.L.C. ALL RIGHTS OF
DESIGN OR INVENTION ARE RESERVED AND
WILL REMAIN THE SOLE PROPERTY OF HBSA


|                              | R                            |                              | SION                         |                              | TOR                          | Υ                            |   |
|------------------------------|------------------------------|------------------------------|------------------------------|------------------------------|------------------------------|------------------------------|---|
| 4/27/2018                    | 5/4/2018                     | 5/11/2018                    | 5/18/2018                    | 5/25/2018                    | 6/1/2018                     | 6/8/2018                     |   |
| L.I.S. #2 - CLOUD REVISION 1 | L.i.s. #2 - CLOUD REVISION 2 | L.i.S. #2 - CLOUD REVISION 3 | L.I.S. #2 - CLOUD REVISION 4 | L.i.S. #2 - CLOUD REVISION 5 | L.i.S. #2 - CLOUD REVISION 6 | L.i.S. #2 - CLOUD REVISION 7 |   |
| -                            | 2                            | င                            | 4                            | 5                            | 9                            | 7                            | ∞ |
| ı                            | MIS                          |                              | LLA<br>ETA                   |                              |                              | JS                           |   |

PROJECT#: 1709 PHASE: DD TEAM: Author

CHECKER: Checker SCALE: AS NOTED ISSUED: 4/20/2018


ISSUED: 4/20/2018
SHEET#:

A3.7.2

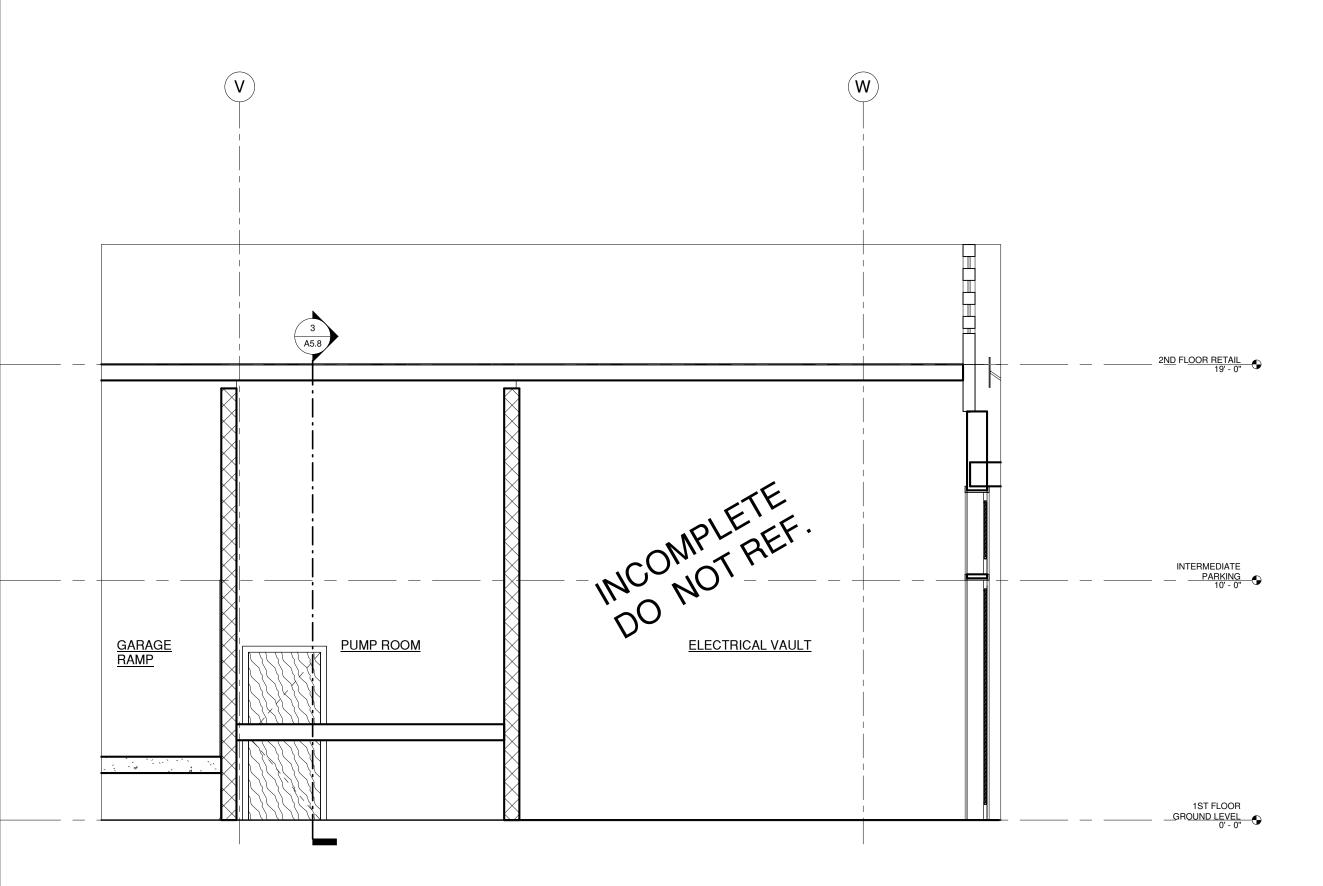

SECTION AT PUMP ROOM

SCALE: 1/4" = 1'-0" A1.1/ A3.8.2

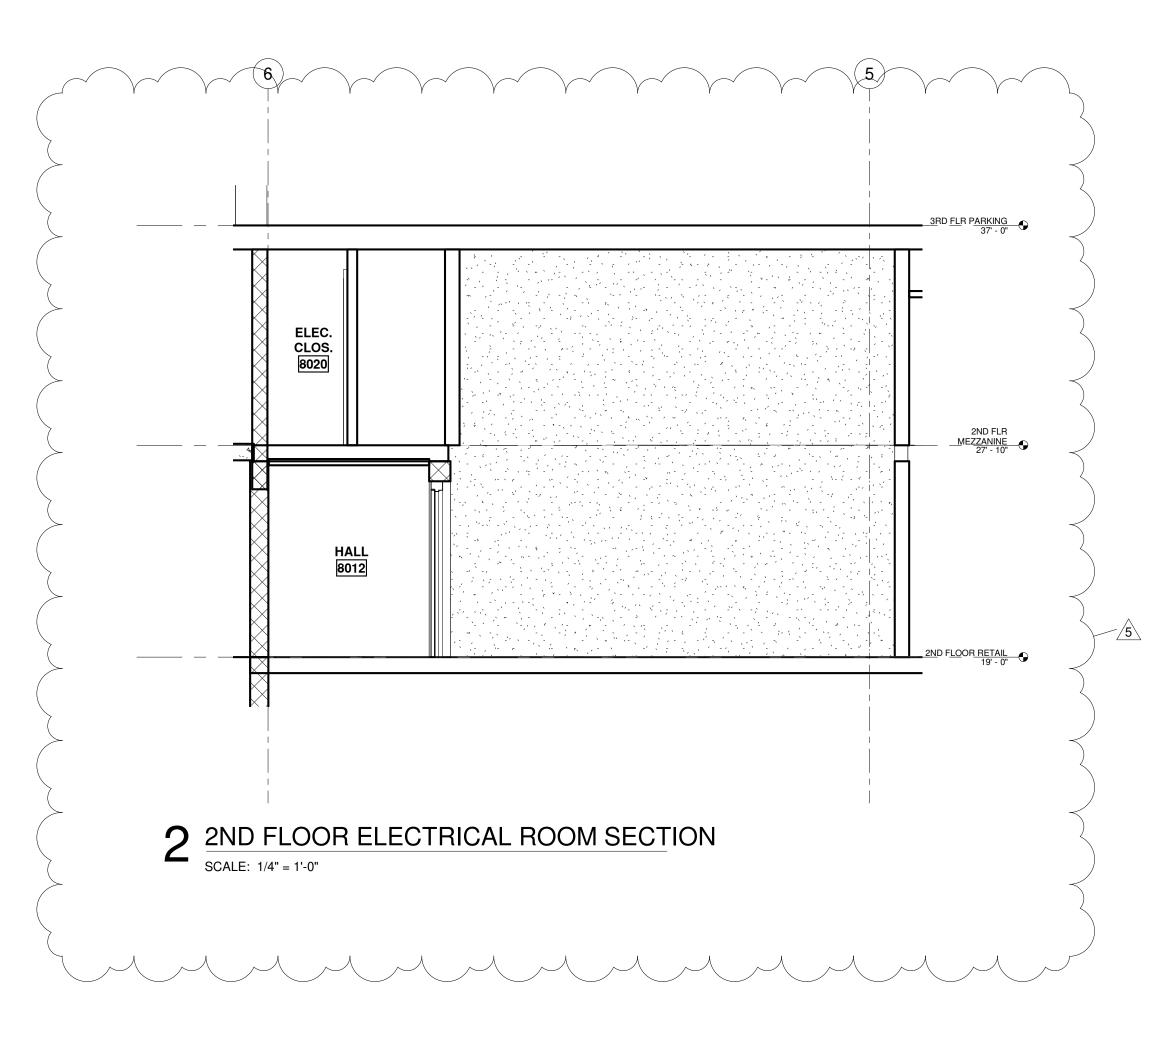

HARRY
BAKER
SMITH
SMITH
ARCHITECTS II
P L C

189 Maple Ridge Drive Metairie, LA 70001
(504)-885-4477
central@hbsaii.com :: hbsaii.com
SINCE 1961

HARD ROCK HOTE

1031 CANAL STREET

NEW ORLEANS, LOUISIANA

THESE PLANS AND SPECIFICATIONS HAVE BEEN PREPARED BY ME OR UNDER MY CLOSE PERSONAL SUPERVISION AND TO THE BEST OF MY KNOWLEDGE AND BELIEF THEY COMPLY WITH ALL CITY, STATE AND FEDERAL REQUIREMENTS, AND I AM NOT PROVIDING CONTRACT ADMINISTRATION.

CERTIFIED CORRECT



THIS DRAWING IS CONFIDENTIAL AND NOT BE LOANED, REPRODUCED, COPIED, EITHER WHOLLY OR IN PART, OR MADE PUBLIC IN ANY MANNER WITHOUT THE WRITTEN CONSENT OF HBSA II ARCHITECTS, A PROFESSIONAL L.L.C. ALL RIGHTS OF DESIGN OR INVENTION ARE RESERVED AND WILL REMAIN THE SOLE PROPERTY OF HBSA II ARCHITECTS A PROFESSIONAL L.L.C.

|                              | R                            |                              |                              | HIS                          |                              |                              |  |
|------------------------------|------------------------------|------------------------------|------------------------------|------------------------------|------------------------------|------------------------------|--|
| 4/27/2018                    | 5/4/2018                     | 5/11/2018                    | 5/18/2018                    | 5/25/2018                    | 6/1/2018                     | 6/8/2018                     |  |
| 4                            | in .                         | in .                         | in .                         | in .                         | 0                            | 0                            |  |
| L.I.S. #2 - CLOUD REVISION 1 | L.I.S. #2 - CLOUD REVISION 2 | L.I.S. #2 - CLOUD REVISION 3 | L.I.S. #2 - CLOUD REVISION 4 | L.I.S. #2 - CLOUD REVISION 5 | L.I.S. #2 - CLOUD REVISION 6 | L.I.S. #2 - CLOUD REVISION 7 |  |
|                              |                              |                              |                              |                              |                              |                              |  |


SECTION DETAILS

PROJECT#: 1709
PHASE: DD
TEAM: Author
CHECKER: Checker
SCALE: AS NOTED

ISSUED: 4/20/2018
SHEET#:

A3.8.2


**EXISTING** OFFSET IN PROPERTY LINE-—DUR-O-WAL JOINT REINFORCED AT 2'-0" O.C. VERTICALLY, TYP. FILL CELLS SOLID WITH 1 #4 BAR AND 5000 PSI PEA GRAVEL CONCRETE AT 4'-0" O.C.

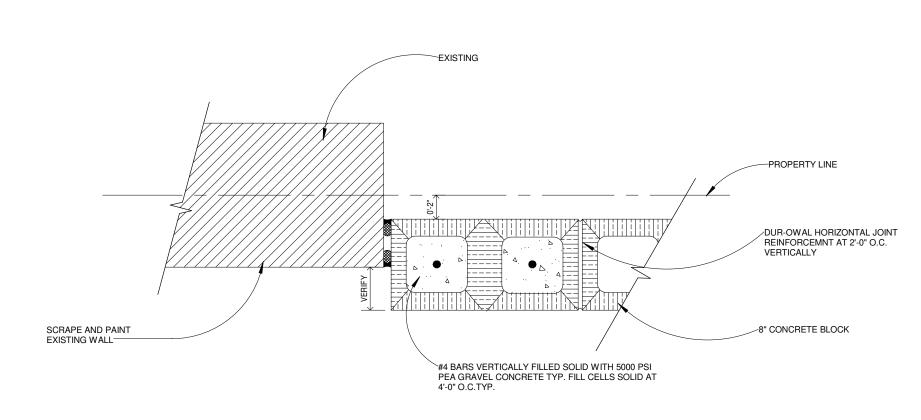


FLASHING @ COMMON WALL TOP SCALE: 3/4" = 1'-0" A3.1.4/ A3.9

2 NEW BLOCK WALL AT OFFSET @ SOUTH WALL SCALE: 1 1/2" = 1'-0" A1.1/ A3.9

NEW WALL TO EXISTING WALL SCALE: 1 1/2" = 1'-0" A1.1/ A3.9

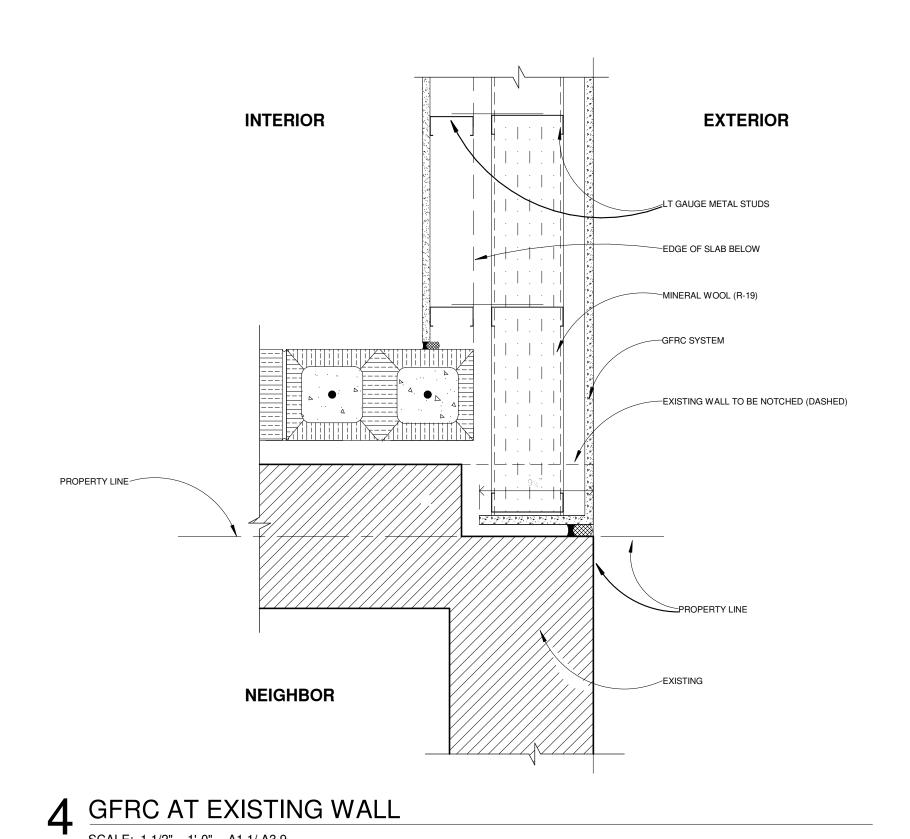

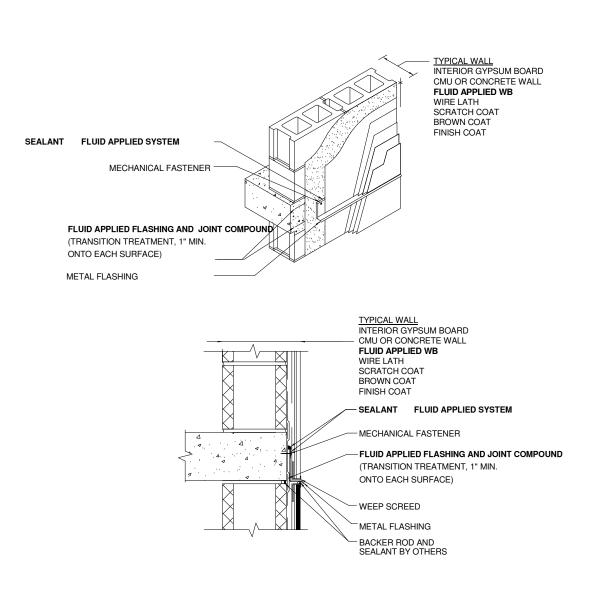

5 WALL TYPE INTERSECTION WATERPROOF SCALE: 1" = 1'-0"

### **DETAIL NOTES:**

- 1. SEE DETAIL 1/A3.9 for general detail of condition that exists at various elevations on the south property line. This detail will need to be coordinated in the field in conditions where existing adjacent demising walls terminate between floor levels.
- 2. SEE DETAIL 3/A3.9 for general detail of condition that exists at various plan locations on the south property line. This detail will need to be coordinated in the field in conditions where existing adjacent demising walls terminate and new walls begin. Some walls have collapsed and some walls have been demolished. Exact field location is field coordinated.
- 3. SEE DETAIL 2/A3.9 FOR general detail of condition that exists at the south wall where the property line jogs per the survey. This detail will need to be coordinated in the field. Notify architect if conflicts exist or field visit is required to ascertain as solution.
- 4. Finish face of exterior faces above adjacent demising walls on the south property lines. Shall be set back 1" from the property line. PER DETAIL 1/A3.9
- 5. Slab edges edges that terminate into the side wall of existing demising walls shall be set back 1" per detail 1/A3.9 These locations are to be field coordinated. As existing walls are not plumb.



1031 CANAL STREET NEW ORLEANS, LOUISIANA

CERTIFIED CORRECT




|                             | REVISION HISTORY             |                              |                              |                              |                               |                               |   |  |  |  |
|-----------------------------|------------------------------|------------------------------|------------------------------|------------------------------|-------------------------------|-------------------------------|---|--|--|--|
| 4/27/2018                   | 5/4/2018                     | 5/11/2018                    | 5/18/2018                    | 5/25/2018                    | 6/1/2018                      | 6/8/2018                      |   |  |  |  |
| Li.S. #2 - CLOUD REVISION 1 | L.I.S. #2 - CLOUD REVISION 2 | L.i.S. #2 - CLOUD REVISION 3 | L.i.S. #2 - CLOUD REVISION 4 | L.i.S. #2 - CLOUD REVISION 5 | L.i.s., #2 - CLOUD REVISION 6 | L.i.S., #2 - CLOUD REVISION 7 |   |  |  |  |
|                             | N                            | က                            | 4                            | 2                            | 9                             |                               | 8 |  |  |  |

**COMMON WALL** SECTION DETAILS

PROJECT#: 1709 PHASE: DD TEAM: Author CHECKER: Checker


SCALE: AS NOTED SSUED: 4/20/2018

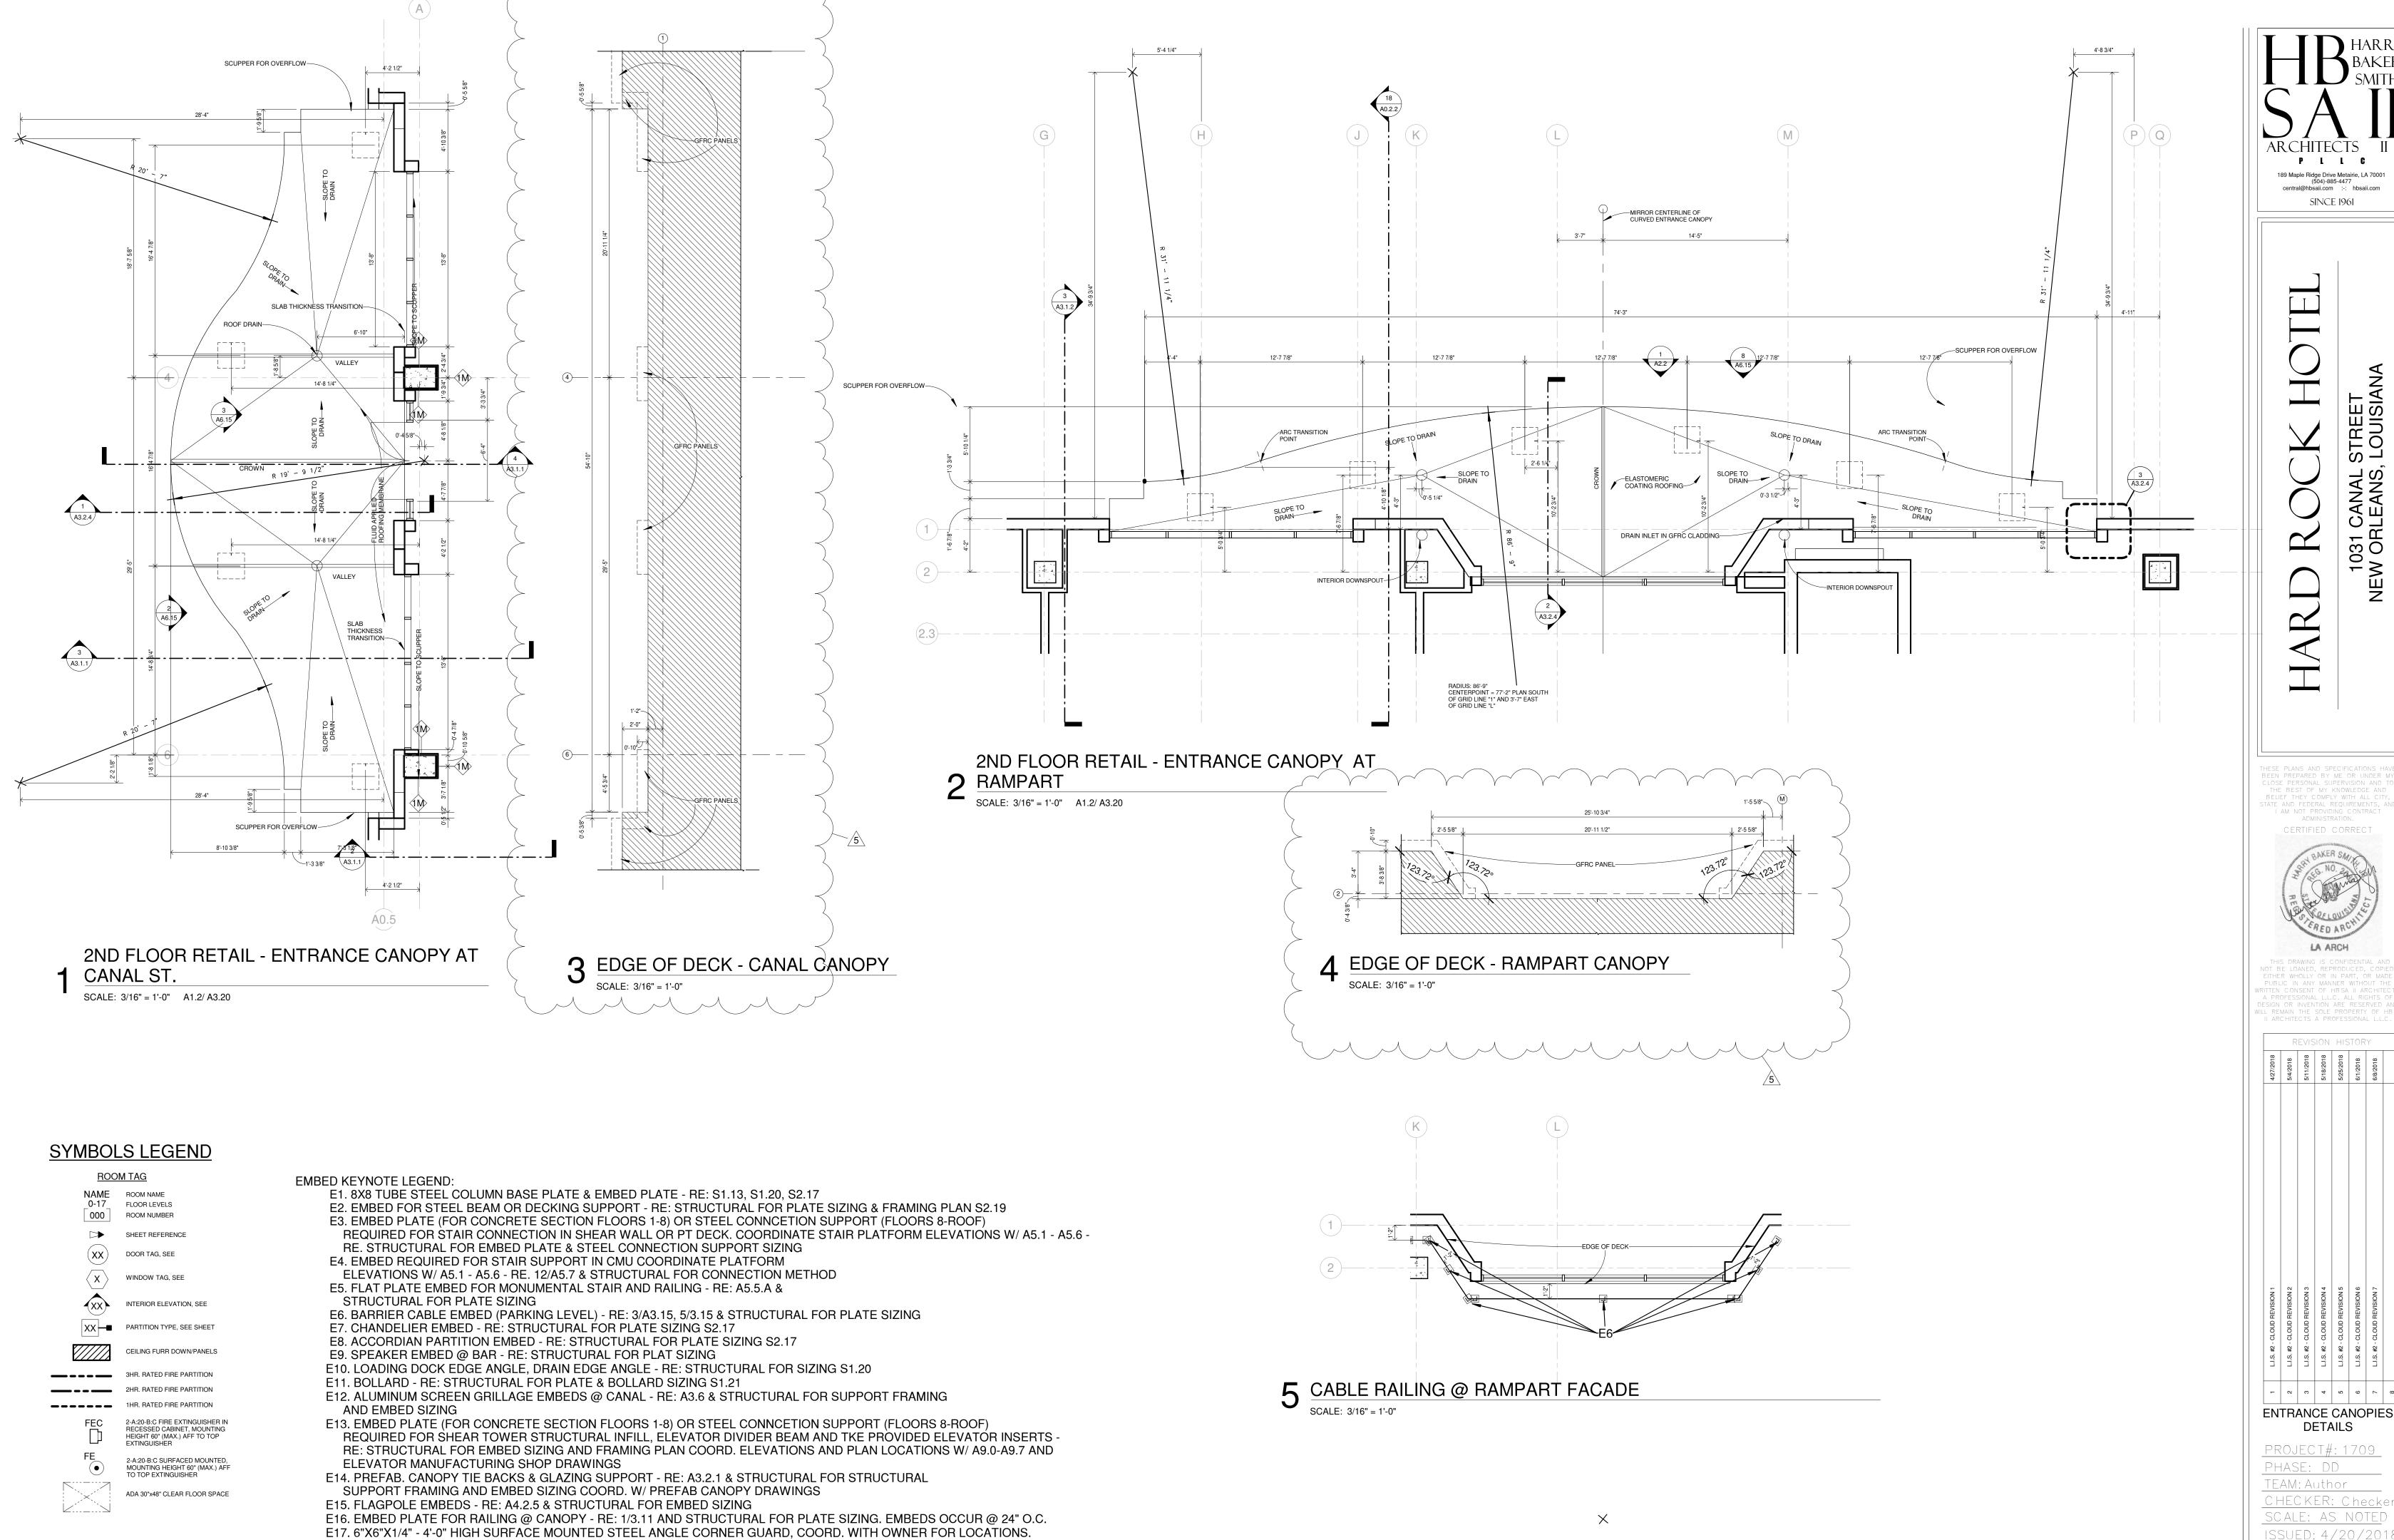


189 Maple Ridge Drive Metairie, LA 70001 (504)-885-4477 central@hbsaii.com :-: hbsaii.com

SINCE 1961


CERTIFIED CORREC

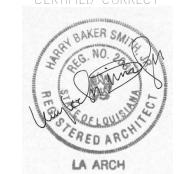

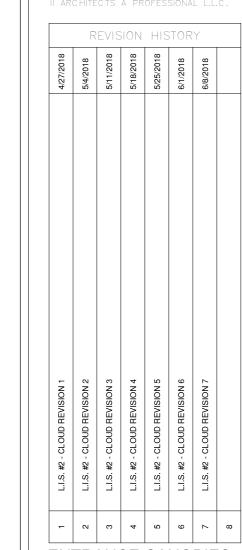

**DETAILS** PROJECT#: 1709 PHASE: DD

TFAM: Author CHECKER: Checker SCALE: AS NOTED ISSUED: 4/20/2018

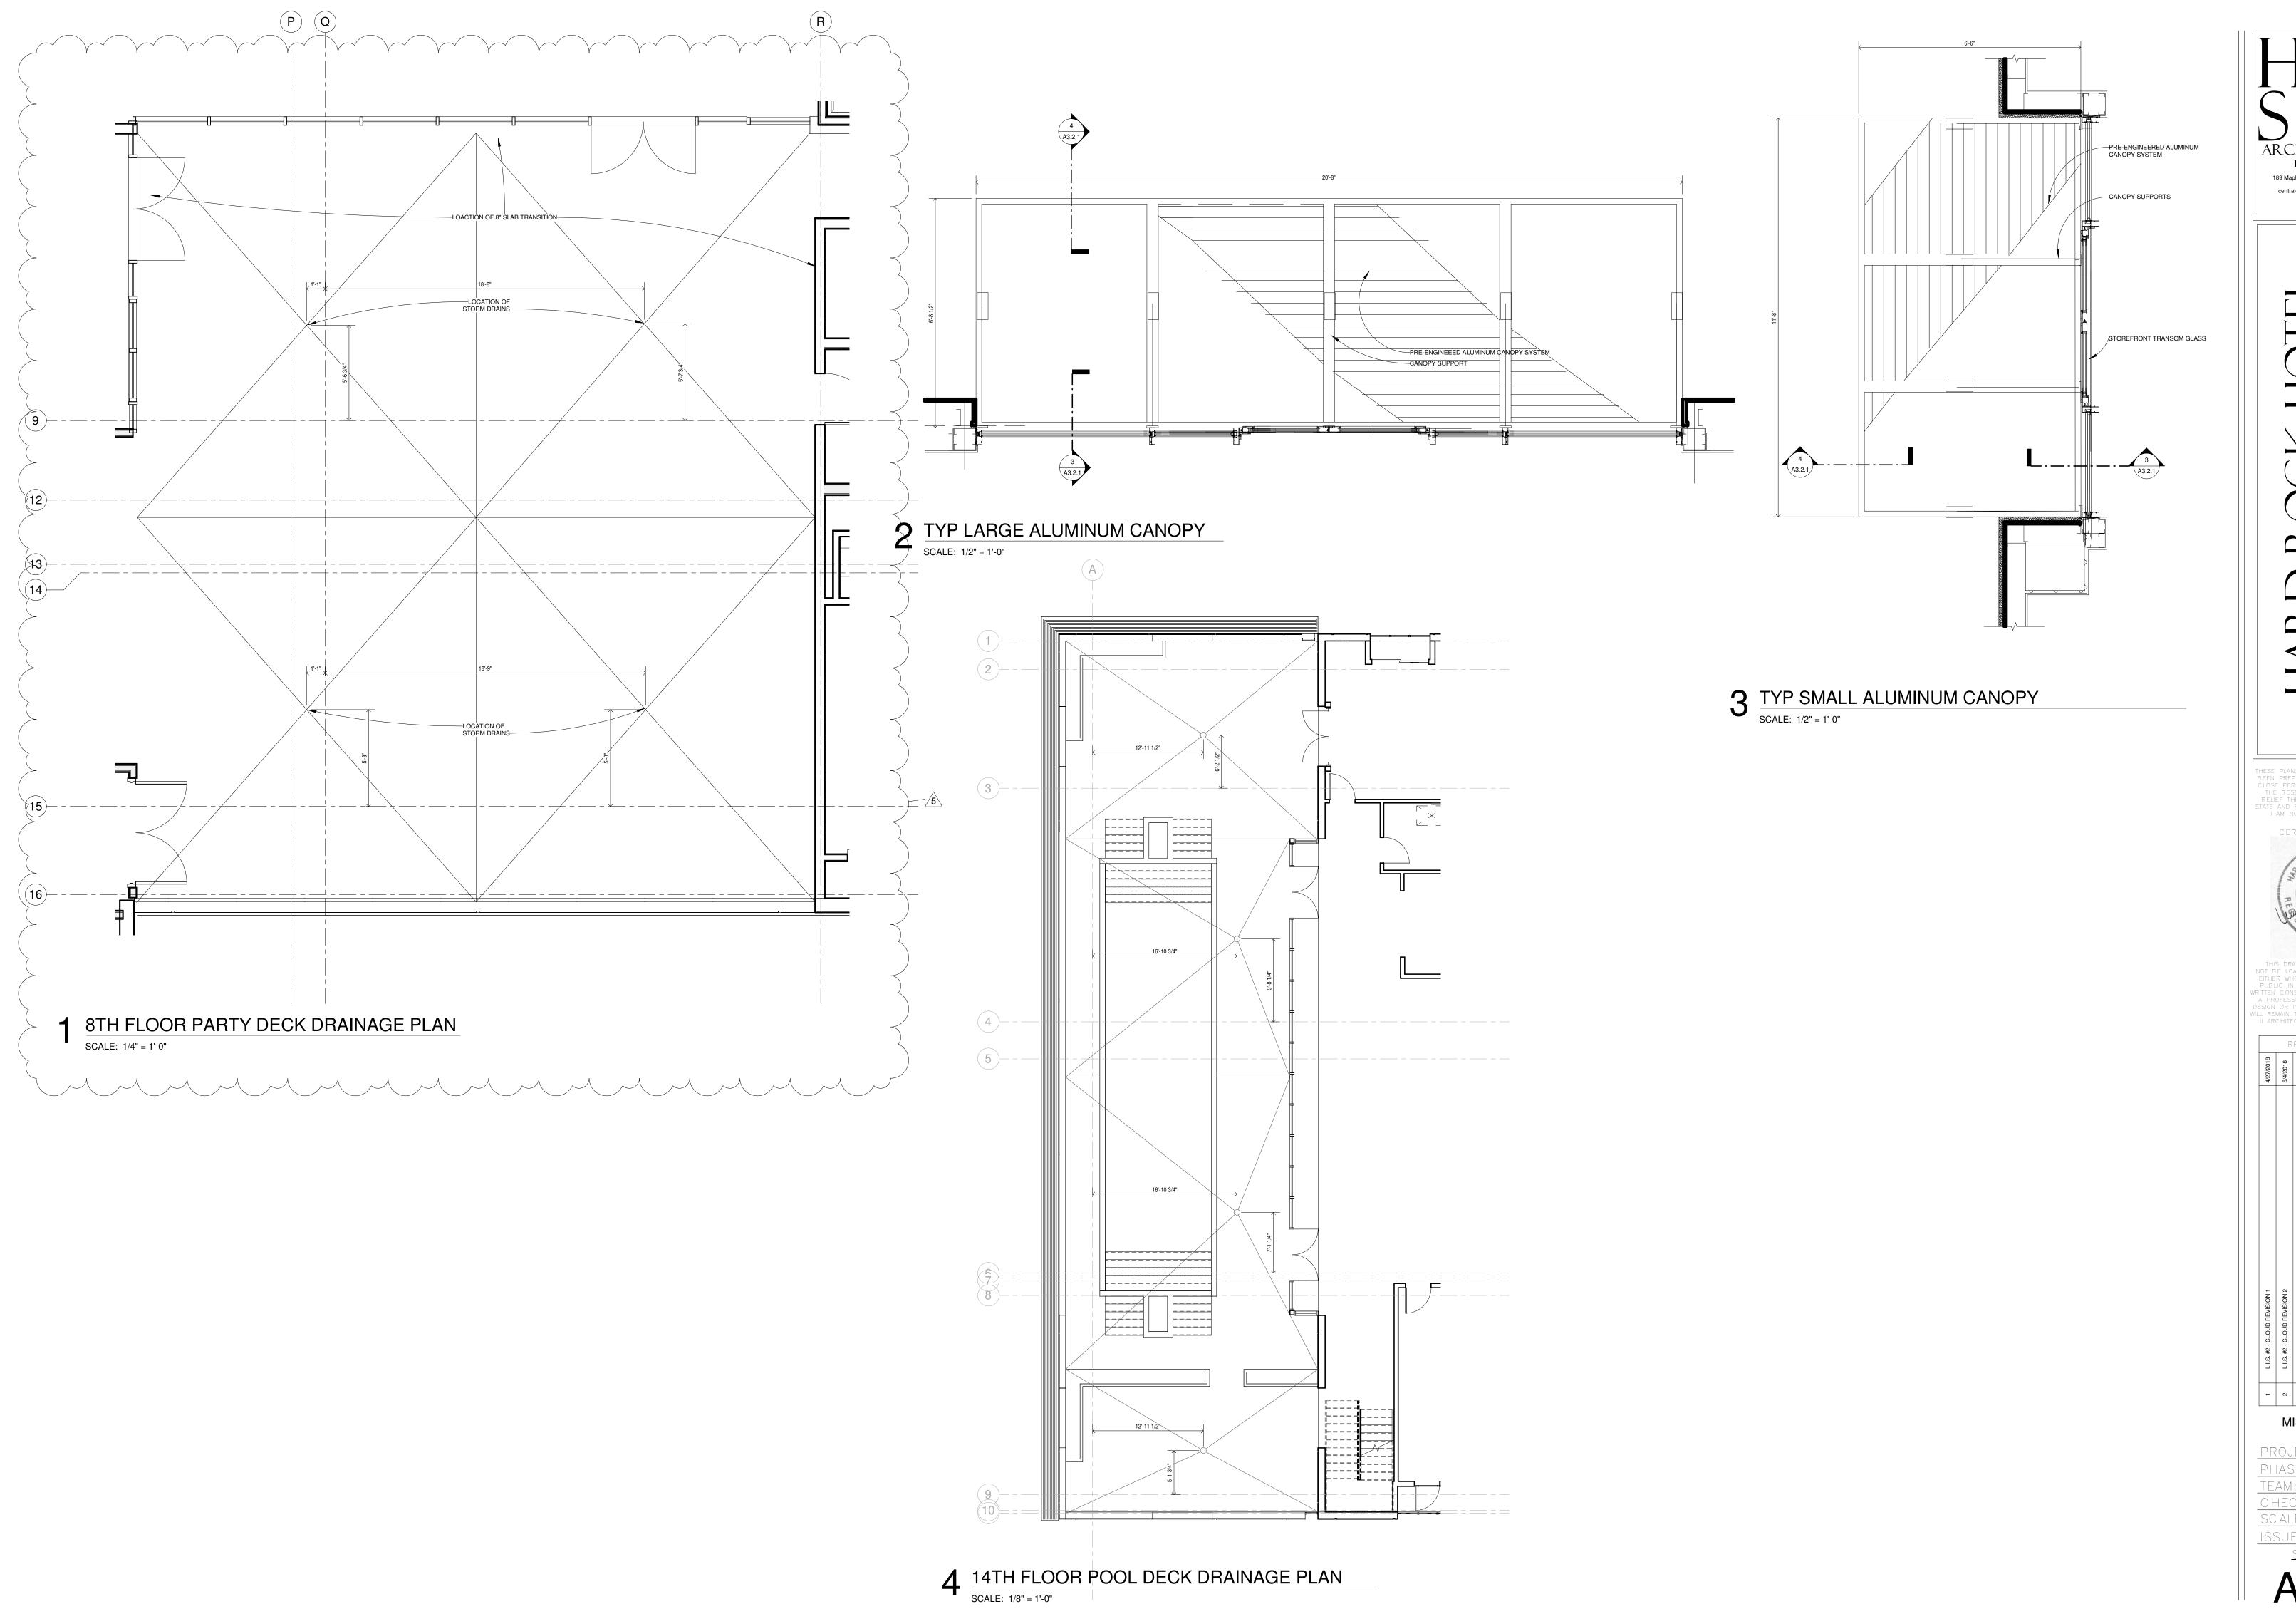

HARRY
BAKER
SMITH
SMITH
ARCHITECTS II
P L C

189 Maple Ridge Drive Metairie, LA 70001
(504)-885-4477
central@hbsaii.com :: hbsaii.com
SINCE 1961

HOTEL ET

1031 CANAL STREET
NEW ORI FANS LOUISIANA

THESE PLANS AND SPECIFICATIONS HAVE
BEEN PREPARED BY ME OR UNDER MY
CLOSE PERSONAL SUPERVISION AND TO
THE BEST OF MY KNOWLEDGE AND
BELIEF THEY COMPLY WITH ALL CITY,
STATE AND FEDERAL REQUIREMENTS, AND
I AM NOT PROVIDING CONTRACT
ADMINISTRATION.

CERTIFIED CORRECT




THIS DRAWING IS CONFIDENTIAL AND NOT BE LOANED, REPRODUCED, COPIED, EITHER WHOLLY OR IN PART, OR MADE PUBLIC IN ANY MANNER WITHOUT THE WRITTEN CONSENT OF HBSA II ARCHITECTS A PROFESSIONAL L.L.C. ALL RIGHTS OF DESIGN OR INVENTION ARE RESERVED AND WILL REMAIN THE SOLE PROPERTY OF HBSA


| II AR                        | CHITE                        | CTS                          | A PR                         | OFES:                        | SIONA                        | L L.L                        | .C . |
|------------------------------|------------------------------|------------------------------|------------------------------|------------------------------|------------------------------|------------------------------|------|
|                              | R                            | EVIS                         | ION                          | HIS                          | TOR                          | Υ                            |      |
| 4/27/2018                    | 5/4/2018                     | 5/11/2018                    | 5/18/2018                    | 5/25/2018                    | 6/1/2018                     | 6/8/2018                     |      |
| L.I.S. #2 - CLOUD REVISION 1 | L.I.S. #2 - CLOUD REVISION 2 | L.I.S. #2 - CLOUD REVISION 3 | L.I.S. #2 - CLOUD REVISION 4 | L.I.S. #2 - CLOUD REVISION 5 | L.I.S. #2 - CLOUD REVISION 6 | L.I.S. #2 - CLOUD REVISION 7 |      |


MISC DETAILS


PROJECT#: 1709
PHASE: DD
TEAM: Author
CHECKER: Checker
SCALE: AS NOTED
ISSUED: 4/20/2018

A3.21

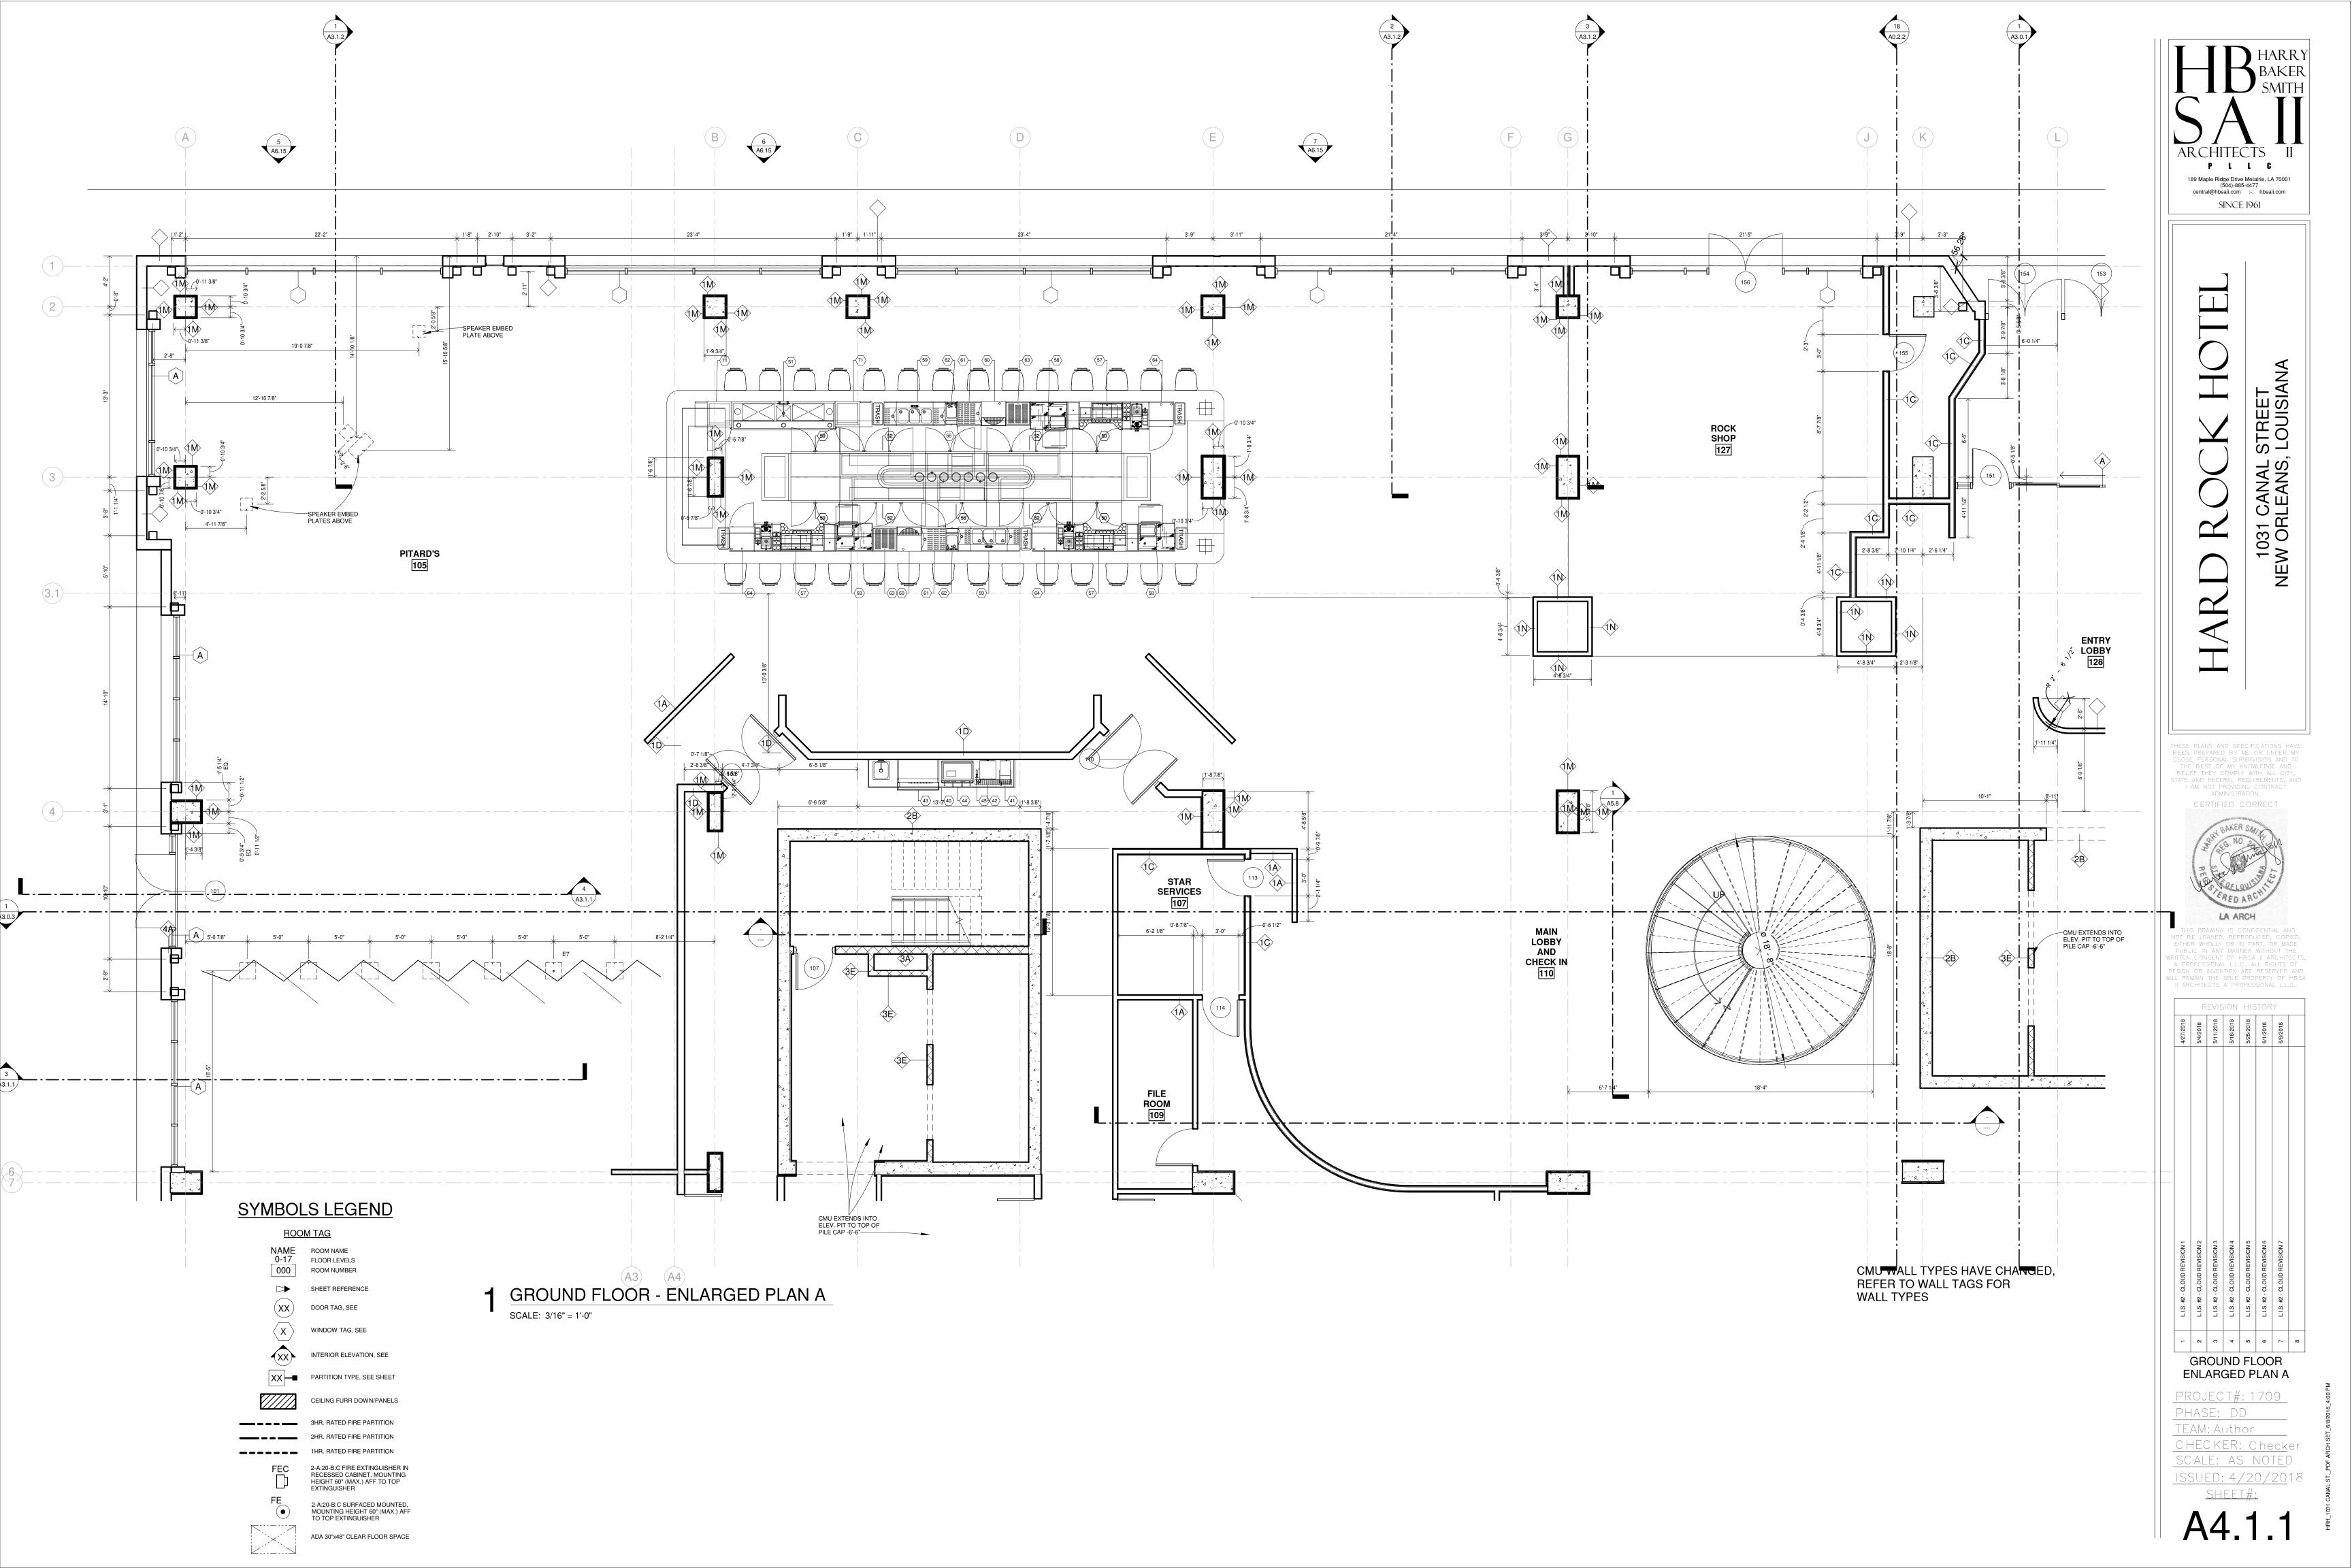

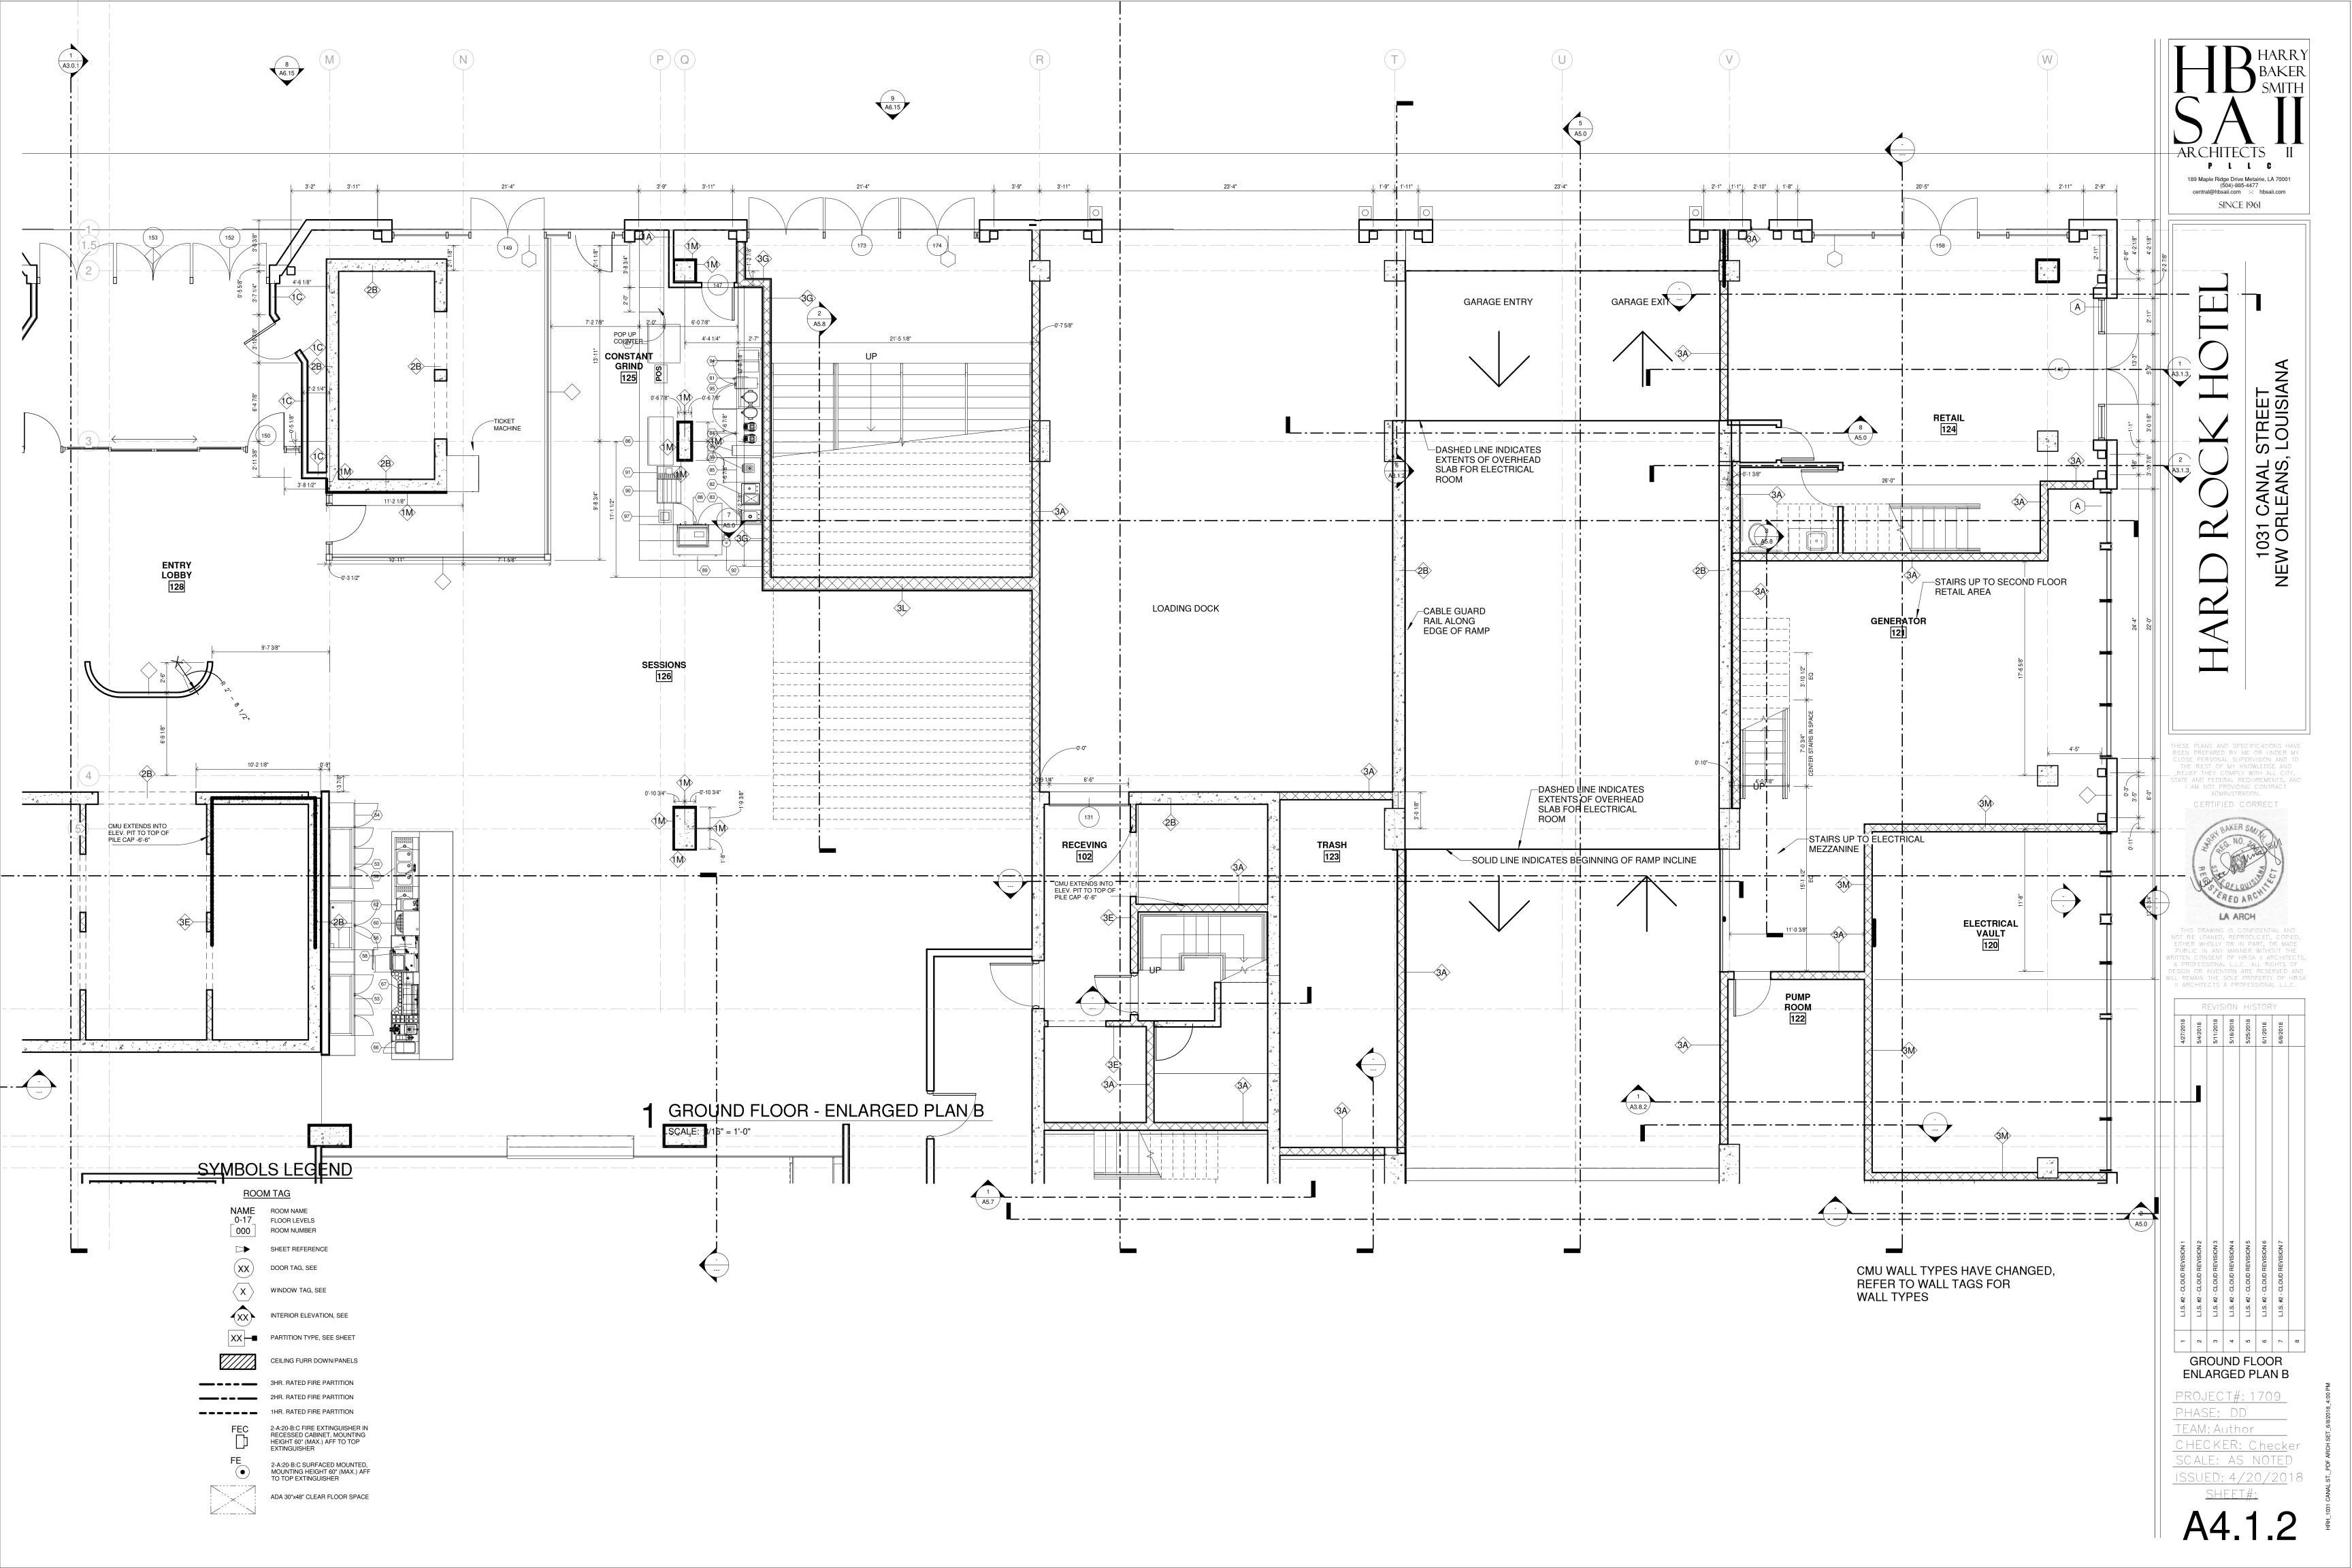

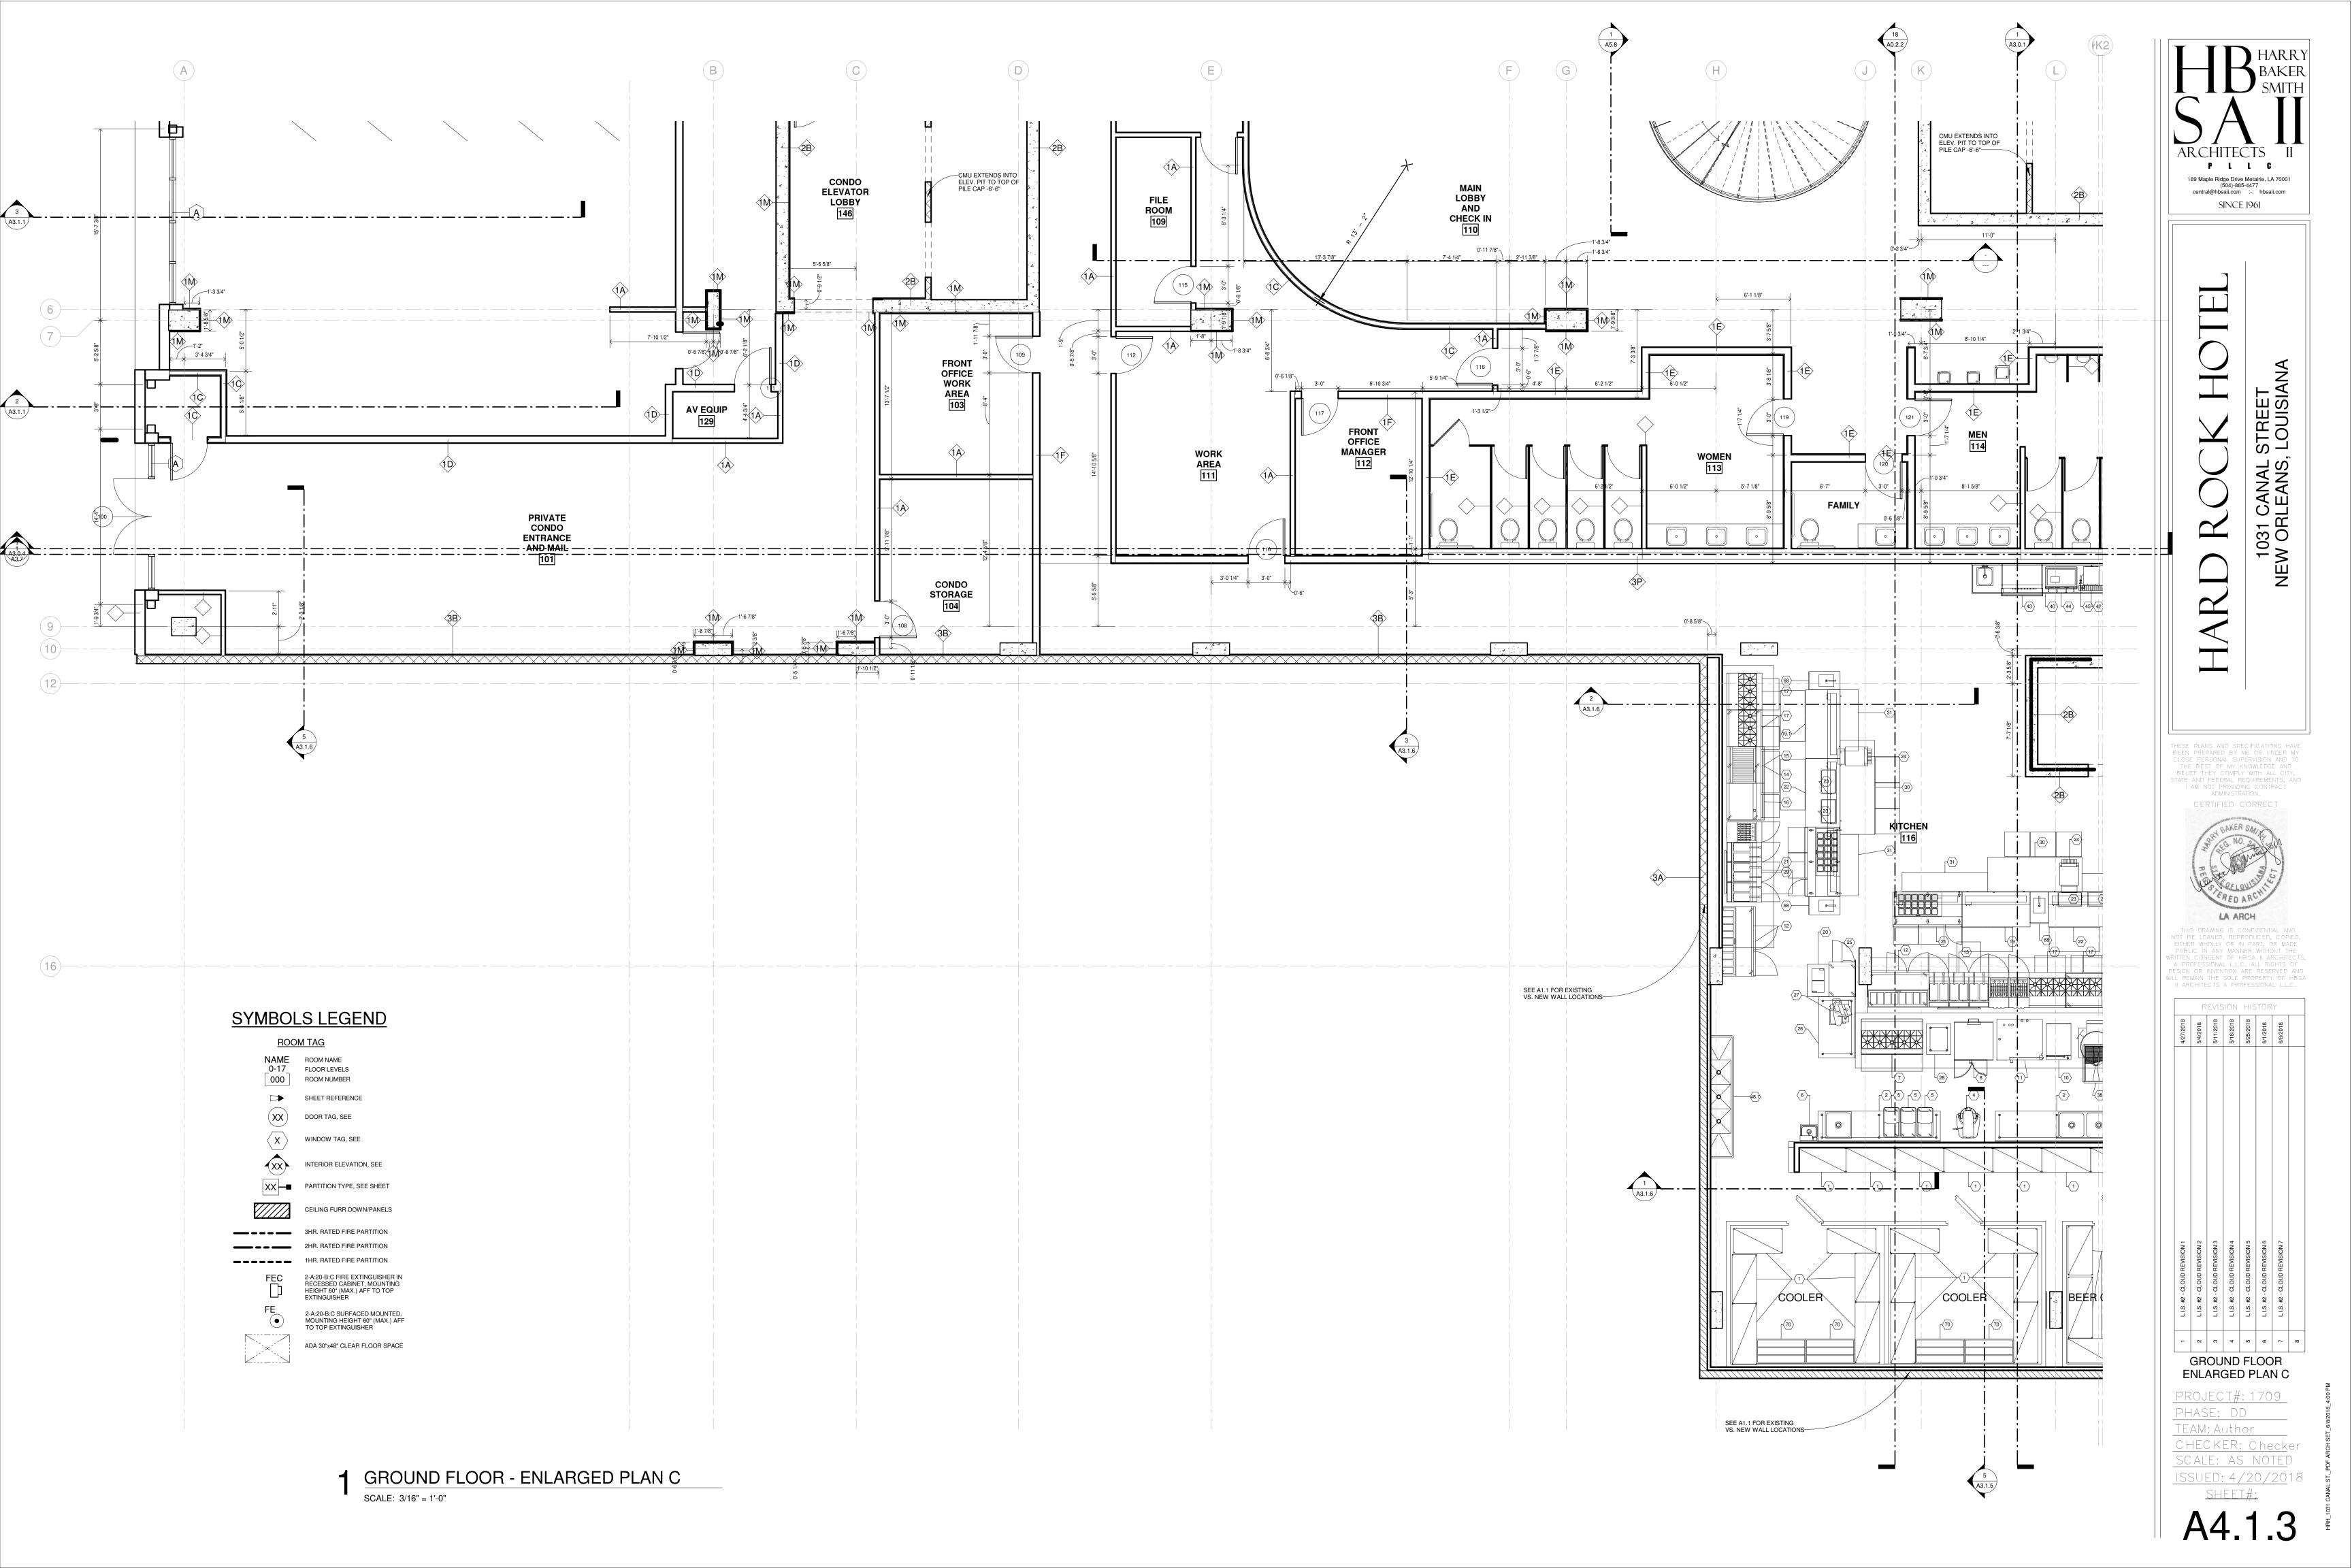

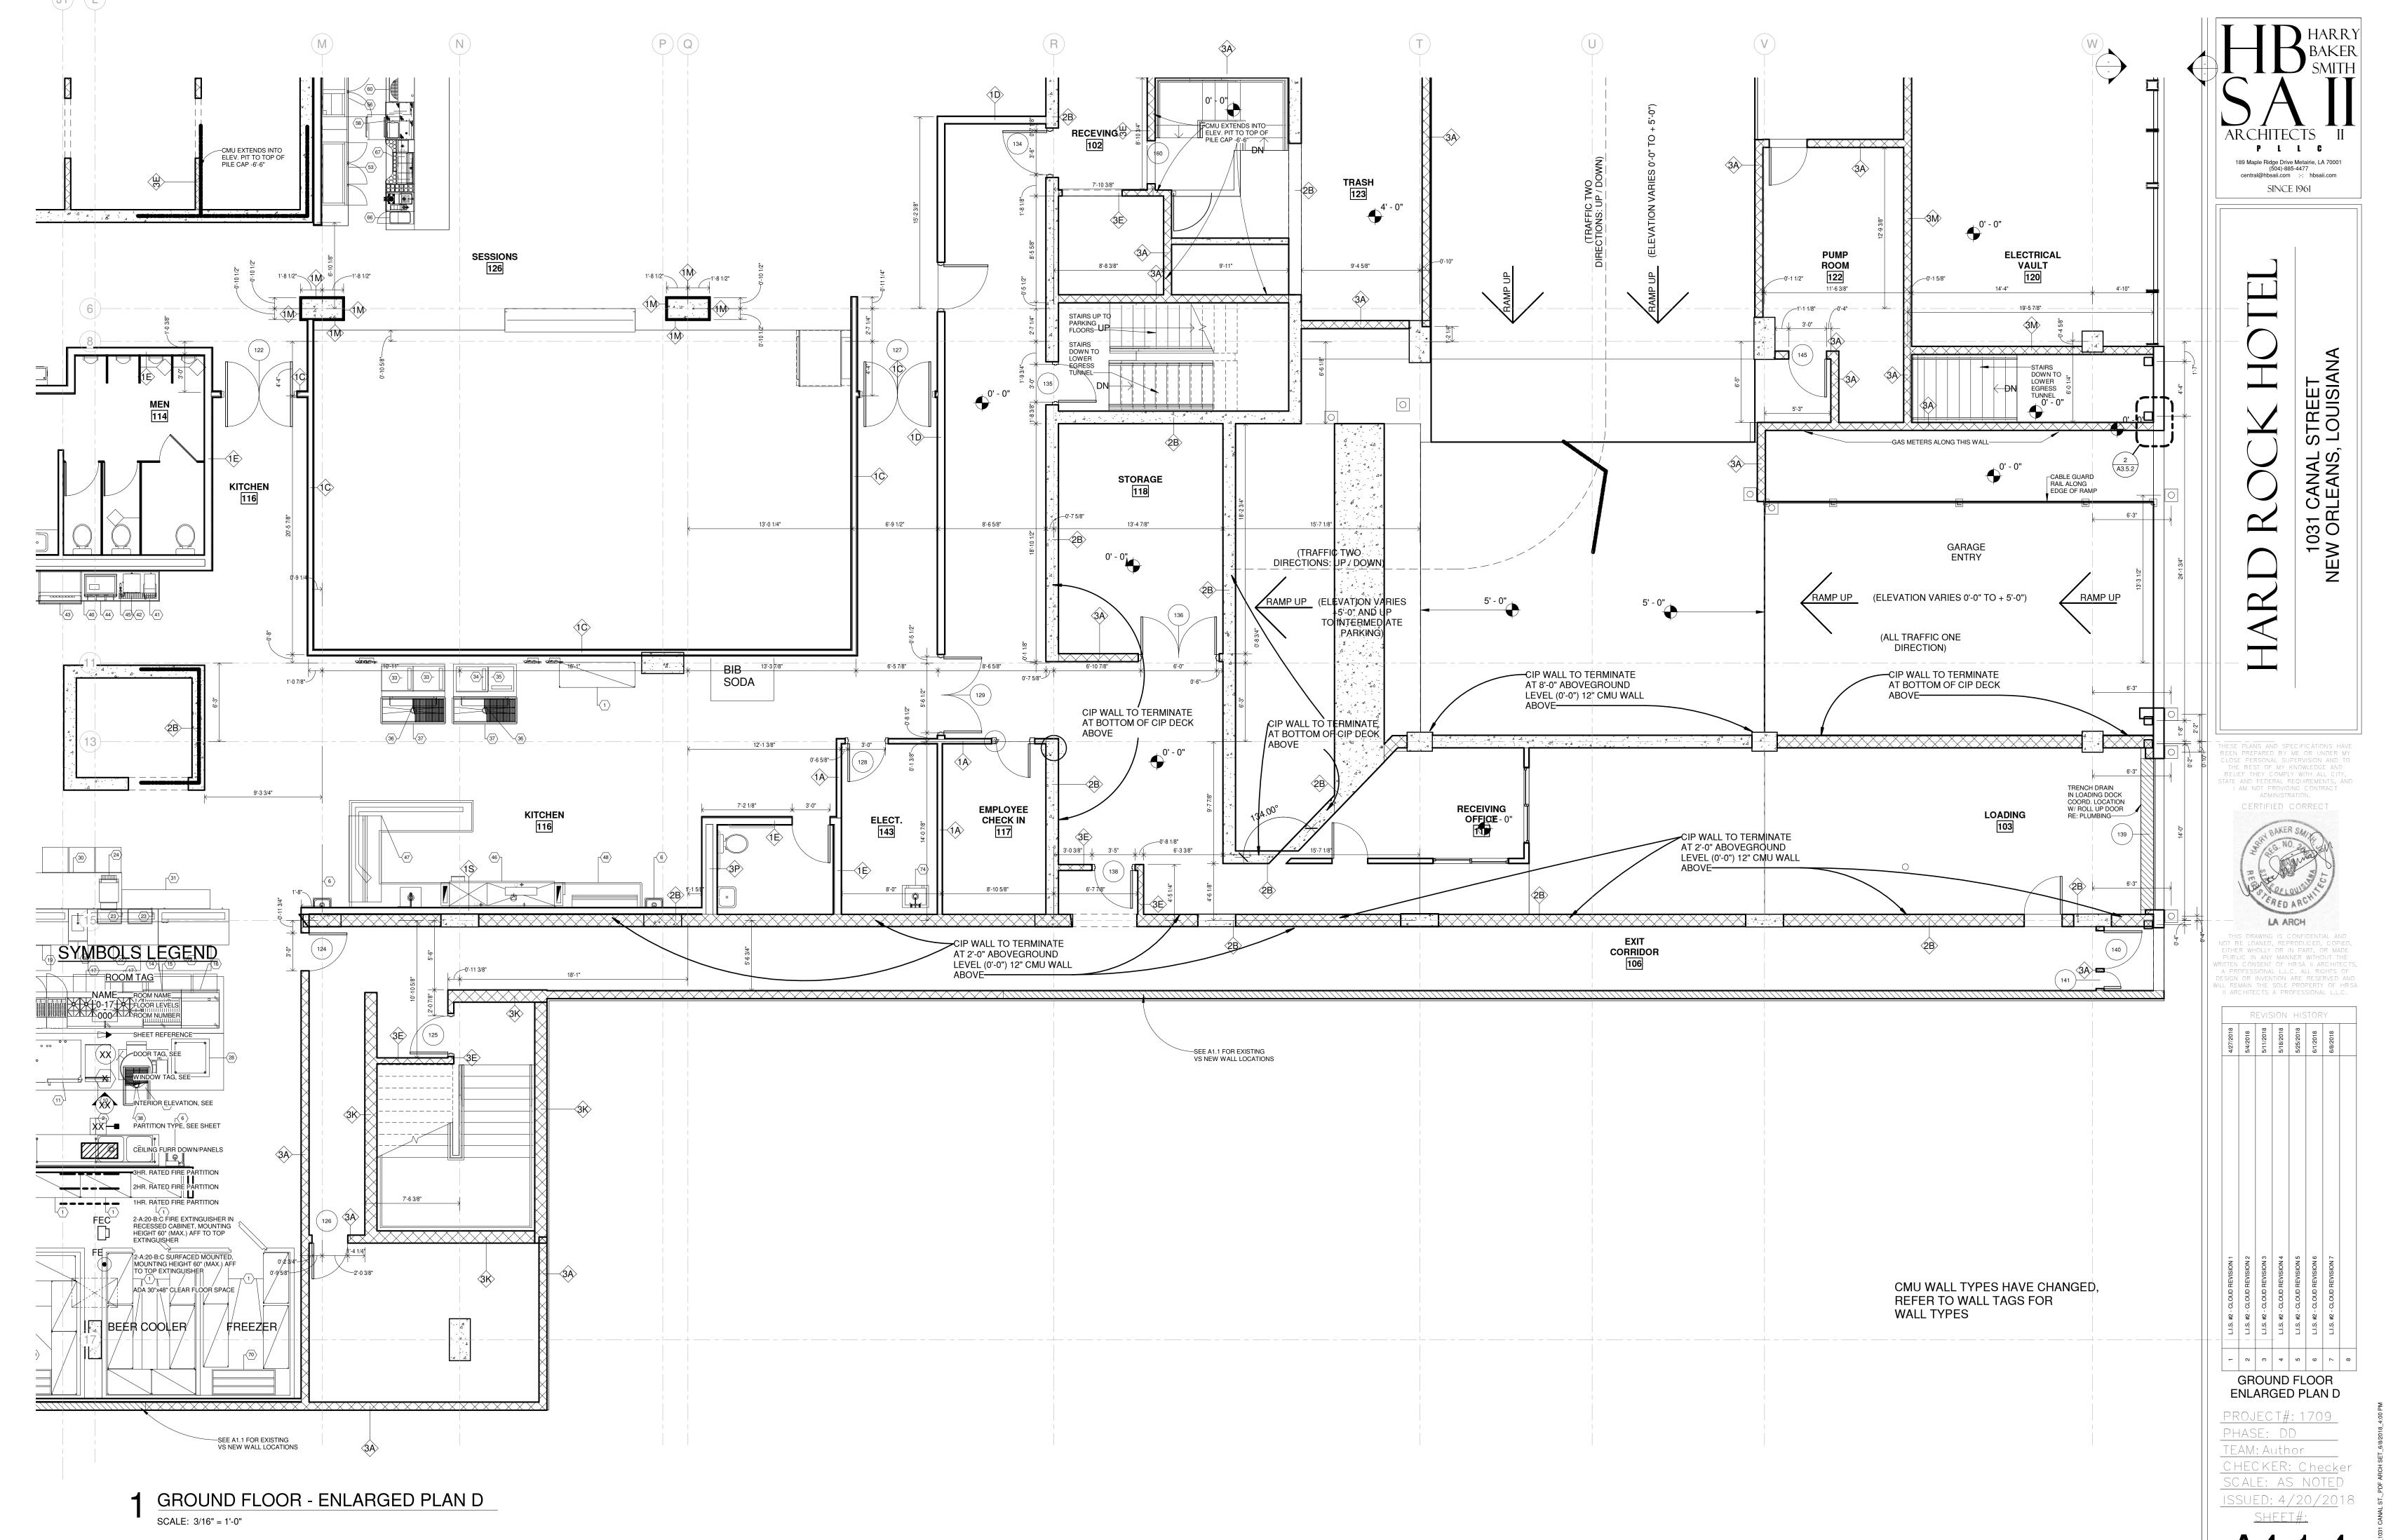

A4.1.4

1 INTERMEDIATE PARKING ENLARGED PLAN A

SCALE: 1/8" = 1'-0"

HARRY
BAKER
SMITH
SMITH
ARCHITECTS II
P L C

189 Maple Ridge Drive Metairie, LA 70001
(504)-885-4477
central@hbsaii.com :: hbsaii.com
SINCE 1961

HARD ROCK HOTEI

1031 CANAL STREET

NEW ORLEANS, LOUISIANA

THESE PLANS AND SPECIFICATIONS HAVE BEEN PREPARED BY ME OR UNDER MY CLOSE PERSONAL SUPERVISION AND TO THE BEST OF MY KNOWLEDGE AND BELIEF THEY COMPLY WITH ALL CITY, STATE AND FEDERAL REQUIREMENTS, AND I AM NOT PROVIDING CONTRACT ADMINISTRATION.

CERTIFIED CORRECT



THIS DRAWING IS CONFIDENTIAL AND NOT BE LOANED, REPRODUCED, COPIED, EITHER WHOLLY OR IN PART, OR MADE PUBLIC IN ANY MANNER WITHOUT THE WRITTEN CONSENT OF HBSA II ARCHITECTS A PROFESSIONAL L.L.C. ALL RIGHTS OF DESIGN OR INVENTION ARE RESERVED AND WILL REMAIN THE SOLE PROPERTY OF HBS

|                              | R                            | EVIS                         | ION                          | HIS                          | TOR                          | Υ                            |  |
|------------------------------|------------------------------|------------------------------|------------------------------|------------------------------|------------------------------|------------------------------|--|
| 4/27/2018                    | 5/4/2018                     | 5/11/2018                    | 5/18/2018                    | 5/25/2018                    | 6/1/2018                     | 6/8/2018                     |  |
| L.I.S. #2 - CLOUD REVISION 1 | L.I.S. #2 - CLOUD REVISION 2 | L.I.S. #2 - CLOUD REVISION 3 | L.I.S. #2 - CLOUD REVISION 4 | L.I.S. #2 - CLOUD REVISION 5 | L.I.S. #2 - CLOUD REVISION 6 | L.I.S. #2 - CLOUD REVISION 7 |  |

INTERMEDIATE PARKING ENLARGED PLAN A

PROJECT#: 1709
PHASE: DD
TEAM: Author

CHECKER: Checker SCALE: AS NOTED ISSUED: 4/20/2018

A4.1.5

INTERMEDIATE PARKING ENLARGED PLAN B

SCALE: 1/8" = 1'-0"

HARRY
BAKER
SMITH
SMITH
ARCHITECTS II
P L C

189 Maple Ridge Drive Metairie, LA 70001
(504)-885-4477
central@hbsaii.com :: hbsaii.com
SINCE 1961

HARD ROCK HOTE

1031 CANAL STREET


NEW ORLEANS, LOUISIANA

THESE PLANS AND SPECIFICATIONS HAVE BEEN PREPARED BY ME OR UNDER MY CLOSE PERSONAL SUPERVISION AND TO THE BEST OF MY KNOWLEDGE AND BELIEF THEY COMPLY WITH ALL CITY, STATE AND FEDERAL REQUIREMENTS, AND I AM NOT PROVIDING CONTRACT ADMINISTRATION.

CERTIFIED CORRECT



THIS DRAWING IS CONFIDENTIAL AND NOT BE LOANED, REPRODUCED, COPIED, EITHER WHOLLY OR IN PART, OR MADE PUBLIC IN ANY MANNER WITHOUT THE WRITTEN CONSENT OF HBSA II ARCHITECTS, A PROFESSIONAL L.L.C. ALL RIGHTS OF DESIGN OR INVENTION ARE RESERVED AND WILL REMAIN THE SOLE PROPERTY OF HBSA II ARCHITECTS A PROFESSIONAL L.L.C.

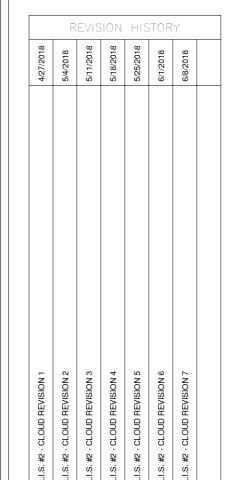



INTERMEDIATE PARKING PLAN B

PROJECT#: 1709


PROJECT#: 1709
PHASE: DD
TEAM: Author
CHECKER: Checker
SCALE: AS NOTED
ISSUED: 4/20/2018


A4.1.6

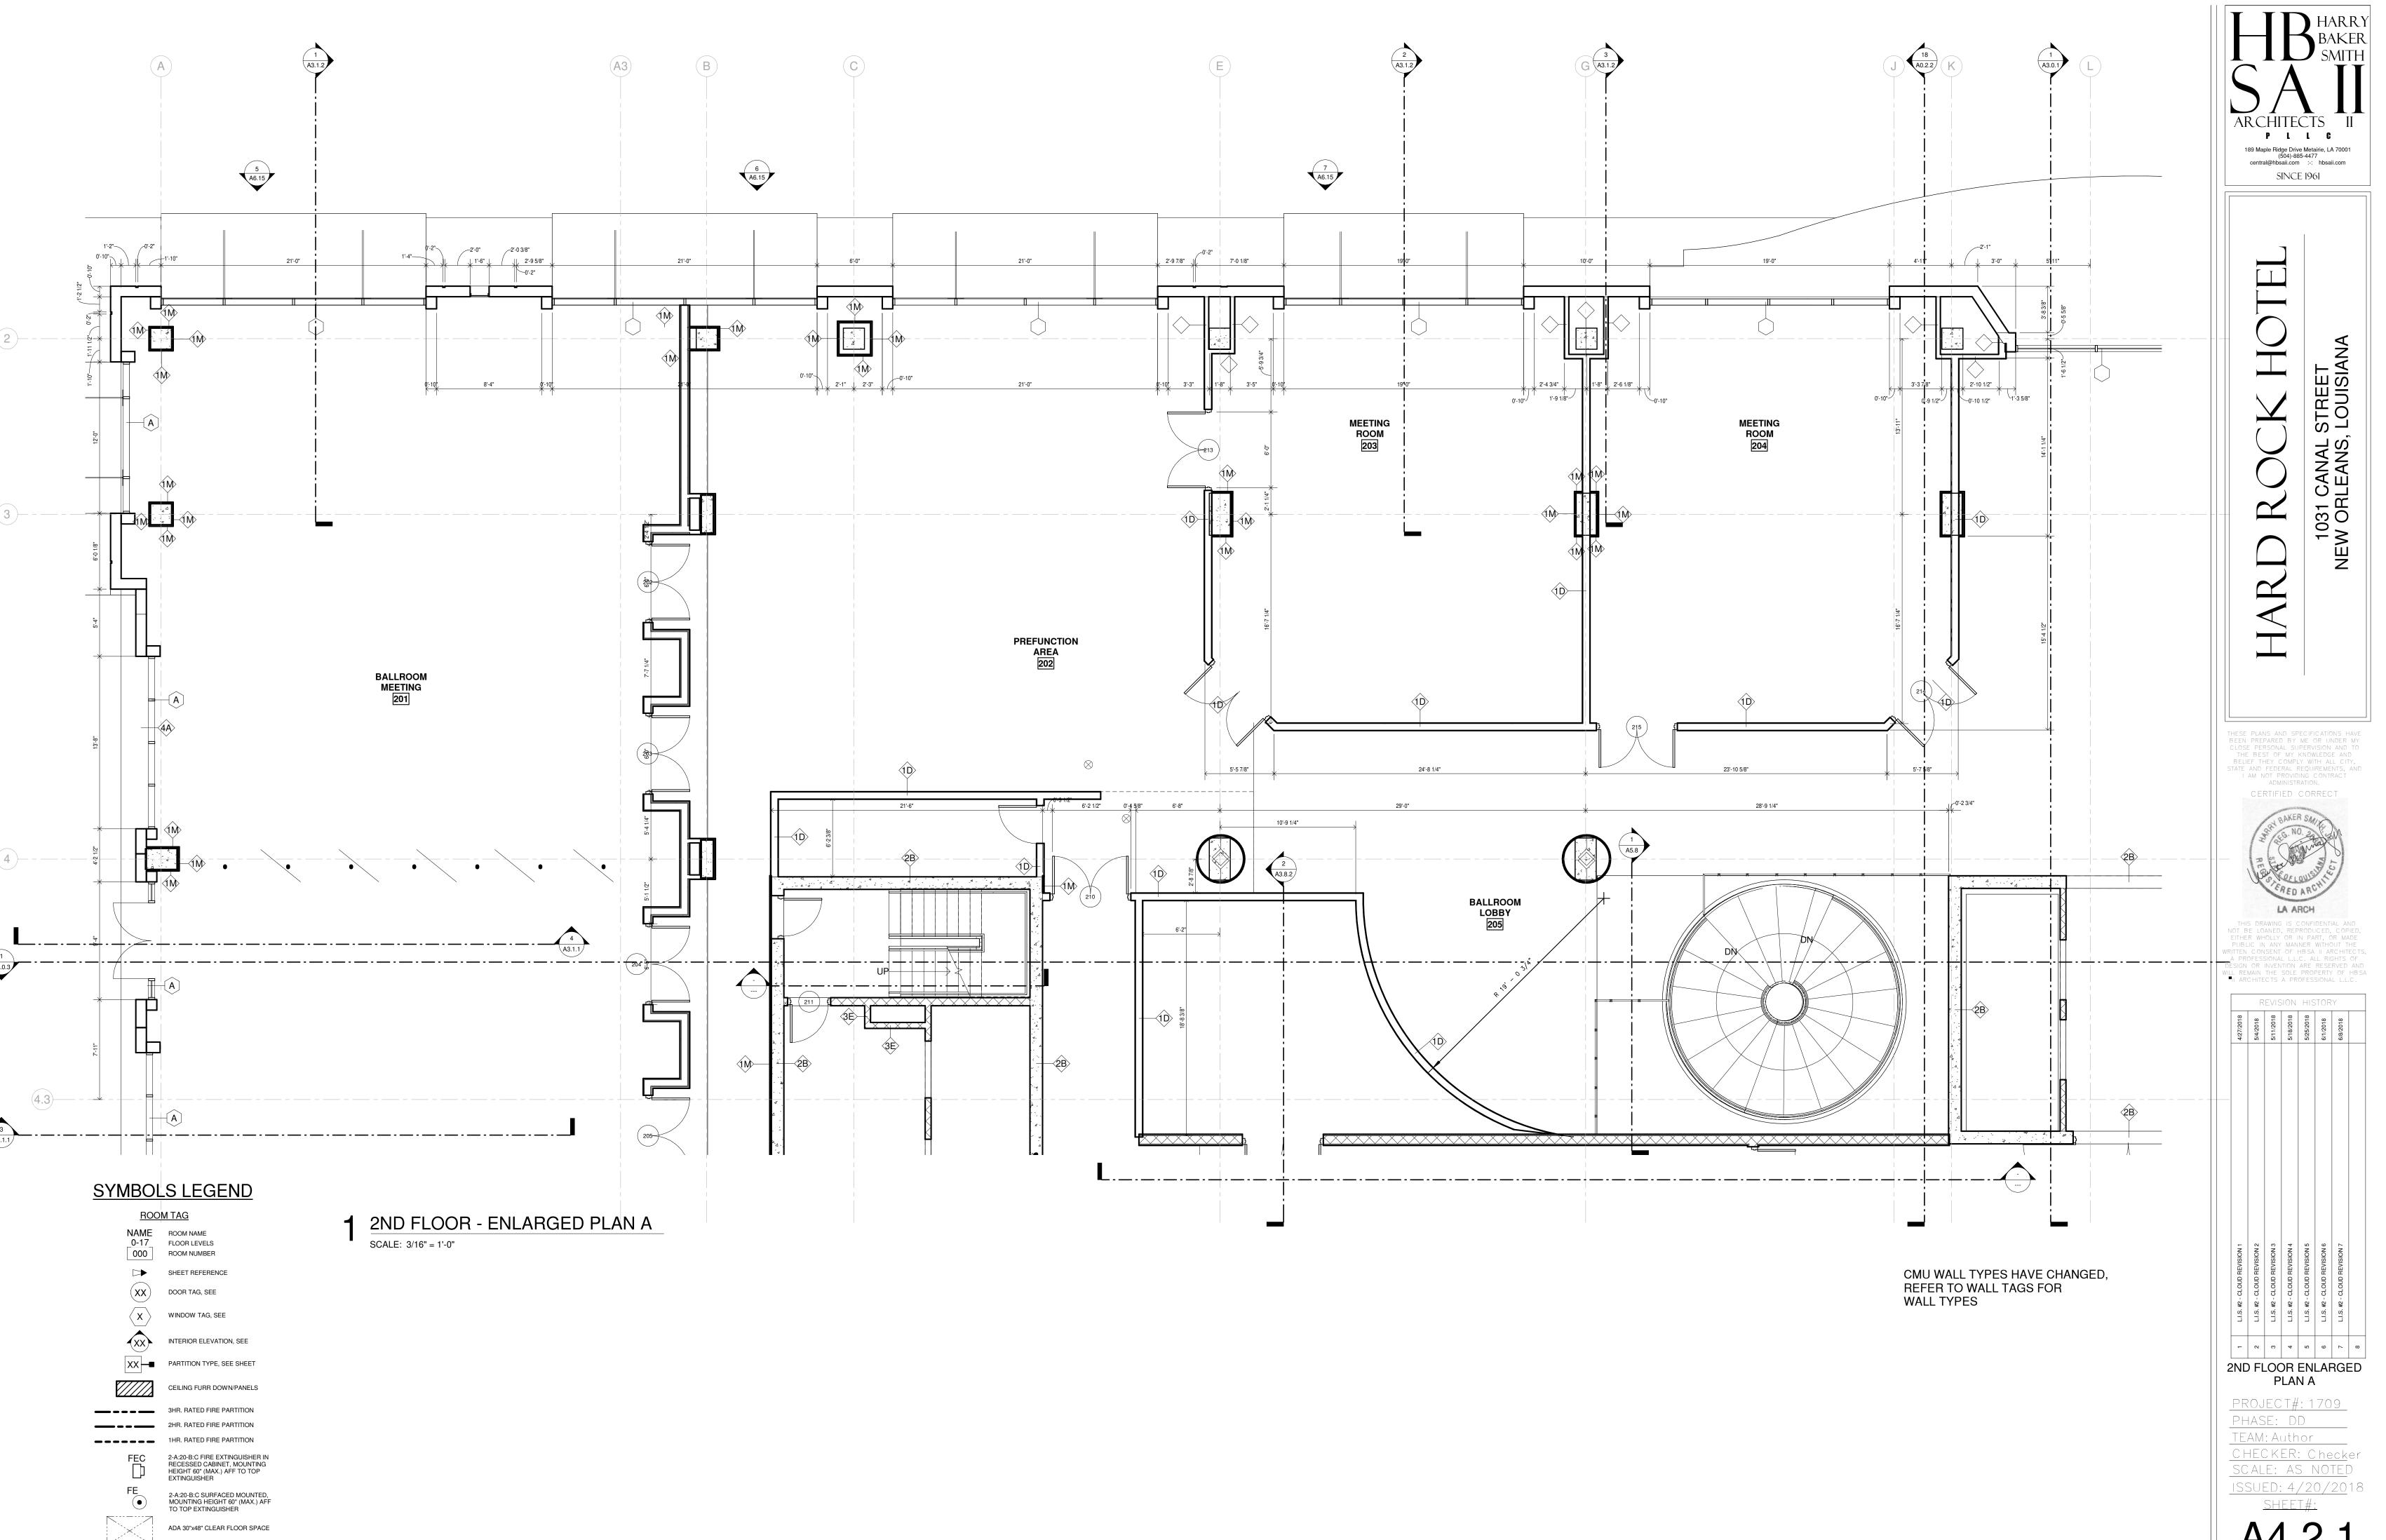


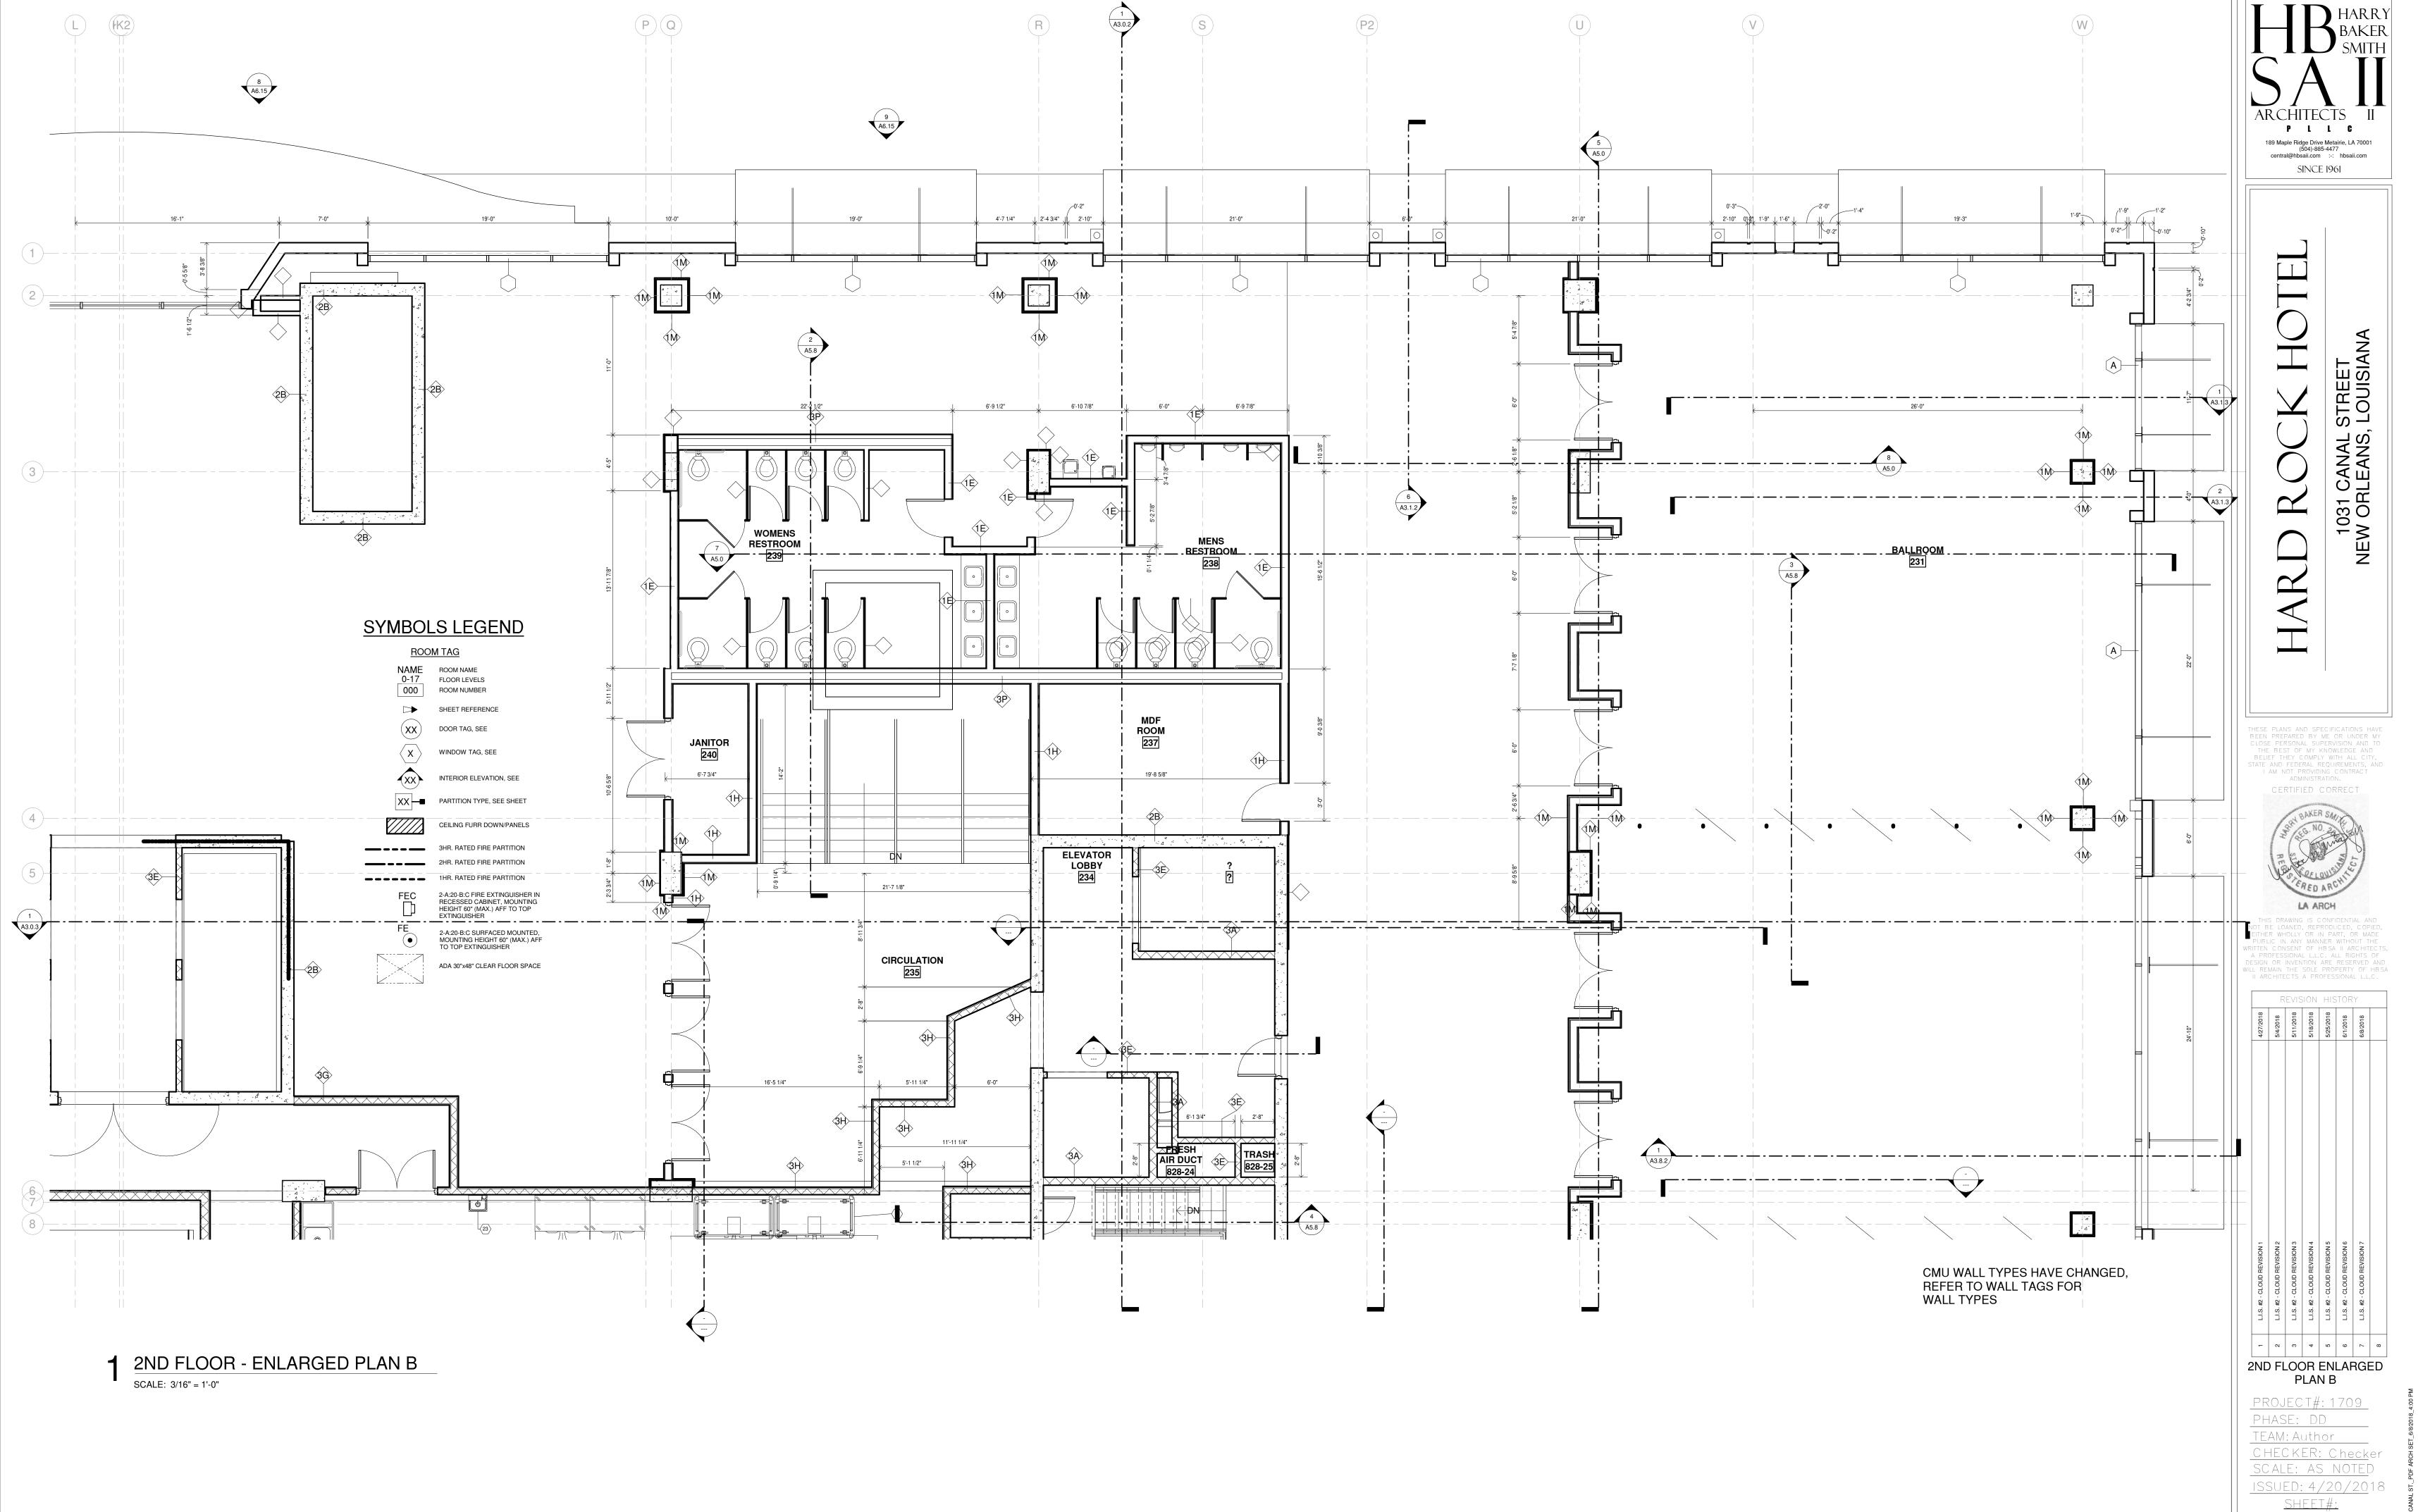

A4 2 2

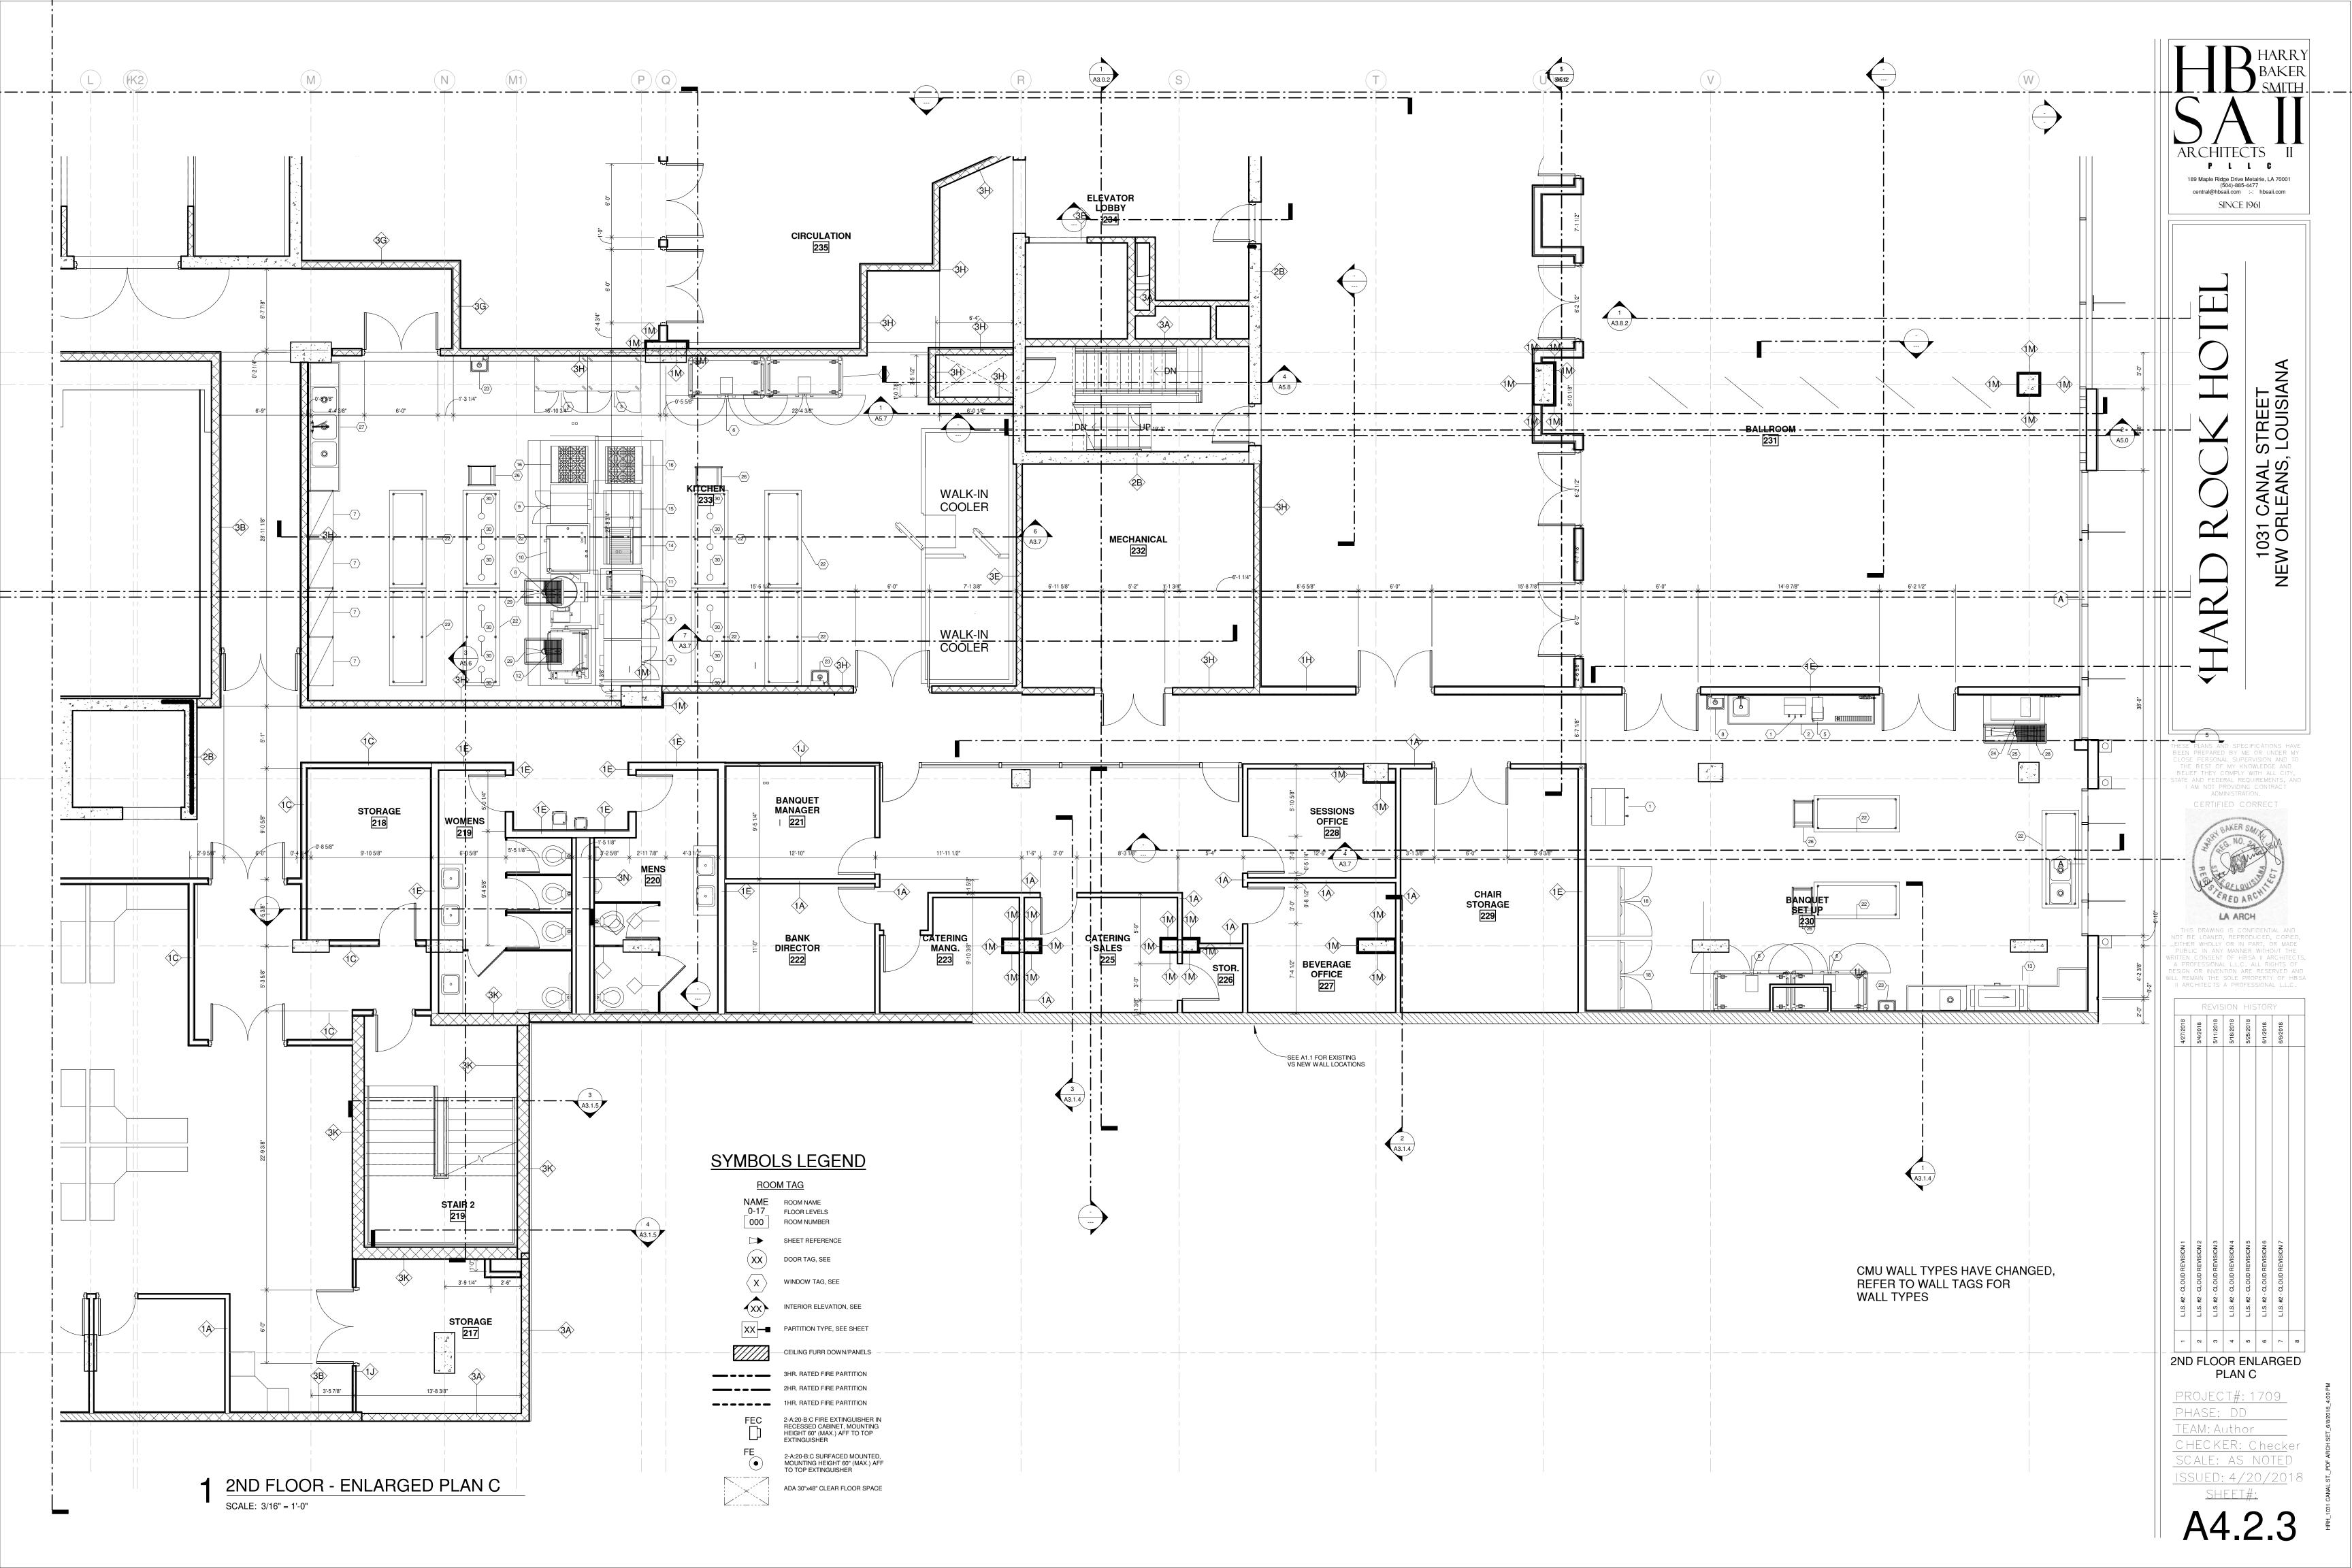

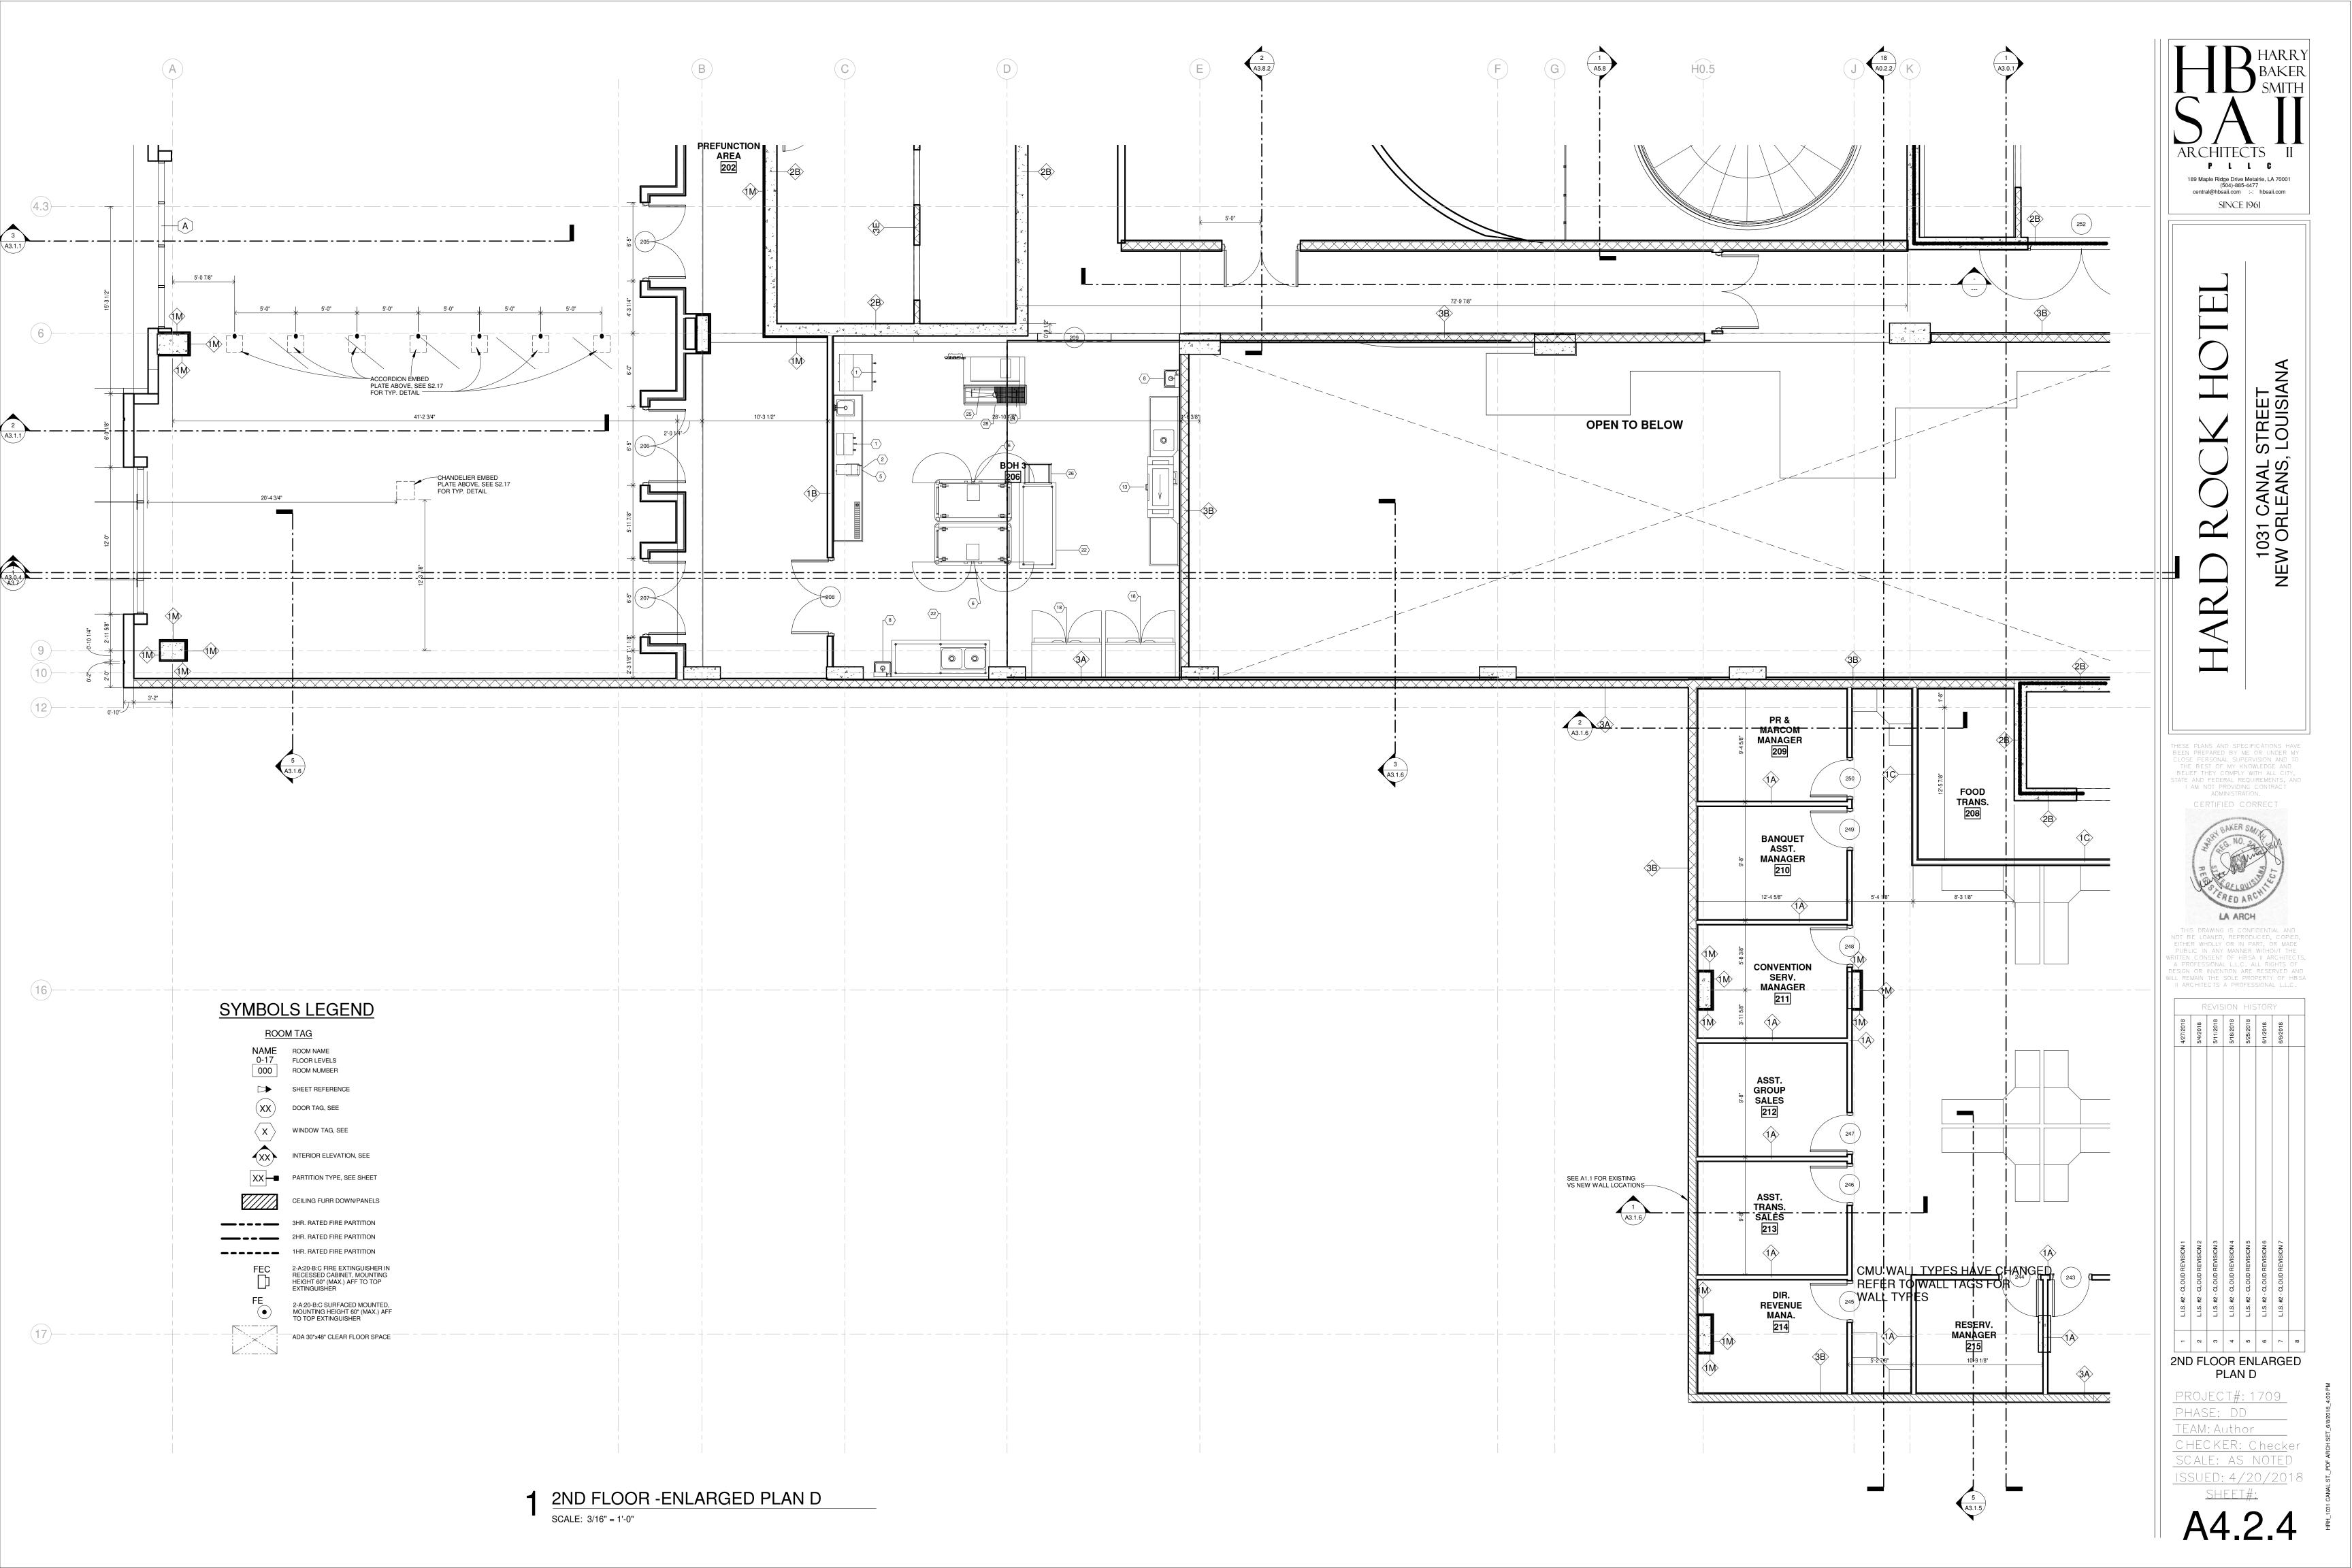

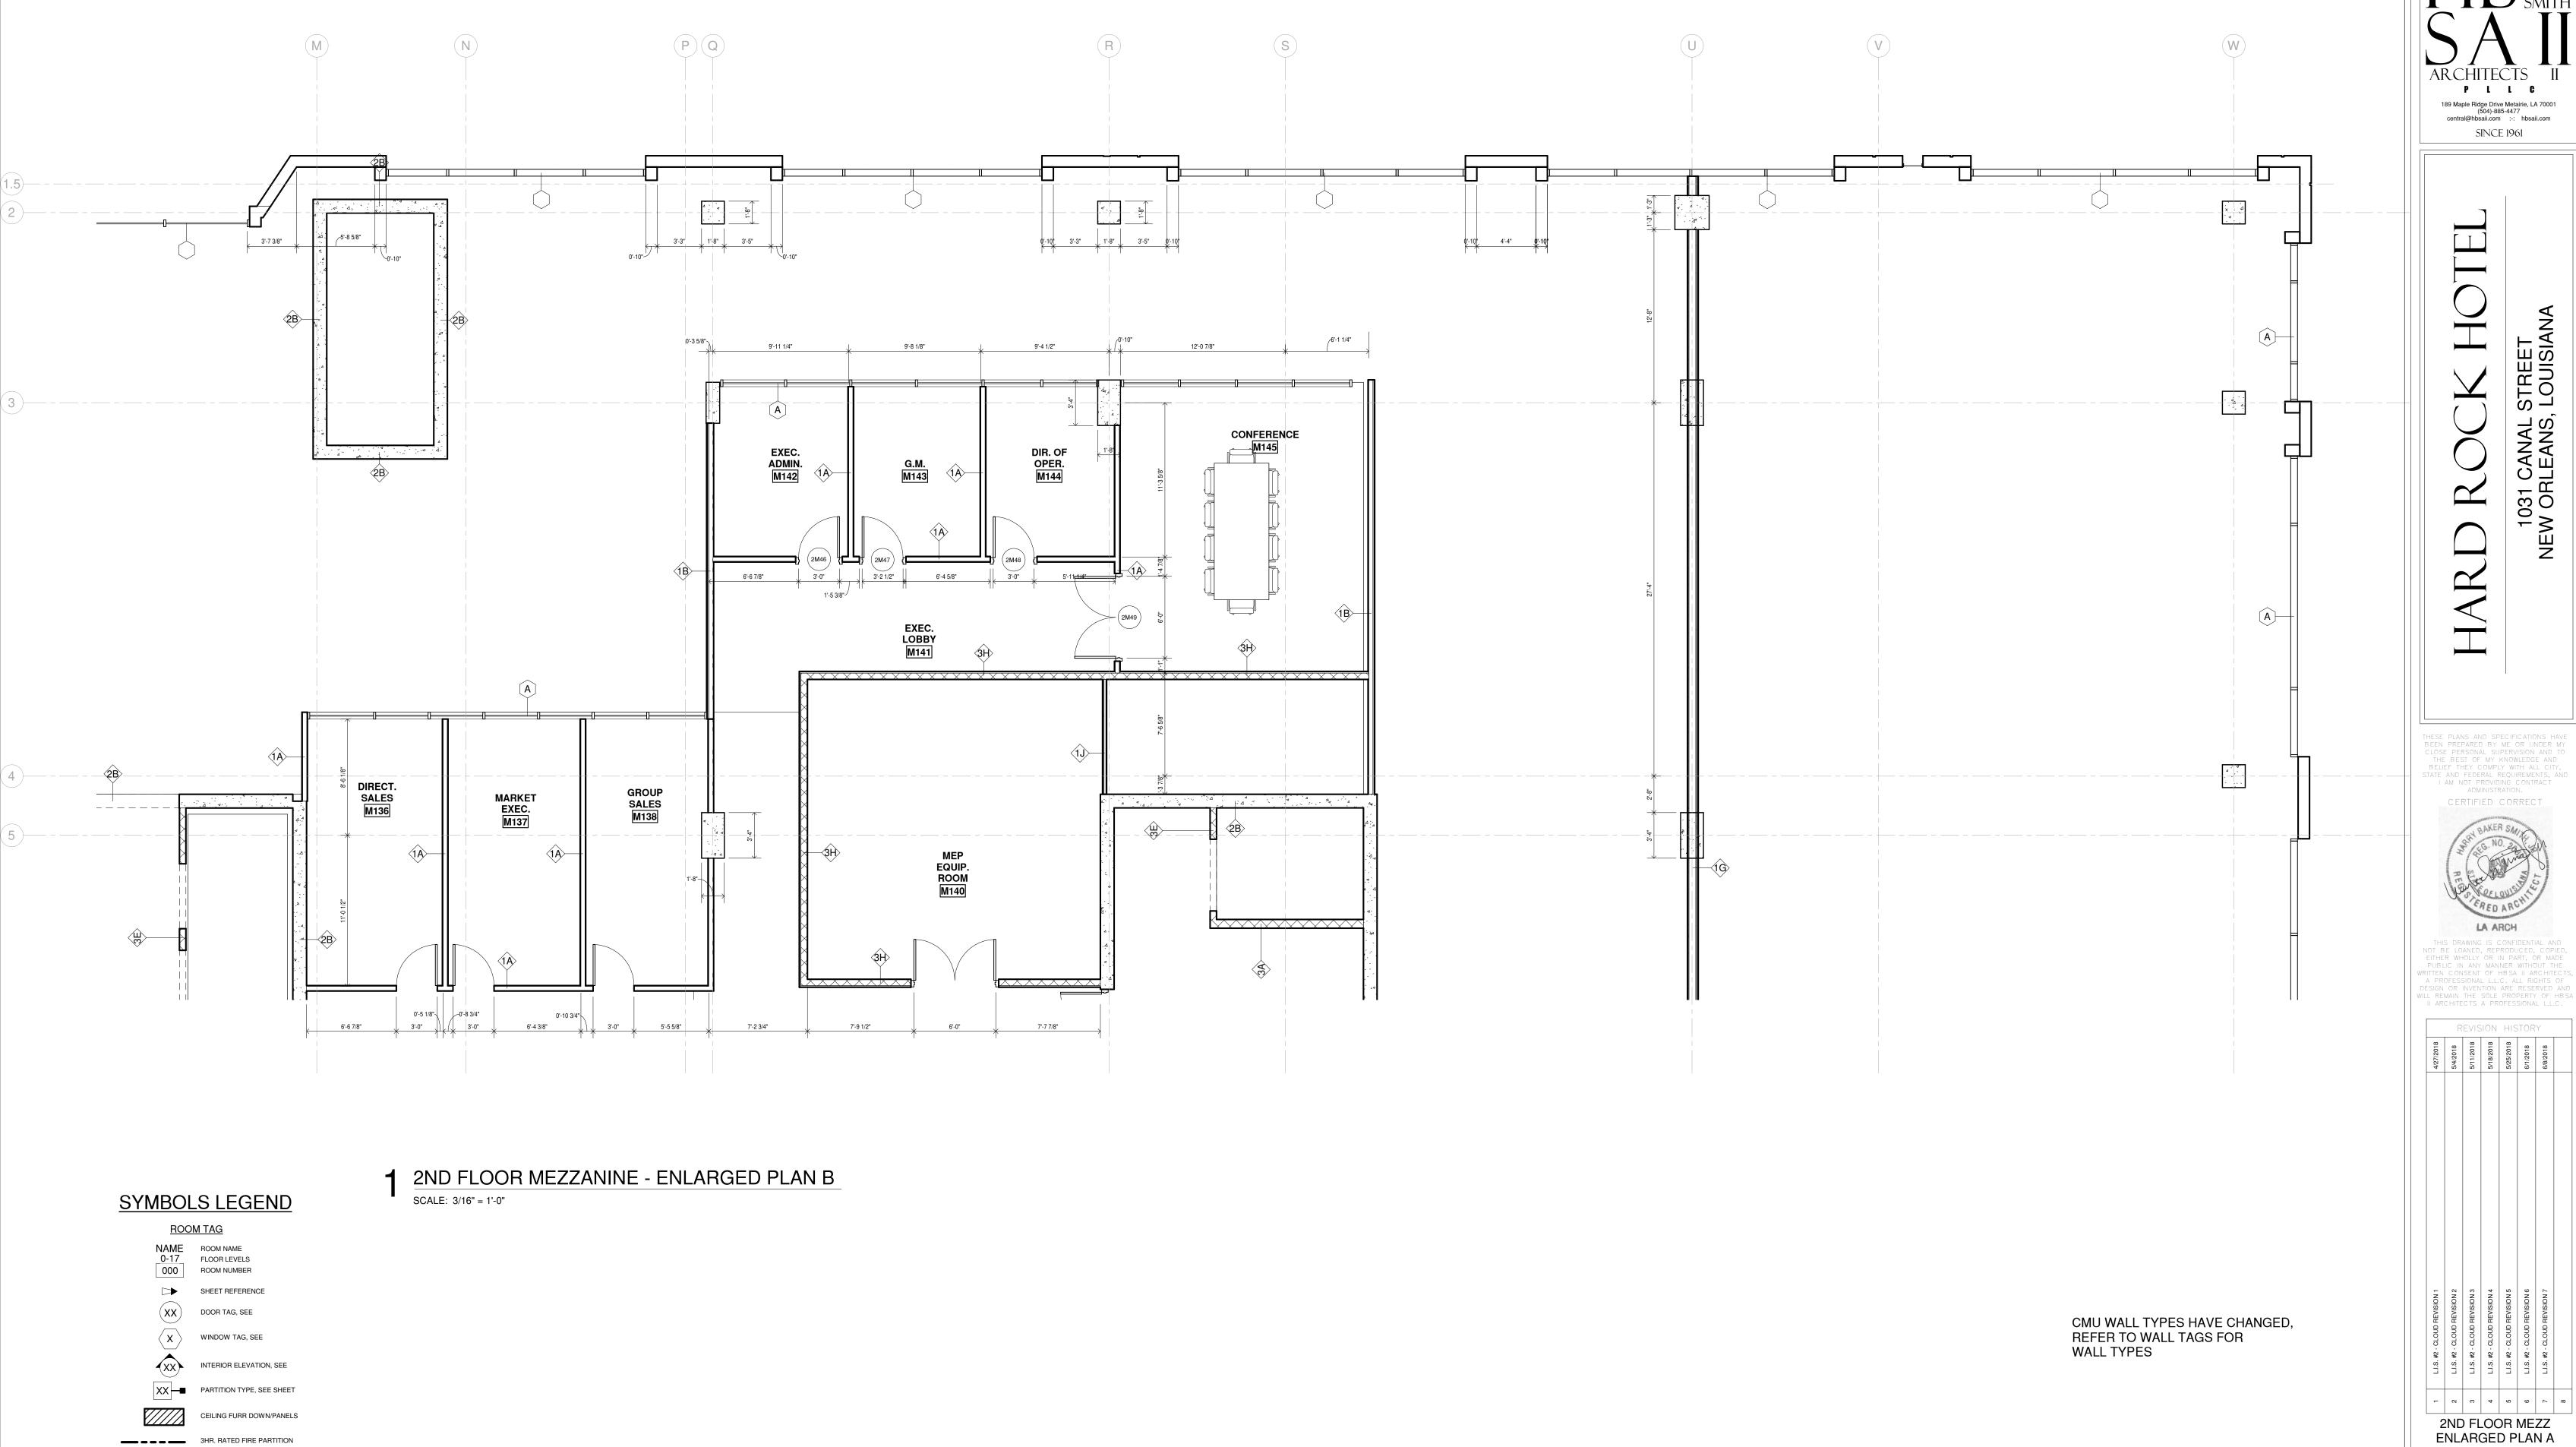

2HR. RATED FIRE PARTITION

1HR. RATED FIRE PARTITION

2-A:20-B:C FIRE EXTINGUISHER IN

RECESSED CABINET, MOUNTING HEIGHT 60" (MAX.) AFF TO TOP EXTINGUISHER


2-A:20-B:C SURFACED MOUNTED, MOUNTING HEIGHT 60" (MAX.) AFF TO TOP EXTINGUISHER


ADA 30"x48" CLEAR FLOOR SPACE


189 Maple Ridge Drive Metairie, LA 70001 (504)-885-4477 central@hbsaii.com :-: hbsaii.com CERTIFIED CORRECT

REVISION HISTORY

2ND FLOOR MEZZ ENLARGED PLAN A

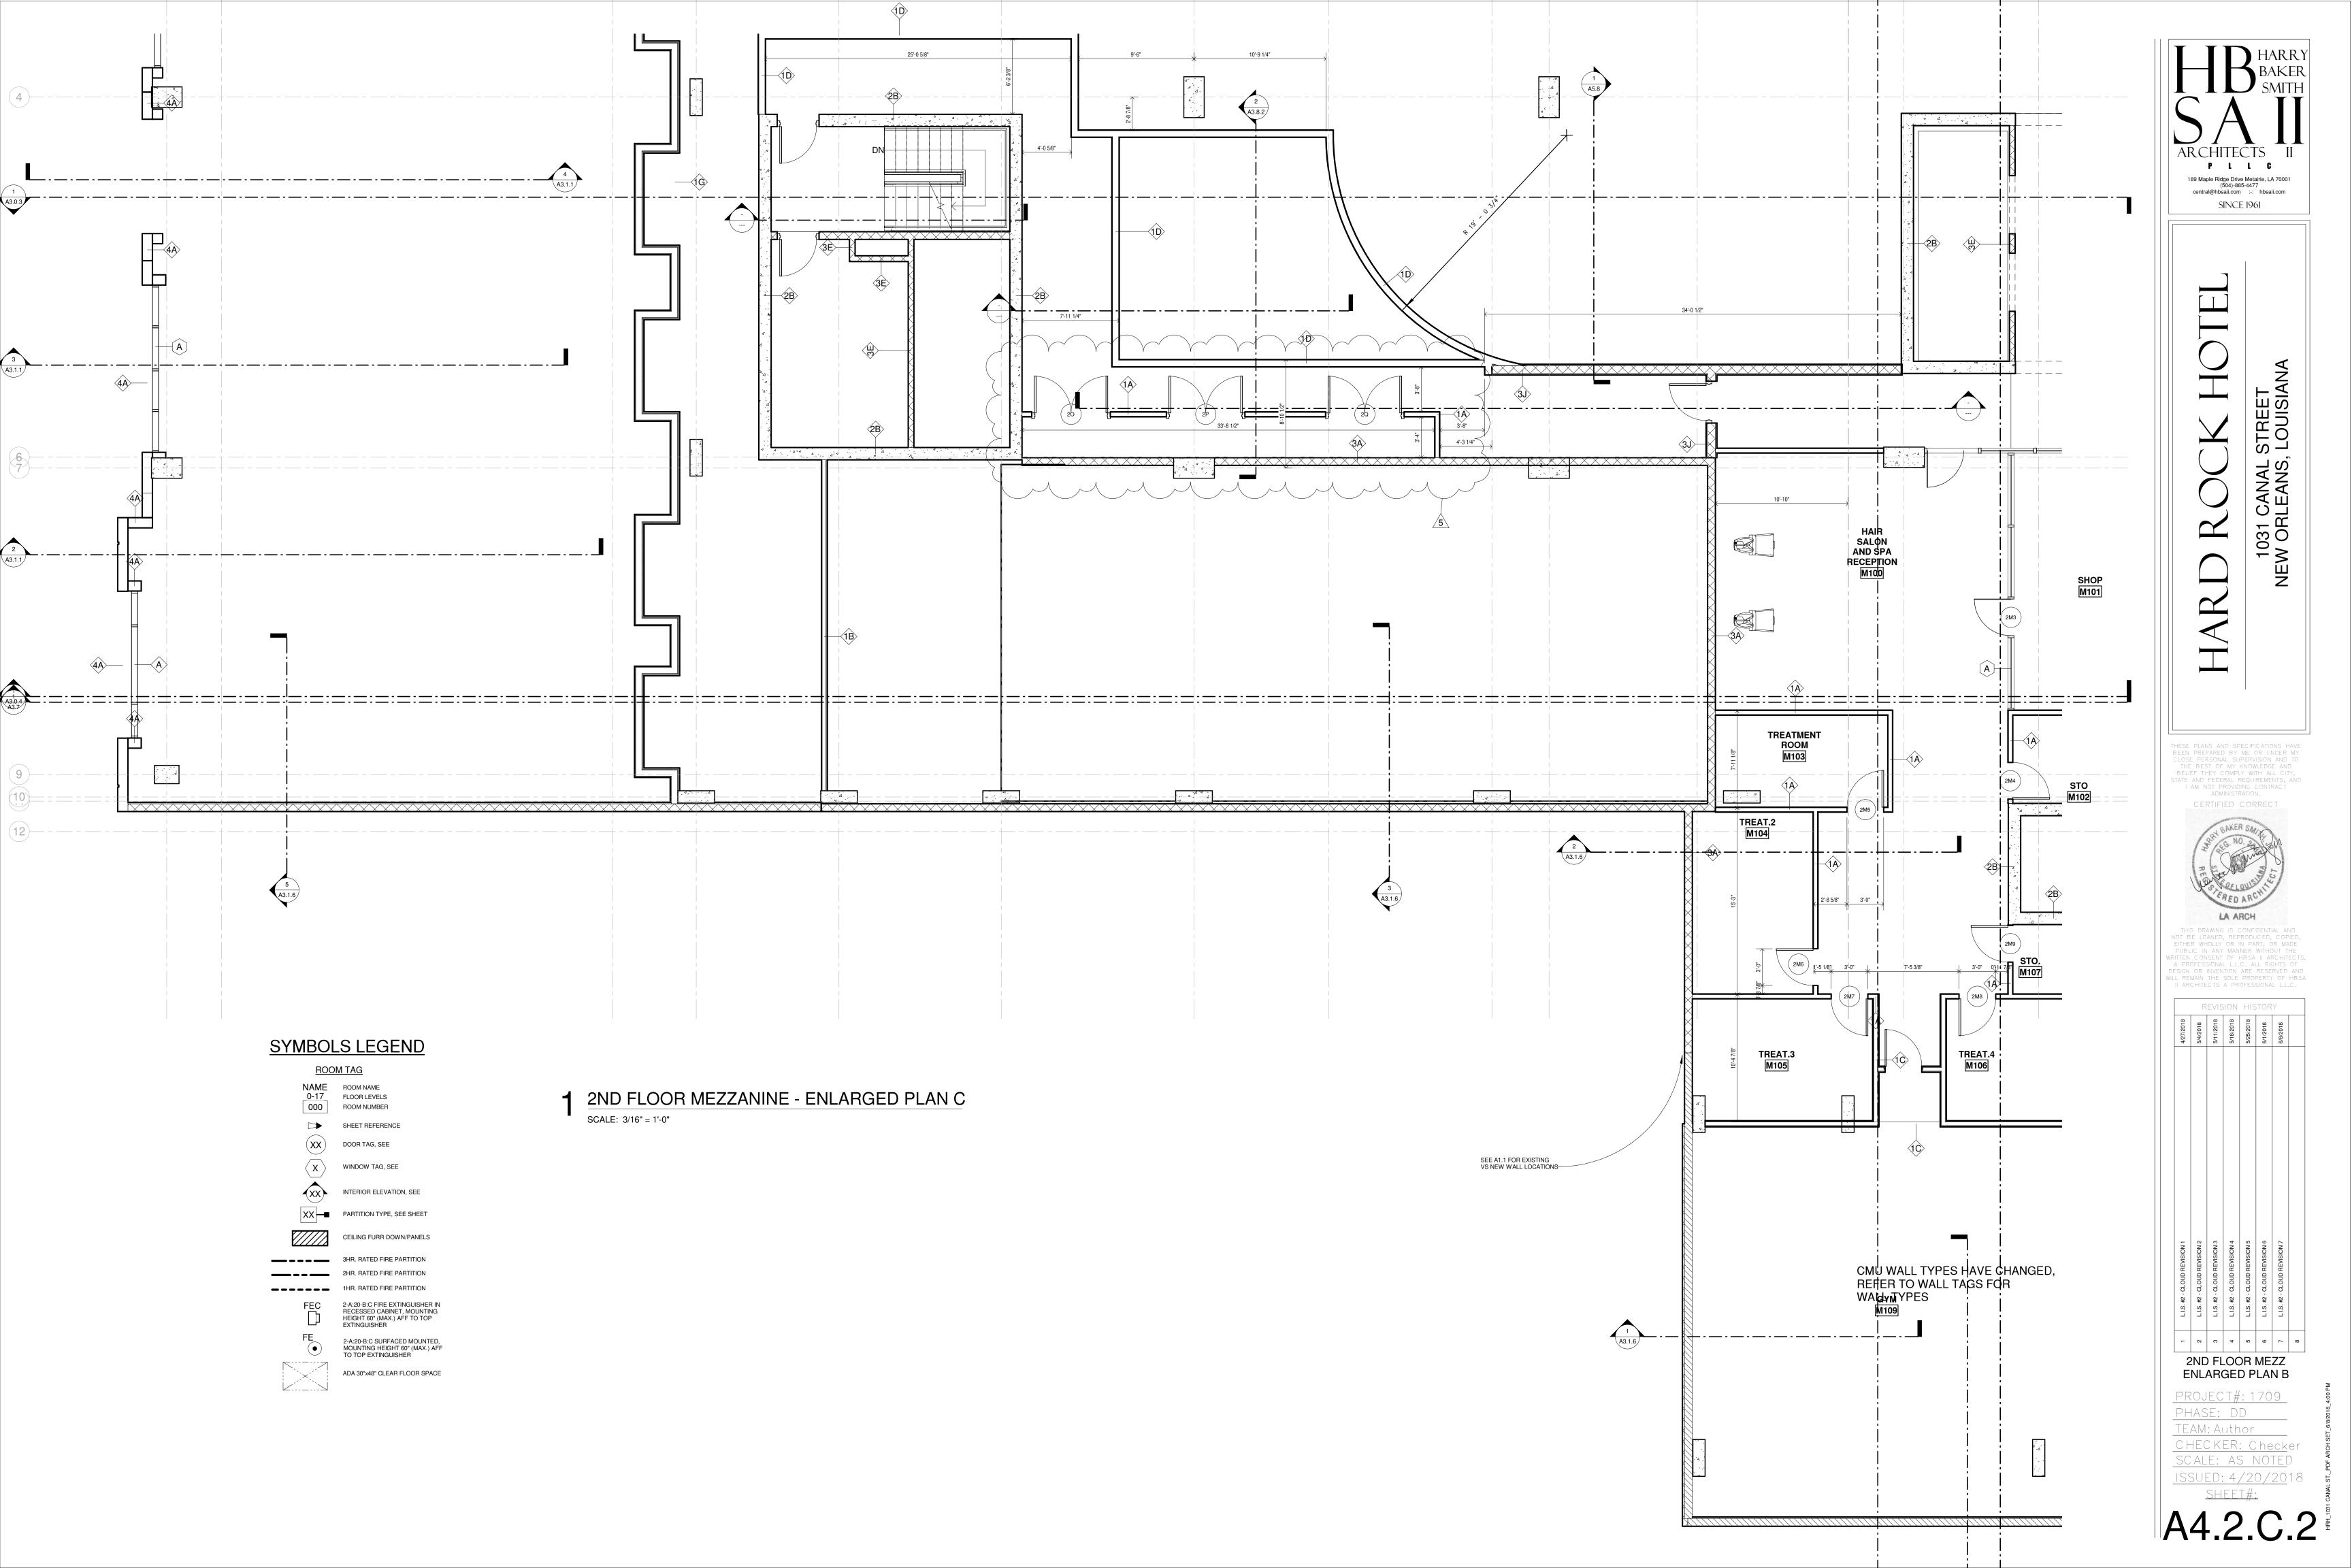


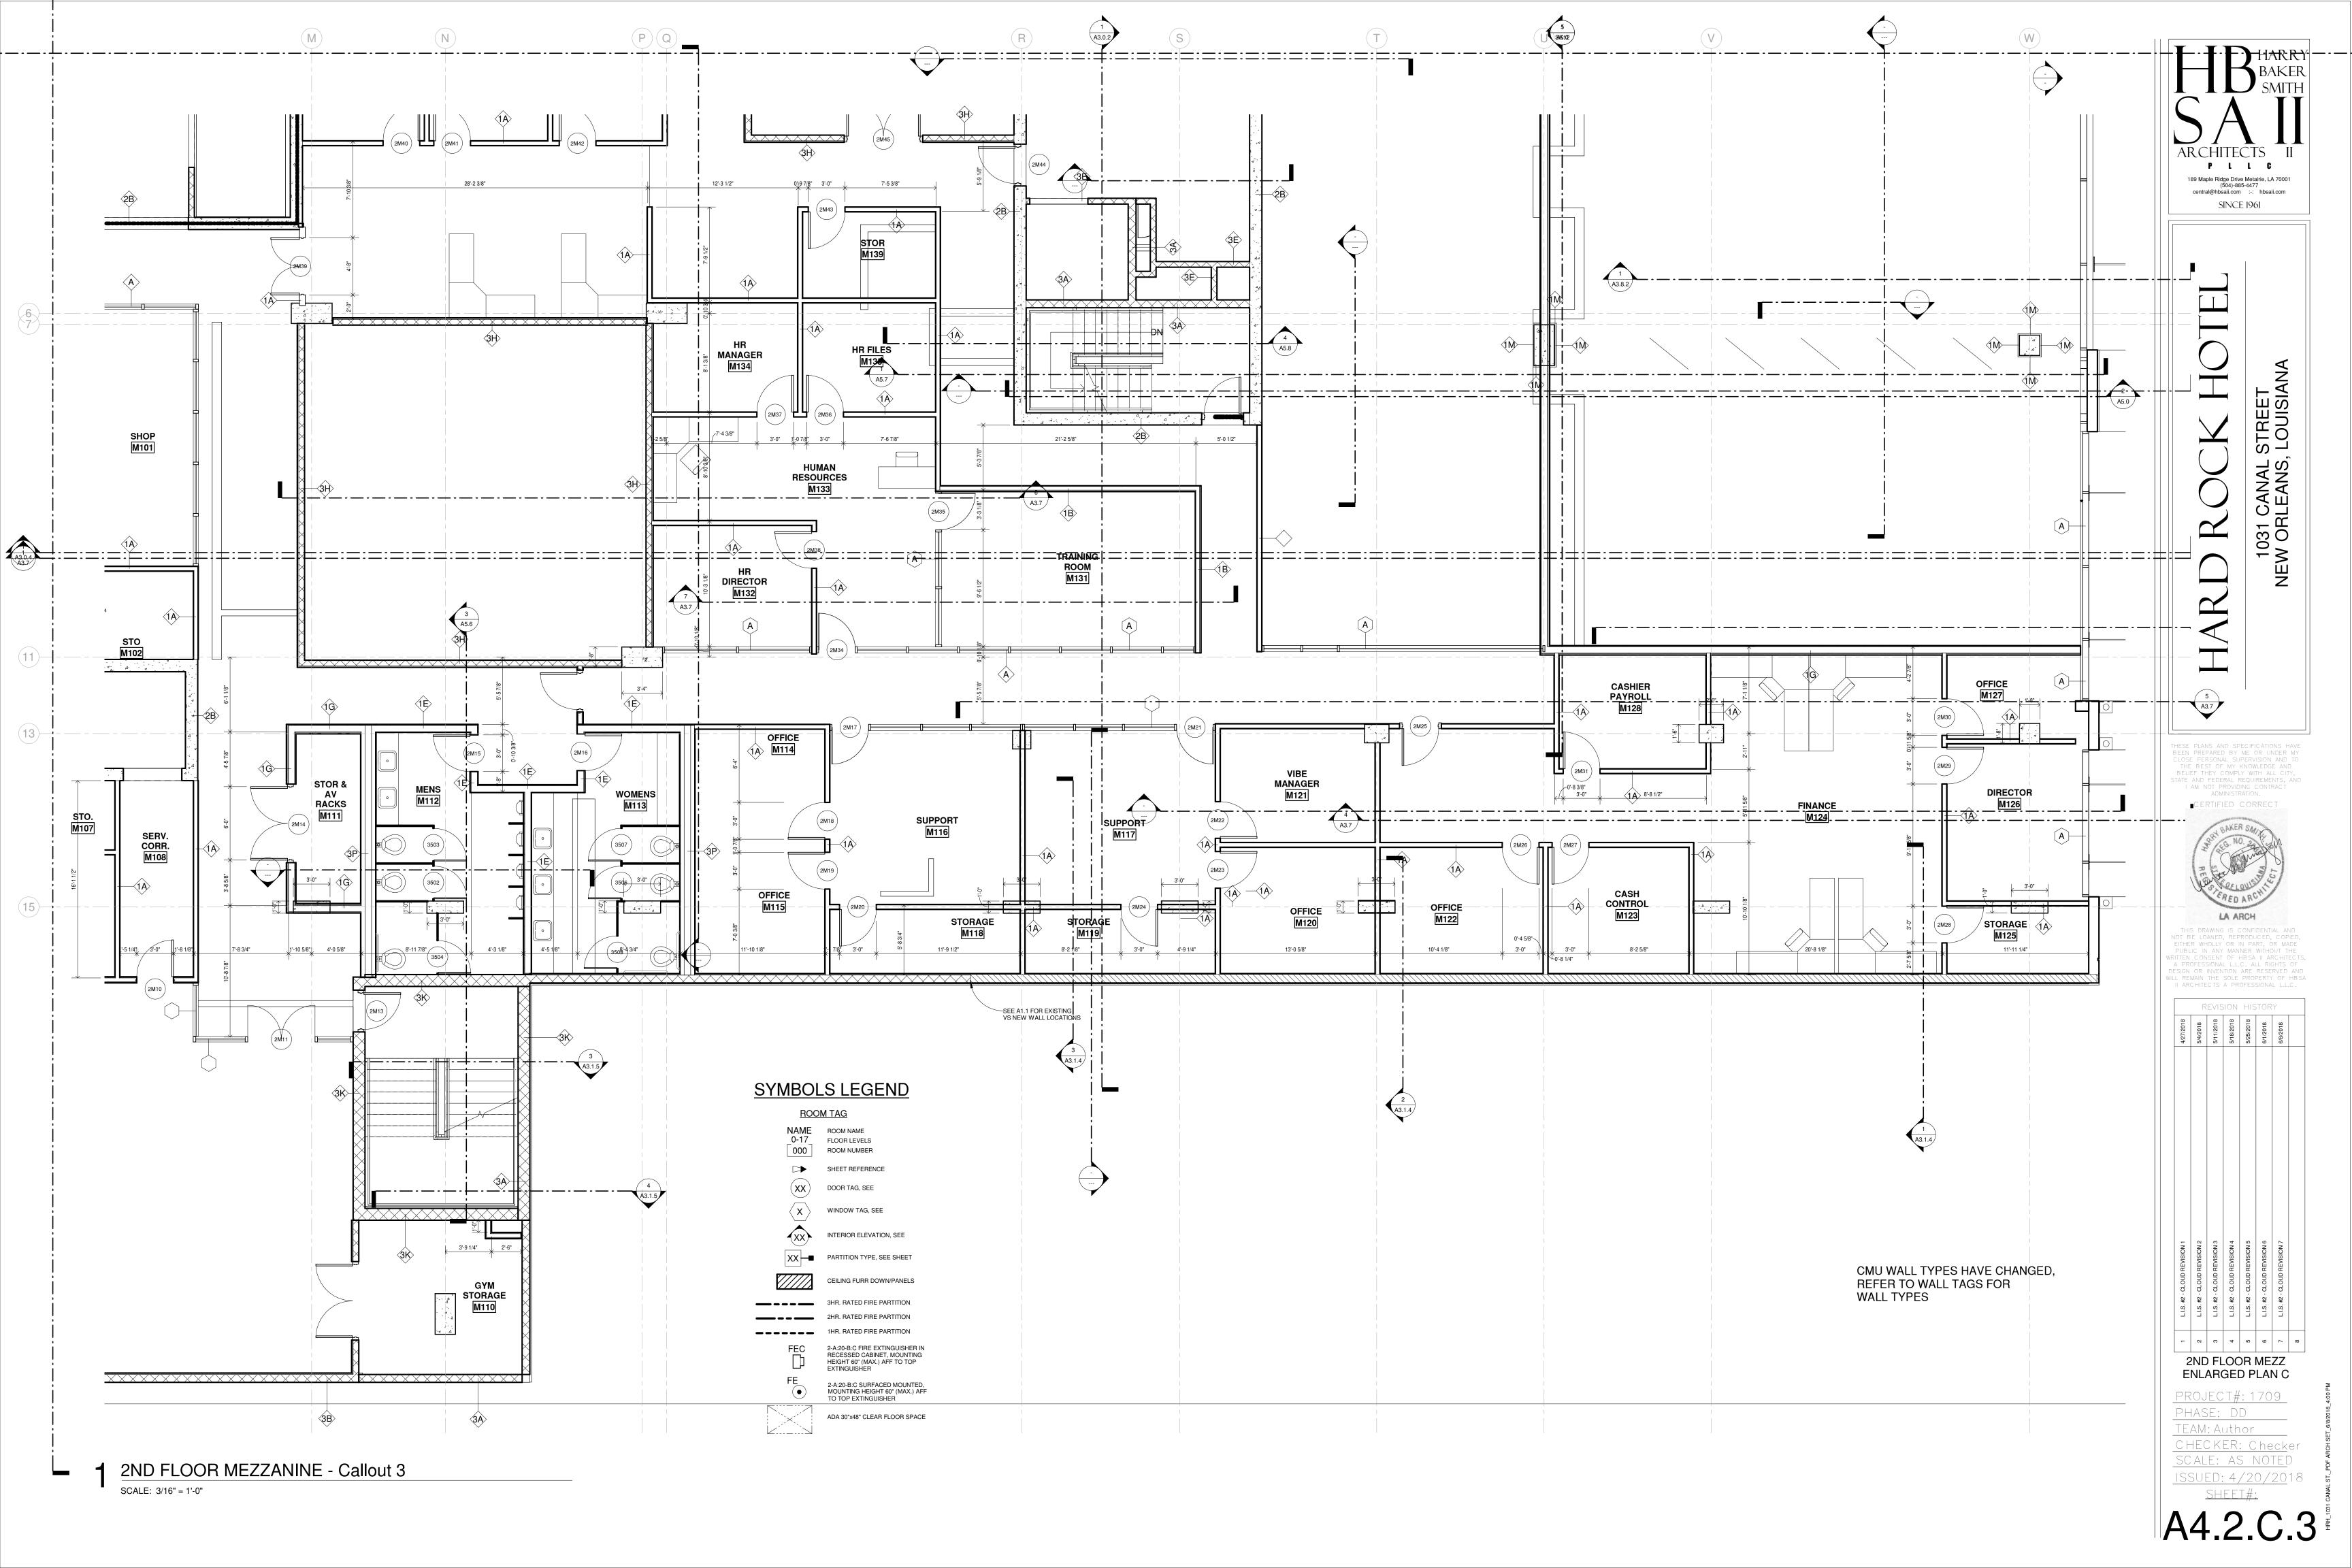

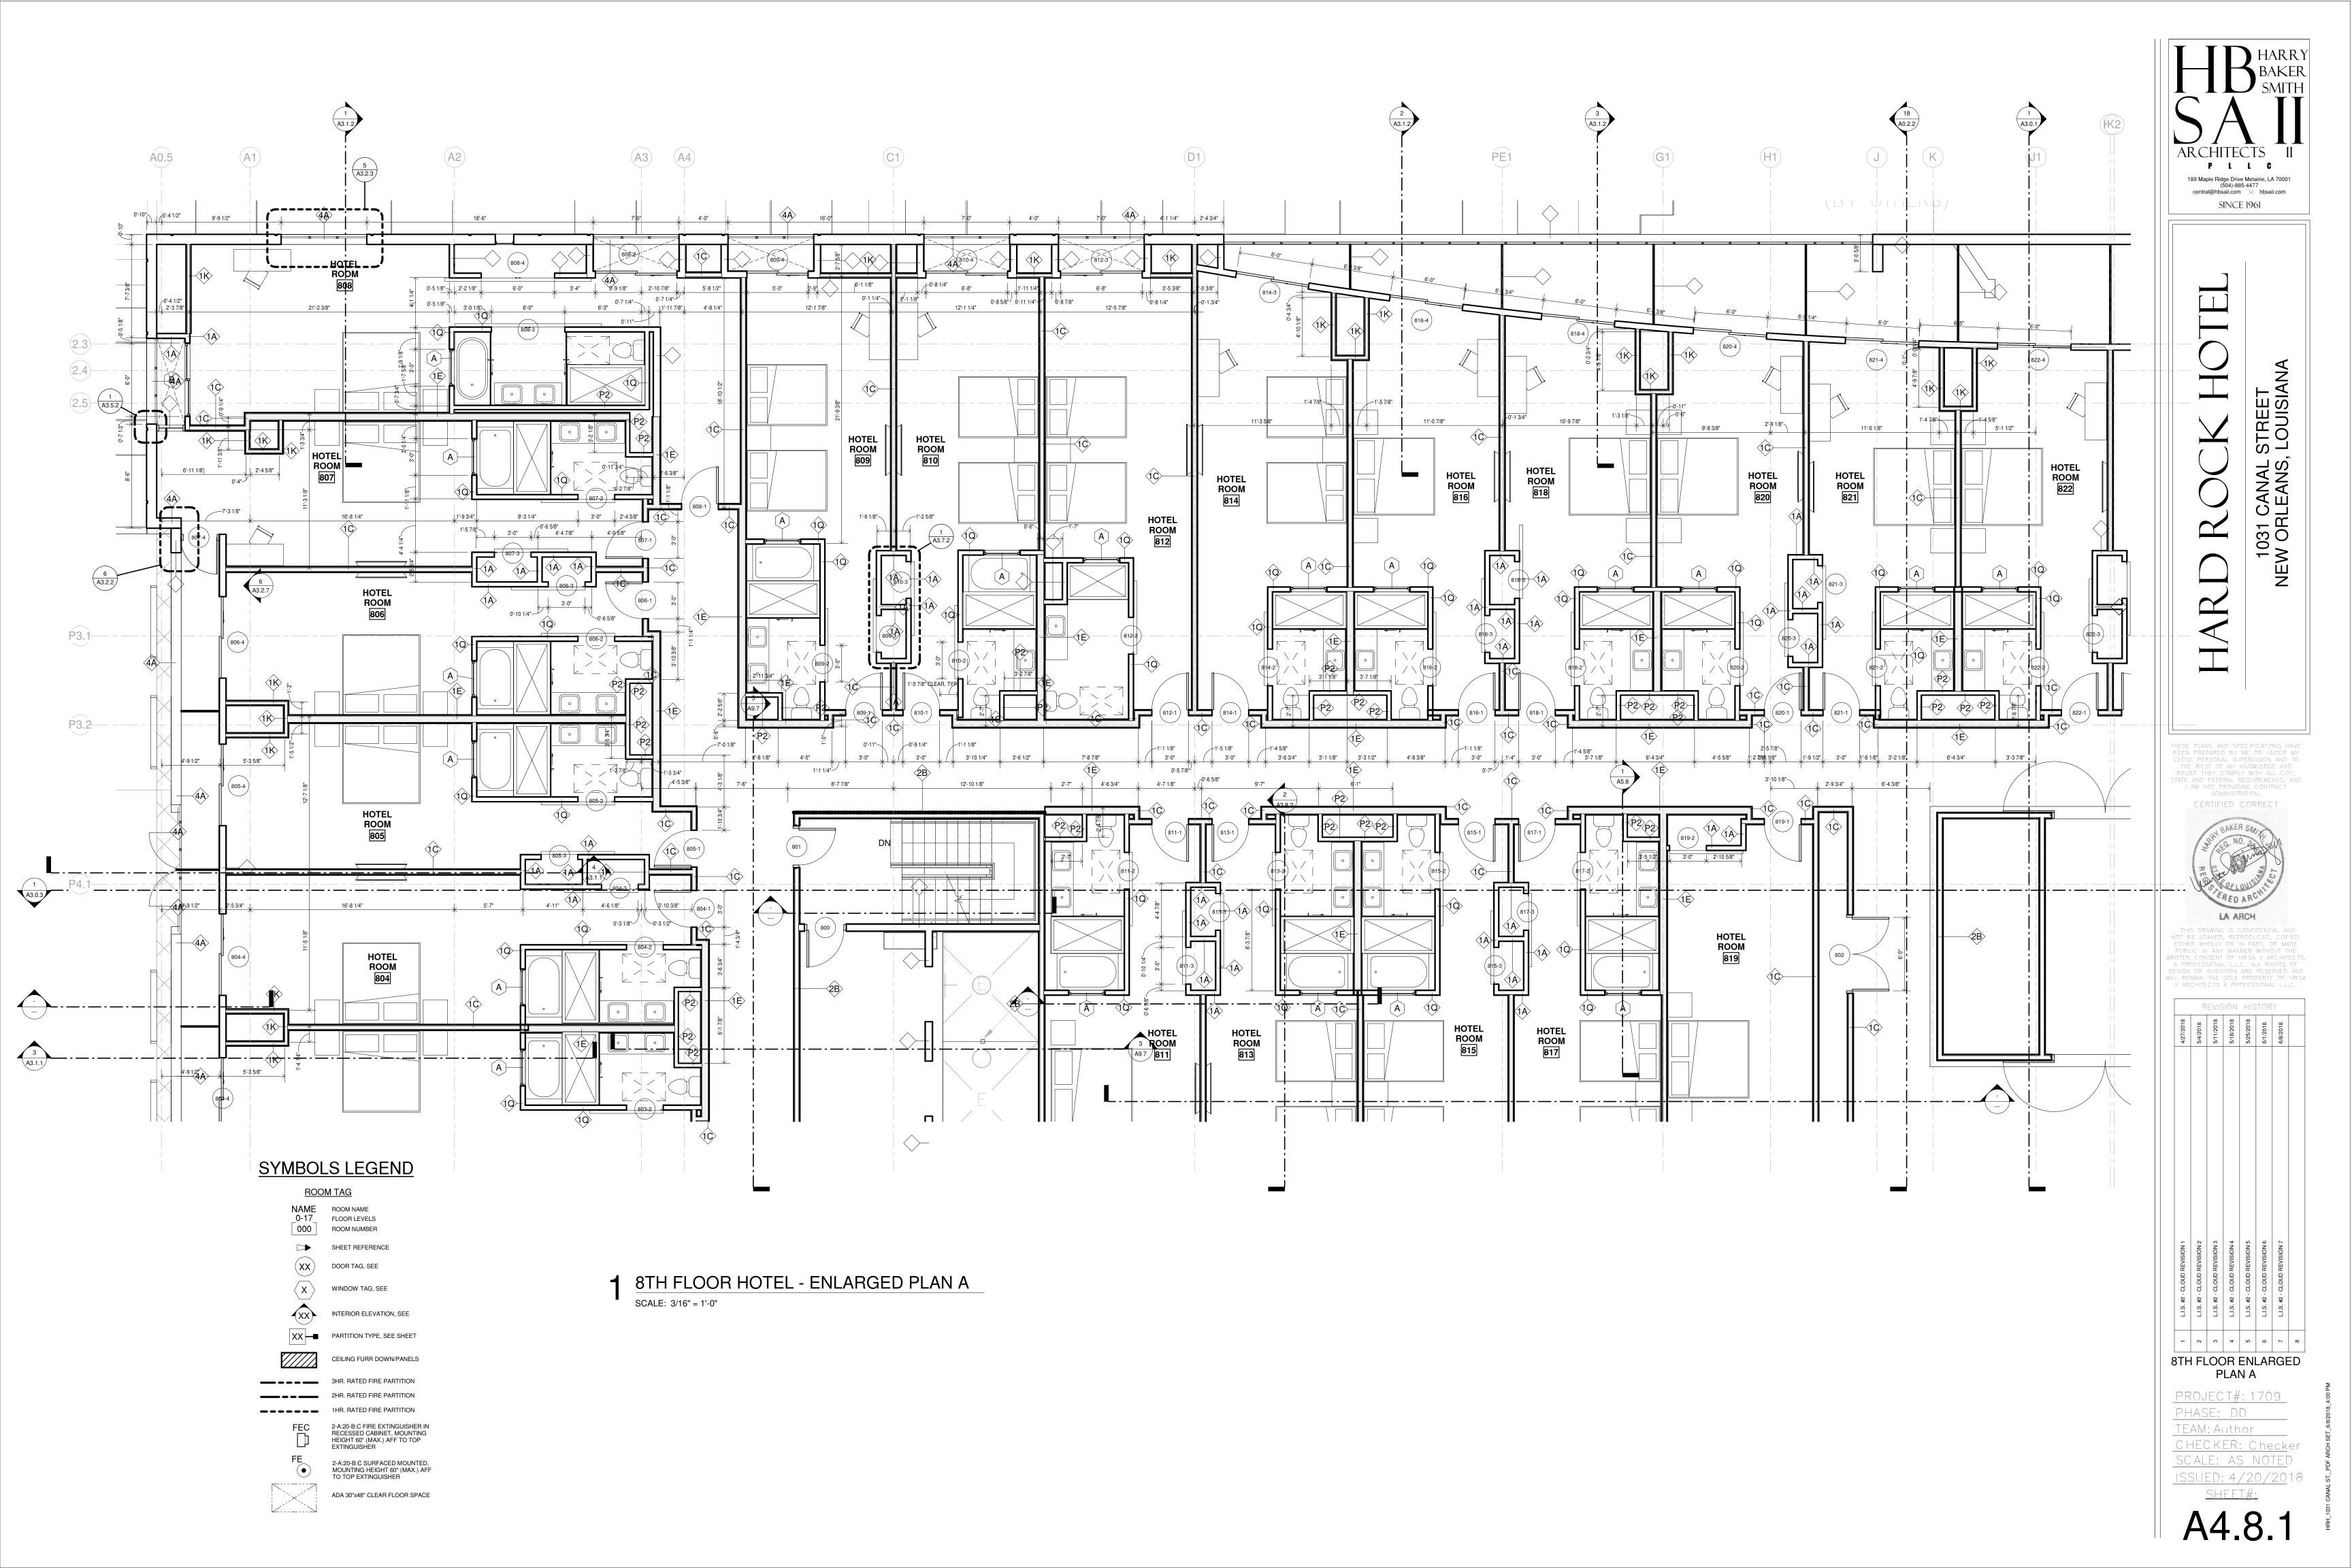

THESE PLANS AND SPECIFICATIONS HAVE BEEN PREPARED BY ME OR UNDER MY CLOSE PERSONAL SUPERVISION AND TO THE BEST OF MY KNOWLEDGE AND BELIEF THEY COMPLY WITH ALL CITY, STATE AND FEDERAL REQUIREMENTS, AND I AM NOT PROVIDING CONTRACT ADMINISTRATION.


CERTIFIED CORRECT

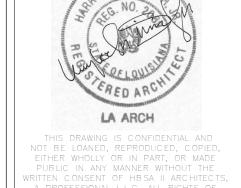


8TH FLOOR ENLARGED PLAN B

PROJECT#: 1709
PHASE: DD
TEAM: Author
CHECKER: Checker
SCALE: AS NOTED

ISSUED: 4/20/2018
SHEET#: **A4.8.2** 

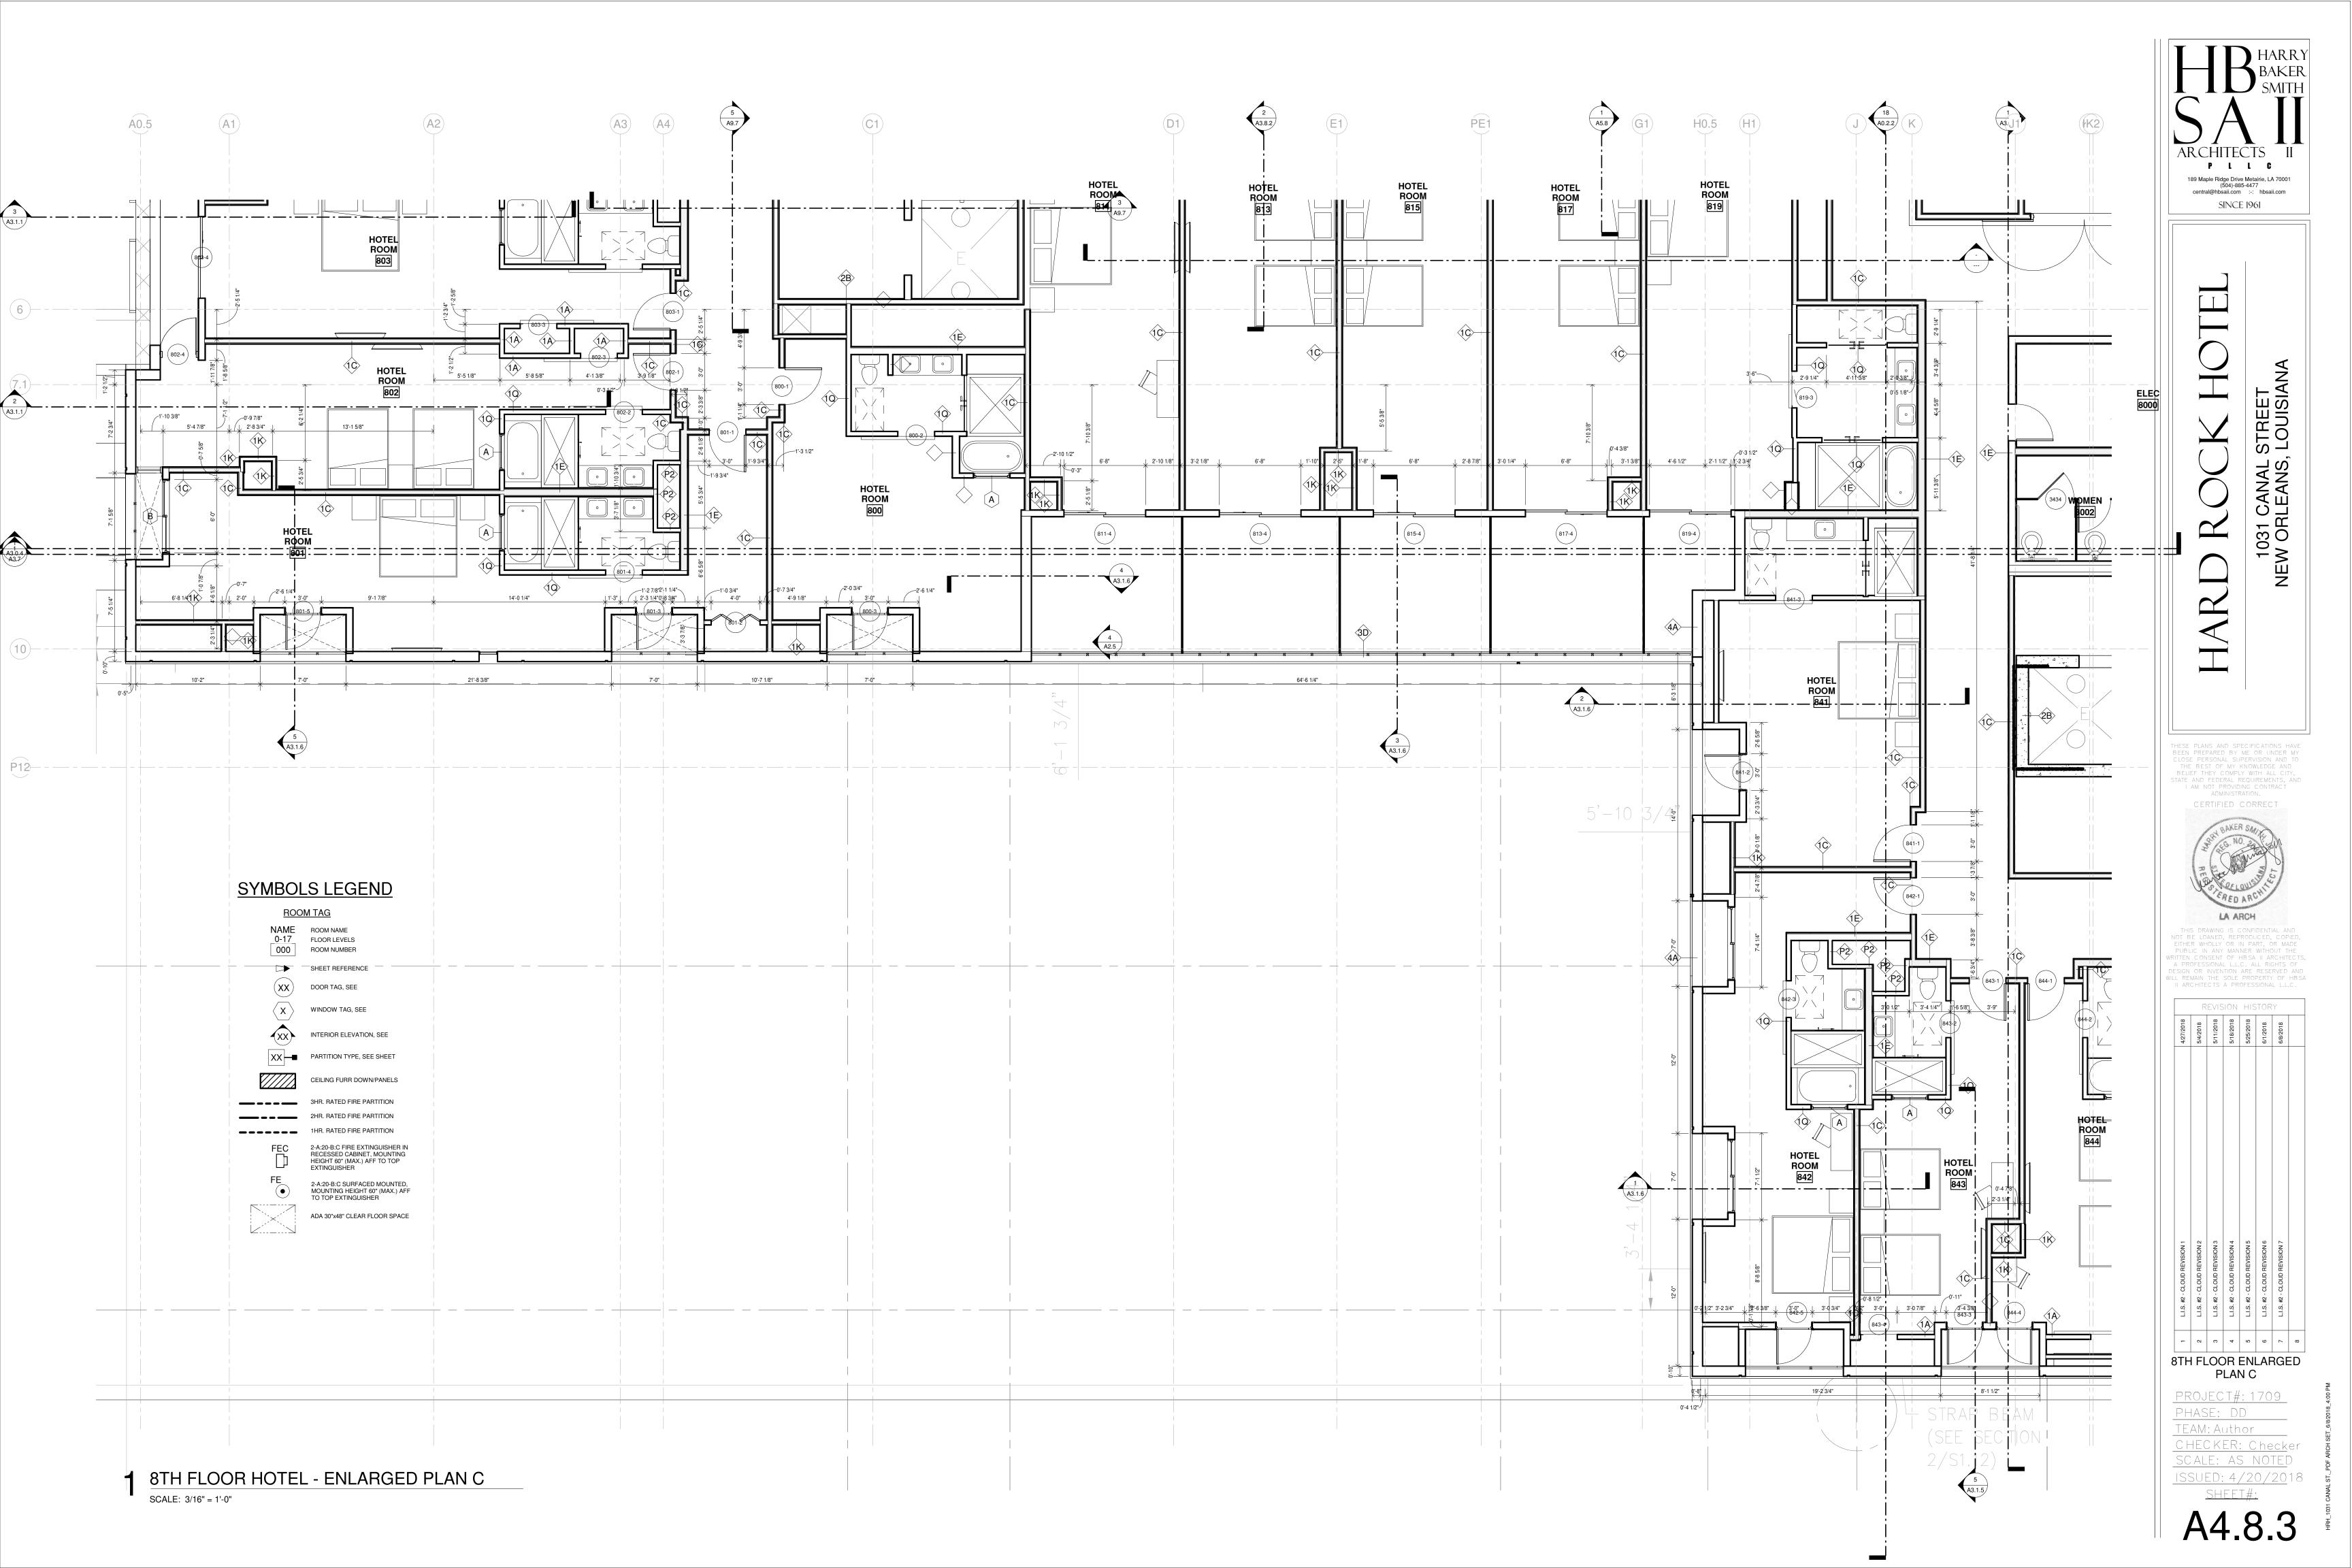

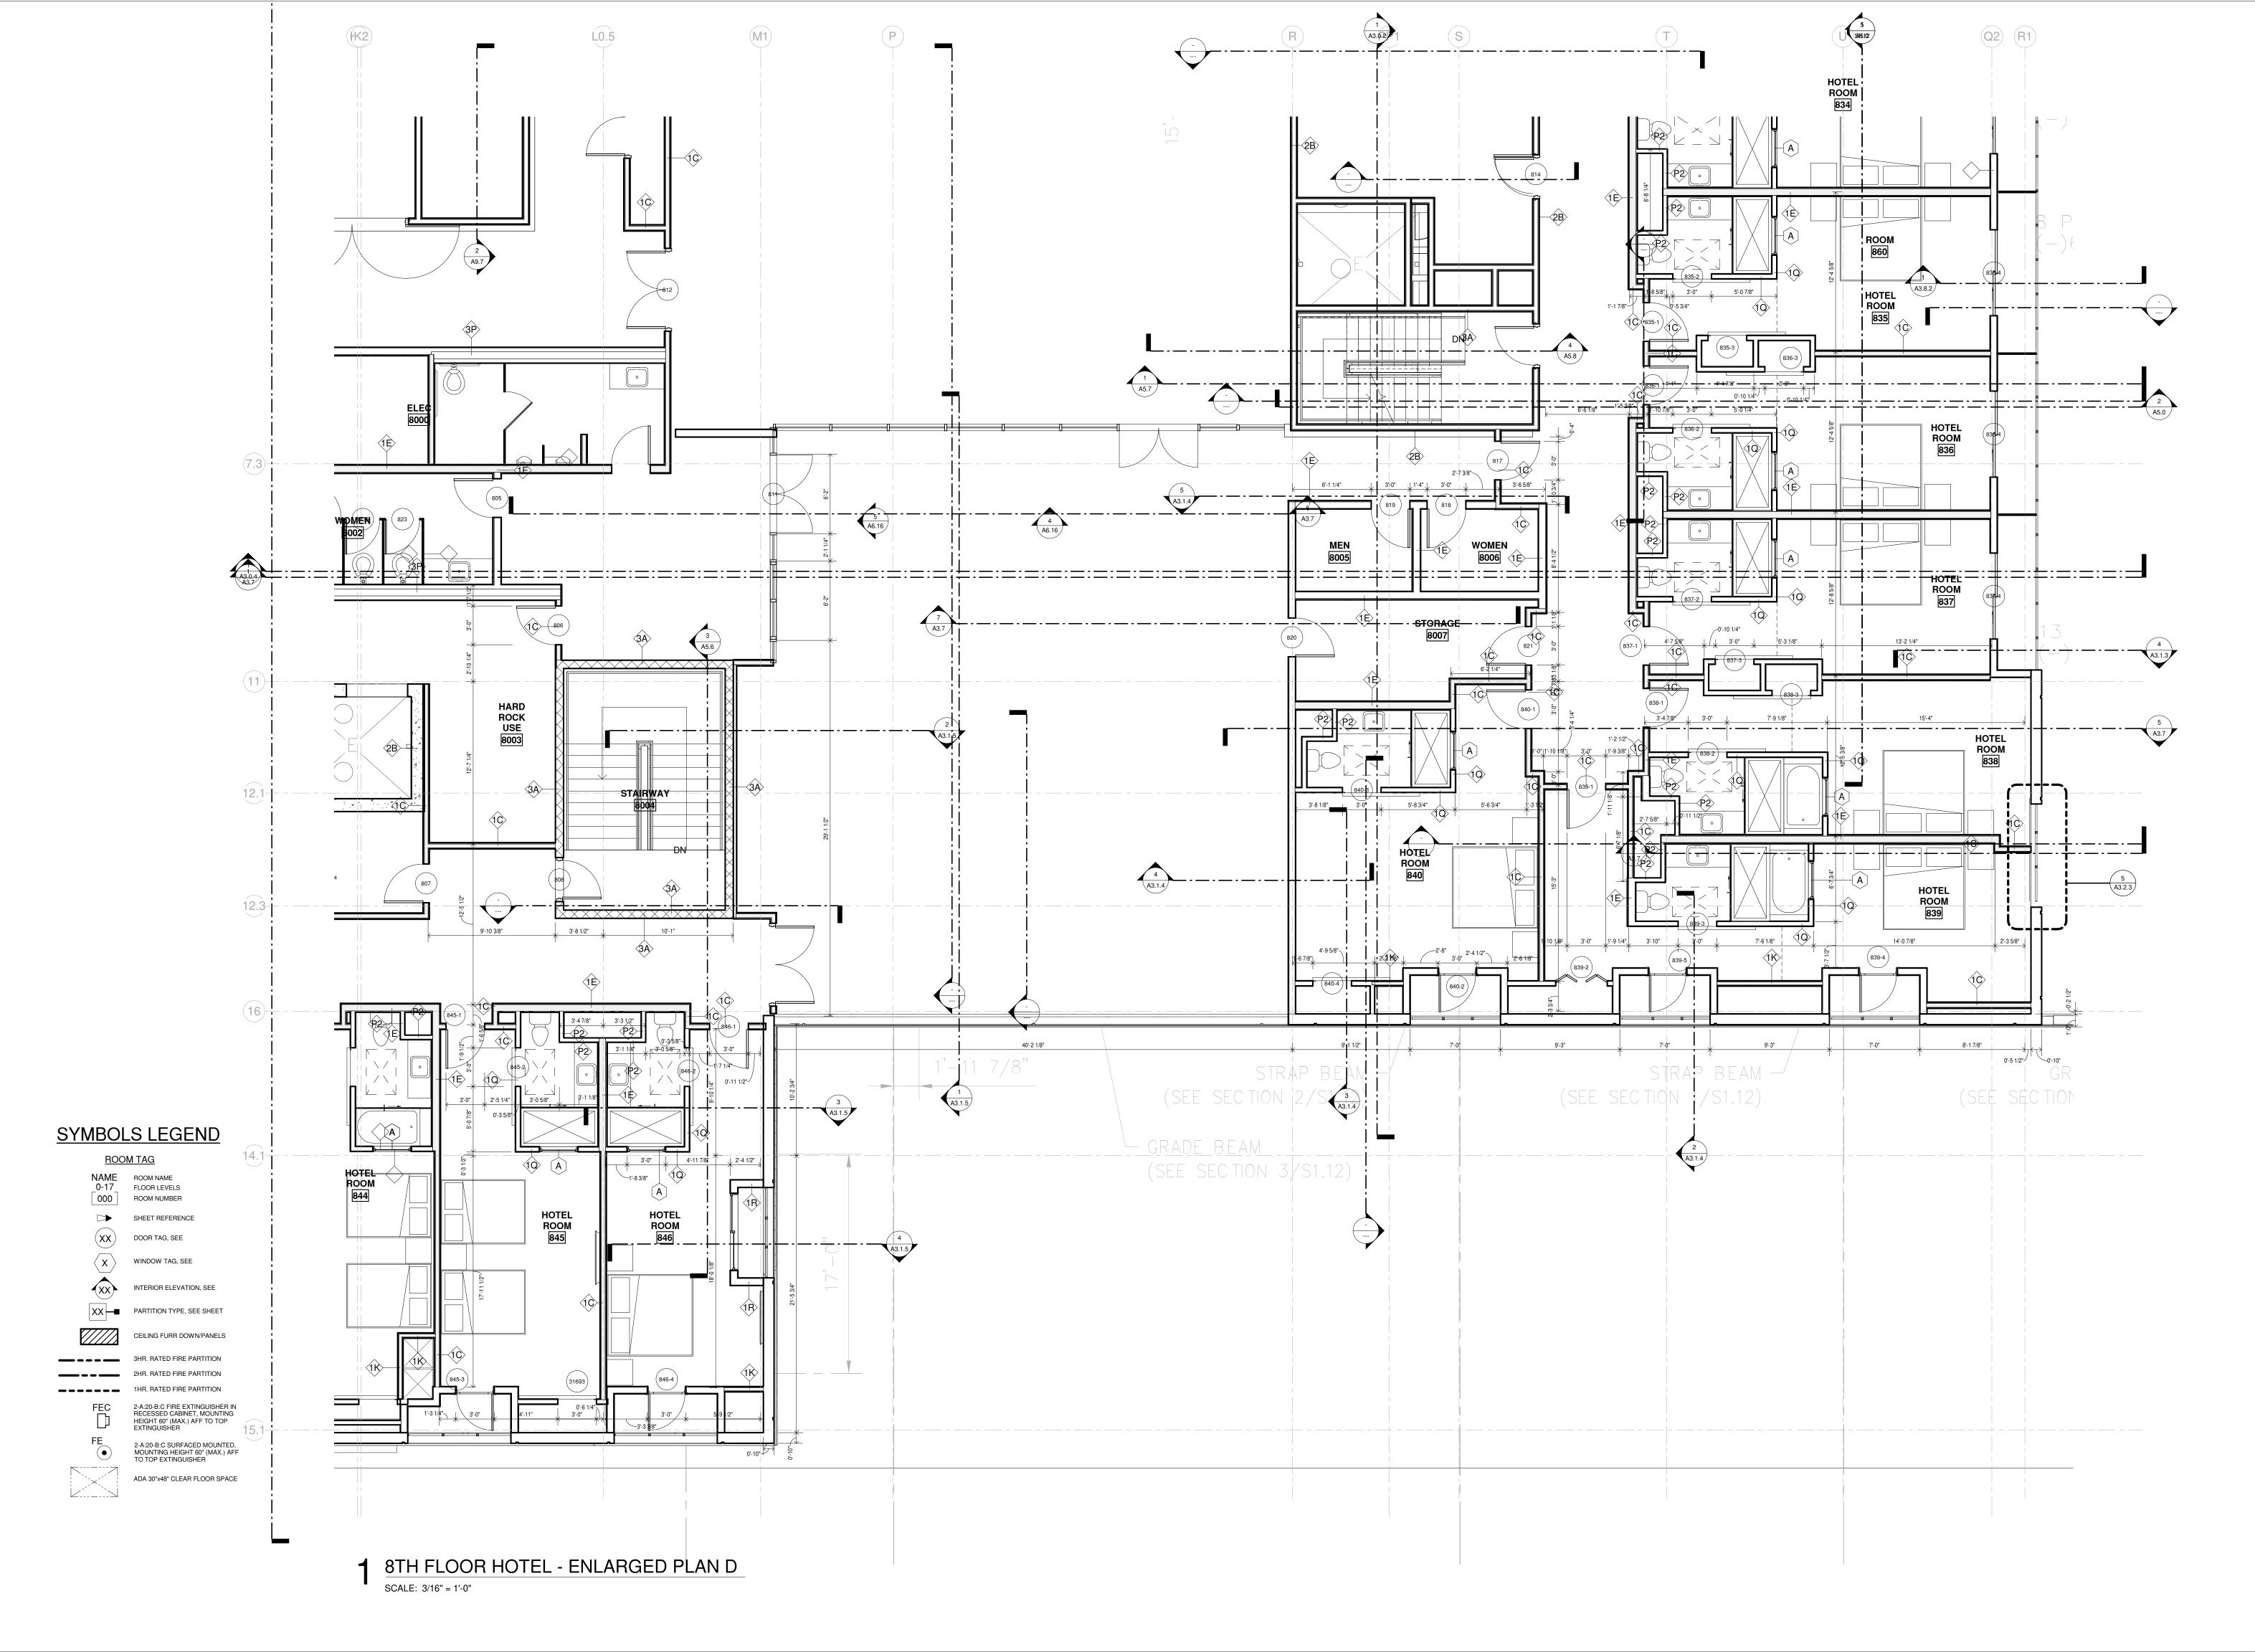



HARD ROCK HOTE

1031 CANAL STREET

NEW ORLEANS, LOUISIANA

LOSE PERSONAL SUPERVISION AND TO THE BEST OF MY KNOWLEDGE AND BELIEF THEY COMPLY WITH ALL CITY, ATE AND FEDERAL REQUIREMENTS, AND I AM NOT PROVIDING CONTRACT ADMINISTRATION.

CERTIFIED CORRECT

THIS DRAWING IS CONFIDENTIAL AND
NOT BE LOANED, REPRODUCED, COPIED,
EITHER WHOLLY OR IN PART, OR MADE
PUBLIC IN ANY MANNER WITHOUT THE
WRITTEN CONSENT OF HBSA II ARCHITECTS,
A PROFESSIONAL L.L.C. ALL RIGHTS OF
DESIGN OR INVENTION ARE RESERVED AND
WILL REMAIN THE SOLE PROPERTY OF HBSA


8TH FLOOR ENLARGED PLAN D

PROJECT#: 1709
PHASE: DD

TEAM: Author
CHECKER: Checker
SCALE: AS NOTED

ISSUED: 4/20/2018

A4.8.4

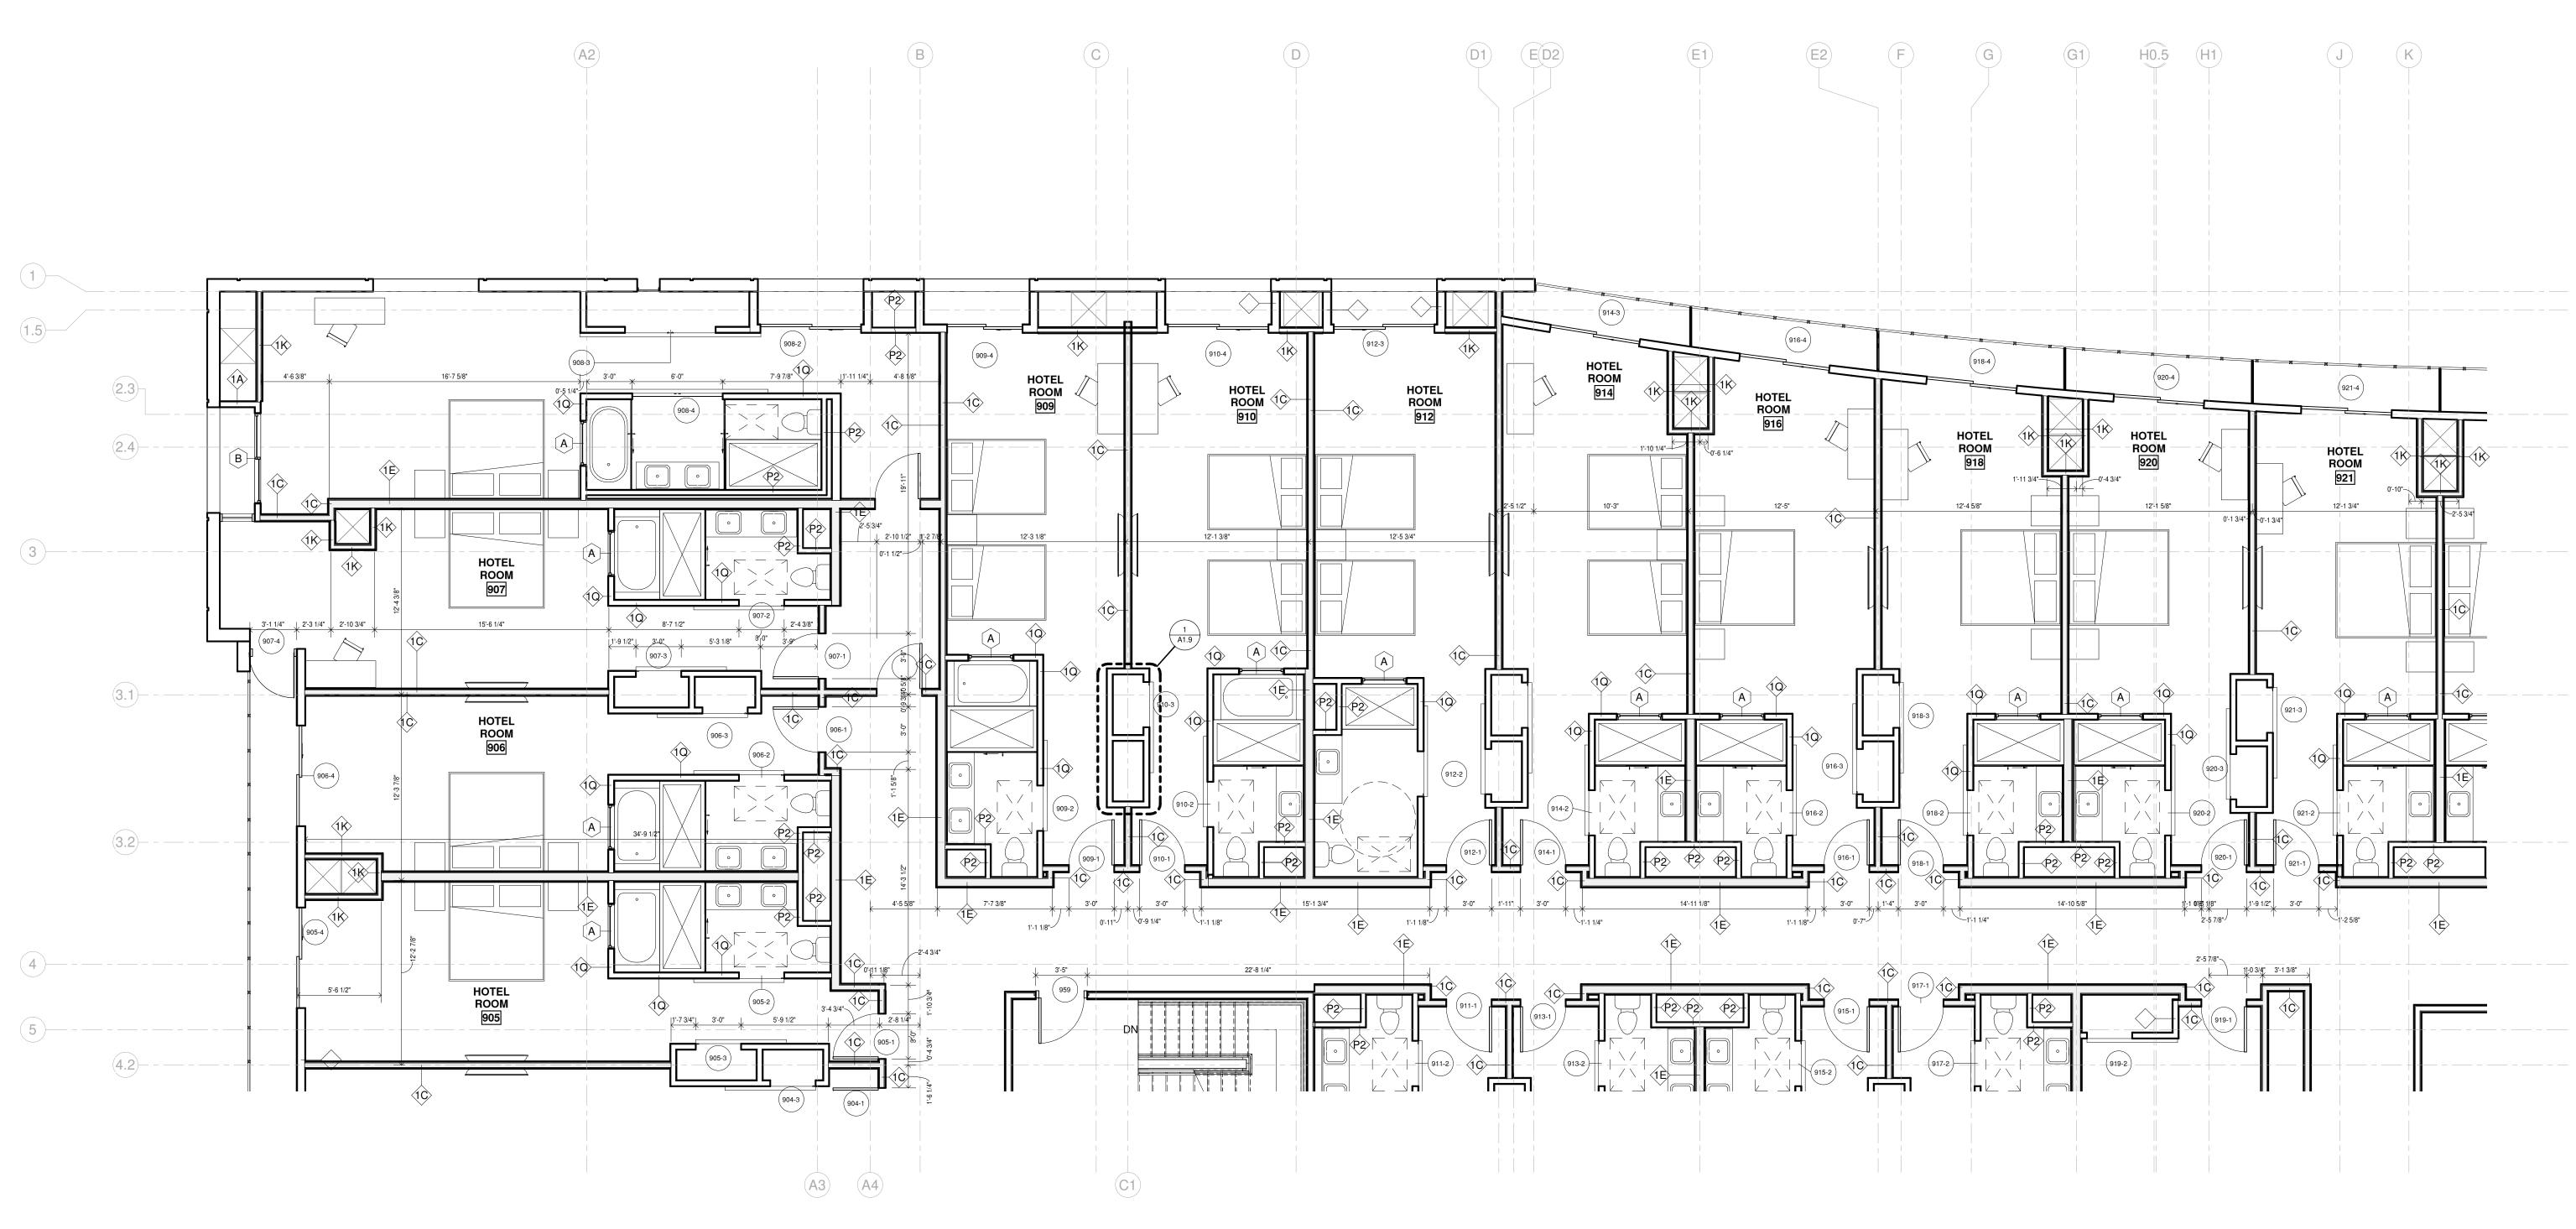

1 9TH FLOOR HOTEL - ENLARGED PLAN A SCALE: 3/16" = 1'-0"

### SYMBOLS LEGEND

ROOM TAG

NAME ROOM NAME
0-17 FLOOR LEVELS

000 ROOM NUMBER

SHEET REFERENCE

XX DOOR TAG, SEE

X WINDOW TAG, SEE

(xx)

XX INTERIOR ELEVATION, SEE

XX PARTITION TYPE, SEE SHEET

3HR. RATED FIRE PARTITION
2HR. RATED FIRE PARTITION
1HR. RATED FIRE PARTITION

FEC

2-A:20-B:C FIRE EXTINGUISHER IN
RECESSED CABINET, MOUNTING
HEIGHT 60" (MAX.) AFF TO TOP
EXTINGUISHER

FE •

2-A:20-B:C SURFACED MOUNTED, MOUNTING HEIGHT 60" (MAX.) AFF TO TOP EXTINGUISHER ADA 30"x48" CLEAR FLOOR SPACE

CEILING FURR DOWN/PANELS

HARD ROCK HOTEI

1031 CANAL STREET

NEW ORLEANS, LOUISIANA

189 Maple Ridge Drive Metairie, LA 70001 (504)-885-4477 central@hbsaii.com :-: hbsaii.com

SINCE 1961

THESE PLANS AND SPECIFICATIONS HAVE BEEN PREPARED BY ME OR UNDER MY CLOSE PERSONAL SUPERVISION AND TO THE BEST OF MY KNOWLEDGE AND BELIEF THEY COMPLY WITH ALL CITY, STATE AND FEDERAL REQUIREMENTS, AND I AM NOT PROVIDING CONTRACT ADMINISTRATION.

CERTIFIED CORRECT

THIS DRAWING IS CONFIDENTIAL AN NOT BE LOANED, REPRODUCED, COPIEITHER WHOLLY OR IN PART, OR MAI PUBLIC IN ANY MANNER WITHOUT THE WRITTEN CONSENT OF HBSA II ARCHITE A PROFESSIONAL L.L.C. ALL RIGHTS (DESIGN OR INVENTION ARE RESERVED)

WILL REMAIN THE SOLE PROPERTY OF HI ARCHITECTS A PROFESSIONAL L.L.C

REVISION HISTORY

8102/81/9

8102/27/67/9

8102/81/9

8102/27/67/9

8102/81/9

1 L.I.S. #2 - CLOUD REVISION 1
2 L.I.S. #2 - CLOUD REVISION 2
3 L.I.S. #2 - CLOUD REVISION 3
4 L.I.S. #2 - CLOUD REVISION 4
5 L.I.S. #2 - CLOUD REVISION 6
7 L.I.S. #2 - CLOUD REVISION 6
7 L.I.S. #2 - CLOUD REVISION 7
8

9TH FLOOR ENLARGED PLAN A

PROJECT#: 1709
PHASE: DD

PHASE: DD

TEAM: Author


CHECKER: Checker

SCALE: AS NOTED

ISSUED: 4/20/2018


A4.9.1



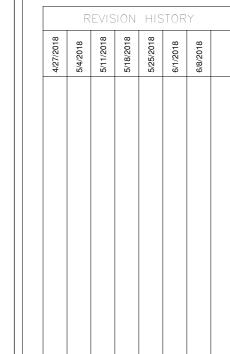

- 0 0 4 0 0 V 8 9TH FLOOR ENLARGED PLAN B

PROJECT#: 1709 PHASE: DD TEAM: Author CHECKER: Checker SCALE: AS NOTED ISSUED: 4/20/2018

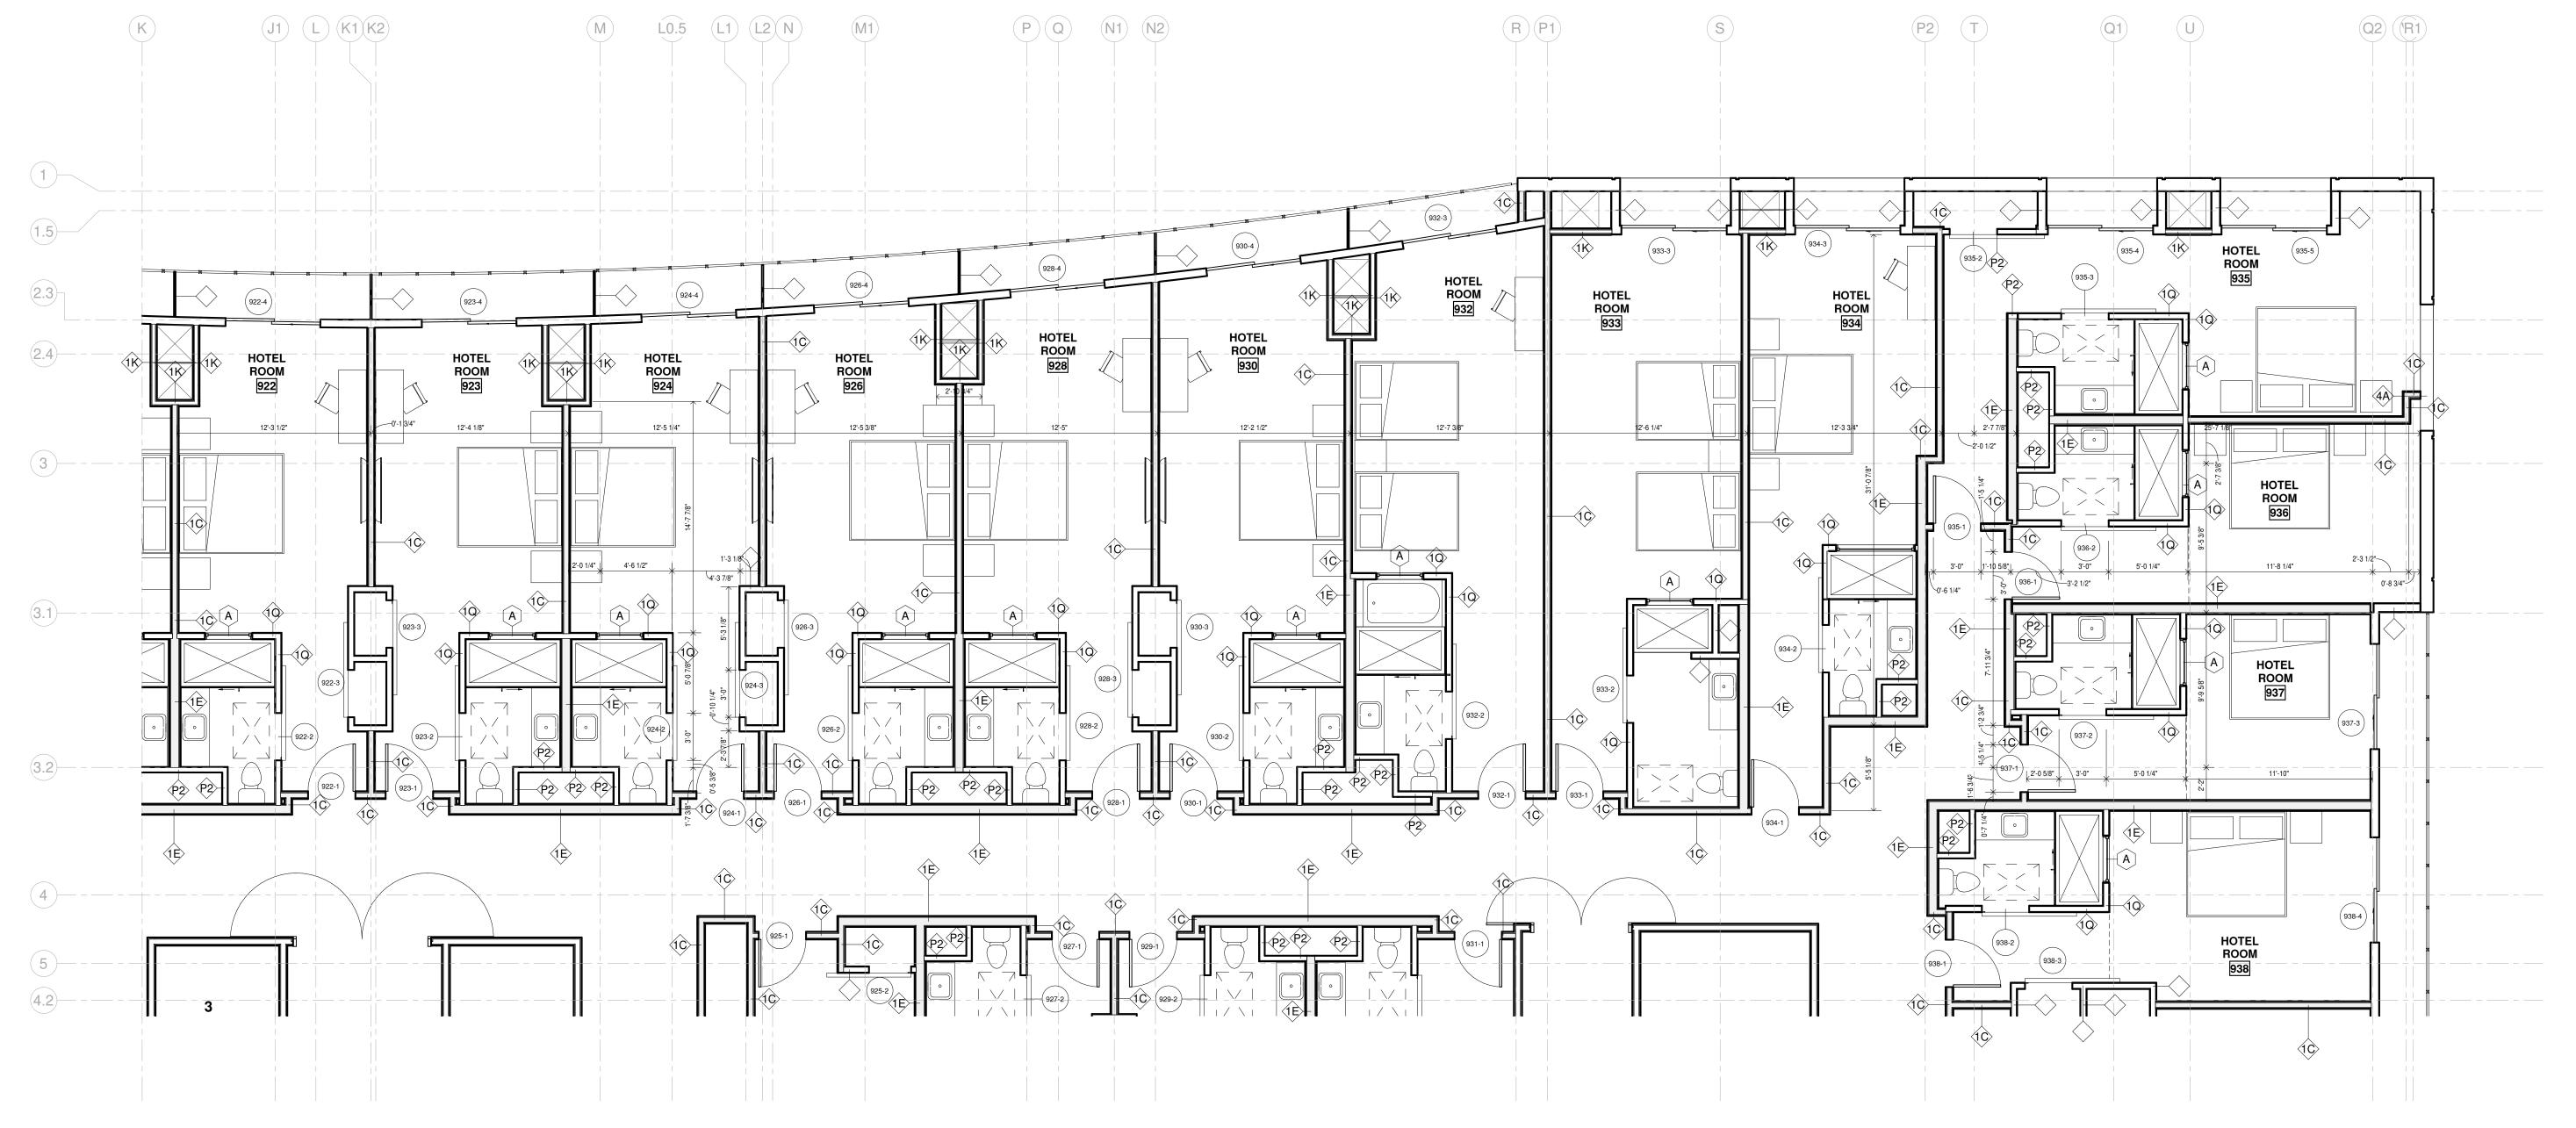

# SYMBOLS LEGEND

**ROOM TAG** NAME ROOM NAME FLOOR LEVELS 000 ROOM NUMBER

SHEET REFERENCE

(XX) DOOR TAG, SEE X WINDOW TAG, SEE

XX INTERIOR ELEVATION, SEE

XX PARTITION TYPE, SEE SHEET

CEILING FURR DOWN/PANELS 3HR. RATED FIRE PARTITION 2HR. RATED FIRE PARTITION

1HR. RATED FIRE PARTITION 2-A:20-B:C FIRE EXTINGUISHER IN RECESSED CABINET, MOUNTING HEIGHT 60" (MAX.) AFF TO TOP

EXTINGUISHER 2-A:20-B:C SURFACED MOUNTED, MOUNTING HEIGHT 60" (MAX.) AFF TO TOP EXTINGUISHER ADA 30"x48" CLEAR FLOOR SPACE

9TH FLOOR HOTEL - ENLARGED PLAN B

SCALE: 3/16" = 1'-0"



**ROOM TAG** ROOM NAME SHEET REFERENCE

FLOOR LEVELS ROOM NUMBER

(XX) DOOR TAG, SEE

WINDOW TAG, SEE XX INTERIOR ELEVATION, SEE

XX PARTITION TYPE, SEE SHEET CEILING FURR DOWN/PANELS

3HR. RATED FIRE PARTITION 1HR, RATED FIRE PARTITION 2-A:20-B:C FIRE EXTINGUISHER IN

RECESSED CABINET, MOUNTING HEIGHT 60" (MAX.) AFF TO TOP EXTINGUISHER 2-A:20-B:C SURFACED MOUNTED, MOUNTING HEIGHT 60" (MAX.) AFF TO TOP EXTINGUISHER ADA 30"x48" CLEAR FLOOR SPACE

9TH FLOOR HOTEL - ENLARGED PLAN C SCALE: 3/16" = 1'-0"


189 Maple Ridge Drive Metairie, LA 70001 (504)-885-4477 central@hbsaii.com :-: hbsaii.com SINCE 1961


1031 CANAL STREET NEW ORLEANS, LOUISIANA

BEEN PREPARED BY ME OR UNDER MY CLOSE PERSONAL SUPERVISION AND TO THE BEST OF MY KNOWLEDGE AND BELIEF THEY COMPLY WITH ALL CITY, STATE AND FEDERAL REQUIREMENTS, AND I AM NOT PROVIDING CONTRACT ADMINISTRATION. CERTIFIED CORRECT



REVISION HISTORY

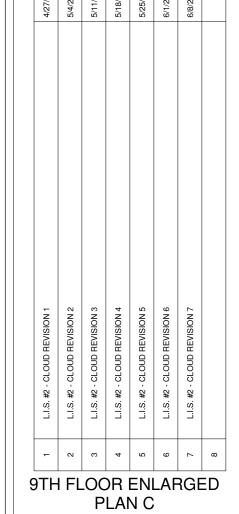

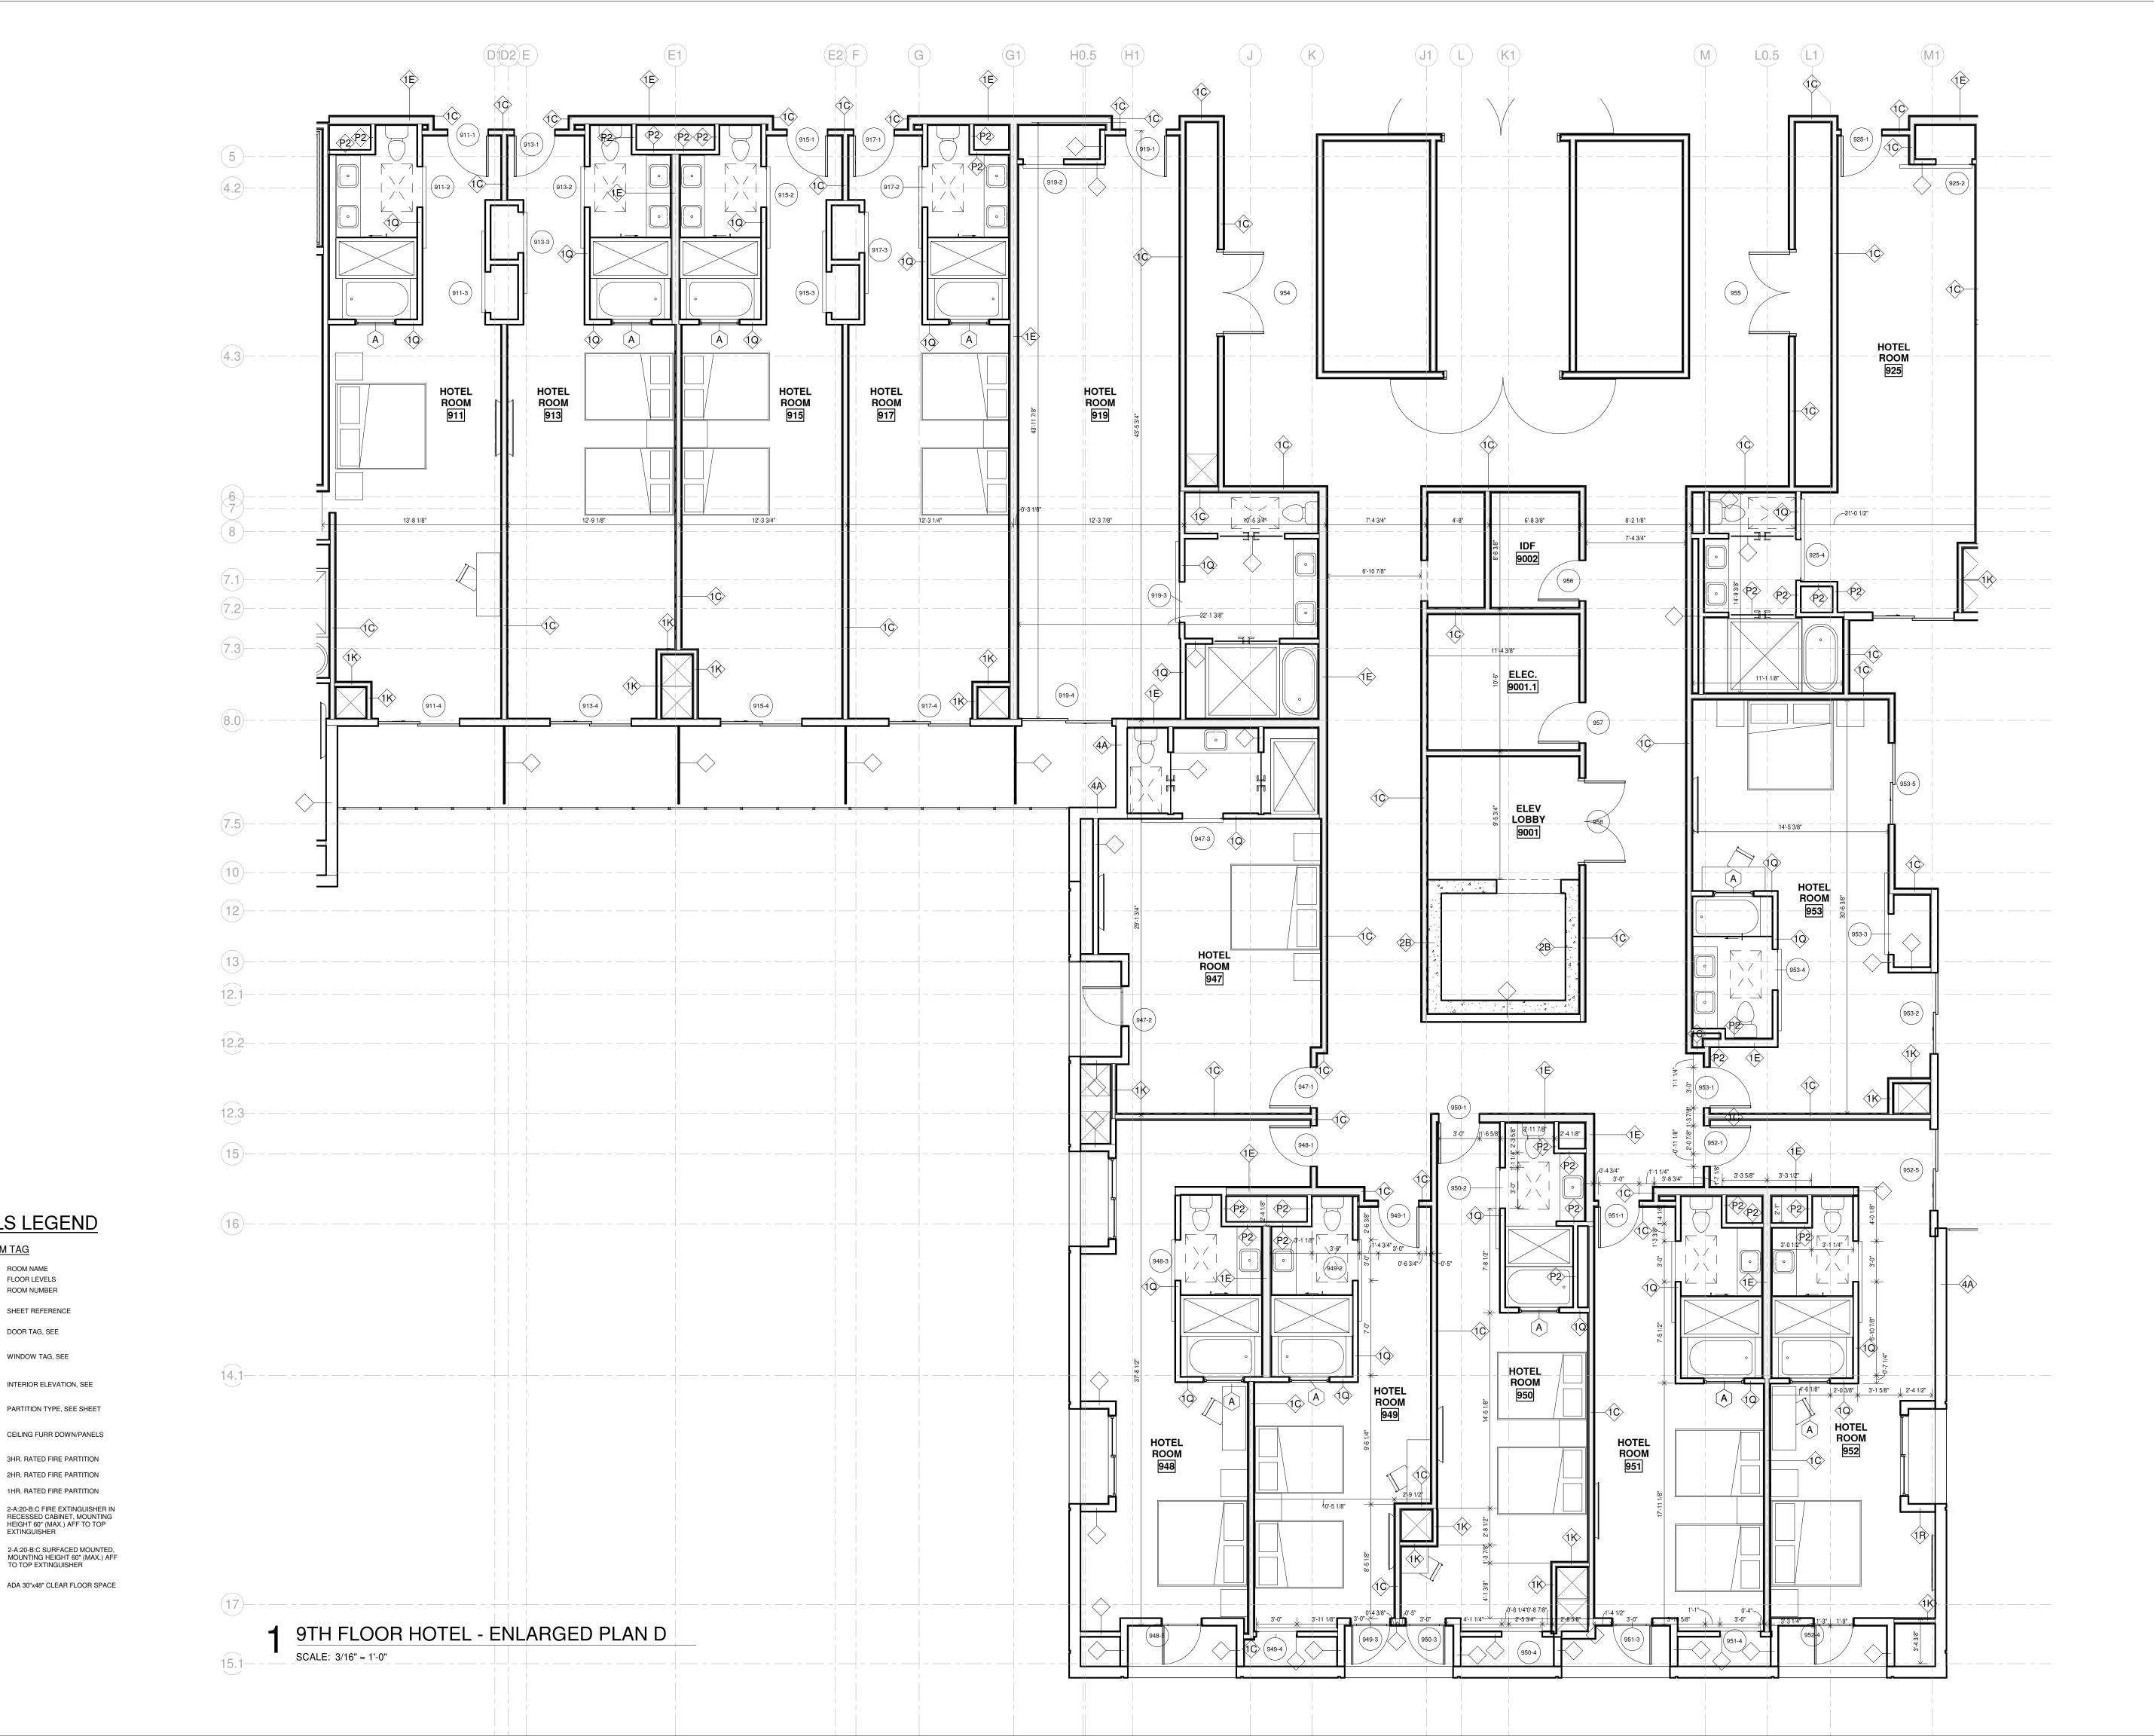

SYMBOLS LEGEND

FLOOR LEVELS

ROOM NUMBER

DOOR TAG, SEE

XX INTERIOR ELEVATION, SEE

XX — PARTITION TYPE, SEE SHEET

CEILING FURR DOWN/PANELS

2-A:20-B:C FIRE EXTINGUISHER IN RECESSED CABINET, MOUNTING HEIGHT 60" (MAX.) AFF TO TOP EXTINGUISHER

SHEET REFERENCE

WINDOW TAG, SEE

**ROOM TAG** 

000

189 Maple Ridge Drive Metairie, LA 70001 (504)-885-4477 central@hbsaii.com :-: hbsaii.com SINCE 1961

1031 CANAL STREET NEW ORLEANS, LOUISIANA

CERTIFIED CORRECT

REVISION HISTORY

9TH FLOOR HOTEL ENLARGED PLAN D

9TH FLOOR HOTEL - ENLARGED PLAN E

SCALE: 3/16" = 1'-0"

# SYMBOLS LEGEND

**ROOM TAG** 

NAME ROOM NAME 0-17 FLOOR LEVELS FLOOR LEVELS ROOM NUMBER

SHEET REFERENCE XX DOOR TAG, SEE

WINDOW TAG, SEE XX INTERIOR ELEVATION, SEE

XX PARTITION TYPE, SEE SHEET CEILING FURR DOWN/PANELS

3HR. RATED FIRE PARTITION 2HR. RATED FIRE PARTITION

1HR. RATED FIRE PARTITION 2-A:20-B:C FIRE EXTINGUISHER IN RECESSED CABINET, MOUNTING HEIGHT 60" (MAX.) AFF TO TOP EXTINGUISHER

2-A:20-B:C SURFACED MOUNTED, MOUNTING HEIGHT 60" (MAX.) AFF TO TOP EXTINGUISHER ADA 30"x48" CLEAR FLOOR SPACE

189 Maple Ridge Drive Metairie, LA 70001 (504)-885-4477 central@hbsaii.com :-: hbsaii.com SINCE 1961


1031 CANAL STREET NEW ORLEANS, LOUISIANA

THESE PLANS AND SPECIFICATIONS HAVE BEEN PREPARED BY ME OR UNDER MY CLOSE PERSONAL SUPERVISION AND TO THE BEST OF MY KNOWLEDGE AND BELIEF THEY COMPLY WITH ALL CITY, STATE AND FEDERAL REQUIREMENTS, AND I AM NOT PROVIDING CONTRACT ADMINISTRATION. CERTIFIED CORRECT



| _ | <u></u>               |                       | EVIS<br><u>8</u>      |                       | HIS                   |                       |                       |  |
|---|-----------------------|-----------------------|-----------------------|-----------------------|-----------------------|-----------------------|-----------------------|--|
|   | 4/27/2018             | 5/4/2018              | 5/11/2018             | 5/18/2018             | 5/25/2018             | 6/1/2018              | 6/8/2018              |  |
|   |                       |                       |                       |                       |                       |                       |                       |  |
|   | #2 - CLOUD REVISION 1 | #2 - CLOUD REVISION 2 | #2 - CLOUD REVISION 3 | #2 - CLOUD REVISION 4 | #2 - CLOUD REVISION 5 | #2 - CLOUD REVISION 6 | #2 - CLOUD REVISION 7 |  |


- 2 C 4 G 9 L 8 9TH FLOOR HOTEL -ENLARGED PLAN E

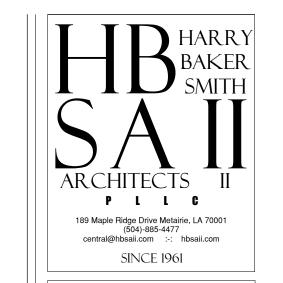

1031 CANAL STREET NEW ORLEANS, LOUISIANA

THESE PLANS AND SPECIFICATIONS HAVE BEEN PREPARED BY ME OR UNDER MY CLOSE PERSONAL SUPERVISION AND TO THE BEST OF MY KNOWLEDGE AND BELIEF THEY COMPLY WITH ALL CITY, STATE AND FEDERAL REQUIREMENTS, AND I AM NOT PROVIDING CONTRACT ADMINISTRATION. CERTIFIED CORRECT



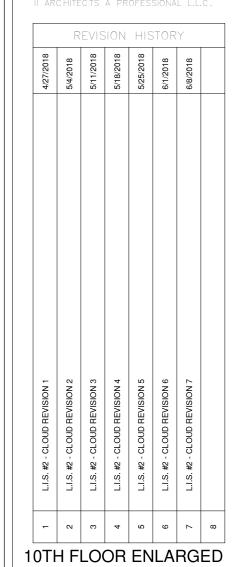

PLAN A PROJECT#: 1709 PHASE: DD TEAM: Author CHECKER: Checker

SCALE: AS NOTED ISSUED: 4/20/2018

SYMBOLS LEGEND

**ROOM TAG** NAME ROOM NAME 0-17 FLOOR LEVELS
000 ROOM NUMBER SHEET REFERENCE

XX DOOR TAG, SEE

WINDOW TAG, SEE

XX INTERIOR ELEVATION, SEE XX — PARTITION TYPE, SEE SHEET

CEILING FURR DOWN/PANELS 3HR. RATED FIRE PARTITION 2HR. RATED FIRE PARTITION


> 1HR. RATED FIRE PARTITION 2-A:20-B:C FIRE EXTINGUISHER IN RECESSED CABINET, MOUNTING HEIGHT 60" (MAX.) AFF TO TOP EXTINGUISHER

2-A:20-B:C SURFACED MOUNTED, MOUNTING HEIGHT 60" (MAX.) AFF TO TOP EXTINGUISHER

ADA 30"x48" CLEAR FLOOR SPACE

10TH FLOOR HOTEL - ENLARGED PLAN A

SCALE: 3/16" = 1'-0"

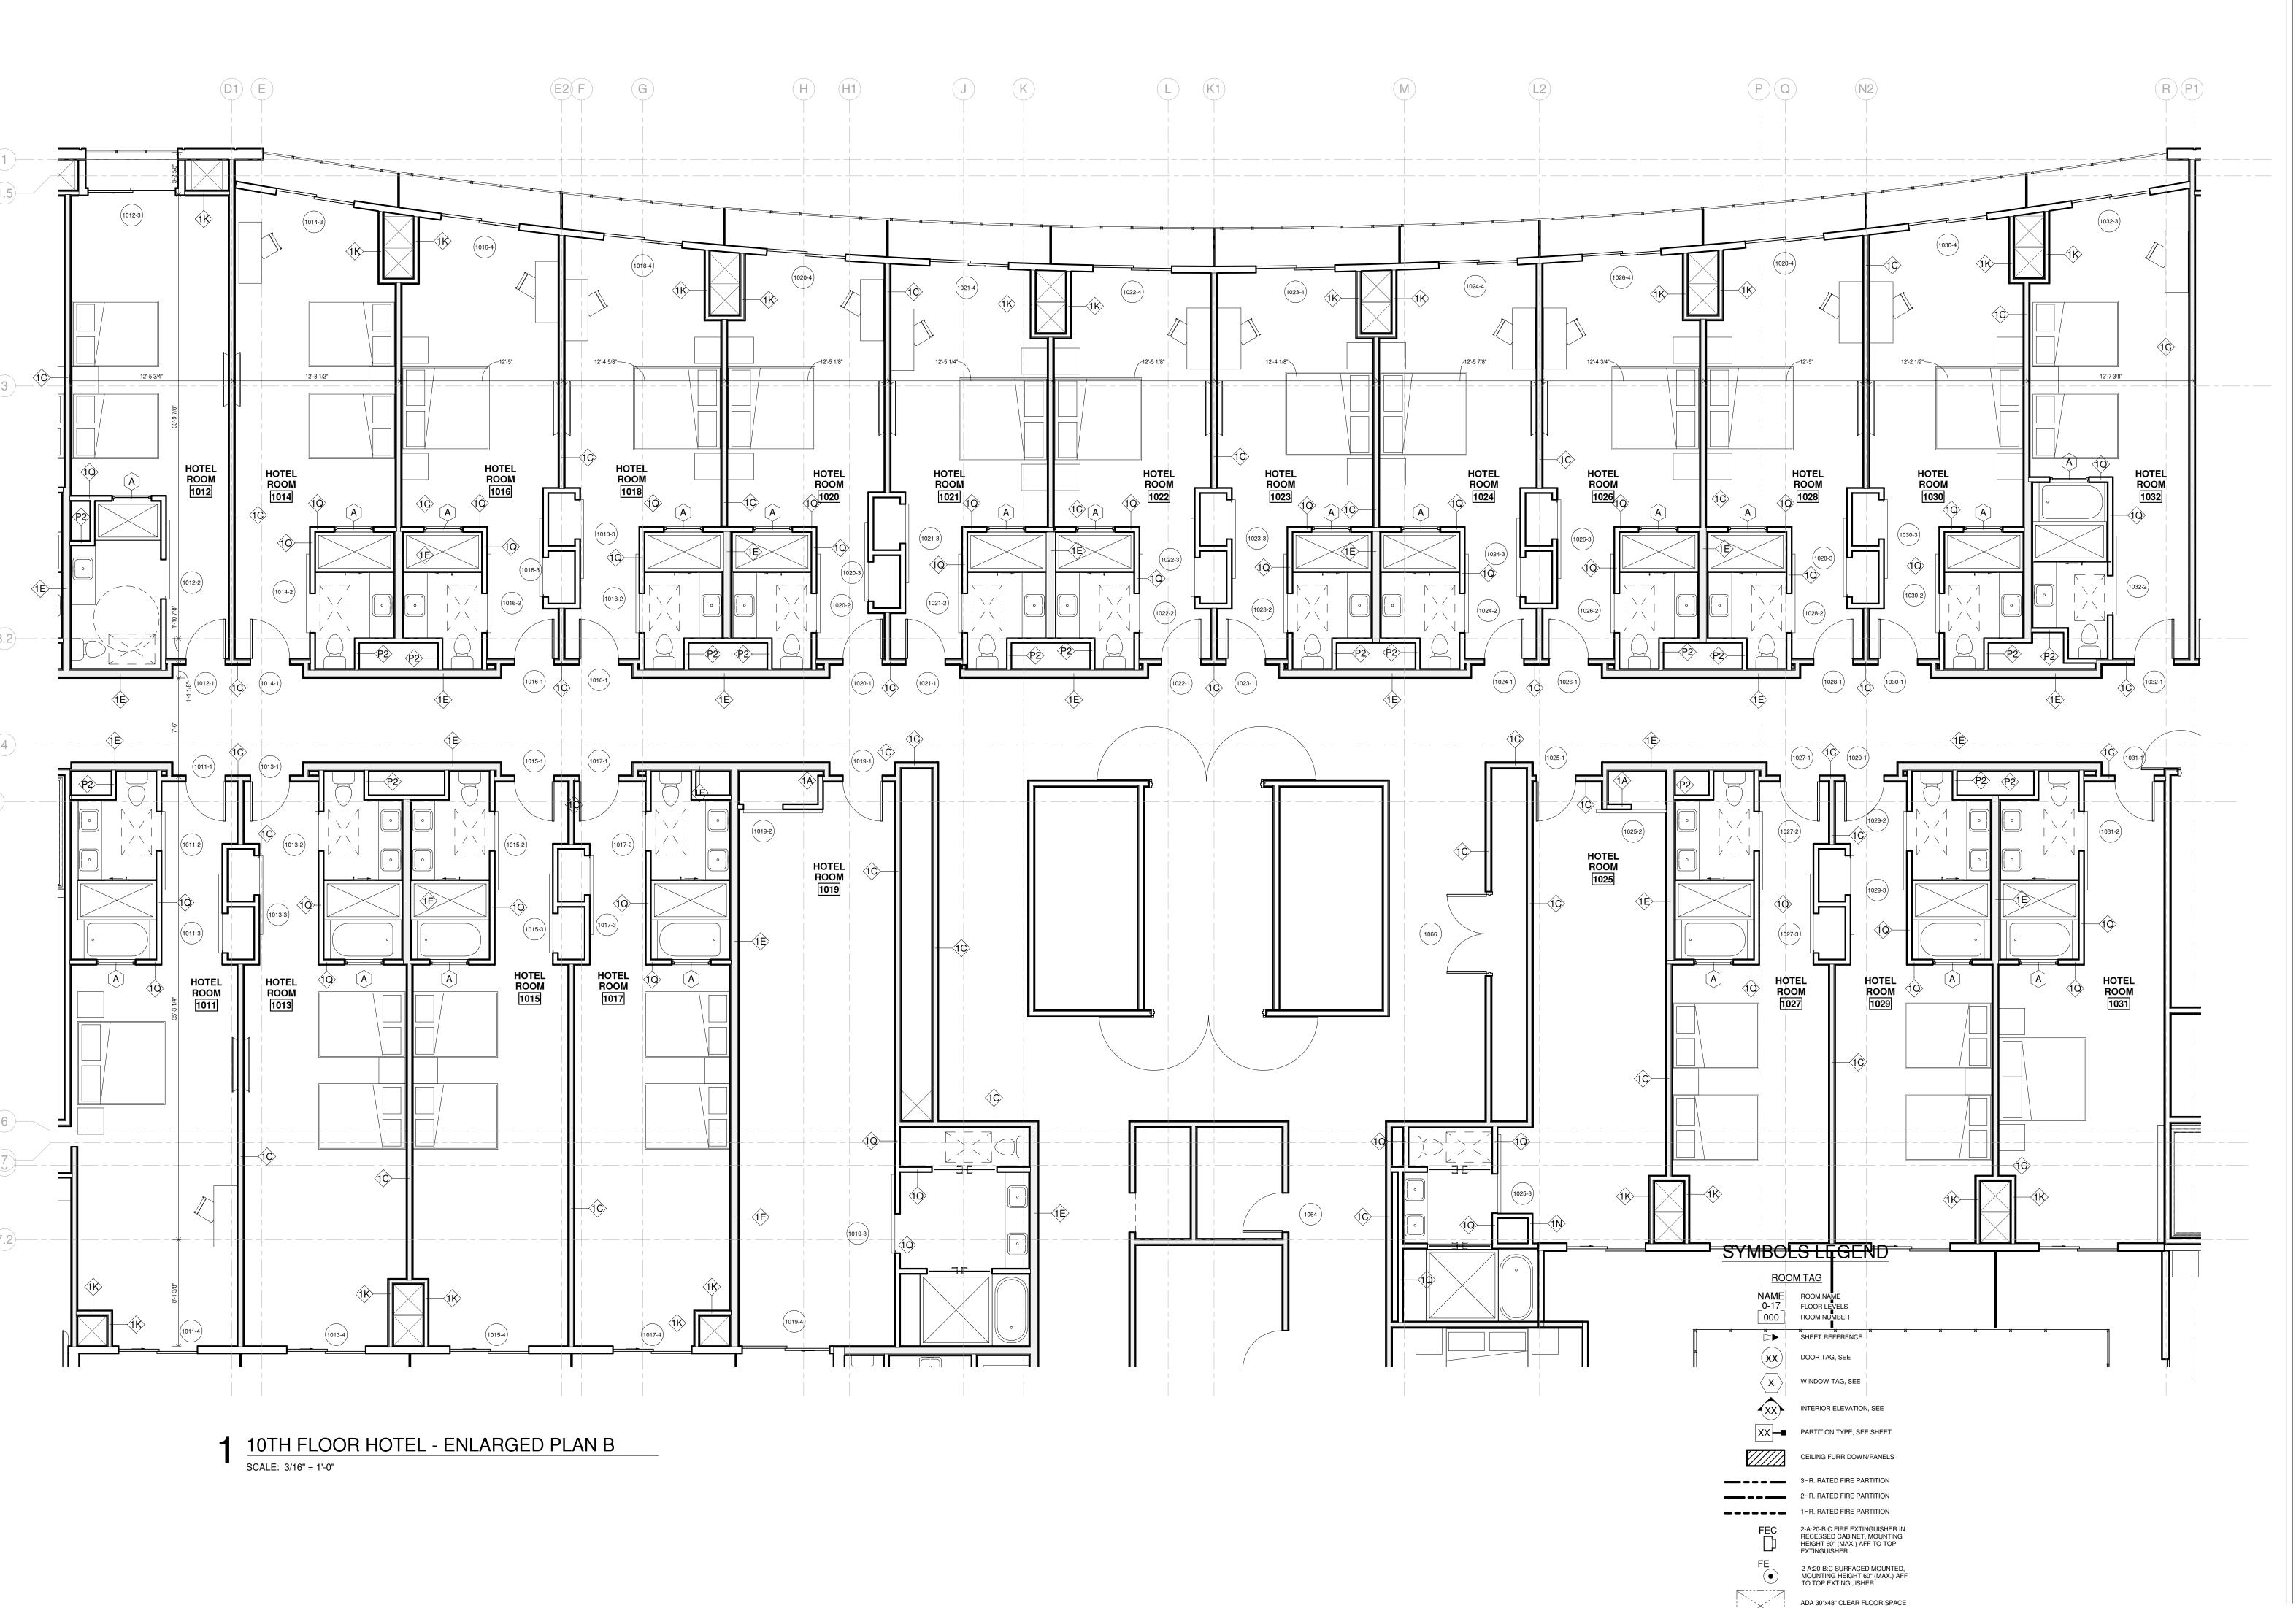

HARRY
BAKER
SMITH
SMITH
ARCHITECTS II
P L C

189 Maple Ridge Drive Metairie, LA 70001
(504)-885-4477
central@hbsaii.com :: hbsaii.com
SINCE 1961

HARD ROCK HOTE

THIS DRAWING IS CONFIDENTIAL AND NOT BE LOANED, REPRODUCED, COPIECE IN HERSEN WHITH AND AND TO AND BELIEF THEY COMPLY WITH ALL CITY.

THIS DRAWING IS CONFIDENTIAL AND NOT BE LOANED, REPRODUCED, COPIECE EITHER WHOLLY OR IN PART, OR MADE VIRITED CONSENSIONAL LL.C. ALL RIGHTS OF A PROFESSIONAL LL.C

 1.S. #2 - CLOUD REVISION 1

 1.S. #2 - CLOUD REVISION 2

 1.S. #2 - CLOUD REVISION 3
 5/14/2018

 1.S. #2 - CLOUD REVISION 4
 5/11/2018

 1.S. #2 - CLOUD REVISION 5
 6/11/2018

 1.S. #2 - CLOUD REVISION 6
 6/11/2018


 1.S. #2 - CLOUD REVISION 7
 6/8/2018

10TH FLOOR ENLARGED PLAN B

PROJECT#: 1709
PHASE: DD
TEAM: Author
CHECKER: Checker
SCALE: AS NOTED

A4.10.2

ISSUED: 4/20/2018

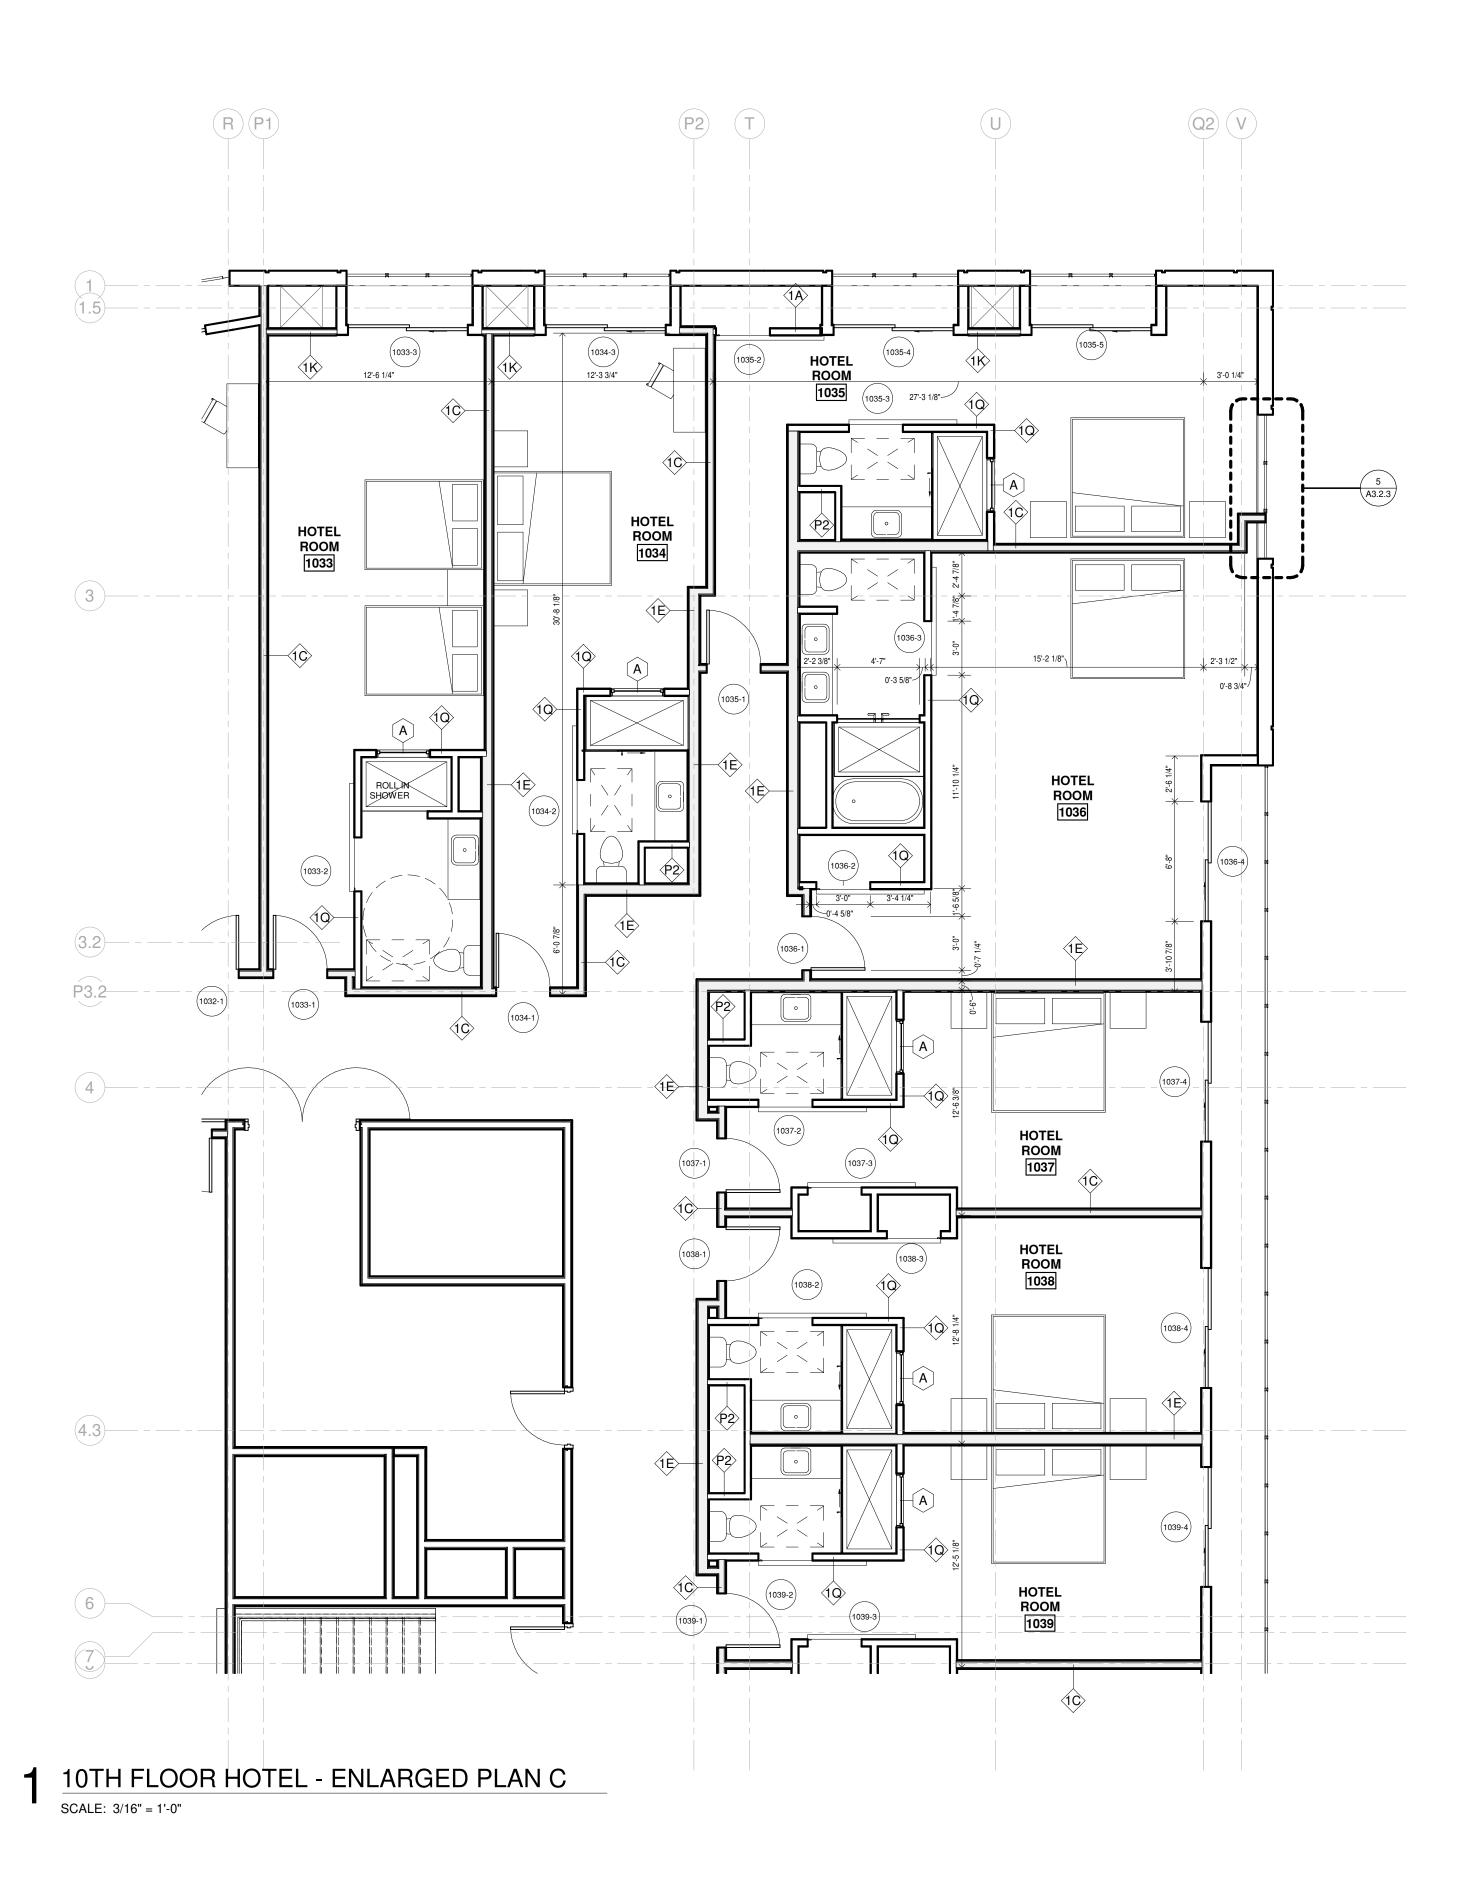



SYMBOLS LEGEND

ROOM TAG NAME ROOM NAME 0-17 FLOOR LEVELS
000 ROOM NUMBER SHEET REFERENCE (xx)DOOR TAG, SEE WINDOW TAG, SEE (XX) INTERIOR ELEVATION, SEE XX PARTITION TYPE, SEE SHEET CEILING FURR DOWN/PANELS 3HR. RATED FIRE PARTITION 1HR. RATED FIRE PARTITION

2-A:20-B:C FIRE EXTINGUISHER IN RECESSED CABINET, MOUNTING HEIGHT 60" (MAX.) AFF TO TOP EXTINGUISHER

2-A:20-B:C SURFACED MOUNTED, MOUNTING HEIGHT 60" (MAX.) AFF TO TOP EXTINGUISHER ADA 30"x48" CLEAR FLOOR SPACE

CHECKER: Checker SCALE: AS NOTED ISSUED: 4/20/2018

189 Maple Ridge Drive Metairie, LA 70001 (504)-885-4477 central@hbsaii.com :-: hbsaii.com SINCE 1961

1031 CANAL STREET NEW ORLEANS, LOUISIANA


THESE PLANS AND SPECIFICATIONS HAVE BEEN PREPARED BY ME OR UNDER MY CLOSE PERSONAL SUPERVISION AND TO THE BEST OF MY KNOWLEDGE AND BELIEF THEY COMPLY WITH ALL CITY, STATE AND FEDERAL REQUIREMENTS, AND I AM NOT PROVIDING CONTRACT ADMINISTRATION.

CERTIFIED CORRECT

REVISION HISTORY

PLAN C PROJECT#: 1709 PHASE: DD TEAM: Author

10TH FLOOR ENLARGED

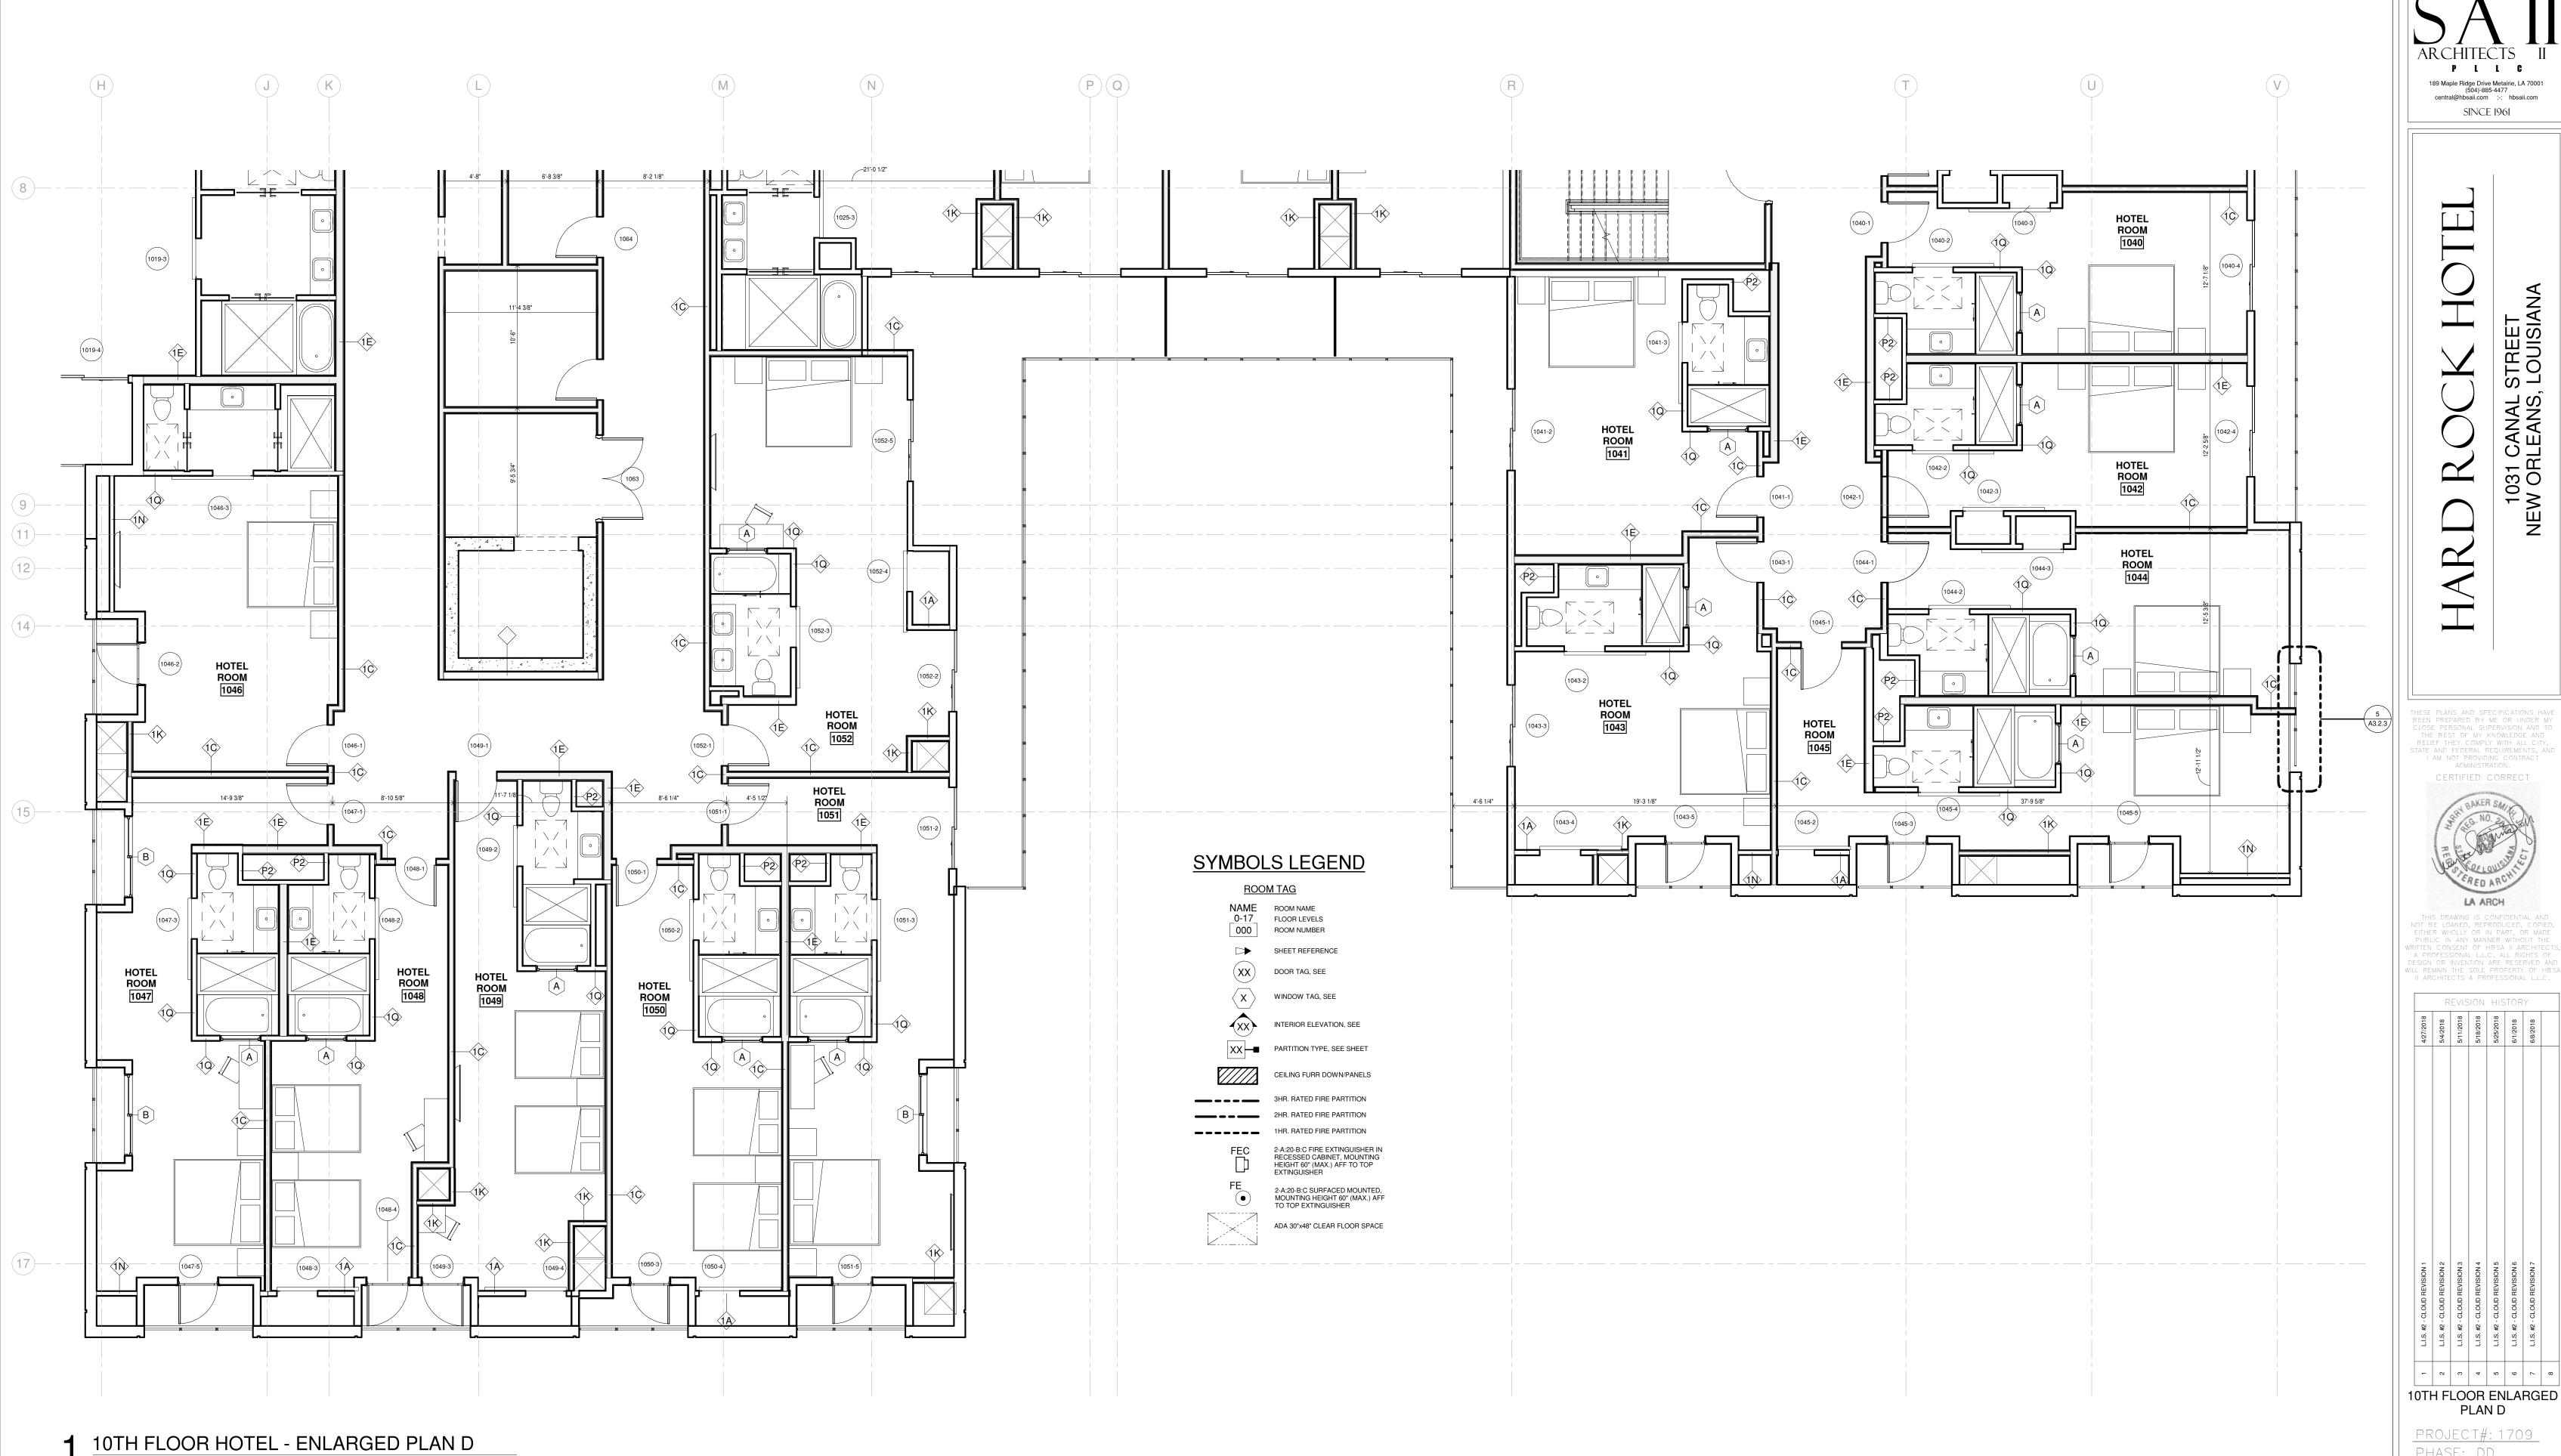

SCALE: 3/16" = 1'-0"

PHASE: DD TEAM: Author CHECKER: Checker SCALE: AS NOTED ISSUED: 4/20/2018

PLAN D

SINCE 1961

1031 CANAL STREET NEW ORLEANS, LOUISIANA

SYMBOLS LEGEND

FLOOR LEVELS

ROOM NUMBER

SHEET REFERENCE

DOOR TAG, SEE

WINDOW TAG, SEE

XX PARTITION TYPE, SEE SHEET

INTERIOR ELEVATION, SEE

CEILING FURR DOWN/PANELS

2HR. RATED FIRE PARTITION 1HR. RATED FIRE PARTITION

2-A:20-B:C FIRE EXTINGUISHER IN RECESSED CABINET, MOUNTING HEIGHT 60" (MAX.) AFF TO TOP EXTINGUISHER

2-A:20-B:C SURFACED MOUNTED, MOUNTING HEIGHT 60" (MAX.) AFF TO TOP EXTINGUISHER


ADA 30"x48" CLEAR FLOOR SPACE

SCALE: 3/16" = 1'-0"

**ROOM TAG** NAME ROOM NAME

(xx)

(XX)

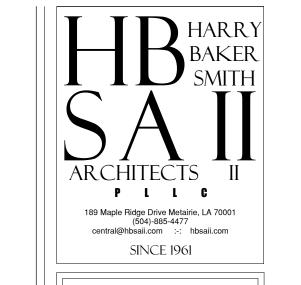

1031 CANAL STREET NEW ORLEANS, LOUISIANA

THESE PLANS AND SPECIFICATIONS HAVE BEEN PREPARED BY ME OR UNDER MY CLOSE PERSONAL SUPERVISION AND TO THE BEST OF MY KNOWLEDGE AND BELIEF THEY COMPLY WITH ALL CITY, STATE AND FEDERAL REQUIREMENTS, AND I AM NOT PROVIDING CONTRACT ADMINISTRATION. CERTIFIED CORRECT



REVISION HISTORY


| L.I.S. #2 - CLOUD REVISION 1 | L.I.S. #2 - CLOUD REVISION 2 | L.I.S. #2 - CLOUD REVISION 3 | L.I.S. #2 - CLOUD REVISION 4 | L.I.S. #2 - CLOUD REVISION 5 | L.I.S. #2 - CLOUD REVISION 6 | L.I.S. #2 - CLOUD REVISION 7 |  |
|------------------------------|------------------------------|------------------------------|------------------------------|------------------------------|------------------------------|------------------------------|--|
| L.I.S.                       |  |


PROJECT#: 1709 PHASE: DD TEAM: Author CHECKER: Checker

SCALE: AS NOTED

PLAN A


ISSUED: 4/20/2018

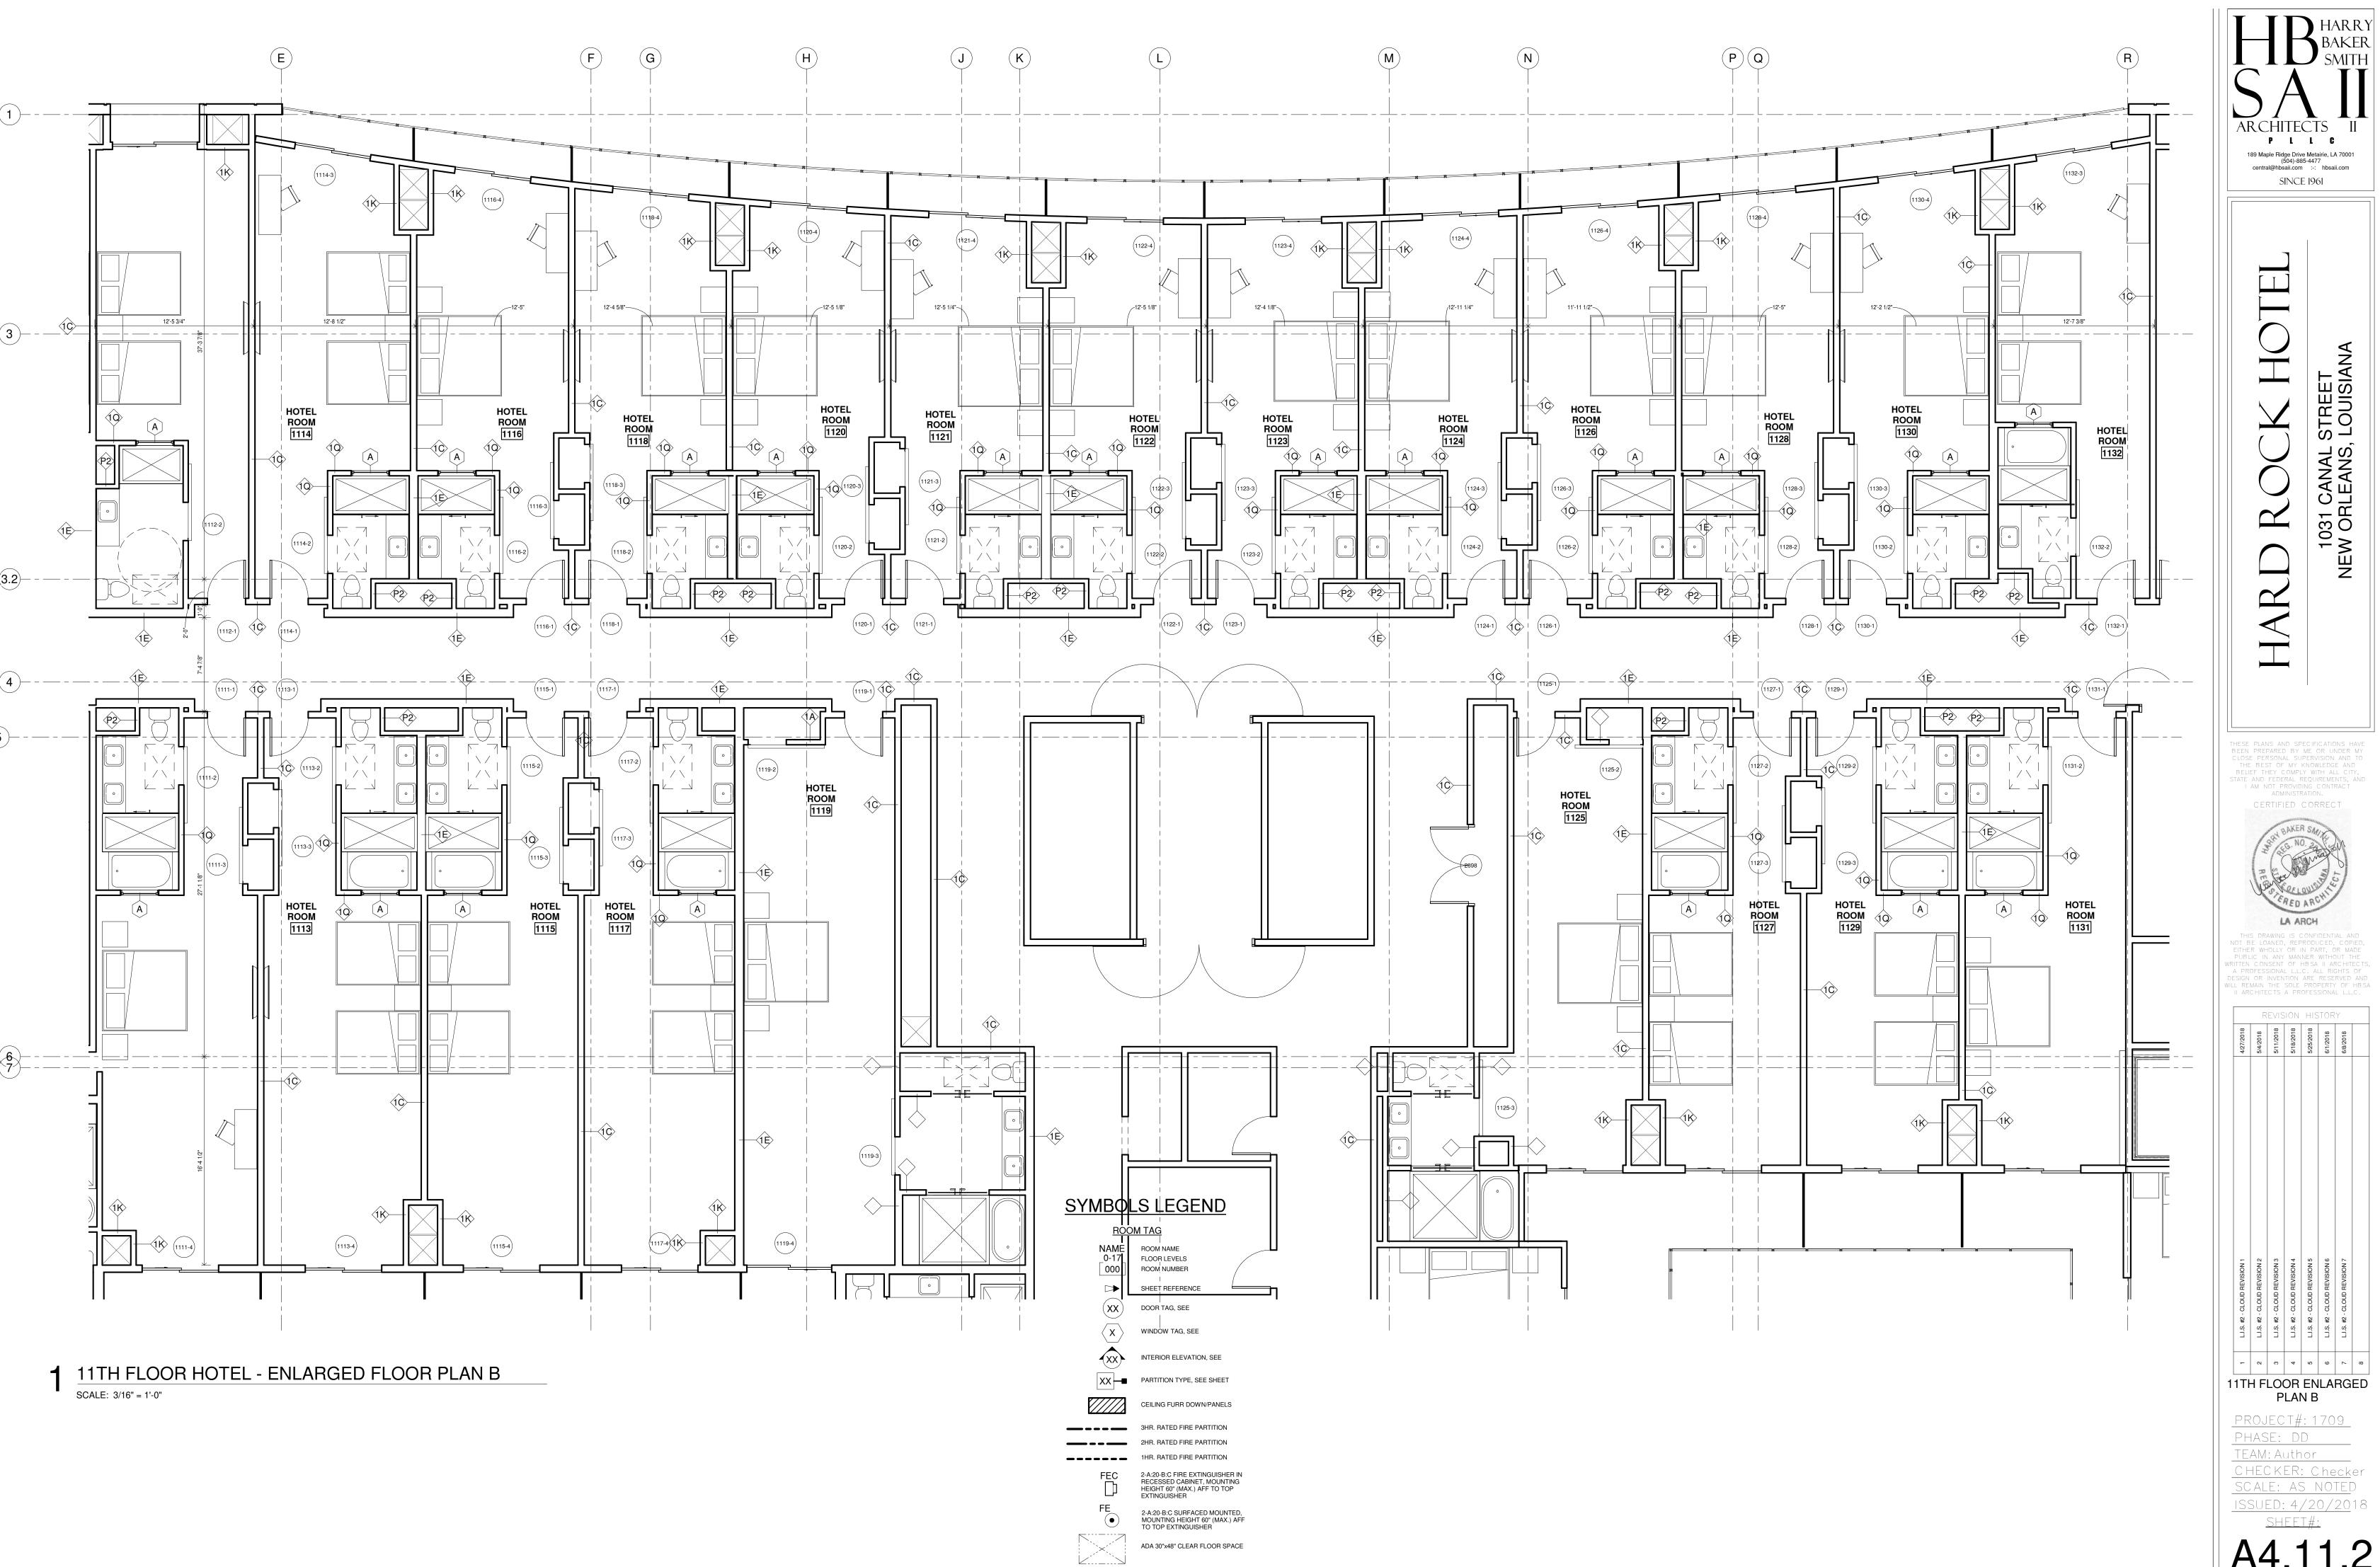

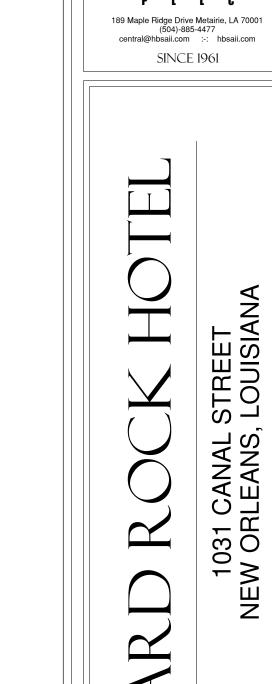


THESE PLANS AND SPECIFICATIONS HAVE BEEN PREPARED BY ME OR UNDER MY CLOSE PERSONAL SUPERVISION AND TO THE BEST OF MY KNOWLEDGE AND BELIEF THEY COMPLY WITH ALL CITY, STATE AND FEDERAL REQUIREMENTS, AND I AM NOT PROVIDING CONTRACT ADMINISTRATION. CERTIFIED CORRECT



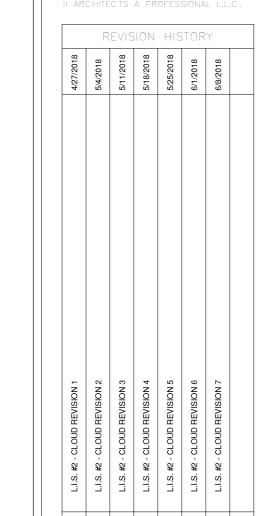

11TH FLOOR ENLARGED PLAN C PROJECT#: 1709 PHASE: DD

TEAM: Author CHECKER: Checker SCALE: AS NOTED ISSUED: 4/20/2018

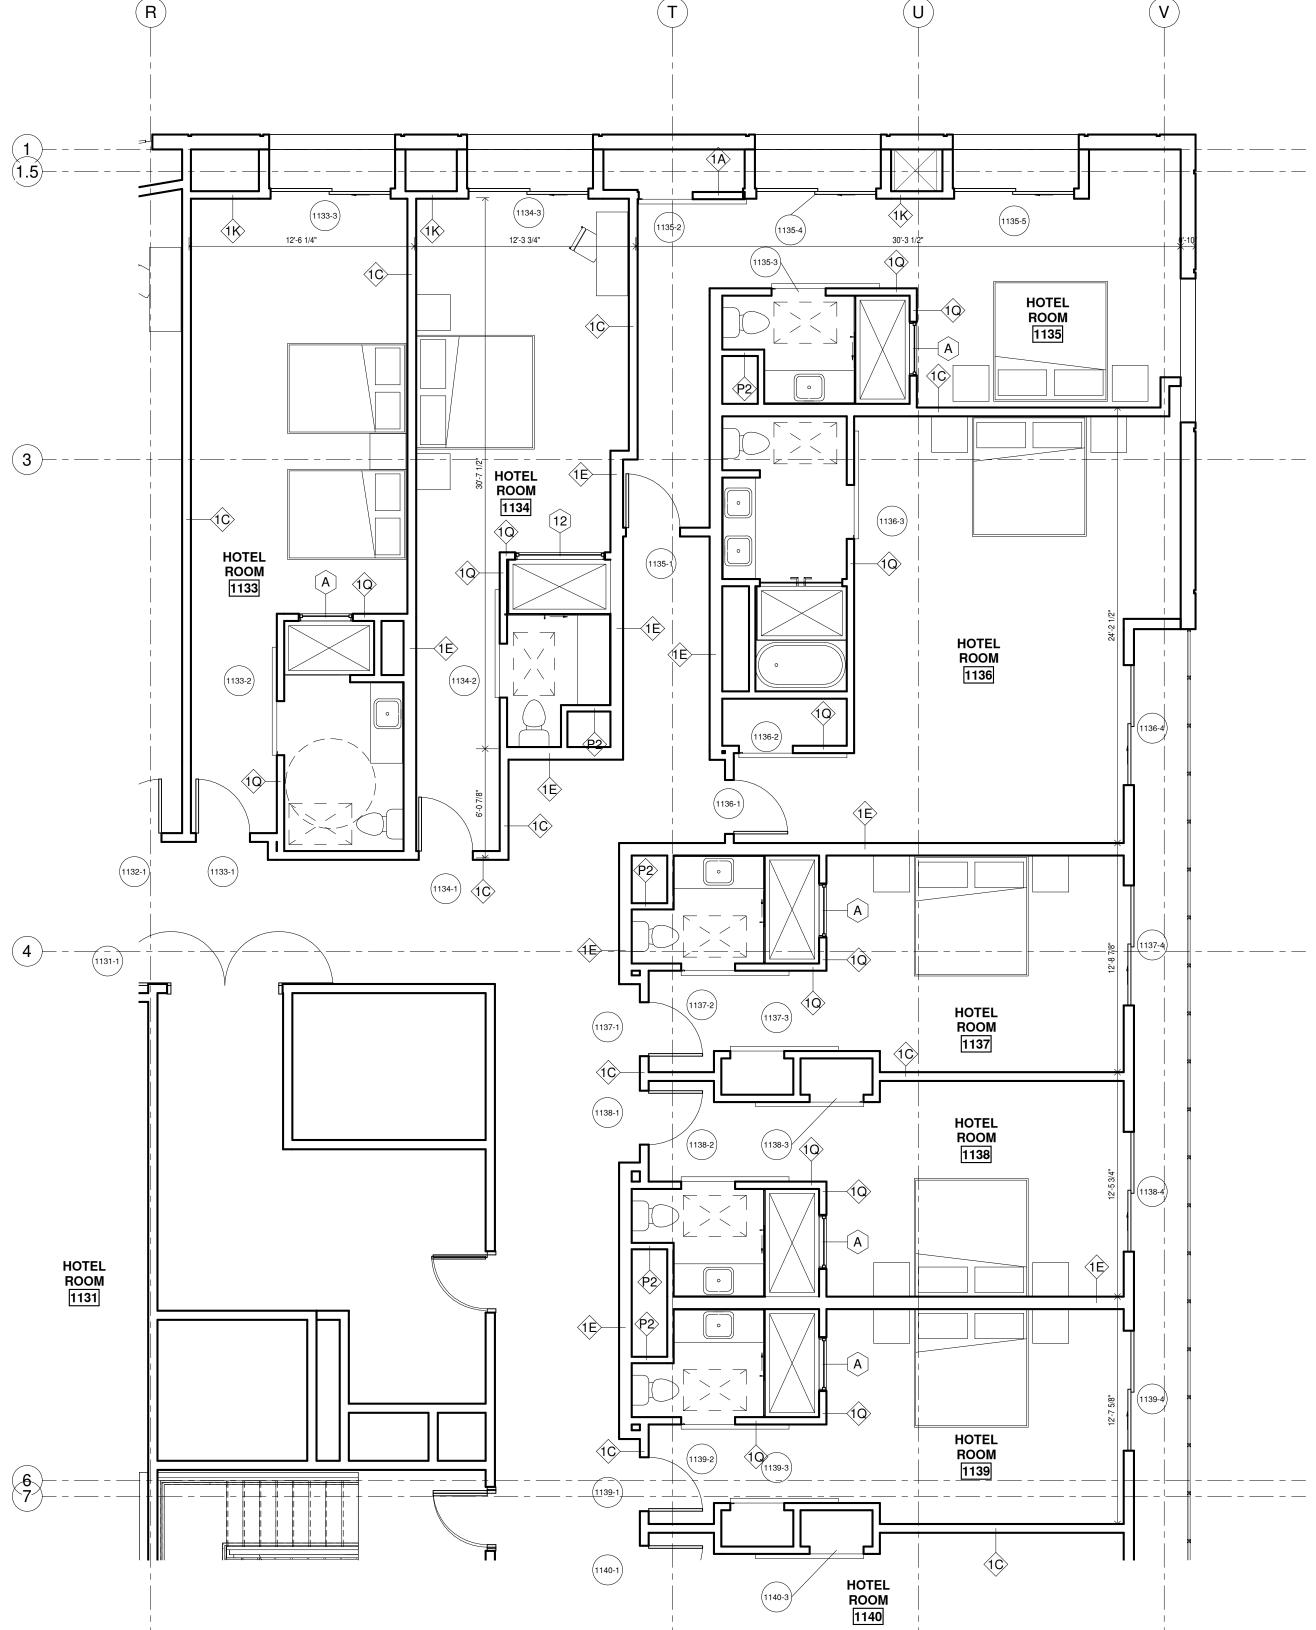

11TH FLOOR HOTEL - ENLARGED FLOOR PLAN C

SCALE: 3/16" = 1'-0"

## SYMBOLS LEGEND

ROOM TAG

NAME 0-17 FLOOR LEVELS ROOM NUMBE FLOOR LEVELS ROOM NUMBER

> SHEET REFERENCE (xx)DOOR TAG, SEE


WINDOW TAG, SEE (XX) INTERIOR ELEVATION, SEE

XX PARTITION TYPE, SEE SHEET CEILING FURR DOWN/PANELS

3HR. RATED FIRE PARTITION 1HR. RATED FIRE PARTITION

2-A:20-B:C FIRE EXTINGUISHER IN RECESSED CABINET, MOUNTING HEIGHT 60" (MAX.) AFF TO TOP EXTINGUISHER

2-A:20-B:C SURFACED MOUNTED, MOUNTING HEIGHT 60" (MAX.) AFF TO TOP EXTINGUISHER ADA 30"x48" CLEAR FLOOR SPACE

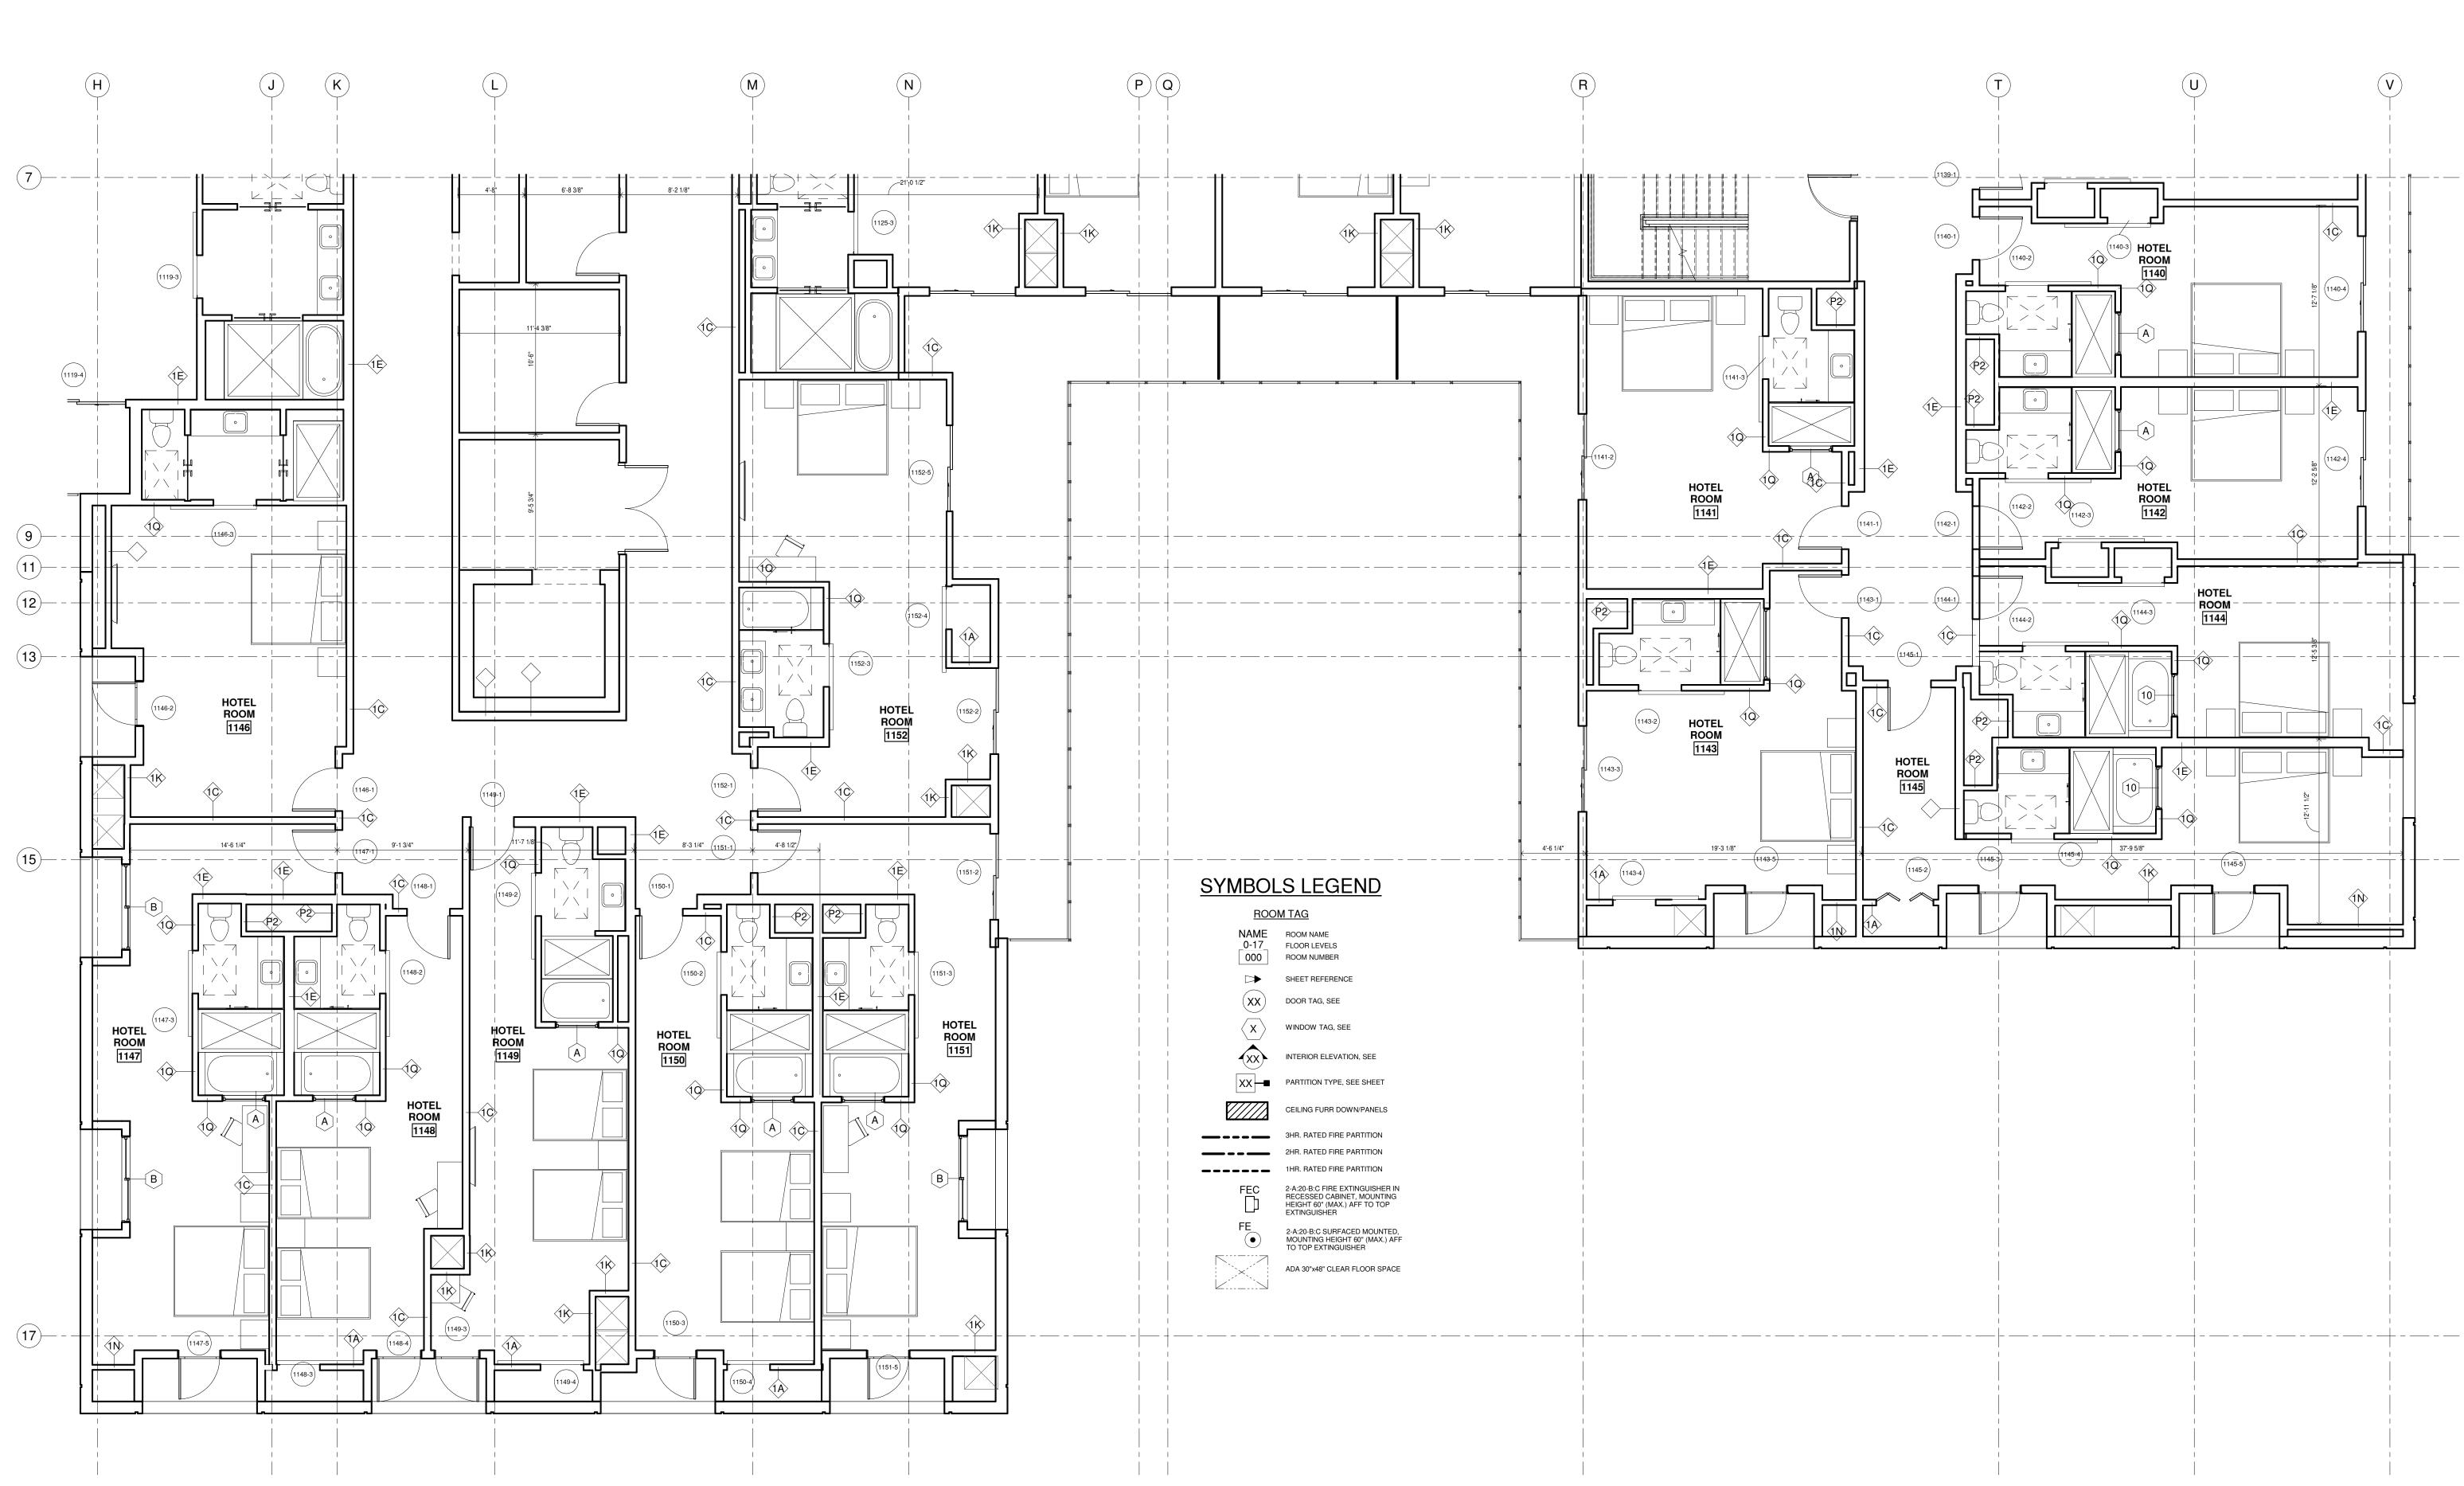

11TH FLOOR HOTEL - ENLARGED FLOOR PLAN D

SCALE: 3/16" = 1'-0"

189 Maple Ridge Drive Metairie, LA 70001 (504)-885-4477 central@hbsaii.com :-: hbsaii.com SINCE 1961 TATE AND FEDERAL REQUIREMENTS, AN I AM NOT PROVIDING CONTRACT ADMINISTRATION. CERTIFIED CORRECT REVISION HISTORY

L.I.S. #2 - CLOUD REVISION 1
L.I.S. #2 - CLOUD REVISION 2
L.I.S. #2 - CLOUD REVISION 3
L.I.S. #2 - CLOUD REVISION 4
L.I.S. #2 - CLOUD REVISION 6
L.I.S. #2 - CLOUD REVISION 6
L.I.S. #2 - CLOUD REVISION 7

11TH FLOOR ENLARGED PLAN D

PROJECT#: 1709

PHASE: DD


TEAM: Author

CHECKER: Checker

SCALE: AS NOTED


ISSUED: 4/20/2018

A4 11 4

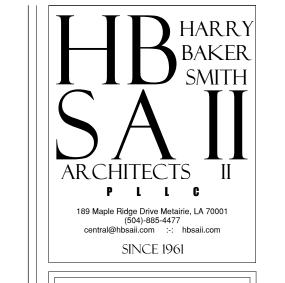

1031 CANAL STREET NEW ORLEANS, LOUISIANA

THESE PLANS AND SPECIFICATIONS HAVE BEEN PREPARED BY ME OR UNDER MY CLOSE PERSONAL SUPERVISION AND TO THE BEST OF MY KNOWLEDGE AND BELIEF THEY COMPLY WITH ALL CITY, STATE AND FEDERAL REQUIREMENTS, AND I AM NOT PROVIDING CONTRACT ADMINISTRATION. CERTIFIED CORRECT

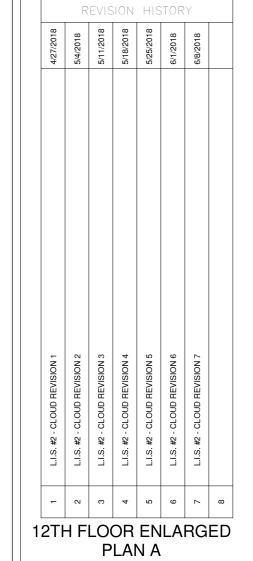

PROJECT#: 1709 PHASE: DD TEAM: Author CHECKER: Checker SCALE: AS NOTED

ISSUED: 4/20/2018

NAME ROOM NAME

0-17 FLOOR LEVELS FLOOR LEVELS 000 ROOM NUMBER SHEET REFERENCE (xx)DOOR TAG, SEE WINDOW TAG, SEE (XX) INTERIOR ELEVATION, SEE XX PARTITION TYPE, SEE SHEET CEILING FURR DOWN/PANELS

SYMBOLS LEGEND


**ROOM TAG** 

3HR. RATED FIRE PARTITION 2HR. RATED FIRE PARTITION 1HR. RATED FIRE PARTITION

2-A:20-B:C FIRE EXTINGUISHER IN RECESSED CABINET, MOUNTING HEIGHT 60" (MAX.) AFF TO TOP EXTINGUISHER

2-A:20-B:C SURFACED MOUNTED, MOUNTING HEIGHT 60" (MAX.) AFF TO TOP EXTINGUISHER ADA 30"x48" CLEAR FLOOR SPACE

SCALE: 3/16" = 1'-0"

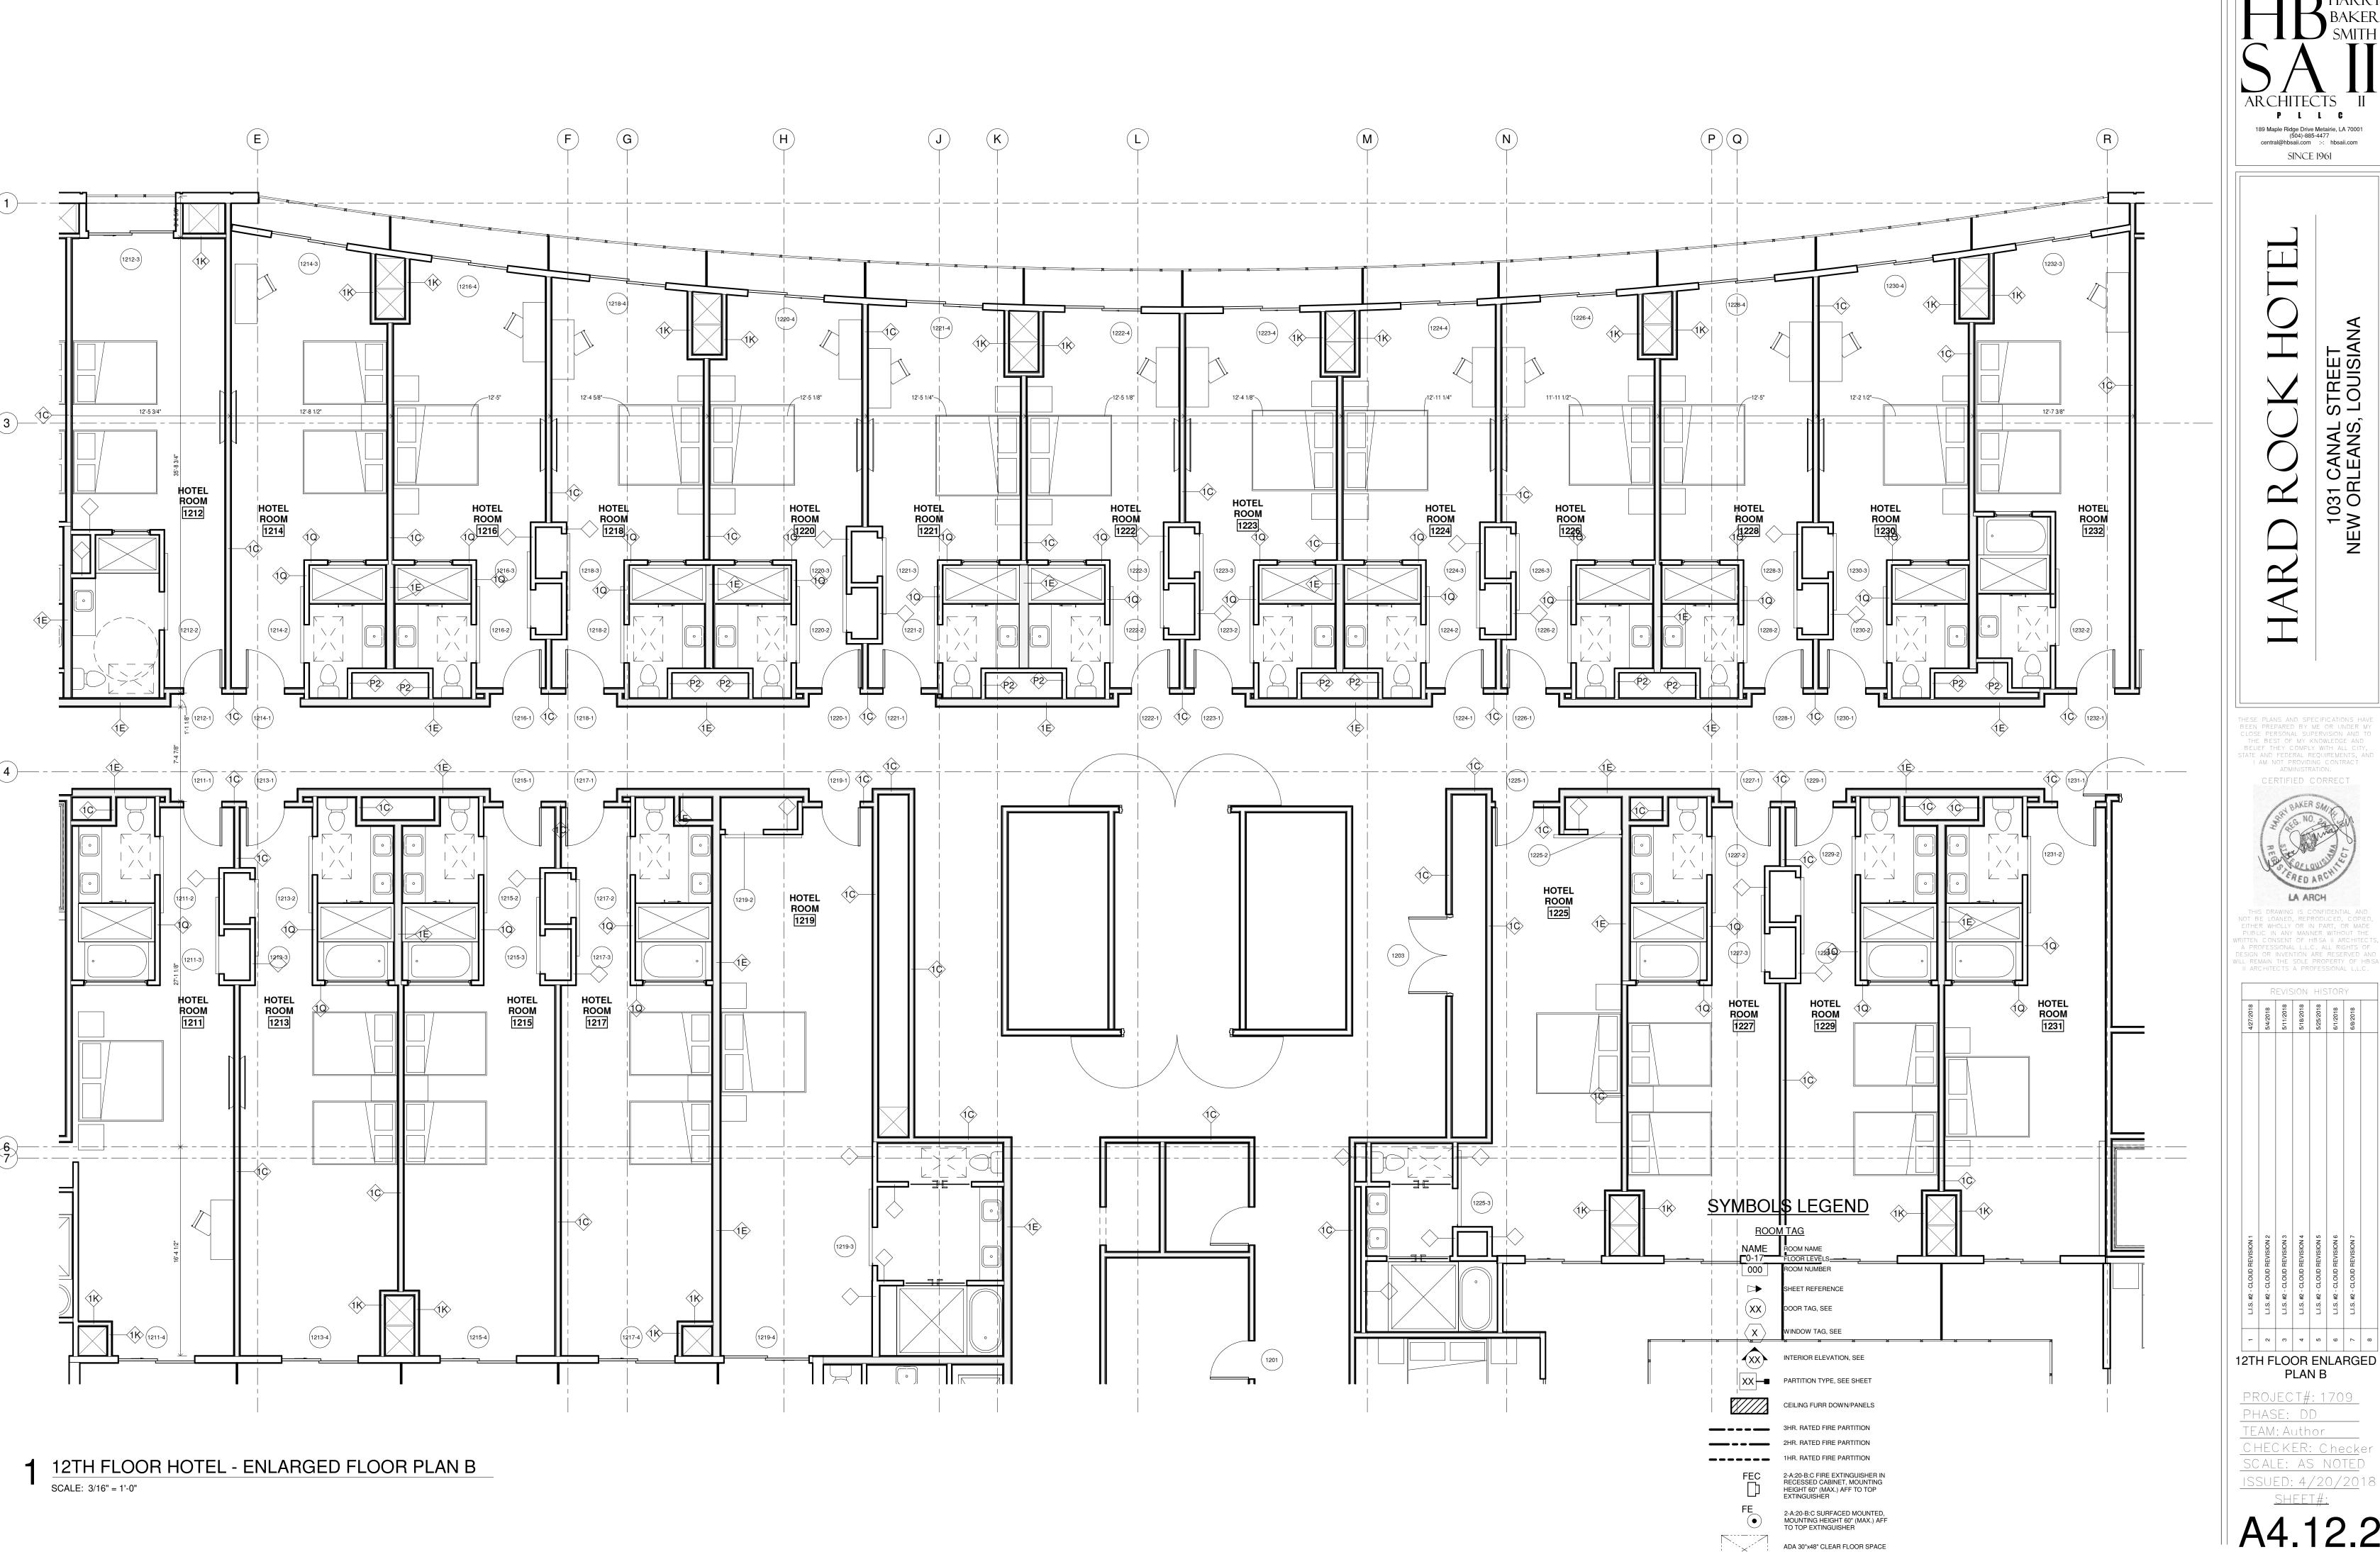

SINCE 1961

1031 CANAL STREET NEW ORLEANS, LOUISIANA

CERTIFIED CORRECT



REVISION HISTORY - N W 4 N W V W 12TH FLOOR ENLARGED

PLAN B PROJECT#: 1709 TEAM: Author CHECKER: Checker SCALE: AS NOTED



ROOM TAG

NAME ROOM NAME

0-17 FLOOR LEVELS FLOOR LEVELS 000 ROOM NUMBER

SHEET REFERENCE DOOR TAG, SEE

WINDOW TAG, SEE

XX INTERIOR ELEVATION, SEE

XX PARTITION TYPE, SEE SHEET CEILING FURR DOWN/PANELS

3HR. RATED FIRE PARTITION 2HR. RATED FIRE PARTITION

RECESSED CABINET, MOUNTING HEIGHT 60" (MAX.) AFF TO TOP EXTINGUISHER 2-A:20-B:C SURFACED MOUNTED, MOUNTING HEIGHT 60" (MAX.) AFF TO TOP EXTINGUISHER ADA 30"x48" CLEAR FLOOR SPACE


2-A:20-B:C FIRE EXTINGUISHER IN

12TH FLOOR HOTEL - ENLARGED FLOOR PLAN C SCALE: 3/16" = 1'-0"

189 Maple Ridge Drive Metairie, LA 70001 (504)-885-4477 central@hbsaii.com :-: hbsaii.com SINCE 1961


BEEN PREPARED BY ME OR UNDER MY
CLOSE PERSONAL SUPERVISION AND TO
THE BEST OF MY KNOWLEDGE AND
BELIEF THEY COMPLY WITH ALL CITY,
STATE AND FEDERAL REQUIREMENTS, AND
I AM NOT PROVIDING CONTRACT
ADMINISTRATION. CERTIFIED CORRECT



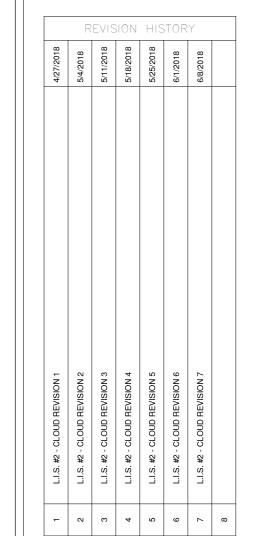

PLAN C PROJECT#: 1709 PHASE: DD TEAM: Author CHECKER: Checker SCALE: AS NOTED

12TH FLOOR ENLARGED

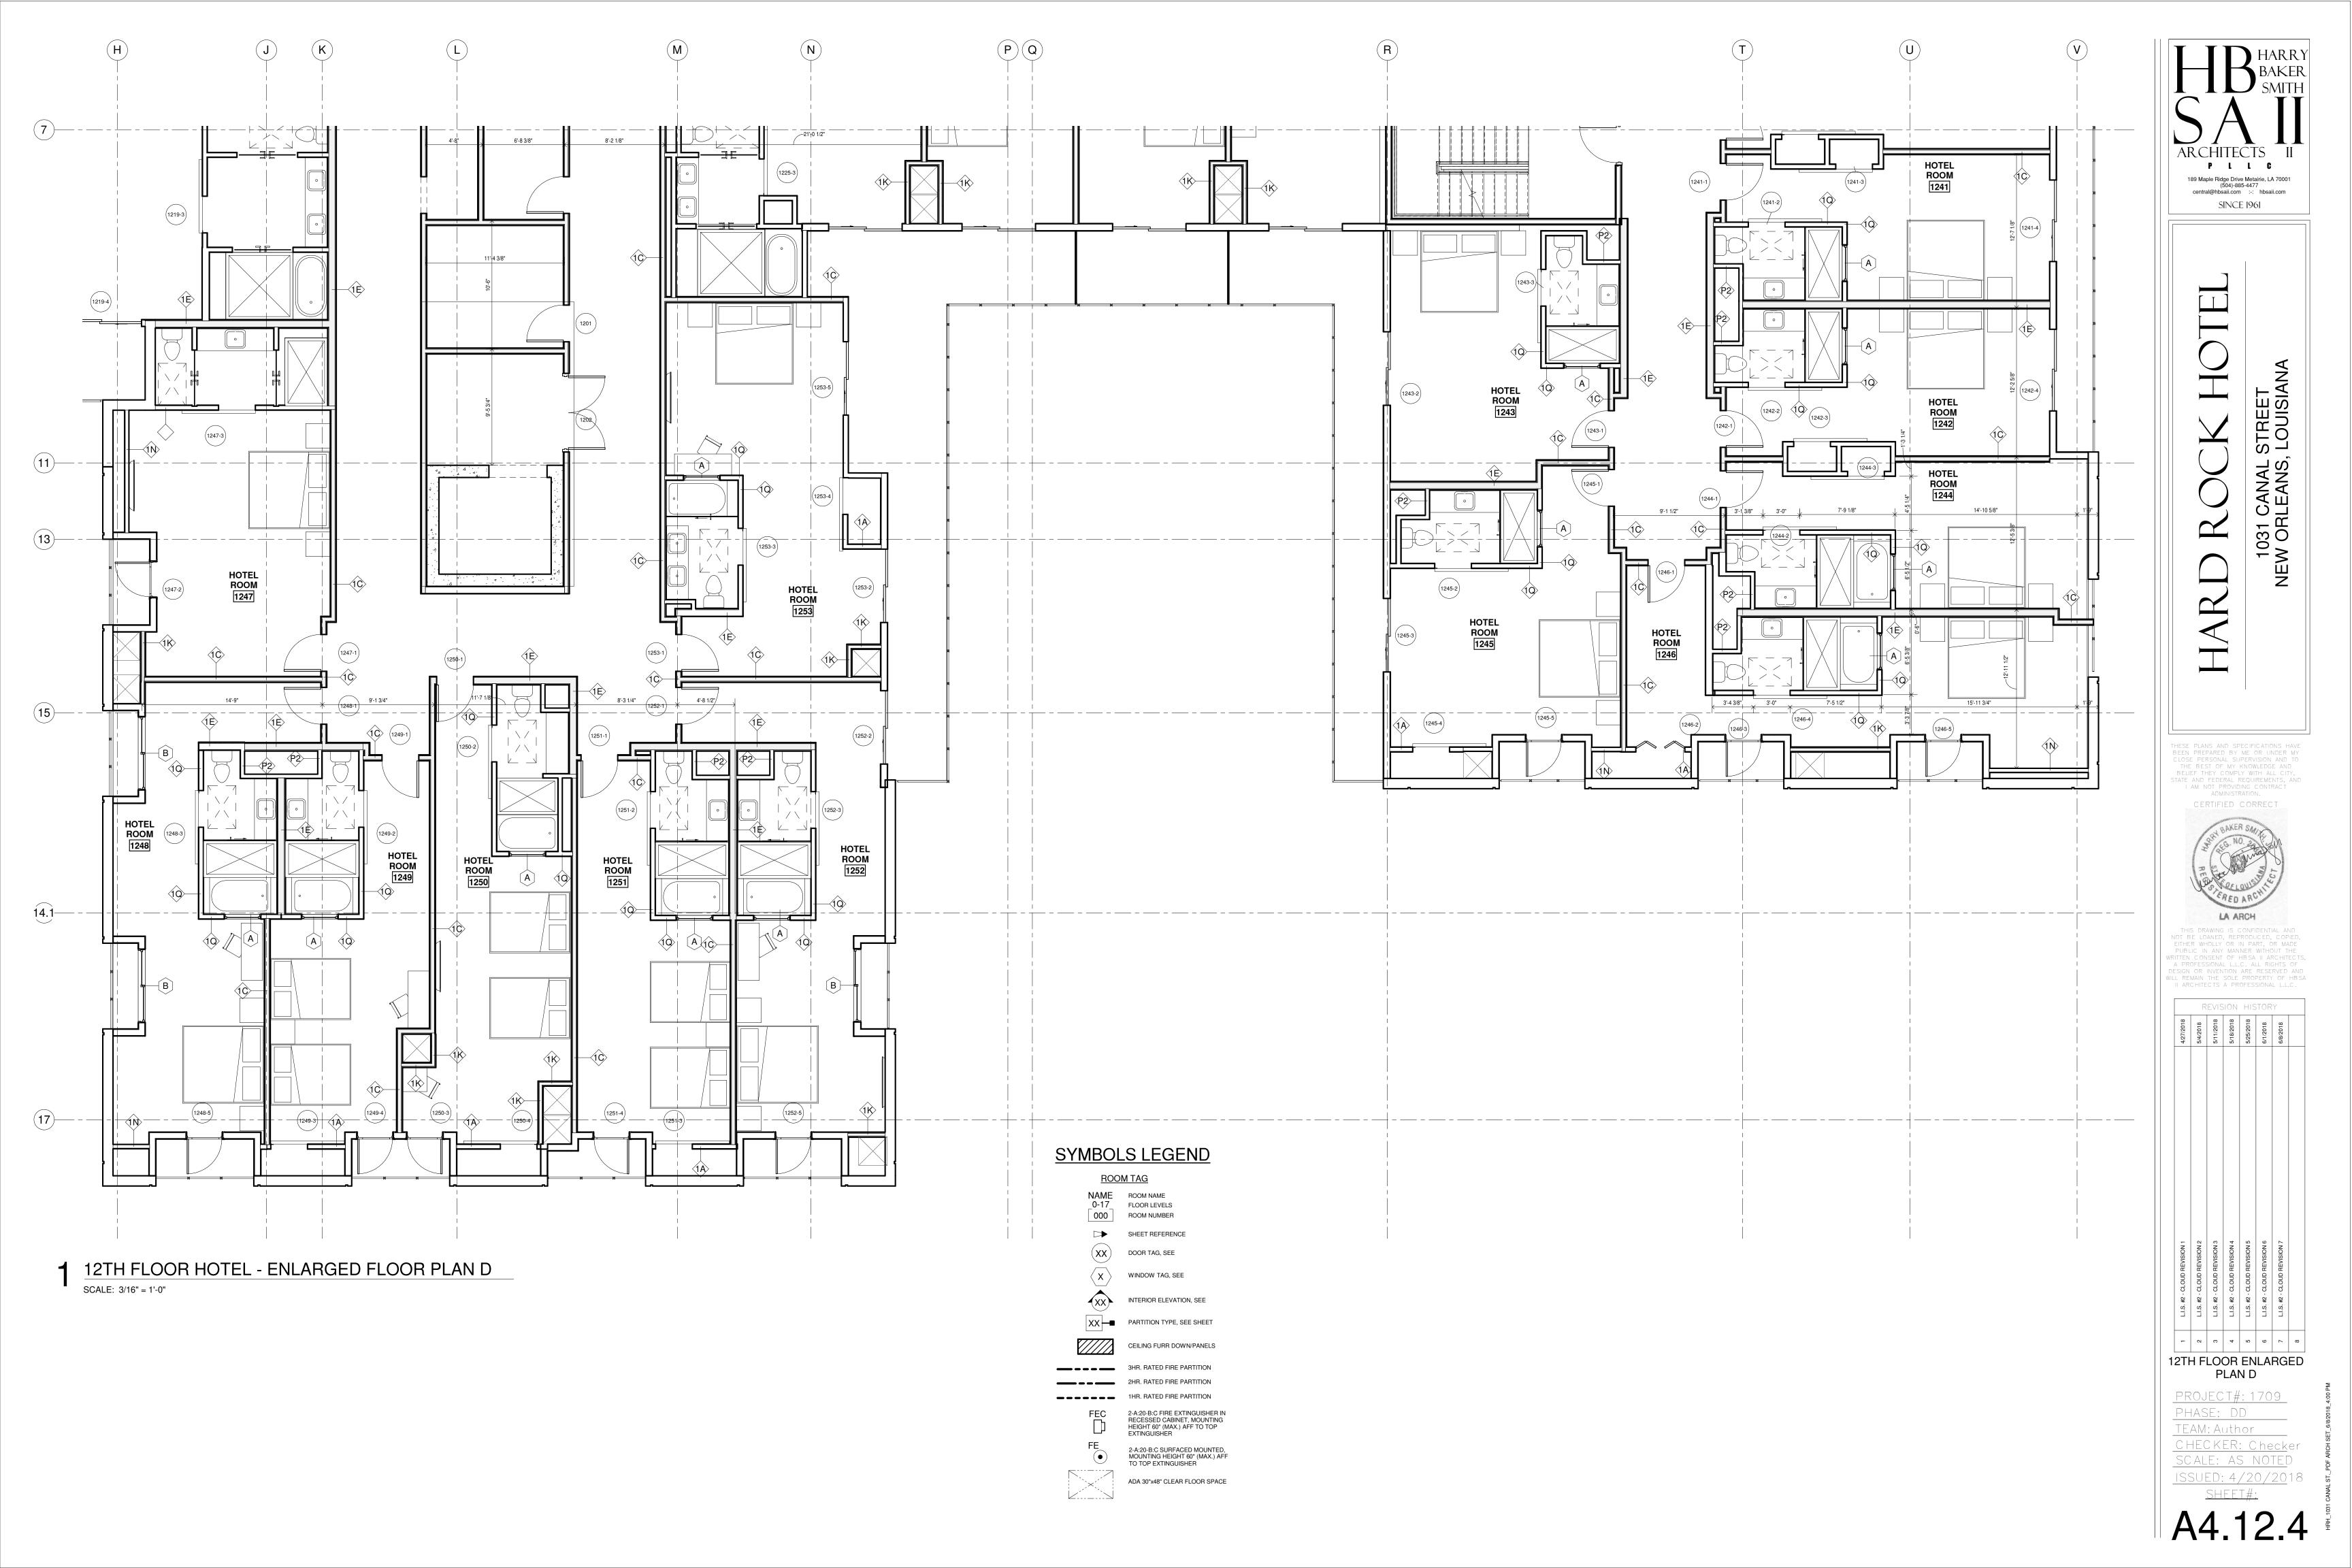

SYMBOLS LEGEND

NAME ROOM NAME
0-17 FLOOR LEVELS
000 ROOM NUMBER

(xx)

SHEET REFERENCE

DOOR TAG, SEE

XX PARTITION TYPE, SEE SHEET

3HR. RATED FIRE PARTITION

2HR. RATED FIRE PARTITION

1HR. RATED FIRE PARTITION

WINDOW TAG, SEE

INTERIOR ELEVATION, SEE


CEILING FURR DOWN/PANELS

RECESSED CABINET, MOUNTING HEIGHT 60" (MAX.) AFF TO TOP EXTINGUISHER

2-A:20-B:C SURFACED MOUNTED, MOUNTING HEIGHT 60" (MAX.) AFF TO TOP EXTINGUISHER

ADA 30"x48" CLEAR FLOOR SPACE

ROOM TAG

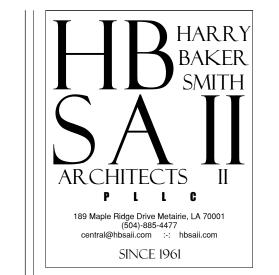


HARD ROCK HOTT 1031 CANAL STREET NEW ORLEANS, LOUISIANA

THESE PLANS AND SPECIFICATIONS HAVE BEEN PREPARED BY ME OR UNDER MY CLOSE PERSONAL SUPERVISION AND TO THE BEST OF MY KNOWLEDGE AND BELIEF THEY COMPLY WITH ALL CITY, STATE AND FEDERAL REQUIREMENTS, AND I AM NOT PROVIDING CONTRACT ADMINISTRATION.

CERTIFIED CORRECT

THIS DRAWING IS CONFIDENTIAL AND NOT BE LOANED, REPRODUCED, COPIED, EITHER WHOLLY OR IN PART, OR MADE PUBLIC IN ANY MANNER WITHOUT THE WRITTEN CONSENT OF HBSA II ARCHITECTS, A PROFESSIONAL L.L.C. ALL RIGHTS OF DESIGN OR INVENTION ARE RESERVED AND WILL REMAIN THE SOLE PROPERTY OF HBSA

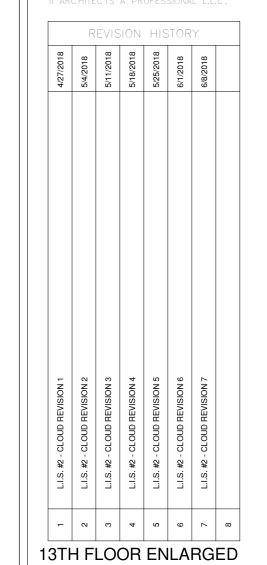

PLAN A

PROJECT#: 1709


PHASE: DD

TEAM: Author

CHECKER: Checker

SCALE: AS NOTED

A4.13.1

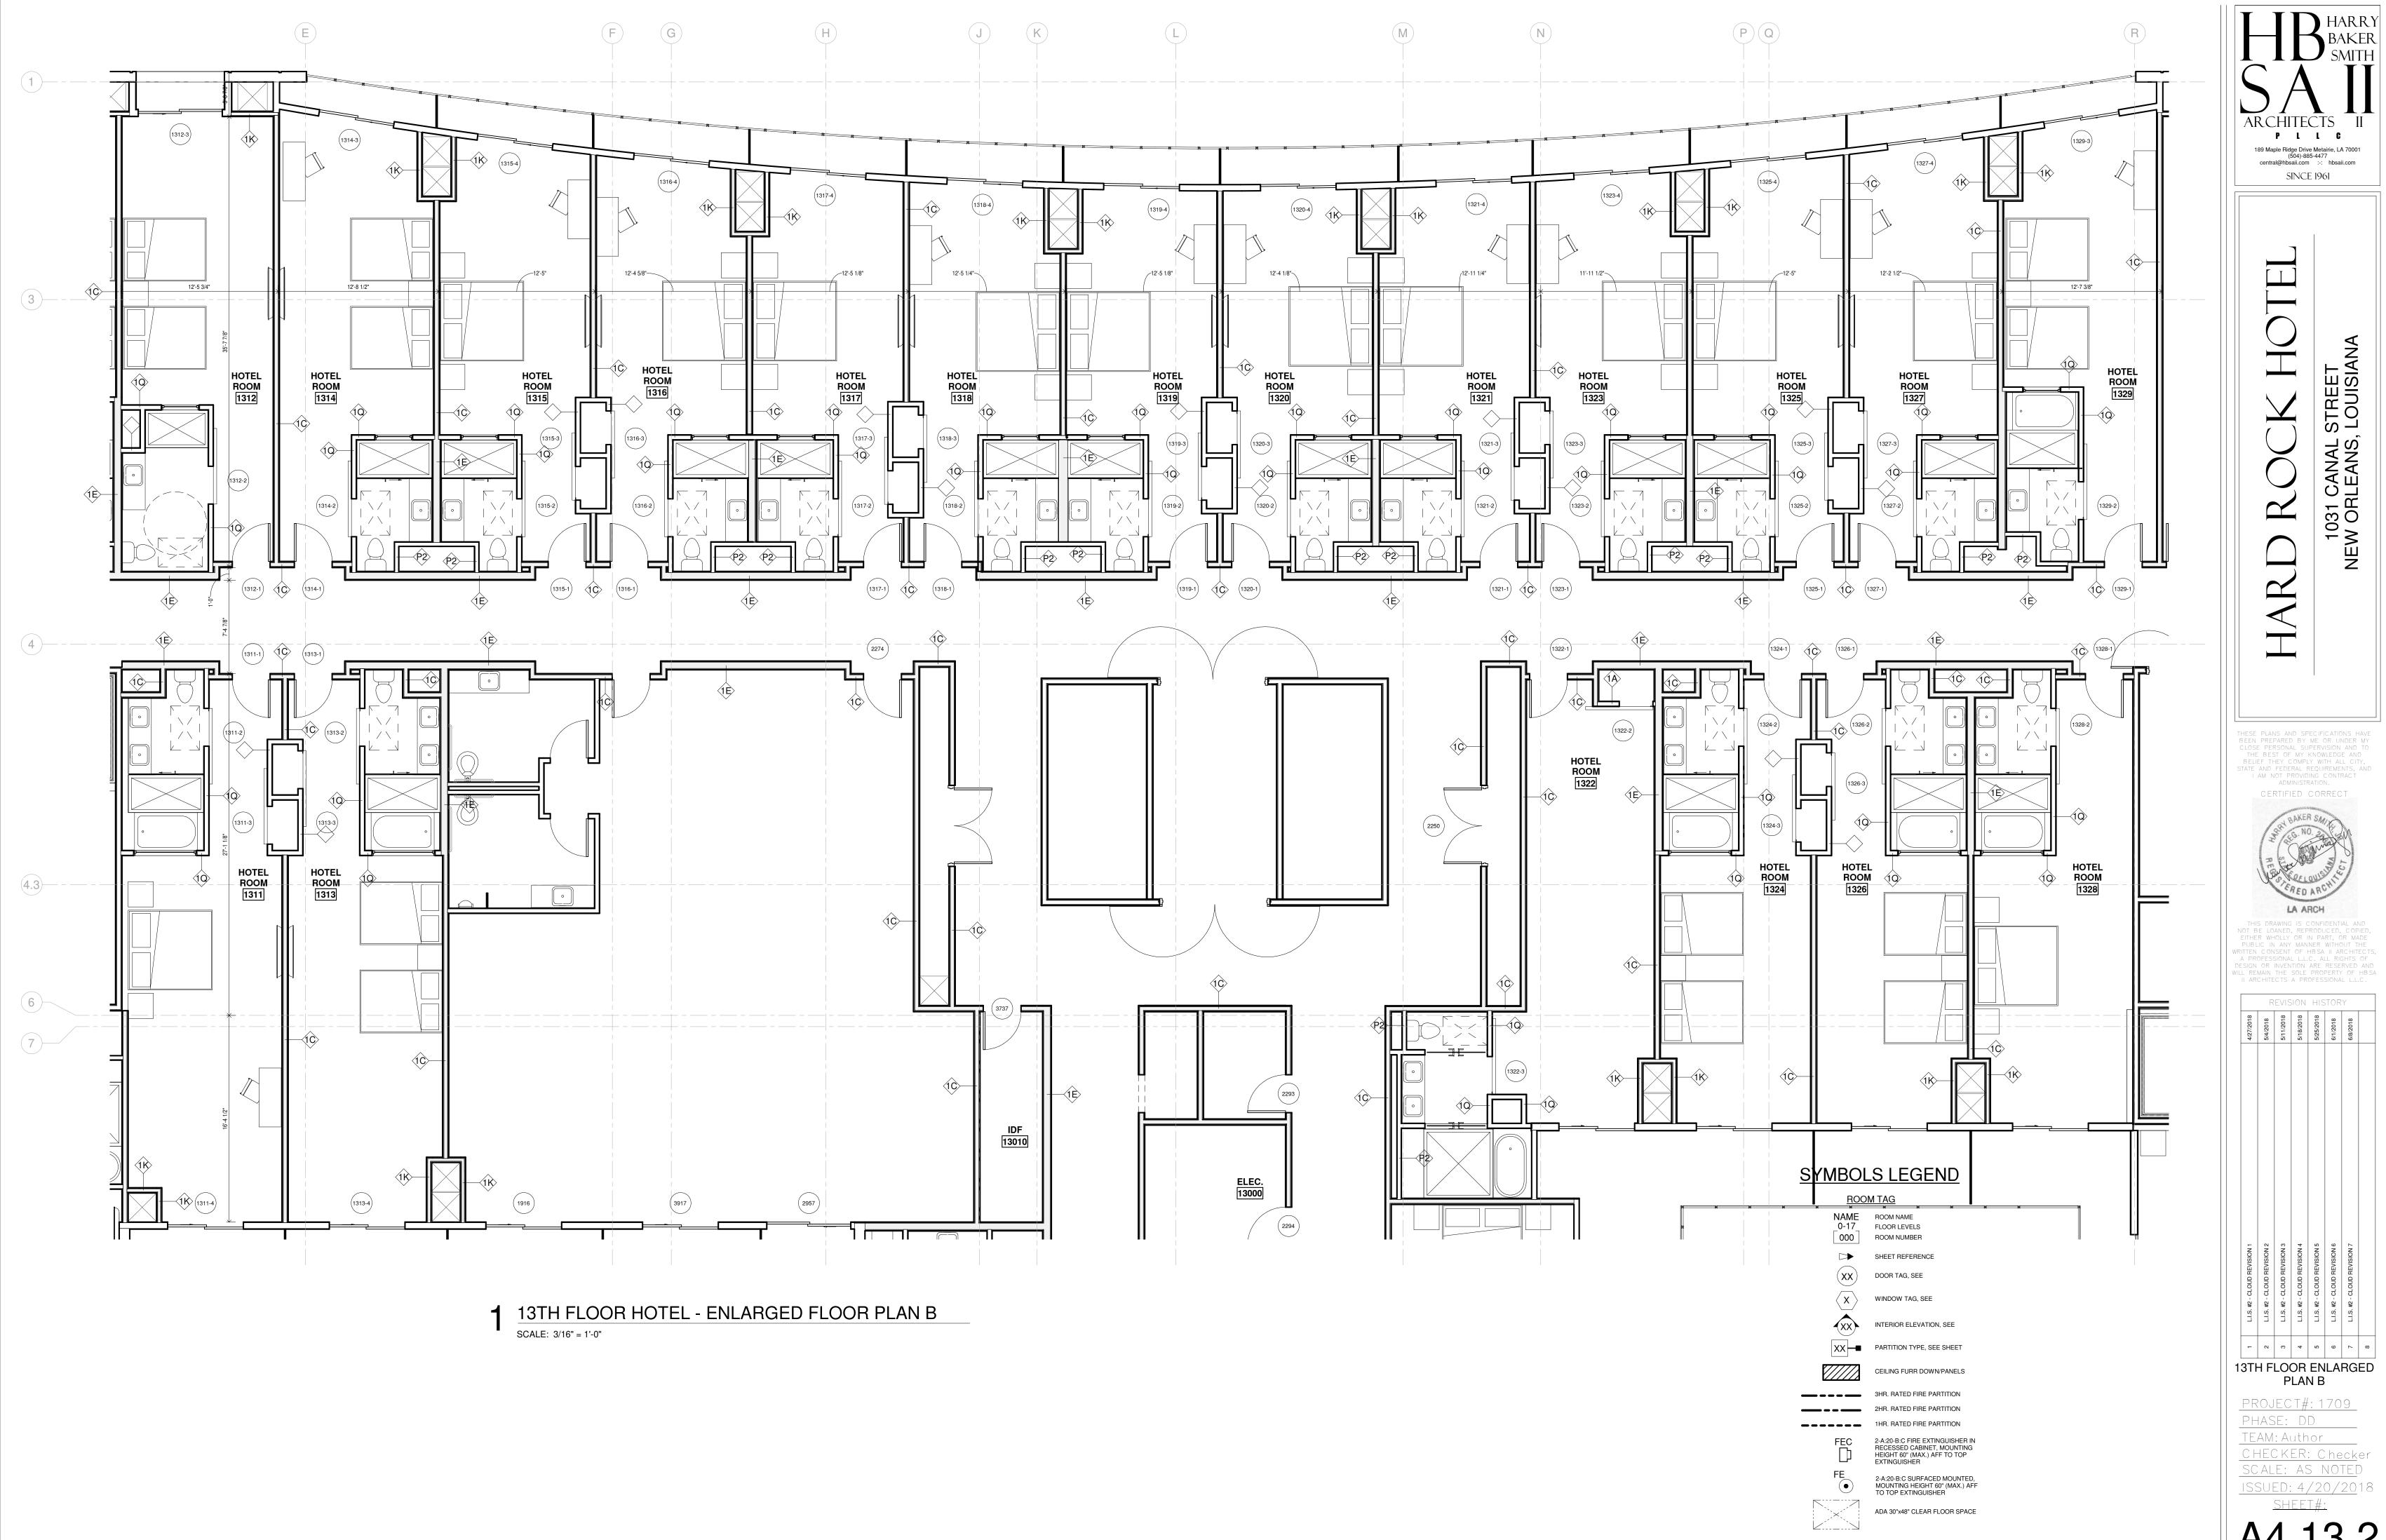



ROOM TAG

NAME ROOM NAME
0-17 FLOOR LEVELS
000 ROOM NUMBER


SHEET REFERENCE XX DOOR TAG, SEE

WINDOW TAG, SEE



XX PARTITION TYPE, SEE SHEET

3HR. RATED FIRE PARTITION 2HR. RATED FIRE PARTITION 1HR. RATED FIRE PARTITION

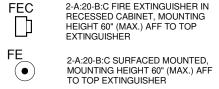

2-A:20-B:C FIRE EXTINGUISHER IN RECESSED CABINET, MOUNTING HEIGHT 60" (MAX.) AFF TO TOP EXTINGUISHER

ADA 30"x48" CLEAR FLOOR SPACE

CEILING FURR DOWN/PANELS

SCALE: 3/16" = 1'-0"



189 Maple Ridge Drive Metairie, LA 70001 (504)-885-4477 central@hbsaii.com :-: hbsaii.com SINCE 1961


1031 CANAL STREET NEW ORLEANS, LOUISIANA

THESE PLANS AND SPECIFICATIONS HAVE BEEN PREPARED BY ME OR UNDER MY CLOSE PERSONAL SUPERVISION AND TO THE BEST OF MY KNOWLEDGE AND BELIEF THEY COMPLY WITH ALL CITY, STATE AND FEDERAL REQUIREMENTS, AND I AM NOT PROVIDING CONTRACT ADMINISTRATION. CERTIFIED CORRECT



| 5/11/2018<br>5/18/2018<br>5/25/2018<br>6/1/2018<br>6/8/2018  | 5/11/2018                    | 5/4/2018                     | 4/27/2018                    |
|--|------------------------------|------------------------------|------------------------------|
| L.I.S. #2 - CLOUD REVISION 3  L.I.S. #2 - CLOUD REVISION 4  L.I.S. #2 - CLOUD REVISION 6  L.I.S. #2 - CLOUD REVISION 7 | L.I.S. #2 - CLOUD REVISION 3 | L.I.S. #2 - CLOUD REVISION 2 | L.I.S. #2 - CLOUD REVISION 1 |
| w 4 m 0 r  | 6                            | 7                            | -                            |

PROJECT#: 1709 PHASE: DD TEAM: Author CHECKER: Checker SCALE: AS NOTED

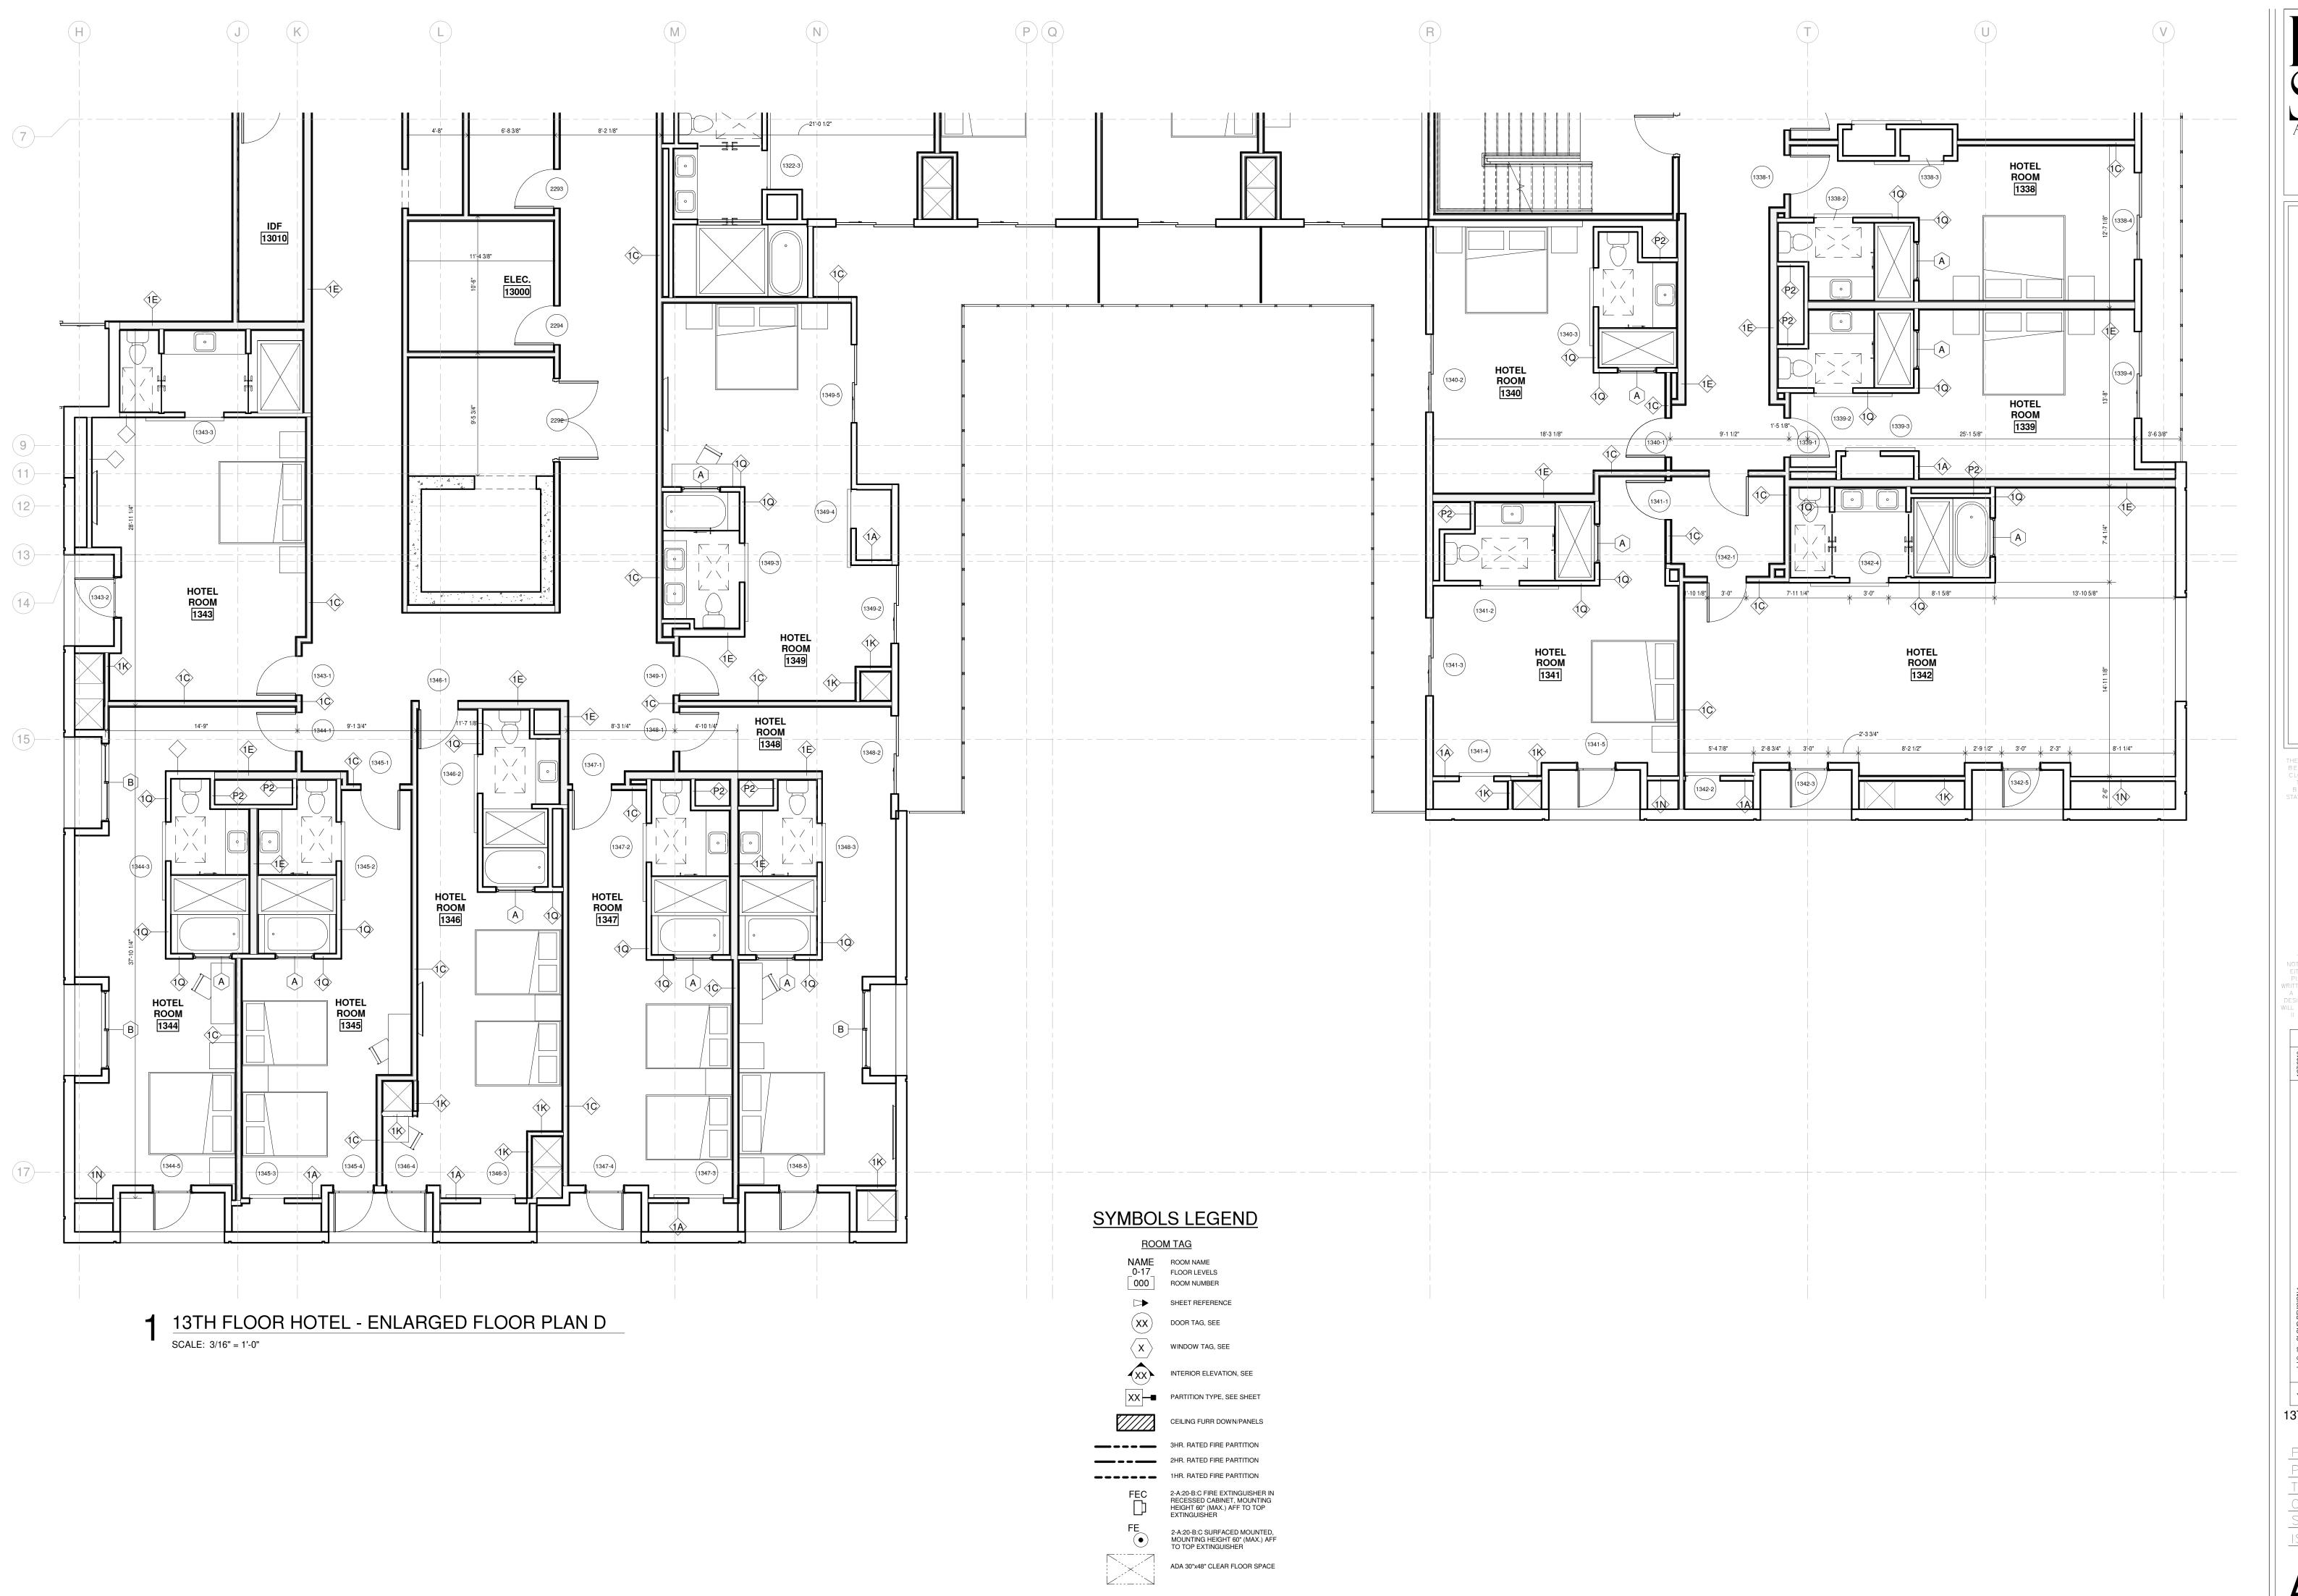

HARRY
BAKER
SMITH
SMITH
ARCHITECTS II
P L L C

189 Maple Ridge Drive Metairie, LA 70001
(504)-885-4477
central@hbsaii.com :: hbsaii.com
SINCE 1961

HARD ROCK HOTEL

1031 CANAL STREET

ADMINISTRATION.

CERTIFIED CORRECT

AKER SALVA

NO.

ARCH

ARCH

THIS DRAWING IS CONFIDENTIAL AND NOT BE LOANED, REPRODUCED, COPIED, EITHER WHOLLY OR IN PART, OR MADE PUBLIC IN ANY MANNER WITHOUT THE WRITTEN CONSENT OF HBSA II ARCHITECTS, A PROFESSIONAL L.L.C. ALL RIGHTS OF DESIGN OR INVENTION ARE RESERVED AND WILL REMAIN THE SOLE PROPERTY OF HBSA II ARCHITECTS A PROFESSIONAL L.L.C.

1 L.I.S. #2 - CLOUD REVISION 1
2 L.I.S. #2 - CLOUD REVISION 2
3 L.I.S. #2 - CLOUD REVISION 3
4 L.I.S. #2 - CLOUD REVISION 4
5 L.I.S. #2 - CLOUD REVISION 5
6 L.I.S. #2 - CLOUD REVISION 6
6 L.I.S. #2 - CLOUD REVISION 6
7 L.I.S. #2 - CLOUD REVISION 6
8 AV27/2018
AV27/2

PLAN D

PROJECT#: 1709

PHASE: DD


TEAM: Author

CHECKER: Checker

SCALE: AS NOTED

ISSUED: 4/20/2018

A4.13.4

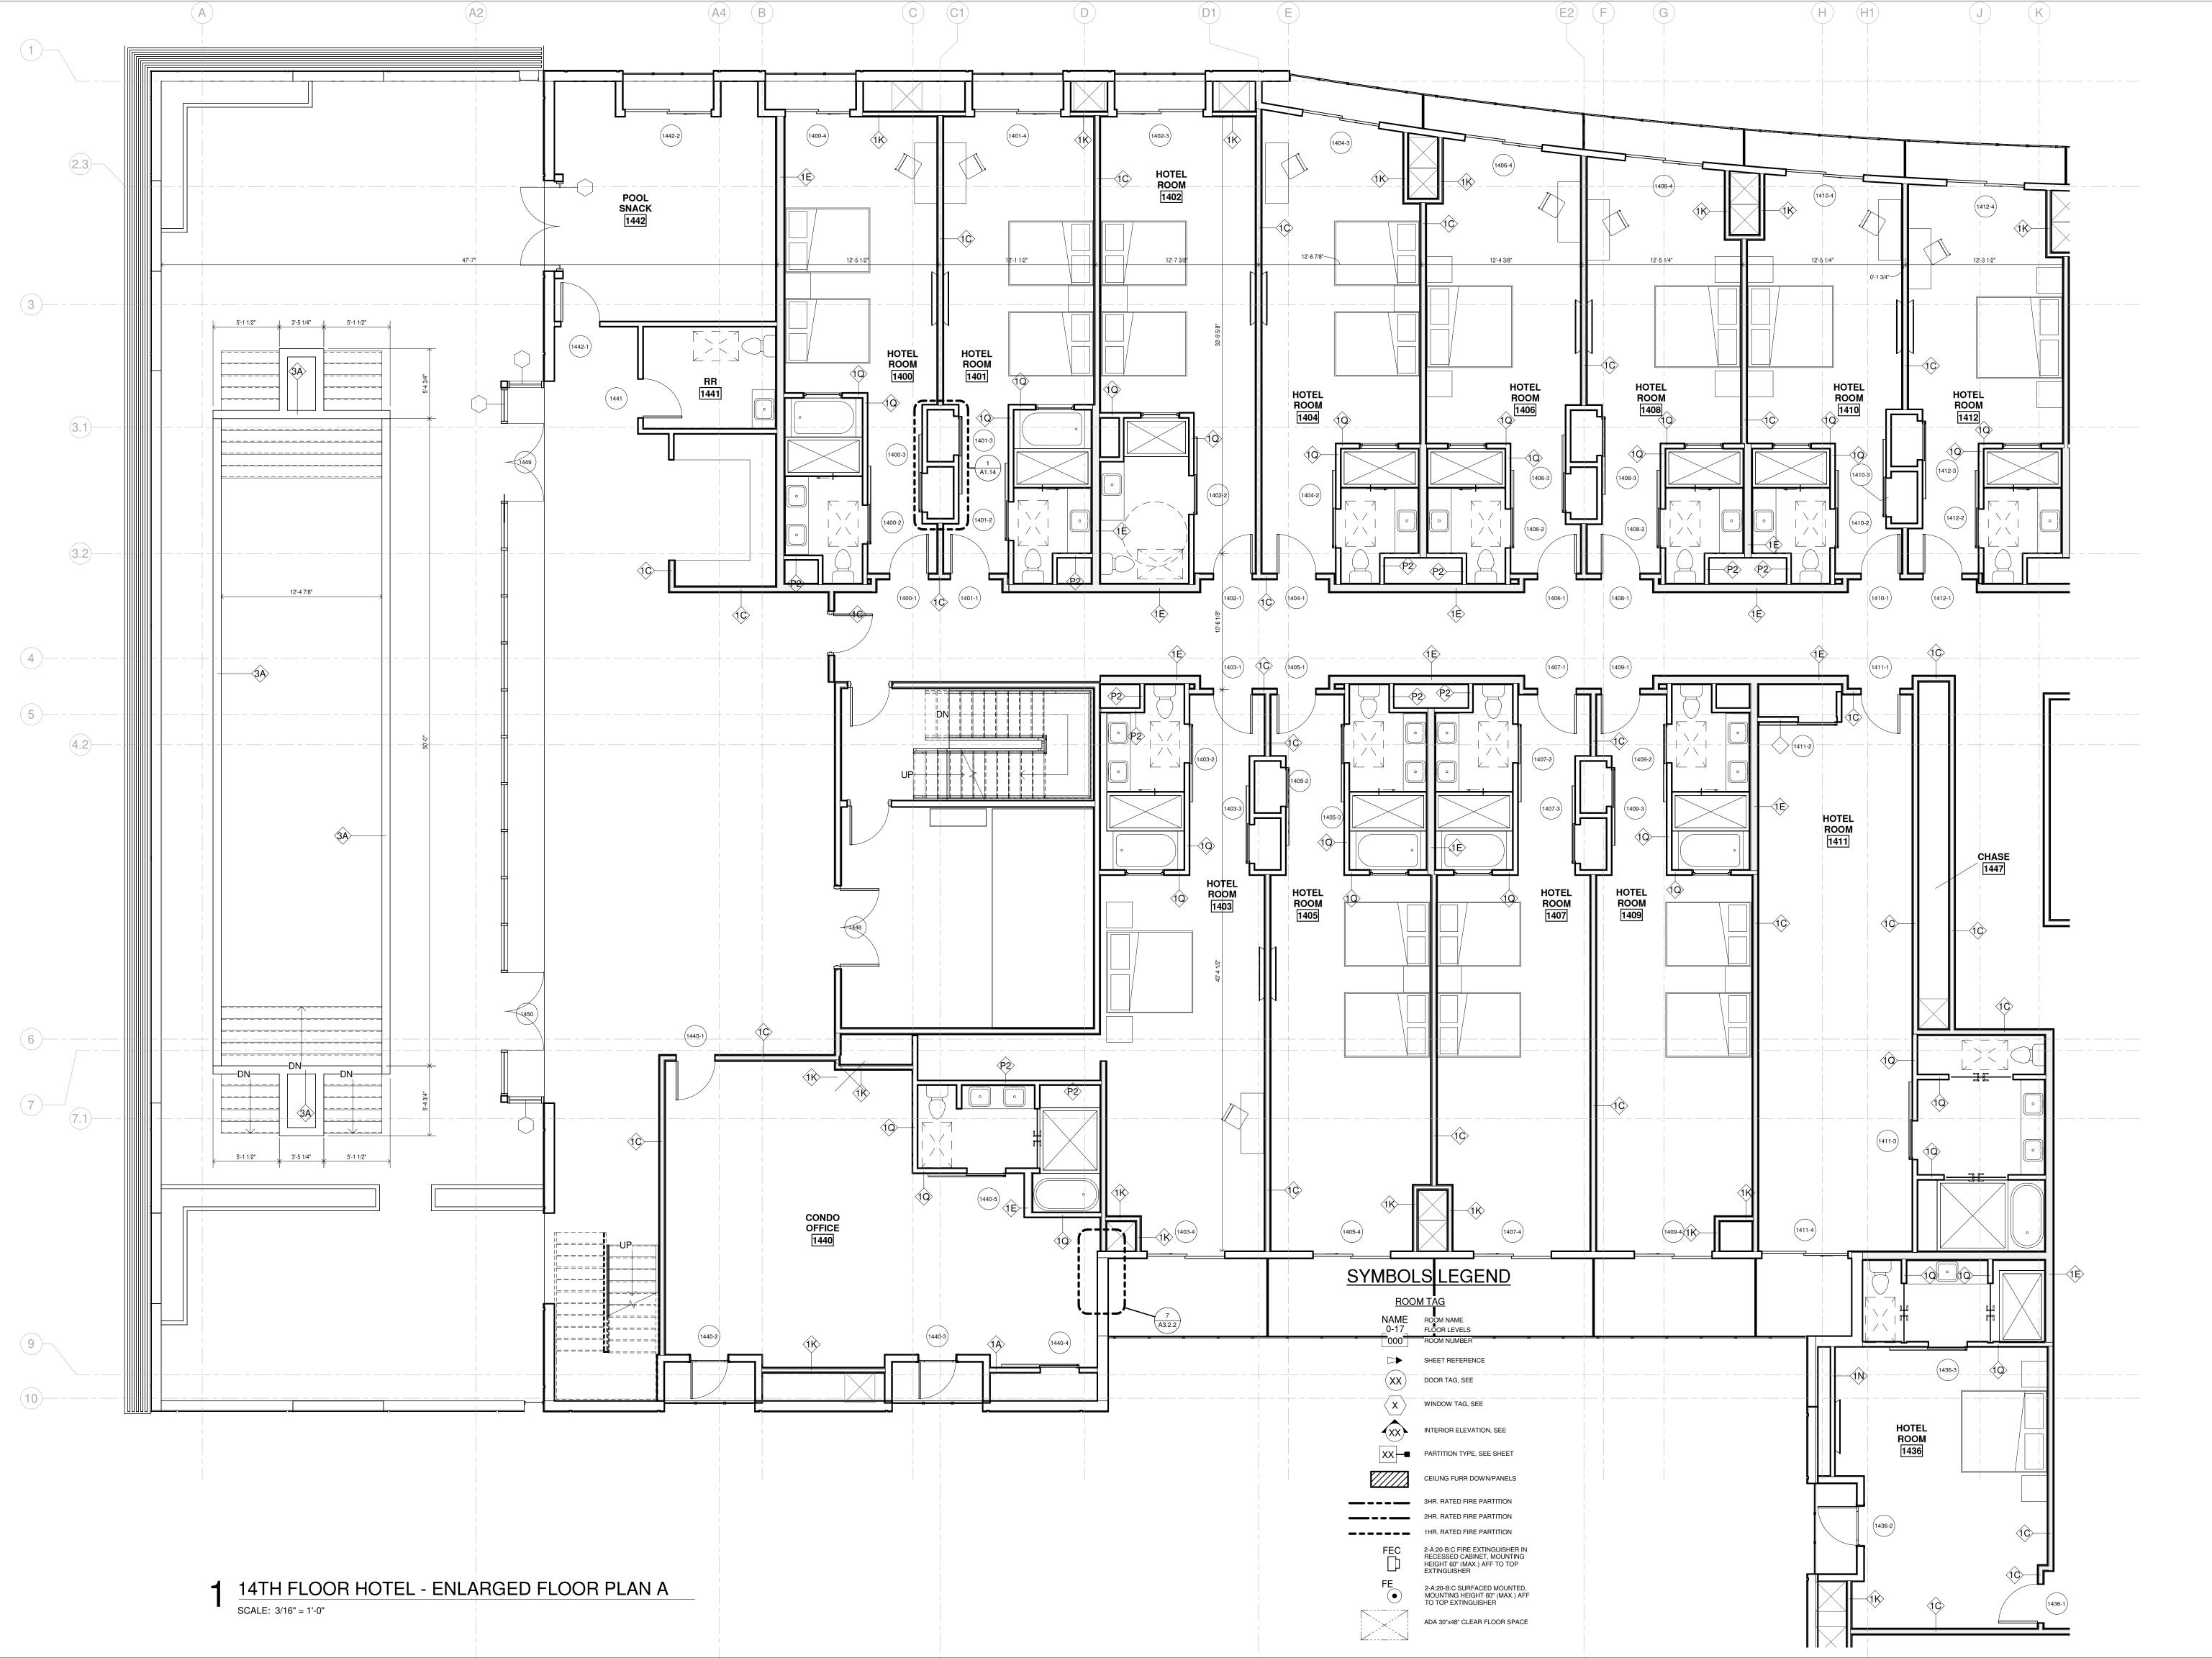

HARRY
BAKER
SMITH
SMITH
ARCHITECTS II
PLC

189 Maple Ridge Drive Metairie, LA 70001
(504)-885-4477
central@hbsaii.com :: hbsaii.com
SINCE 1961

ARD ROCK HOTEL

1031 CANAL STREET

NEW ORLEANS, LOUISIANA

EEN PREPARED BY ME OR UNDER MY LOSE PERSONAL SUPERVISION AND TO THE BEST OF MY KNOWLEDGE AND BELIEF THEY COMPLY WITH ALL CITY, ATE AND FEDERAL REQUIREMENTS, AND I AM NOT PROVIDING CONTRACT ADMINISTRATION.

CERTIFIED CORRECT

THIS DRAWING IS CONFIDENTIAL AND STEEL BE LOANED, REPRODUCED, COPIED,

REVISION HISTORY

| REVISION HISTORY | REVISION | REVIS


2 L.I.S. #2 - CLOUD REVISION 2
3 L.I.S. #2 - CLOUD REVISION 3
4 L.I.S. #2 - CLOUD REVISION 4
5 L.I.S. #2 - CLOUD REVISION 6
6 L.I.S. #2 - CLOUD REVISION 6
7 L.I.S. #2 - CLOUD REVISION 7

14TH FLOOR ENLARGED PLAN A

PROJECT#: 1709

PROJECT#: 1709
PHASE: DD
TEAM: Author
CHECKER: Checker
SCALE: AS NOTED
ISSUED: 4/20/2018

Δ4 14 1

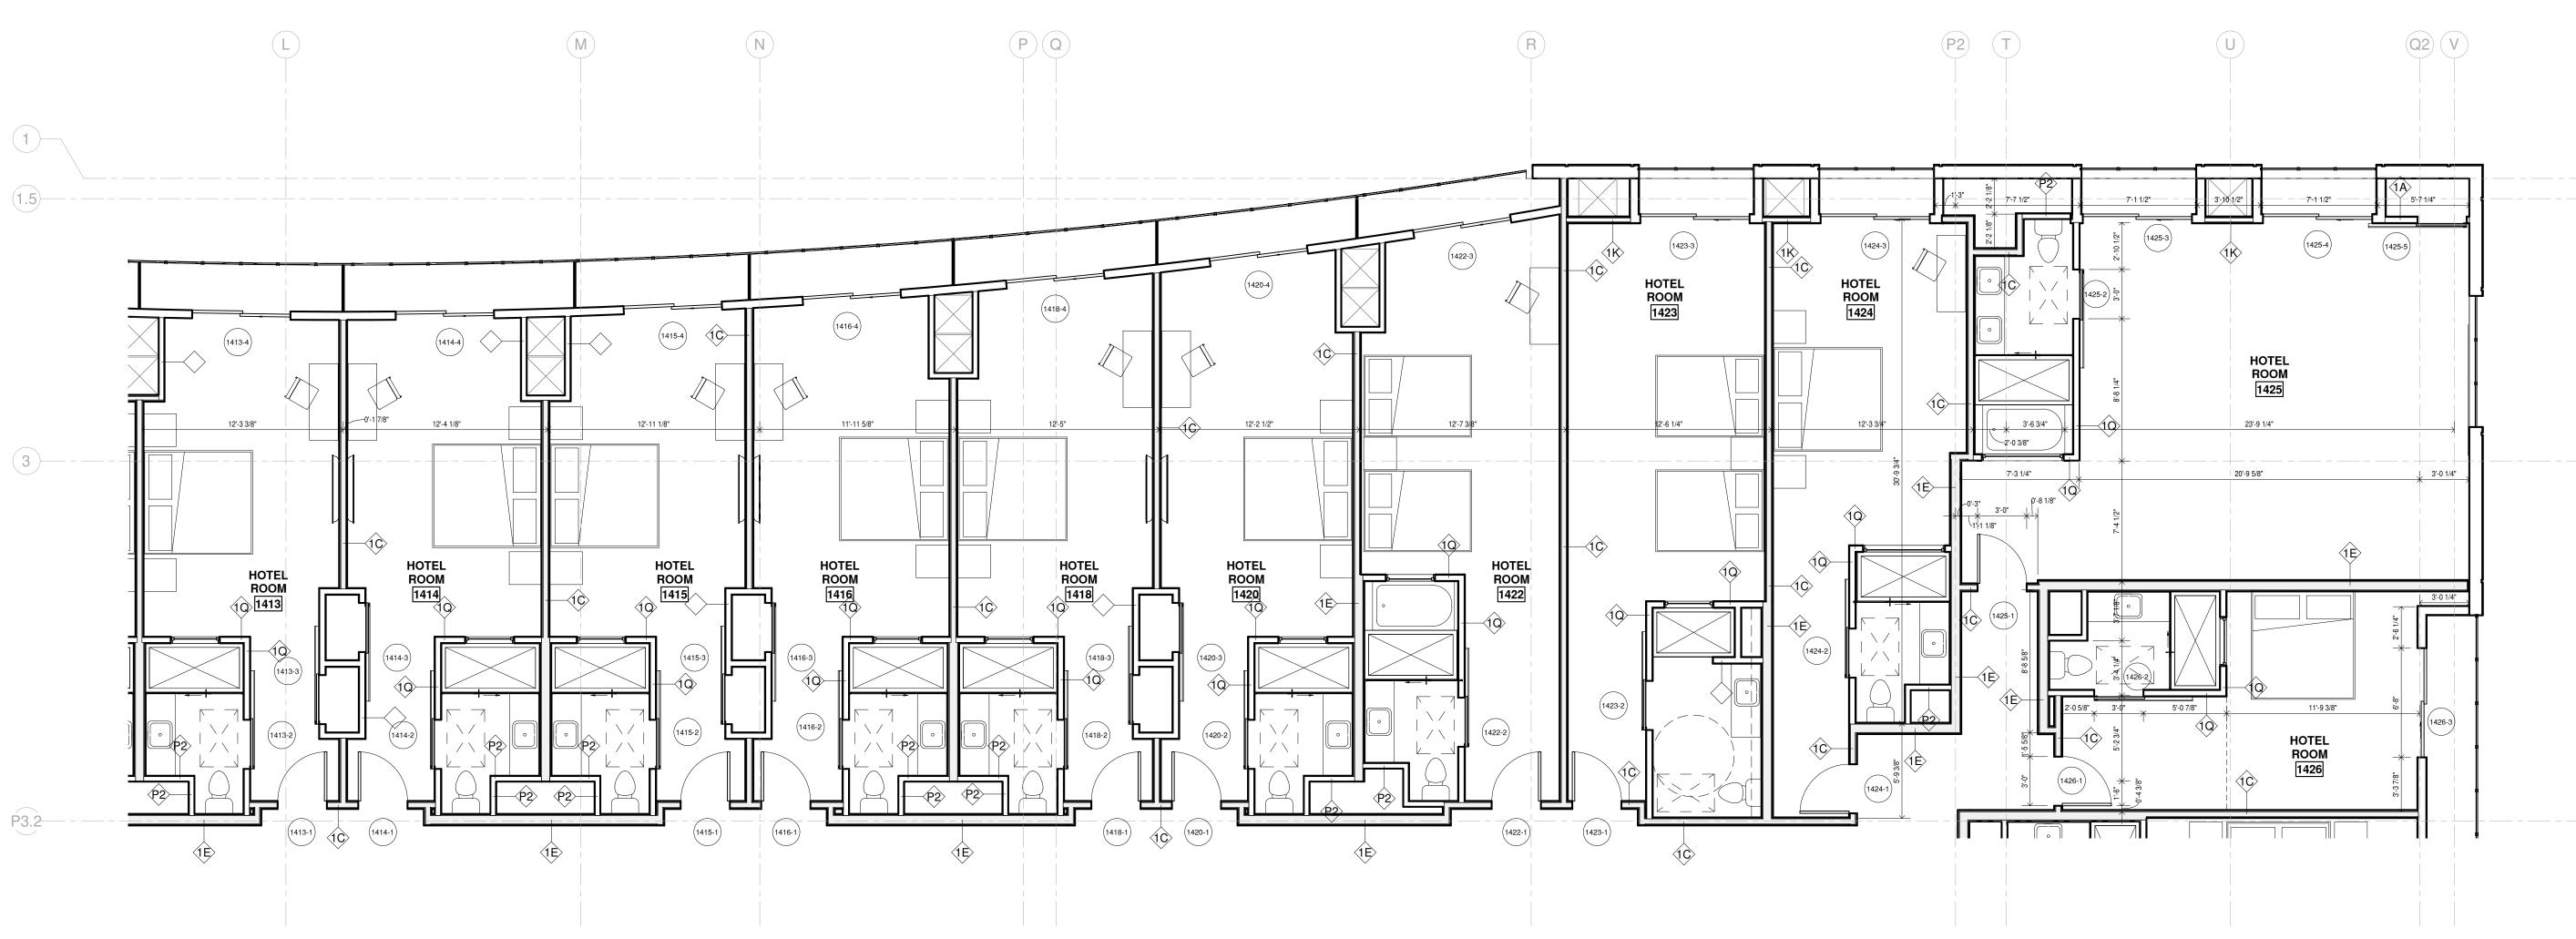

1 14TH FLOOR HOTEL - ENLARGED FLOOR PLAN B
SCALE: 3/16" = 1'-0"

## SYMBOLS LEGEND

ROOM TAG

NAME ROOM NAME
0-17 FLOOR LEVELS
000 ROOM NUMBER

SHEET REFERENCE

XX DOOR TAG, SEE

XX WINDOW TAG, SEE

XX INTERIOR ELEVATION, SEE

XX PARTITION TYPE, SEE SHEET

CEILING FURR DOWN/PANELS

3HR. RATED FIRE PARTITION
2HR. RATED FIRE PARTITION
1HR. RATED FIRE PARTITION
1HR. RATED FIRE PARTITION

THR. RATED FIRE EXTINGUISHER IN RECESSED CABINET, MOUNTING HEIGHT 60" (MAX.) AFF TO TOP EXTINGUISHER

FE

2-A:20-B:C SURFACED MOUNTED, MOUNTING HEIGHT 60" (MAX.) AFF TO TOP EXTINGUISHER

ADA 30"x48" CLEAR FLOOR SPACE

HARRY
BAKER
SMITH
SMITH
ARCHITECTS II
P L C

189 Maple Ridge Drive Metairie, LA 70001
(504)-885-4477
central@hbsaii.com :: hbsaii.com
SINCE 1961

HARD ROCK HOTEL

1031 CANAL STREET

NEW ORLEANS, LOUISIANA

THESE PLANS AND SPECIFICATIONS HAD BEEN PREPARED BY ME OR UNDER ME CLOSE PERSONAL SUPERVISION AND ITHE BEST OF MY KNOWLEDGE AND BELIEF THEY COMPLY WITH ALL CITY STATE AND FEDERAL REQUIREMENTS, A I AM NOT PROVIDING CONTRACT ADMINISTRATION.

CERTIFIED CORRECT



THIS DRAWING IS CONFIDENTIAL AND NOT BE LOANED, REPRODUCED, COPIED, EITHER WHOLLY OR IN PART, OR MADE PUBLIC IN ANY MANNER WITHOUT THE WRITTEN CONSENT OF HBSA II ARCHITECTS, A PROFESSIONAL L.L.C. ALL RIGHTS OF DESIGN OR INVENTION ARE RESERVED AND WILL REMAIN THE SOLE PROPERTY OF HBSA II ARCHITECTS A PROFESSIONAL L.L.C.

|                              | R                            | EVIS                         |                              |                              | TOR                          | Υ                            |   |
|------------------------------|------------------------------|------------------------------|------------------------------|------------------------------|------------------------------|------------------------------|---|
| 4/27/2018                    | 5/4/2018                     | 5/11/2018                    | 5/18/2018                    | 5/25/2018                    | 6/1/2018                     | 6/8/2018                     |   |
| L.I.S. #2 - CLOUD REVISION 1 | L.I.S. #2 - CLOUD REVISION 2 | L.I.S. #2 - CLOUD REVISION 3 | L.I.S. #2 - CLOUD REVISION 4 | L.I.S. #2 - CLOUD REVISION 5 | L.I.S. #2 - CLOUD REVISION 6 | L.I.S. #2 - CLOUD REVISION 7 |   |
| -                            | 2                            | က                            | 4                            | 2                            | 9                            | 7                            | ω |

PLAN B

PROJECT#: 1709

PHASE: DD


TEAM: Author

CHECKER: Checker

SCALE: AS NOTED


ISSUED: 4/20/2018 SHEET#:


A4.14.2

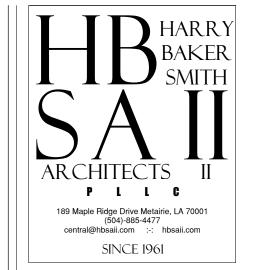

1031 CANAL STREET NEW ORLEANS, LOUISIANA

STATE AND FEDERAL REQUIREMENTS, AND I AM NOT PROVIDING CONTRACT ADMINISTRATION. CERTIFIED CORRECT

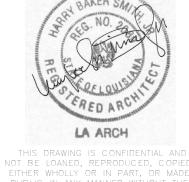

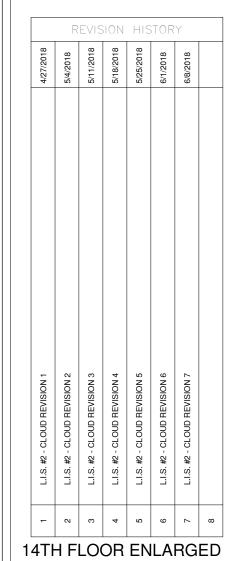

PLAN C PROJECT#: 1709 PHASE: DD TEAM: Author CHECKER: Checker SCALE: AS NOTED

ISSUED: 4/20/2018

SYMBOLS LEGEND

ROOM TAG NAME ROOM NAME

\_0-17 FLOOR LEVELS FLOOR LEVELS 000 ROOM NUMBER

SHEET REFERENCE XX DOOR TAG, SEE WINDOW TAG, SEE

INTERIOR ELEVATION, SEE XX PARTITION TYPE, SEE SHEET


CEILING FURR DOWN/PANELS 3HR. RATED FIRE PARTITION

2HR. RATED FIRE PARTITION HR. RATED FIRE PARTITION 2-A:20-B:C FIRE EXTINGUISHER IN RECESSED CABINET, MOUNTING HEIGHT 60" (MAX.) AFF TO TOP EXTINGUISHER


ADA 30"x48" CLEAR FLOOR SPACE

2-A:20-B:C SURFACED MOUNTED, MOUNTING HEIGHT 60" (MAX.) AFF TO TOP EXTINGUISHER

14TH FLOOR HOTEL - ENLARGED FLOOR PLAN C SCALE: 3/16" = 1'-0"

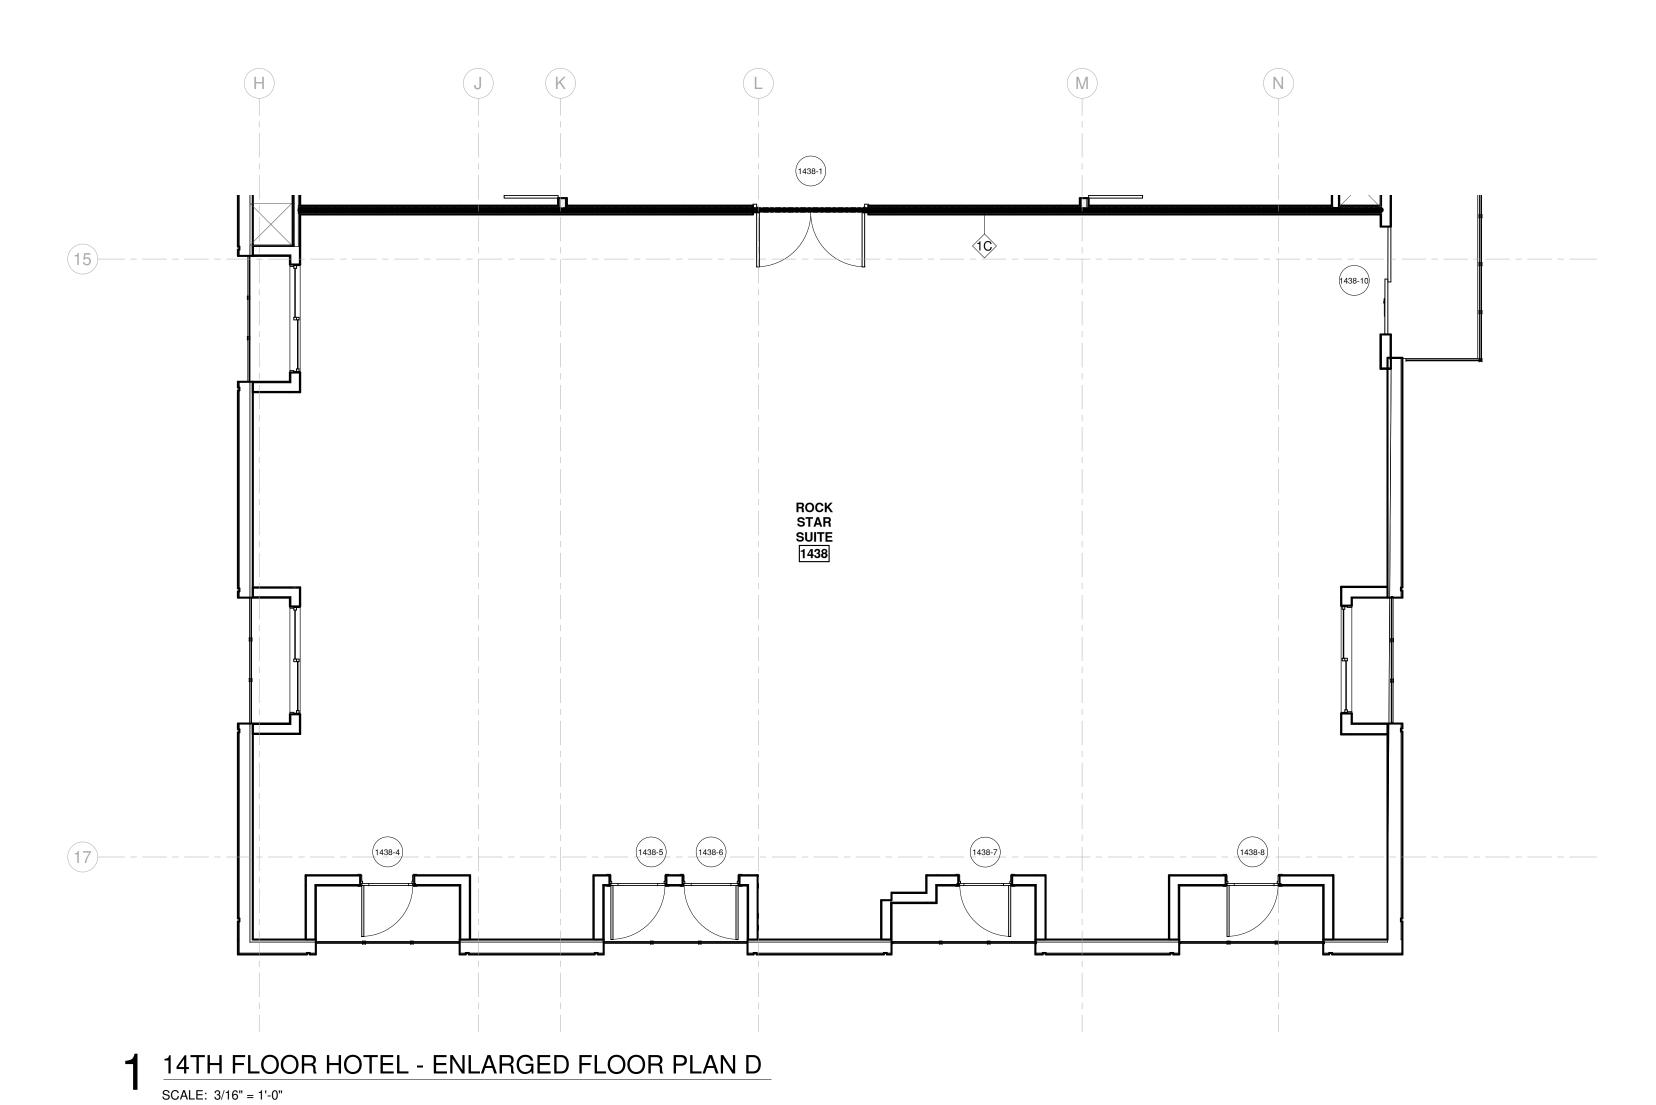

### SYMBOLS LEGEND

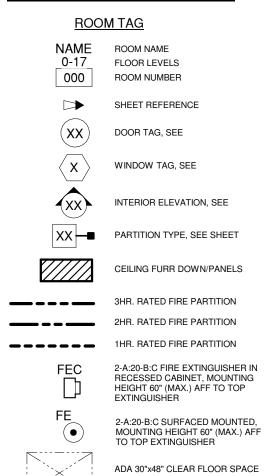

HARRY
BAKER
SMITH
SMITH
ARCHITECTS II
P L C

189 Maple Ridge Drive Metairie, LA 70001
(504)-885-4477
central@hbsaii.com :: hbsaii.com
SINCE 1961

HAKUKK HUIL 1031 CANAL STREET NEW ORLEANS, LOUISIANA

THESE PLANS AND SPECIFICATIONS HAVE BEEN PREPARED BY ME OR UNDER MY CLOSE PERSONAL SUPERVISION AND TO THE BEST OF MY KNOWLEDGE AND BELIEF THEY COMPLY WITH ALL CITY, STATE AND FEDERAL REQUIREMENTS, AND I AM NOT PROVIDING CONTRACT ADMINISTRATION.

CERTIFIED CORRECT



THIS DRAWING IS CONFIDENTIAL AND
NOT BE LOANED, REPRODUCED, COPIED,
EITHER WHOLLY OR IN PART, OR MADE
PUBLIC IN ANY MANNER WITHOUT THE
WRITTEN CONSENT OF HBSA II ARCHITECTS
A PROFESSIONAL L.L.C. ALL RIGHTS OF
DESIGN OR INVENTION ARE RESERVED AND
WILL REMAIN THE SOLE PROPERTY OF HBS/

|                              | R                            |                              |                              |                              | TOR                          | Υ                            |   |
|------------------------------|------------------------------|------------------------------|------------------------------|------------------------------|------------------------------|------------------------------|---|
| 4/27/2018                    | 5/4/2018                     | 5/11/2018                    | 5/18/2018                    | 5/25/2018                    | 6/1/2018                     | 6/8/2018                     |   |
| L.I.S. #2 - CLOUD REVISION 1 | L.I.S. #2 - CLOUD REVISION 2 | L.I.S. #2 - CLOUD REVISION 3 | L.I.S. #2 - CLOUD REVISION 4 | L.I.S. #2 - CLOUD REVISION 5 | L.I.S. #2 - CLOUD REVISION 6 | L.I.S. #2 - CLOUD REVISION 7 |   |
|                              | 8                            | ဗ                            |                              | 2                            | 9                            |                              | 8 |

PLAN D


PROJECT#: 1709


PHASE: DD


PHASE: DD
TEAM: Author
CHECKER: Checker
SCALE: AS NOTED
ISSUED: 4/20/2018


14TH FLOOR ENLARGED

A4 14 4

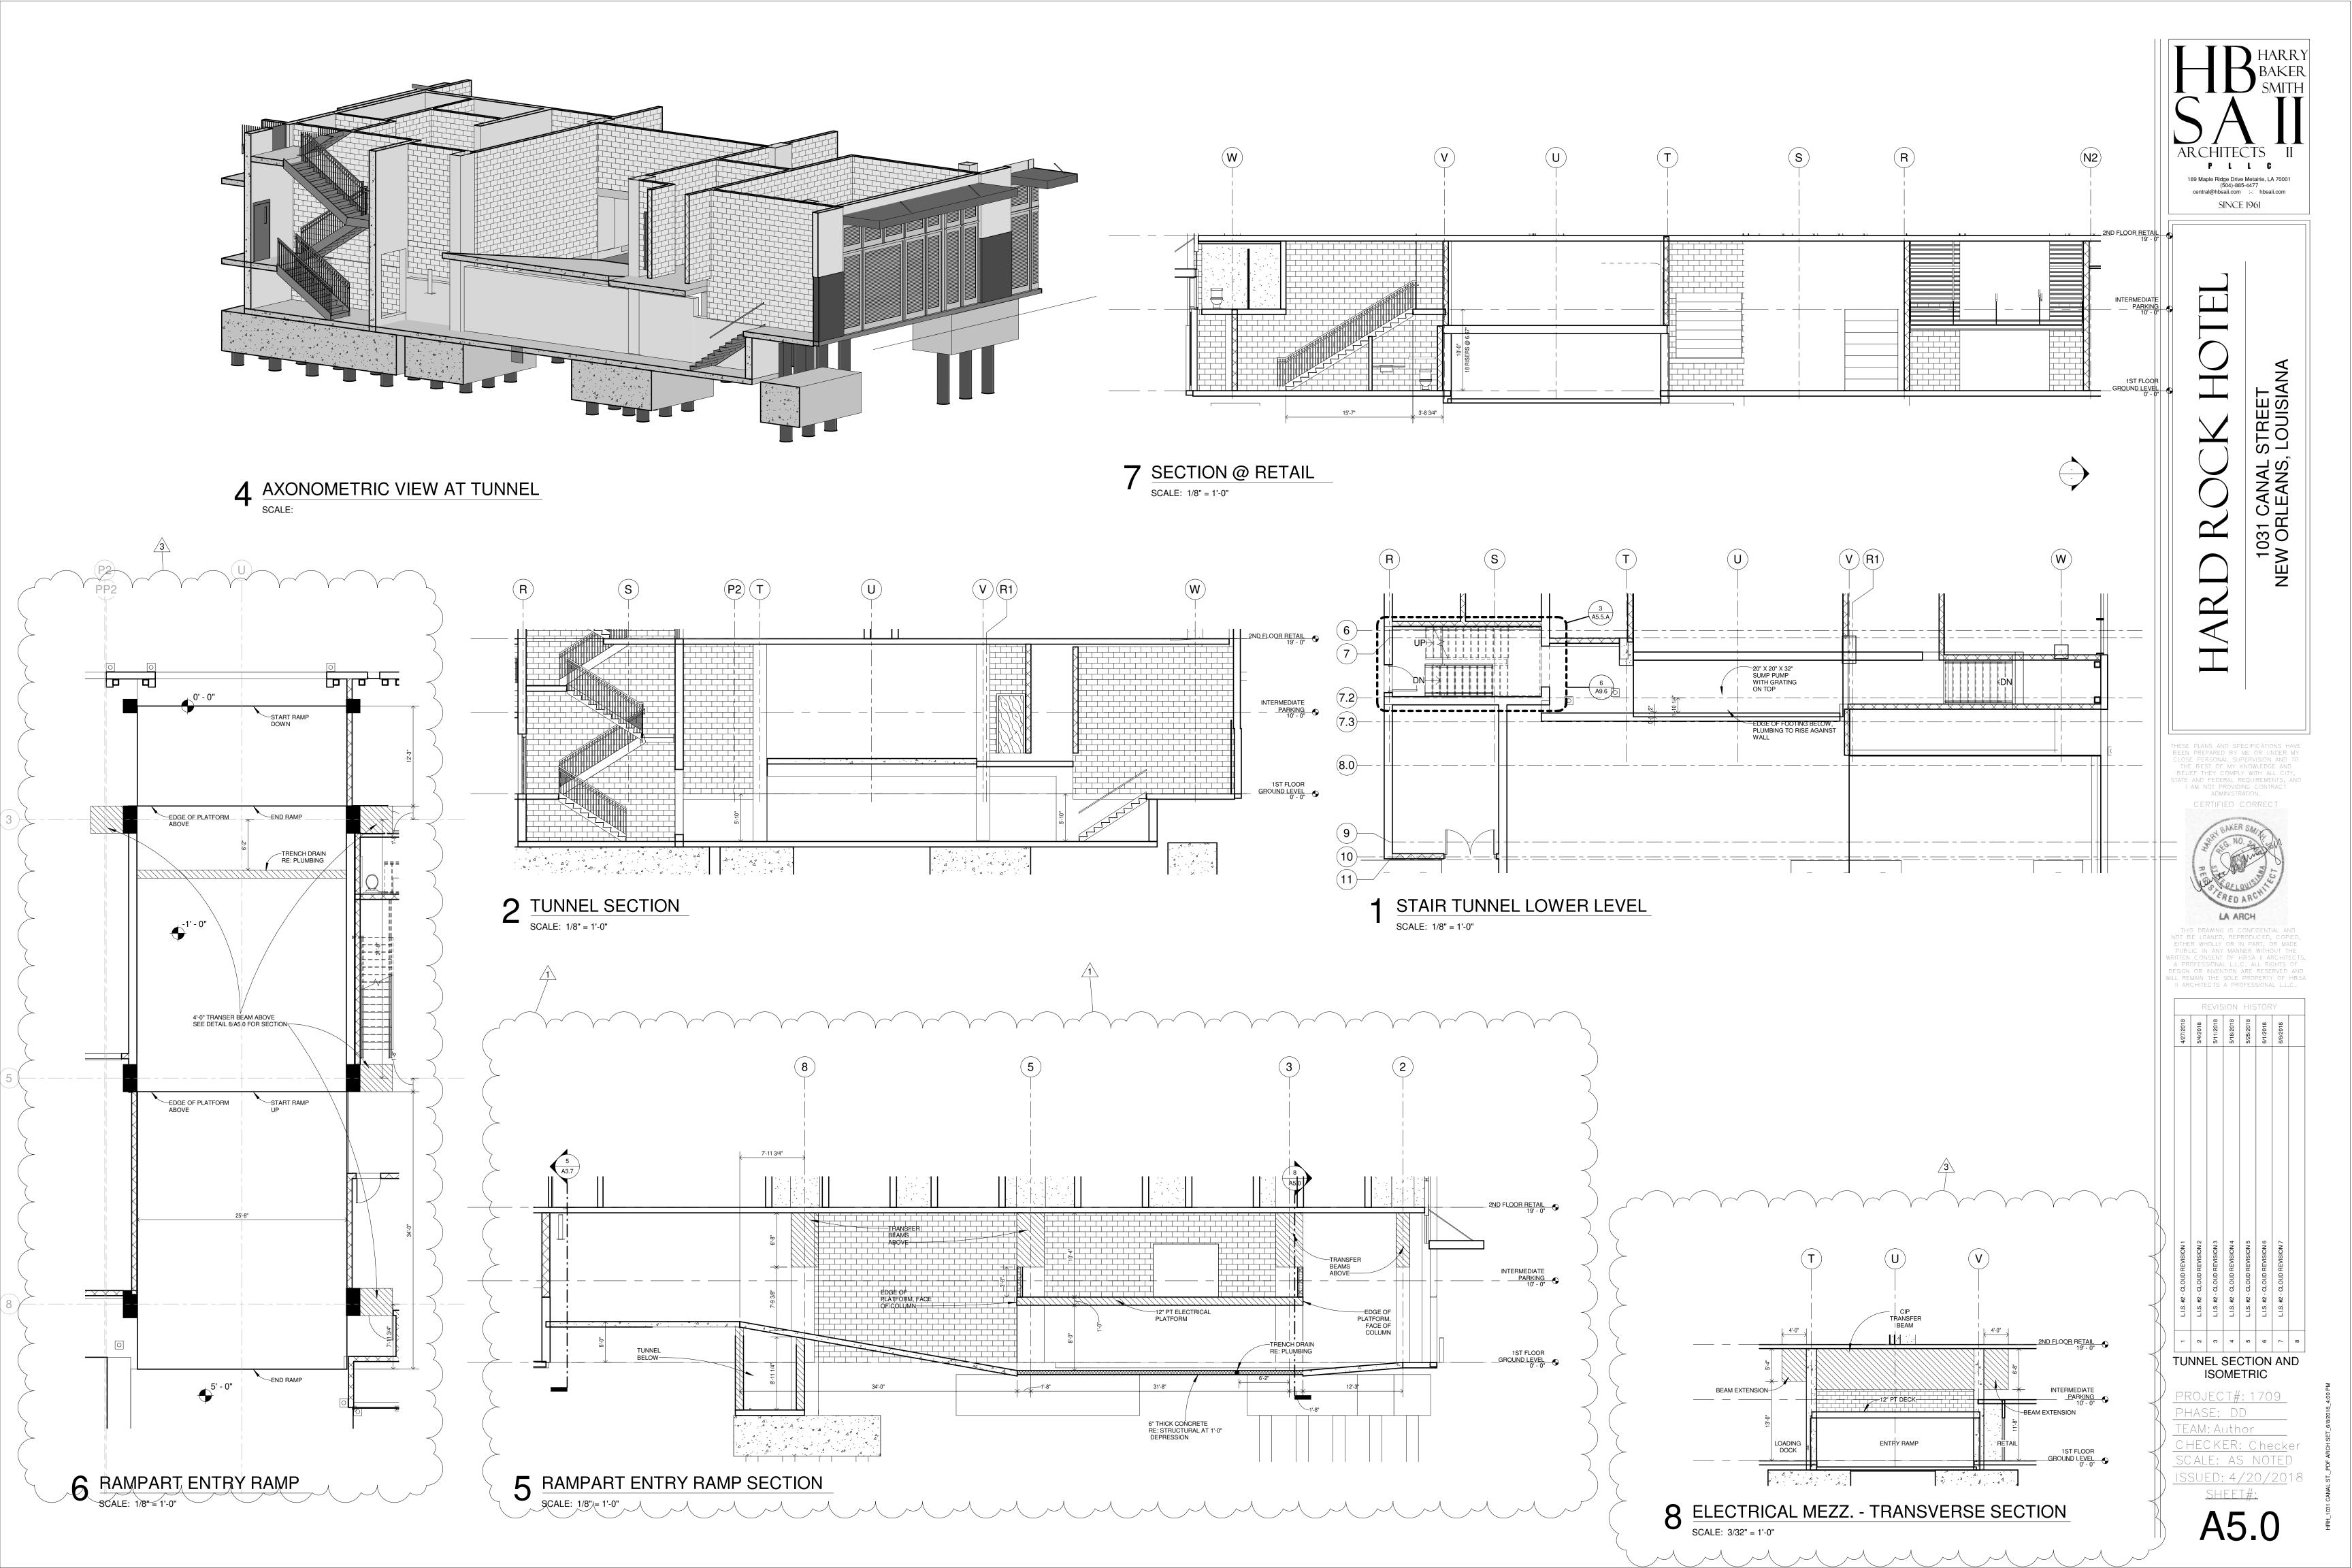

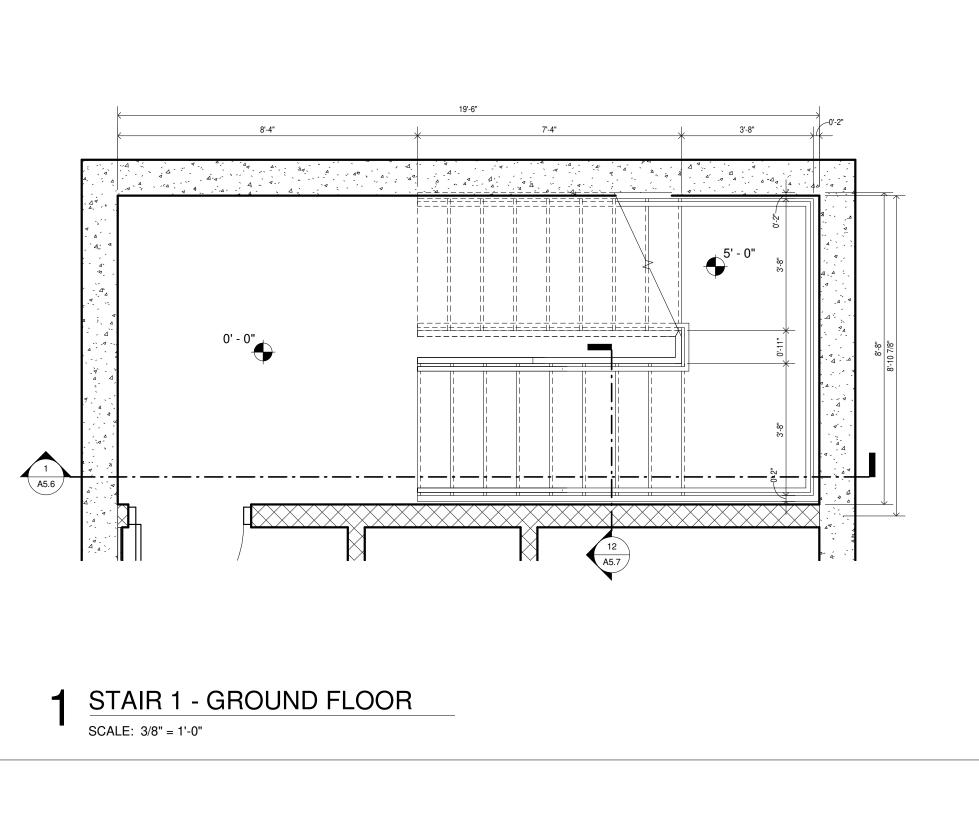


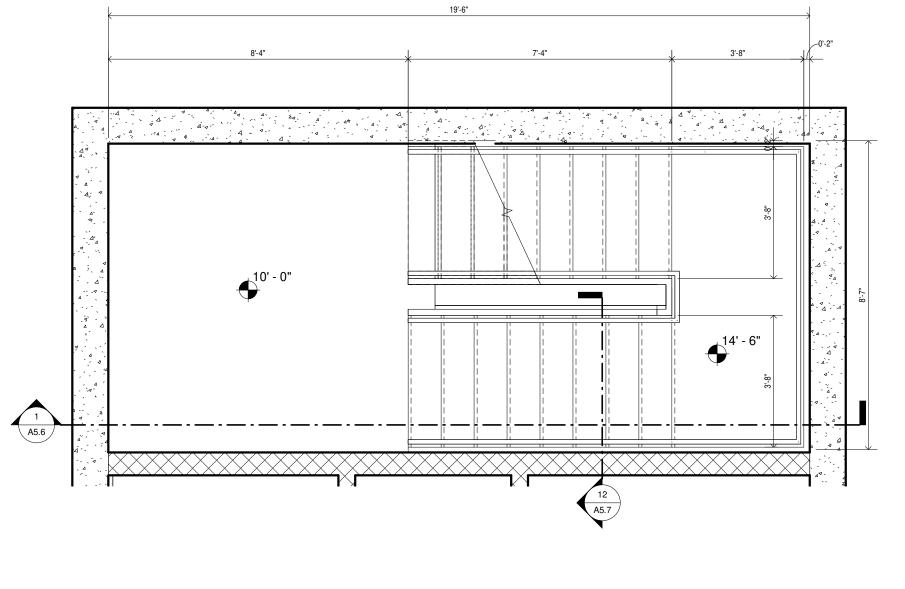


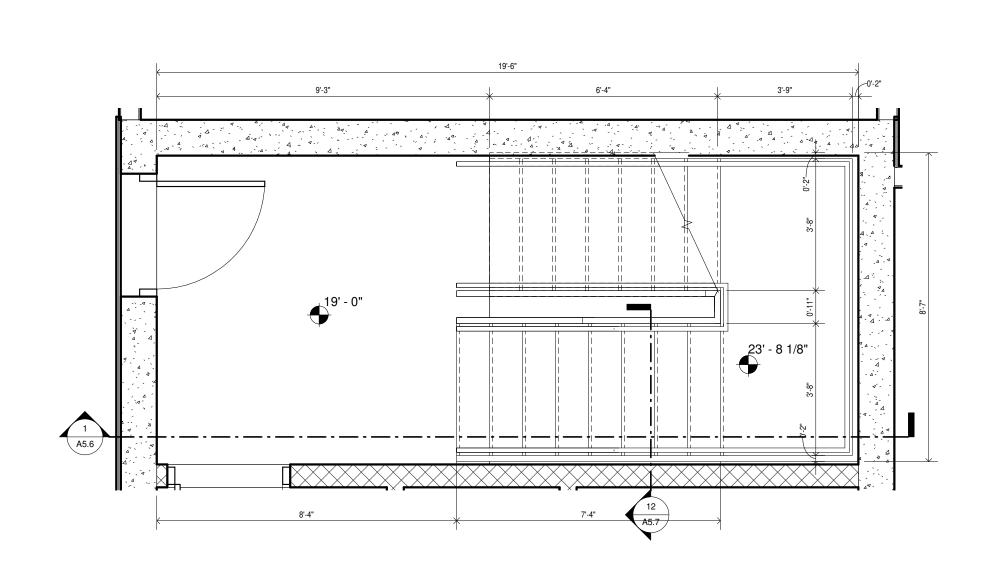



2 STAIR 1 - 2ND FLOOR

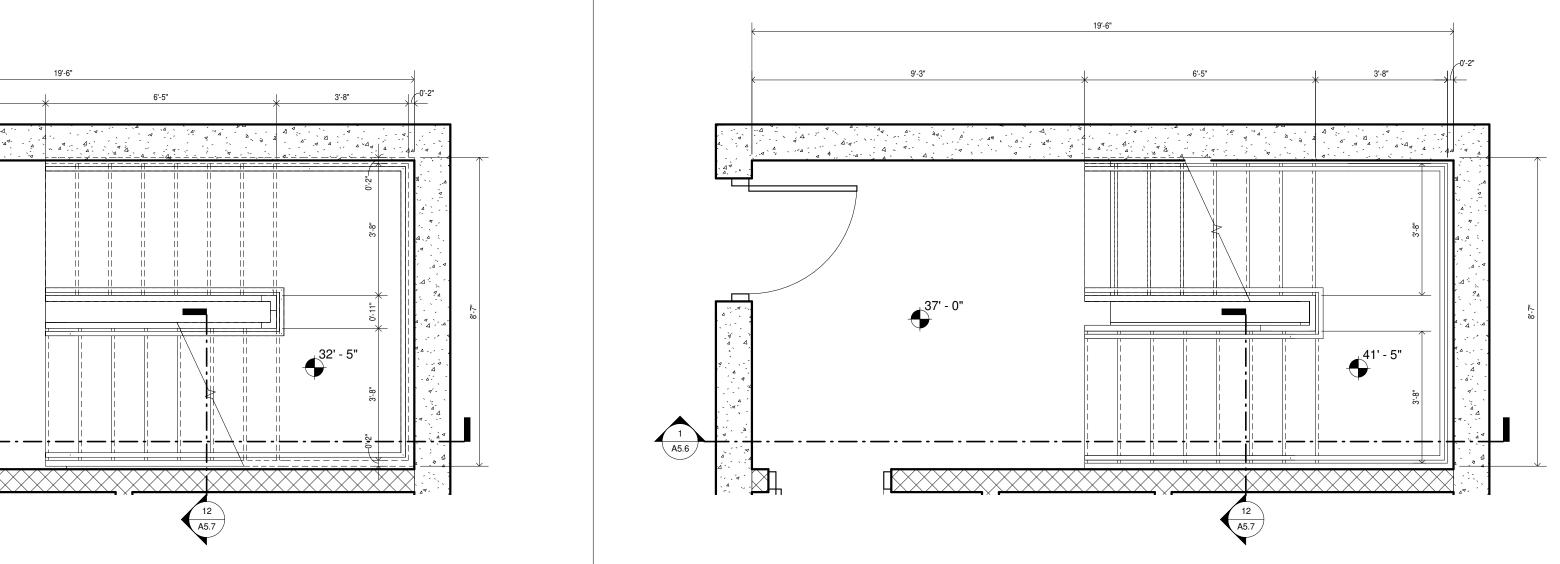


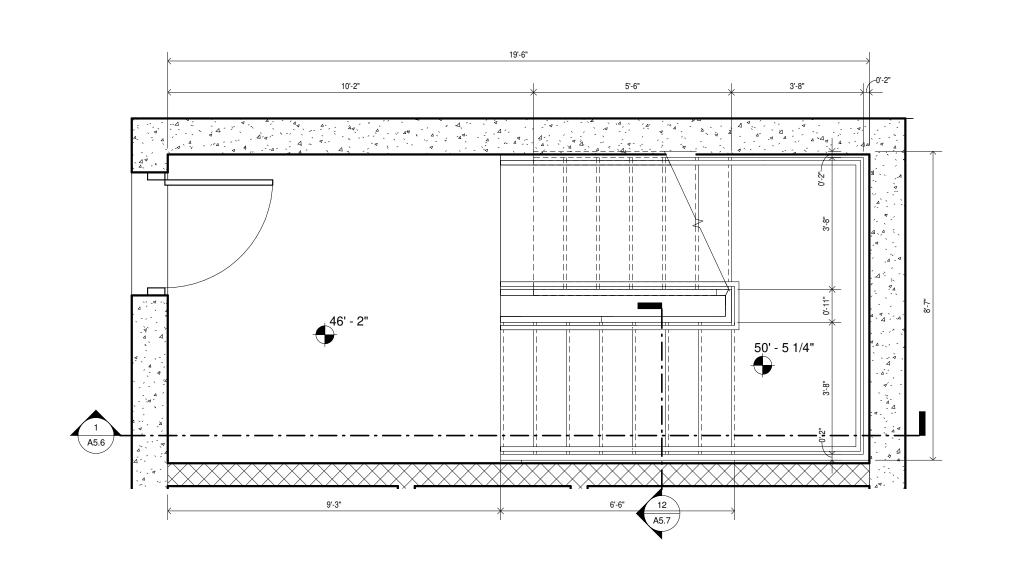


10 STAIR 1 - 3RD FLOOR
SCALE: 3/8" = 1'-0"


4 STAIR 1 - 4TH FLOOR

SCALE: 3/8" = 1'-0"

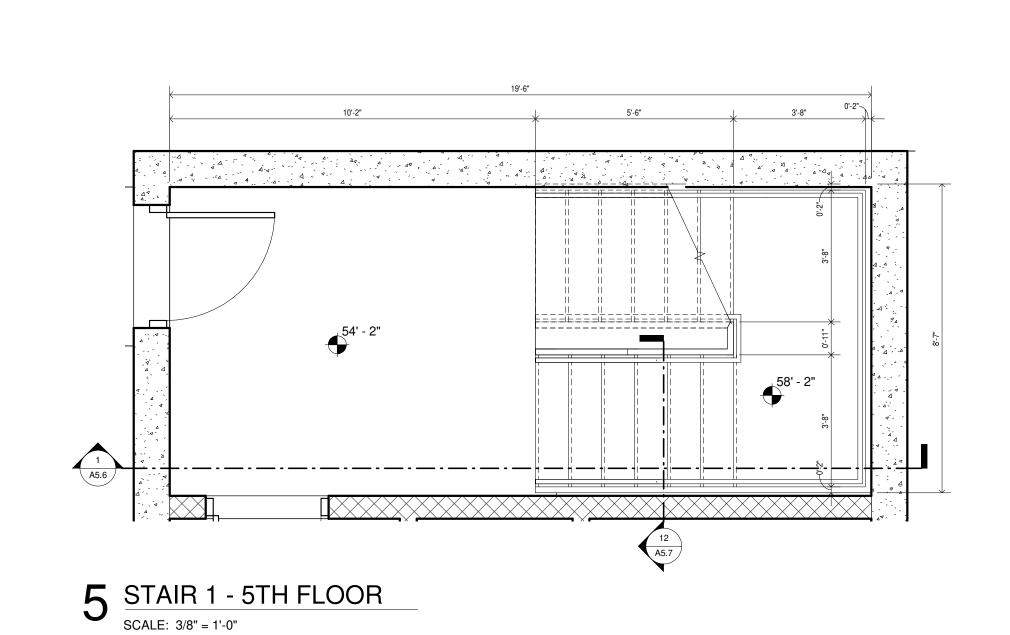


3 STAIR 1 - 2ND MEZZ FLOOR SCALE: 3/8" = 1'-0"

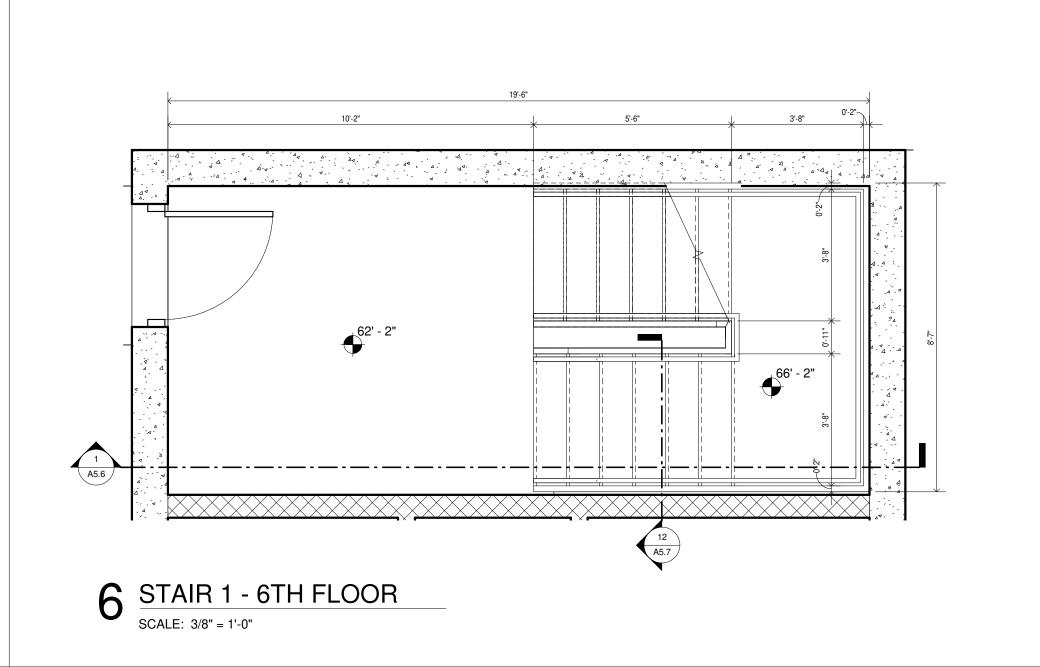

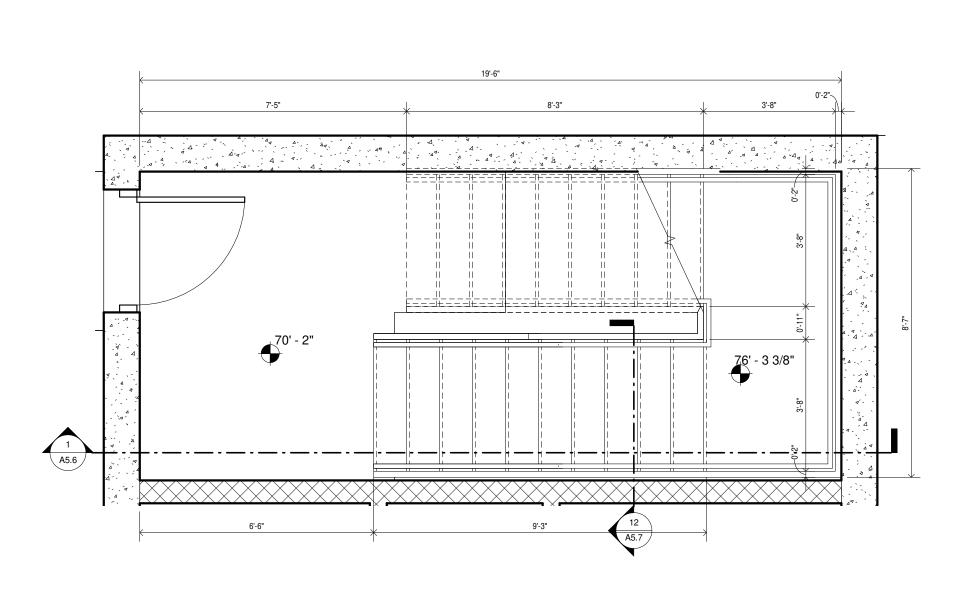

7 STAIR 1 - 7TH FLOOR

SCALE: 3/8" = 1'-0"

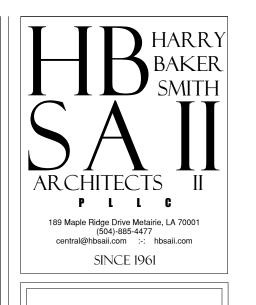

ARD ROCK HOTE

1031 CANAL STREET


NEW ORLEANS, LOUISIANA

ESE PLANS AND SPECIFICATIONS HAVE
EEN PREPARED BY ME OR UNDER MY
LOSE PERSONAL SUPERVISION AND TO
THE BEST OF MY KNOWLEDGE AND
BELIEF THEY COMPLY WITH ALL CITY,
ATE AND FEDERAL REQUIREMENTS, AND
I AM NOT PROVIDING CONTRACT
ADMINISTRATION.

CERTIFIED CORRECT




THIS DRAWING IS CONFIDENTIAL AND NOT BE LOANED, REPRODUCED, COPIED, EITHER WHOLLY OR IN PART, OR MADE PUBLIC IN ANY MANNER WITHOUT THE WRITTEN CONSENT OF HBSA II ARCHITECTS, A PROFESSIONAL LL.C. ALL RIGHTS OF DESIGN OR INVENTION ARE RESERVED AND WILL REMAIN THE SOLE PROPERTY OF HBSA

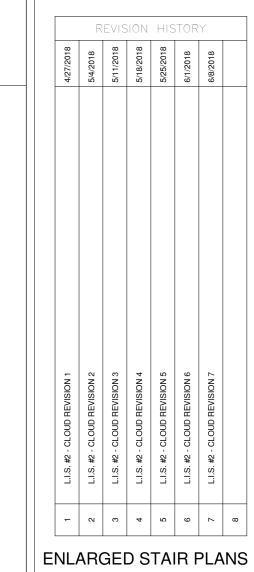


PROJECT#: 1709
PHASE: DD
TEAM: Author
CHECKER: Checker
SCALE: AS NOTED
ISSUED: 4/20/2018


A5.1

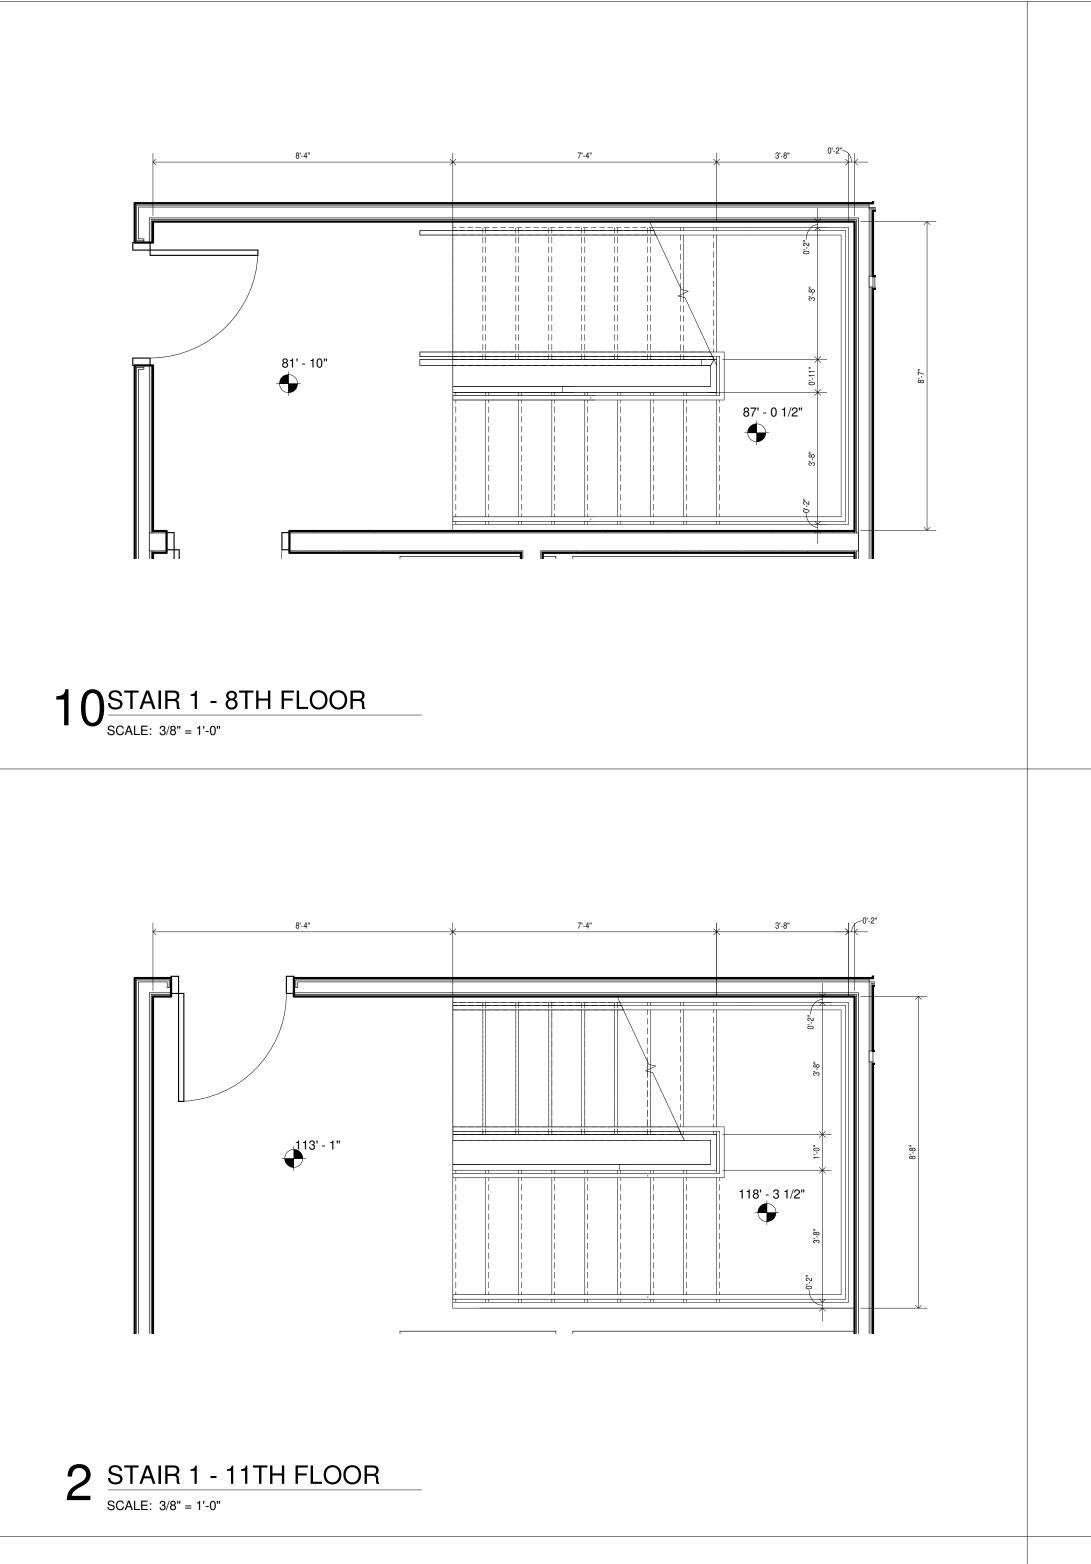


5 STAIR 1 - 14TH FLOOR


SCALE: 3/8" = 1'-0"

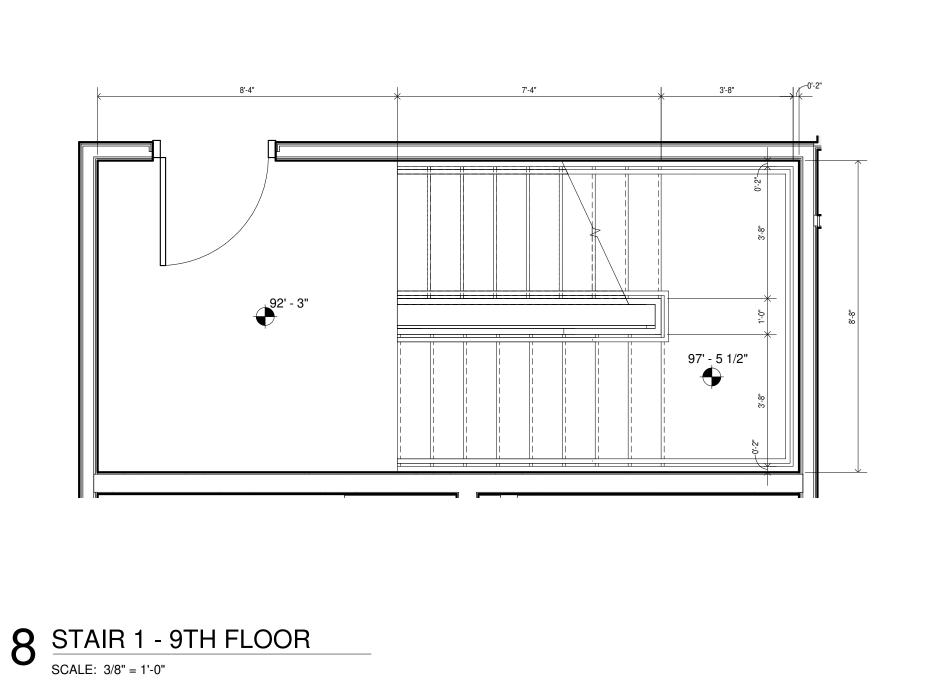

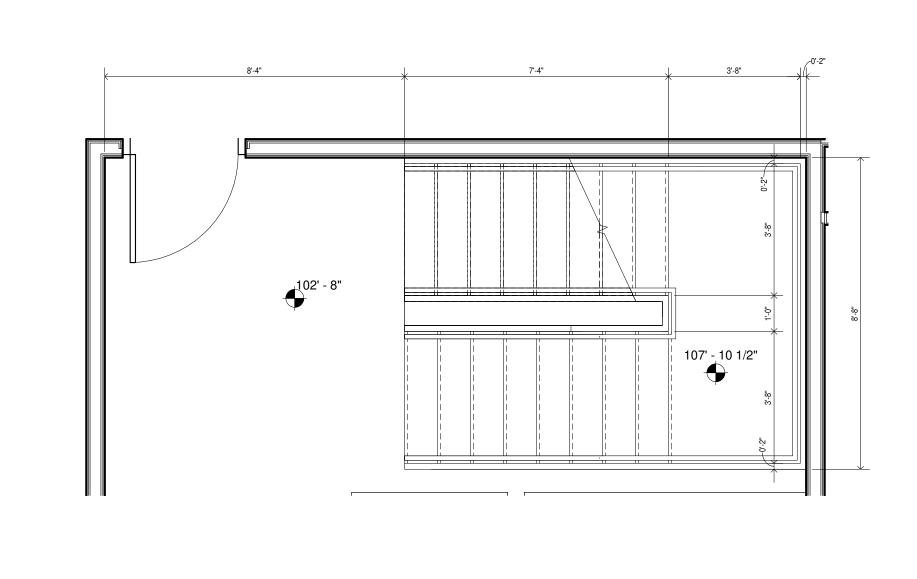





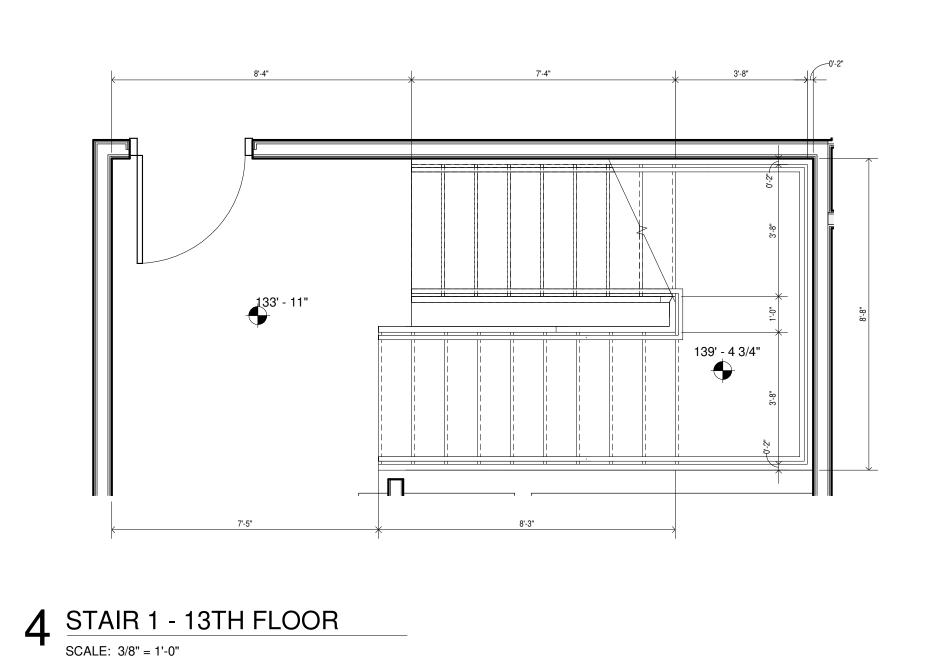


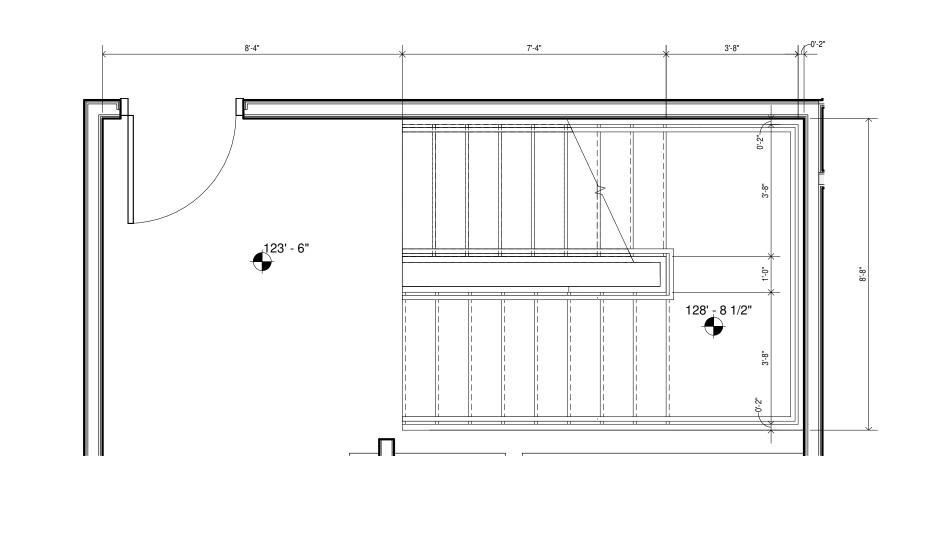

3 STAIR 1 - 12TH FLOOR
SCALE: 3/8" = 1'-0"

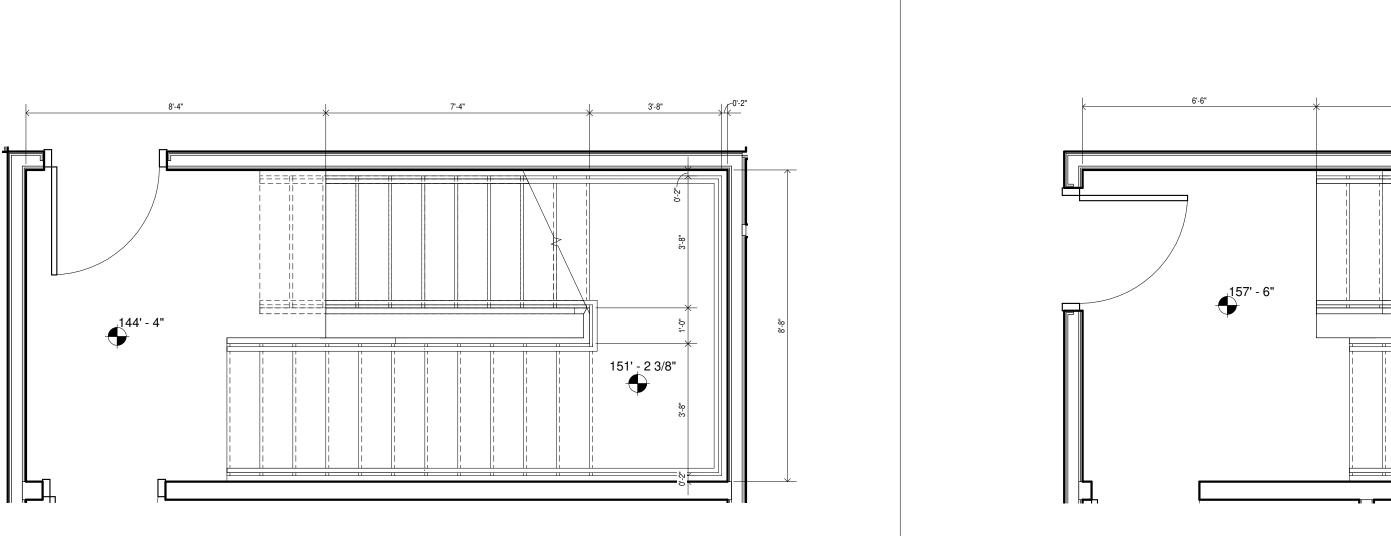


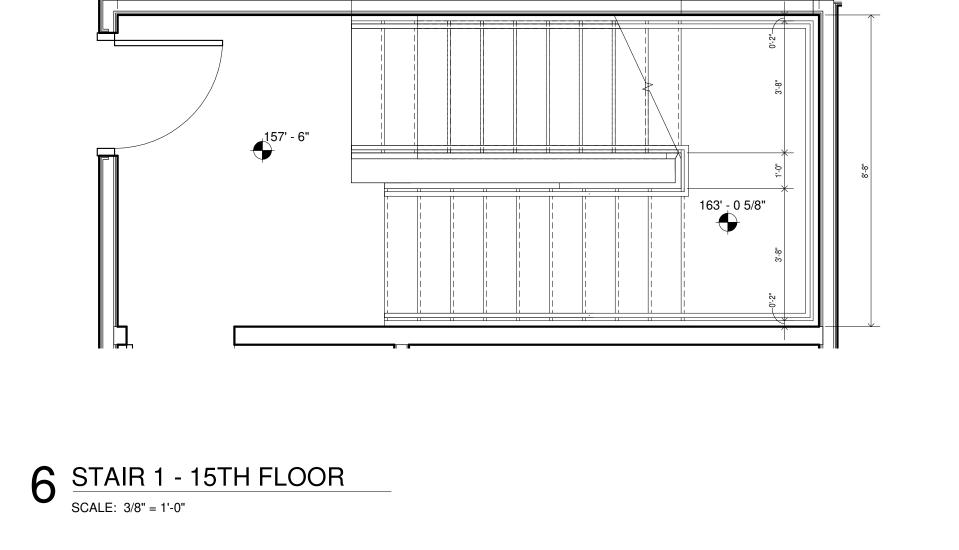

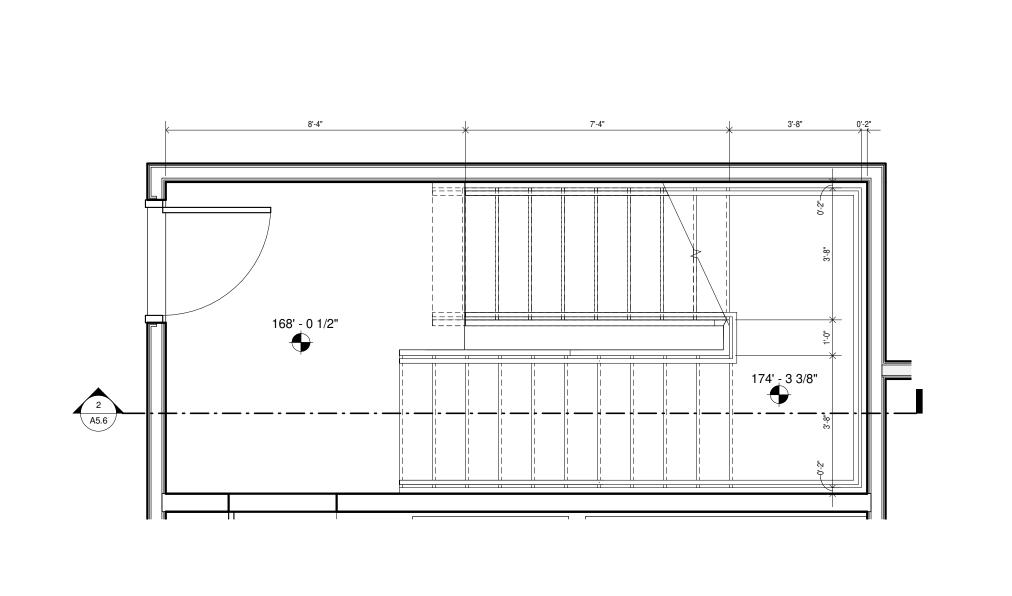

7 STAIR 1 - 16TH FLOOR

SCALE: 3/8" = 1'-0"

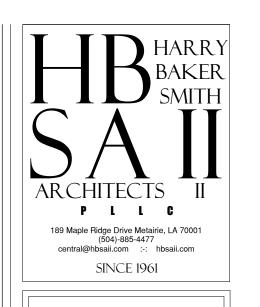

ARD ROCK HOTEL

1031 CANAL STREET


NEW ORLEANS, LOUISIANA

HESE PLANS AND SPECIFICATIONS HAVE BEEN PREPARED BY ME OR UNDER MY CLOSE PERSONAL SUPERVISION AND TO THE BEST OF MY KNOWLEDGE AND BELIEF THEY COMPLY WITH ALL CITY, TATE AND FEDERAL REQUIREMENTS, AND I AM NOT PROVIDING CONTRACT ADMINISTRATION.

CERTIFIED CORRECT



THIS DRAWING IS CONFIDENTIAL AND
NOT BE LOANED, REPRODUCED, COPIED,
EITHER WHOLLY OR IN PART, OR MADE
PUBLIC IN ANY MANNER WITHOUT THE
WRITTEN CONSENT OF HBSA II ARCHITECTS,
A PROFESSIONAL L.L.C. ALL RIGHTS OF
DESIGN OR INVENTION ARE RESERVED AND
WILL REMAIN THE SOLE PROPERTY OF HBSA

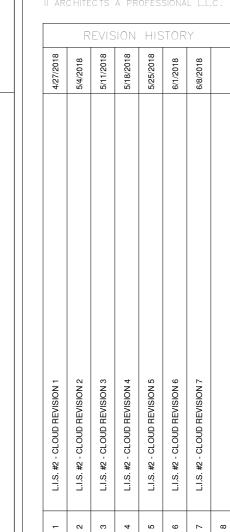

ENLARGED STAIR PLANS

PHASE: DD

TEAM: Author


CHECKER: Checker

SCALE: AS NOTED

ISSUED: 4/20/2018

A5.2

1 STAIR 1 - 17TH FLOOR
SCALE: 3/8" = 1'-0"

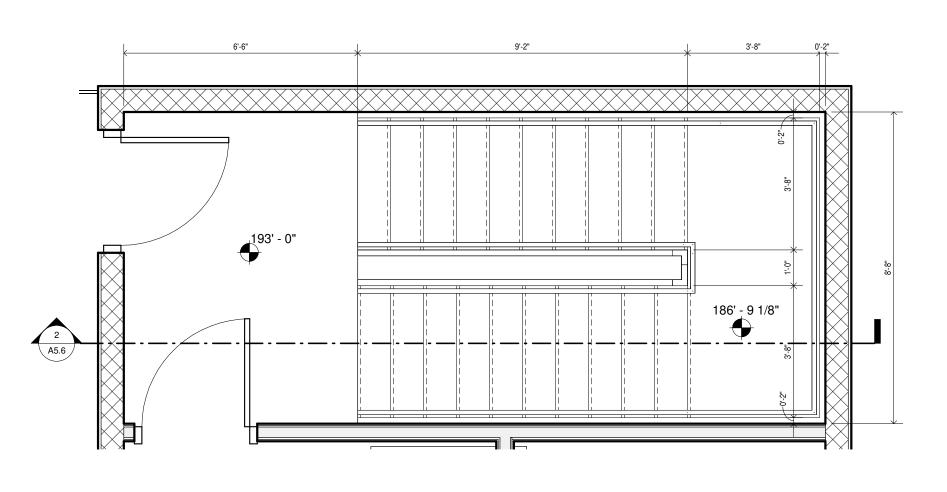

2 STAIR 1 - ROOF
SCALE: 3/8" = 1'-0"

189 Maple Ridge Drive Metairie, LA 70001 (504)-885-4477 central@hbsaii.com :-: hbsaii.com

SINCE 1961

1031 CANAL STREET NEW ORLEANS, LOUISIANA

THESE PLANS AND SPECIFICATIONS HAVE BEEN PREPARED BY ME OR UNDER MY CLOSE PERSONAL SUPERVISION AND TO THE BEST OF MY KNOWLEDGE AND BELIEF THEY COMPLY WITH ALL CITY, STATE AND FEDERAL REQUIREMENTS, AND I AM NOT PROVIDING CONTRACT ADMINISTRATION. CERTIFIED CORRECT



| Į |  |                              |                              |                              |                              |                              |                              |                              |  |
|---|--|------------------------------|------------------------------|------------------------------|------------------------------|------------------------------|------------------------------|------------------------------|--|
|   |  |                              | R                            | EVIS                         | SION                         | HIS                          | TOR                          | Υ                            |  |
|   |  | 4/27/2018                    | 5/4/2018                     | 5/11/2018                    | 5/18/2018                    | 5/25/2018                    | 6/1/2018                     | 6/8/2018                     |  |
|   |  | L.I.S. #2 - CLOUD REVISION 1 | L.I.S. #2 - CLOUD REVISION 2 | L.I.S. #2 - CLOUD REVISION 3 | L.I.S. #2 - CLOUD REVISION 4 | L.I.S. #2 - CLOUD REVISION 5 | L.I.S. #2 - CLOUD REVISION 6 | L.I.S. #2 - CLOUD REVISION 7 |  |
|   |  |                              |                              |                              |                              |                              |                              |                              |  |

ENLARGED STAIR PLANS

PROJECT#: 1709
PHASE: DD
TEAM: Author TEAM: Author


CHECKER: Checker

SCALE: AS NOTED

ISSUED: 4/20/2018

SHEET#:

A5.2.A

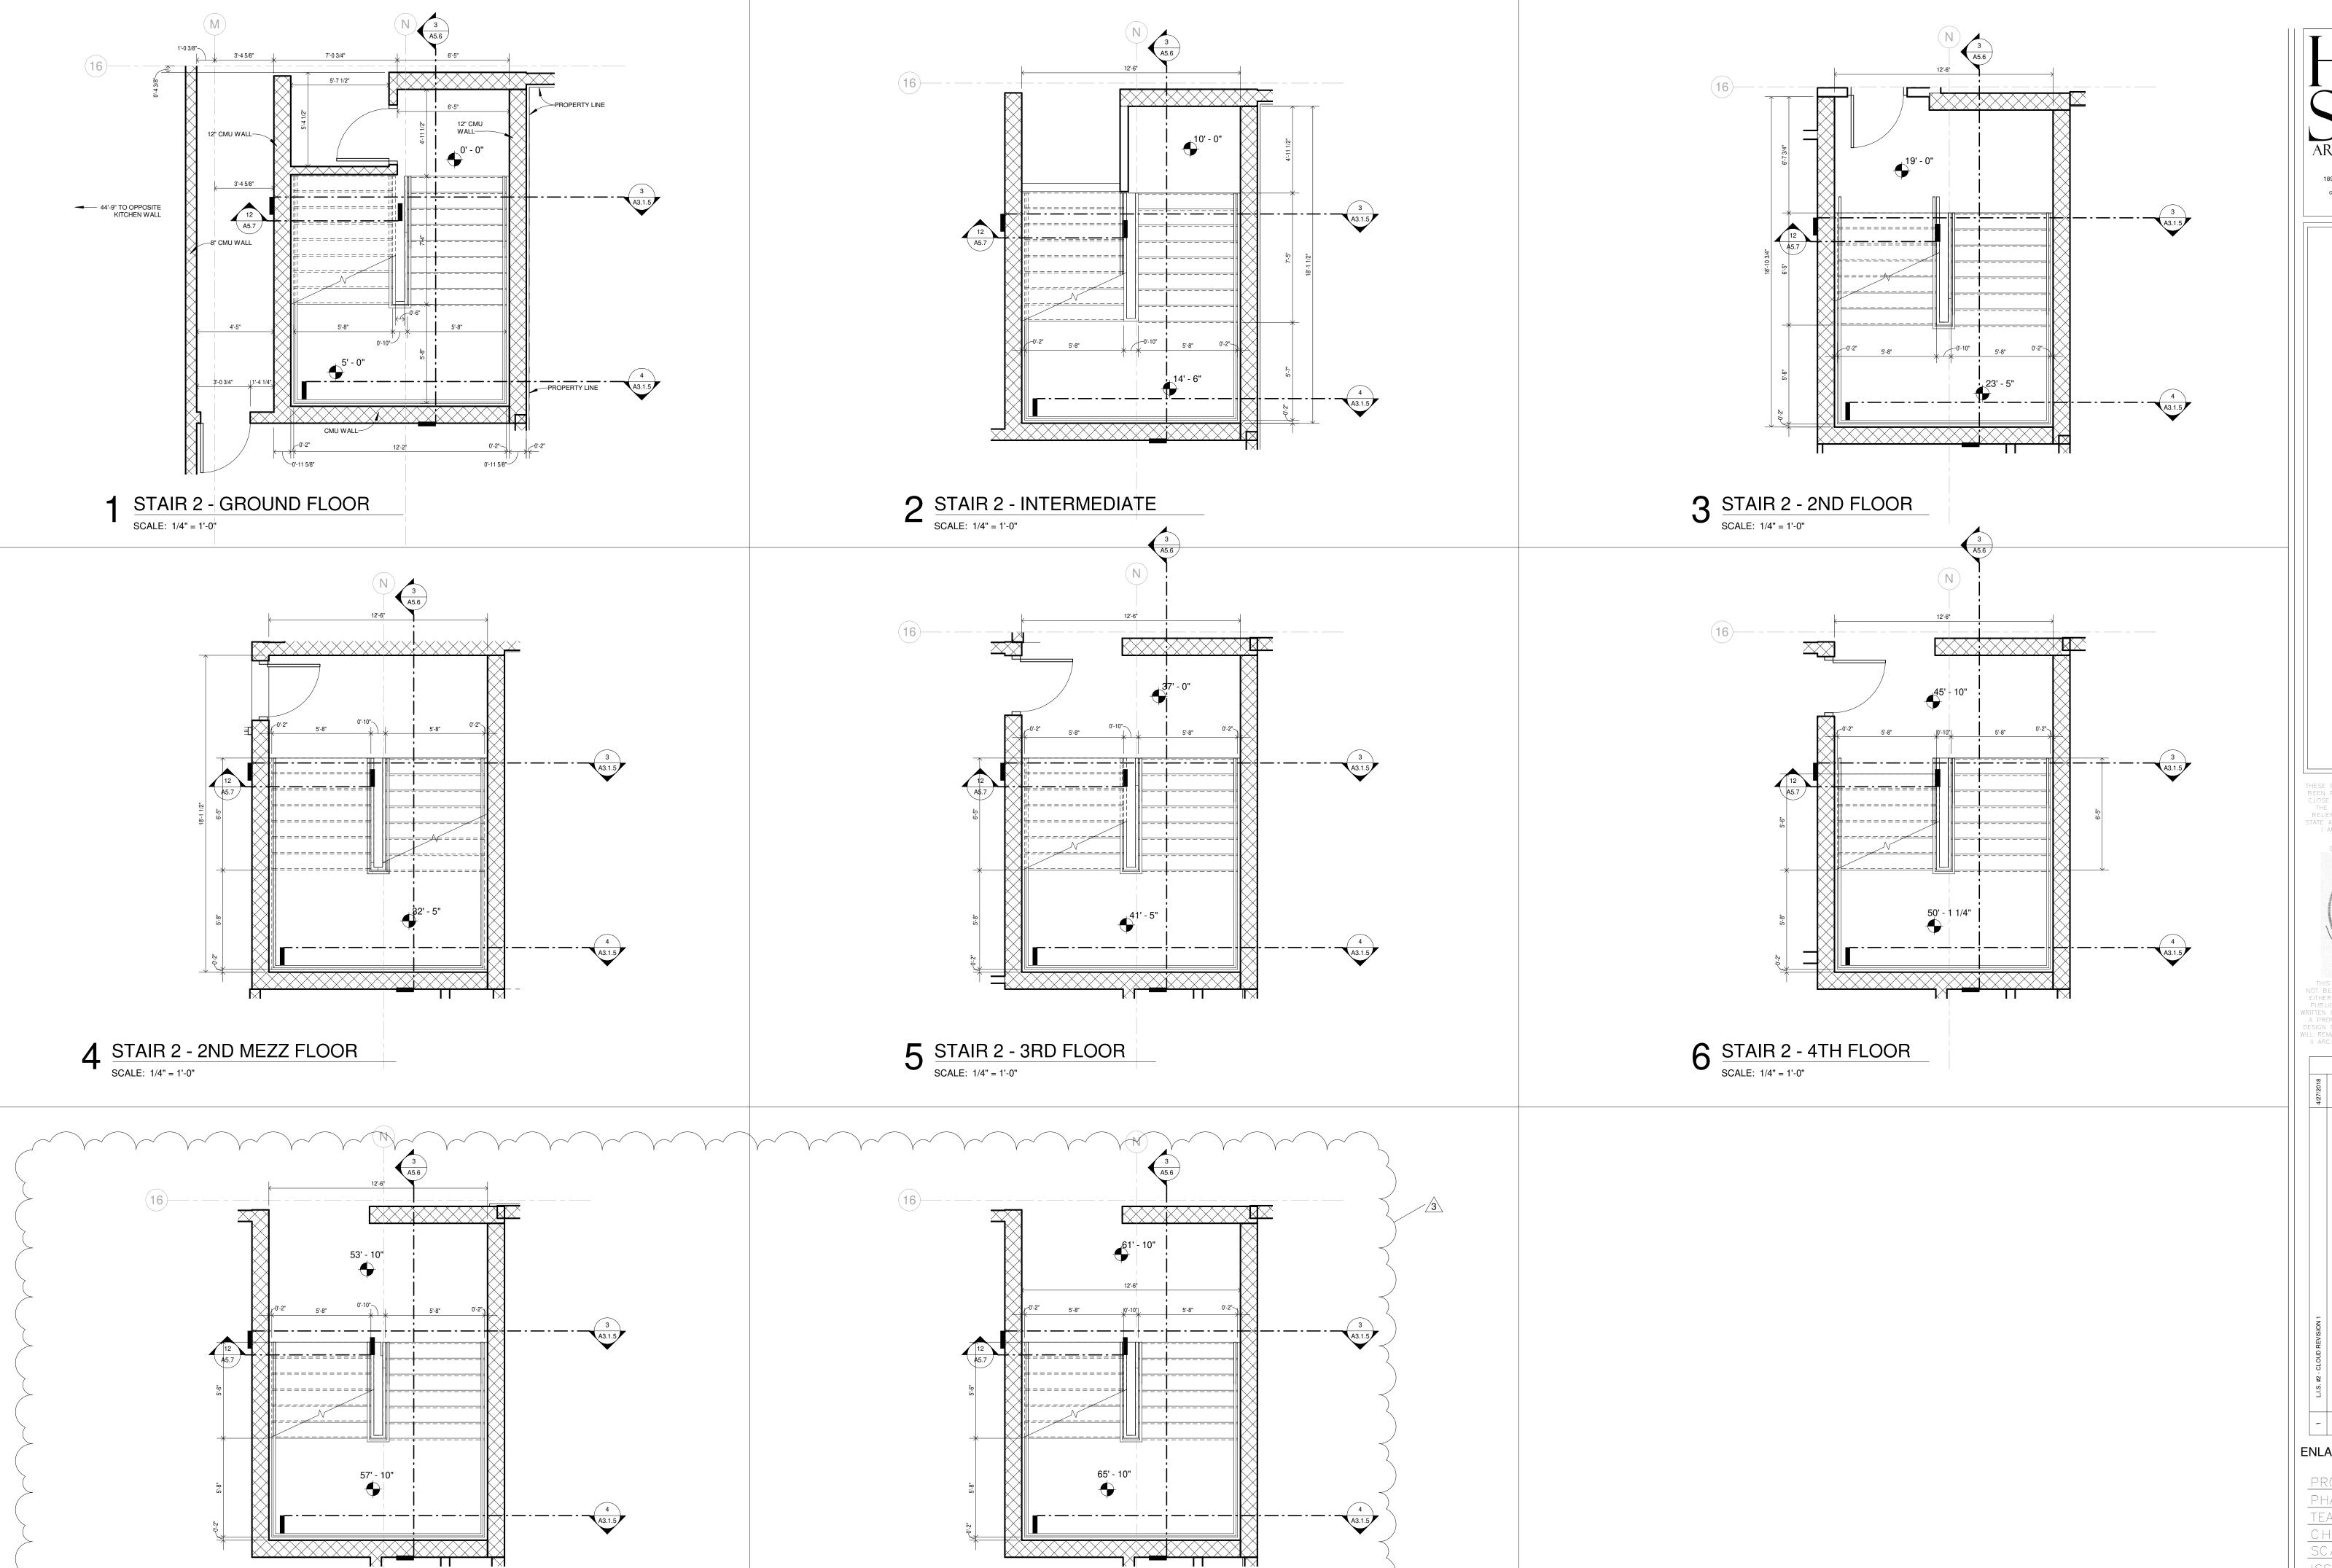

8 STAIR 2 - 6TH FLOOR
SCALE: 1/4" = 1'-0"

7 STAIR 2 - 5TH FLOOR
SCALE: 1/4" = 1'-0"

HARRY
BAKER
SMITH
SMITH
ARCHITECTS II
P L C

189 Maple Ridge Drive Metairie, LA 70001
(504)-885-4477
central@hbsaii.com :: hbsaii.com
SINCE 1961

DROCKHOTEL


1031 CANAL STREET
NEW ORLEANS, LOUISIANA

E PLANS AND SPECIFICATIONS HAVE
I PREPARED BY ME OR UNDER MY
SE PERSONAL SUPERVISION AND TO
EE BEST OF MY KNOWLEDGE AND
JEF THEY COMPLY WITH ALL CITY,
AND FEDERAL REQUIREMENTS, AND
AM NOT PROVIDING CONTRACT
ADMINISTRATION.

CERTIFIED CORRECT




THIS DRAWING IS CONFIDENTIAL AND NOT BE LOANED, REPRODUCED, COPIED, EITHER WHOLLY OR IN PART, OR MADE PUBLIC IN ANY MANNER WITHOUT THE WRITTEN CONSENT OF HBSA II ARCHITECTS, A PROFESSIONAL L.L.C. ALL RIGHTS OF DESIGN OR INVENTION ARE RESERVED AND WILL REMAIN THE SOLE PROPERTY OF HBSA

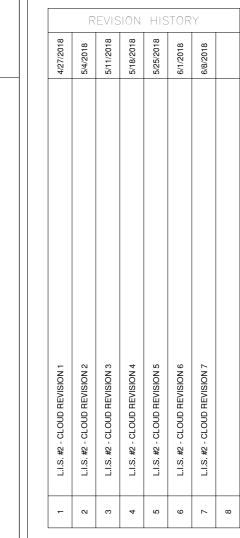


ENLARGED STAIR PLANS

PROJECT#: 1709
PHASE: DD
TEAM: Author
CHECKER: Checker
SCALE: AS NOTED
ISSUED: 4/20/2018

A5.3

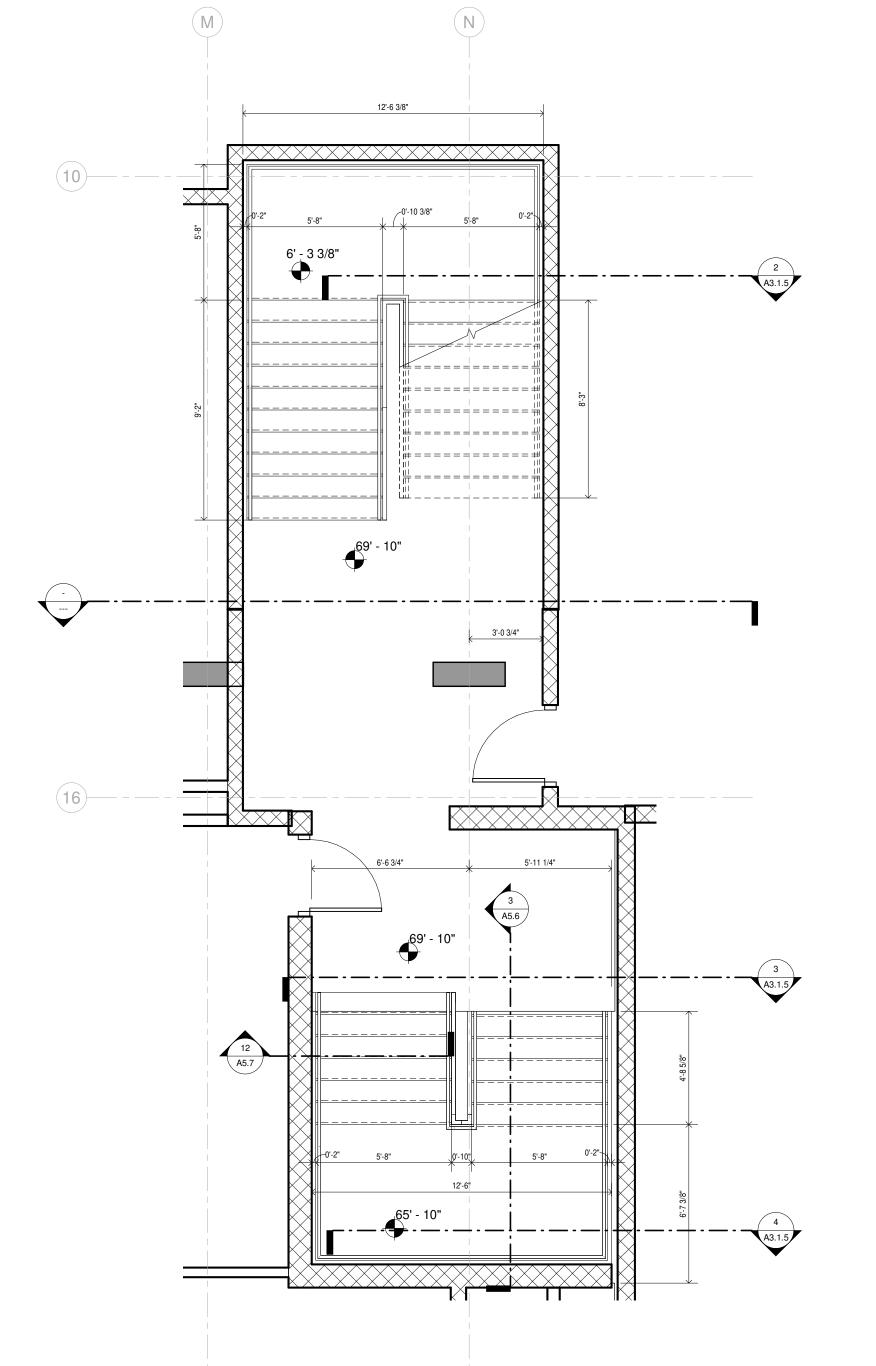

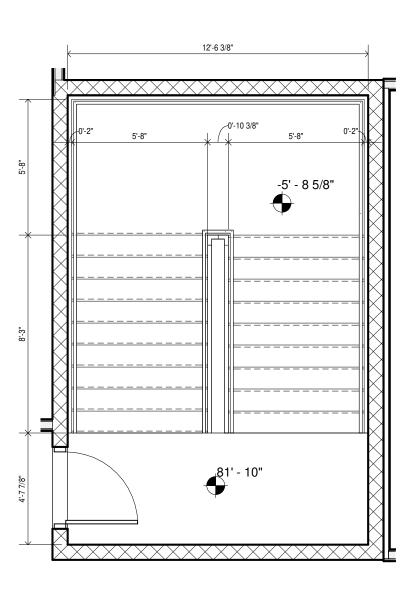

2 STAIR 2 - 8TH FLOOR

SCALE: 1/4" = 1'-0"

STAIR 2 - 7TH FLOOR

SCALE: 1/4" = 1'-0"

HARRY
BAKER
SMITH
SMITH
ARCHITECTS II
P L C

189 Maple Ridge Drive Metairie, LA 70001
(504)-885-4477
central@hbsaii.com :: hbsaii.com
SINCE 1961

HARD ROCK HOTE

THESE PLANS AND SPECIFICATIONS HAVE BEEN PREPARED BY ME OR UNDER MY CLOSE PERSONAL SUPERVISION AND TO THE BEST OF MY KNOWLEDGE AND BELIEF THEY COMPLY WITH ALL CITY, STATE AND FEDERAL REQUIREMENTS, AND I AM NOT PROVIDING CONTRACT ADMINISTRATION.

CERTIFIED CORRECT




THIS DRAWING IS CONFIDENTIAL AND
NOT BE LOANED, REPRODUCED, COPIED,
EITHER WHOLLY OR IN PART, OR MADE
PUBLIC IN ANY MANNER WITHOUT THE
WRITTEN CONSENT OF HBSA II ARCHITECTS,
A PROFESSIONAL L.L.C. ALL RIGHTS OF
DESIGN OR INVENTION ARE RESERVED AND
WILL REMAIN THE SOLE PROPERTY OF HBSA
II ARCHITECTS A PROFESSIONAL L.L.C.


|                              | R                            | EVIS                         | SION                         | HIS                          | TOR                          | Υ                            |  |
|------------------------------|------------------------------|------------------------------|------------------------------|------------------------------|------------------------------|------------------------------|--|
| 4/27/2018                    | 5/4/2018                     | 5/11/2018                    | 5/18/2018                    | 5/25/2018                    | 6/1/2018                     | 6/8/2018                     |  |
|                              |                              |                              |                              |                              |                              |                              |  |
| L.I.S. #2 - CLOUD REVISION 1 | L.I.S. #2 - CLOUD REVISION 2 | L.I.S. #2 - CLOUD REVISION 3 | L.I.S. #2 - CLOUD REVISION 4 | L.I.S. #2 - CLOUD REVISION 5 | L.I.S. #2 - CLOUD REVISION 6 | L.I.S. #2 - CLOUD REVISION 7 |  |


ENLARGED STAIR PLANS

PROJECT#: 1709
PHASE: DD
TEAM: Author
CHECKER: Checker
SCALE: AS NOTED
ISSUED: 4/20/2018

Δ53Δ

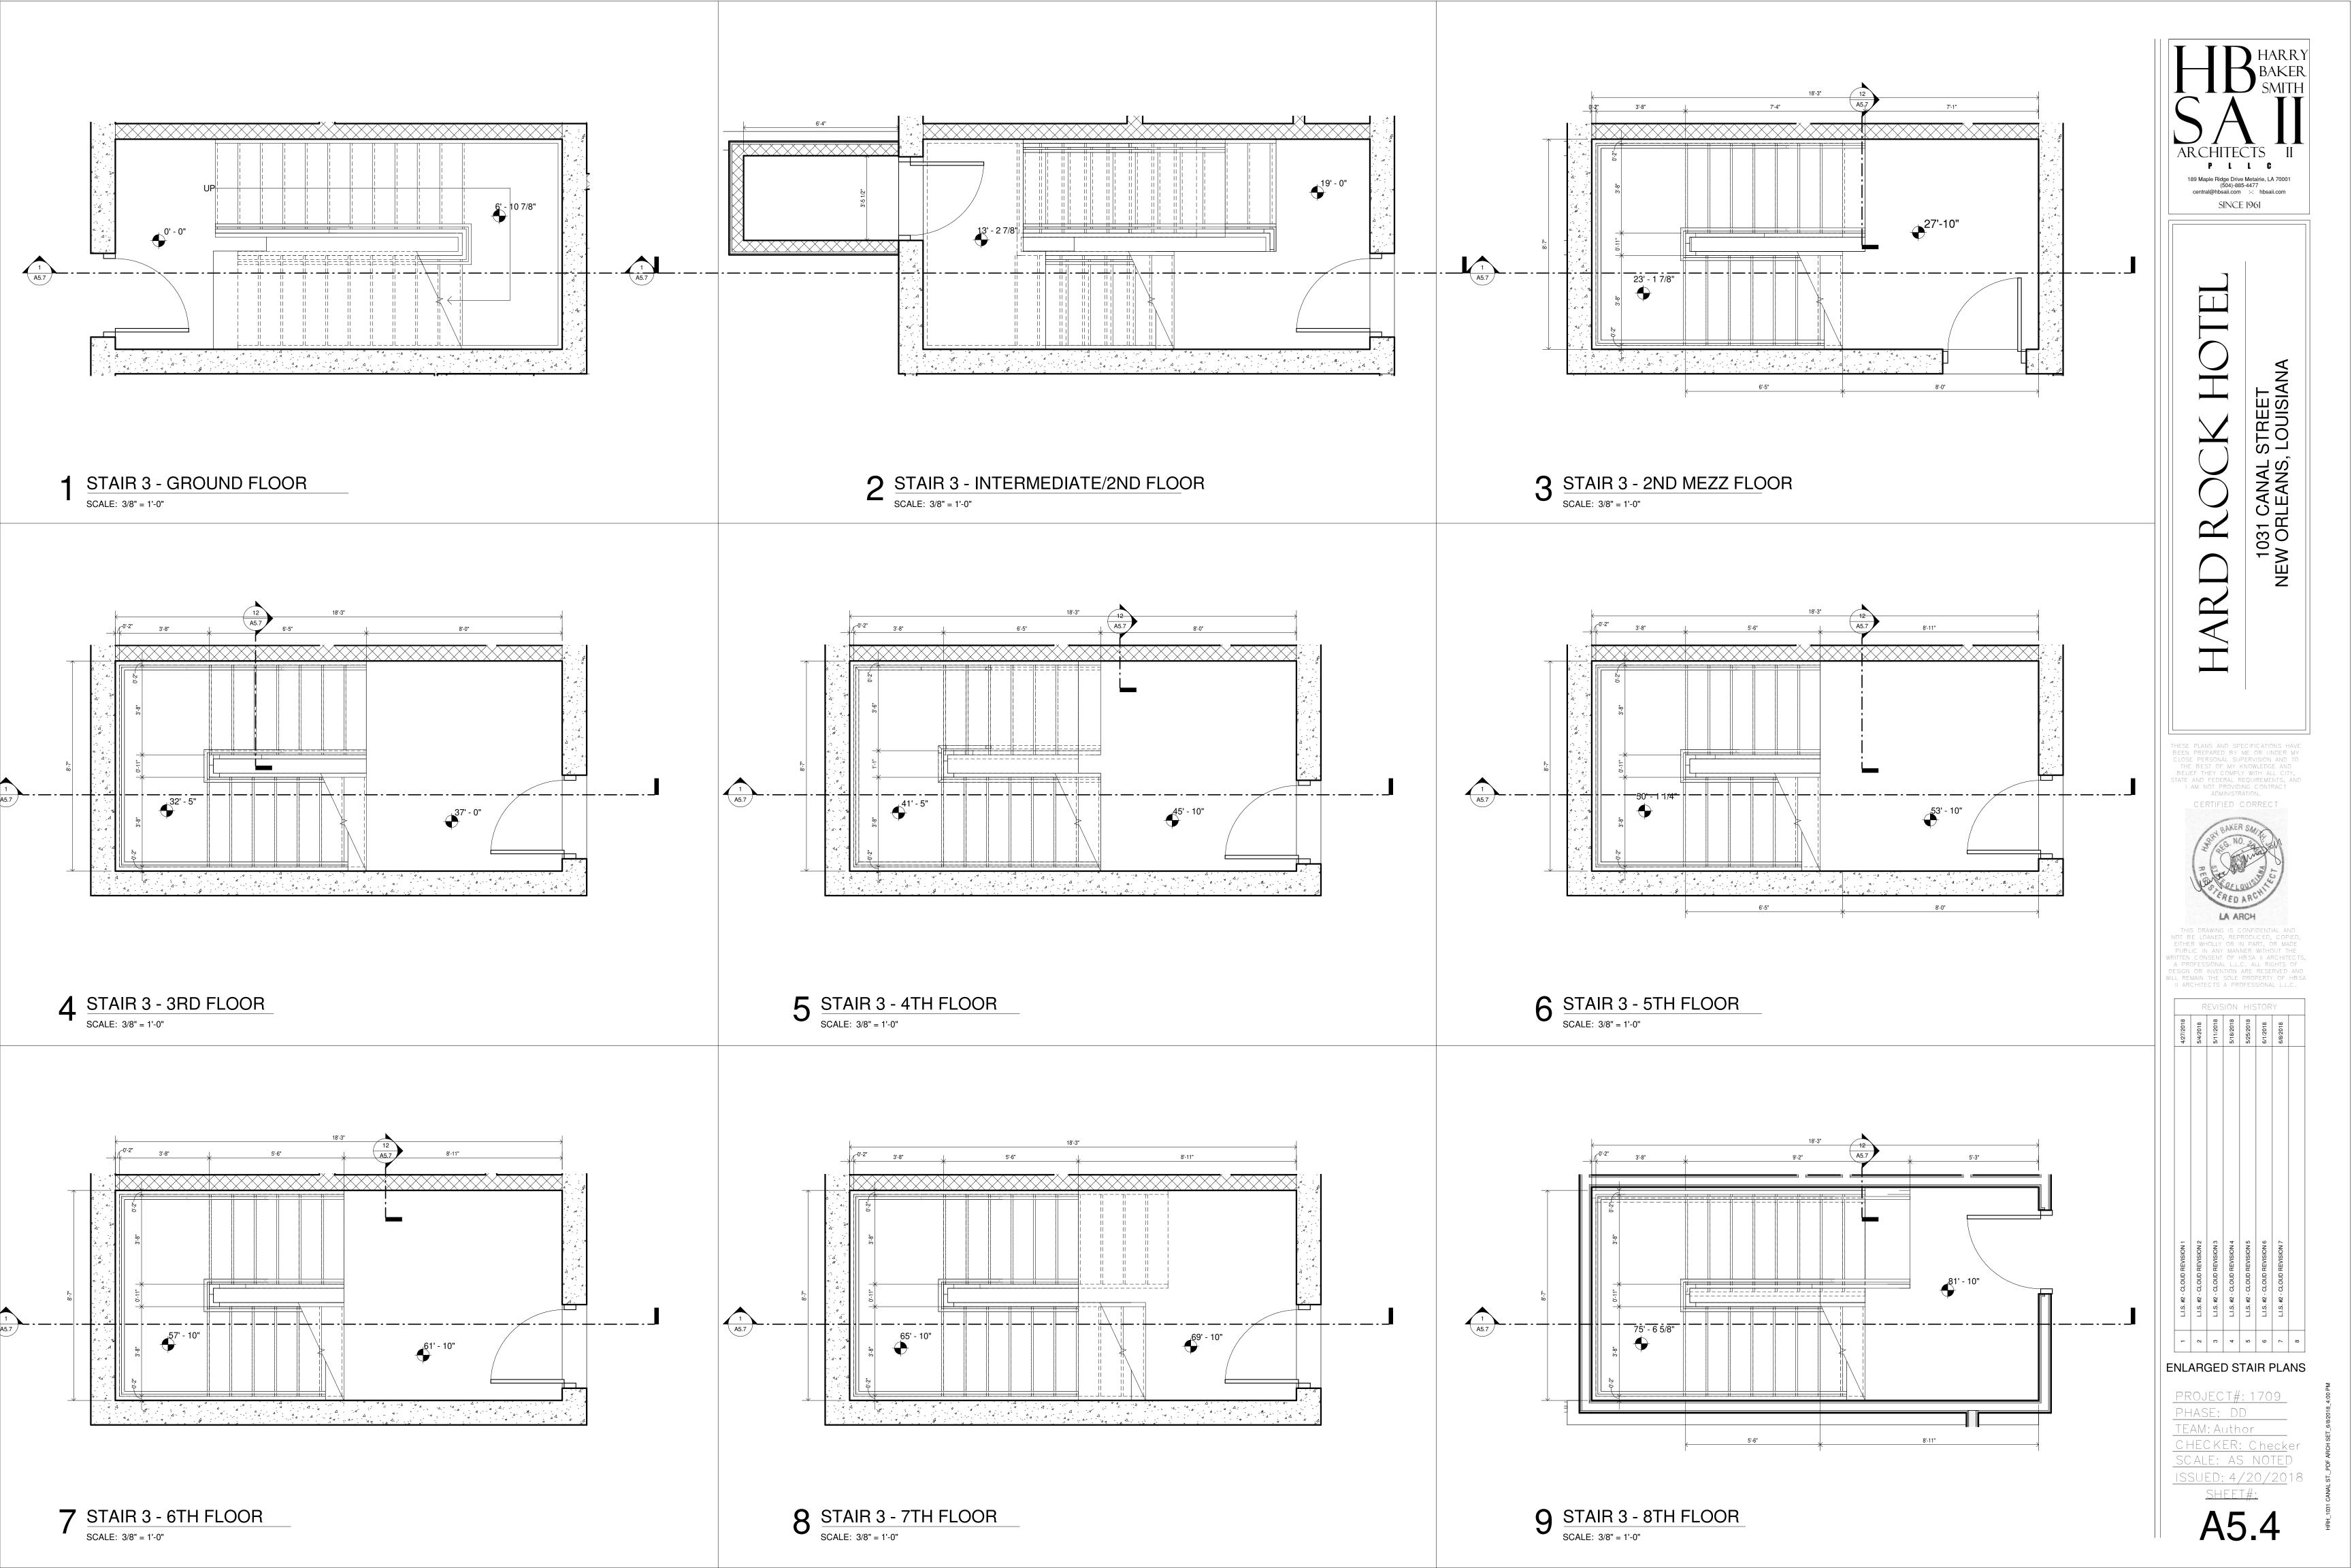

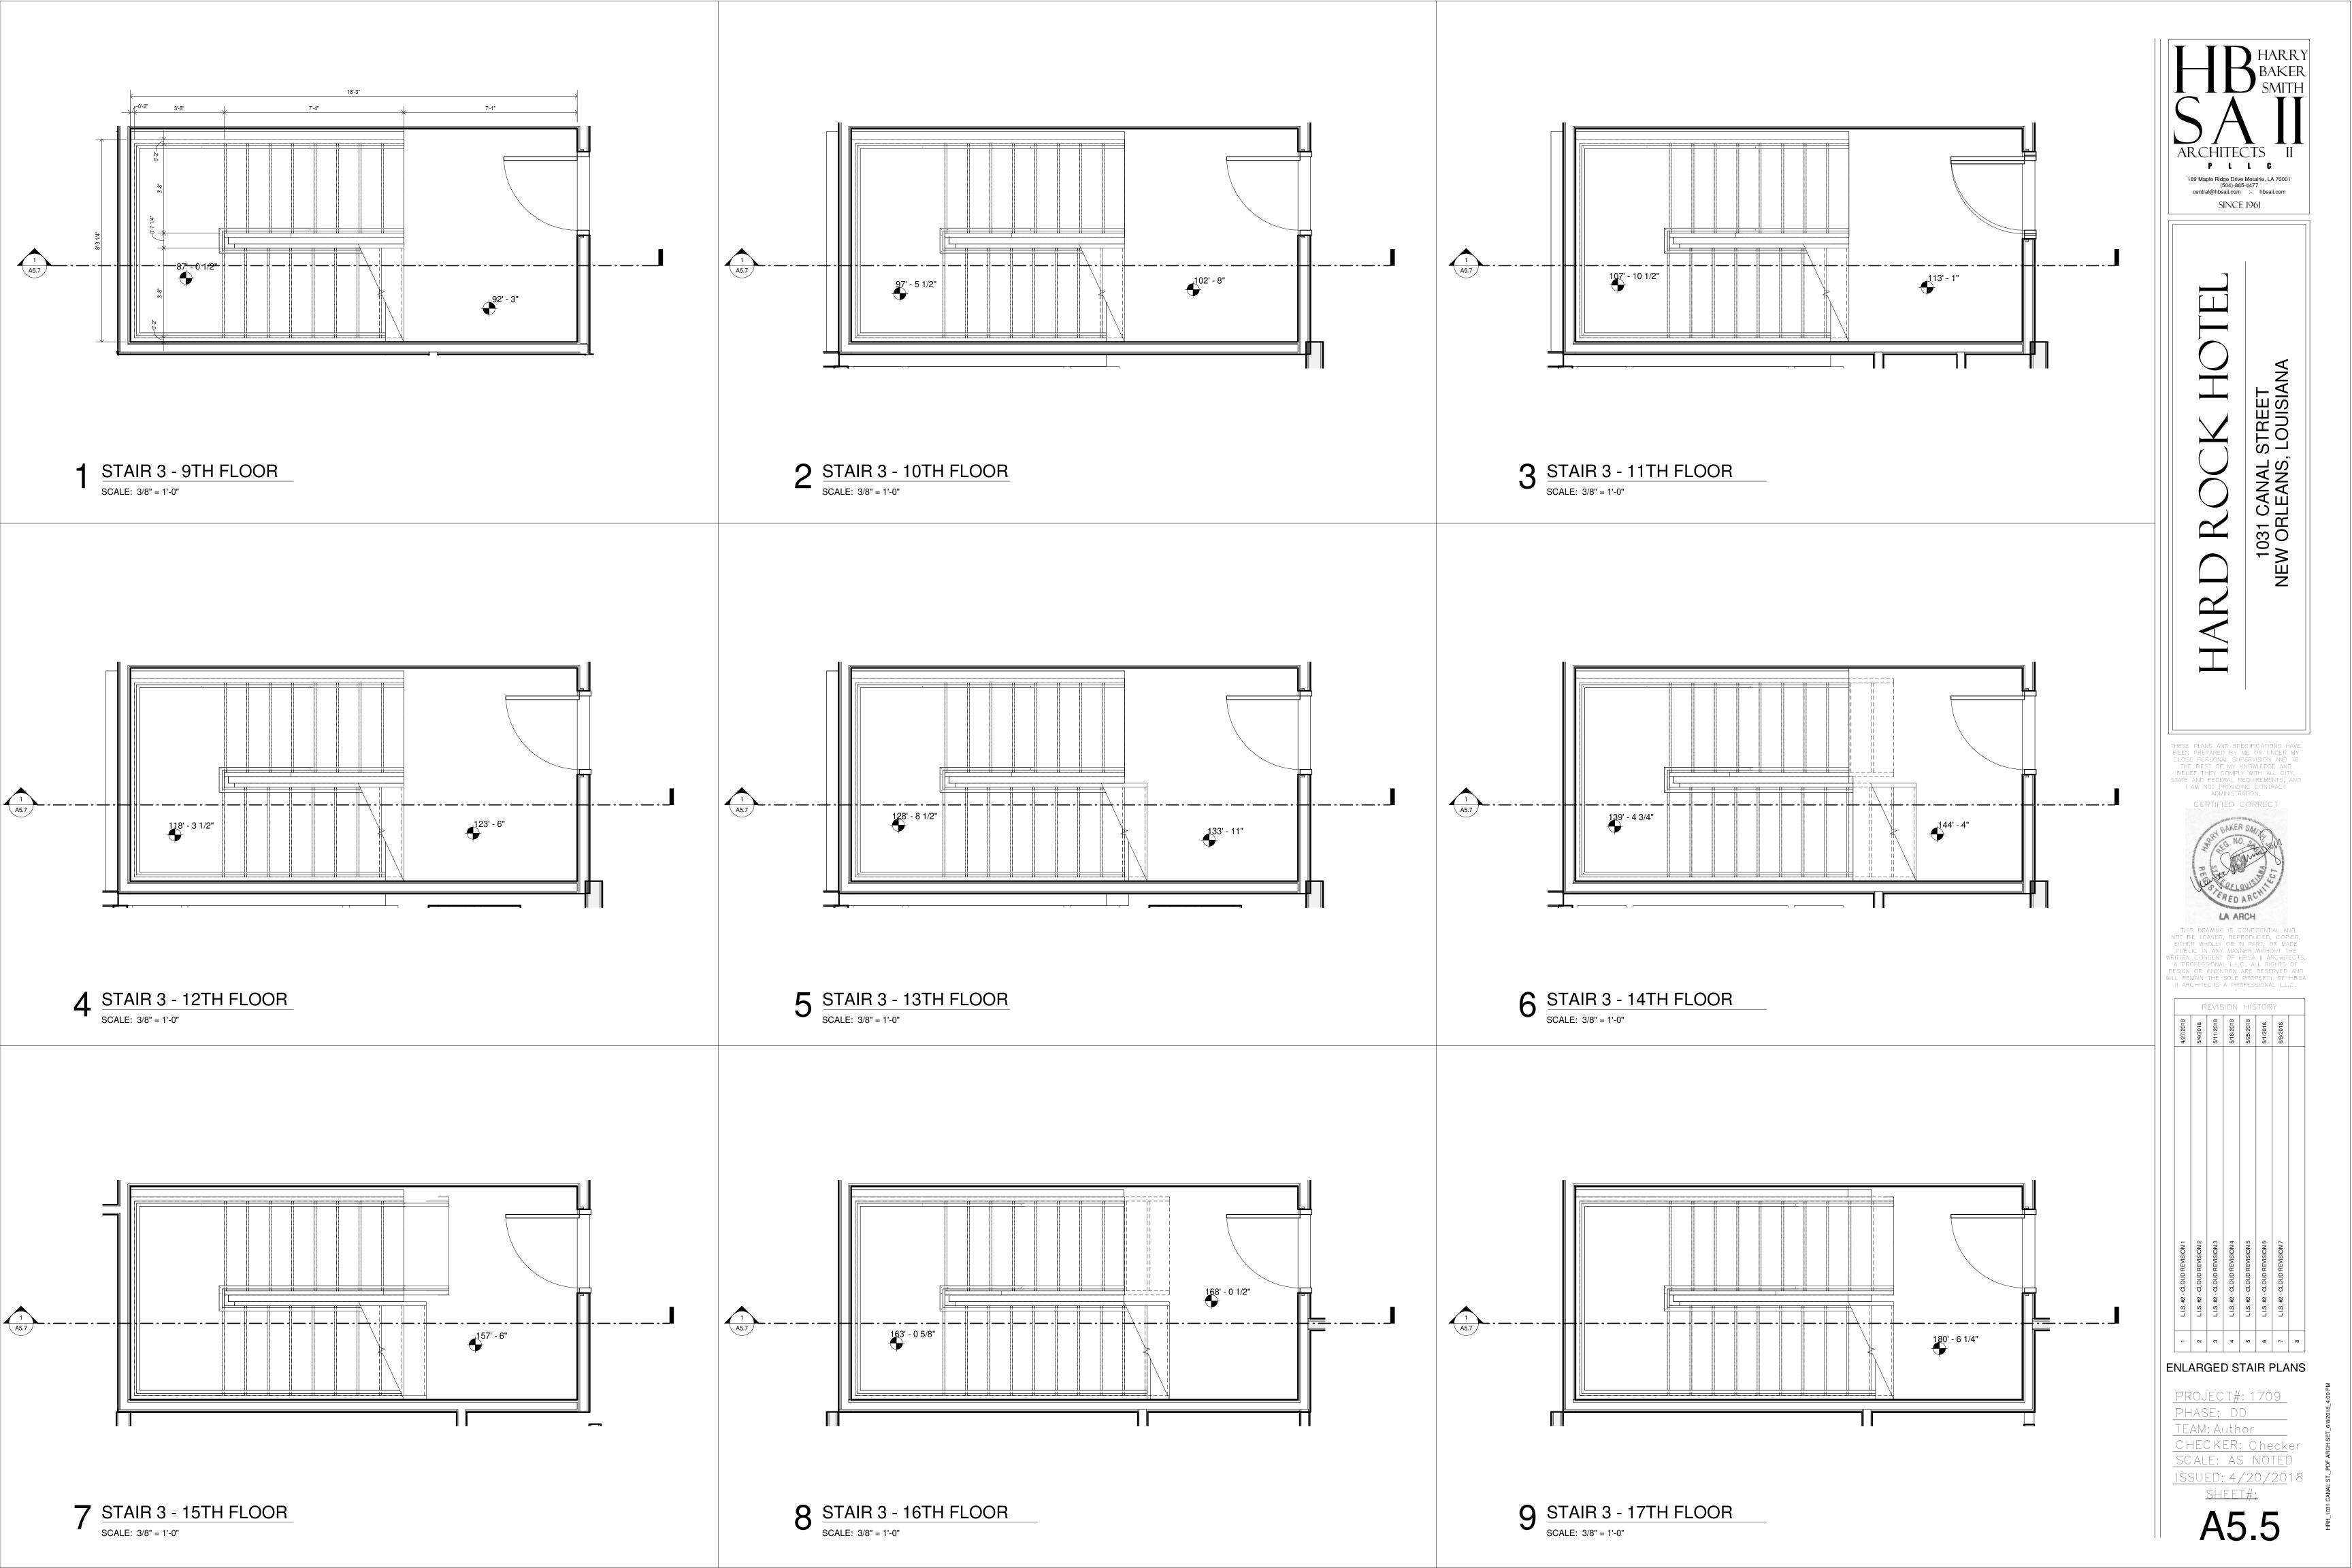

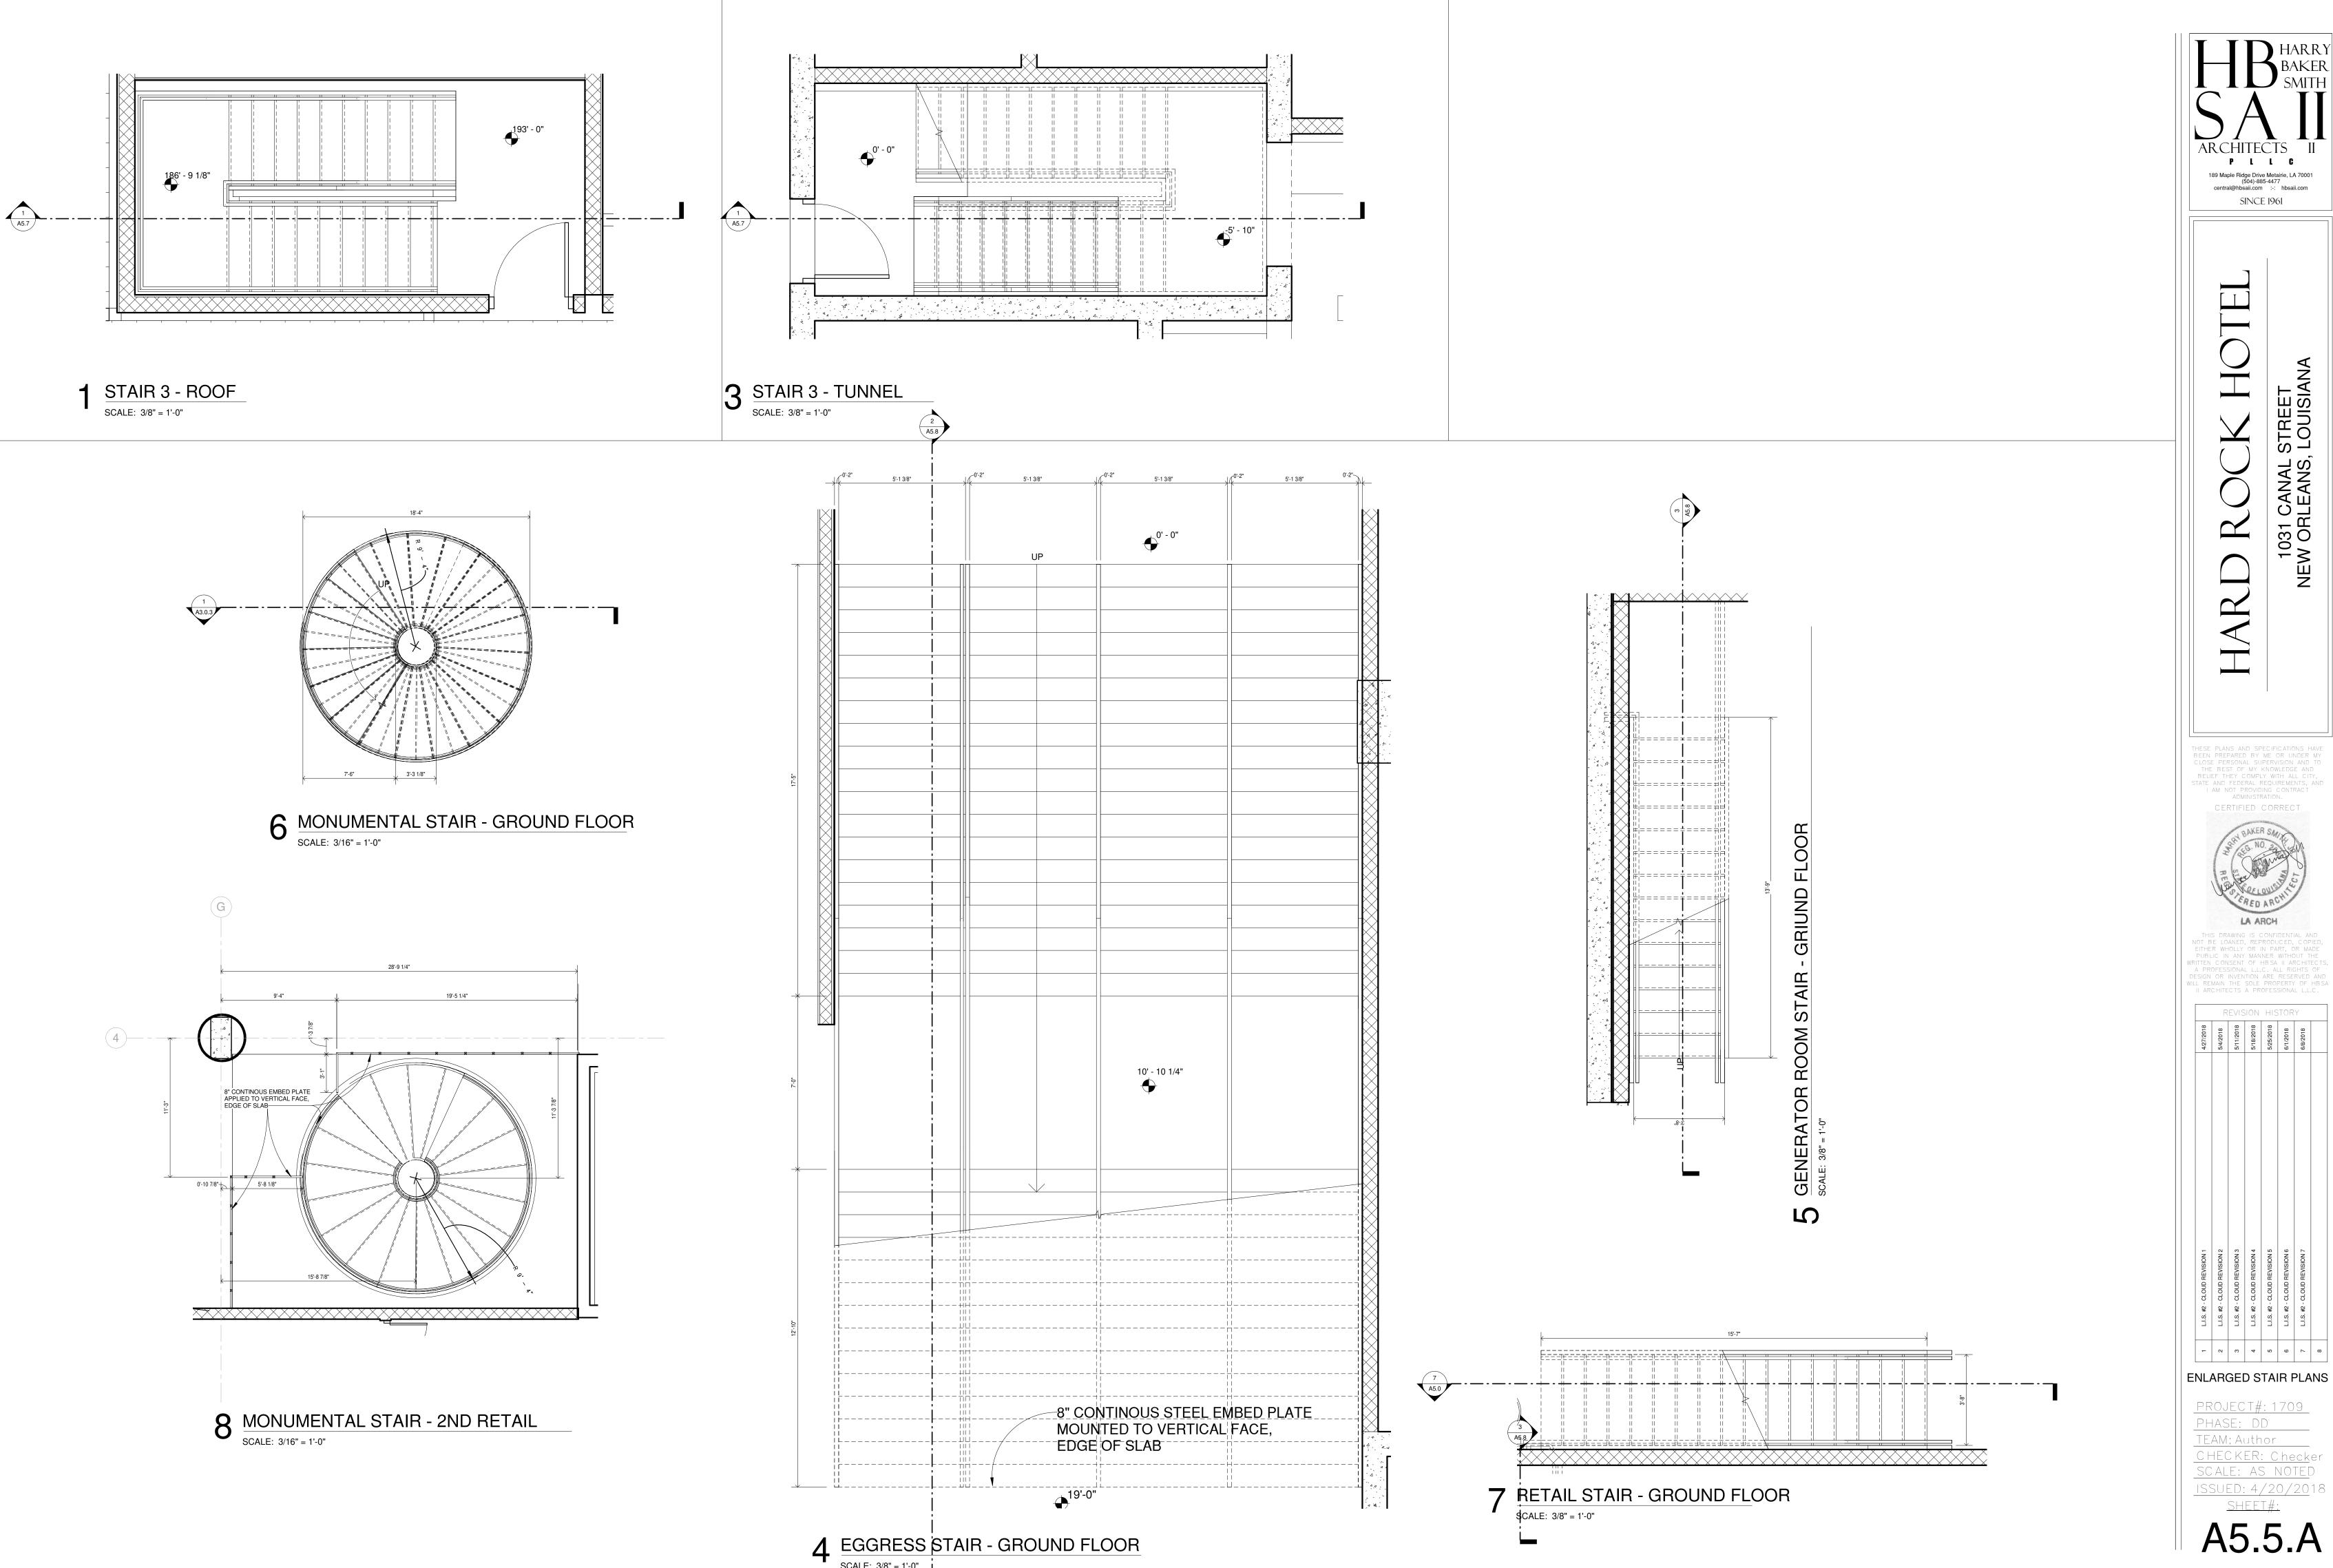


189 Maple Ridge Drive Metairie, LA 70001 (504)-885-4477 central@hbsaii.com :-: hbsaii.com

SINCE 1961

1031 CANAL STREET NEW ORLEANS, LOUISIANA


STATE AND FEDERAL REQUIREMENTS, AND I AM NOT PROVIDING CONTRACT ADMINISTRATION. CERTIFIED CORRECT




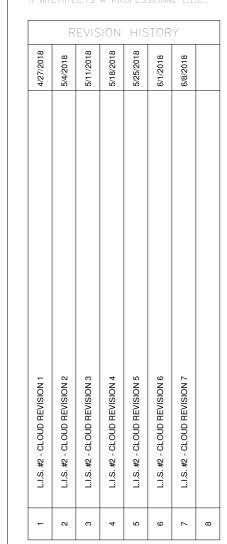

ENLARGED STAIR PLANS

PHASE: DD TEAM: Author CHECKER: Checker SCALE: AS NOTED

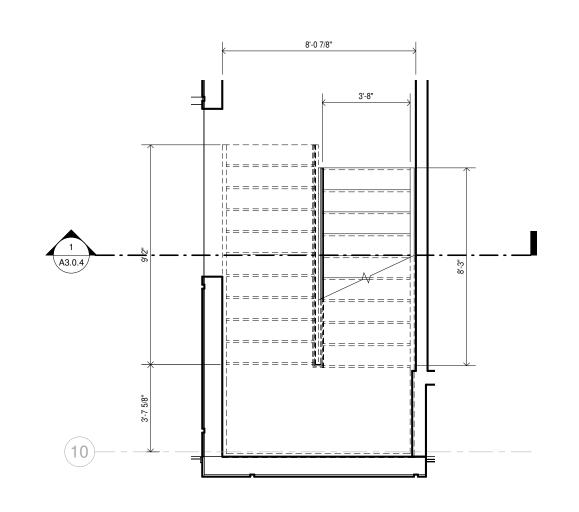


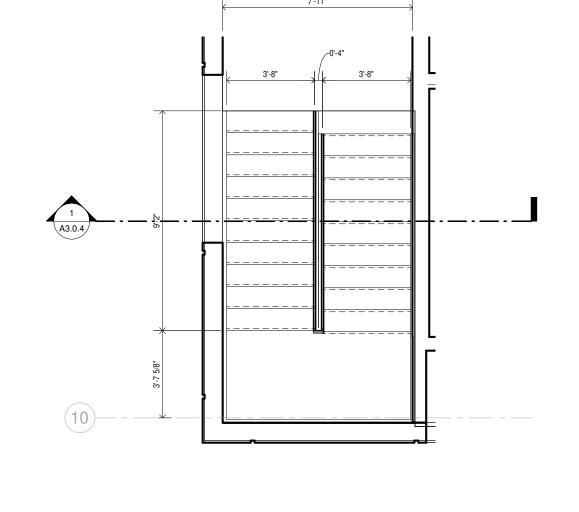




1 GYM EXIT STAIR - 15TH FLOOR

SCALE: 1/4" = 1'-0"

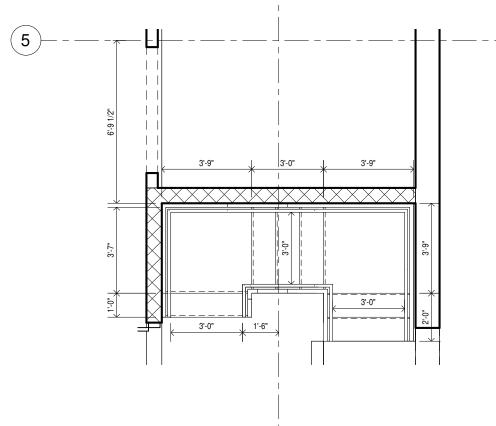

3 CAN WASH STAIR - GROUND FLOOR SCALE: 1/4" = 1'-0"

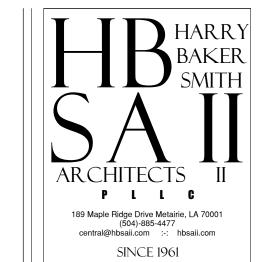

ARD ROCK HOTE 1031 CANAL STREET NEW ORLEANS, LOUISIANA

THESE PLANS AND SPECIFICATIONS HAVE BEEN PREPARED BY ME OR UNDER MY CLOSE PERSONAL SUPERVISION AND TO THE BEST OF MY KNOWLEDGE AND BELIEF THEY COMPLY WITH ALL CITY, STATE AND FEDERAL REQUIREMENTS, AND I AM NOT PROVIDING CONTRACT ADMINISTRATION.

CERTIFIED CORRECT



THIS DRAWING IS CONFIDENTIAL AND NOT BE LOANED, REPRODUCED, COPIED, EITHER WHOLLY OR IN PART, OR MADE PUBLIC IN ANY MANNER WITHOUT THE WRITTEN CONSENT OF HBSA II ARCHITECTS, A PROFESSIONAL L.L.C. ALL RIGHTS OF DESIGN OR INVENTION ARE RESERVED AND WILL REMAIN THE SOLE PROPERTY OF HBSA


ENLARGED STAIR PLANS

PROJECT#: 1709
PHASE: DD
TEAM: Author
CHECKER: Checker
SCALE: AS NOTED


ISSUED: 4/20/2018
SHEET#: **A5.5.B** 

FIRE STAIR 1 SECTION - FLOORS 1 THRU. 8

SCALE: 3/16" = 1'-0"

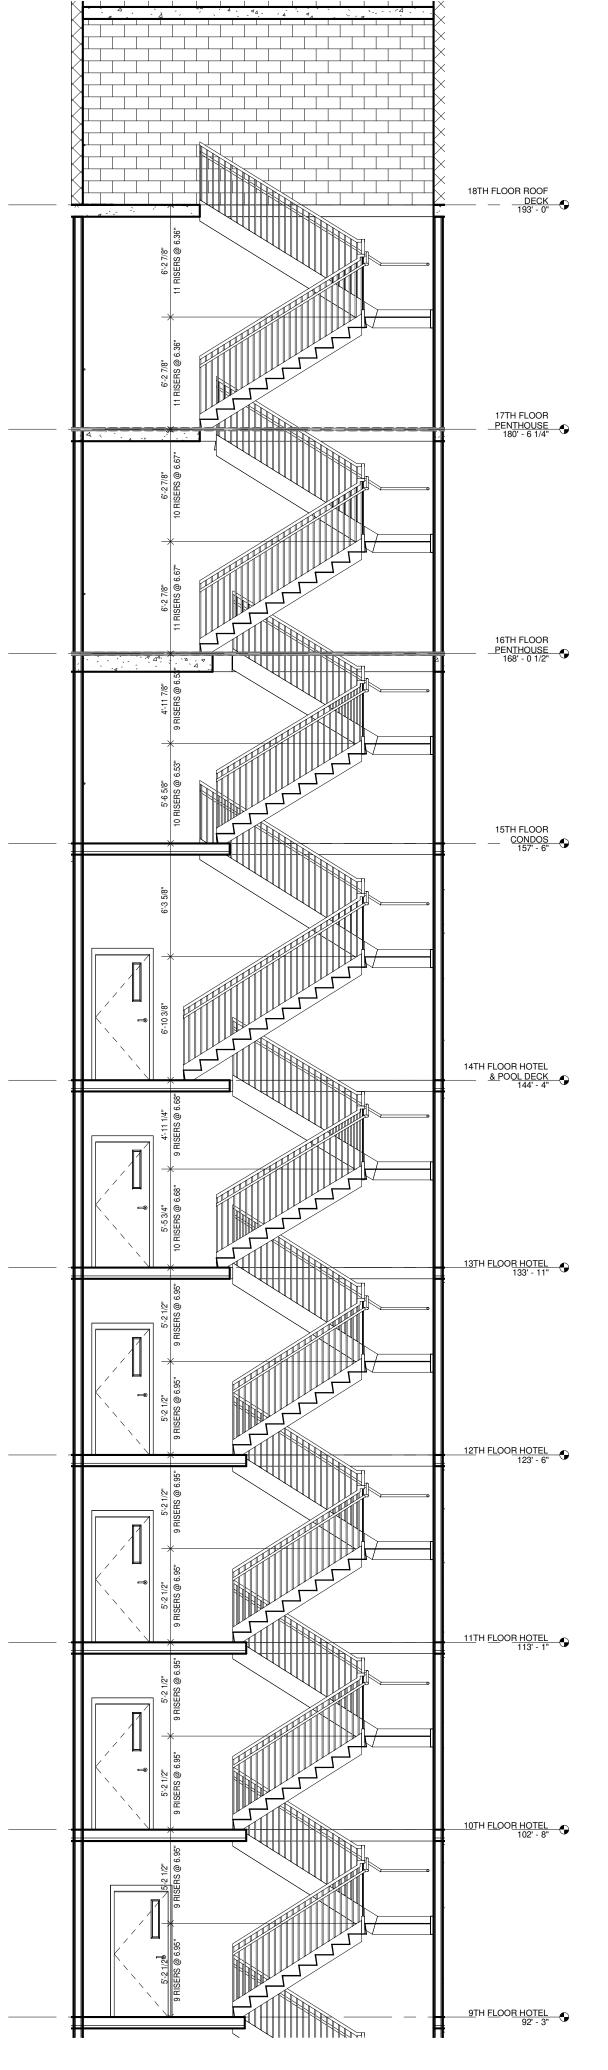

PIRE STAIR 1 SECTION - FLOORS 9 THRU. ROOF SCALE: 3/16" = 1'-0"

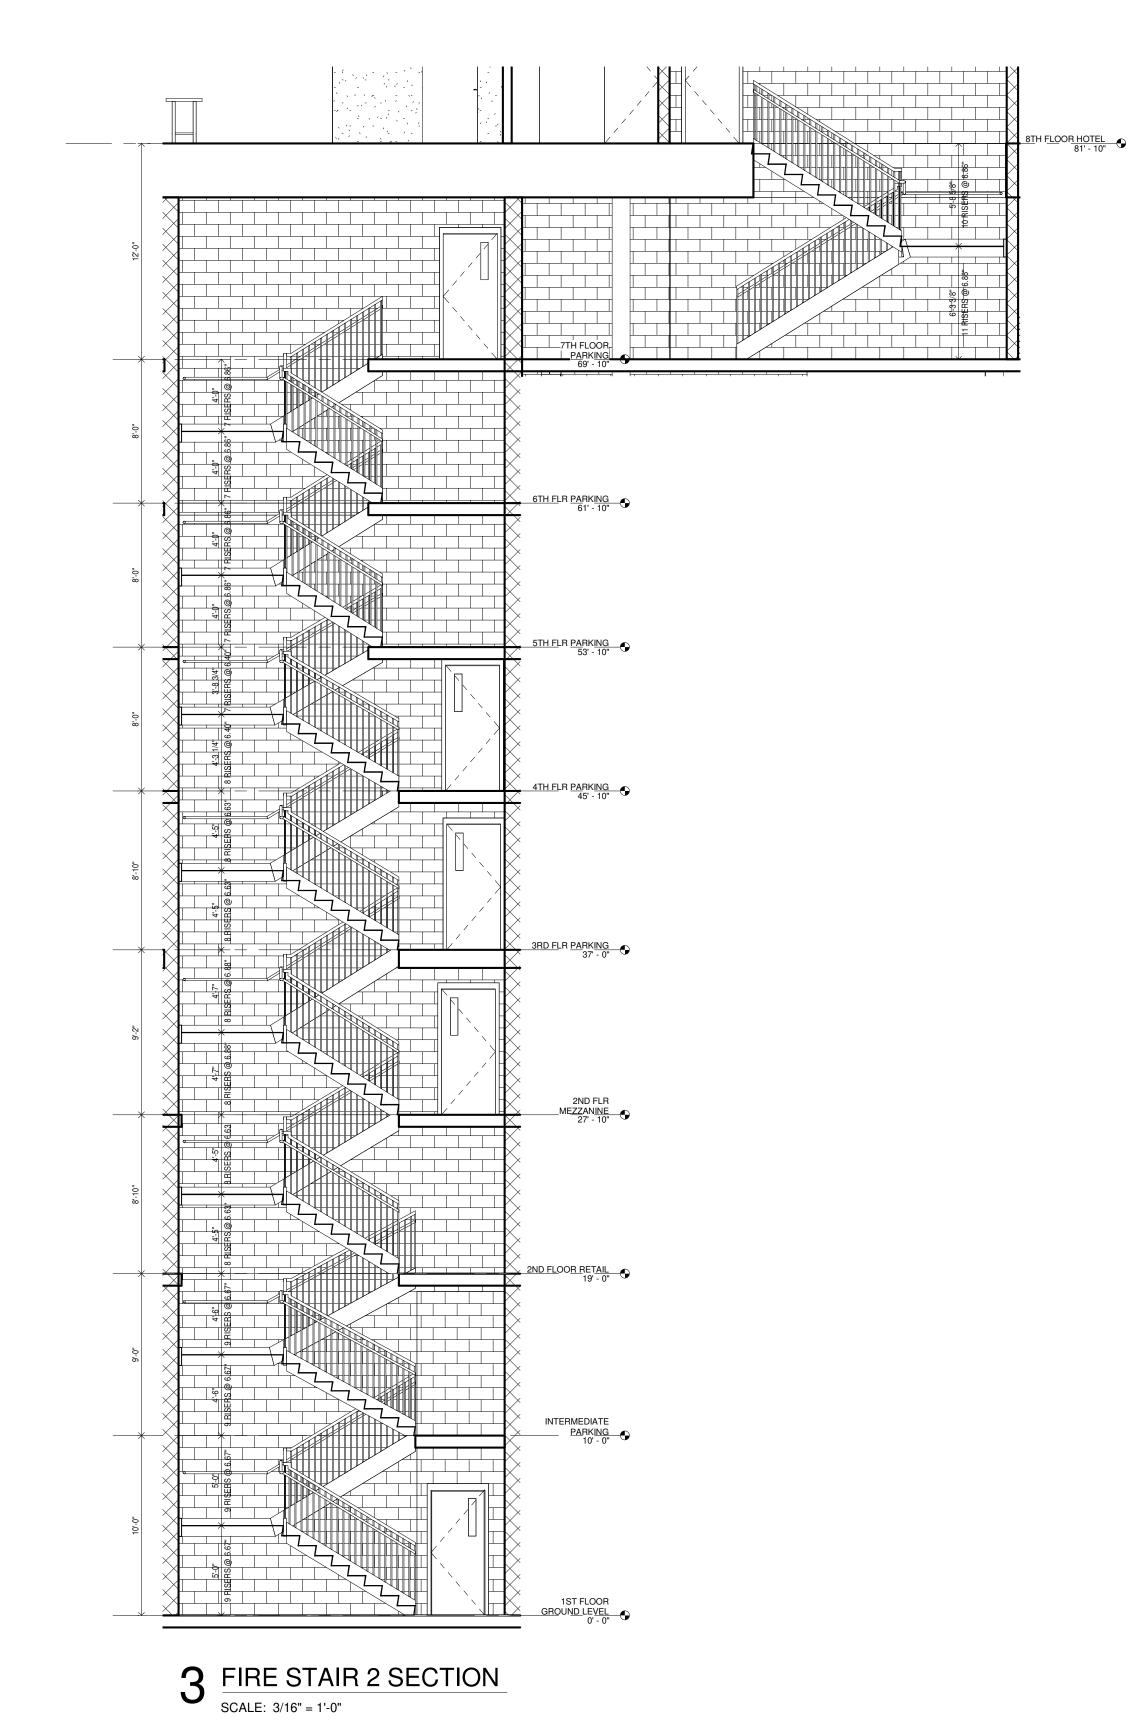

189 Maple Ridge Drive Metairie, LA 70001 (504)-885-4477 central@hbsaii.com :-: hbsaii.com SINCE 1961

1031 CANAL STREET NEW ORLEANS, LOUISIANA


THESE PLANS AND SPECIFICATIONS HAVE BEEN PREPARED BY ME OR UNDER MY CLOSE PERSONAL SUPERVISION AND TO THE BEST OF MY KNOWLEDGE AND BELIEF THEY COMPLY WITH ALL CITY, STATE AND FEDERAL REQUIREMENTS, AND I AM NOT PROVIDING CONTRACT ADMINISTRATION. CERTIFIED CORRECT


8/4/2018 HISTORY HISTORY REVISION HISTORY RESPISORS RESP

| 4/2                          | 2/2                          | 5/1                          | 5/1                          | 2/2                          | 6/1                          | 3/9                          |     |
|------------------------------|------------------------------|------------------------------|------------------------------|------------------------------|------------------------------|------------------------------|-----|
| L.I.S. #2 - CLOUD REVISION 1 | L.I.S. #2 - CLOUD REVISION 2 | L.I.S. #2 - CLOUD REVISION 3 | L.I.S. #2 - CLOUD REVISION 4 | L.I.S. #2 - CLOUD REVISION 5 | L.I.S. #2 - CLOUD REVISION 6 | L.I.S. #2 - CLOUD REVISION 7 |     |
|                              | 2                            | 3   L.I                      | 4 L.I                        | 5   L.I                      | F                            |                              | 8   |
| E                            |                              | .AR                          | GE                           | D S                          | STA                          | \IR                          | ω ] |
|                              |                              | SE                           | CII                          | ON                           | S                            |                              |     |


PROJECT#: 1709
PHASE: DD
TEAM: Author CHECKER: Checker SCALE: AS NOTED ISSUED: 4/20/2018

A5.6

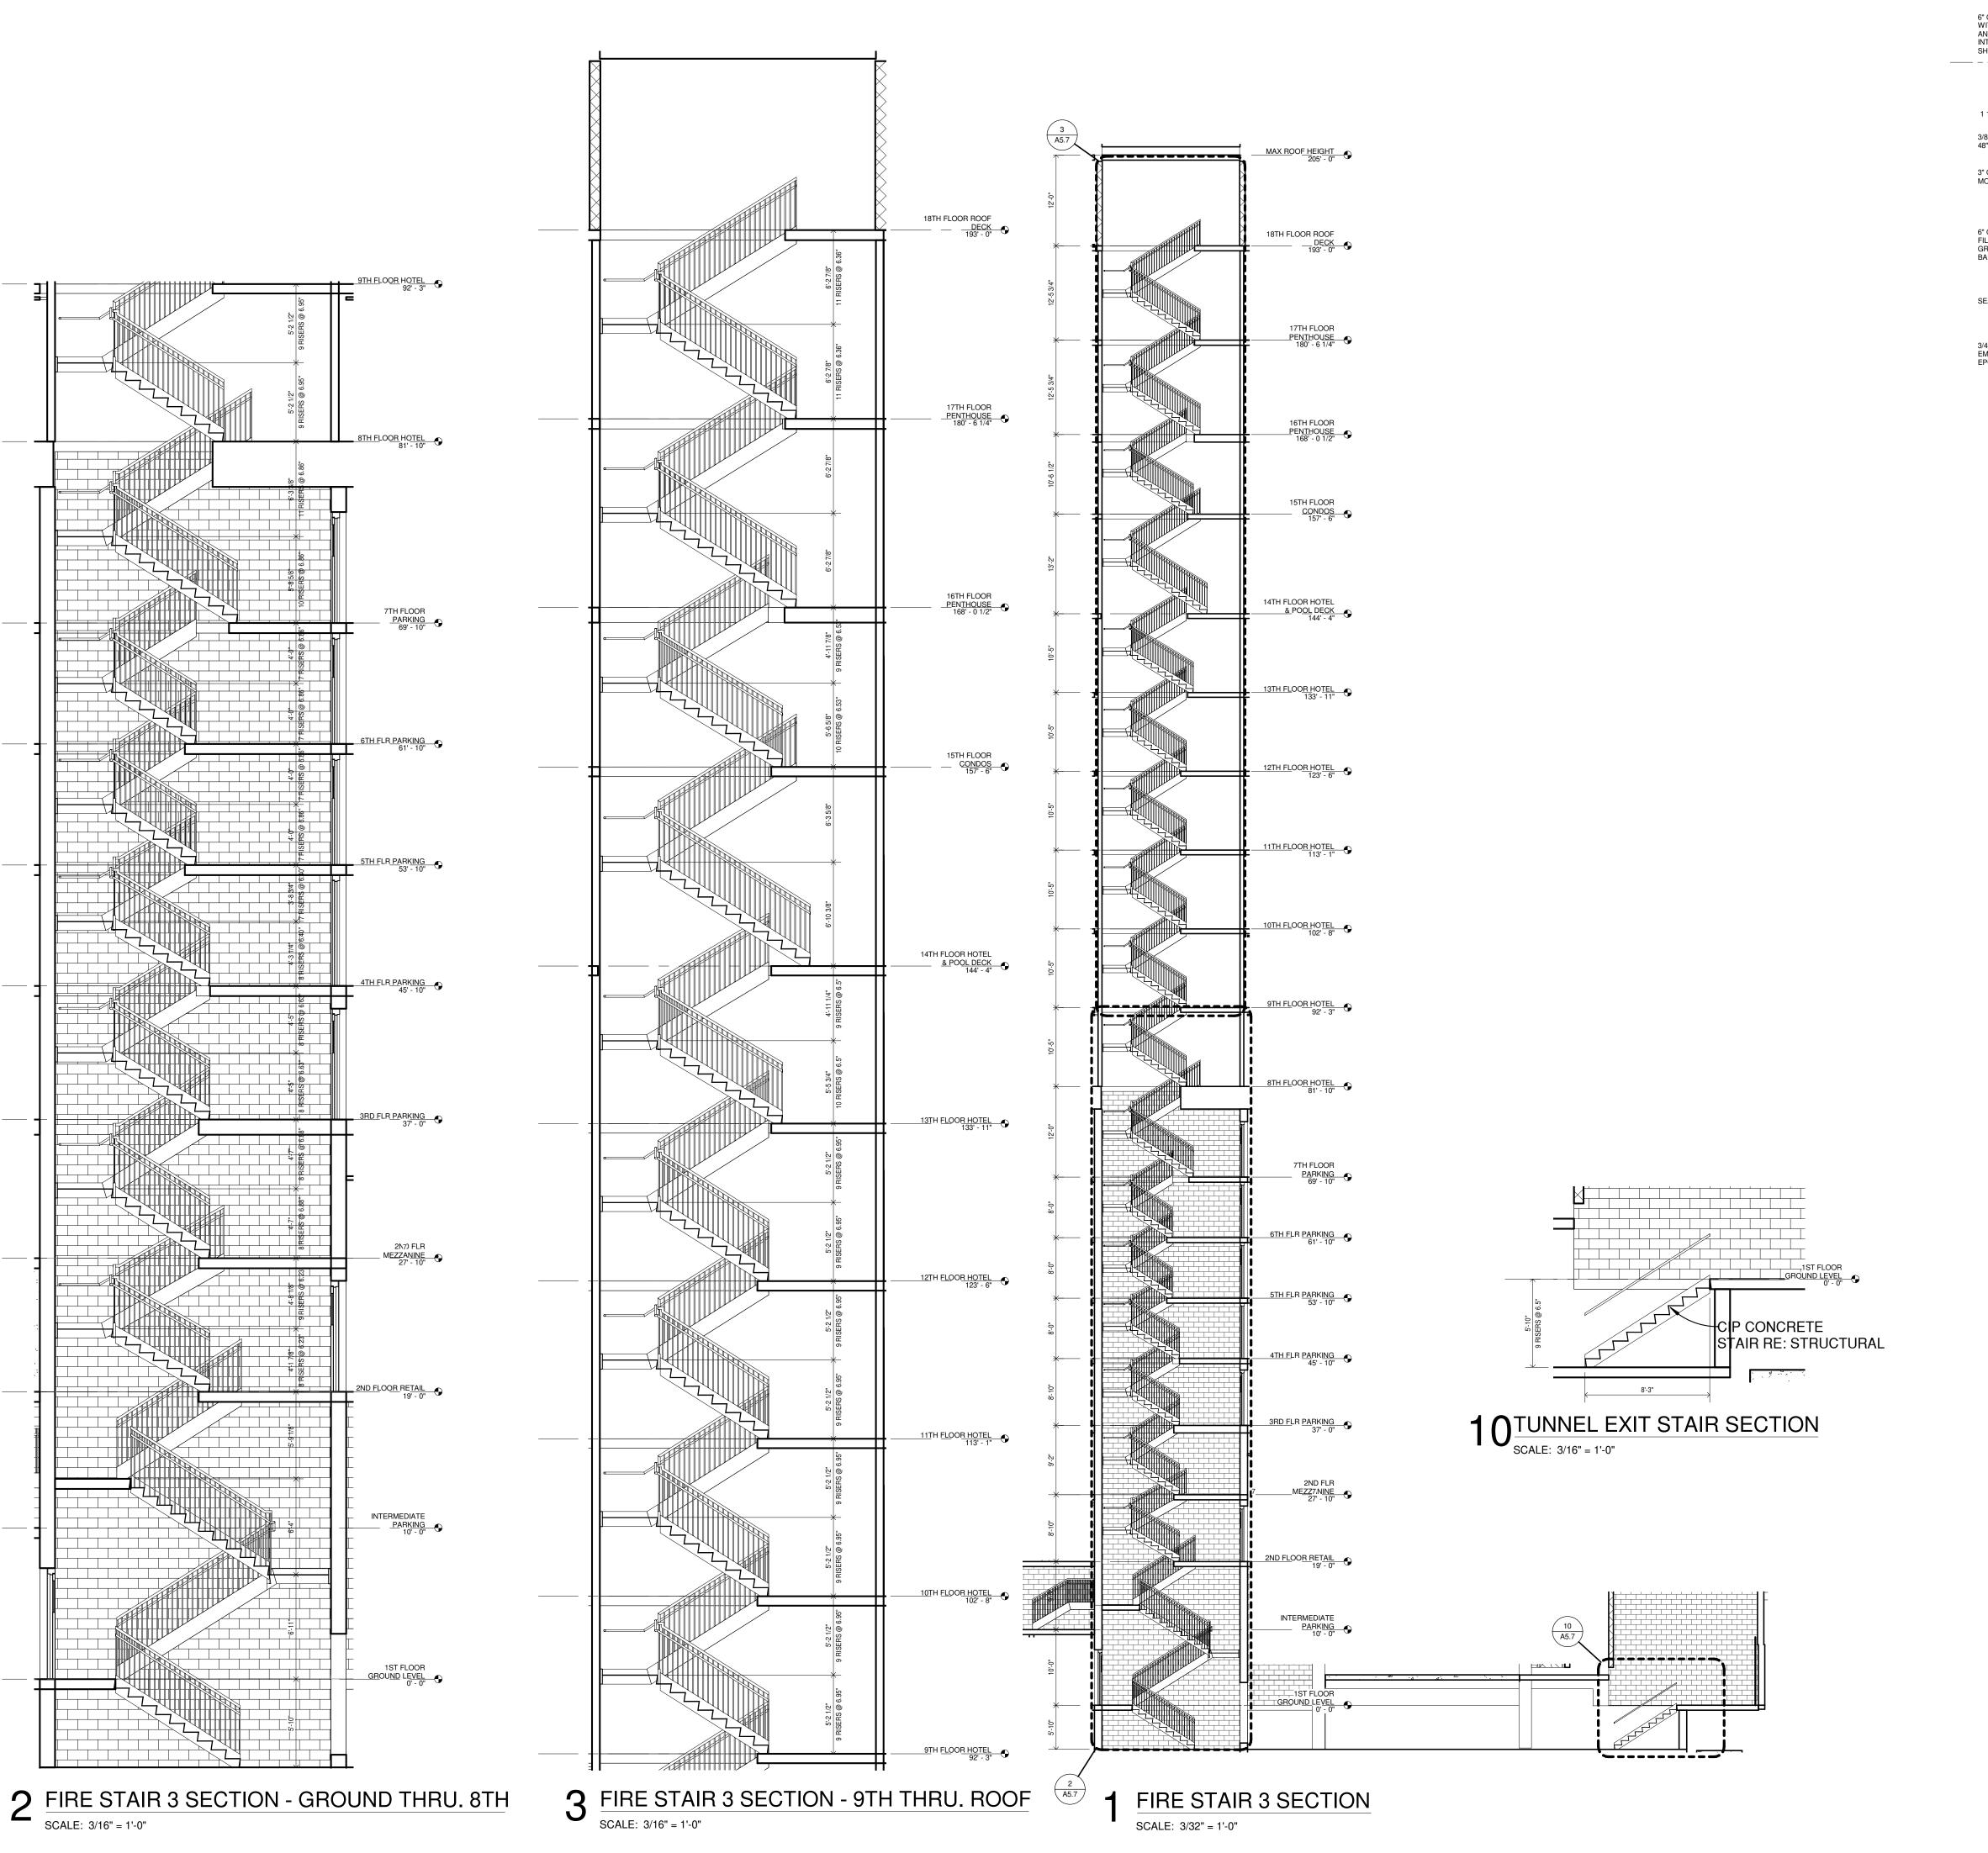


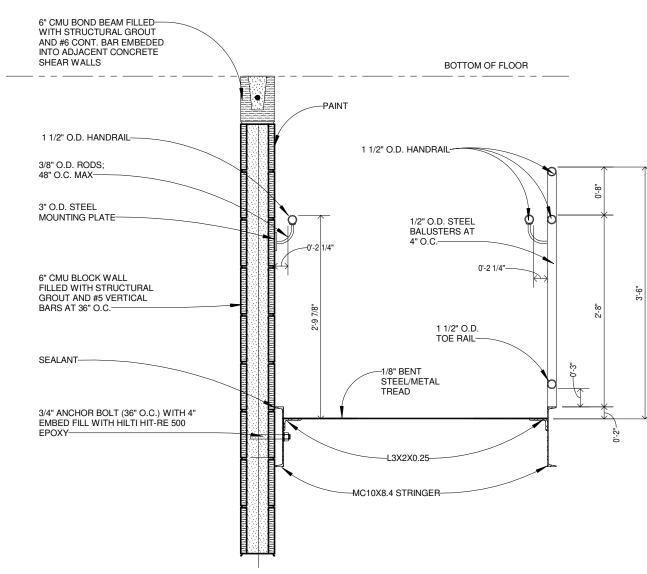

# 12 STAIR TREAD SECTION SCALE: 3/4" = 1'-0"

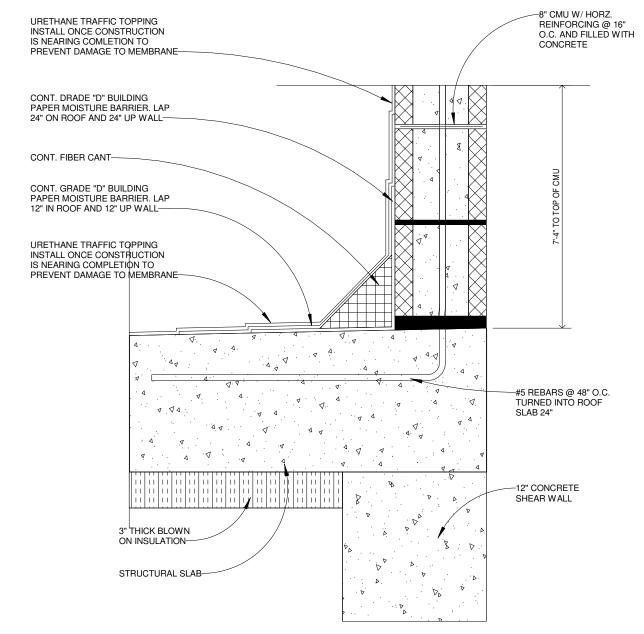



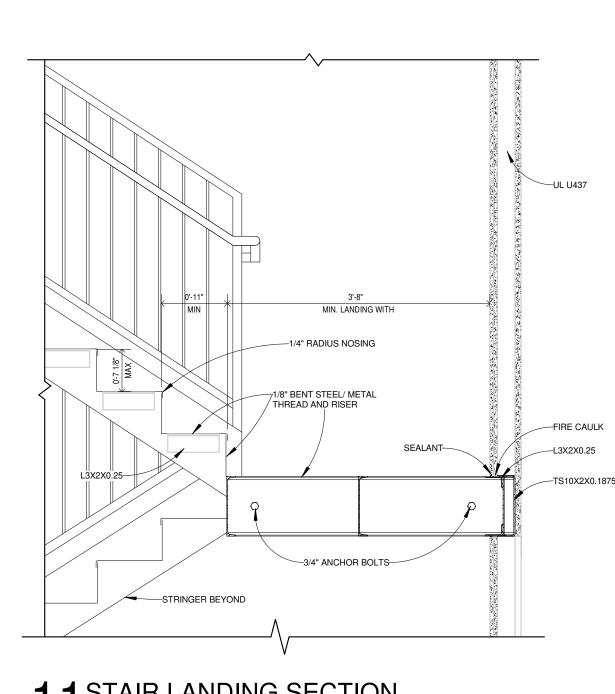

1 1 STAIR LANDING SECTION


SCALE: 3/4" = 1'-0"

189 Maple Ridge Drive Metairie, LA 70001 (504)-885-4477 central@hbsaii.com :-: hbsaii.com SINCE 1961

1031 CANAL STREET NEW ORLEANS, LOUISIANA


BEEN PREPARED BY ME OR UNDER MY CLOSE PERSONAL SUPERVISION AND TO THE BEST OF MY KNOWLEDGE AND

CERTIFIED CORRECT

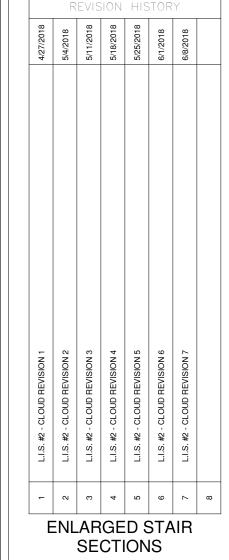

PROJECT#: 1709 PHASE: DD TEAM: VR,CS,GR,HV CHECKER: HANK SCALE: AS NOTED ISSUED: 4/20/2018

A5.7

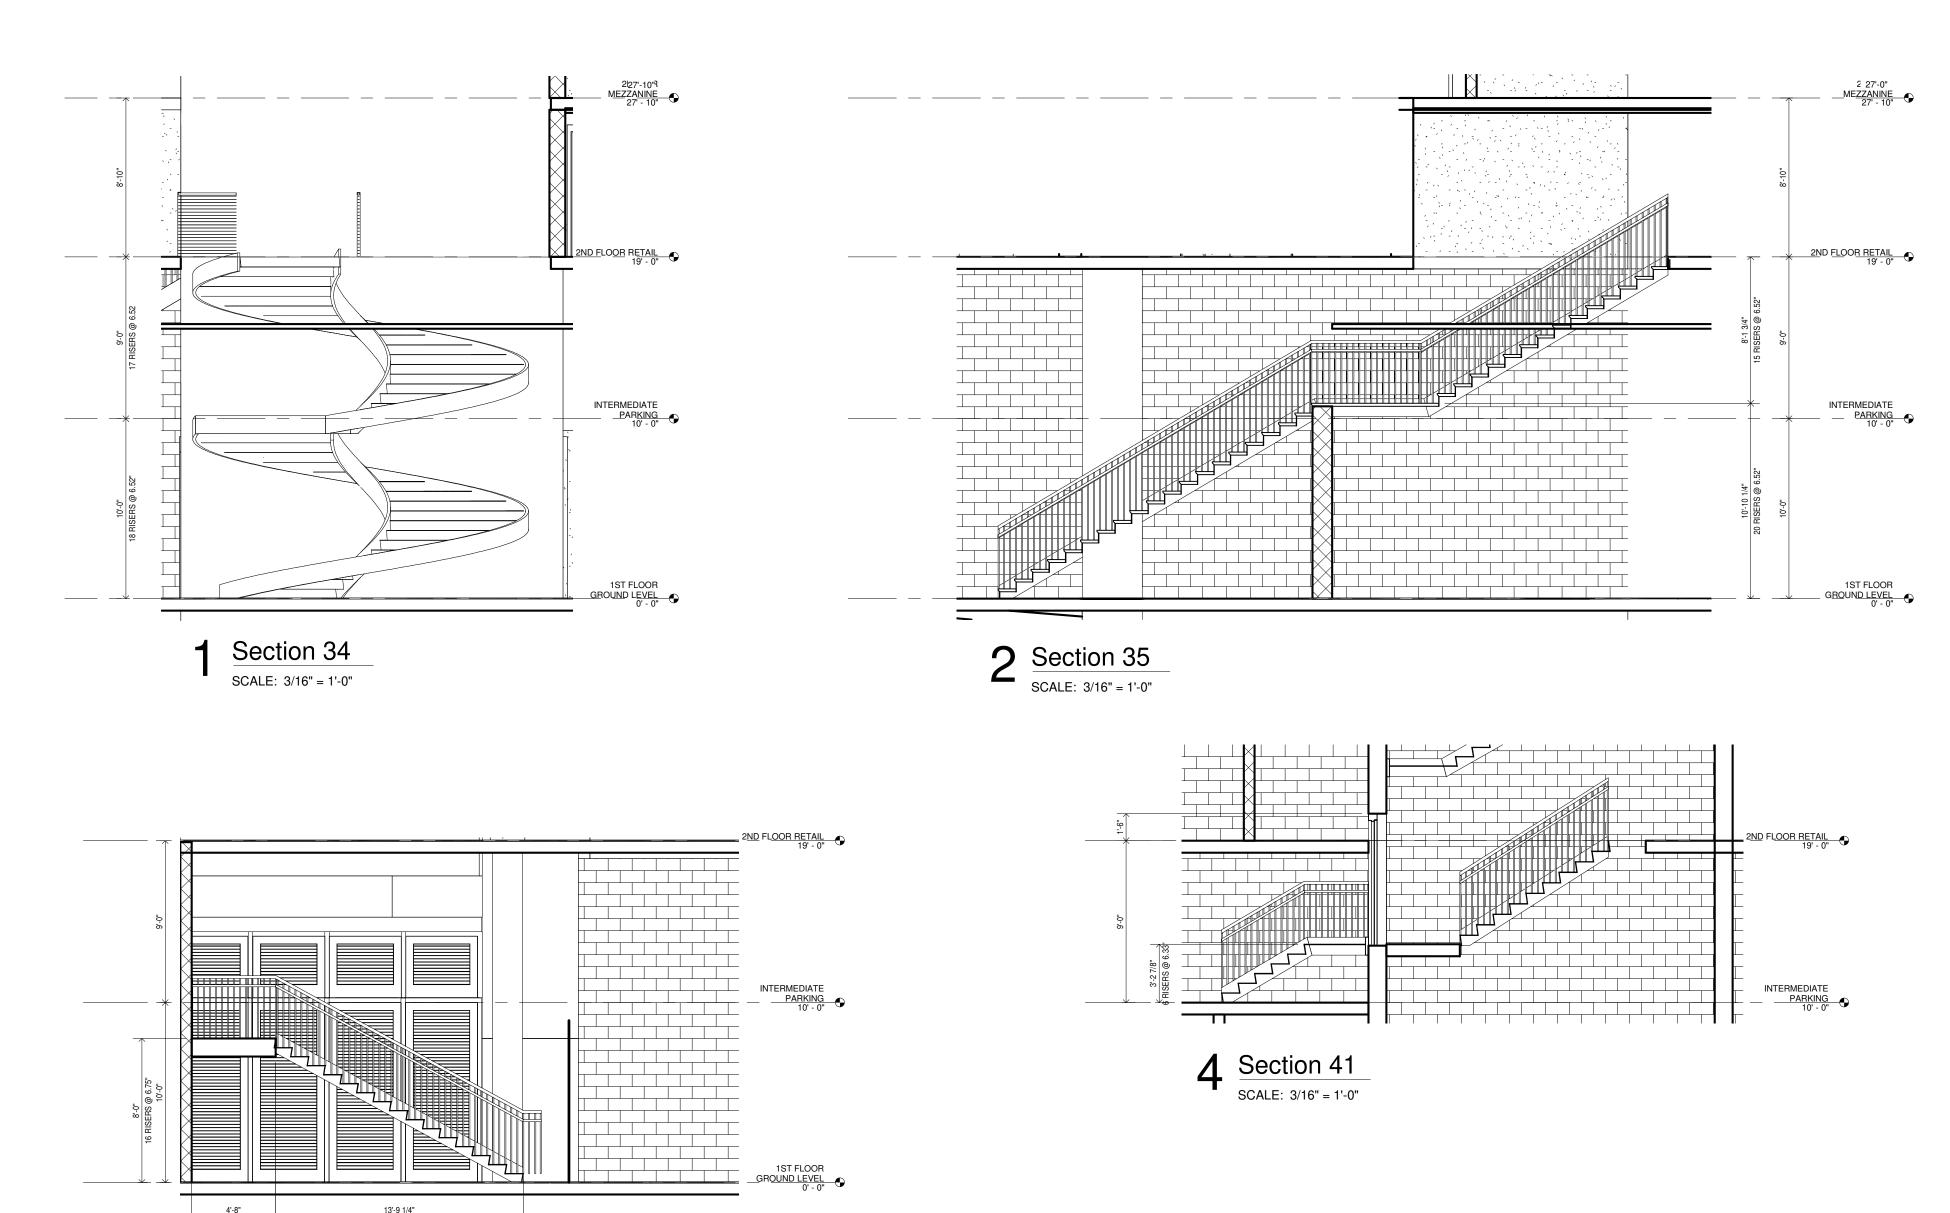

3 GENERATOR ROOM STAIR SECTION

SCALE: 3/16" = 1'-0"


189 Maple Ridge Drive Metairie, LA 70001 (504)-885-4477 central@hbsaii.com :-: hbsaii.com SINCE 1961


1031 CANAL STREET NEW ORLEANS, LOUISIANA


THESE PLANS AND SPECIFICATIONS HAVE BEEN PREPARED BY ME OR UNDER MY CLOSE PERSONAL SUPERVISION AND TO THE BEST OF MY KNOWLEDGE AND BELIEF THEY COMPLY WITH ALL CITY, STATE AND FEDERAL REQUIREMENTS, AND I AM NOT PROVIDING CONTRACT ADMINISTRATION. CERTIFIED CORRECT





PROJECT#: 1709 PHASE: DD TEAM: Author CHECKER: Checker SCALE: AS NOTED <u>ISSUED: 4/20/20</u>18

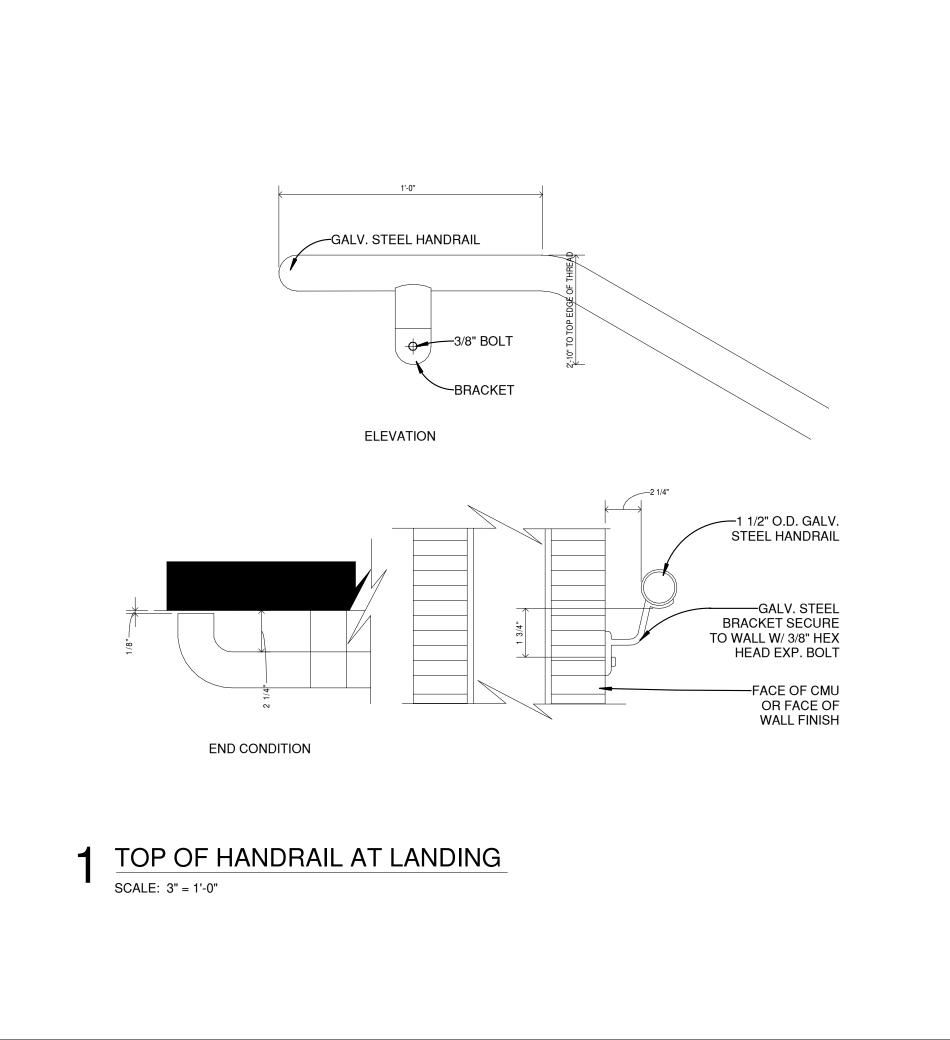

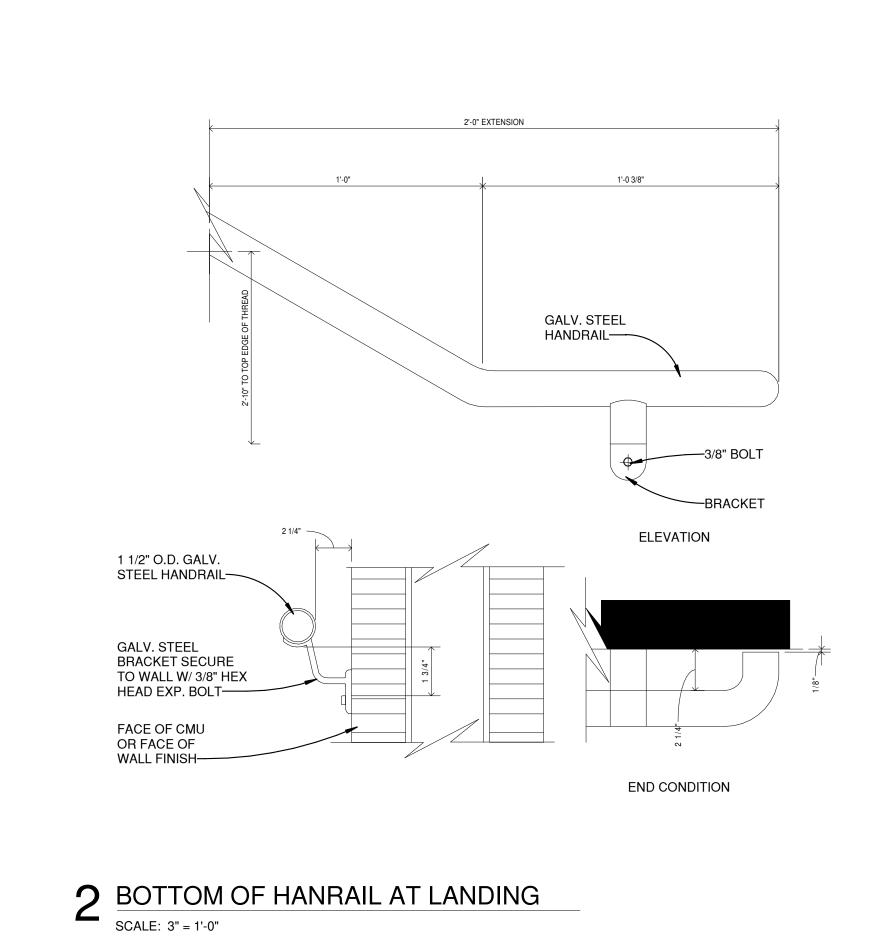

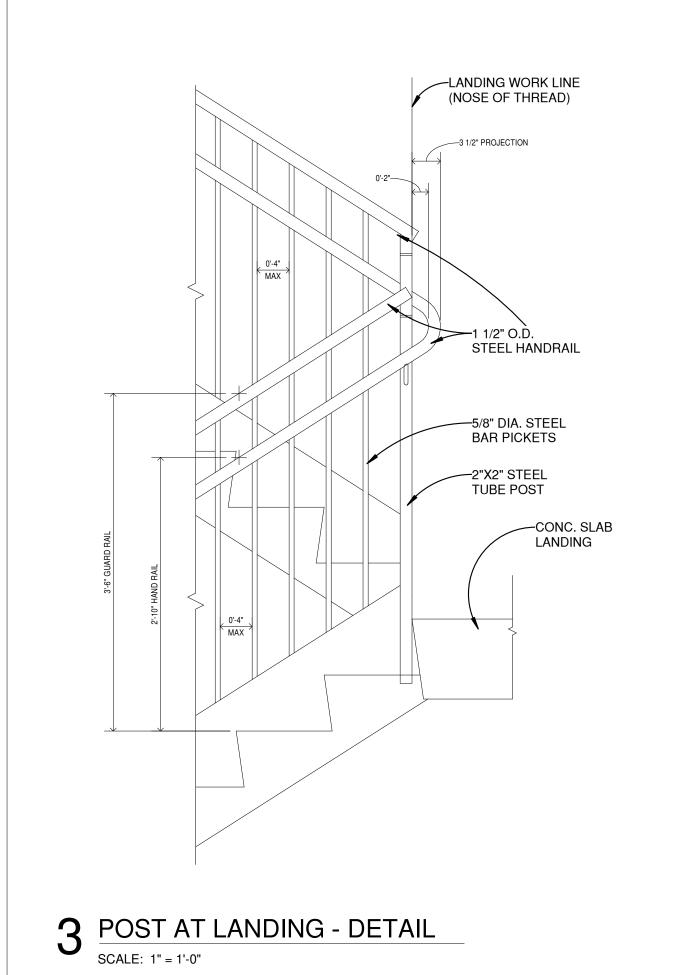

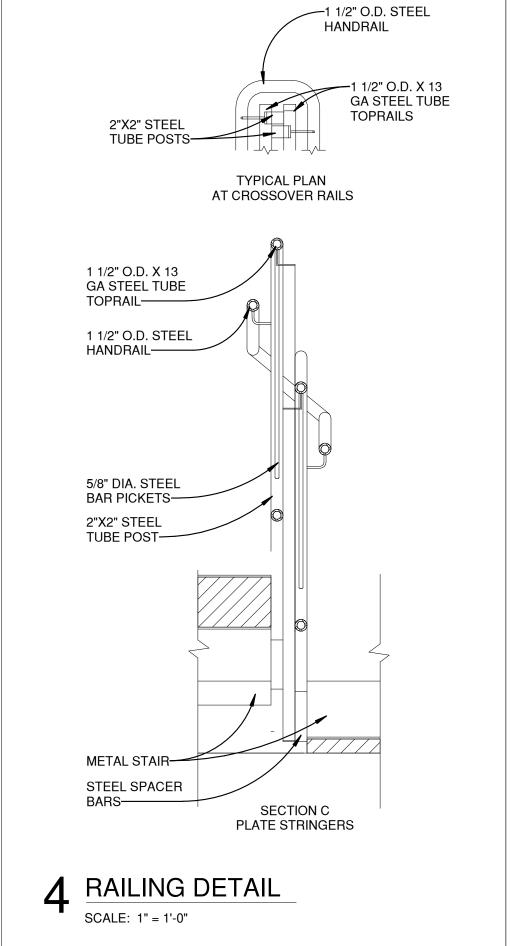

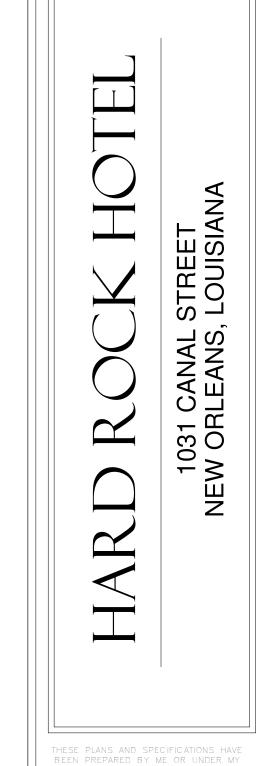


CERTIFIED CORRECT

189 Maple Ridge Drive Metairie, LA 70001 (504)-885-4477 central@hbsaii.com :-: hbsaii.com

SINCE 1961



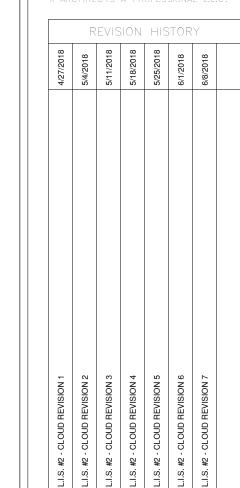


RAII ING DETAILS

RAILING DETAILS

PROJECT#: 1709
PHASE: DD
TEAM: Author
CHECKER: Check


CHECKER: Checker SCALE: AS NOTED ISSUED: 4/20/2018 SHEET#:

SHEET#:
A5.11

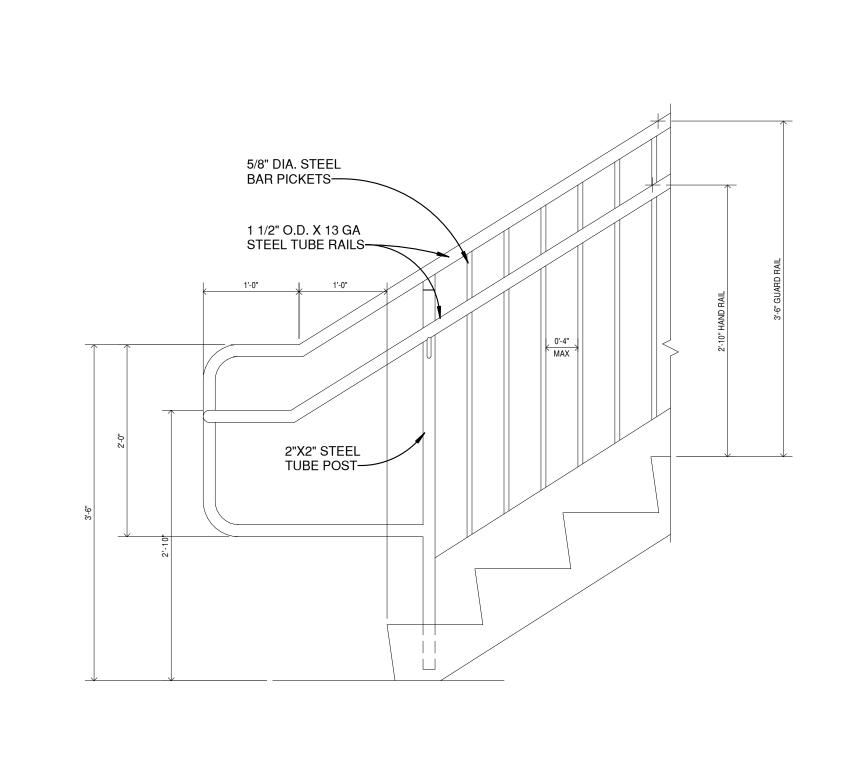

5 STAIR & GUARDRAIL - DETAIL

SCALE: 1" = 1'-0"

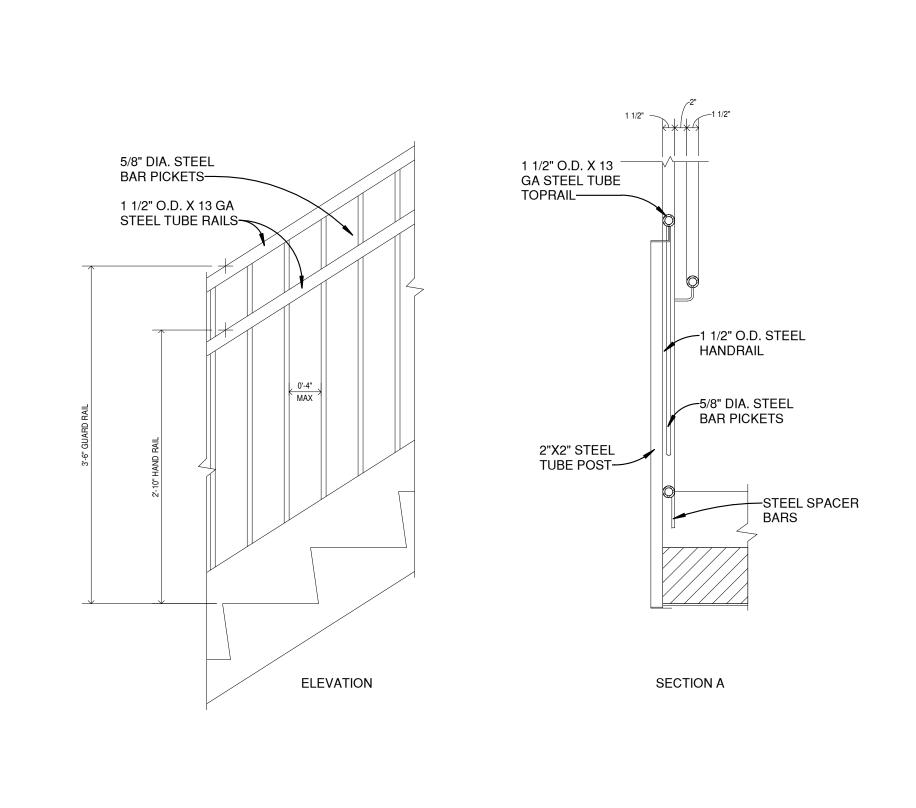

6 INTERMEDIATE POST DETAIL
SCALE: 1" = 1'-0"

|                     |                                       | DOOR SCHEDUL  | E - 1ST FLOOR      |                    |             |               |            |           |             |                      |
|---------------------|---------------------------------------|---|--------------------|--------------------|-------------|---------------|------------|-----------|-------------|----------------------|
| MARK                | FROM                                  | 0   | WIDTH              | НЕІСНТ             | THICKNESS   | DOOR MATERIAL | DOOR FRAME | DOOR TYPE | FIRE RATING | REMARKS              |
|                     | ENTRANCE                              | TUNNEL  | 6' - 0 5/8"        | 8' - 0"            |             |               |            |           |             |                      |
|                     | CONSTANT GRIND                        | TUNNEL  | 3' - 4 15/16"      | 8' - 0"            | 0' - 1 1/2" |               |            | 1.        |             |                      |
| 00                  | TUNNEL                                | PRIVATE CONDO ENTRANCE AND MAIL                                 |                    | 8' - 0"            |             | AL/GL         | AL         | A         |             |                      |
| 01                  | TUNNEL                                | PITARD'S  | 6' - 0"            | 8' - 0"            |             | AL/GL         | AL         | A         |             |                      |
| 03                  | HALL<br>STOR.                         | PITARD'S  | 6' - 0"            | 7' - 0"            | 0' 10/4"    | HM/GL         | HM         | W         |             |                      |
| 04<br>06            | CONDO ELEVATOR LOBBY                  | PRIVATE CONDO ENTRANCE AND MAIL PRIVATE CONDO ENTRANCE AND MAIL |                    | 7' - 0"<br>0' - 0" | 0' - 1 3/4" |               |            | -         |             | FRAMED OPENING       |
| )7                  | STAIR 1                               | CONDO ELEVATOR LOBBY  | 3' - 0"            | 7' - 0"            | 0' - 1 3/4" | НМ            | НМ         | С         | 2HR         | THANLE OF LINING     |
| )8                  | PRIVATE CONDO ENTRANCE AND MAIL       | CONDO STORAGE   | 3' - 0"            | 7' - 0"            | 0' - 1 3/4" |               | HM         | F         | 1HR         |                      |
| )9                  | HALL                                  | FRONT OFFICE WORK AREA  | 3' - 0"            | 7' - 0"            | 0' - 1 3/4" |               | HM         | T         |             |                      |
| 10                  | HALL                                  | PITARD'S  | 6' - 0"            | 7' - 0"            |             | HM/GL         | НМ         | W         |             |                      |
| 11                  | HALL                                  | AV EQUIP  | 3' - 0"            | 7' - 0"            | 0' - 1 3/4" | SCW           | НМ         | V         |             |                      |
| 12                  | HALL                                  | WORK AREA   | 3' - 0"            | 7' - 0"            | 0' - 1 3/4" | WD/GL         | НМ         | Т         |             |                      |
| 13                  | STAR SERVICES                         | MAIN LOBBY AND CHECK IN   | 3' - 0"            | 7' - 0"            | 0' - 1 3/4" | НМ            | НМ         | F         |             |                      |
| 4                   | STAR SERVICES                         | HALL  | 3' - 0"            | 7' - 0"            | 0' - 1 3/4" | WD/GL         | НМ         | Т         |             |                      |
| 15                  | HALL                                  | FILE ROOM   | 3' - 0"            | 7' - 0"            | 0' - 1 3/4" |               | НМ         | F         |             |                      |
| 16                  | KITCHEN                               | WORK AREA   | 3' - 0"            | 7' - 0"            | 0' - 1 3/4" |               | HM         | Т         |             |                      |
| 17                  | HALL                                  | FRONT OFFICE MANAGER  | 3' - 0"            | 7' - 0"            | 0' - 1 3/4" |               | HM         | Т         |             |                      |
| 18                  | MAIN LOBBY AND CHECK IN               | HALL  | 3' - 0"            | 7' - 0"            | 0' - 1 3/4" |               | HM         | F         |             |                      |
| 19                  | MAIN LOBBY AND CHECK IN               | WOMEN   | 3' - 0"            | 7' - 0"            | 0' - 1 3/4" |               | HM         | F         |             |                      |
| 20                  | MAIN LOBBY AND CHECK IN               | FAMILY  | 3' - 0"            | 7' - 0"            | 0' - 1 3/4" |               | HM         | F         |             |                      |
| 21                  | MEN MAINLORDY AND CHECK IN            | MAIN LOBBY AND CHECK IN   | 3' - 0"<br>6' - 0" | 7' - 0"            | 0' - 1 3/4" |               | HM<br>HM   | F         |             |                      |
| 22<br>24            | MAIN LOBBY AND CHECK IN EXIT CORRIDOR | KITCHEN<br>KITCHEN  | 3' - 0"            | 7' - 0"<br>7' - 0" | 0' - 1 3/4" | HM/GL         | HM         | W<br>C    | 2HR         |                      |
| 24<br>25            | STAIR 2                               | EXIT CORRIDOR   | 3' - 0"            | 7' - 0"            | 0' - 1 3/4" |               | HM         | С         | 2HR         |                      |
| 26                  | EXIT CORRIDOR                         | FIRE COMMAND  | 2' - 10"           | 7' - 0"            | 0' - 1 3/4" |               | HM         | C         | ZIIII       |                      |
| <u>2</u> 7          | SESSIONS                              | KITCHEN   | 6' - 0"            | 7' - 0"            | 0 10/4      | HM/GL         | HM         | W         |             |                      |
| - <i>-</i><br>28    | ELECT.                                | KITCHEN   | 3' - 0"            | 7' - 0"            | 0' - 1 3/4" |               | HM         | C         |             |                      |
| 29                  | KITCHEN                               | EXIT CORRIDOR   | 6' - 0"            | 7' - 0"            | 0' - 1 3/4" |               | НМ         | X         |             |                      |
| 30                  | KITCHEN                               | EMP. REST.  | 3' - 0"            | 7' - 0"            | 0' - 1 3/4" |               | НМ         | F         |             |                      |
| 31                  | LOADING                               | RECEVING  | 6' - 6"            | 10' - 0"           | 0' - 1 1/2" |               | НМ         | J         |             |                      |
| 32                  | LOADING                               | TRASH   | 8' - 0"            | 8' - 0"            | 0' - 1 1/2" | М             | НМ         | J         | -           |                      |
| 34                  | RECEVING                              | EXIT CORRIDOR   | 3' - 6"            | 7' - 0"            | 0' - 1 3/4" | HM/GL         | НМ         | E         | -           |                      |
| 35                  | EXIT CORRIDOR                         | STAIR 3   | 3' - 0"            | 7' - 0"            | 0' - 1 3/4" | НМ            | НМ         | E         | 2HR         |                      |
| 36                  | STORAGE                               | EXIT CORRIDOR   | 6' - 0"            | 7' - 0"            | 0' - 1 3/4" |               | HM         | D         | 1HR         |                      |
| 37                  | EXIT CORRIDOR                         | EMPLOYEE CHECK IN   | 2' - 8"            | 7' - 0"            | 0' - 1 3/4" |               | HM         | E         |             |                      |
| 38                  | EXIT CORRIDOR                         |   | 3' - 0"            | 7' - 0"            | 0' - 1 3/4" |               | HM         | E         |             |                      |
| 39                  | TUNNEL                                | LOADING   | 12' - 0"           | 14' - 0"           | 0' - 1 1/2" |               | HM         | J         |             | 1/01545              |
| 40<br>11            | TUNNEL                                | EXIT CORRIDOR   | 3' - 0"<br>1' - 4" | 7' - 0"            | 0' - 1 3/4" |               | HM         | D         | 1110        | 1/2 LEAF<br>1/2 LEAF |
| l1<br>l4            | EXIT CORRIDOR PITARD'S                | TUNNEL  | 3' - 0"            | 7' - 0"<br>7' - 0" | 0' - 1 3/4" | HM            | HM<br>HM   | D<br>V    | 1HR         | 1/2 LEAF             |
| <del>14</del><br>15 | PUMP ROOM                             | PUMP ROOM   | 3' - 0"            | 7' - 0"            | 0' - 1 3/4" |               | HM         | C         | 45MIN       |                      |
| <del>1</del> 6      | TUNNEL                                | RETAIL  | 5' - 9"            | 8' - 0"            | 0 1 3/4     | AL/GL         | AL         | A         | TOWNIN      |                      |
| 17                  | 10111122                              | CONSTANT GRIND  | 2' - 8"            | 6' - 8"            | 0' - 2"     | / LE GE       | 7 12       | +         |             |                      |
| 48                  | ENTRY LOBBY                           | ELEVATOR LOBBY  |                    | 7' - 10 1/2"       |             |               |            |           |             |                      |
| 49                  | ELEVATOR LOBBY                        | TUNNEL  | 6' - 0"            | 8' - 0"            | 1 .,_       |               |            |           |             |                      |
| 50                  | ENTRY LOBBY                           | ENTRY LOBBY   | 3' - 0"            | 7' - 0"            | 0' - 1 1/2" | AL/GL         | AL         | K         |             |                      |
| 51                  | ENTRY LOBBY                           | ENTRY LOBBY   | 3' - 0"            | 7' - 0"            | 0' - 1 1/2" | AL/GL         | AL         | K         |             |                      |
| 52                  | ENTRY LOBBY                           | TUNNEL  | 6' - 0"            | 8' - 0"            |             | AL/GL         | AL         | Α         |             |                      |
| 53                  | ENTRY LOBBY                           | TUNNEL  | 6' - 0"            | 8' - 0"            |             | AL/GL         | AL         | Α         |             |                      |
| 54                  | ENTRY LOBBY                           | TUNNEL  | 6' - 0"            | 8' - 0"            |             | AL/GL         | AL         | Α         |             |                      |
| 55                  | STORAGE                               | ROCK SHOP   | 3' - 0"            | 7' - 0"            | 0' - 1 3/4" |               | SCW        | V         | 1HR         |                      |
| 56                  | TUNNEL                                | ROCK SHOP   | 6' - 0"            | 8' - 0"            |             | AL/GL         | AL         | Α         |             |                      |
| 58<br>59            | RETAIL                                | TUNNEL EXIT CORRIDOR  | 6' - 0"<br>5' - 1" | 8' - 0"            |             | AL/GL         | AL         | A         |             |                      |
| 90<br>80            | RECEVING                              | CAN WASH  | 3' - 0"            | 8' - 0"<br>7' - 0" | 0' - 1 3/4" | HM/GI         | HM         | E         |             |                      |
| 67                  | EXIT CORRIDOR                         | LOADING   | 3' - 0"            | 7' - 0"            | 0' - 1 3/4" | HIVI/GL       | HIVI       | ╬         |             |                      |
| ,,<br>69            | GENERATOR                             | TUNNEL  | 4' - 0"            | 10' - 0"           | 0' - 1 3/4" | M             | M          | В         | _           |                      |
| 71                  | ELECTRICAL VAULT                      |   | 8' - 0"            | 10' - 0"           | 0' - 1 3/4" |               | M          | В         |             |                      |
| 73                  | ENTRANCE                              | TUNNEL  | 6' - 0"            | 8' - 0"            | 1 3, .      | AL/GL         | AL         | A         |             |                      |
| 74                  | ENTRANCE                              | TUNNEL  | 6' - 0"            | 8' - 0"            |             | AL/GL         | AL         | Α         |             |                      |
| 77                  |                                       | ENTRY LOBBY   | 3' - 0"            | 7' - 0"            | 0' - 1 3/4" |               | НМ         | С         |             |                      |
| 78                  | ENTRY LOBBY                           | ENTRY LOBBY   | 14' - 10 29/32"    | 7' - 5"            |             |               |            |           |             |                      |
| 79                  | EXIT CORRIDOR                         | RECEIVING OFFICE  | 2' - 10"           | 7' - 0"            | 0' - 1 3/4" |               |            |           |             |                      |
| 30                  |                                       | ENTRY LOBBY   | 8' - 0"            | 12' - 0"           |             |               |            |           |             |                      |
| 31                  |                                       |   | 12' - 0"           | 14' - 4"           |             |               |            |           |             |                      |
| 32                  | ELEVATOR LOBBY                        |   | 4' - 9"            | 0' - 0"            |             |               |            |           |             |                      |
| 33                  |                                       | ELEVATOR LOBBY  | 4' - 9"            | 0' - 0"            |             |               |            |           | 1           |                      |

| MARK       | From Room: Name                   | To Room: Name                               | WIDTH               | НЕІСНТ                 | THICKNESS     | DOOR MATERIAL  | DOOR FRAME | DOOR TYPE | FIRE RATING    | REMARKS |
|------------|-----------------------------------|---|---------------------|------------------------|---------------|----------------|------------|-----------|----------------|---------|
|            | BALLROOM MEETING                  |   | 6' - 0"             | 7' - 0"                |               |                |            |           |                |         |
| 162        | FOOD TRANS.                       |   | 4' - 9"             | 0' - 0"                | 01 4 0 4 4 11 | 14/5 (11) 4    |            |           | 001411         |         |
| 202        | BALLROOM MEETING PREFUNCTION AREA | PREFUNCTION AREA BALLROOM MEETING           | 6' - 0"<br>6' - 0"  | 7' - 0"<br>7' - 0"     |               | WD/HM<br>WD/HM |            | BB<br>BB  | 90MIN<br>90MIN |         |
| 204        | BALLROOM MEETING                  | PREFUNCTION AREA                            | 6' - 0"             | 7' - 0"                |               | WD/HM          |            | BB        | 90MIN          |         |
| 205        | BALLROOM MEETING                  | PREFUNCTION AREA                            | 6' - 0"             | 7' - 0"                |               | WD/HM          | НМ         | ВВ        | 90MIN          |         |
|            | BALLROOM MEETING                  | PREFUNCTION AREA                            | 6' - 0"             | 7' - 0"                |               | WD/HM          |            | BB        | 90MIN          |         |
| 207<br>208 | BALLROOM MEETING<br>BOH 3         | PREFUNCTION AREA PREFUNCTION AREA           | 6' - 0"<br>6' - 0"  | 7' - 0"<br>7' - 0"     |               | WD/HM<br>WD/HM |            | BB<br>BB  | 90MIN          |         |
| 209        | BOH 3                             | HALL  | 6' - 0"             | 0' - 0"                | 0 1 3/4       |                | HM         | D         |                |         |
| 210        | PREFUNCTION AREA                  | HALL  | 6' - 0"             | 7' - 0"                |               | WD/HM          | НМ         | ВВ        |                |         |
| 211        | ELEV LOBBY                        | STAIR 1                                     | 3' - 0"             | 7' - 0"                | 0' - 1 3/4"   | HM             | HM         | E         | 2HR            |         |
|            | PREFUNCTION AREA PREFUNCTION AREA | MEETING ROOM MEETING ROOM                   | 6' - 0"<br>6' - 0"  | 7' - 0"<br>7' - 0"     |               | WD/HM<br>WD/HM |            | BB<br>BB  |                |         |
| 214        | MEETING ROOM                      | BALLROOM LOBBY                              | 6' - 0"             | 7' - 0"                |               | WD/HM          |            | BB        |                |         |
| 215        | BALLROOM LOBBY                    | MEETING ROOM                                | 6' - 0"             | 7' - 0"                | 0' - 1 3/4"   | WD/HM          | НМ         | ВВ        |                |         |
| 216        | PREFUNCTION AREA                  | BALLROOM  DDEELINGTION ADEA                 | 6' - 0"             | 7' - 0"                |               | WD/HM<br>WD/HM |            | BB        | 90MIN          |         |
| 217<br>218 | BALLROOM PREFUNCTION AREA         | PREFUNCTION AREA BALLROOM                   | 6' - 0"<br>6' - 0"  | 7' - 0"<br>7' - 0"     | 0' - 1 3/4"   | WD/HM<br>WD/HM |            | BB<br>BB  | 90MIN<br>90MIN |         |
| 219        | PREFUNCTION AREA                  | BALLROOM                                    | 6' - 0"             | 7' - 0"                | 0' - 1 3/4"   | WD/HM          |            | BB        | 90MIN          |         |
| 220        | BALLROOM                          | PREFUNCTION AREA                            | 6' - 0"             | 7' - 0"                | 0' - 1 3/4"   | WD/HM          |            | ВВ        | 90MIN          |         |
| 221        | PREFUNCTION AREA                  | BALLROOM  DDEELINGTION ADEA                 | 6' - 0"<br>6' - 0"  | 7' - 0"<br>7' - 0"     |               | WD/HM          |            | BB        | 90MIN          |         |
| 222<br>223 | BALLROOM BANQUET SET UP           | PREFUNCTION AREA BALLROOM                   | 6' - 0"             | 7' - 0"                |               | WD/HM<br>WD/HM |            | BB<br>BB  | 90MIN<br>90MIN |         |
|            | BALLROOM                          | BANQUET SET UP                              | 6' - 0"             | 7' - 0"                | 0' - 1 3/4"   |                |            | BB        | 90MIN          |         |
| 225        | HALL                              | PREFUNCTION AREA                            | 6' - 0"             | 7' - 0"                | 0' - 1 3/4"   |                | НМ         | D         | =              |         |
| 226<br>227 | HALL<br>FOOD & BEV. COPY AREA     | CHAIR STORAGE HALL                          | 6' - 0"<br>3' - 0"  | 7' - 0"<br>6' - 9 1/2" |               |                | HM<br>AL   | D<br>K    | 1HR            |         |
| 228        | FOOD & BEV. COPY AREA             | SESSIONS OFFICE                             | 3' - 0"             | 7' - 0"                |               |                | MTL        | T         |                |         |
| 229        | BEVERAGE OFFICE                   | FOOD & BEV. COPY AREA                       | 3' - 0"             | 7' - 0"                |               |                | MTL        | Т         |                |         |
| 230        | FOOD & BEV. COPY AREA             | CATERING SALES                              | 3' - 0"             | 7' - 0"                |               |                | MTL        | T         |                |         |
|            | BANK DIRECTOR BANQUET MANAGER     | FOOD & BEV. COPY AREA FOOD & BEV. COPY AREA | 3' - 0"             | 7' - 0"<br>7' - 0"     |               |                | MTL<br>MTL | T         |                |         |
| 233        | FOOD & BEV. COPY AREA             | HALL  | 3' - 0"             | 7' - 0"                |               |                | AL         | K         |                |         |
| 234        | HALL                              | KITCHEN                                     | 6' - 0"             | 7' - 0"                |               |                | НМ         | D         | 2HR            |         |
| 235<br>236 | MECHANICAL<br>HALL                | MENS  | 5' - 2"<br>3' - 0"  | 7' - 0"<br>7' - 0"     |               | HM<br>WD/HM    | HM         | D<br>F    | 1HR            |         |
| 237        | HALL                              | WOMENS                                      | 3' - 0"             | 7' - 0"                |               | WD/HM          |            | F         |                |         |
| 238        |                                   |   | 6' - 0"             | 7' - 0"                |               |                | НМ         | X         |                |         |
|            | OFFICE                            | WAITING                                     | 6' - 0"             | 7' - 0"                |               |                | НМ         | X         |                |         |
| 240<br>241 | STAIR 2<br>WAITING                | WAITING<br>STORAGE                          | 3' - 0"             | 7' - 0"<br>7' - 0"     |               |                | HM<br>HM   | E         | 2HR<br>1HR     |         |
| 241        | OFFICE                            | STORAGE                                     | 6' - 0"             | 7' - 0"                |               |                | HM         | D         | 1HR            |         |
| 243        | ECOMMERCE MANAGER                 | OFFICE                                      | 3' - 0"             | 7' - 0"                | 0' - 1 3/4"   | GL/WD          | НМ         | T         |                |         |
|            | OFFICE                            | RESERV. MANAGER                             | 3' - 0"             | 7' - 0"                |               |                | НМ         | T         |                |         |
| 245<br>246 | OFFICE<br>ASST. TRANS. SALES      | DIR. REVENUE MANA. OFFICE                   | 3' - 0"             | 7' - 0"<br>7' - 0"     |               |                | HM<br>HM   | T         |                |         |
| 247        | OFFICE                            | ASST. GROUP SALES                           | 3' - 0"             | 7' - 0"                |               |                | НМ         | T         |                |         |
| 248        | OFFICE                            | CONVENTION SERV. MANAGER                    | 3' - 0"             | 7' - 0"                | 0' - 1 3/4"   | GL/WD          | НМ         | Т         |                |         |
|            | BANQUET ASST. MANAGER             | OFFICE                                      | 3' - 0"             | 7' - 0"                |               |                | HM         | T         |                |         |
|            | OFFICE<br>AV RACKS                | PR & MARCOM MANAGER PREFUNCTION AREA        | 3' - 0"             | 7' - 0"<br>7' - 0"     |               | WD/HM          | HM<br>HM   | F         |                |         |
| 251        |                                   | KITCHEN                                     | 6' - 0"             | 7' - 0"                |               |                | НМ         | D         | 2HR            |         |
|            | ELEV LOBBY                        | LORDY                                       | 8' - 4"             | 7' - 10"               |               | WD/HM          |            | ВВ        | 20MIN          |         |
| 253<br>254 | CIRCULATION CIRCULATION           | LOBBY                                       | 6' - 0"<br>6' - 0"  | 7' - 0"<br>7' - 0"     | _             | WD/HM<br>WD/HM |            | BB<br>BB  |                |         |
| 255        | CIRCULATION                       | LOBBY                                       | 6' - 0"             | 7' - 0"                |               | WD/HM          |            | ВВ        |                |         |
| 256        | JANITOR                           | LOBBY                                       | 6' - 0"             | 7' - 0"                | 0' - 1 3/4"   | НМ             | НМ         | D         | 1HR            |         |
|            | WOMENS RESTROOM                   | LOBBY                                       | 3' - 0"             | 7' - 0"<br>7' - 0"     | 0' - 1 3/4"   |                |            | F         |                |         |
|            | PREFUNCTION AREA                  | MENS RESTROOM MDF ROOM                      | 3' - 0"             | 7' - 0"                | 0' - 1 3/4"   |                |            | F         |                |         |
|            | PREFUNCTION AREA                  | ELEVATOR LOBBY                              | 3' - 0"             | 7' - 0"                | 0' - 1 3/4"   |                |            | G         | 45MIN          |         |
|            | PREFUNCTION AREA                  | STAIR 3                                     | 3' - 0"             | 7' - 0"                |               | НМ             | НМ         | Е         | 2HR            |         |
|            | CATERING SALES                    | STOR.                                       | 3' - 0"             | 7' - 0"                | 0' - 1 3/4"   |                |            |           | 1HR            |         |
|            | PREFUNCTION AREA ELEV LOBBY       | STAIR 1<br>LOBBY                            | 3' - 0"<br>9' - 10" | 7' - 0"<br>7' - 4"     | 0' - 1 3/4"   |                |            |           | 2HR            |         |
|            | FOOD TRANS.                       |   | 4' - 9"             | 0' - 0"                |               |                |            |           |                |         |
| 267        | KITCHEN                           | ELEVATOR LOBBY                              | 6' - 0"             | 0' - 0"                |               |                |            | 1         |                |         |

| MARK | FROM                         | O                            | WIDTH              | НЕІСНТ         | THICKNESS                  | DOOR MATERIAL | DOOR FRAME | DOOR TYPE | FIRE RATING | REMARKS  |
|------|------------------------------|------------------------------|--------------------|----------------|----------------------------|---------------|------------|-----------|-------------|----------|
| Σ    | ii.                          | O <sub>L</sub>               | ≥                  | 三              | F                          | ă             | _ م        | ַבֿ       | 正           | <u> </u> |
| 2M   | HAIR SALON AND SPA RECEPTION |                              | 4' - 2 15/32"      | 7' - 8<br>1/4" | 0' - 1 1/2"                |               |            |           |             |          |
| 2M3  | HAIR SALON AND SPA RECEPTION | SHOP                         | 3' - 0"            |                | 0' - 1 1/2"                | AL/GL         | AL         | K         |             |          |
| 2M4  | HAIR SALON AND SPA RECEPTION |                              | 3' - 0"            |                | 0' - 1 3/4"                |               | НМ         | V         | 1HR         |          |
| 2M5  | TREATMENT ROOM               | HAIR SALON AND SPA RECEPTION | 3' - 0"            | 7' - 0"        | 0' - 1 3/4"                | SCW           | НМ         | V         |             |          |
| 2M6  | HAIR SALON AND SPA RECEPTION | TREAT.2                      | 3' - 0"            | 7' - 0"        | 0' - 1 3/4"                | SCW           | НМ         | V         |             |          |
| 2M7  | TREAT.3                      | HAIR SALON AND SPA RECEPTION | 3' - 0"            | 7' - 0"        | 0' - 1 3/4"                | SCW           | НМ         | V         |             |          |
| 2M8  | HAIR SALON AND SPA RECEPTION | TREAT.4                      | 3' - 0"            |                | 0' - 1 3/4"                |               | НМ         | V         |             |          |
| 2M9  | HAIR SALON AND SPA RECEPTION | STO.                         | 3' - 0"            |                | 0' - 1 3/4"                |               | НМ         | V         | 1HR         |          |
|      | SERV. CORR.                  | GYM                          | 3' - 0"            |                | 0' - 1 3/4"                |               |            | G         |             |          |
|      | GYM                          | HALL                         | 5' - 5 15/16"      |                |                            |               | AL         | A         |             |          |
|      | HALL                         | STAIR 2                      | 3' - 0"            |                | 0' - 1 3/4"                |               | HM         | E         | 2HR         |          |
|      | HALL                         | STOR & AV RACKS              | 6' - 0"            |                | 0' - 1 3/4"                |               | HM         | D         | 1HR         |          |
|      | MENS                         | HALL                         | 3' - 0"            |                | 0' - 1 3/4"                |               |            | F         |             |          |
|      | HALL                         | WOMENS                       | 3' - 0"            |                | 0' - 1 3/4"                |               |            | F         |             |          |
|      | HALL                         | SUPPORT                      | 3' - 0"            |                | 0' - 1 1/2"                |               | AL         | K         |             |          |
|      | SUPPORT                      | OFFICE<br>SUPPORT            | 3' - 0"<br>3' - 0" |                | 0' - 1 3/4"<br>0' - 1 3/4" |               | HM         | T         |             |          |
|      | SUPPORT                      | STORAGE                      | 3' - 0"            |                | 0' - 1 3/4"                |               | HM<br>HM   | V         | 1HR         |          |
| 2M21 | SUPPORT                      | HALL                         | 3' - 0"            |                | 0' - 1 1/2"                |               | AL         | K         | IIIN        |          |
| 2M22 |                              | SUPPORT                      | 3' - 0"            |                | 0' - 1 3/4"                |               | HM         | T         |             |          |
|      | SUPPORT                      | OFFICE                       | 3' - 0"            |                | 0' - 1 3/4"                |               | HM         | T         |             |          |
|      | STORAGE                      | SUPPORT                      | 3' - 0"            |                | 0' - 1 3/4"                |               | HM         | V         | 1HR         |          |
|      | HALL                         | FINANCE                      | 3' - 0"            |                | 0' - 1 3/4"                |               | НМ         | T         |             |          |
|      | FINANCE                      | OFFICE                       | 3' - 0"            |                | 0' - 1 3/4"                |               | НМ         | T         |             |          |
|      | CASH CONTROL                 | FINANCE                      | 3' - 0"            |                | 0' - 1 3/4"                |               | НМ         | Т         |             |          |
| 2M28 | FINANCE                      | STORAGE                      | 3' - 0"            | 7' - 0"        | 0' - 1 3/4"                | WD            | НМ         | V         | 1HR         |          |
| 2M29 | DIRECTOR                     | FINANCE                      | 3' - 0"            | 7' - 0"        | 0' - 1 3/4"                | WD/GL         | НМ         | Т         |             |          |
| 2M30 | FINANCE                      | OFFICE                       | 3' - 0"            | 7' - 0"        | 0' - 1 3/4"                | WD/GL         | НМ         | Т         |             |          |
|      | CASHIER PAYROLL              | FINANCE                      | 3' - 0"            |                | 0' - 1 3/4"                |               | НМ         | Т         |             |          |
|      | HUMAN RESOURCES              | HALL                         | 3' - 0"            |                | 0' - 1 1/2"                |               | AL         | K         |             |          |
|      | HUMAN RESOURCES              | TRAINING ROOM                | 3' - 0"            |                | 0' - 1 1/2"                |               | AL         | K         |             |          |
|      | HUMAN RESOURCES              | HR FILES                     | 3' - 0"            |                | 0' - 1 3/4"                |               | НМ         | Т         |             |          |
|      | HR MANAGER                   | HUMAN RESOURCES              | 3' - 0"            |                | 0' - 1 3/4"                |               | HM         | T         |             |          |
|      | HUMAN RESOURCES              | HR DIRECTOR                  | 3' - 0"            |                | 0' - 1 3/4"                |               | HM         | T         |             |          |
|      | HALL                         | WORK STATION                 | 4' - 8"            |                | 0' - 1 3/4"                |               |            | BB        |             |          |
|      | WORK STATION                 | DIRECT. SALES                | 3' - 0"            |                | 0' - 1 3/4"                |               | HM         | T         |             |          |
|      | MARKET EXEC. GROUP SALES     | WORK STATION WORK STATION    | 3' - 0"<br>3' - 0" |                | 0' - 1 3/4"<br>0' - 1 3/4" |               | HM<br>HM   | T         |             |          |
|      | HALL                         | STOR                         | 3' - 0"            |                | 0' - 1 3/4"                |               | НМ         | V         | 1HR         |          |
|      | HALL                         | ELEV LOBBY                   | 3' - 0"            |                | 0' - 1 3/4"                |               |            | G         | 45MIN       |          |
|      | HALL                         | MEP EQUIP. ROOM              | 6' - 0"            |                | 0' - 1 3/4"                |               | HM         | D         | 1HR         |          |
|      | EXEC. ADMIN.                 | EXEC. LOBBY                  | 3' - 0"            |                | 0' - 1 3/4"                |               | HM         | T         |             |          |
|      | EXEC. LOBBY                  | G.M.                         | 3' - 0"            |                | 0' - 1 3/4"                |               | НМ         | T         |             |          |
|      | DIR. OF OPER.                | EXEC. LOBBY                  | 3' - 0"            |                | 0' - 1 3/4"                |               | НМ         | T         |             |          |
|      | CONFERENCE                   | EXEC. LOBBY                  | 6' - 0"            |                | 0' - 1 3/4"                |               | НМ         | S         |             |          |
|      | AV RACKS                     | STAIR 1                      | 3' - 0"            |                | 0' - 1 3/4"                |               |            |           | 2HR         |          |
|      | HALL                         |                              | 9' - 10"           | 7' - 4"        |                            |               |            |           |             |          |
| 2M52 | CONFERENCE                   |                              | 9' - 10"           | 7' - 4"        |                            |               |            |           |             |          |
| 2M53 | SERV. CORR.                  |                              | 4' - 9"            | 0' - 0"        |                            |               |            |           |             |          |
| 2M54 | STAIR 3                      | HALL                         | 3' - 0"            | 7' - 0"        | 0' - 1 3/4"                |               |            |           | 45MIN       |          |

DOOR SCHEDULE - INTERMEDIATE PARKING

3' - 0" 7' - 0" 0' - 1 3/8"

8' - 0" 6' - 6" 0' - 1 1/2"


2HR

3' - 0" 7' - 0" 0' - 1 3/4" 3' - 0" 7' - 0" 0' - 1 3/4"

ELECTRIC MEZZ

ELECTRIC MEZZ

STAIR 3

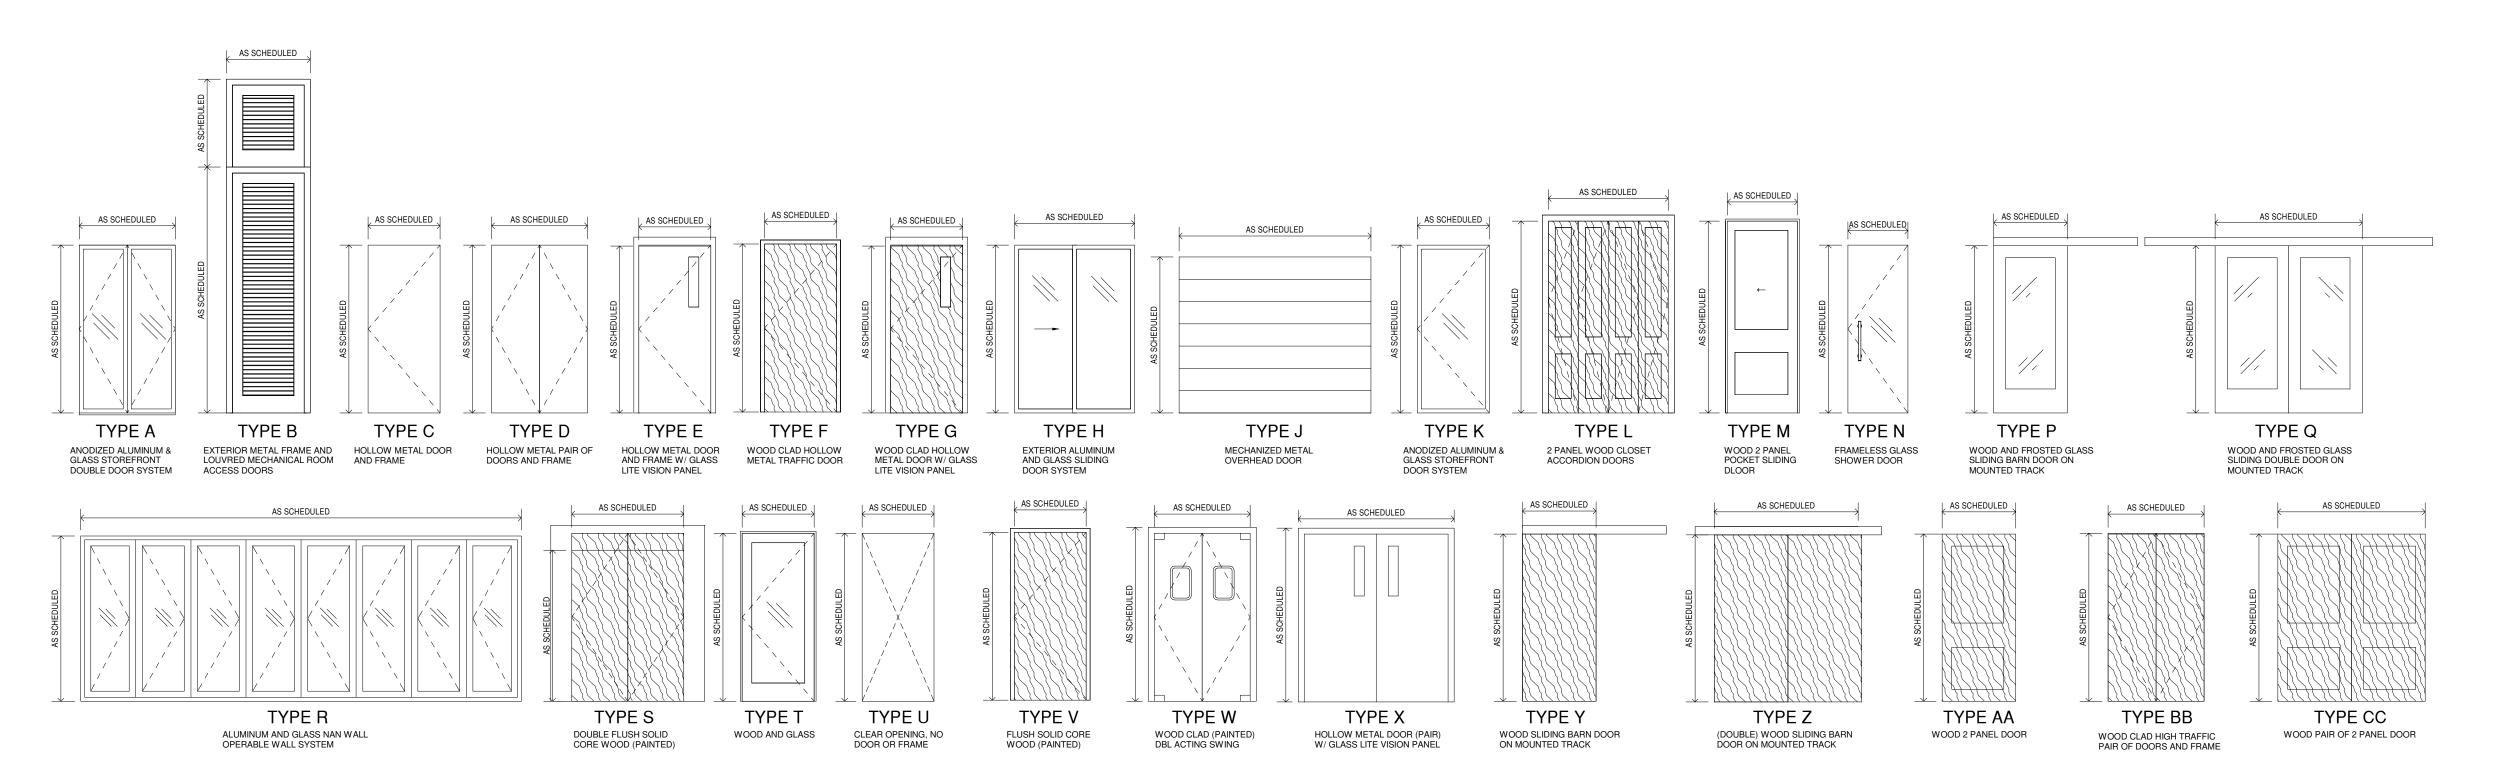

IP 01 GENERATOR

IP 04 EXIT CORRIDOR

IP 05 EXIT CORRIDOR

IP 02 LOADING




SINCE 1961

CERTIFIED CORRECT




NOT BE LOANED, REPRODUCED, COPIED, EITHER WHOLLY OR IN PART, OR MADE PUBLIC IN ANY MANNER WITHOUT THE WRITTEN CONSENT OF HBSA II ARCHITECTS, A PROFESSIONAL L.L.C. ALL RIGHTS OF DESIGN OR INVENTION ARE RESERVED AND WILL REMAIN THE SOLE PROPERTY OF HBSA II ARCHITECTS A PROFESSIONAL L.L.C.

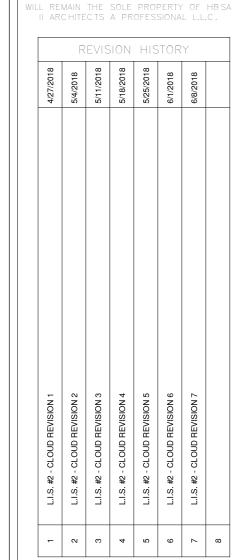

SCHEDULES

PROJECT#: 1709 PHASE: DD TEAM: Author CHECKER: Checker

SCALE: AS NOTED

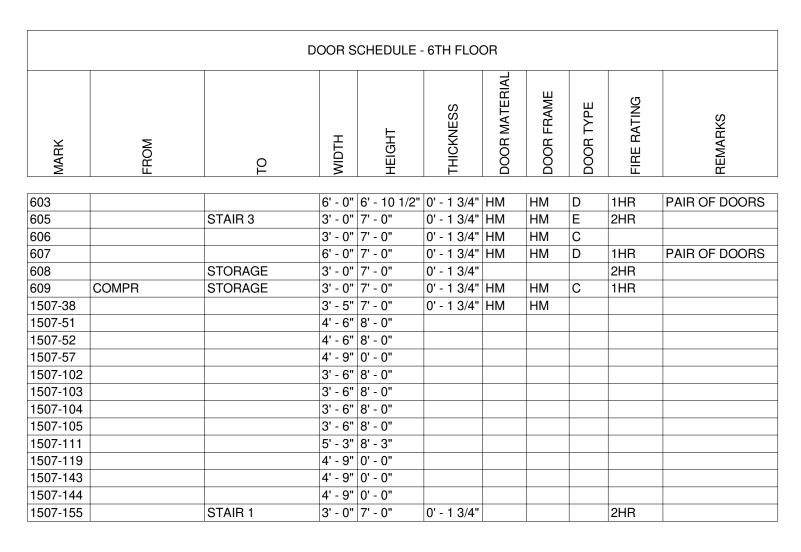

|          |      | DO                      | OR SCH  | IEDULE - 71  | H FLOOR     |               |            |           |             |         |
|----------|------|-------------------------|---------|--------------|-------------|---------------|------------|-----------|-------------|---------|
| MARK     | FROM | 9                       | WIDTH   | НЕІСНТ       | THICKNESS   | DOOR MATERIAL | DOOR FRAME | DOOR TYPE | FIRE RATING | REMARKS |
| 105      | T    |                         | 41 011  | 01 011       |             |               | 1          |           |             | T       |
| 165      |      |                         | 4' - 9" | 0' - 0"      | 01 4 0 (41) | 1.15.4        |            | _         | OL ID       |         |
| 701      |      | IDE                     | 6' - 0" | 7' - 0"      |             | HM            | HM         | D         | 2HR         |         |
| 707      |      | IDF                     | 3' - 0" | 7' - 0"      | 0' - 1 3/4" | HM            | HM         | С         | 4115        |         |
| 708      |      |                         | 6' - 0" | 6' - 10 1/2" | 0' - 1 3/4" | HM            | HM         | D         | 1HR         |         |
| 710      |      |                         | 6' - 0" | 7' - 0"      | 0' - 1 3/4" | HM            | HM         | D         | 1HR         |         |
| 711      |      | OTAID 0                 | 3' - 0" | 7' - 0"      | 0' - 1 3/4" | HM            | HM         | С         | 2HR         |         |
| 712      |      | STAIR 3                 | 3' - 0" | 7' - 0"      | 0' - 1 3/4" | HM            | HM         | E         | 2HR         |         |
| 714      |      |                         | 3' - 0" | 7' - 0"      | 0' - 1 3/4" | HM            | НМ         | E         | 2HR         |         |
| 715      |      | IDF                     | 3' - 0" | 7' - 0"      | 0' - 1 3/4" | НМ            | НМ         | С         | 1HR         |         |
| 878      |      |                         | 3' - 0" | 7' - 0"      | 0' - 1 3/4" | НМ            | НМ         | E         | 2HR         |         |
| 908-11   |      | TOILET                  | 3' - 0" | 7' - 0"      | 0' - 1 3/4" | НМ            | НМ         | С         | 1HR         |         |
| 908-12   |      | SUPPLIES                | 3' - 0" | 7' - 0"      | 0' - 1 3/4" | НМ            | НМ         | С         | 1HR         |         |
| 908-13   |      | HOUSE KEEPING / MGMT.   | 3' - 0" | 7' - 0"      | 0' - 1 3/4" | НМ            | НМ         | С         | 1HR         |         |
| 908-14   |      | LINENS                  | 6' - 0" | 7' - 0"      | 0' - 2"     | НМ            | HM         | С         |             |         |
| 908-15   |      | ELEV. 9 CONTROL<br>ROOM | 3' - 0" | 7' - 0"      | 0' - 1 3/4" | НМ            | НМ         | С         | 1HR         |         |
| 1507-39  |      |                         | 3' - 5" | 7' - 0"      | 0' - 1 3/4" | НМ            | НМ         |           |             |         |
| 1507-53  |      |                         | 4' - 6" | 8' - 0"      |             |               |            |           |             |         |
| 1507-54  |      |                         | 4' - 6" | 8' - 0"      |             |               |            |           |             |         |
| 1507-112 |      |                         | 5' - 3" | 8' - 3"      |             |               |            |           |             |         |
| 1507-120 |      |                         | 4' - 9" | 0' - 0"      |             |               |            |           |             |         |
| 1507-145 |      |                         | 4' - 9" | 0' - 0"      |             |               |            |           |             |         |
| 1507-146 |      |                         | 4' - 9" | 0' - 0"      |             |               |            |           |             |         |
| 1507-156 |      | STAIR 1                 | 3' - 0" | 7' - 0"      | 0' - 1 3/4" |               |            |           | 2HR         |         |
| 1507-174 |      |                         | 3' - 5" | 7' - 0"      | 0' - 1 3/4" |               |            |           |             |         |

|      |                 | DOC               | OR SCHE | DULE -  | 3RD FLOO    | JK            |            |           |             |   |
|------|-----------------|-------------------|---------|---------|-------------|---------------|------------|-----------|-------------|---|
| MARK | FROM            | 10                | WIDTH   | HEIGHT  | THICKNESS   | DOOR MATERIAL | DOOR FRAME | DOOR TYPE | FIRE RATING | я<br>В<br>В<br>В<br>В<br>В<br>В<br>В<br>В |
| 300  |                 | ELEC.             | 3' - 0" | 7' - 0" | 0' - 1 3/4" | НМ            | НМ         | С         |             |   |
| 301  | STOR.           | IT WORK STATION   | 3' - 0" | 7' - 0" | 0' - 1 3/4" | HM            | HM         | E         | 2HR         |   |
| 302  | GARAGE          | IT WORK STATION   | 6' - 0" | 7' - 0" | 0' - 1 3/4" | HM            | HM         | D         | 2HR         |   |
| 303  | d/ II / IGE     | TI WOITE OF THOSE | 6' - 0" | 7' - 0" | 0' - 1 3/4" |               | HM         | D         | 21111       |   |
| 304  |                 |                   | 6' - 0" | 7' - 0" | 0' - 1 3/4" | HM            | HM         | D         |             |   |
| 308  | GARAGE          |                   |         | _       | 0' - 1 3/4" |               | HM         | D         | 1HR         |   |
| 309  | STAIR 1         |                   | 3' - 0" | 7' - 0" | 0' - 1 3/4" | НМ            | HM         | E         | 2HR         |   |
| 310  |                 | STAIR 3           | 3' - 0" | 7' - 0" | 0' - 1 3/4" | НМ            | НМ         | E         | 2HR         |   |
| 311  |                 |                   | 3' - 0" | 7' - 0" | 0' - 1 3/4" | НМ            | НМ         | С         | 2HR         |   |
| 312  |                 |                   | 6' - 0" | 7' - 0" | 0' - 1 3/4" | НМ            | НМ         | D         | 1HR         |   |
| 314  | IT WORK STATION | Room              | 3' - 0" | 7' - 0" | 0' - 1 3/4" | НМ            | НМ         | С         |             |   |
| 315  | IT WORK STATION | DATA CENTER       | 3' - 0" | 7' - 0" | 0' - 1 3/4" | НМ            | НМ         | С         |             |   |
| 316  | IT WORK STATION | IT MANAGER        | 3' - 0" | 7' - 0" | 0' - 1 3/4" | HM/GL         | НМ         | Т         |             |   |
| 317  | IT WORK STATION | OSBF              | 3' - 0" | 7' - 0" | 0' - 1 3/4" | НМ            | НМ         | С         |             |   |
| 318  | IT WORK STATION | STOR              | 3' - 0" | 7' - 0" | 0' - 1 3/4" | НМ            | НМ         | С         | 1HR         |   |
| 319  | IT WORK STATION | MDF               | 3' - 0" | 7' - 0" | 0' - 1 3/4" | НМ            | НМ         | С         |             |   |
| 320  | COMPR           | Room              | 3' - 0" | 7' - 0" | 0' - 1 3/4" |               |            |           | 1HR         |   |
| 320  |                 | STAIR 1           | 3' - 0" | 7' - 0" | 0' - 1 3/4" |               |            |           | 2HR         |   |
| 321  | STOR.           | GARAGE            | 6' - 0" | 7' - 0" | 0' - 1 3/4" |               |            |           | 2HR         |   |
| 322  |                 |                   | 3' - 5" |         | 0' - 1 3/4" |               | НМ         |           |             |   |
| 327  | STAIR 1         |                   | 3' - 0" |         | 0' - 1 3/4" | НМ            | НМ         | E         | 2HR         |   |
| 328  |                 | STAIR 1           | 3' - 0" | 7' - 0" | 0' - 1 3/4" |               |            |           | 2HR         |   |

|          |             | DC            | OR SC   | HEDULE - 4   | TH FLOOF    | ?             |            |           |             |         |
|----------|-------------|---------------|---------|--------------|-------------|---------------|------------|-----------|-------------|---------|
| MARK     | FROM        | 10            | WIDTH   | НЕІСНТ       | THICKNESS   | DOOR MATERIAL | DOOR FRAME | DOOR TYPE | FIRE RATING | REMARKS |
| 163      |             |               | 4' O"   | 0' - 0"      |             |               |            |           |             |         |
| 404      |             |               |         | 6' - 10 1/2" | 0' - 1 3/4" | НМ            | НМ         | D         | 1HR         |         |
| 405      |             | STAIR 3       |         | 7' - 0"      | 0' - 1 3/4" | HM            | HM         | E         | 2HR         |         |
| 406      |             | 01711110      | 3' - 0" | 7' - 0"      | 0' - 1 3/4" | HM            | HM         | C         | 45MIN       |         |
| 407      |             |               | 6' - 0" | 7' - 0"      | 0' - 1 3/4" | HM            | HM         | D         | 1HR         |         |
| 408      |             |               | 6' - 0" | 7' - 0"      | 0' - 1 3/4" |               | HM         | D         | 2HR         |         |
| 409      | MENS LOCKER |               | 3' - 0" | 7' - 0"      | 0' - 1 3/4" |               | SCW        | V         |             |         |
| 410      |             | WOMENS LOCKER | 3' - 0" | 7' - 0"      | 0' - 1 3/4" |               | SCW        | V         |             |         |
| 411      | MENS RR     |               | 3' - 0" | 7' - 0"      | 0' - 1 3/4" |               | SCW        | V         |             |         |
| 412      |             | WOMENS RR     | 3' - 0" | 7' - 0"      | 0' - 1 3/4" |               | SCW        | V         |             |         |
| 413      | COMPR       | WOMENS RR     | 3' - 0" | 7' - 0"      | 0' - 1 3/4" | НМ            | НМ         | С         | 1HR         |         |
| 1507-36  |             |               | 3' - 5" | 7' - 0"      | 0' - 1 3/4" | НМ            | НМ         |           |             |         |
| 1507-47  |             |               | 4' - 6" | 8' - 0"      |             |               |            |           |             |         |
| 1507-48  |             |               | 4' - 6" | 8' - 0"      |             |               |            |           |             |         |
| 1507-77  |             | STAIR 1       | 3' - 0" | 7' - 0"      | 0' - 1 3/4" |               |            |           | 2HR         |         |
| 1507-93  |             |               | 5' - 3" | 8' - 3"      |             |               |            |           |             |         |
| 1507-94  |             |               | 3' - 6" | 8' - 0"      |             |               |            |           |             |         |
| 1507-95  |             |               | 3' - 6" | 8' - 0"      |             |               |            |           |             |         |
| 1507-96  |             |               | 3' - 6" | 8' - 0"      |             |               |            |           |             |         |
| 1507-97  |             |               | 3' - 6" | 8' - 0"      |             |               |            |           |             |         |
| 1507-117 |             |               | 4' - 9" | 0' - 0"      |             |               |            |           |             |         |
| 1507-139 |             |               | 4' - 9" | 0' - 0"      |             |               |            |           |             |         |
| 1507-140 |             |               | 4' - 9" | 0' - 0"      |             |               |            |           |             |         |
| 1507-151 |             |               | 3' - 0" | 7' - 0"      | 0' - 1 3/4" |               |            |           | 2HR         |         |
| 1515-15  | WOMENS RR   | WOMENS RR     | 3' - 0" | 7' - 0"      | 0' - 1"     |               |            |           |             |         |
| 1515-19  | WOMENS RR   | WOMENS RR     | 2' - 8" | 7' - 0"      | 0' - 1"     |               |            |           |             |         |
| 1515-20  | WOMENS RR   | WOMENS RR     | 2' - 0" | 7' - 0"      | 0' - 1"     |               |            |           |             |         |
| 1515-22  | MENS RR     | MENS RR       | 2' - 8" | 7' - 0"      | 0' - 1"     |               |            |           |             |         |
| 1515-23  | MENS RR     | MENS RR       | 3' - 0" | 7' - 0"      | 0' - 1"     |               |            |           |             |         |

|          |               |             | DOOR S  | SCHEDULE | - 5TH FLC   | OR            |            |           |             |         |
|----------|---------------|-------------|---------|----------|-------------|---------------|------------|-----------|-------------|---------|
| MARK     | FROM          | 01          | WIDTH   | НЕІСНТ   | THICKNESS   | DOOR MATERIAL | DOOR FRAME | DOOR TYPE | FIRE RATING | REMARKS |
| 164      | ENGINEERING   |             | 4' - 9" | 0' - 0"  |             |               |            |           |             |         |
| 503      | LINGINLLITING | ENGINEERING | 6' - 0" | 7' - 0"  | 0' - 1 3/4" | нм            | НМ         | D         | 2HR         |         |
| 504      | COMPR         | ENGINEERING | 3' - 0" | 7' - 0"  |             | HM            | HM         | С         | 1HR         |         |
| 505      | WATER HEATERS |             | 6' - 0" | 7' - 0"  |             | HM            | HM         | D         | 2HR         |         |
| 506      |               |             | 6' - 0" | _        |             |               | НМ         | D         | 1HR         |         |
| 508      |               |             | 6' - 0" | 7' - 0"  |             | НМ            | НМ         | D         | 1HR         |         |
| 509      |               |             | 3' - 0" | 7' - 0"  | 0' - 1 3/4" | НМ            | НМ         | С         |             |         |
| 510      |               | STAIR 3     | 3' - 0" | 7' - 0"  | 0' - 1 3/4" | НМ            | НМ         | Е         | 2HR         |         |
| 877      |               | STAIR 1     | 3' - 0" | 7' - 0"  | 0' - 1 3/4" |               |            |           | 2HR         |         |
| 1507-37  |               |             | 3' - 5" | 7' - 0"  | 0' - 1 3/4" | НМ            | НМ         |           |             |         |
| 1507-49  |               |             | 4' - 6" | 8' - 0"  |             |               |            |           |             |         |
| 1507-50  |               |             | 4' - 6" | 8' - 0"  |             |               |            |           |             |         |
| 1507-99  |               |             | 3' - 5" | 7' - 0"  | 0' - 1 3/4" |               |            |           |             |         |
| 1507-101 |               |             | 3' - 5" | 7' - 0"  | 0' - 1 3/4" |               |            |           |             |         |
| 1507-110 |               |             | 5' - 3" | 8' - 3"  |             |               |            |           |             |         |
| 1507-118 |               |             | 4' - 9" | 0' - 0"  |             |               |            |           |             |         |
| 1507-141 |               |             | 4' - 9" | 0' - 0"  |             |               |            |           |             |         |
| 1507-142 |               |             | 4' - 9" | 0' - 0"  |             |               |            |           |             |         |
| 1507-154 |               | STAIR 1     | 3' - 0" | 7' - 0"  | 0' - 1 3/4" |               |            |           | 2HR         |         |



SINCE 1961

1031 CANAL STREET NEW ORLEANS, LOUISIANA

THESE PLANS AND SPECIFICATIONS HAVE
BEEN PREPARED BY ME OR UNDER MY
CLOSE PERSONAL SUPERVISION AND TO
THE BEST OF MY KNOWLEDGE AND
BELIEF THEY COMPLY WITH ALL CITY,
STATE AND FEDERAL REQUIREMENTS, AND
I AM NOT PROVIDING CONTRACT
ADMINISTRATION. CERTIFIED CORRECT



|  | OUD REVISION 1 4/27/2018     | 5/4/2018                     | 5/11/2018                    | .OUD REVISION 4 5/18/2018    | 5/25/2018                    | OUD REVISION 6 6/1/2018      | 6/8/2018                     |  |
|--|------------------------------|------------------------------|------------------------------|------------------------------|------------------------------|------------------------------|------------------------------|--|
|  | L.I.S. #2 - CLOUD REVISION 1 | L.I.S. #2 - CLOUD REVISION 2 | L.I.S. #2 - CLOUD REVISION 3 | L.I.S. #2 - CLOUD REVISION 4 | L.I.S. #2 - CLOUD REVISION 5 | L.I.S. #2 - CLOUD REVISION 6 | L.I.S. #2 - CLOUD REVISION 7 |  |


SCHEDULES

PROJECT#: 1709 PHASE: DD TEAM: Author CHECKER: Checker SCALE: AS NOTED

| 805-1          | HOTEL ROOM            | Room                  | 3' - 0"            | 7' - 0"            | 0' - 1 3/4" | WD           | WD         | ٧      | 20MIN          |   |
|----------------|-----------------------|-----------------------|--------------------|--------------------|-------------|--------------|------------|--------|----------------|---|
| 805-2          | HOTEL ROOM            | BATH                  | 3' - 0"            | 7' - 0"            |             | WD/GL        | MTL        | Р      |                |   |
| 805-3          |                       | HOTEL ROOM            | 3' - 0"            | 7' - 0"            |             | SCW          | MTL        | Υ      |                |   |
| 805-4          | HOTEL ROOM            | LIADD BOOK HOE        | 6' - 8"            | 7' - 0"            | 0' - 2"     | AL/GL        | AL         | Н      |                | EXTERIOR STOREFRONT                     |
| 806<br>806-1   | HOTEL ROOM            | HARD ROCK USE<br>Room | 3' - 0"            | 7' - 0"<br>7' - 0" | 0' - 2"     | HM<br>WD     | HM<br>WD   | C      | 20MIN          |   |
| 806-2          | BATH                  | HOTEL ROOM            | 3' - 0"            | 7' - 0"            | 0 1 0/ 1    | WD/GL        | MTL        | P      | LOWIN          |   |
| 806-3          | HOTEL ROOM            |                       | 3' - 0"            | 7' - 0"            |             | SCW          | MTL        | Υ      |                |   |
| 806-4          | HOTEL ROOM            |                       | 6' - 8"            | 7' - 0"            | 0' - 2"     | AL/GL        | AL         | Н      |                | EXTERIOR STOREFRONT                     |
| 807<br>807-1   | Room HOTEL ROOM       | IT<br>Poom            | 3' - 0"<br>3' - 0" | 7' - 0"<br>7' - 0" | 0' - 1 3/4" | WD/GL<br>WD  | HM<br>WD   | T<br>V | 45MIN<br>20MIN |   |
| 807-1          | HOTEL ROOM            | Room<br>BATH          | 3' - 0"            | 7' - 0"            | 0 - 1 3/4   | WD/GL        | MTL        | P      | ZUIVIIIN       |   |
| 807-3          |                       | HOTEL ROOM            | 3' - 0"            | 7' - 0"            |             | SCW          | MTL        | Υ      |                |   |
| 807-4          | HOTEL ROOM            |                       | 2' - 9 7/32"       | 6' - 11"           | 0' - 1 1/2" | AL/GL        | AL         | K      |                | EXTERIOR STOREFRONT                     |
| 808            | Room                  | STAIRWAY              | 3' - 0"            | 7' - 0"            | 0' - 1 3/4" | HM           | HM         | E      | 2HR            |   |
| 808-1<br>808-2 | Room HOTEL ROOM       | HOTEL ROOM            | 3' - 0"<br>6' - 8" | 7' - 0"<br>7' - 0" | 0' - 1 3/4" | WD<br>AL/GL  | WD<br>AL   | V      | 20MIN          | EXTERIOR STOREFRONT                     |
| 808-3          | BATH                  | HOTEL ROOM            | 6' - 0"            | 7' - 0"            | 0 - 2       | SCW          | MTL        | Q      |                | EXTENION STONEFROINT                    |
| 808-4          | 2,111                 | HOTEL ROOM            | 6' - 0"            | 7' - 0"            |             | SCW          | MTL        | Z      |                |   |
| 809            | Room                  |                       | 6' - 0"            | 7' - 0"            | 0' - 1 3/4" | AL/GL        | AL         | Α      |                | EXTERIOR STOREFRONT                     |
| 809-1          | Room                  | HOTEL ROOM            | 3' - 0"            | 7' - 0"            | 0' - 1 3/4" | WD           | WD         | ٧      | 20MIN          |   |
| 809-2<br>809-3 | BATH                  | HOTEL ROOM            | 3' - 0"<br>3' - 0" | 7' - 0"<br>7' - 0" |             | WD/GL<br>SCW | MTL<br>MTL | P<br>Y |                |   |
| 809-4          | HOTEL ROOM            | TIOTEL NOOM           | 5' - 0"            | 7' - 0"            | 0' - 2"     | AL/GL        | AL         | Н      |                | EXTERIOR STOREFRONT                     |
| 810            |                       |                       | 6' - 1 5/32"       | 7' - 9"            |             |              |            |        |                |   |
| 810-1          | Room                  | HOTEL ROOM            | 3' - 0"            | 7' - 0"            | 0' - 1 3/4" | WD           | WD         | ٧      | 20MIN          |   |
| 810-2          | HOTEL ROOM            | BATH                  | 3' - 0"            | 7' - 0"            |             | WD/GL        | MTL        | P      |                |   |
| 810-3<br>810-4 | HOTEL ROOM HOTEL ROOM |                       | 3' - 0"<br>6' - 8" | 7' - 0"<br>7' - 0" | 0' - 2"     | SCW<br>AL/GL | MTL<br>AL  | Y<br>H |                | EXTERIOR STOREFRONT                     |
| 811            | . IO I LL I IOOIVI    |                       | 6' - 0"            | 7' - 8 3/4"        | - Z         | AL/GL        | AL         | А      |                | LATERIOR OF ORLI RONT                   |
| 811-1          | Room                  | HOTEL ROOM            | 3' - 0"            | 7' - 0"            | 0' - 1 3/4" | WD           | WD         | ٧      | 20MIN          | EXTERIOR STOREFRONT                     |
| 811-2          | HOTEL ROOM            | Room                  | 3' - 0"            | 7' - 0"            |             | WD/GL        | MTL        | Р      |                |   |
| 811-3          | LIOTEL BOOM           | HOTEL ROOM            | 3' - 0"            | 7' - 0"            | 01 011      | SCW          | MTL        | Υ      |                | EVTERIOR OTOREFRONT                     |
| 811-4<br>812   | HOTEL ROOM            | Room                  | 6' - 8"<br>6' - 0" | 7' - 0"<br>7' - 0" | 0' - 2"     | AL/GL        | AL<br>AL   | H<br>A |                | EXTERIOR STOREFRONT EXTERIOR STOREFRONT |
| 812-1          | HOTEL ROOM            | Room                  | 3' - 0"            | 7' - 0"            |             |              | WD         | V      | 20MIN          | EXTERNOLOGICATION                       |
| 812-2          | BATH                  | HOTEL ROOM            | 3' - 0"            | 7' - 0"            |             | WD/GL        | MTL        | Р      |                |   |
| 812-3          |                       | HOTEL ROOM            | 6' - 8"            | 7' - 0"            | 0' - 2"     | AL/GL        | AL         | Н      |                | EXTERIOR STOREFRONT                     |
| 813            | D                     | Room                  | 6' - 0"            | 7' - 0"<br>7' - 0" |             | AL/GL        | AL         | Α      |                | EXTERIOR STOREFRONT                     |
| 813-1<br>813-2 | Room<br>Room          | HOTEL ROOM            | 3' - 0"<br>3' - 0" | 7' - 0"            | 0' - 1 3/4" | WD<br>WD/GL  | WD<br>MTL  | V      | 20MIN          |   |
| 813-3          | HOTEL ROOM            | HOTELHOOM             | 3' - 0"            | 7' - 0"            |             | SCW          | MTL        | Y      |                |   |
| 813-4          | HOTEL ROOM            |                       | 6' - 8"            | 7' - 0"            | 0' - 2"     | AL/GL        | AL         | Н      |                | EXTERIOR STOREFRONT                     |
| 814            | Room                  |                       | 3' - 0"            | 7' - 0"            | 0' - 1 3/4" | НМ           | НМ         | С      | 45MIN          |   |
| 814-1<br>814-2 | Room HOTEL ROOM       | HOTEL ROOM<br>BATH    | 3' - 0"<br>3' - 0" | 7' - 0"<br>7' - 0" | 0' - 1 3/4" | WD<br>WD/GL  | WD<br>MTL  | V<br>P | 20MIN          |   |
| 814-3          | HOTEL ROOM            | DAIN                  | 6' - 0"            | 7 - 0"             | 0' - 2"     | AL/GL        | AL         | Н      |                | EXTERIOR STOREFRONT                     |
| 815-1          | Room                  | HOTEL ROOM            | 3' - 0"            | 7' - 0"            | 0' - 1 3/4" | WD           | WD         | ٧      | 20MIN          |   |
| 815-2          | HOTEL ROOM            | Room                  | 3' - 0"            | 7' - 0"            |             | WD/GL        | MTL        | Р      |                |   |
| 815-3          |                       | HOTEL ROOM            | 3' - 0"            | 7' - 0"            |             | SCW          | MTL        | Υ      |                |   |
| 815-4<br>816-1 | HOTEL ROOM            | Room                  | 6' - 8"<br>3' - 0" | 7' - 0"<br>7' - 0" | 0' - 2"     | AL/GL<br>WD  | AL<br>WD   | H<br>V | 20MIN          | EXTERIOR STOREFRONT                     |
| 816-2          | BATH                  | HOTEL ROOM            | 3' - 0"            | 7' - 0"            | 0 - 1 3/4   | WD/GL        | MTL        | P      | ZUIVIIIN       |   |
| 816-3          |                       | HOTEL ROOM            | 3' - 0"            | 7' - 0"            |             | SCW          | MTL        | Υ      |                |   |
| 816-4          | HOTEL ROOM            |                       | 6' - 0"            | 7' - 0"            | 0' - 2"     | AL/GL        | AL         | Н      |                | EXTERIOR STOREFRONT                     |
| 817            | Deam                  | Room                  | 3' - 0"            | 7' - 0"            | 0' - 1 3/4" | AL/GL        | AL         | K      | OOMAINI        | EXTERIOR STOREFRONT                     |
| 817-1<br>817-2 | Room<br>Room          | HOTEL ROOM            | 3' - 0"<br>3' - 0" | 7' - 0"<br>7' - 0" | 0' - 1 3/4" | WD<br>WD/GL  | WD<br>MTL  | V<br>P | 20MIN          |   |
| 817-3          | HOTEL ROOM            | . IO I LE I IOOIVI    | 3' - 0"            | 7' - 0"            |             | SCW          | MTL        | Y      |                |   |
| 817-4          |                       | HOTEL ROOM            | 6' - 8"            | 7' - 0"            | 0' - 2"     | AL/GL        | AL         | Н      |                | EXTERIOR STOREFRONT                     |
| 818            |                       | WOMEN                 | 3' - 0"            | 7' - 0"            | 0' - 1 3/4" | НМ           | HM         | С      |                |   |
| 818-1<br>818-2 | Room<br>HOTEL ROOM    | HOTEL ROOM<br>BATH    | 3' - 0"<br>3' - 0" | 7' - 0"<br>7' - 0" | 0' - 1 3/4" | WD/GL        | WD<br>MTL  | V<br>P | 20MIN          |   |
| 818-3          | HOTEL ROOM            | DAIN                  | 3' - 0"            | 7 - 0"             |             | SCW          | MTL        | Y      |                |   |
| 818-4          | HOTEL ROOM            |                       | 6' - 0"            | 7' - 0"            | 0' - 2"     | AL/GL        | AL         | Н      |                | EXTERIOR STOREFRONT                     |
| 819            | MEN                   |                       | 3' - 0"            | 7' - 0"            | 0' - 1 3/4" | НМ           | НМ         | С      |                |   |
| 819-1          | Room                  | HOTEL ROOM            | 3' - 0"            | 7' - 0"            | 0' - 1 3/4" | WD           | WD         | ٧      | 20MIN          |   |
| 819-2<br>819-3 | Room                  | HOTEL ROOM            | 3' - 0"<br>3' - 0" | 7' - 0"<br>7' - 0" |             | SCW<br>WD/GL | MTL<br>MTL | Y      |                |   |
| 819-4          | 1 100111              | HOTEL ROOM            | 6' - 8"            | 7 - 0"             | 0' - 2"     | AL/GL        | AL         | Н      |                | EXTERIOR STOREFRONT                     |
| 820            |                       | STORAGE               | 3' - 0"            | 7' - 0"            | 0' - 1 3/4" |              | MTL        | С      | 1HR            | 511 511 511 5111                        |
| 820-1          | HOTEL ROOM            | Room                  | 3' - 0"            | 7' - 0"            | 0' - 1 3/4" |              | WD         | ٧      | 20MIN          |   |
| 820-2          | BATH                  | HOTEL ROOM            | 3' - 0"            | 7' - 0"            |             | WD/GL        | MTL        | Р      |                |   |
| 820-3          | HOTEL BOOM            | HOTEL ROOM            | 3' - 0"<br>6' - 0" | 7' - 0"<br>7' - 0" | 0' - 2"     | SCW          | MTL        | Υ      |                | EYTEDIOD STODEEDONT                     |
| 820-4<br>821   | HOTEL ROOM<br>STORAGE | Room                  | 3' - 0"            | 7' - 0"            | 0' - 2"     | AL/GL<br>HM  | AL<br>MTL  | H<br>F | 1HR            | EXTERIOR STOREFRONT                     |
| <u></u>        | J. J. W. W.L          | 1                     |                    | ı. <b>v</b>        | 10 . 0/4    | 1            | <b>-</b>   | 1.     |                |   |
|                |                       |                       |                    |                    |             |              |            |        |                |   |
| 826                                    | WAITING                                 | HALL<br>HOTEL BOOM       | 6' - 0"              | 7' - 0"                       | 0' - 1 3/4"                |                | HM         | X            | 00144  |                       |
|--|---|--------------------------|----------------------|-------------------------------|----------------------------|----------------|------------|--------------|--|-----------------------|
| 826-1<br>826-2                         | Room HOTEL ROOM                         | HOTEL ROOM<br>BATH       | 3' - 0"              | 7' - 0"<br>7' - 0"            | 0' - 1 3/4"                | WD/GL          | MTL<br>MTI | Р            | 20MIN  |                       |
| 826-3<br>826-4                         | HOTEL ROOM HOTEL ROOM                   | DEDDOC:                  | 3' - 0"<br>6' - 0"   | 7' - 0"                       | 0' - 2"                    | SCW<br>AL/GL   | MTL<br>AL  | Y<br>H       |  | EXTERIOR STOREFRONT   |
| 827<br>827-1                           | LIVIING<br>HOTEL ROOM                   | Room                     | 2' - 8"              | 8' - 0"<br>7' - 0"            | 0' - 1 3/4"                | WD<br>WD       | WD<br>WD   | V            | 20MIN  |                       |
| 827-2<br>827-3                         | BATH<br>HOTEL ROOM                      | HOTEL ROOM               | 3' - 0"<br>6' - 0"   | 7' - 0"<br>7' - 0"            | 0' - 2"                    | WD/GL<br>AL/GL | MTL<br>AL  | P<br>H       |  | EXTERIOR STOREFRONT   |
| 828<br>828-1                           | TOILET ROOM<br>Room                     | CLOSET<br>HOTEL ROOM     | 2' - 8"<br>3' - 0"   | 8' - 0"<br>7' - 0"            | 0' - 1 3/4"<br>0' - 1 3/4" | WD             | WD         | V            | 20MIN  |                       |
| 828-2<br>828-3                         | HOTEL ROOM HOTEL ROOM                   | BATH                     | 3' - 0"<br>6' - 8"   | 7' - 0"<br>7' - 0"            | 0' - 2"                    | WD/GL<br>AL/GL | MTL<br>AL  | P<br>H       | -  | EXTERIOR STOREFRONT   |
| 829                                    | MASTER<br>BEDROOM                       | CLOSET                   | 3' - 0"              | 8' - 0"                       | 0' - 1 3/4"                | 712/02         | 7.2        | <u> </u>     |  | ZATEMION OF ONE MONTH |
| 829-1<br>829-2                         | Room<br>HOTEL ROOM                      | HOTEL ROOM               | 3' - 0"<br>3' - 0"   | 7' - 0"<br>7' - 0"            | 0' - 1 3/4"                | WD<br>WD/GL    | WD<br>MTL  | V            | 20MIN  |                       |
| 829-3                                  | HOTEL ROOM                              |                          | 6' - 8"              | 7' - 0"<br>7' - 0"<br>8' - 0" | 0' - 2"                    | AL/GL          | AL         | Н            |  | EXTERIOR STOREFRONT   |
| 830                                    | MASTER<br>BEDROOM                       | Room                     | 3' - 0"              |                               | 0' - 1 3/4"                | WD             | WD         | 11           | OUR 41F.   |                       |
| 830-1<br>830-2                         |   | Room                     | 3' - 0"              | 7' - 0"                       | 0' - 1 3/4"                | SCW            | WD<br>HM   | L            | 20MIN  |                       |
| 830-3<br>830-4                         |   | Room                     | 3' - 0"<br>6' - 8"   | 7' - 0"<br>7' - 0"            | 0' - 2"                    | WD/GL<br>AL/GL | MTL<br>AL  | P<br>H       |  | EXTERIOR STOREFRONT   |
| 830-5<br>831                           | CLOSET                                  |                          | 6' - 8"<br>2' - 8"   | 7' - 0"<br>8' - 0"            | 0' - 2"<br>0' - 1 3/4"     | AL/GL<br>WD    | AL<br>WD   | H            |  | EXTERIOR STOREFRONT   |
| 831-1                                  | Room                                    | HOTEL ROOM               | 3' - 0"              | 7' - 0"                       | 0' - 1 3/4"                | WD             | WD         | Α            | 20MIN  |                       |
| 831-2<br>832                           | Room                                    | HOTEL ROOM CLOSET        | 3' - 0"              | 7' - 0"<br>8' - 0"            | 0' - 1 3/4"                | WD/GL          | MTL        | P            | VIII V   |                       |
| 832-1                                  | Room                                    | HOTEL ROOM               | 3' - 0"              | 7' - 0"                       | 0' - 1 3/4"                |                | WD         | V            | 20MIN  |                       |
| 832-2<br>832-3                         | Room<br>HOTEL ROOM                      | HOTEL ROOM               | 3' - 0"<br>6' - 8"   | 7' - 0"<br>7' - 0"            | 0' - 2"                    | WD/GL<br>AL/GL | MTL<br>AL  | P<br>H       |  | EXTERIOR STOREFRONT   |
| 833                                    | MASTER<br>BEDROOM                       |                          | 3' - 0"              | 7' - 0"                       |                            |                |            |              |  |                       |
| 833-1<br>833-2                         | Room<br>Room                            | HOTEL ROOM               | 3' - 0"<br>3' - 0"   | 7' - 0"<br>7' - 0"            | 0' - 1 3/4"                | WD<br>GL/WD    | WD<br>MTL  | V<br>P       | 20MIN  |                       |
| 833-3<br>833-4                         | HOTEL ROOM HOTEL ROOM                   |                          | 3' - 0"<br>6' - 8"   | 7' - 0"<br>7' - 0"            | 0' - 2"                    | SCW<br>AL/GL   | MTL        | Y<br>H       |  | EXTERIOR STOREFRONT   |
| 834                                    | LIVING                                  | LIOTE: 5.5.              | 3' - 0"              | 7' - 0"                       |                            |                |            |              | 00:  |                       |
| 834-1<br>834-2                         | Room<br>HOTEL ROOM                      | HOTEL ROOM<br>Room       | 3' - 0"              | 7' - 0"<br>7' - 0"            | 0' - 1 3/4"                | WD/GL          | WD<br>MTL  | V<br>P       | 20MIN  |                       |
| 834-3<br>834-4                         | HOTEL ROOM<br>HOTEL ROOM                |                          | 3' - 0"<br>6' - 8"   | 7' - 0"<br>7' - 0"            | 0' - 2"                    | SCW<br>AL/GL   | MTL<br>AL  | Н            |  | EXTERIOR STOREFRONT   |
| 835-1<br>835-2                         | Room<br>Room                            | ROOM<br>ROOM             | 3' - 0"              | 7' - 0"<br>7' - 0"            | 0' - 1 3/4"                | WD<br>WD/GL    | WD<br>MTL  | _            | 20MIN  | 2.2                   |
| 835-3                                  | ROOM                                    | I TOOIVI                 | 3' - 0"              | 7' - 0"                       | 01 0"                      | SCW            | MTL        | Υ            |  | EVTERIOR OF COLUMN    |
| 835-4<br>836                           | ROOM<br>MASTER                          |                          | 6' - 8"<br>3' - 0"   | 7' - 0"<br>7' - 0"            | 0' - 2"                    | AL/GL          | AL         | Н            |  | EXTERIOR STOREFRONT   |
| 836-1                                  | BEDROOM<br>Room                         | HOTEL ROOM               | 3' - 0"              | 7' - 0"                       | 0' - 1 3/4"                | WD             | WD         | V            | 20MIN  |                       |
| 836-2<br>836-3                         | HOTEL ROOM<br>HOTEL ROOM                | Room                     | 3' - 0"              | 7' - 0"<br>7' - 0"            |                            | WD/GL<br>SCW   | MTL<br>MTL | P<br>Y       |  |                       |
| 836-4<br>837                           | HOTEL ROOM LIVIING                      |                          | 6' - 8"<br>3' - 0"   | 7' - 0"<br>7' - 0"            | 0' - 2"                    | AL/GL          | AL         | Н            |  | EXTERIOR STOREFRONT   |
| 837-1                                  | Room                                    | HOTEL ROOM               | 3' - 0"              | 7' - 0"                       | 0' - 1 3/4"                |                | WD         |              | 20MIN  |                       |
| 837-2<br>837-3                         | Room<br>HOTEL ROOM                      | HOTEL ROOM               | 3' - 0"<br>3' - 0"   | 7' - 0"<br>7' - 0"            |                            | WD/GL<br>SCW   | MTL<br>MTL | P<br>Y       |  |                       |
| 837-4<br>838                           | HOTEL ROOM<br>MASTER                    |                          | 6' - 8"<br>3' - 0"   | 7' - 0"<br>7' - 0"            | 0' - 2"                    | AL/GL          | AL         | Н            |  | EXTERIOR STOREFRONT   |
| 838-1                                  | BEDROOM<br>Room                         | HOTEL ROOM               | 3' - 0"              | 7' - 0"                       | 0' - 1 3/4"                | WD             | WD         | V            | 20MIN  |                       |
| 838-2                                  | HOTEL ROOM                              | BATH                     | 3' - 0"              | 7' - 0"                       | 0 1 0/4                    | WD/GL          | MTL        | Р            | _OIVIIIN   |                       |
| 838-3<br>839-1                         | HOTEL ROOM<br>Room                      | HOTEL ROOM               | 3' - 0"              | 7' - 0"<br>7' - 0"            | 0' - 1 3/4"                |                | MTL<br>WD  | Y<br>V       | 20MIN  |                       |
| 839-2<br>839-3                         | BATH                                    | HOTEL ROOM<br>HOTEL ROOM | 4' - 0"<br>3' - 0"   | 7' - 0"<br>7' - 0"            | 0' - 1 1/2"                | WD<br>WD/GL    | WD<br>MTL  | L<br>P       |  |                       |
| 839-4<br>839-5                         | HOTEL ROOM                              |                          | 2' - 10"<br>2' - 10" | 7' - 0"<br>7' - 0"            | 0' - 1 3/8"                | AL/GL          | AL         | Н            |  | EXTERIOR STOREFRONT   |
| 839-5<br>840                           | MASTER                                  | HOTEL ROOM               | 2' - 10"             | 7' - 0"                       | υ - I 3/8"                 |                |            | +            |  |                       |
| 840-1                                  | BEDROOM<br>HOTEL ROOM                   | Room                     | 3' - 0"              | 7' - 0"                       | 0' - 1 3/4"                |                | WD         |              | 20MIN  |                       |
| 840-2<br>840-3                         | HOTEL ROOM<br>HOTEL ROOM                | HOTEL ROOM               | 2' - 10"<br>3' - 0"  | 7' - 0"<br>7' - 0"            | 0' - 1 3/8"                | AL/GL<br>WD/GL | AL<br>MTL  | H<br>P       |  | EXTERIOR STOREFRONT   |
| 840-4<br>841                           |   | HOTEL ROOM MASTER        | 3' - 0"              | 7' - 0"<br>7' - 0"            |                            | WD             | WD         | L            |  |                       |
| 841-1                                  | Room                                    | BEDROOM<br>HOTEL ROOM    | 3' - 0"              | 7' - 0"                       | 0' - 1 3/4"                | WD             | WD         | V            | 20MIN  |                       |
| 841-2                                  | HOTEL ROOM                              |                          | 2' - 10"             | 7' - 0"                       | 0' - 1 3/4                 | AL/GL          | AL         | Н            | _OIVIIIN   | EXTERIOR STOREFRONT   |
| 841-3<br>842-1                         | HOTEL ROOM<br>Room                      | HOTEL ROOM               | 3' - 0"              | 7' - 0"                       | 0' - 1 3/4"                | WD/GL<br>WD    | MTL<br>WD  |              | 20MIN  |                       |
| 842-3<br>842-5                         | Room<br>HOTEL ROOM                      | HOTEL ROOM               | 3' - 0"<br>2' - 10"  | 7' - 0"<br>7' - 0"            | 0' - 1 3/8"                | WD/GL<br>AL/GL | MTL<br>AL  | P<br>H       |  | EXTERIOR STOREFRONT   |
| 843<br>843-1                           | Room                                    | DINING<br>HOTEL ROOM     | 3' - 0"              | 7' - 0"<br>7' - 0"            |                            | WD             | WD         |              | 20MIN  |                       |
| 843-2                                  | HOTEL ROOM                              | Room                     | 3' - 0"              | 7' - 0"                       |                            | WD/GL          | MTL        | Р            | _OIVIIIN   |                       |
| 843-3<br>843-4                         | HOTEL ROOM                              | HOTEL ROOM               | 2' - 10"             | 7' - 0"                       | 0' - 1 3/8"                | AL/GL<br>WD    | AL<br>WD   | K<br>L       |  | EXTERIOR STOREFRONT   |
| 844<br>844-1                           | LIVING<br>HOTEL ROOM                    | Room                     | 3' - 0"<br>3' - 0"   | 7' - 0"<br>7' - 0"            | 0' - 1 3/4"                | WD             | WD         | V            | 20MIN  |                       |
| 844-2<br>844-3                         |   | HOTEL ROOM HOTEL ROOM    | 3' - 0"              | 7' - 0"<br>7' - 0"            |                            | WD/GL<br>WD    | MTL<br>WD  | P            |  |                       |
| 844-4                                  | HOTEL ROOM                              |                          | 2' - 10"             | 7' - 0"                       | 0' - 1 3/8"                | AL/GL          | AL         | K            |  | EXTERIOR STOREFRONT   |
| 845<br>845-1                           | LIVING<br>Room                          | HOTEL ROOM               | 3' - 0"              | 7' - 0"                       | 0' - 1 3/4"                |                | WD         | _            | 20MIN  |                       |
| 845-2<br>845-3                         | Room<br>HOTEL ROOM                      | HOTEL ROOM               | 3' - 0"<br>2' - 10"  | 7' - 0"<br>7' - 0"            | 0' - 1 3/8"                | WD/GL<br>AL/GL | MTL<br>AL  | P<br>H       |  | EXTERIOR STOREFRONT   |
| 846                                    | MASTER<br>BEDROOM                       |                          | 3' - 0"              | 7' - 0"                       |                            |                |            |              |  |                       |
| 846-1<br>846-2                         | Room<br>HOTEL ROOM                      | HOTEL ROOM<br>Room       | 3' - 0"<br>3' - 0"   | 7' - 0"<br>7' - 0"            | 0' - 1 3/4"                | WD<br>WD/GL    | WD<br>MTL  | V            | 20MIN  |                       |
| 846-4                                  | HOTEL ROOM                              |                          | 2' - 10"             | 7' - 0"                       | 0' - 1 3/8"                | AL/GL          | AL         | Н            |  | EXTERIOR STOREFRONT   |
| 847<br>848                             | OFFICE<br>LIVING                        |                          | 3' - 0"              | 7' - 0"                       |                            |                |            | <del> </del> |  |                       |
| 849<br>850                             | LIVING<br>MASTER                        |                          | 3' - 0"<br>3' - 0"   | 7' - 0"<br>7' - 0"            |                            |                |            | +            |  |                       |
| 851                                    | BEDROOM                                 |                          | 3' - 0"              | 7' - 0"                       |                            |                |            | +            |  |                       |
| 852                                    | MASTER<br>BEDROOM                       |                          | 3' - 0"              | 7' - 0"                       |                            |                |            |              |  |                       |
| 853<br>854                             | LIVING<br>LIVING                        | BALCONY                  | 3' - 0"              | 7' - 0"                       |                            |                |            | #            |  |                       |
| 854<br>855                             | MASTER                                  | BALCONY<br>BALCONY       | 3' - 0"              | 7' - 0"<br>7' - 0"            |                            |                |            | +            |  |                       |
| 856                                    | BEDROOM                                 | MASTER                   | 3' - 0"              | 7' - 0"                       |                            |                |            | +            |  |                       |
| 857                                    |   | BEDROOM<br>DINING        | 3' - 0"              | 7' - 0"                       |                            |                |            | <u></u>      |  |                       |
| 858                                    | MASTER<br>BEDROOM                       |                          | 3' - 0"              | 7' - 0"                       |                            |                |            |              |  |                       |
| 359<br>360                             | OFFICE<br>DINING                        |                          | 3' - 0"<br>3' - 0"   | 7' - 0"<br>7' - 0"            |                            |                |            | +            |  |                       |
| 861                                    | DINING                                  |                          | 3' - 0"              | 7' - 0"                       | 01 4 5                     |                |            | #            |  |                       |
| 862<br>862                             | KITCHEN<br>MASTER                       |                          | 3' - 0"              | 8' - 0"<br>7' - 0"            | 0' - 1 3/4"                |                |            | +            |  |                       |
| 863                                    | BEDROOM                                 | LIVING                   | 2' - 0"              | 8' - 0"                       | 0' - 1 3/4"                |                |            | _            |  |                       |
|  | DINING<br>LIVING                        |                          | 3' - 0"              | 7' - 0"<br>7' - 0"            |                            |                |            | #            |  |                       |
|  | MASTER                                  |                          | 3' - 0"              | 7' - 0"                       |                            |                |            | +            |  |                       |
| 865                                    | BEDROOM                                 | 1                        |                      | 8' - 0"                       | 0' - 1 3/4"                |                |            | +            |  |                       |
| 865<br>866<br>867                      | BEDROOM<br>Room                         | ELEC                     | 3' - 0"              |                               |                            |                |            | +-           | <del>                                     </del> |                       |
| 865<br>866<br>867<br>869               | Room<br>HAIR SALON AND<br>SPA RECEPTION | GYM                      | 3' - 0"              | 7' - 0"                       | 0' - 1 3/4"                |                |            | <u> </u>     |  |                       |
| 864<br>865<br>866<br>867<br>869<br>873 | Room<br>HAIR SALON AND                  |                          |                      |                               |                            |                |            |              | -<br>2HR   |                       |

103-NEW O

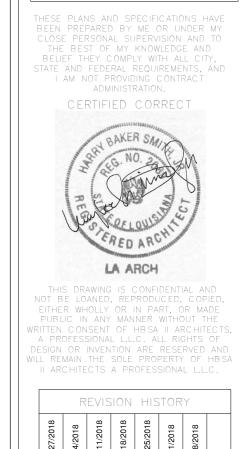

| - | 1 L.I.S. #2 - CLOUD REVISION 1 | 4/27/ |
|---|--------------------------------|-------|
| 0 | 2 L.I.S. #2 - CLOUD REVISION 2 | 5/4/2 |
| က | 3 L.I.S. #2 - CLOUD REVISION 3 | 5/11/ |
| 4 | 4 L.I.S. #2 - CLOUD REVISION 4 | 5/18/ |
| 2 | 5 L.I.S. #2 - CLOUD REVISION 5 | 5/25/ |
| 9 | 6 L.I.S. #2 - CLOUD REVISION 6 | 6/1/2 |
| 7 | 7 L.I.S. #2 - CLOUD REVISION 7 | 6/8/2 |
| ω | 8                              |       |

# SCHEDULES

PROJECT#: 1709
PHASE: DD
TEAM: Author
CHECKER: Checker
SCALE: AS NOTED
ISSUED: 4/20/2018
SHEET#:

A6.3

| 900-1            |                          | HOTEL ROOM         |                         | 7' - 0"             | 0' - 1 3/4"            | SCW            | НМ         | ٧      | 20MIN      |   |
|------------------|--------------------------|--------------------|-------------------------|---------------------|------------------------|----------------|------------|--------|------------|---|
| 900-2<br>900-3   | HOTEL ROOM               | HOTEL ROOM         | 3' - 0"<br>4' - 0"      | 7' - 0"<br>7' - 0"  | 0' - 1 1/2"            | WD/GL<br>WD    | MTL<br>WD  | P<br>L |            |   |
| 900-4<br>901-1   | HOTEL ROOM<br>HOTEL ROOM |                    | 2' - 10"<br>3' - 0"     | 7' - 0"<br>7' - 0"  | 0' - 1 3/8"            | AL/GL<br>SCW   | AL<br>HM   | H<br>V | 20MIN      | EXTERIOR STOREFRONT   |
| 901-2            | HOTEL ROOM               |                    | 2' - 10"                | 7' - 0"             | 0' - 1 3/8"            | AL/GL          | AL         | Н      | ZOWIIN     | EXTERIOR STOREFRONT   |
| 901-3<br>901-4   | HOTEL ROOM               | BATH               | 3' - 0"<br>2' - 10"     | 7' - 0"<br>7' - 0"  | 0' - 1 3/8"            | WD/GL<br>AL/GL | MTL<br>AL  | P<br>H |            | EXTERIOR STOREFRONT   |
| 901-5<br>902-1   |                          | HOTEL ROOM         | 4' - 0"<br>3' - 0"      | 7' - 0"<br>7' - 0"  | 0' - 1 1/2"            | WD<br>SCW      | WD<br>HM   | L<br>V | 20MIN      |   |
| 902-2            | HOTEL ROOM               | HOTEL ROOM         | 3' - 0"                 | 7' - 0"             | 0 1 0/ 1               | WD/GL          | MTL        | Р      | 20111111   |   |
| 902-3<br>902-4   | HOTEL ROOM               | HOTEL ROOM         | 3' - 0"<br>2' - 9 7/32" | 7' - 0"<br>6' - 11" | 0' - 1 1/2"            | SCW<br>AL/GL   | MTL<br>AL  | Y<br>K |            | EXTERIOR STOREFRONT   |
| 903-1<br>903-2   | HOTEL ROOM               |                    | 3' - 0"<br>3' - 0"      | 7' - 0"<br>7' - 0"  | 0' - 1 3/4"            | SCW<br>WD/GL   | HM<br>MTL  | V<br>P | 20MIN      |   |
| 903-3            |                          | HOTEL ROOM         | 3' - 0"                 | 7' - 0"             |                        | SCW            | MTL        | Υ      |            |   |
| 903-4<br>904-1   | HOTEL ROOM               | HOTEL ROOM         | 6' - 8"<br>3' - 0"      | 7' - 0"<br>7' - 0"  | 0' - 2"                | AL/GL<br>SCW   | AL<br>HM   | H<br>V | 20MIN      | EXTERIOR STOREFRONT   |
| 904-2<br>904-3   | HOTEL ROOM               | HOTEL ROOM         | 3' - 0"<br>3' - 0"      | 7' - 0"<br>7' - 0"  |                        | WD/GL<br>SCW   | MTL<br>MTL | P<br>Y |            |   |
| 904-4            | HOTEL ROOM               |                    | 6' - 8"                 | 7' - 0"             | 0' - 2"                | AL/GL          | AL         | Н      |            | EXTERIOR STOREFRONT   |
| 905-1<br>905-2   | HOTEL ROOM               |                    | 3' - 0"<br>3' - 0"      | 7' - 0"<br>7' - 0"  | 0' - 1 3/4"            | SCW<br>WD/GL   | HM<br>MTL  | V<br>P | 20MIN      |   |
| 905-3<br>905-4   | HOTEL ROOM               | HOTEL ROOM         | 3' - 0"<br>6' - 8"      | 7' - 0"<br>7' - 0"  | 0' - 2"                | SCW<br>AL/GL   | MTL<br>AL  | Y<br>H |            | EXTERIOR STOREFRONT   |
| 906-1            | 1101221100111            | HOTEL ROOM         | 3' - 0"                 | 7' - 0"             | 0' - 1 3/4"            | SCW            | НМ         | ٧      | 20MIN      | ZXI Z I I O I C I C I C I I C |
| 906-2<br>906-3   | HOTEL ROOM               | HOTEL ROOM         | 3' - 0"<br>3' - 0"      | 7' - 0"<br>7' - 0"  |                        | WD/GL<br>SCW   | MTL<br>MTL | P<br>Y |            |   |
| 906-4<br>907-1   | HOTEL ROOM               |                    | 6' - 8"<br>3' - 0"      | 7' - 0"<br>7' - 0"  | 0' - 2"                | AL/GL<br>SCW   | AL<br>HM   | H<br>V | 20MIN      | EXTERIOR STOREFRONT   |
| 907-2            |                          | Room               | 3' - 0"                 | 7' - 0"             |                        | WD/GL          | MTL        | P      |            |   |
| 907-3<br>907-4   | HOTEL ROOM               | HOTEL ROOM         | 3' - 0"<br>2' - 9 7/32" |                     |                        |                | MTL<br>AL  | Y<br>K |            | EXTERIOR STOREFRONT   |
| 908-1<br>908-2   | HOTEL ROOM               | HOTEL ROOM         | 3' - 0"<br>6' - 8"      | 7' - 0"<br>7' - 0"  | 0' - 1 3/4"<br>0' - 2" | SCW<br>AL/GL   | HM<br>AL   | V<br>H | 20MIN      | EXTERIOR STOREFRONT   |
| 908-3            | 2 100ivi                 | HOTEL ROOM         | 6' - 0"                 | 7' - 0"             |                        | SCW            | MTL        | Z      |            |   |
| 908-4<br>908-6   |                          | HOTEL ROOM         | 6' - 0"<br>3' - 0"      | 7' - 0"<br>7' - 0"  | 0' - 1 3/4"            | GL/WD          | MTL        | Q      |            |   |
| 908-7<br>908-9   | RETAIL                   | REST.              | 3' - 0"<br>3' - 0"      | 7' - 0"<br>7' - 0"  | 0' - 1 3/4"            | НМ             | НМ         | F      |            |   |
| 908-10           | RETAIL                   |                    | 2' - 8"                 | 7' - 0"             | 0' - 2"                | НМ             | НМ         | F      | 1HR        |   |
| 908-11<br>908-12 |                          | TOILET<br>SUPPLIES | 3' - 0"<br>3' - 0"      | 7' - 0"<br>7' - 0"  | 0' - 1 3/4"            | HM<br>HM       | HM<br>HM   | C<br>C | 1HR<br>1HR |   |
| 908-13           |                          | HOUSE<br>KEEPING / | 3' - 0"                 | 7' - 0"             | 0' - 1 3/4"            | НМ             | НМ         | С      | 1HR        |   |
| 908-14           |                          | MGMT.<br>LINENS    | 6' - 0"                 | 7' - 0"             | 0' - 2"                | НМ             | НМ         | С      |            |   |
| 908-15           |                          | ELEV. 9            | 3' - 0"                 | 7' - 0"             | 0' - 1 3/4"            | НМ             | HM         | С      | 1HR        |   |
|                  |                          | CONTROL<br>ROOM    |                         |                     |                        |                |            |        |            |   |
| 908-16<br>908-17 | GENERATOR<br>GENERATOR   | TUNNEL             | 4' - 0"<br>4' - 0"      | 10' - 0"<br>3' - 5" | 0' - 1 3/4"            | M              | M          | В      | -          |   |
| 908-18<br>908-25 | GENERATOR<br>ELEC.       | TUNNEL             | 4' - 0"<br>3' - 0"      | 10' - 0"<br>7' - 0" |                        | M<br>SCW       | M<br>HM    | B<br>V |            |   |
| 908-26           | LLLO.                    | LIVING             | 2' - 10"                | 7' - 0"             | 0' - 1 3/8"            |                |            |        |            |   |
| 909-1<br>909-2   |                          | HOTEL ROOM         | 3' - 0"<br>3' - 0"      | 7' - 0"<br>7' - 0"  | 0' - 1 3/4"            | SCW<br>WD/GL   | HM<br>MTL  | V<br>P | 20MIN      |   |
| 909-4<br>910-1   | HOTEL ROOM               |                    | 5' - 0"<br>3' - 0"      | 7' - 0"<br>7' - 0"  | 0' - 2"<br>0' - 1 3/4" | AL/GL<br>SCW   | AL<br>HM   | H<br>V | 20MIN      | EXTERIOR STOREFRONT   |
| 910-2            | HOTEL ROOM               |                    | 3' - 0"                 | 7' - 0"             | 0 10/4                 | GL/WD          | MTL        | P      | ZOWIII     |   |
| 910-3<br>910-4   | HOTEL ROOM               |                    | 3' - 0"<br>6' - 8"      | 7' - 0"<br>7' - 0"  | 0' - 2"                | SCW<br>AL/GL   | MTL<br>AL  | Y<br>H |            | EXTERIOR STOREFRONT   |
| 911-1<br>911-2   | HOTEL ROOM               | HOTEL ROOM         | 3' - 0"<br>3' - 0"      | 7' - 0"<br>7' - 0"  | 0' - 1 3/4"            | SCW<br>WD/GL   | HM<br>MTL  | V<br>P | 20MIN      |   |
| 911-3            |                          | HOTEL ROOM         | 3' - 0"                 | 7' - 0"             | 01 011                 | SCW            | MTL        | Υ      |            | EVIEDIOD OTODEFDONIE  |
| 911-4<br>912-1   | HOTEL ROOM               | HOTEL ROOM         | 6' - 0"<br>3' - 0"      | 7' - 0"<br>7' - 0"  | 0' - 2"                | AL/GL<br>SCW   | AL<br>HM   | H<br>V | 20MIN      | EXTERIOR STOREFRONT   |
| 912-2<br>912-3   |                          | HOTEL ROOM         |                         | 7' - 0"<br>7' - 0"  | 0' - 2"                | GL/WD<br>AL/GL | MTL<br>AL  | P<br>H |            | EXTERIOR STOREFRONT   |
| 913-1            | HOTEL ROOM               |                    | 3' - 0"                 | 7' - 0"             | 0' - 1 3/4"            | SCW            | НМ         | ٧      | 20MIN      |   |
| 913-2<br>913-3   | HOTEL ROOM               | HOTEL ROOM         | 3' - 0"<br>3' - 0"      | 7' - 0"<br>7' - 0"  |                        | WD/GL<br>SCW   | MTL<br>MTL | P<br>Y |            |   |
| 913-4<br>914-1   | HOTEL ROOM               |                    | 6' - 0"<br>3' - 0"      | 7' - 0"<br>7' - 0"  | 0' - 2"                | AL/GL<br>SCW   | AL<br>HM   | H<br>V | 20MIN      | EXTERIOR STOREFRONT   |
| 914-2<br>914-3   | HOTEL ROOM HOTEL ROOM    |                    | 3' - 0"<br>6' - 0"      | 7' - 0"<br>7' - 0"  | 0' - 2"                | GL/WD<br>AL/GL | MTL        | P<br>H |            | EXTERIOR STOREFRONT   |
| 914-3            | HOTEL ROOM               | HOTEL ROOM         | 3' - 0"                 | 7' - 0"             | 0' - 2"                | SCW            | HM         | V      | 20MIN      | EXTERIOR STOREFRONT   |
| 915-2<br>915-3   | HOTEL ROOM               | HOTEL ROOM         | 3' - 0"<br>3' - 0"      | 7' - 0"<br>7' - 0"  |                        | WD/GL<br>SCW   | MTL<br>MTL | P<br>Y |            |   |
| 915-4<br>916-1   | HOTEL ROOM               |                    | 6' - 0"<br>3' - 0"      | 7' - 0"<br>7' - 0"  | 0' - 2"<br>0' - 1 3/4" | AL/GL<br>SCW   | AL<br>HM   | H      | 20MIN      | EXTERIOR STOREFRONT   |
| 916-2            |                          | HOTEL ROOM         | 3' - 0"                 | 7' - 0"             | 0 - 1 3/4              | GL/WD          | MTL        | Р      | LOIVIIIN   |   |
| 916-3<br>916-4   | HOTEL ROOM               | HOTEL ROOM         | 3' - 0"<br>6' - 0"      | 7' - 0"<br>7' - 0"  | 0' - 2"                | SCW<br>AL/GL   | MTL<br>AL  | Y<br>H |            | EXTERIOR STOREFRONT   |
| 917-1<br>917-2   | HOTEL ROOM               | HOTEL ROOM         | 3' - 0"<br>3' - 0"      | 7' - 0"<br>7' - 0"  | 0' - 1 3/4"            | SCW<br>WD/GL   | HM<br>MTL  | v<br>P | 20MIN      |   |
| 917-3            | HOTEL ROOM               | LIOTEL NOOW        | 3' - 0"                 | 7' - 0"             |                        | SCW            | MTL        | Υ      |            |   |
| 917-4<br>918-1   | HOTEL ROOM               |                    | 6' - 0"<br>3' - 0"      | 7' - 0"<br>7' - 0"  | 0' - 2"                | AL/GL<br>SCW   | AL<br>HM   | H<br>V | 20MIN      | EXTERIOR STOREFRONT   |
| 918-2<br>918-3   | HOTEL ROOM<br>HOTEL ROOM |                    | 3' - 0"<br>3' - 0"      | 7' - 0"<br>7' - 0"  |                        | GL/WD<br>SCW   | MTL<br>MTL | P<br>Y |            |   |
| 918-4            | HOTEL ROOM               |                    | 6' - 0"                 | 7' - 0"             | 0' - 2"                | AL/GL          | AL         | Н      | 0.51.5     | EXTERIOR STOREFRONT   |
| 919-1<br>919-2   |                          | HOTEL ROOM         | 3' - 0"<br>3' - 0"      | 7' - 0"<br>7' - 0"  | 0' - 1 3/4"            | SCW<br>SCW     | HM<br>MTL  | V<br>Y | 20MIN      |   |
| 919-3<br>919-4   | HOTEL ROOM               | HOTEL ROOM         | 3' - 0"<br>6' - 8"      | 7' - 0"<br>7' - 0"  | 0' - 2"                | GL/WD<br>AL/GL | MTL<br>AL  | P<br>H |            | EXTERIOR STOREFRONT   |
| 920-1            |                          | HOTEL ROOM         | 3' - 0"                 | 7' - 0"             | 0' - 1 3/4"            | SCW            | НМ         | ٧      | 20MIN      | LATERIOR GRONEFAUNT   |
| 920-2<br>920-3   |                          | HOTEL ROOM         | 3' - 0"<br>3' - 0"      | 7' - 0"<br>7' - 0"  |                        | GL/WD<br>SCW   | MTL<br>MTL | P<br>Y |            |   |
| 920-4<br>921-1   | HOTEL ROOM<br>HOTEL ROOM |                    | 6' - 0"<br>3' - 0"      | 7' - 0"<br>7' - 0"  | 0' - 2"                | AL/GL<br>SCW   | AL<br>HM   | H      | 20MIN      | EXTERIOR STOREFRONT   |
| 921-2            | HOTEL ROOM               |                    | 3' - 0"                 | 7' - 0"             | 0 - 1 3/4              | GL/WD          | MTL        | P      | LUIVIIIN   |   |
| 921-3<br>921-4   | HOTEL ROOM               | HOTEL ROOM         | 3' - 0"<br>6' - 0"      | 7' - 0"<br>7' - 0"  | 0' - 2"                | SCW<br>AL/GL   | MTL<br>AL  | Y<br>H |            | EXTERIOR STOREFRONT   |
| 922-1            | 2                        | HOTEL ROOM         | 3' - 0"<br>3' - 0"      | 7' - 0"<br>7' - 0"  | 0' - 1 3/4"            | SCW            | НМ         | ٧      | 20MIN      |   |
|                  | HOTEL ROOM               | HOTEL ROOM         | 3' - 0"                 | 7' - 0"             |                        | GL/WD<br>SCW   | MTL<br>MTL | P<br>Y |            |   |
| 922-4            | HOTEL ROOM               |                    | 6' - 0"<br>3' - 0"      | 7' - 0"<br>7' - 0"  | 0' - 2"<br>0' - 1 3/4" | AL/GL<br>SCW   | AL<br>HM   | H<br>V | 20MIN      | EXTERIOR STOREFRONT   |
| 923-1            | TIOTEL ROOM              |                    |                         |                     |                        |                |            |        | ļ          | 1   |
| 923-1            | HOTEL ROOM               |                    | 3' - 0"                 | 7' - 0"             |                        | GL/WD          | MTL        | Р      |            |   |

| 923-3<br>923-4          | HOTEL ROOM               |                          | 3' - 0"<br>6' - 0"              | 7' - 0"<br>7' - 0"                       | 0' - 2"                                  | SCW<br>AL/GL          | MTL<br>AL        | Y           |            | EXTERIOR STOREFRONT |
|-------------------------|--------------------------|--------------------------|---------------------------------|--|--|-----------------------|------------------|-------------|------------|---------------------|
| 924-1<br>924-2          |                          | HOTEL ROOM               |                                 | 7' - 0"<br>7' - 0"                       | 0' - 1 3/4"                              | SCW<br>GL/WD          | HM<br>MTL        | V<br>P      | 20MIN      |                     |
| 924-3<br>924-4          | HOTEL ROOM               |                          | 3' - 0"<br>6' - 0"              | 7' - 0"<br>7' - 0"                       | 0' - 2"                                  | SCW<br>AL/GL          | MTL<br>AL        | Y<br>H      |            | EXTERIOR STOREFRONT |
| 925-1<br>925-2<br>925-3 | HOTEL ROOM               | HOTEL ROOM               | 3' - 0"<br>M 2' - 8"<br>6' - 0" | 7' - 0"<br>7' - 0"<br>7' - 0"            | 0' - 1 3/4"                              | SCW<br>SCW<br>AL/GL   | HM<br>MTL<br>AL  | V<br>Y      | 20MIN      | EXTERIOR STOREFRONT |
| 925-4<br>926-1          | HOTEL ROOM               | HOTEL ROOF               |                                 | 7' - 0"<br>7' - 0"                       | 0' - 1 3/4"                              | GL/WD<br>SCW          | MTL              | P           | 20MIN      | EXTERIOR STORE HON  |
| 926-2<br>926-3          | HOTEL ROOM HOTEL ROOM    |                          | 3' - 0"<br>3' - 0"              | 7' - 0"<br>7' - 0"                       |  | GL/WD<br>SCW          | MTL              | P<br>Y      | 2011111    |                     |
| 926-4<br>927-1          | HOTEL ROOM<br>HOTEL ROOM |                          | 6' - 0"<br>3' - 0"              | 7' - 0"<br>7' - 0"                       | 0' - 2"                                  | AL/GL<br>SCW          | AL<br>HM         | H           | 20MIN      | EXTERIOR STOREFRONT |
| 927-2<br>927-3          | HOTEL ROOM               |                          | 3' - 0"<br>3' - 0"              | 7' - 0"<br>7' - 0"                       |  | WD/GL<br>SCW          | MTL<br>MTL       | P<br>Y      |            |                     |
| 927-4<br>928-1          | HOTEL ROOM               | HOTEL ROOM               | 6' - 0"<br>M 3' - 0"            | 7' - 0"<br>7' - 0"                       | 0' - 2"<br>0' - 1 3/4"                   | AL/GL<br>SCW          | AL<br>HM         | H<br>V      | 20MIN      | EXTERIOR STOREFRONT |
| 928-2<br>928-3          | HOTEL ROOM               | HOTEL ROOF               | M 3' - 0"<br>3' - 0"            | 7' - 0"<br>7' - 0"                       |  | GL/WD<br>SCW          | MTL<br>MTL       | P<br>Y      |            |                     |
| 928-4<br>929-1          | HOTEL ROOM               | HOTEL ROOM               | 6' - 0"<br>M 3' - 0"            | 7' - 0"<br>7' - 0"                       | 0' - 2"<br>0' - 1 3/4"                   | AL/GL<br>SCW          | AL<br>HM         | H<br>V      | 20MIN      | EXTERIOR STOREFRONT |
| 929-2<br>929-3          | HOTEL ROOM               | HOTEL ROOM               | M 3' - 0"<br>3' - 0"            | 7' - 0"<br>7' - 0"                       |  | WD/GL<br>SCW          | MTL<br>MTL       | P<br>Y      |            |                     |
| 929-4<br>930-1          | HOTEL ROOM<br>HOTEL ROOM |                          | 6' - 0"<br>3' - 0"              | 7' - 0"<br>7' - 0"                       | 0' - 2"                                  | AL/GL<br>SCW          | AL<br>HM         | H<br>V      | 20MIN      | EXTERIOR STOREFRONT |
| 930-2<br>930-3          | HOTEL ROOM HOTEL ROOM    |                          | 3' - 0"<br>3' - 0"              | 7' - 0"<br>7' - 0"                       |  | GL/WD<br>SCW          | MTL<br>MTL       | P<br>Y      |            |                     |
| 930-4<br>931-1          | HOTEL ROOM<br>HOTEL ROOM |                          | 6' - 0"<br>3' - 0"              | 7' - 0"<br>7' - 0"                       | 0' - 2"                                  | AL/GL<br>SCW          | AL<br>HM         | H<br>V      | 20MIN      | EXTERIOR STOREFRON  |
| 931-2<br>931-3          | HOTEL ROOM               |                          | 3' - 0"<br>6' - 0"              | 7' - 0"                                  | 0' - 2"                                  | WD/GL<br>AL/GL        | MTL<br>AL        | P<br>H      |            | EXTERIOR STOREFRON  |
| 932-1<br>932-2          | HOTEL ROOM               | HOTEL ROOM               | M 3' - 0"                       | 7' - 0"                                  | 0' - 1 3/4"                              | SCW<br>WD/GL          | HM<br>MTL        | V<br>P      | 20MIN      |                     |
| 932-3<br>933-1          | HOTEL ROOM               |                          | 6' - 0"<br>3' - 0"              | 7' - 0"                                  | 0' - 2"                                  | AL/GL<br>SCW          | AL<br>HM         | V           | 20MIN      | EXTERIOR STOREFRONT |
| 933-2<br>933-3          | HOTEL ROOM               | HOTEL POO                | 6' - 8"                         | 7' - 0"<br>7' - 0"                       | 0' - 2"                                  | WD/GL<br>AL/GL        | AL<br>HM         | P<br>H      | OUP 415 :  | EXTERIOR STOREFRONT |
| 934-1<br>934-2          | HOTEL ROOM               | HOTEL ROOM               | M 3' - 0"                       | 7' - 0"<br>7' - 0"                       | 0' - 1 3/4"                              | SCW<br>WD/GL          | MTL              | V<br>P      | 20MIN      | EYTEDIOD OTODEEDO:  |
| 934-3<br>935-1          | HOTEL ROOM               | HOTEL ROOM               |                                 | 7' - 0"<br>7' - 0"<br>7' - 0"            | 0' - 2"                                  | AL/GL<br>SCW          | AL<br>HM         | H<br>V<br>Y | 20MIN      | EXTERIOR STOREFRON  |
| 935-2<br>935-3<br>935-4 | HOTEL ROOM               | HOTEL ROOM               | M 3' - 0"<br>3' - 0"<br>6' - 8" | 7' - 0"<br>7' - 0"<br>7' - 0"            | 0' - 2"                                  | SCW<br>GL/WD<br>AL/GL | MTL<br>MTL<br>AL | P<br>H      |            | EXTERIOR STOREFRONT |
| 935-4<br>935-5<br>936-1 | HOTEL ROOM               | HOTEL ROOM               | 6' - 8"                         | 7' - 0"<br>7' - 0"<br>7' - 0"            | 0' - 2" 0' - 2" 0' - 1 3/4"              | AL/GL<br>SCW          | AL<br>AL<br>HM   | H           | 20MIN      | EXTERIOR STOREFRONT |
| 936-1<br>936-2<br>937-1 |                          | HOTEL ROOM               | M 3' - 0"                       | 7' - 0"<br>7' - 0"<br>7' - 0"            | 0' - 1 3/4"                              | GL/WD<br>SCW          | MTL<br>HM        | P<br>V      | 20MIN      |                     |
| 937-1<br>937-2<br>937-3 | HOTEL ROOM               | HOTEL ROOF               |                                 | 7' - 0"<br>7' - 0"                       | 0' - 2"                                  | GL/WD<br>AL/GL        | MTL<br>AL        | P<br>H      | _OIVIIIV   | EXTERIOR STOREFRON  |
| 938-1<br>938-2          | HOTEL ROOM               | HOTEL ROOF               | M 3' - 0"                       | 7' - 0"<br>7' - 0"                       | 0' - 1 3/4"                              | SCW<br>GL/WD          | HM<br>MTL        | V           | 20MIN      |                     |
| 938-3<br>938-4          | HOTEL ROOM HOTEL ROOM    |                          | 3' - 0"<br>6' - 8"              | 7' - 0"<br>7' - 0"                       | 0' - 2"                                  | SCW<br>AL/GL          | MTL              | Y           |            | EXTERIOR STOREFRON  |
| 939-1<br>939-2          | HOTEL ROOM HOTEL ROOM    |                          | 3' - 0"<br>3' - 0"              | 7' - 0"<br>7' - 0"                       | 0' - 1 3/4"                              | SCW<br>GL/WD          | HM<br>MTL        | V           | 20MIN      |                     |
| 939-3<br>939-4          | HOTEL ROOM               |                          | 3' - 0"<br>6' - 8"              | 7' - 0"<br>7' - 0"                       | 0' - 2"                                  | SCW<br>AL/GL          | MTL              | Y           |            | EXTERIOR STOREFRON  |
| 940-1<br>940-2          |                          | HOTEL ROOM               | M 3' - 0"                       | 7' - 0"<br>7' - 0"                       | 0' - 1 3/4"                              | SCW<br>GL/WD          | HM<br>MTL        | V           | 20MIN      |                     |
| 940-3<br>940-4          | HOTEL ROOM<br>HOTEL ROOM |                          | 3' - 0"<br>6' - 8"              | 7' - 0"<br>7' - 0"                       | 0' - 2"                                  | SCW<br>AL/GL          | MTL              | Y           |            | EXTERIOR STOREFRON  |
| 941-1<br>941-2          | HOTEL ROOM<br>HOTEL ROOM |                          | 3' - 0"<br>3' - 0"              | 7' - 0"<br>7' - 0"                       | 0' - 1 3/4"                              | SCW<br>GL/WD          | HM<br>MTL        | V<br>P      | 20MIN      |                     |
| 941-3<br>941-4          | HOTEL ROOM<br>HOTEL ROOM |                          | 3' - 0"<br>6' - 8"              | 7' - 0"<br>7' - 0"                       | 0' - 2"                                  | SCW<br>AL/GL          | MTL<br>AL        | Y<br>H      |            | EXTERIOR STOREFRON  |
| 942-1<br>942-2          |                          | HOTEL ROOM               | M 3' - 0"                       | 7' - 0"<br>7' - 0"                       | 0' - 1 3/4"                              | SCW<br>GL/WD          | HM<br>MTL        | V<br>P      | 20MIN      |                     |
| 942-3<br>942-4          | HOTEL ROOM               |                          | 3' - 0"<br>6' - 8"              | 7' - 0"<br>7' - 0"                       | 0' - 2"                                  | SCW<br>AL/GL          | MTL<br>AL        | Y<br>H      | 001        | EXTERIOR STOREFRON  |
| 943-1<br>943-2          | HOTEL ROOM               | HOTEL ROOM               |                                 | 7' - 0"<br>7' - 0"                       | 0' - 1 3/4"                              | SCW<br>AL/GL          | AL<br>MTI        | H           | 20MIN      | EXTERIOR STOREFRONT |
| 943-3<br>944-1          | HOTEL ROOM               | HOTEL ROOM               | 3' - 0"                         | 7' - 0"<br>7' - 0"                       | 0' - 1 3/4"                              | GL/WD<br>SCW          | MTL<br>HM        | P<br>V      | 20MIN      |                     |
| 944-2<br>944-3          | HOTEL ROOM HOTEL ROOM    | HOTEL ROOM               | 3' - 0"                         | 7' - 0"<br>7' - 0"<br>7' - 0"            | 0' 10''                                  | GL/WD<br>SCW          | MTL<br>MTL       | P<br>Y<br>V | SUN VIN I  |                     |
| 945-1<br>945-2<br>945-3 | HOTEL ROOM               | HOTEL ROOF<br>HOTEL ROOF | M 3' - 0"                       | 7' - 0"<br>7' - 0"<br>7' - 0"            | 0' - 1 3/4"                              | GL/WD<br>AL/GL        | HM<br>MTL<br>AL  | V<br>P<br>H | 20MIN      | EXTERIOR STOREFRONT |
| 945-3<br>945-4<br>945-5 | HOTEL ROOM               | HOTEL ROOM               |                                 | 7' - 0"<br>7' - 0"                       | 0' - 1 3/8"                              | SCW<br>AL/GL          | MTL<br>AL        | Υ           |            | EXTERIOR STOREFRON  |
| 946-1<br>946-2          | HOTEL ROOM               | HOTEL ROOF               | 3' - 0"                         | 7' - 0"<br>7' - 0"                       | 0' - 1 3/4"                              | SCW<br>SCW            | HM<br>MTL        | V           | 20MIN      |                     |
| 946-3<br>946-4          |                          | HOTEL ROOM               | M 2' - 10"                      | 7' - 0"<br>7' - 0"                       | 0' - 1 3/8"                              | AL/GL<br>GL/WD        | AL<br>MTL        | H<br>P      |            | EXTERIOR STOREFRON  |
| 946-5<br>947-1          | HOTEL ROOM               | HOTEL ROOM               | 2' - 10"                        | 7' - 0"<br>7' - 0"                       | 0' - 1 3/8"<br>0' - 1 3/4"               | AL/GL<br>SCW          | AL<br>HM         | H<br>V      | 20MIN      | EXTERIOR STOREFRON  |
| 947-2<br>947-3          | HOTEL ROOM<br>HOTEL ROOM | HOTEL ROOM               | 2' - 10"                        | 7' - 0"<br>7' - 0"                       | 0' - 1 3/8"                              | AL/GL<br>GL/WD        | AL<br>MTL        | H<br>P      |            | EXTERIOR STOREFRONT |
| 948-1<br>948-3          | HOTEL ROOM               | HOTEL ROOM               |                                 | 7' - 0"<br>7' - 0"                       | 0' - 1 3/4"                              | SCW<br>GL/WD          | HM<br>MTL        | V<br>P      | 20MIN      |                     |
| 948-5<br>949-1          | HOTEL ROOM               | HOTEL ROOM               |                                 | 7' - 0"<br>7' - 0"                       | 0' - 1 3/8"<br>0' - 1 3/4"               | AL/GL<br>SCW          | AL<br>HM         | H<br>V      | 20MIN      | EXTERIOR STOREFRON  |
| 949-2<br>949-3          | HOTEL ROOM               | Room                     | 3' - 0"<br>2' - 10"             | 7' - 0"<br>7' - 0"                       | 0' - 1 3/8"                              | GL/WD<br>AL/ GL       | MTL<br>AL        | P<br>K      |            | EXTERIOR STOREFRONT |
| 949-4<br>950-1          | HOTEL ROOM               | HOTEL BOOK               | 3' - 0"                         | 7' - 0"<br>7' - 0"                       | 0' - 1 3/4"                              | SCW                   | HM               | V           | 20MIN      |                     |
| 950-2<br>950-3          | HOTEL ROOM               | HOTEL POOR               | 2' - 10"                        | 7' - 0"<br>7' - 0"                       | 0' - 1 3/8"                              | GL/WD<br>AL/ GL       | AL<br>MTI        | P<br>K      |            | EXTERIOR STOREFRON  |
| 950-4<br>951-1<br>951-2 | HOTEL ROOM               | HOTEL ROOF               | 3' - 0"                         | 7' - 0"<br>7' - 0"<br>7' - 0"            | 0' - 1 3/4"                              | SCW<br>SCW<br>GL/WD   | MTL<br>HM<br>MTL | Y<br>V<br>P | 20MIN      |                     |
| 951-2<br>951-3<br>951-4 | HOTEL ROOM               | HOTEL ROOF               | 2' - 10"                        | 7' - 0"<br>7' - 0"<br>7' - 0"            | 0' - 1 3/8"                              | AL/GL<br>SCW          | AL<br>MTL        | H<br>Y      |            | EXTERIOR STOREFRONT |
| 951-4<br>952-1<br>952-2 | HOTEL ROOM               | HOTEL ROOF               |                                 | 7' - 0"<br>7' - 0"                       | 0' - 1 3/4"                              | SCW<br>SCW<br>GL/WD   | HM<br>MTL        | V<br>P      | 20MIN      |                     |
| 952-4<br>952-5          | HOTEL ROOM<br>HOTEL ROOM |                          | 2' - 10"<br>6' - 0"             | 7' - 0"<br>7' - 0"                       | 0' - 1 3/8"<br>0' - 2"                   | AL/GL<br>AL/GL        | AL<br>AL         | H<br>H      |            | EXTERIOR STOREFRONT |
| 953-1<br>953-2          | HOTEL ROOM               |                          | 3' - 0"<br>6' - 0"              | 7' - 0"<br>7' - 0"                       | 0' - 1 3/4"                              | SCW<br>AL/GL          | HM<br>AL         | V           | 20MIN      | EXTERIOR STOREFRONT |
| 953-3<br>953-4          |                          | HOTEL ROOF               | M 3' - 0"<br>M 3' - 0"          | 7' - 0"<br>7' - 0"                       |  | SCW<br>SCW            | MTL<br>MTL       | Y           |            |                     |
| 953-5<br>954            | HOTEL ROOM               |                          | 6' - 0"<br>6' - 0"              | 7' - 0"<br>7' - 0"                       | 0' - 2"<br>0' - 1 3/4"                   | AL/GL<br>HM           | AL<br>HM         | H<br>D      |            | EXTERIOR STOREFRONT |
| 955<br>956              |                          | IDF                      | 6' - 0"<br>3' - 0"              | 7' - 0"<br>7' - 0"                       | 0' - 1 3/4"<br>0' - 1 3/4"               | HM<br>GL/WD           | HM<br>HM         | D<br>T      |            |                     |
| 957<br>958              | ELEV LOBBY               | ELEC.                    | 3' - 0"<br>6' - 0"              | 7' - 0"<br>7' - 0"                       | 0' - 1 3/4"<br>0' - 1 3/4"               | SCW<br>HM             | HM<br>HM         | V<br>D      |            |                     |
| 959<br>960              |                          | STAIR 1                  | 3' - 0"<br>6' - 0"              | 7' - 0"<br>7' - 0"                       | 0' - 1 3/4"<br>0' - 1 3/4"               | HM<br>HM              | HM<br>HM         | E<br>D      | 2HR<br>1HR |                     |
| 961<br>962              | STAIR 3                  |                          | 3' - 0"<br>3' - 0"              | 7' - 0"<br>7' - 0"                       | 0' - 1 3/4"                              | HM<br>HM              | HM<br>HM         | C<br>E      | 2HR<br>2HR |                     |
|                         | WOMEN WOMEN              |                          | 3' - 0"<br>2' - 8"              | 7' - 0"<br>7' - 0"                       | 0' - 1"                                  | HM                    | HM               | C           |            |                     |
| 999<br>999              |                          |                          | 2' - 8"                         | 7' - 0"                                  | 0' - 1"                                  | HM                    | НМ               | С           |            |                     |
| 999<br>999<br>999       | WOMEN<br>WOMEN           |                          | 2' - 8"                         | 7' - 0"                                  | 0' - 1"                                  | HM                    | HM               | С           |            |                     |
| 999<br>999              | WOMEN                    |                          |                                 | 7' - 0"<br>7' - 0"<br>7' - 0"<br>7' - 0" | 0' - 1"<br>0' - 1"<br>0' - 1"<br>0' - 1" | HM<br>HM<br>HM        | HM<br>HM<br>HM   | C<br>C<br>C |            |                     |

(504)-885-4477 central@hbsaii.com :-: hbsaii.com SINCE 1961

ARD ROCK HOTI 1031 CANAL STREET NEW ORLEANS, LOUISIANA

THESE PLANS AND SPECIFICATIONS HAVE BEEN PREPARED BY ME OR UNDER MY CLOSE PERSONAL SUPERVISION AND TO THE BEST OF MY KNOWLEDGE AND BELIEF THEY COMPLY WITH ALL CITY, STATE AND FEDERAL REQUIREMENTS, AND I AM NOT PROVIDING CONTRACT ADMINISTRATION.

CERTIFIED CORRECT

THIS DRAWING IS CONFIDENTIAL AND NOT BE LOANED, REPRODUCED, COPIED, EITHER WHOLLY OR IN PART, OR MADE PUBLIC IN ANY MANNER WITHOUT THE WRITTEN CONSENT OF HBSA II ARCHITECTS, A PROFESSIONAL L.L.C. ALL RIGHTS OF DESIGN OR INVENTION ARE RESSERVED AND WILL REMAIN THE SOLE PROPERTY OF HBSA II ARCHITECTS A PROFESSIONAL L.L.C.

REVISION HISTORY

8 102/11/15

REVISION HISTORY

8 102/11/15

REVISION HISTORY

1 L.I.S. #2 - CLOUD R
3 L.I.S. #2 - CLOUD R
4 L.I.S. #2 - CLOUD R
5 L.I.S. #2 - CLOUD R
7 L.I.S. #2 - CLOUD R
8

PROJECT#: 1709
PHASE: DD
TEAM: Author
CHECKER: Checke

CHECKER: Checker SCALE: AS NOTED ISSUED: 4/20/2018

A6.4

|                            |                          |                          | DO                      | OOR SCE             | HEDULE - 10                |                     |            |           |             |                          |
|----------------------------|--------------------------|--------------------------|-------------------------|---------------------|----------------------------|---------------------|------------|-----------|-------------|--------------------------|
| MARK                       | FROM                     | 01                       | WIDTH                   | НЕІСНТ              | THICKNESS                  | DOOR MATERIAL       | DOOR FRAME | DOOR TYPE | FIRE RATING | REMARKS                  |
| 1000-1                     | BATH                     |                          | 3' - 0"                 | 7' - 0"             | 0' - 1 3/4"                | SCW                 | НМ         | ٧         | 20MIN       |                          |
| 1000-2<br>1000-3           | BATH                     | HOTEL ROOM               | 3' - 0"<br>4' - 7"      | 7' - 0"<br>6' - 8"  |                            | GL/WD<br>WD         | WD<br>WD   | P<br>L    |             |                          |
| 1000-4<br>1000-5           | HOTEL ROOM               | HOTEL ROOM               | 2' - 10"<br>3' - 0"     | 7' - 0"<br>7' - 0"  | 0' - 1 3/8"                | AL/ GL<br>WD        | AL<br>WD   | H<br>L    |             | EXTERIOR STOREFRONT      |
| 1001-1<br>1001-2           | HOTEL ROOM               |                          | 3' - 0"<br>2' - 10"     | 7' - 0"<br>7' - 0"  | 0' - 1 3/4"                | SCW<br>AL/ GL       | HM<br>AL   | V<br>H    | 20MIN       | EXTERIOR STOREFRONT      |
| 1001-3<br>1001-4           | HOTEL ROOM               | BATH                     | 3' - 0"<br>2' - 10"     | 7' - 0"<br>7' - 0"  | 0' - 1 3/8"                | WD/GL<br>AL/ GL     | MTL<br>AL  | P<br>H    |             | EXTERIOR STOREFRONT      |
| 1001-5<br>1002-1           |                          | HOTEL ROOM               | 4' - 0"<br>3' - 0"      | 7' - 0"<br>7' - 0"  | 0' - 1 1/2"<br>0' - 1 3/4" | WD<br>SCW           | WD<br>HM   | L<br>V    | 20MIN       |                          |
| 1002-2<br>1002-3           | HOTEL ROOM               | BATH                     | 3' - 0"<br>3' - 0"      | 7' - 0"<br>7' - 0"  |                            | WD / GL<br>SCW      | HM<br>MTL  | P<br>Y    |             |                          |
| 1002-4                     | HOTEL ROOM               | HOTEL ROOM               | 2' - 9 7/32"<br>3' - 0" | 6' - 11"<br>7' - 0" | 0' - 1 1/2"                | AL/GL<br>SCW        | AL<br>HM   | K         | 20MIN       | EXTERIOR STOREFRONT      |
| 1003-2                     | HOTEL ROOM               | BATH<br>HOTEL ROOM       | 3' - 0"<br>3' - 0"      | 7' - 0"<br>7' - 0"  | 0 1 0/1                    | WD/GL<br>SCW        | MTL        | P<br>Y    | Zowiii      |                          |
| 1003-4<br>1004-1           | HOTEL ROOM               |                          | 6' - 8"<br>3' - 0"      | 7' - 0"<br>7' - 0"  | 0' - 2"                    | AL/ GL<br>SCW       | AL<br>HM   | H         | 20MIN       | EXTERIOR STOREFRONT      |
|                            |                          | HOTEL ROOM               | 3' - 0"                 | 7' - 0"<br>7' - 0"  | 0 - 1 3/4                  | WD/GL<br>WD         | MTL        | Р         | ZUIVIIIN    |                          |
| 1004-4                     | HOTEL ROOM               |                          | 3' - 0"<br>6' - 8"      | 7' - 0"             | 0' - 2"                    | AL/ GL              | MTL<br>AL  | Y<br>H    | 2014111     | EXTERIOR STOREFRONT      |
|                            | HOTEL ROOM<br>HOTEL ROOM |                          | 3' - 0"                 | 7' - 0"             | 0' - 1 3/4"                | SCW<br>WD/GL        | 1          | Y<br>P    | 20MIN       |                          |
| 1005-3<br>1005-4           | HOTEL ROOM               | HOTEL ROOM               | 6' - 8"                 | 7' - 0"<br>7' - 0"  | 0' - 2"                    | SCW<br>AL/ GL       | AL         | Y<br>H    |             | EXTERIOR STOREFRONT      |
| 1006-1<br>1006-2           | BATH                     | HOTEL ROOM               | 3' - 0"<br>3' - 0"      | 7' - 0"<br>7' - 0"  | 0' - 1 3/4"                | SCW<br>WD/GL        | HM<br>MTL  | V<br>P    | 20MIN       |                          |
| 1006-3<br>1006-4           | HOTEL ROOM               |                          | 3' - 0"<br>6' - 8"      | 7' - 0"<br>7' - 0"  | 0' - 2"                    | SCW<br>AL/ GL       | MTL<br>AL  | Y<br>H    |             | EXTERIOR STOREFRONT      |
| 1007-1<br>1007-2           | HOTEL ROOM               | BATH                     | 3' - 0"<br>3' - 0"      | 7' - 0"<br>7' - 0"  | 0' - 1 3/4"                | SCW<br>WD/GL        | HM<br>MTL  | V<br>P    | 20MIN       |                          |
| 1007-3<br>1007-4           | HOTEL ROOM               | HOTEL ROOM               | 3' - 0"<br>2' - 9 7/32" | 7' - 0"<br>6' - 11" | 0' - 1 1/2"                | SCW<br>AL/GL        | MTL<br>AL  | Y<br>K    |             | EXTERIOR STOREFRONT      |
| 1008-1                     | HOTEL ROOM               | HOTEL ROOM               | 3' - 0"<br>6' - 8"      | 7' - 0"<br>7' - 0"  | 0' - 1 3/4"                | SCW<br>AL/ GL       | HM<br>HM   | V<br>H    | 20MIN       | EXTERIOR STOREFRONT      |
| 1008-3<br>1008-4           | BATH                     | HOTEL ROOM<br>HOTEL ROOM |                         | 7' - 0"<br>7' - 0"  | 0 2                        | SCW<br>GL/WD        | MTL        | Y         |             | EXTERIOR CTORETTON       |
| 1009-1                     |                          | HOTEL ROOM               | 3' - 0"                 | 7' - 0"             | 0' - 1 3/4"                | SCW                 | НМ         | V         | 20MIN       |                          |
| 1009-3                     |                          | HOTEL ROOM               | 3' - 0"                 | 7' - 0"<br>7' - 0"  | 21 21                      | WD/GL<br>SCW        | MTL        | P<br>Y    |             |                          |
| 1010-1                     |                          |                          | 5' - 0"<br>3' - 0"      | 7' - 0"             | 0' - 2"                    | AL/ GL<br>SCW       | AL<br>HM   | V         | 20MIN       | EXTERIOR STOREFRONT      |
| 1010-3                     | HOTEL ROOM               | BATH                     | 3' - 0"<br>3' - 0"      | 7' - 0"<br>7' - 0"  |                            | GL/WD<br>SCW        | MTL<br>MTL | P<br>Y    |             |                          |
| 1010-4<br>1011-1           | HOTEL ROOM               | HOTEL ROOM               | 6' - 8"<br>3' - 0"      | 7' - 0"<br>7' - 0"  | 0' - 2"<br>0' - 1 3/4"     | AL/ GL<br>SCW       | AL<br>HM   | H<br>V    | 20MIN       | EXTERIOR STOREFRONT      |
| 1011-2<br>1011-3           | HOTEL ROOM               | BATH<br>HOTEL ROOM       | 3' - 0"<br>3' - 0"      | 7' - 0"<br>7' - 0"  |                            | WD/GL<br>SCW        | MTL<br>MTL | P<br>Y    |             |                          |
| 1011-4<br>1012-1           | HOTEL ROOM               | HOTEL ROOM               | 6' - 0"<br>3' - 0"      | 7' - 0"<br>7' - 0"  | 0' - 2"                    | AL/GL<br>SCW        | AL<br>HM   | H<br>Y    | 20MIN       | EXTERIOR STOREFRONT      |
| 1012-2<br>1012-3           | BATH                     | HOTEL ROOM               | 3' - 0"<br>6' - 8"      | 7' - 0"<br>7' - 0"  | 0' - 2"                    | GL/WD<br>AL/ GL     | MTL<br>AL  | P<br>H    |             | EXTERIOR STOREFRONT      |
| 1013-1<br>1013-2           | HOTEL ROOM<br>BATH       | HOTEL ROOM               | 3' - 0"<br>3' - 0"      | 7' - 0"<br>7' - 0"  | 0' - 1 3/4"                | SCW<br>WD/GL        | HM<br>MTL  | V<br>P    | 20MIN       |                          |
| 1013-3                     | HOTEL ROOM               |                          | 3' - 0"<br>6' - 0"      | 7' - 0"<br>7' - 0"  | 0' - 2"                    | SCW<br>AL/ GL       | MTL<br>AL  | Y<br>H    |             | EXTERIOR STOREFRONT      |
| 1014-1                     | HOTEL ROOM HOTEL ROOM    | RATH                     | 3' - 0"<br>3' - 0"      | 7' - 0"<br>7' - 0"  | 0' - 1 3/4"                | SCW<br>GL/WD        | HM<br>MTL  | V         | 20MIN       | ZATERIIOTE OT CITE TO IN |
|                            | HOTEL ROOM               | HOTEL ROOM               | 6' - 0"<br>3' - 0"      | 7' - 0"<br>7' - 0"  | 0' - 2"                    | AL/ GL<br>SCW       | AL<br>HM   | H         | 20MIN       | EXTERIOR STOREFRONT      |
| 1015-2                     | HOTEL ROOM               | BATH                     | 3' - 0"                 | 7' - 0"             | 0 - 1 3/4                  | WD/GL               | MTL        | Р         | ZOIVIIIN    |                          |
| 1015-3                     | HOTEL ROOM               | HOTEL ROOM               | 6' - 0"                 | 7' - 0"<br>7' - 0"  | 0' - 2"                    | SCW<br>AL/ GL       | MTL<br>AL  | Y<br>H    | 2014111     | EXTERIOR STOREFRONT      |
| 1016-1<br>1016-2           | BATH                     | HOTEL ROOM<br>HOTEL ROOM | 3' - 0"<br>3' - 0"      | 7' - 0"<br>7' - 0"  | 0' - 1 3/4"                | SCW<br>GL/WD        | HM<br>MTL  | V<br>P    | 20MIN       |                          |
|                            |                          | HOTEL ROOM               | 3' - 0"<br>6' - 0"      | 7' - 0"<br>7' - 0"  | 0' - 2"                    | SCW<br>AL/ GL       | MTL<br>AL  | Y<br>H    |             | EXTERIOR STOREFRONT      |
| 1017-1<br>1017-2           | HOTEL ROOM<br>BATH       | HOTEL ROOM               | 3' - 0"<br>3' - 0"      | 7' - 0"<br>7' - 0"  | 0' - 1 3/4"                | SCW<br>WD/GL        | HM<br>MTL  | V<br>P    | 20MIN       |                          |
| 1017-3<br>1017-4           | HOTEL ROOM               |                          | 3' - 0"<br>6' - 0"      | 7' - 0"<br>7' - 0"  | 0' - 2"                    | SCW<br>AL/ GL       | MTL<br>AL  | Y<br>H    |             | EXTERIOR STOREFRONT      |
| 1018-1<br>1018-2           | HOTEL ROOM               | BATH                     | 3' - 0"<br>3' - 0"      | 7' - 0"<br>7' - 0"  | 0' - 1 3/4"                | SCW<br>GL/WD        | HM<br>MTL  | V<br>P    | 20MIN       |                          |
| 1018-3<br>1018-4           | HOTEL ROOM               |                          | 3' - 0"<br>6' - 0"      | 7' - 0"<br>7' - 0"  | 0' - 2"                    | SCW<br>AL/ GL       | MTL<br>AL  | Y<br>H    |             | EXTERIOR STOREFRONT      |
| 1019-1                     | 22                       | HOTEL ROOM<br>HOTEL ROOM | 3' - 0"<br>3' - 0"      | 7' - 0"<br>7' - 0"  | 0' - 1 3/4"                | SCW<br>GL/WD        | HM<br>MTL  | V         |             |                          |
|                            | HOTEL ROOM               | BATH<br>HOTEL ROOM       | 3' - 0"<br>6' - 8"      | 7' - 0"<br>7' - 0"  | 0' - 2"                    | GL/WD<br>AL/ GL     | MTL        | P<br>H    |             | EXTERIOR STOREFRONT      |
| 1019-4<br>1020-1<br>1020-2 | ВАТН                     | HOTEL ROOM               | 3' - 0"<br>3' - 0"      | 7' - 0"<br>7' - 0"  | 0' - 1 3/4"                | SCW<br>GL/WD        | HM<br>MTL  | V<br>P    | 20MIN       | Z Z. IION OTOTILI HONT   |
| 1020-3                     |                          | HOTEL ROOM               | 3' - 0"                 | 7' - 0"             | 0' 0"                      | SCW                 | MTL        | Υ         |             | EVTEDIOD STORESSONT      |
| 1021-1                     | HOTEL ROOM               | DATU                     | 6' - 0"<br>3' - 0"      | 7' - 0"             | 0' - 2"                    | AL/ GL<br>SCW       | AL<br>HM   | H<br>V    | 20MIN       | EXTERIOR STOREFRONT      |
| 1021-3                     |                          | BATH<br>HOTEL ROOM       | 3' - 0"                 | 7' - 0"             | 0, 2"                      | GL/WD<br>SCW        | MTL        | P<br>Y    |             | EVTERIOR                 |
| 1021-4<br>1022-1           | HOTEL ROOM               | HOTEL ROOM               |                         | 7' - 0"             | 0' - 2"                    | AL/ GL<br>SCW       | AL<br>HM   | H<br>V    | 20MIN       | EXTERIOR STOREFRONT      |
| 1022-3                     | HOTEL ROOM               | HOTEL ROOM               | 3' - 0"<br>3' - 0"      | 7' - 0"<br>7' - 0"  |                            | GL/WD<br>SCW        | MTL<br>MTL | P<br>Y    |             |                          |
| 1023-1                     | HOTEL ROOM               |                          | 6' - 0"<br>3' - 0"      | 7' - 0"<br>7' - 0"  | 0' - 2"<br>0' - 1 3/4"     | AL/ GL<br>SCW       | AL<br>HM   | H<br>V    | 20MIN       | EXTERIOR STOREFRONT      |
|                            | HOTEL ROOM<br>HOTEL ROOM | BATH                     | 3' - 0"<br>3' - 0"      | 7' - 0"<br>7' - 0"  |                            | GL/WD<br>SCW        | MTL<br>MTL | P<br>Y    |             |                          |
|                            | HOTEL ROOM               | HOTEL ROOM               | 6' - 0"<br>3' - 0"      | 7' - 0"<br>7' - 0"  | 0' - 2"                    | AL/ GL<br>SCW       | AL<br>HM   | H<br>V    | 20MIN       | EXTERIOR STOREFRONT      |
| 1024-2                     | BATH<br>HOTEL ROOM       | HOTEL ROOM               |                         | 7' - 0"<br>7' - 0"  |                            | GL/WD<br>SCW        | MTL        | P<br>Y    |             |                          |
| 1024-4                     | HOTEL ROOM HOTEL ROOM    |                          | 6' - 0"<br>3' - 0"      | 7' - 0"<br>7' - 0"  | 0' - 2"                    | AL/ GL<br>SCW       | AL<br>HM   | H         | 20MIN       | EXTERIOR STOREFRONT      |
| 1025-1<br>1025-2<br>1025-3 |                          | HOTEL ROOM               | 2' - 8"                 | 7' - 0"<br>7' - 0"  | 1 0/4                      | SCW<br>SCW<br>GL/WD |            | Y<br>P    | N           |                          |
| 1025-4                     | HOTEL ROOM               | INOTEL NOUN              | 6' - 0"                 | 7' - 0"             | 0' - 2"                    | AL/ GL              | AL         | Н         | 201411      | EXTERIOR STOREFRONT      |
| 1026-2                     | HOTEL ROOM               | BATH                     | 3' - 0"                 | 7' - 0"<br>7' - 0"  | 0' - 1 3/4"                | SCW<br>GL/WD        |            | V<br>P    | 20MIN       |                          |
| 1026-4                     | HOTEL ROOM<br>HOTEL ROOM |                          | 3' - 0"<br>6' - 0"      | 7' - 0"<br>7' - 0"  | 0' - 2"                    | SCW<br>AL/ GL       | MTL<br>AL  | Y<br>H    |             | EXTERIOR STOREFRONT      |
|                            | HOTEL ROOM               |                          | 3' - 0"                 | 7' - 0"             | 0' - 1 3/4"                | SCW                 | НМ         | ٧         | 20MIN       | 1                        |

| ~                | Ę                        |                          | I                   | 노                  | THICKNESS              | DOOR MATERIAL   | R FRAME    | 3 TYPE | RATING   | ARKS                              |
|------------------|--------------------------|--------------------------|---------------------|--------------------|------------------------|-----------------|------------|--------|----------|-----------------------------------|
| MARK             | FROM                     | <u></u> 2                | WIDTH               | HEIGHT             | THIC T                 | D006            | DOOR       | DOOR   | FIRE     | REMARKS                           |
|                  | HOTEL ROOM               | ВАТН                     | 3' - 0"<br>3' - 0"  | 7' - 0"<br>7' - 0" |                        | WD/GL<br>SCW    |            | P<br>Y |          |                                   |
|                  | HOTEL ROOM               | HOTEL ROOM               | 6' - 0"<br>3' - 0"  | 7' - 0"            | 0' - 2"                | AL/ GL<br>SCW   | AL<br>HM   | H      | 20MIN    | EXTERIOR STOREFR                  |
| 1028-2           |                          | HOTEL ROOM               | 3' - 0"             | 7' - 0"            | 0 13/4                 | GL/WD           | MTL        | Р      | ZOWIIN   |                                   |
| 1028-4           | HOTEL ROOM<br>HOTEL ROOM |                          | 3' - 0"<br>6' - 0"  | 7' - 0"<br>7' - 0" | 0' - 2"                | SCW<br>AL/ GL   | AL         | Y<br>H |          | EXTERIOR STOREFR                  |
| 1029-1<br>1029-2 | BATH                     | HOTEL ROOM               | 3' - 0"<br>3' - 0"  | 7' - 0"<br>7' - 0" | 0' - 1 3/4"            | SCW<br>WD/GL    | HM<br>MTL  | V<br>P |          |                                   |
|                  | HOTEL ROOM               |                          | 3' - 0"<br>6' - 0"  | 7' - 0"<br>7' - 0" | 0' - 2"                | SCW<br>AL/ GL   | MTL<br>AL  | Y<br>H |          | EXTERIOR STOREFR                  |
| 1030-1           | HOTEL ROOM               |                          | 3' - 0"             | 7' - 0"            | 0' - 1 3/4"            | SCW             | НМ         | ٧      | 20MIN    | LATERIOR GRONEITE                 |
| 1030-3           | HOTEL ROOM               | BATH                     | 3' - 0"<br>3' - 0"  | 7' - 0"<br>7' - 0" |                        | GL/WD<br>SCW    | MTL<br>MTL | P<br>Y |          |                                   |
|                  | HOTEL ROOM               |                          | 6' - 0"<br>3' - 0"  | 7' - 0"<br>7' - 0" | 0' - 2"                | AL/ GL<br>SCW   | AL<br>HM   | H<br>V | 20MIN    | EXTERIOR STOREFR                  |
|                  | HOTEL ROOM               | BATH                     | 3' - 0"<br>6' - 0"  | 7' - 0"<br>7' - 0" | 0' - 2"                | WD/GL<br>AL/GL  | MTL<br>AL  | P<br>H |          | EXTERIOR STOREFR                  |
| 1032-1           |                          | HOTEL ROOM               | 3' - 0"             | 7' - 0"            | 0' - 1 3/4"            | SCW             | НМ         | V      | 20MIN    | EXTERIOR GROTELIN                 |
| 1032-2<br>1032-3 | HOTEL ROOM               | HOTEL ROOM               | 3' - 0"<br>6' - 0"  | 7' - 0"<br>7' - 0" | 0' - 2"                | WD/GL<br>AL/ GL | MTL<br>AL  | P<br>H |          | EXTERIOR STOREFR                  |
| 1033-1<br>1033-2 | HOTEL ROOM               | BATH                     | 3' - 0"<br>3' - 0"  | 7' - 0"<br>7' - 0" | 0' - 1 3/4"            | SCW<br>WD/GL    | HM<br>MTL  | V<br>P | 20MIN    |                                   |
|                  | HOTEL ROOM               | HOTEL ROOM               | 6' - 8"<br>3' - 0"  | 7' - 0"<br>7' - 0" | 0' - 2"                | AL/ GL<br>SCW   | AL<br>HM   | H<br>V | 20MIN    | EXTERIOR STOREFR                  |
| 1034-2           | HOTEL ROOM               | -                        | 3' - 0"             | 7' - 0"            |                        | WD/GL           | MTL        | Р      | LOWIN    | EVERSION                          |
| 1035-1           | HOTEL ROOM               |                          | 6' - 8"<br>3' - 0"  | 7' - 0"<br>7' - 0" | 0' - 2"<br>0' - 1 3/4" | AL/ GL<br>SCW   | AL<br>HM   | V      | 20MIN    | EXTERIOR STOREFR                  |
| 1035-2<br>1035-3 | HOTEL ROOM               | HOTEL ROOM<br>BATH       | 3' - 0"<br>3' - 0"  | 7' - 0"<br>7' - 0" |                        | SCW<br>GL/WD    | MTL<br>MTL | Y<br>P |          |                                   |
| 1035-4           | HOTEL ROOM               |                          | 6' - 8"<br>6' - 8"  | 7' - 0"            | 0' - 2"                | AL/ GL          | AL         | Н      |          | EXTERIOR STOREFR EXTERIOR STOREFR |
| 1036-1           | HOTEL ROOM               |                          | 3' - 0"             | 7' - 0"            | 0' - 2"                | AL/ GL<br>SCW   | AL<br>HM   | H<br>V | 20MIN    | EVIERIOR STORFLY                  |
| 1036-2<br>1036-3 | HOTEL ROOM               | HOTEL ROOM<br>BATH       | 3' - 0"<br>3' - 0"  | 7' - 0"<br>7' - 0" |                        | SCW<br>WD/GL    |            | Y<br>P |          |                                   |
|                  | HOTEL ROOM               |                          | 6' - 8"<br>3' - 0"  | 7' - 0"<br>7' - 0" | 0' - 2"                | AL/ GL<br>SCW   | AL<br>HM   | H<br>V | 20MIN    | EXTERIOR STOREFR                  |
| 1037-2           |                          |                          | 3' - 0"             | 7' - 0"            | 0 1 0/ 1               | GL/WD           | MTL        | Р      | Zowiii   |                                   |
| 1037-4           | HOTEL ROOM               |                          | 3' - 0"<br>6' - 8"  | 7' - 0"<br>7' - 0" | 0' - 2"                | SCW<br>AL/ GL   | MTL<br>AL  | Н      |          | EXTERIOR STOREFR                  |
|                  | HOTEL ROOM               | BATH                     | 3' - 0"<br>3' - 0"  | 7' - 0"<br>7' - 0" | 0' - 1 3/4"            | SCW<br>GL/WD    | HM<br>MTL  | V<br>P | 20MIN    |                                   |
| 1038-3           | HOTEL ROOM               |                          | 3' - 0"<br>6' - 8"  | 7' - 0"<br>7' - 0" | 0' - 2"                | SCW<br>AL/ GL   | MTL<br>AL  | Y<br>H |          | EXTERIOR STOREFR                  |
| 1039-1           |                          |                          | 3' - 0"             | 7' - 0"            | 0' - 1 3/4"            | WD              | НМ         | ٧      | 20MIN    | EXTERIOR STORE R                  |
|                  | HOTEL ROOM               | HOTEL ROOM               | 3' - 0"<br>3' - 0"  | 7' - 0"<br>7' - 0" |                        | GL/WD<br>SCW    |            | P<br>Y |          |                                   |
|                  | HOTEL ROOM               |                          | 6' - 8"<br>3' - 0"  | 7' - 0"<br>7' - 0" | 0' - 2"<br>0' - 1 3/4" | AL/ GL<br>SCW   | MTL<br>HM  | H<br>V | 20MIN    | EXTERIOR STOREFR                  |
| 1040-2           | HOTEL ROOM<br>HOTEL ROOM | BATH                     | 3' - 0"<br>3' - 0"  | 7' - 0"            |                        | GL/WD<br>SCW    |            | Р      |          |                                   |
| 1040-4           | HOTEL ROOM               |                          | 6' - 8"             | 7' - 0"            | 0' - 2"                | AL/ GL          | AL         | Н      |          | EXTERIOR STOREFR                  |
| 1041-1<br>1041-2 | HOTEL ROOM               | HOTEL ROOM               | 3' - 0"<br>6' - 0"  | 7' - 0"<br>7' - 0" | 0' - 1 3/4"            | SCW<br>AL/ GL   | HM<br>AL   | V<br>H | 20MIN    | EXTERIOR STOREFR                  |
| 1041-3<br>1042-1 | BATH                     |                          | 3' - 0"<br>3' - 0"  | 7' - 0"<br>7' - 0" | 0' - 1 3/4"            | GL/WD<br>SCW    | MTL<br>HM  | P<br>V | 20MIN    |                                   |
| 1042-2           | BATH<br>HOTEL ROOM       | HOTEL ROOM               | 3' - 0"<br>3' - 0"  | 7' - 0"<br>7' - 0" |                        | GL/WD<br>SCW    | MTL<br>MTL | P      |          |                                   |
| 1042-4           | HOTEL ROOM               | LICTEL BOOM              | 6' - 8"             | 7' - 0"            | 0' - 2"                | AL/ GL          | AL         | Н      | 2014111  | EXTERIOR STOREFR                  |
| 1043-1<br>1043-2 | BATH                     | HOTEL ROOM<br>HOTEL ROOM | 3' - 0"             | 7' - 0"<br>7' - 0" | 0' - 1 3/4"            | SCW<br>WD/GL    | HM<br>MTL  | V<br>P | 20MIN    |                                   |
| 1043-3<br>1043-4 |                          |                          | 6' - 0"<br>3' - 0"  | 7' - 0"<br>7' - 0" | 0' - 2"                | AL/ GL<br>SCW   | AL<br>MTL  | H<br>Y |          | EXTERIOR STOREFR                  |
|                  | HOTEL ROOM               |                          | 2' - 10"<br>3' - 0" | 7' - 0"<br>7' - 0" | 0' - 1 3/8"            | AL/ GL<br>SCW   | AL<br>HM   | H<br>V | 20MIN    | EXTERIOR STOREFR                  |
| 1044-2           | HOTEL ROOM               | BATH                     | 3' - 0"             | 7' - 0"            | 0 - 1 0/4              | AL/GL           | MTL        | Р      | LOWIN    |                                   |
| 1045-1           | HOTEL ROOM               |                          | 3' - 0"<br>3' - 0"  | 7' - 0"<br>7' - 0" | 0' - 1 3/4"            | SCW<br>SCW      | MTL<br>HM  | V      | 20MIN    |                                   |
| 1045-2<br>1045-3 |                          |                          | 2' - 8"<br>2' - 10" | 7' - 0"<br>7' - 0" | 0' - 1 3/8"            | SCW<br>AL/ GL   | MTL<br>AL  | Y      |          | EXTERIOR STOREFR                  |
| 1045-4           | BATH<br>HOTEL ROOM       |                          | 3' - 0"<br>2' - 10" | 7' - 0"<br>7' - 0" | 0' - 1 3/8"            | GL/WD<br>AL/ GL | MTL<br>AL  | 1      |          | EXTERIOR STOREFR                  |
| 1046-1           |                          | HOTEL ROOM               | 3' - 0"             | 7' - 0"            | 0' - 1 3/4"            | SCW             | НМ         | ٧      | 20MIN    |                                   |
| 1046-3           | HOTEL ROOM               | BATH                     | 3' - 0"<br>3' - 0"  | 7' - 0"<br>7' - 0" | 0' - 1 3/8"            | AL/ GL<br>SCW   | AL<br>MTL  | H<br>P |          | EXTERIOR STOREFR                  |
| 1046-4<br>1046-5 | BATH                     | BATH                     | 4' - 7"<br>4' - 7"  | 6' - 8"<br>6' - 8" |                        |                 |            |        |          |                                   |
|                  | HOTEL ROOM               |                          | 3' - 0"<br>3' - 0"  | 7' - 0"<br>7' - 0" | 0' - 1 3/4"            | HM<br>GL/WD     | HM<br>MTL  | V      | 20MIN    |                                   |
| 1047-5           | HOTEL ROOM               |                          | 2' - 10"            | 7' - 0"            | 0' - 1 3/8"            | AL/ GL          | AL         | Н      | 001.111  | EXTERIOR STOREFR                  |
|                  | HOTEL ROOM               | BATH                     | 3' - 0"<br>3' - 0"  | 7' - 0"<br>7' - 0" | 0' - 1 3/4"            | SCW<br>GL/WD    | MTL<br>MTL | Р      | 20MIN    |                                   |
| 1048-3<br>1048-4 | HOTEL ROOM               | HOTEL ROOM               | 3' - 0"<br>3' - 0"  | 7' - 0"<br>7' - 0" | 0' - 1 3/8"            | SCW<br>AL/ GL   | MTL<br>AL  | Y<br>K |          | EXTERIOR STOREFR                  |
|                  | HOTEL ROOM               | HOTEL ROOM               | 3' - 0"<br>3' - 0"  | 7' - 0"<br>7' - 0" | 0' - 1 3/4"            | SCW<br>WD/GL    | MTL        | 1      | 20MIN    |                                   |
| 1049-3           | HOTEL ROOM               |                          | 3' - 0"             | 7' - 0"            | 0' - 1 3/8"            | AL/ GL          | AL         | K      |          | EXTERIOR STOREFR                  |
|                  | HOTEL ROOM               |                          | 3' - 0"<br>3' - 0"  | 7' - 0"<br>7' - 0" | 0' - 1 3/4"            | AL/ GL<br>HM    | AL<br>HM   | H<br>V | 20MIN    | EXTERIOR STOREFR                  |
| 1050-2<br>1050-3 | BATH<br>HOTEL ROOM       | HOTEL ROOM               | 3' - 0"<br>2' - 10" | 7' - 0"<br>7' - 0" | 0' - 1 3/8"            | GL/WD<br>AL/ GL | MTL<br>AL  | P<br>H |          | EXTERIOR STOREFR                  |
| 1050-4<br>1051-1 | 133                      |                          | 3' - 0"             | 7' - 0"<br>7' - 0" | 0' - 1 3/4"            | SCW<br>SCW      |            | Y      | 20MIN    |                                   |
| 1051-2           | HOTEL ROOM               |                          | 6' - 0"             | 7' - 0"            | 0' - 1 3/4"            | AL/ GL          | AL         | Н      | ZOIVIIIN | EXTERIOR STOREFR                  |
|                  | HOTEL ROOM               | RAIH                     | 3' - 0"<br>2' - 10" | 7' - 0"<br>7' - 0" | 0' - 1 3/8"            | GL/WD<br>AL/ GL | AL         | Н      |          | EXTERIOR STOREFR                  |
|                  | HOTEL ROOM               |                          | 3' - 0"<br>6' - 0"  | 7' - 0"<br>7' - 0" | 0' - 1 3/4"            | SCW<br>AL/GL    | MTL<br>AL  | V<br>H | 20MIN    | EXTERIOR STOREFR                  |
|                  | HOTEL ROOM               |                          | 3' - 0"<br>3' - 0"  | 7' - 0"<br>7' - 0" |                        | WD/GL<br>SCW    | MTL<br>MTL | Р      |          |                                   |
|                  | HOTEL ROOM               | LICTEL MOUN              | 6' - 0"             | 7' - 0"            | 0' - 2"                | AL/ GL          | AL         | Н      |          | EXTERIOR STOREFR                  |
| 1063             | ELEV. LOBBY              |                          | 6' - 0"             | 7' - 0"            | 0' - 1 3/4"            | HM              | НМ         | D      |          | DOUBLE DOOR / PAIR                |



# HARD ROCK HOTE 1031 CANAL STREET NEW ORLEANS, LOUISIANA

THESE PLANS AND SPECIFICATIONS HAVE BEEN PREPARED BY ME OR UNDER MY CLOSE PERSONAL SUPERVISION AND TO THE BEST OF MY KNOWLEDGE AND BELIEF THEY COMPLY WITH ALL CITY, STATE AND FEDERAL REQUIREMENTS, AND I AM NOT PROVIDING CONTRACT ADMINISTRATION.

CERTIFIED CORRECT

THIS DRAWING IS CONFIDENTIAL AND
NOT BE LOANED, REPRODUCED, COPIED,
EITHER WHOLLY OR IN PART, OR MADE
PUBLIC IN ANY MANNER WITHOUT THE
WRITTEN CONSENT OF HBSA II ARCHITECTS,
A PROFESSIONAL L.L.C. ALL RIGHTS OF
DESIGN OR INVENTION ARE RESERVED AND
WILL REMAIN THE SOLE PROPERTY OF HBSA

|  |                              | R                            | EVIS                         | ION                          | HIS                          | TOR                          | Υ                            |  |
|--|------------------------------|------------------------------|------------------------------|------------------------------|------------------------------|------------------------------|------------------------------|--|
|  | 4/27/2018                    | 5/4/2018                     | 5/11/2018                    | 5/18/2018                    | 5/25/2018                    | 6/1/2018                     | 6/8/2018                     |  |
|  | 11                           | 15                           | 8.1                          | 47                           | 15                           | 97                           | 21                           |  |
|  | L.I.S. #2 - CLOUD REVISION 1 | L.I.S. #2 - CLOUD REVISION 2 | L.I.S. #2 - CLOUD REVISION 3 | L.I.S. #2 - CLOUD REVISION 4 | L.I.S. #2 - CLOUD REVISION 5 | L.I.S. #2 - CLOUD REVISION 6 | L.I.S. #2 - CLOUD REVISION 7 |  |

PROJECT#: 1709
PHASE: DD
TEAM: Author
CHECKER: Checker
SCALE: AS NOTED
ISSUED: 4/20/2018

ISSUED: 4/20/2018
SHEET#:

A6.5

|                  |                          |                    | DOO                     | R SCHEI             | DULE - 11TH            | FLOOR           |            | ı         |             |                     |
|------------------|--------------------------|--------------------|-------------------------|---------------------|------------------------|-----------------|------------|-----------|-------------|---------------------|
| MARK             | FROM                     | 0                  | WIDTH                   | HEIGHT              | THICKNESS              | DOOR MATERIAL   | DOOR FRAME | DOOR TYPE | FIRE RATING | REMARKS             |
| 1100-1           | DATIL                    |                    | 3' - 0"                 | 7' - 0"             | 0' - 1 3/4"            | SCW             | HM         | ٧         | 20MIN       |                     |
| 1100-3           |                          |                    | 3' - 0"                 | 7' - 0"             | 01 4 0 (01)            | GL/WD<br>AL/ GL | MTL<br>AL  | P<br>H    |             | EXTERIOR STOREFRONT |
| 1101-1           | HOTEL ROOM               |                    | 2' - 10"                | 7' - 0"             | 0' - 1 3/8"            | AL/ GL<br>SCW   | AL<br>HM   | V         | 20MIN       | EXTERIOR STOREFRONT |
| 1101-2<br>1101-3 |                          | BATH               | 2' - 10"<br>3' - 0"     | 7' - 0"<br>7' - 0"  | 0' - 1 3/8"            | AL/ GL<br>WD/GL | AL<br>MTL  | H<br>P    |             | EXTERIOR STOREFRONT |
| 1101-4<br>1102-1 | HOTEL ROOM               | HOTEL ROOM         | 2' - 10"<br>3' - 0"     | 7' - 0"<br>7' - 0"  | 0' - 1 3/8"            | AL/ GL<br>SCW   | AL<br>HM   | H<br>V    | 20MIN       | EXTERIOR STOREFRONT |
| 1102-2<br>1102-3 | HOTEL ROOM               | BATH               | 3' - 0"<br>3' - 0"      | 7' - 0"<br>7' - 0"  |                        | GL/WD<br>SCW    | MTL<br>MTL | P<br>Y    |             |                     |
| 1102-4<br>1103-1 |                          | HOTEL ROOM         | 2' - 9 7/32"<br>3' - 0" | 6' - 11"<br>7' - 0" | 0' - 1 1/2"            | AL/GL<br>HM     | AL<br>HM   | K<br>V    | 20MIN       | EXTERIOR STOREFRONT |
| 1103-2<br>1103-3 |                          | BATH<br>HOTEL ROOM | 3' - 0"<br>3' - 0"      | 7' - 0"<br>7' - 0"  | 0 10/4                 | WD/GL<br>SCW    | MTL        | P<br>Y    | ZOWIII      |                     |
| 1103-4           | HOTEL ROOM               |                    | 6' - 8"<br>3' - 0"      | 7' - 0"             | 0' - 2"                | AL/ GL          | AL<br>HM   | Н         | COMMINI     | EXTERIOR STOREFRONT |
| 1104-1           |                          |                    | 3' - 0"                 | 7' - 0"             | 0' - 1 3/4"            | HM<br>WD/GL     | MTL        | V<br>P    | 20MIN       |                     |
| 1104-3<br>1104-4 | HOTEL ROOM               |                    | 3' - 0"<br>6' - 8"      | 7' - 0"<br>7' - 0"  | 0' - 2"                | SCW<br>AL/ GL   | MTL<br>AL  | Y<br>H    |             | EXTERIOR STOREFRONT |
| 1105-1<br>1105-2 | HOTEL ROOM               | BATH               | 3' - 0"<br>3' - 0"      | 7' - 0"<br>7' - 0"  | 0' - 1 3/4"            | SCW<br>WD/GL    | HM<br>MTL  | V<br>P    | 20MIN       |                     |
| 1105-3<br>1105-4 | HOTEL ROOM               | HOTEL ROOM         | 3' - 0"<br>6' - 8"      | 7' - 0"<br>7' - 0"  | 0' - 2"                | SCW<br>AL/ GL   | MTL<br>AL  | Y<br>H    |             | EXTERIOR STOREFRONT |
| 1106-1<br>1106-2 | BATH                     | HOTEL ROOM         | 3' - 0"<br>3' - 0"      | 7' - 0"<br>7' - 0"  | 0' - 1 3/4"            | SCW<br>WD/GL    | HM<br>MTL  | V<br>P    | 20MIN       |                     |
| 1106-3           |                          |                    | 3' - 0"<br>6' - 8"      | 7' - 0"<br>7' - 0"  | 0' - 2"                | SCW<br>AL/ GL   | MTL        | Y         |             | EXTERIOR STOREFRONT |
|                  | HOTEL ROOM               | ВАТН               | 3' - 0"<br>3' - 0"      | 7' - 0"<br>7' - 0"  | 0' - 1 3/4"            | SCW<br>WD/GL    | HM<br>MTL  | V         | 20MIN       | 22.3.110111         |
| 1107-3           | HOTEL ROOM               |                    | 3' - 0"<br>2' - 9 7/32" | 7' - 0"             | 0' - 1 1/2"            | SCW<br>AL/GL    | MTL        | Υ         |             | EVTEDIOD STODEEDONT |
| 1108-1           |                          | HOTEL ROOM         | 3' - 0"                 | 7' - 0"             | 0' - 1 3/4"            | SCW             | AL<br>HM   | K<br>V    | 20MIN       | EXTERIOR STOREFRONT |
| 1108-3           | HOTEL ROOM               |                    | 6' - 8"<br>3' - 0"      | 7' - 0"<br>7' - 0"  | 0' - 2"                | AL/ GL<br>WD/GL | AL<br>MTL  | H<br>P    |             | EXTERIOR STOREFRONT |
| 1108-4<br>1109-1 | BATH                     | HOTEL ROOM         | 6' - 0"<br>3' - 0"      | 7' - 0"<br>7' - 0"  | 0' - 1 3/4"            | GL/WD<br>SCW    | MTL<br>HM  | Q<br>V    | 20MIN       |                     |
| 1109-2<br>1109-3 | BATH                     |                    | 3' - 0"<br>3' - 0"      | 7' - 0"<br>7' - 0"  |                        | WD/GL<br>SCW    | MTL<br>MTL | P<br>Y    |             |                     |
|                  | HOTEL ROOM               |                    | 5' - 0"<br>3' - 0"      | 7' - 0"<br>7' - 0"  | 0' - 2"<br>0' - 1 3/4" | AL/ GL<br>SCW   | AL<br>HM   | H<br>V    | 20MIN       | EXTERIOR STOREFRONT |
|                  | HOTEL ROOM               | BATH               | 3' - 0"<br>3' - 0"      | 7' - 0"<br>7' - 0"  |                        | GL/WD<br>SCW    |            | P<br>Y    |             |                     |
|                  | HOTEL ROOM               | HOTEL ROOM         | 6' - 8"<br>3' - 0"      | 7' - 0"             | 0' - 2"                | AL/ GL<br>SCW   | AL<br>HM   | H         | 20MIN       | EXTERIOR STOREFRONT |
| 1111-2           | HOTEL ROOM               | BATH               | 3' - 0"<br>3' - 0"      | 7' - 0"<br>7' - 0"  | 0 - 1 3/4              | WD/GL           | MTL        | P<br>Y    | ZOIVIIIN    |                     |
|                  | HOTEL ROOM               |                    | 6' - 0"                 | 7' - 0"             | 0' - 2"                | SCW<br>AL/ GL   | MTL<br>AL  | Н         | 0014111     | EXTERIOR STOREFRONT |
| 1112-1           | BATH                     | HOTEL ROOM         | 3' - 0"                 | 7' - 0"             | 0' - 1 3/4"            | SCW<br>GL/WD    | HM<br>MTL  | V<br>P    | 20MIN       |                     |
|                  | HOTEL ROOM               |                    | 6' - 8"<br>3' - 0"      | 7' - 0"<br>7' - 0"  | 0' - 2"                | AL/ GL<br>SCW   | AL<br>HM   | H<br>V    | 20MIN       | EXTERIOR STOREFRONT |
| 1113-2<br>1113-3 | BATH<br>HOTEL ROOM       | HOTEL ROOM         | 3' - 0"<br>3' - 0"      | 7' - 0"<br>7' - 0"  |                        | WD/GL<br>SCW    | MTL<br>MTL | P<br>Y    |             |                     |
| 1113-4<br>1114-1 | HOTEL ROOM               |                    | 6' - 0"<br>3' - 0"      | 7' - 0"<br>7' - 0"  | 0' - 2"                | AL/ GL<br>SCW   | AL<br>HM   | H<br>V    | 20MIN       | EXTERIOR STOREFRONT |
| 1114-2<br>1114-3 | HOTEL ROOM               | BATH               | 3' - 0"<br>6' - 0"      | 7' - 0"<br>7' - 0"  | 0' - 2"                | GL/WD<br>AL/ GL | MTL<br>AL  | P<br>H    |             | EXTERIOR STOREFRONT |
| 1115-1<br>1115-2 | HOTEL ROOM               |                    | 3' - 0"<br>3' - 0"      | 7' - 0"<br>7' - 0"  | 0' - 1 3/4"            | SCW<br>WD/GL    | HM<br>MTL  | V<br>P    | 20MIN       |                     |
| 1115-3           | HOTEL ROOM               |                    | 3' - 0"<br>6' - 0"      | 7' - 0"<br>7' - 0"  | 0' - 2"                | SCW<br>AL/ GL   |            | Y<br>H    |             | EXTERIOR STOREFRONT |
| 1116-1<br>1116-2 |                          |                    | 3' - 0"<br>3' - 0"      | 7' - 0"<br>7' - 0"  | 0' - 1 3/4"            | SCW<br>GL/WD    | HM<br>MTL  | V<br>P    | 20MIN       |                     |
| 1116-3           | HOTEL ROOM               |                    | 3' - 0"<br>6' - 0"      | 7' - 0"<br>7' - 0"  | 0' - 2"                | SCW<br>AL/ GL   | MTL        | Y<br>H    |             | EXTERIOR STOREFRONT |
| 1117-1           | HOTEL ROOM               | LICTEL DOOM        | 3' - 0"                 | 7' - 0"             | 0' - 1 3/4"            | SCW             | НМ         | ٧         | 20MIN       | EXTERIOR STOREFRONT |
|                  | HOTEL ROOM               | HOTEL ROOM         | 3' - 0"                 | 7' - 0"             | 01 011                 | WD/GL<br>SCW    | MTL        | P<br>Y    |             | EVERDIOR OTOREROUE  |
| 1118-1           |                          |                    | 6' - 0"<br>3' - 0"      | 7' - 0"<br>7' - 0"  | 0' - 2"                | AL/ GL<br>HM    | AL<br>HM   | H<br>V    | 20MIN       | EXTERIOR STOREFRONT |
|                  | HOTEL ROOM               | BATH               | 3' - 0"<br>3' - 0"      | 7' - 0"<br>7' - 0"  |                        | GL/WD<br>SCW    | MTL<br>MTL | P<br>Y    |             |                     |
| 1118-4<br>1119-1 | HOTEL ROOM               | HOTEL ROOM         | 6' - 0"<br>3' - 0"      | 7' - 0"<br>7' - 0"  | 0' - 2"                | AL/ GL<br>SCW   | AL<br>HM   | H<br>V    | 20MIN       | EXTERIOR STOREFRONT |
| 1119-2<br>1119-3 | HOTEL ROOM               | HOTEL ROOM<br>BATH | 3' - 0"<br>3' - 0"      | 7' - 0"<br>7' - 0"  |                        | SCW<br>WD/GL    | MTL<br>MTL | Y<br>P    |             |                     |
| 1119-4<br>1120-1 |                          | HOTEL ROOM         | 6' - 8"<br>3' - 0"      | 7' - 0"<br>7' - 0"  | 0' - 2"<br>0' - 1 3/4" | AL/ GL<br>SCW   | AL<br>HM   | H<br>V    | 20MIN       | EXTERIOR STOREFRONT |
| 1120-2<br>1120-3 | BATH                     | HOTEL ROOM         | 3' - 0"<br>3' - 0"      | 7' - 0"<br>7' - 0"  |                        | GL/WD<br>SCW    | MTL        | P<br>Y    |             |                     |
| 1120-4           | HOTEL ROOM               |                    | 6' - 0"<br>3' - 0"      | 7' - 0"<br>7' - 0"  | 0' - 2"                | AL/ GL<br>SCW   | AL<br>HM   | H         | 20MIN       | EXTERIOR STOREFRONT |
| 1121-2           | HOTEL ROOM               |                    | 3' - 0"<br>3' - 0"      | 7' - 0"             | 0 1 0/4                | GL/WD<br>SCW    | MTL        | Р         | LOIVIIIN    |                     |
|                  | HOTEL ROOM               |                    | 6' - 0"                 | 7' - 0"<br>7' - 0"  | 0' - 2"                | AL/ GL          | MTL<br>AL  | Y<br>H    | 002.41      | EXTERIOR STOREFRONT |
| 1122-1           |                          |                    | 3' - 0"                 | 7' - 0"<br>7' - 0"  | 0' - 1 3/4"            | SCW<br>GL/WD    | MTL        | V<br>P    | 20MIN       |                     |
| 1122-4           |                          |                    | 3' - 0"<br>6' - 0"      | 7' - 0"             | 0' - 2"                | SCW<br>AL/ GL   | MTL<br>AL  | Y<br>H    | 651         | EXTERIOR STOREFRONT |
| 1123-2           |                          | ВАТН               | 3' - 0"<br>3' - 0"      | 7' - 0"<br>7' - 0"  | 0' - 1 3/4"            | SCW<br>GL/WD    | HM<br>MTL  | V<br>P    | 20MIN       |                     |
|                  | HOTEL ROOM<br>HOTEL ROOM |                    | 3' - 0"<br>6' - 0"      | 7' - 0"<br>7' - 0"  | 0' - 2"                | SCW<br>AL/ GL   | MTL<br>AL  | Y<br>H    |             | EXTERIOR STOREFRONT |
| 1124-1<br>1124-2 |                          |                    | 3' - 0"<br>3' - 0"      | 7' - 0"<br>7' - 0"  | 0' - 1 3/4"            | SCW<br>GL/WD    | НМ         | V         | 20MIN       | -                   |
| 1124-3           | HOTEL ROOM HOTEL ROOM    |                    | 3' - 0"<br>6' - 0"      | 7' - 0"<br>7' - 0"  | 0' - 2"                | SCW<br>AL/ GL   |            | Y<br>H    |             | EXTERIOR STOREFRONT |
|                  | HOTEL ROOM               | HOTEL ROOM         | 3' - 0"<br>2' - 8"      | 7' - 0"<br>7' - 0"  | 0' - 1 3/4"            | SCW<br>SCW      | HM<br>WD   | V<br>Y    | 20MIN       | NON OTORET HOINT    |
| 1125-3           |                          |                    | 3' - 0"                 | 7' - 0"             | 0' 0"                  | GL/WD           | MTL        | Р         |             | EVTEDIOD OTODESDOUT |
| レント-/            | HOTEL ROOM               | I                  | 6' - 0"                 | 7' - 0"             | 0' - 2"                | AL/ GL          | AL         | Н         | 1           | EXTERIOR STOREFRONT |
| 1126-1           | HOTEL ROOM               | D. A               | 3' - 0"<br>3' - 0"      | 7' - 0"<br>7' - 0"  | 0' - 1 3/4"            | SCW<br>GL/WD    | HM<br>MTL  | V<br>P    | 20MIN       |                     |

|  |  |  | DOOF   | R SCHEI   | DULE - 11TH  | FLOOR   |   |  |                                  |  |
|--|--|--|--|---|--|---|---|--|----------------------------------|--|
| MARK   | FROM   | Q <u>+</u>   | WIDTH  | НЕІСНТ  | THICKNESS  | DOOR MATERIAL   | DOOR FRAME  | DOOR TYPE  | FIRE RATING                      | REMARKS  |
| 1127-1   | HOTEL ROOM   |  | 6' - 0"<br>3' - 0"   | 7' - 0"<br>7' - 0"  | 0' - 2"<br>0' - 1 3/4"   | AL/ GL<br>SCW   |   | H<br>V   | 20MIN                            | EXTERIOR STOREFRON   |
|  | HOTEL ROOM   | BATH   | 3' - 0"<br>3' - 0"   | 7' - 0"<br>7' - 0"  |  | WD/GL<br>SCW  |   | P<br>Y   |                                  |  |
|  | HOTEL ROOM   | HOTEL ROOM   | 6' - 0"<br>3' - 0"   | 7' - 0"<br>7' - 0"  | 0' - 2"<br>0' - 1 3/4"   | AL/ GL<br>SCW   | AL<br>HM  | H<br>V   | 20MIN                            | EXTERIOR STOREFRON   |
| 1128-2   | BATH   |  | 3' - 0"  | 7' - 0"   | 0 - 1 3/4  | GL/WD   | MTL   | Р  | ZUIVIIIN                         |  |
|  | HOTEL ROOM   |  | 3' - 0"<br>6' - 0"   | 7' - 0"<br>7' - 0"  | 0' - 2"  | SCW<br>AL/ GL   | MTL<br>AL   | Y<br>H   |                                  | EXTERIOR STOREFRON   |
| 1129-1<br>1129-2   | BATH   |  | 3' - 0"<br>3' - 0"   | 7' - 0"<br>7' - 0"  | 0' - 1 3/4"  | SCW<br>WD/GL  | HM<br>MTL   | V<br>P   | 20MIN                            |  |
| 1129-3   | HOTEL ROOM   | HOTEL ROOM   | 3' - 0"  | 7' - 0"   |  | SCW   | MTL   | Υ  |                                  |  |
|  | HOTEL ROOM   |  | 6' - 0"<br>3' - 0"   | 7' - 0"<br>7' - 0"  | 0' - 2"  | AL/ GL<br>SCW   | AL<br>HM  | H<br>V   | 20MIN                            | EXTERIOR STOREFRON   |
| 1130-2   | HOTEL ROOM<br>HOTEL ROOM   | BATH   | 3' - 0"<br>3' - 0"   | 7' - 0"<br>7' - 0"  |  | GL/WD<br>SCW  |   | P<br>Y   |                                  |  |
| 1130-4   | HOTEL ROOM   |  | 6' - 0"  | 7' - 0"   | 0' - 2"  | AL/ GL  | AL  | Н  |                                  | EXTERIOR STOREFRON   |
|  | HOTEL ROOM   | BATH   | 3' - 0"<br>3' - 0"   | 7' - 0"<br>7' - 0"  | 0' - 1 3/4"  | SCW<br>WD/GL  | HM<br>MTL   | V<br>P   | 20MIN                            |  |
| 1131-3   | HOTEL ROOM   |  | 6' - 0"  | 7' - 0"   | 0' - 2"<br>0' - 1 3/4"   | AL/ GL  | AL  | Н  | 0004101                          | EXTERIOR STOREFRON   |
| 1132-1<br>1132-2   | HOTEL ROOM   |  | 3' - 0"<br>3' - 0"   | 7' - 0"<br>7' - 0"  |  | SCW<br>GL/WD  | HM<br>MTL   | V<br>P   | 20MIN                            |  |
|  | HOTEL ROOM   |  | 6' - 0"<br>3' - 0"   | 7' - 0"<br>7' - 0"  | 0' - 2"  | AL/ GL<br>SCW   | AL<br>HM  | H<br>V   | 20MIN                            | EXTERIOR STOREFRON   |
| 1133-2   | HOTEL ROOM   | BATH   | 3' - 0"  | 7' - 0"   |  | SCW   | MTL   | Р  |                                  | EVERNOR OF OPERAN  |
| 1133-3<br>1134-1   | HOTEL ROOM   | HOTEL ROOM   | 6' - 8"<br>3' - 0"   | 7' - 0"<br>7' - 0"  | 0' - 2"  | AL/ GL<br>SCW   | AL<br>HM  | H<br>V   | 20MIN                            | EXTERIOR STOREFRON   |
|  | HOTEL ROOM<br>HOTEL ROOM   | BATH   | 3' - 0"<br>6' - 8"   | 7' - 0"<br>7' - 0"  | 0' - 2"  | WD/GL<br>AL/ GL   | MTL<br>AL   | P<br>H   |                                  | EXTERIOR STOREFRON   |
| 1135-1   | HOTEL NOOW   | HOTEL ROOM   | 3' - 0"  | 7' - 0"   | 0' - 1 3/4"  | SCW   | НМ  | ٧  | 20MIN                            | EXTERIOR STOREFRON   |
| 1135-2<br>1135-3   | HOTEL ROOM   | HOTEL ROOM<br>BATH   | 3' - 0"<br>3' - 0"   | 7' - 0"<br>7' - 0"  |  | SCW<br>GL/WD  | MTL<br>MTL  |  |                                  |  |
| 1135-4   | HOTEL ROOM   |  | 6' - 8"  | 7' - 0"   | 0' - 2"  | AL/ GL  | AL  | Н  |                                  | EXTERIOR STOREFRON   |
| 1135-5<br>1136-1   | HOTEL ROOM   | HOTEL ROOM   | 6' - 8"<br>3' - 0"   | 7' - 0"<br>7' - 0"  | 0' - 2"  | AL/ GL<br>SCW   |   | H<br>V   | 20MIN                            | EXTERIOR STOREFRON   |
| 1136-2   | HOTEL ROOM   | HOTEL ROOM   | 3' - 0"<br>3' - 0"   | 7' - 0"<br>7' - 0"  |  | SCW<br>WD/GL  | MTL<br>MTL  | Υ  |                                  |  |
| 1136-4   | HOTEL ROOM   |  | 6' - 8"  | 7' - 0"   | 0' - 2"  | AL/ GL  | AL  | Н  |                                  | EXTERIOR STOREFRON   |
| 1137-1<br>1137-2   | BATH   | HOTEL ROOM   |  | 7' - 0"<br>7' - 0"  | 0' - 1 3/4"  | SCW<br>GL/WD  | HM<br>MTL   | V<br>P   | 20MIN                            |  |
| 1137-3   | HOTEL ROOM   | TIOTELTIOON  | 3' - 0"  | 7' - 0"   |  | SCW   | MTL   | Υ  |                                  |  |
|  | HOTEL ROOM   |  | 6' - 8"<br>3' - 0"   | 7' - 0"<br>7' - 0"  | 0' - 2"  | AL/ GL<br>SCW   |   | H<br>V   | 20MIN                            | EXTERIOR STOREFRON   |
| 1138-2   | HOTEL ROOM   | BATH   | 3' - 0"  | 7' - 0"   |  | GL/WD   | MTL   |  |                                  |  |
|  | HOTEL ROOM   |  | 3' - 0"<br>6' - 8"   | 7' - 0"<br>7' - 0"  | 0' - 2"  | SCW<br>AL/ GL   | MTL<br>AL   | Y<br>H   |                                  | EXTERIOR STOREFRON   |
| 1139-1<br>1139-2   | DATU   | HOTEL ROOM   |  | 7' - 0"<br>7' - 0"  | 0' - 1 3/4"  | SCW<br>GL/WD  | HM<br>MTL   |  | 20MIN                            |  |
| 1139-3   | HOTEL ROOM   | HOTEL ROOM   | 3' - 0"  | 7' - 0"   |  | SCW   | MTL   | Υ  |                                  |  |
|  | HOTEL ROOM   |  | 6' - 8"<br>3' - 0"   |   | 0' - 2"  | AL/ GL<br>SCW   |   | H<br>V   | 20MIN                            | EXTERIOR STOREFRON   |
| 1140-2   | HOTEL ROOM   | BATH   | 3' - 0"  | 7' - 0"   |  | GL/WD   |   | P  |                                  |  |
|  | HOTEL ROOM<br>HOTEL ROOM   |  | 3' - 0"<br>6' - 8"   | 7' - 0"<br>7' - 0"  | 0' - 2"  | SCW<br>AL/ GL   | MTL<br>AL   | Y<br>H   |                                  | EXTERIOR STOREFRON   |
| 1141-1<br>1141-2   | HOTEL ROOM   | HOTEL ROOM   | 3' - 0"<br>6' - 0"   | 7' - 0"<br>7' - 0"  | 0' - 1 3/4"  | SCW<br>AL/ GL   | HM<br>AL  | V<br>H   | 20MIN                            | EXTERIOR STOREFRON   |
| 1141-3   | BATH   | HOTEL ROOM   | 3' - 0"  | 7' - 0"   |  | GL/WD   | MTL   | Р  |                                  |  |
| 1142-1<br>1142-2   | BATH   | HOTEL ROOM   |  | 7' - 0"   | 0' - 1 3/4"  | SCW<br>GL/WD  | MTL   | Р  | 20MIN                            |  |
|  | HOTEL ROOM   |  | 3' - 0"<br>6' - 8"   | 7' - 0"<br>7' - 0"  | 0' - 2"  | SCW<br>AL/ GL   | MTL<br>AL   | Y<br>H   |                                  | EXTERIOR STOREFRON   |
| 1143-1   |  | HOTEL ROOM   | 3' - 0"  | 7' - 0"   | 0' - 1 3/4"  | SCW   | НМ  | ٧  | 20MIN                            | EXTERIOR GYORIEI FION  |
| 1143-2<br>1143-3   | BATH   | HOTEL ROOM   |  | 7' - 0"<br>7' - 0"  | 0' - 2"  | WD/GL<br>AL/ GL   | MTL<br>AL   | P<br>H   |                                  | EXTERIOR STOREFRON   |
| 1143-4   | HOTEL BOOM   | HOTEL ROOM   |  | 7' - 0"   | 0' - 1 3/8"  | SCW   | MTL   | Υ  |                                  |  |
| 1144-1   | HOTEL ROOM<br>HOTEL ROOM   |  | 3' - 0"  | 7' - 0"<br>7' - 0"  | 0' - 1 3/8"  | AL/ GL<br>SCW   | НМ  | H<br>V   | 20MIN                            | EXTERIOR STOREFRON   |
|  | HOTEL ROOM   | BATH   | 3' - 0"<br>3' - 0"   | 7' - 0"<br>7' - 0"  |  | WD/GL<br>SCW  |   | P<br>Y   |                                  |  |
| 1145-1   | HOTEL ROOM   | HOTEL BOOK   | 3' - 0"  | 7' - 0"   | 0' - 1 3/4"  | SCW   | НМ  | ٧  | 20MIN                            |  |
| 1145-2<br>1145-3   |  | HOTEL ROOM   |  | 7' - 0"<br>7' - 0"  | 0' - 1 1/2"<br>0' - 1 3/8"   | SCW<br>AL/ GL   | AL  | Y<br>H   |                                  | EXTERIOR STOREFRON   |
| 1145-4   | BATH<br>HOTEL ROOM   | HOTEL ROOM   |  | 7' - 0"<br>7' - 0"  | 0' - 1 3/8"  | GL/WD<br>AL/ GL   | MTL<br>AL   |  |                                  | EXTERIOR STOREFRON   |
|  |  | I  |  | 7' - 0"   | 0' - 1 3/4"  | SCW   | НМ  | ٧  | 20MIN                            |  |
|  |  | HOTEL ROOM   |  |   | 0' - 1 3/8"  |   | AL  | Н  |                                  | EXTERIOR STOREFRON   |
| 1146-2   | HOTEL ROOM   |  | 3' - 0"<br>3' - 0"   | 7' - 0"<br>7' - 0"  | 0 - 1 3/6  | AL/ GL<br>WD/GL   |   | Р  |                                  |  |
| 1146-2<br>1146-3<br>1147-1   | HOTEL ROOM<br>HOTEL ROOM<br>HOTEL ROOM   | BATH   | 3' - 0"<br>3' - 0"<br>3' - 0"  | 7' - 0"<br>7' - 0"  | 0' - 1 3/4"  | WD/GL<br>SCW  | MTL<br>HM   | ٧  | 20MIN                            |  |
| 1146-2<br>1146-3<br>1147-1<br>1147-3   | HOTEL ROOM<br>HOTEL ROOM   |  | 3' - 0"<br>3' - 0"<br>3' - 0"  | 7' - 0"   |  | WD/GL   | MTL<br>HM<br>MTL  | ٧  | 20MIN                            | EXTERIOR STOREFROM   |
| 1146-2<br>1146-3<br>1147-1<br>1147-3<br>1147-5<br>1148-1   | HOTEL ROOM<br>HOTEL ROOM<br>HOTEL ROOM<br>BATH<br>HOTEL ROOM   | BATH HOTEL ROOM  | 3' - 0"<br>3' - 0"<br>3' - 0"<br>3' - 0"<br>2' - 10"<br>3' - 0"  | 7' - 0"<br>7' - 0"<br>7' - 0"<br>7' - 0"<br>7' - 0"   | 0' - 1 3/4"  | WD/GL<br>SCW<br>GL/WD<br>AL/ GL<br>SCW  | MTL<br>HM<br>MTL<br>AL<br>HM  | V<br>P<br>H<br>V   | 20MIN<br>20MIN                   | EXTERIOR STOREFROM   |
| 1146-2<br>1146-3<br>1147-1<br>1147-3<br>1147-5<br>1148-1<br>1148-2<br>1148-3   | HOTEL ROOM HOTEL ROOM BATH HOTEL ROOM HOTEL ROOM   | BATH HOTEL ROOM  | 3' - 0"<br>3' - 0"<br>3' - 0"<br>3' - 0"<br>2' - 10"<br>3' - 0"<br>3' - 0"   | 7' - 0"<br>7' - 0"<br>7' - 0"<br>7' - 0"<br>7' - 0"<br>7' - 0"<br>7' - 0"   | 0' - 1 3/4"<br>0' - 1 3/8"<br>0' - 1 3/4"  | WD/GL<br>SCW<br>GL/WD<br>AL/ GL<br>SCW<br>GL/WD<br>SCW  | MTL<br>HM<br>MTL<br>AL<br>HM<br>MTL<br>MTL  | V<br>P<br>H  |                                  |  |
| 1146-2<br>1146-3<br>1147-1<br>1147-3<br>1147-5<br>1148-1<br>1148-2<br>1148-3<br>1148-4   | HOTEL ROOM HOTEL ROOM BATH HOTEL ROOM HOTEL ROOM   | BATH HOTEL ROOM HOTEL ROOM BATH  | 3' - 0"<br>3' - 0"<br>3' - 0"<br>3' - 0"<br>2' - 10"<br>3' - 0"  | 7' - 0"<br>7' - 0"<br>7' - 0"<br>7' - 0"<br>7' - 0"<br>7' - 0"  | 0' - 1 3/4"  | WD/GL<br>SCW<br>GL/WD<br>AL/ GL<br>SCW<br>GL/WD<br>SCW<br>AL/ GL  | MTL HM MTL AL HM MTL MTL ATL AL   | V<br>P<br>H<br>V<br>P                                    |                                  |  |
| 1146-2<br>1146-3<br>1147-1<br>1147-3<br>1147-5<br>1148-1<br>1148-2<br>1148-3<br>1148-4<br>1149-1   | HOTEL ROOM HOTEL ROOM BATH HOTEL ROOM HOTEL ROOM HOTEL ROOM HOTEL ROOM HOTEL ROOM BATH   | BATH HOTEL ROOM HOTEL ROOM BATH  | 3' - 0"<br>3' - 0"<br>3' - 0"<br>2' - 10"<br>3' - 0"<br>3' - 0"<br>3' - 0"<br>3' - 0"<br>3' - 0"<br>3' - 0"  | 7' - 0"<br>7' - 0"  | 0' - 1 3/4"<br>0' - 1 3/8"<br>0' - 1 3/4"<br>0' - 1 3/8"<br>0' - 1 3/4"  | WD/GL SCW GL/WD AL/ GL SCW GL/WD SCW AL/ GL SCW SCW   | MTL HM MTL AL HM MTL MTL HL HM MTL AL HM  | V<br>P<br>H<br>V<br>P<br>Y<br>Q<br>V                     | 20MIN                            | EXTERIOR STOREFRON   |
| 1146-2<br>1146-3<br>1147-1<br>1147-3<br>1147-5<br>1148-1<br>1148-2<br>1148-3<br>1148-4<br>1149-1<br>1149-2<br>1149-3   | HOTEL ROOM HOTEL ROOM BATH HOTEL ROOM HOTEL ROOM HOTEL ROOM HOTEL ROOM   | BATH HOTEL ROOM HOTEL ROOM BATH HOTEL ROOM   | 3' - 0"<br>3' - 0"<br>3' - 0"<br>2' - 10"<br>3' - 0"<br>3' - 0"<br>3' - 0"<br>3' - 0"<br>3' - 0"<br>3' - 0"<br>3' - 0"   | 7' - 0"<br>7' - 0"   | 0' - 1 3/4"<br>0' - 1 3/8"<br>0' - 1 3/4"<br>0' - 1 3/8"   | WD/GL<br>SCW<br>GL/WD<br>AL/ GL<br>SCW<br>GL/WD<br>SCW<br>AL/ GL<br>SCW   | MTL HM MTL AL HM MTL AL HHL AL HM AL HAL  | V<br>P<br>H<br>V<br>P<br>Y<br>Q                          | 20MIN                            | EXTERIOR STOREFRON   |
| 1146-2<br>1146-3<br>1147-1<br>1147-3<br>1147-5<br>1148-1<br>1148-2<br>1148-3<br>1148-4<br>1149-1<br>1149-2<br>1149-3<br>1149-4<br>1150-1   | HOTEL ROOM HOTEL ROOM BATH HOTEL ROOM BATH HOTEL ROOM  | BATH  HOTEL ROOM  HOTEL ROOM  BATH  HOTEL ROOM  HOTEL ROOM   | 3' - 0"<br>3' - 0"<br>3' - 0"<br>2' - 10"<br>3' - 0"<br>3' - 0"   | 7' - 0" 7' - 0" 7' - 0" 7' - 0" 7' - 0" 7' - 0" 7' - 0" 7' - 0" 7' - 0" 7' - 0" 7' - 0" 7' - 0" 7' - 0" 7' - 0"   | 0' - 1 3/4"<br>0' - 1 3/8"<br>0' - 1 3/4"<br>0' - 1 3/8"<br>0' - 1 3/4"  | WD/GL SCW GL/WD AL/ GL SCW GL/WD SCW AL/ GL SCW SCW SCW SCW SCW SCW   | MTL HM MTL AL HM MTL AL HM AL HM MTL AL HM MTL AL HM MTL AL   | V<br>P<br>H<br>V<br>P<br>Q<br>V<br>P<br>Q<br>V           | 20MIN                            | EXTERIOR STOREFROM   |
| 1146-2<br>1146-3<br>1147-1<br>1147-3<br>1147-5<br>1148-1<br>1148-2<br>1148-3<br>1148-4<br>1149-1<br>1149-2<br>1149-3<br>1149-4<br>1150-1<br>1150-2   | HOTEL ROOM HOTEL ROOM BATH HOTEL ROOM HOTEL ROOM HOTEL ROOM HOTEL ROOM BATH HOTEL ROOM HOTEL ROOM  | BATH  HOTEL ROOM  HOTEL ROOM  HOTEL ROOM  HOTEL ROOM  HOTEL ROOM   | 3' - 0"<br>3' - 0"<br>3' - 0"<br>2' - 10"<br>3' - 0"<br>3' - 0"<br>2' - 10"                                 | 7' - 0" 7' - 0" 7' - 0" 7' - 0" 7' - 0" 7' - 0" 7' - 0" 7' - 0" 7' - 0" 7' - 0" 7' - 0" 7' - 0" 7' - 0" 7' - 0" 7' - 0" 7' - 0"   | 0' - 1 3/4"<br>0' - 1 3/8"<br>0' - 1 3/4"<br>0' - 1 3/8"<br>0' - 1 3/4"  | WD/GL SCW GL/WD AL/ GL SCW GL/WD SCW AL/ GL SCW SCW SCW AL/ GL SCW AL/ GL SCW AL/ GL                                      | MTL HM MTL AL HM MTL AL HM MTL AL HM MTL AL HM AL MTL AL  | V<br>P<br>H<br>V<br>P<br>Y<br>Q<br>V<br>P<br>Q<br>Y<br>V | 20MIN<br>20MIN                   | EXTERIOR STOREFRON   |
| 1146-2<br>1146-3<br>1147-1<br>1147-3<br>1147-5<br>1148-1<br>1148-2<br>1148-3<br>1148-4<br>1149-1<br>1149-2<br>1149-3<br>1149-4<br>1150-1<br>1150-2<br>1150-3<br>1150-4   | HOTEL ROOM HOTEL ROOM BATH HOTEL ROOM HOTEL ROOM HOTEL ROOM HOTEL ROOM HOTEL ROOM HOTEL ROOM BATH HOTEL ROOM BATH HOTEL ROOM BATH  | BATH  HOTEL ROOM  HOTEL ROOM  HOTEL ROOM  HOTEL ROOM  HOTEL ROOM  HOTEL ROOM                               | 3' - 0" 3' - 0" 3' - 0" 3' - 0" 2' - 10" 3' - 0" 3' - 0" 3' - 0" 3' - 0" 3' - 0" 3' - 0" 3' - 0" 3' - 0" 3' - 0" 3' - 0" 3' - 0" 3' - 0" 3' - 0" 3' - 0"                                 | 7' - 0" 7' - 0" 7' - 0" 7' - 0" 7' - 0" 7' - 0" 7' - 0" 7' - 0" 7' - 0" 7' - 0" 7' - 0" 7' - 0" 7' - 0" 7' - 0" 7' - 0" 7' - 0" 7' - 0" 7' - 0" 7' - 0"   | 0' - 1 3/4"<br>0' - 1 3/8"<br>0' - 1 3/4"<br>0' - 1 3/4"<br>0' - 1 3/8"<br>0' - 1 3/4"<br>0' - 1 3/8"                | WD/GL SCW GL/WD AL/ GL SCW GL/WD SCW AL/ GL SCW SCW AL/ GL SCW SCW AL/ GL SCW SCW SCW SCW SCW SCW SCW SCW                 | MTL HM MTL AL MTL AL HM MTL HM MTL  | V P H V P Y Q V P Q Y V P H Y                            | 20MIN<br>20MIN<br>20MIN          | EXTERIOR STOREFRON   |
| 1146-3<br>1147-1<br>1147-3<br>1147-5<br>1148-1<br>1148-2<br>1148-3<br>1148-4<br>1149-1<br>1149-2<br>1149-3<br>1149-4<br>1150-1<br>1150-2<br>1150-3<br>1150-4<br>1151-1   | HOTEL ROOM HOTEL ROOM HOTEL ROOM BATH HOTEL ROOM HOTEL ROOM HOTEL ROOM HOTEL ROOM HOTEL ROOM BATH HOTEL ROOM HOTEL ROOM HOTEL ROOM HOTEL ROOM HOTEL ROOM HOTEL ROOM  | BATH  HOTEL ROOM                   | 3' - 0" 3' - 0" 3' - 0" 3' - 0" 2' - 10" 3' - 0" 3' - 0" 3' - 0" 3' - 0" 3' - 0" 3' - 0" 3' - 0" 3' - 0" 3' - 0" 3' - 0" 3' - 0" 3' - 0" 3' - 0" 6' - 0"                                 | 7' - 0"                                 | 0' - 1 3/4"<br>0' - 1 3/8"<br>0' - 1 3/4"<br>0' - 1 3/4"<br>0' - 1 3/4"<br>0' - 1 3/4"                               | WD/GL SCW GL/WD AL/ GL SCW GL/WD SCW AL/ GL SCW SCW SCW AL/ GL SCW SCW SCW GL/WD AL/ GL SCW SCW GL/WD AL/ GL              | MTL HM MTL AL HM MTL AL HM MTL AL HM MTL AL HM HM HTL AL HM MTL HM MTL AL   | V P H V P Y Q V P Q V P V V H                            | 20MIN<br>20MIN                   | EXTERIOR STOREFRON  EXTERIOR STOREFRON  EXTERIOR STOREFRON   |
| 1146-2<br>1146-3<br>1147-1<br>1147-3<br>1147-5<br>1148-1<br>1148-2<br>1148-3<br>1148-4<br>1149-1<br>1149-2<br>1149-3<br>1149-4<br>1150-1<br>1150-2<br>1150-3<br>1150-4<br>1151-1   | HOTEL ROOM HOTEL ROOM HOTEL ROOM BATH HOTEL ROOM HOTEL ROOM HOTEL ROOM BATH HOTEL ROOM BATH HOTEL ROOM HOTEL ROOM HOTEL ROOM HOTEL ROOM HOTEL ROOM HOTEL ROOM  | BATH  HOTEL ROOM                   | 3' - 0" 3' - 0" 3' - 0" 3' - 0" 2' - 10" 3' - 0" 3' - 0" 3' - 0" 3' - 0" 3' - 0" 3' - 0" 3' - 0" 3' - 0" 3' - 0" 3' - 0" 3' - 0" 3' - 0" 3' - 0" 3' - 0" 3' - 0" 3' - 0" 3' - 0" 3' - 0" | 7' - 0"                         | 0' - 1 3/4"<br>0' - 1 3/8"<br>0' - 1 3/4"<br>0' - 1 3/4" | WD/GL SCW GL/WD AL/ GL SCW GL/WD SCW AL/ GL SCW SCW AL/ GL SCW SCW AL/ GL SCW SCW AL/ GL SCW AL/ GL SCW AL/ GL SCW AL/ GL | MTL HM MTL AL HM MTL HM MTL AL MTL AL MTL AL MTL HM MTL AL MTL HM                       | V P H V P Q V P P H Y V H P P                            | 20MIN<br>20MIN<br>20MIN          | EXTERIOR STOREFRON  EXTERIOR STOREFRON  EXTERIOR STOREFRON  EXTERIOR STOREFRON   |
| 1146-2<br>1146-3<br>1147-1<br>1147-3<br>1147-5<br>1148-1<br>1148-2<br>1148-3<br>1148-4<br>1149-1<br>1149-2<br>1149-3<br>1149-4<br>1150-1<br>1150-2<br>1150-3<br>1150-4<br>1151-1<br>1151-2<br>1151-3<br>1151-5<br>1152-1           | HOTEL ROOM HOTEL ROOM HOTEL ROOM BATH HOTEL ROOM | BATH  HOTEL ROOM                   | 3' - 0" 3' - 0" 3' - 0" 3' - 0" 2' - 10" 3' - 0" 3' - 0" 3' - 0" 3' - 0" 3' - 0" 3' - 0" 3' - 0" 3' - 0" 3' - 0" 3' - 0" 3' - 0" 3' - 0" 2' - 10" 3' - 0" 3' - 0" 2' - 10" 3' - 0"       | 7' - 0" | 0' - 1 3/4"<br>0' - 1 3/8"<br>0' - 1 3/4"<br>0' - 2"     | WD/GL SCW GL/WD AL/ GL SCW GL/WD SCW AL/ GL SCW SCW SCW AL/ GL SCW SCW SCW GL/WD AL/ GL SCW SCW GL/WD AL/ GL              | MTL HM MTL AL HM MTL AL HM MTL AL HM MTL AL HM HM HTL AL HM MTL HM MTL AL   | V P H V V P P H Y V V H P H V V                          | 20MIN<br>20MIN<br>20MIN          | EXTERIOR STOREFRON  EXTERIOR STOREFRON  EXTERIOR STOREFRON  EXTERIOR STOREFRON  EXTERIOR STOREFRON   |
| 1146-2<br>1146-3<br>1147-1<br>1147-3<br>1147-5<br>1148-1<br>1148-2<br>1148-3<br>1148-4<br>1149-1<br>1149-2<br>1149-3<br>1149-4<br>1150-1<br>1150-2<br>1150-3<br>1150-4<br>1151-1<br>1151-2<br>1151-3<br>1151-5<br>1152-1<br>1152-2 | HOTEL ROOM HOTEL ROOM HOTEL ROOM BATH HOTEL ROOM HOTEL ROOM HOTEL ROOM HOTEL ROOM BATH HOTEL ROOM                             | BATH  HOTEL ROOM  BATH  HOTEL ROOM | 3' - 0" 3' - 0" 3' - 0" 3' - 0" 2' - 10" 3' - 0" 3' - 0" 3' - 0" 3' - 0" 3' - 0" 3' - 0" 3' - 0" 3' - 0" 3' - 0" 3' - 0" 3' - 0" 3' - 0" 3' - 0" 2' - 10" 3' - 0" 2' - 10"               | 7' - 0"         | 0' - 1 3/4"<br>0' - 1 3/8"<br>0' - 1 3/4"<br>0' - 2"     | WD/GL SCW GL/WD AL/ GL SCW GL/WD SCW AL/ GL SCW SCW AL/ GL SCW SCW GL/WD AL/ GL SCW GL/WD AL/ GL SCW                      | MTL HM MTL AL MTL HM MTL AL MTL AL MTL AL AL MTL AL | V P H V P Y Q V P Q Y V H H H H                          | 20MIN<br>20MIN<br>20MIN<br>20MIN | EXTERIOR STOREFRON  EXTERIOR STOREFRON  EXTERIOR STOREFRON  EXTERIOR STOREFRON  EXTERIOR STOREFRON  EXTERIOR STOREFRON  EXTERIOR STOREFRON |



SINCE 1961

THESE PLANS AND SPECIFICATIONS HAVE
BEEN PREPARED BY ME OR UNDER MY
CLOSE PERSONAL SUPERVISION AND TO
THE BEST OF MY KNOWLEDGE AND
BELIEF THEY COMPLY WITH ALL CITY,
STATE AND FEDERAL REQUIREMENTS, AND
I AM NOT PROVIDING CONTRACT
ADMINISTRATION. CERTIFIED CORRECT

|                              | R                            | EVIS                         |                              |                              | TOR                          | Y<br>I                       |   |
|------------------------------|------------------------------|------------------------------|------------------------------|------------------------------|------------------------------|------------------------------|---|
| 4/27/2018                    | 5/4/2018                     | 5/11/2018                    | 5/18/2018                    | 5/25/2018                    | 6/1/2018                     | 6/8/2018                     |   |
| L.i.S. #2 - CLOUD REVISION 1 | L.I.S. #2 - CLOUD REVISION 2 | L.I.S. #2 - CLOUD REVISION 3 | L.I.S. #2 - CLOUD REVISION 4 | L.I.S. #2 - CLOUD REVISION 5 | L.I.S. #2 - CLOUD REVISION 6 | L.I.S. #2 - CLOUD REVISION 7 |   |
| -                            | 2                            | က                            | 4                            | 2                            | 9                            | 7                            | 8 |

SCHEDULES PROJECT#: 1709
PHASE: DD
TEAM: Author CHECKER: Checker SCALE: AS NOTED

ISSUED: 4/20/2018
SHEET#:


A6.6

| 1007             |                 |                    | 0 0                |                    |             | 41./01          |           |            |           |                        |
|------------------|-----------------|--------------------|--------------------|--------------------|-------------|-----------------|-----------|------------|-----------|------------------------|
| 1207-4           | HOTEL ROOM      | LIOTEL BOOM        | 2' - 9 7/32"       |                    | 0' - 1 1/2" | AL/GL           | AL        | K          | 00141     | EXTERIOR STOREFRONT    |
| 1208-1           |                 | HOTEL ROOM         | 3' - 0"            | 7' - 0"            | 0' - 1 3/4" | SCW             | НМ        | V          | 20MI<br>N |                        |
| 1208-2           | HOTEL ROOM      |                    | 6' - 8"            | 7' - 0"            | 0' - 2"     | AL/ GL          | AL        | Н          |           | EXTERIOR STOREFRONT    |
| 1208-3           |                 | HOTEL ROOM         | 3' - 0"            | 7' - 0"            |             | SCW             | MTL       | Υ          |           |                        |
| 1208-4           | BATH            | HOTEL ROOM         | 6' - 0"            | 7' - 0"            |             | GL/WD           | MTL       | Q          |           |                        |
| 1209-1           |                 | HOTEL ROOM         | 3' - 0"            | 7' - 0"            | 0' - 1 3/4" | SCW             | НМ        | ٧          | 20MI      |                        |
|                  |                 |                    |                    |                    |             |                 |           |            | N         |                        |
| 1209-2           | BATH            | HOTEL ROOM         | 3' - 0"            | 7' - 0"            |             | WD/GL           | MTL       |            |           |                        |
| 1209-3           |                 | HOTEL ROOM         | 3' - 0"            | 7' - 0"            |             | SCW             | MTL       |            |           |                        |
| 1209-4           | HOTEL ROOM      |                    | 5' - 0"            | 7' - 0"            | 0' - 2"     | AL/ GL          | AL        | Н          | 0014      | EXTERIOR STOREFRONT    |
| 1210-1           | HOTEL ROOM      |                    | 3' - 0"            | 7' - 0"            | 0' - 1 3/4" | SCW             | НМ        | V          | 20MI<br>N |                        |
| 1210-2           | HOTEL ROOM      | BATH               | 3' - 0"            | 7' - 0"            |             | GL/WD           | MTL       | P          | IN        |                        |
| 1210-2           | HOTEL ROOM      | DATTI              | 3' - 0"            | 7' - 0"            |             | SCW             | MTL       |            |           |                        |
| 1210-3           | HOTEL ROOM      |                    | 6' - 8"            | 7' - 0"            | 0' - 2"     | AL/GL           | AL        | Н          |           | EXTERIOR STOREFRONT    |
| 1211-1           | TIOTELTIOON     | HOTEL ROOM         | 3' - 0"            | 7' - 0"            | 0' - 1 3/4" | SCW             | HM        | V          | 20MI      | EXTERIOR GLORIEL HOLL  |
|                  |                 | TIOTEETIOON        |                    | , ,                | 0 1 0/1     |                 |           |            | N         |                        |
| 1211-2           | HOTEL ROOM      | BATH               | 3' - 0"            | 7' - 0"            |             | WD/GL           | MTL       | Р          |           |                        |
| 1211-3           |                 | HOTEL ROOM         | 3' - 0"            | 7' - 0"            |             | SCW             | MTL       | Υ          |           |                        |
| 1211-4           | HOTEL ROOM      |                    | 6' - 0"            | 7' - 0"            | 0' - 2"     | AL/ GL          | AL        | Н          |           | EXTERIOR STOREFRONT    |
| 1212-1           |                 | HOTEL ROOM         | 3' - 0"            | 7' - 0"            | 0' - 1 3/4" | SCW             | НМ        | ٧          | 20MI      |                        |
|                  |                 |                    |                    |                    |             |                 |           |            | N         |                        |
| 1212-2           | BATH            | HOTEL ROOM         | 3' - 0"            | 7' - 0"            | 01 0"       | GL/WD           | MTL       |            |           | EVERNO                 |
| 1212-3           | LIOTE, DOC!     | HOTEL ROOM         | 6' - 8"            | 7' - 0"            | 0' - 2"     | AL/ GL          | AL        | Н          | 00:       | EXTERIOR STOREFRONT    |
| 1213-1           | HOTEL ROOM      |                    | 3' - 0"            | 7' - 0"            | 0' - 1 3/4" | SCW             | НМ        | V          | 20MI<br>N |                        |
| 1213-2           | BATH            | HOTEL ROOM         | 3' - 0"            | 7' - 0"            |             | WD/GL           | MTL       | D          | IN        |                        |
| 1213-2           | HOTEL ROOM      | HOTEL NOUN         | 3' - 0"            | 7' - 0"            |             | SCW             | MTL       | Υ          |           |                        |
| 1213-3           | HOTEL ROOM      |                    | 6' - 0"            | 7' - 0"            | 0' - 2"     | AL/ GL          | AL        |            |           | EXTERIOR STOREFRONT    |
| 1213-4           | HOTEL ROOM      |                    | 3' - 0"            | 7' - 0"            | 0' - 2"     | SCW             | HM        | H<br>V     | 20MI      | LATERIOR STUREFRUNT    |
| 14-1             | I TO TEE TIOOWI |                    |                    | , -0               | 0 1 3/4     | 3000            | i iivi    | "          | N         |                        |
| 1214-2           | HOTEL ROOM      | BATH               | 3' - 0"            | 7' - 0"            |             | GL/WD           | MTL       | Р          |           |                        |
| 1214-3           | HOTEL ROOM      |                    | 6' - 0"            | 7' - 0"            | 0' - 2"     | AL/ GL          | AL        | Н          |           | EXTERIOR STOREFRONT    |
| 1215-1           |                 | HOTEL ROOM         | 3' - 0"            | 7' - 0"            | 0' - 1 3/4" | SCW             | MTL       | С          | 20MI      |                        |
|                  |                 |                    |                    |                    |             |                 |           |            | N         |                        |
| 1215-2           | HOTEL ROOM      | BATH               | 3' - 0"            | 7' - 0"            |             | WD/GL           | MTL       |            |           |                        |
| 1215-3           |                 | HOTEL ROOM         | 3' - 0"            | 7' - 0"            |             | SCW             | MTL       | Υ          |           |                        |
| 1215-4           | HOTEL ROOM      |                    | 6' - 0"            | 7' - 0"            | 0' - 2"     | AL/ GL          | AL        | Н          |           | EXTERIOR STOREFRONT    |
| 1216-1           |                 | HOTEL ROOM         | 3' - 0"            | 7' - 0"            | 0' - 1 3/4" | SCW             | НМ        | V          | 20MI      |                        |
| 1010.0           | BATH            | HOTEL ROOM         | 3' - 0"            | 7' - 0"            |             | GL/WD           | MTL       | П          | N         |                        |
| 1216-2<br>1216-3 | DAIN            | HOTEL ROOM         | 3' - 0"            | 7' - 0"            |             | SCW             | MTL       |            |           |                        |
| 1216-3           | HOTEL ROOM      | HOTEL ROOM         | 6' - 0"            | 7' - 0"            | 0' - 2"     | AL/ GL          | AL        | Н          |           | EXTERIOR STOREFRONT    |
| 1217-1           | HOTEL ROOM      |                    | 3' - 0"            | 7' - 0"            | 0' - 1 3/4" | SCW             | HM        | V          | 20MI      | EXTERIOR STOREFRONT    |
| 1217 1           | TIOTELTIOOM     |                    | 3 0                | , 0                | 0 1 3/4     | 0000            | 1 1101    | \ \ \      | N         |                        |
| 1217-2           | BATH            | HOTEL ROOM         | 3' - 0"            | 7' - 0"            |             | WD/GL           | MTL       | Р          |           |                        |
| 1217-3           | HOTEL ROOM      |                    | 3' - 0"            | 7' - 0"            |             | SCW             | MTL       | Υ          |           |                        |
| 1217-4           | HOTEL ROOM      |                    | 6' - 0"            | 7' - 0"            | 0' - 2"     | AL/ GL          | AL        | Н          |           | EXTERIOR STOREFRONT    |
| 1218-1           | HOTEL ROOM      |                    | 3' - 0"            | 7' - 0"            | 0' - 1 3/4" | SCW             | НМ        | ٧          | 20MI      |                        |
|                  |                 |                    |                    |                    |             |                 |           |            | N         |                        |
| 1218-2           | HOTEL ROOM      | BATH               | 3' - 0"            | 7' - 0"            |             | GL/WD           | MTL       |            |           |                        |
| 1218-3           | HOTEL ROOM      |                    | 3' - 0"            | 7' - 0"            |             | SCW             | MTL       | Υ          |           |                        |
| 1218-4           | HOTEL ROOM      |                    | 6' - 0"            | 7' - 0"            | 0' - 2"     | AL/ GL          | AL        | Н          |           | EXTERIOR STOREFRONT    |
| 1219-1           |                 | HOTEL ROOM         | 3' - 0"            | 7' - 0"            | 0' - 1 3/4" | SCW             | НМ        | V          | 20MI      |                        |
| 1010.0           |                 | LIOTEL BOOM        | 01 011             | 71 011             |             | COM             | NATI      | \ <u>\</u> | N         |                        |
| 1219-2           | HOTEL BOOM      | HOTEL ROOM         | 3' - 0"            | 7' - 0"<br>7' - 0" |             | SCW             | MTL       |            |           |                        |
| 1219-3<br>1219-4 | HOTEL ROOM      | BATH<br>HOTEL ROOM | 3' - 0"<br>6' - 8" | 7' - 0"            | 0' - 2"     | WD/GL<br>AL/ GL | MTL<br>AL | Н          |           | EXTERIOR STOREFRONT    |
| 1219-4           |                 | HOTEL ROOM         | 3' - 0"            | 7' - 0"            | 0' - 2"     | SCW             | HM        | V          |           | LATERIOR STUREFRUNT    |
| 1220-1           | BATH            | HOTEL ROOM         | 3' - 0"            | 7' - 0"            | 0 - 1 3/4   | GL/WD           | MTL       |            |           |                        |
| 1220-2           |                 | HOTEL ROOM         | 3' - 0"            | 7' - 0"            |             | SCW             | MTL       | Y          |           |                        |
| 1220-4           | HOTEL ROOM      |                    | 6' - 0"            | 7' - 0"            | 0' - 2"     | AL/ GL          | AL        | Н          |           | EXTERIOR STOREFRONT    |
| 1221-1           | HOTEL ROOM      |                    | 3' - 0"            | 7' - 0"            | 0' - 1 3/4" | SCW             | HM        | V          | 20MI      |                        |
| '                |                 |                    |                    |                    |             |                 |           |            | N         |                        |
| 1221-2           | HOTEL ROOM      | BATH               | 3' - 0"            | 7' - 0"            |             | GL/WD           | MTL       | Р          |           |                        |
| 1221-3           |                 | HOTEL ROOM         | 3' - 0"            | 7' - 0"            |             | SCW             | MTL       | Υ          |           |                        |
| 1221-4           | HOTEL ROOM      |                    | 6' - 0"            | 7' - 0"            | 0' - 2"     | AL/ GL          | AL        | Н          |           | EXTERIOR STOREFRONT    |
| 1222-1           |                 | HOTEL ROOM         | 3' - 0"            | 7' - 0"            | 0' - 1 3/4" | SCW             | НМ        | ٧          | 20MI      |                        |
| 100=             | DATI!           | LIOTEL BOOK        | 0. 5"              |                    |             | 01.77           |           | _          | N         |                        |
| 1222-2           | BATH            | HOTEL ROOM         | 3' - 0"            | 7' - 0"            |             | GL/WD           | MTL       |            |           |                        |
| 1222-3           | HOTEL ROOM      |                    | 3' - 0"            | 7' - 0"            | 01 0"       | SCW             | MTL       |            |           | EVIEDIOD OTODESES OF T |
| 1222-4           | HOTEL ROOM      |                    | 6' - 0"            | 7' - 0"            | 0' - 2"     | AL/ GL          | AL        | Н          | 0014      | EXTERIOR STOREFRONT    |
| 1223-1           | HOTEL ROOM      |                    | 3' - 0"            | 7' - 0"            | 0' - 1 3/4" | SCW             | НМ        | ٧          | 20MI<br>N |                        |
| 1223-2           | HOTEL ROOM      | BATH               | 3' - 0"            | 7' - 0"            |             | GL/WD           | MTL       | Р          |           |                        |
| 1223-2           | HOTEL ROOM      | <i></i>            | 3' - 0"            | 7' - 0"            |             | SCW             | MTL       |            |           |                        |
| 1223-4           | HOTEL ROOM      |                    | 6' - 0"            | 7' - 0"            | 0' - 2"     | AL/ GL          | AL        | Н          |           | EXTERIOR STOREFRONT    |
| 1224-1           |                 | HOTEL ROOM         | 3' - 0"            | 7' - 0"            | 0' - 1 3/4" | SCW             | HM        | V          | 20MI      |                        |
| · ·              |                 |                    |                    |                    |             |                 |           |            | N         |                        |
|                  |                 | 1                  | 1                  | 1                  | 1           |                 |           | 1          | 1         |                        |
|                  |                 |                    |                    |                    |             |                 |           |            |           |                        |
| 1229-22  | BEDROOM  | CLOSET   | 3' - 0"   | 8' - 0"   | 0' - 1 3/4"   |  |   |   |   |   |
|--|--|--|---|---|---|--|---|---|---|---|
|  | CLOSET<br>BEDROOM  | BEDROOM<br>CLOSET  | 3' - 0"<br>3' - 0"  | 8' - 0"<br>8' - 0"  | 0' - 1 3/4"<br>0' - 1 3/4"  |  |   |   |   |   |
| 1229-26<br>1229-28   | MASTER BEDROOM   | MASTER BATH  | 2' - 11 3/4"<br>2' - 0"   | 8' - 0"<br>7' - 0"  | 0' - 1 1/2"<br>0' - 1"  |  |   |   |   |   |
| 1229-29<br>1229-30   | CLOSET   | MASTER BATH MASTER BATH  | 2' - 8"<br>2' - 6"  | 8' - 0"<br>7' - 0"  | 0' - 1 3/4"<br>0' - 2"  | WD   | WD  | L   |   |   |
| 1230-1   | HOTEL ROOM   |  | 3' - 0"   | 7' - 0"   | 0' - 1 3/4"   | SCW  | НМ  | ٧   | 20MI<br>N   |   |
| 1230-2   | HOTEL ROOM   | BATH   | 3' - 0"   | 7' - 0"   |   | GL/WD  | MTL   |   |   |   |
| 1230-3<br>1230-4   | HOTEL ROOM HOTEL ROOM  |  | 3' - 0"<br>6' - 0"  | 7' - 0"<br>7' - 0"  | 0' - 2"   | SCW<br>AL/ GL  | MTL<br>AL   | Н   |   | EXTERIOR STOREFRONT   |
| 1231-1<br>1231-2   | HOTEL ROOM HOTEL ROOM  | BATH   | 3' - 0"   | 7' - 0"<br>7' - 0"  | 0' - 1 3/4"   | SCW<br>WD/GL   | HM<br>MTL   | V<br>P  |   |   |
| 1231-3<br>1232-1   | HOTEL ROOM   | HOTEL ROOM   | 6' - 0"<br>3' - 0"  | 7' - 0"<br>7' - 0"  | 0' - 2"<br>0' - 1 3/4"  | AL/ GL<br>SCW  | AL<br>HM  | H<br>V  | 20MI  | EXTERIOR STOREFRONT   |
| 1232-2   | ВАТН   | HOTEL ROOM   | 3' - 0"   | 7' - 0"   | 0 10/4  | WD/GL  | MTL   |   | N   |   |
| 1232-3   | HOTEL ROOM   | HOTEL ROOM   | 6' - 0"   | 7' - 0"   | 0' - 2"   | AL/ GL   | AL  | Н   |   | EXTERIOR STOREFRONT   |
| 1233-1   | HOTEL ROOM   |  | 3' - 0"   | 7' - 0"   | 0' - 1 3/4"   | SCW  | НМ  | V   | 20MI<br>N   |   |
| 1233-2<br>1233-3   | HOTEL ROOM HOTEL ROOM  | BATH   | 3' - 0"<br>6' - 8"  | 7' - 0"<br>7' - 0"  | 0' - 2"   | WD/GL<br>AL/ GL  | MTL<br>AL   | P<br>H  |   | EXTERIOR STOREFRONT   |
| 1234-1   |  | HOTEL ROOM   | 3' - 0"   | 7' - 0"   | 0' - 1 3/4"   | SCW  | НМ  | V   | 20MI<br>N   |   |
| 1234-2<br>1234-3   | HOTEL ROOM<br>HOTEL ROOM   | ВАТН   | 3' - 0"<br>6' - 8"  | 7' - 0"<br>7' - 0"  | 0' - 2"   | SCW<br>AL/ GL  | MTL<br>AL   | P<br>H  |   |   |
| 1235-1   | TIOTELTIOOM  | HOTEL ROOM   | 3' - 0"   | 7' - 0"   | 0' - 1 3/4"   | SCW  | HM  | ٧   | 20MI<br>N   |   |
| 1235-2   |  | HOTEL ROOM   | 3' - 0"   | 7' - 0"   |   | SCW  | MTL   |   | IN  |   |
| 1235-3<br>1235-4   | HOTEL ROOM<br>HOTEL ROOM   | BATH   | 3' - 0"<br>6' - 8"  | 7' - 0"<br>7' - 0"  | 0' - 2"   | GL/WD<br>AL/ GL  | MTL<br>AL   | Н   |   | EXTERIOR STOREFRONT   |
| 1235-5<br>1236-1   | HOTEL ROOM   | HOTEL ROOM   | 6' - 8"<br>3' - 0"  | 7' - 0"<br>7' - 0"  | 0' - 2"   | AL/ GL<br>HM   | AL<br>HM  | H<br>C  | 20MI  | EXTERIOR STOREFRONT   |
| 1236-2   | ВАТН   | HOTEL ROOM   | 3' - 0"   | 7' - 0"   |   | GL/WD  | MTL   |   | N   |   |
| 1237-1   |  | HOTEL ROOM   | 3' - 0"   | 7' - 0"   | 0' - 1 3/4"   | HM   | HM  | V   | 20MI<br>N   |   |
| 1237-2   | BATH<br>HOTEL BOOM   | HOTEL ROOM   | 3' - 0"   | 7' - 0"   | 0' 0"   | GL/WD  | MTL   |   |   | EVTEDIOD CTORESCO   |
| 1237-3<br>1237-4   | HOTEL ROOM   |  | 6' - 8"<br>3' - 0"  | 7' - 0"<br>7' - 0"  | 0' - 2"   | AL/ GL<br>HM   | AL<br>HM  | H<br>C  | 45MI  | EXTERIOR STOREFRONT   |
|  | STAIR 3  |  | 3' - 0"   | 7' - 0"   | 0' - 1 3/4"   | НМ   | НМ  | E   | N<br>2HR  |   |
| 1237-18<br>1237-19   |  |  | 3' - 0"<br>2' - 8"  | 7' - 0"<br>7' - 0"  | 0' - 1"<br>0' - 1"  |  |   |   |   |   |
| 1237-43  | WOMENS RESTROOM  |  | 3' - 0"   | 7' - 0"   | 0' - 1"   |  |   |   |   |   |
| 1237-45  | WOMENS RESTROOM WOMENS RESTROOM  | WOMENS RESTROOM  | 2' - 8"   | 7' - 0"   | 0' - 1"   |  |   |   |   |   |
|  | WOMENS RESTROOM WOMENS RESTROOM  | WOMENS RESTROOM WOMENS RESTROOM  | 2' - 8"<br>3' - 0"  | 7' - 0"<br>7' - 0"  | 0' - 1"<br>0' - 1"  |  |   |   |   |   |
| 1237-48  | WOMENS RESTROOM  | WOMENS RESTROOM WOMENS RESTROOM  | 2' - 8"   | 7' - 0"<br>7' - 0"  | 0' - 1"   |  |   |   |   |   |
| 1237-50  | WOMENS RESTROOM  | WOMENS RESTROOM  | 2' - 8"   | 7' - 0"   | 0' - 1"   |  |   |   |   |   |
| 1237-54  | MENS RESTROOM MENS RESTROOM  | MENS RESTROOM MENS RESTROOM  | 3' - 0"   | 7' - 0"   | 0' - 1"   |  |   |   |   |   |
|  | MENS RESTROOM MENS RESTROOM  | MENS RESTROOM MENS RESTROOM  | 2' - 8"   | 7' - 0"<br>7' - 0"  | 0' - 1"   |  |   |   |   |   |
| 1238-1   |  | HOTEL ROOM   | 3' - 0"   | 7' - 0"   | 0' - 1 3/4"   | SCW  | НМ  | V   | 20MI<br>N   |   |
| 1238-2<br>1238-3   | BATH<br>HOTEL ROOM   | HOTEL ROOM   | 3' - 0"<br>3' - 0"  | 7' - 0"<br>7' - 0"  |   | GL/WD<br>SCW   | MTL<br>MTL  |   |   |   |
| 1238-4   | HOTEL ROOM   |  | 6' - 8"   | 7' - 0"   | 0' - 2"   | AL/ GL   | AL  | Н   |   | EXTERIOR STOREFRONT   |
| 1239-1   | HOTEL ROOM   |  | 3' - 0"   | 7' - 0"   | 0' - 1 3/4"   | SCW  | НМ  | V   | 20MI<br>N   |   |
| 1239-2<br>1239-3   | HOTEL ROOM HOTEL ROOM  | BATH   | 3' - 0"   | 7' - 0"<br>7' - 0"  |   | GL/WD<br>SCW   | MTL<br>MTL  |   |   |   |
| 1239-4<br>1240-1   | HOTEL ROOM   | HOTEL ROOM   | 6' - 8"<br>3' - 0"  | 7' - 0"<br>7' - 0"  | 0' - 2"<br>0' - 1 3/4"  | AL/ GL<br>SCW  | AL<br>HM  | H<br>V  | 20MI  | EXTERIOR STOREFRONT   |
|  | DATH   |  |   |   | 0 - 1 3/4   |  |   |   | N   |   |
| 1240-2<br>1240-3   | BATH<br>HOTEL ROOM   | HOTEL ROOM   | 3' - 0"<br>3' - 0"  | 7' - 0"<br>7' - 0"  |   | GL/WD<br>SCW   | MTL<br>MTL  | Υ   |   |   |
| 1240-4<br>1241-1   | HOTEL ROOM HOTEL ROOM  |  | 6' - 8"<br>3' - 0"  | 7' - 0"<br>7' - 0"  | 0' - 2"   | AL/ GL<br>SCW  | AL<br>HM  | H<br>V  | 20MI  | EXTERIOR STOREFRONT   |
| 1241-2   | HOTEL ROOM   | BATH   | 3' - 0"   | 7' - 0"   |   | GL/WD  | MTL   | Р   | N   |   |
| 1241-3<br>1241-4   | HOTEL ROOM HOTEL ROOM  |  | 3' - 0"<br>6' - 8"  | 7' - 0"<br>7' - 0"  | 0' - 2"   | SCW<br>AL/ GL  | MTL<br>AL   | Y<br>H  |   | EXTERIOR STOREFRONT   |
| 1242-1   | TIOTEE TIOOM   | HOTEL ROOM   | 3' - 0"   | 7' - 0"   | 0' - 1 3/4"   | SCW  | HM  | V   | 20MI<br>N   | EXTERNOT OTTENTION  |
| 1242-2<br>1242-3   | BATH<br>HOTEL ROOM   | HOTEL ROOM   | 3' - 0"<br>3' - 0"  | 7' - 0"<br>7' - 0"  |   | GL/WD<br>SCW   | MTL<br>MTL  |   |   |   |
| 1242-4   | HOTEL ROOM   |  | 6' - 8"   | 7' - 0"   | 0' - 2"   | AL/ GL   | AL  | Н   |   | EXTERIOR STOREFRONT   |
| 1243-1   | HOTEL ROOM   |  | 3' - 0"   | 7' - 0"   | 0' - 1 3/4"   | НМ   | НМ  | ٧   | 20MI<br>N   |   |
| 1243-2<br>1243-3   | BATH   | HOTEL ROOM HOTEL ROOM  | 6' - 0"<br>3' - 0"  | 7' - 0"<br>7' - 0"  | 0' - 2"   | AL/ GL<br>GL/WD  | AL<br>MTL   | H<br>P  |   | EXTERIOR STOREFRONT   |
| 1244-1   | HOTEL ROOM   |  | 3' - 0"   | 7' - 0"   | 0' - 1 3/4"   | SCW  | НМ  | ٧   | 20MI<br>N   |   |
| 1244-2<br>1244-3   | HOTEL ROOM HOTEL ROOM  | ВАТН   | 3' - 0"<br>3' - 0"  | 7' - 0"<br>7' - 0"  |   | WD/GL<br>SCW   | MTL<br>MTL  |   |   |   |
| 1244-3   | LE I LOOIVI  | HOTEL ROOM   | 3' - 0"   | 7' - 0"   | 0' - 1 3/4"   | SCW  | HM  | V   | 20MI  |   |
| 1245-2   | ВАТН   | HOTEL ROOM   | 3' - 0"   | 7' - 0"   |   | WD/GL  | MTL   |   | N   |   |
| 1245-3<br>1245-4   |  | HOTEL ROOM HOTEL ROOM  | 6' - 0"<br>3' - 0"  | 7' - 0"<br>7' - 0"  | 0' - 2"   | AL/ GL<br>SCW  | AL<br>MTL   | H<br>Y  |   | EXTERIOR STOREFRONT   |
| 1245-5<br>1246-1   | HOTEL ROOM HOTEL ROOM  |  | 2' - 10"  | 7' - 0"   | 0' - 1 3/8"   |  | AL  | Н   |   | EXTERIOR STOREFRONT   |
| →∪ ⁻ I   | HIRATE CONTRACTOR  |  | 3' - 0"   |   |   | AL/ GL<br>SCW  | Ни  |   | 20M   |   |
| 12/6 2   | TIOTEL NOOW  | HOTEL POOM   | 3' - 0"<br>4' - 0"  | 7' - 0"   | 0' - 1 3/4"   | SCW  | HM  | V   | 20MI<br>N   |   |
| 1246-2<br>1246-3   |  | HOTEL ROOM<br>HOTEL ROOM   | 4' - 0"<br>2' - 10"   | 7' - 0"<br>7' - 0"<br>7' - 0"   |   | SCW<br>SCW<br>AL/GL  | MTL<br>AL   | V<br>Y<br>H   |   | EXTERIOR STOREFRONT   |
|  | BATH HOTEL ROOM  |  | 4' - 0"   | 7' - 0"<br>7' - 0"  | 0' - 1 3/4"   | SCW  | MTL   | V<br>Y<br>H   |   | EXTERIOR STOREFRONT   |
| 1246-3<br>1246-4   | BATH   | HOTEL ROOM   | 4' - 0"<br>2' - 10"<br>3' - 0"  | 7' - 0"<br>7' - 0"<br>7' - 0"<br>7' - 0"  | 0' - 1 3/4"<br>0' - 1 1/2"<br>0' - 1 3/8"   | SCW<br>SCW<br>AL/GL<br>GL/WD   | MTL<br>AL<br>MTL  | V<br>Y<br>H<br>P  |   |   |
| 1246-3<br>1246-4<br>1246-5<br>1247-1<br>1247-2   | BATH HOTEL ROOM  | HOTEL ROOM HOTEL ROOM  | 4' - 0"<br>2' - 10"<br>3' - 0"<br>2' - 10"<br>3' - 0"   | 7' - 0"<br>7' - 0"<br>7' - 0"<br>7' - 0"<br>7' - 0"<br>7' - 0"  | 0' - 1 3/4"<br>0' - 1 1/2"<br>0' - 1 3/8"<br>0' - 1 3/8"  | SCW SCW AL/GL GL/WD AL/ GL SCW AL/ GL  | MTL<br>AL<br>MTL<br>AL<br>HM  | V<br>Y<br>H<br>P<br>H<br>V  | 20MI  |   |
| 1246-3<br>1246-4<br>1246-5<br>1247-1   | BATH<br>HOTEL ROOM   | HOTEL ROOM HOTEL ROOM  | 4' - 0"<br>2' - 10"<br>3' - 0"<br>2' - 10"<br>3' - 0"   | 7' - 0"<br>7' - 0"<br>7' - 0"<br>7' - 0"<br>7' - 0"<br>7' - 0"  | 0' - 1 3/4"<br>0' - 1 1/2"<br>0' - 1 3/8"<br>0' - 1 3/8"<br>0' - 1 3/4"   | SCW SCW AL/GL GL/WD AL/ GL SCW   | MTL<br>AL<br>MTL<br>AL<br>HM  | V<br>Y<br>H<br>P<br>H<br>V  | 20MI<br>N   | EXTERIOR STOREFRONT   |
| 1246-3<br>1246-4<br>1246-5<br>1247-1<br>1247-2<br>1247-3<br>1248-1   | BATH HOTEL ROOM HOTEL ROOM HOTEL ROOM HOTEL ROOM   | HOTEL ROOM HOTEL ROOM  | 4' - 0"<br>2' - 10"<br>3' - 0"<br>2' - 10"<br>3' - 0"<br>2' - 10"<br>3' - 0"<br>3' - 0"   | 7' - 0" 7' - 0" 7' - 0" 7' - 0" 7' - 0" 7' - 0" 7' - 0" 7' - 0" 7' - 0" 7' - 0"   | 0' - 1 3/4"<br>0' - 1 1/2"<br>0' - 1 3/8"<br>0' - 1 3/4"<br>0' - 1 3/8"<br>0' - 1 3/4"  | SCW SCW AL/GL GL/WD AL/ GL SCW AL/ GL WD/GL SCW GL/WD  | MTL AL HM AL HTL HM AL MTL HM   | Y H P H V V P   | 20MI N  | EXTERIOR STOREFRONT  EXTERIOR STOREFRONT  |
| 1246-3<br>1246-4<br>1246-5<br>1247-1<br>1247-2<br>1247-3<br>1248-1   | BATH HOTEL ROOM HOTEL ROOM HOTEL ROOM HOTEL ROOM   | HOTEL ROOM HOTEL ROOM BATH   | 4' - 0"<br>2' - 10"<br>3' - 0"<br>2' - 10"<br>3' - 0"<br>2' - 10"<br>3' - 0"  | 7' - 0"<br>7' - 0"  | 0' - 1 3/4"<br>0' - 1 1/2"<br>0' - 1 3/8"<br>0' - 1 3/8"<br>0' - 1 3/4"<br>0' - 1 3/8"  | SCW SCW AL/GL GL/WD AL/ GL SCW AL/ GL WD/GL SCW  | MTL AL HM AL HTL HM AL MTL HM   | Y H P H V V   | 20MI<br>N   | EXTERIOR STOREFRONT   |
| 1246-3<br>1246-4<br>1246-5<br>1247-1<br>1247-2<br>1247-3<br>1248-1<br>1248-3<br>1248-5   | BATH HOTEL ROOM HOTEL ROOM HOTEL ROOM HOTEL ROOM BATH HOTEL ROOM   | HOTEL ROOM  HOTEL ROOM  BATH  HOTEL ROOM   | 4' - 0"<br>2' - 10"<br>3' - 0"<br>2' - 10"<br>3' - 0"<br>2' - 10"<br>3' - 0"<br>3' - 0"<br>3' - 0"  | 7' - 0" 7' - 0" 7' - 0" 7' - 0" 7' - 0" 7' - 0" 7' - 0" 7' - 0" 7' - 0" 7' - 0" 7' - 0"   | 0' - 1 3/4"<br>0' - 1 1/2"<br>0' - 1 3/8"<br>0' - 1 3/4"<br>0' - 1 3/4"<br>0' - 1 3/4"  | SCW SCW AL/GL GL/WD AL/ GL SCW AL/ GL WD/GL SCW GL/WD  | MTL AL HM AL HTL HM AL MTL HM MTL   | Y H P H V V P   | 20MI<br>N   | EXTERIOR STOREFRONT  EXTERIOR STOREFRONT  |
| 1246-3<br>1246-4<br>1246-5<br>1247-1<br>1247-2<br>1247-3<br>1248-1<br>1248-3<br>1248-5<br>1248-6<br>1249-1   | BATH HOTEL ROOM HOTEL ROOM HOTEL ROOM HOTEL ROOM BATH HOTEL ROOM   | HOTEL ROOM HOTEL ROOM  HOTEL ROOM  BATH  HOTEL ROOM  MASTER BEDROOM HOTEL ROOM  BATH   | 4' - 0" 2' - 10" 3' - 0" 2' - 10" 3' - 0" 2' - 10" 3' - 0" 3' - 0" 2' - 10" 3' - 0" 3' - 0" 3' - 0" 3' - 0"   | 7' - 0" 7' - 0" 7' - 0" 7' - 0" 7' - 0" 7' - 0" 7' - 0" 7' - 0" 7' - 0" 7' - 0" 7' - 0" 7' - 0" 7' - 0"   | 0' - 1 3/4"<br>0' - 1 1/2"<br>0' - 1 3/8"<br>0' - 1 3/4"<br>0' - 1 3/4"<br>0' - 1 3/4"<br>0' - 1 3/4"   | SCW SCW AL/GL GL/WD AL/ GL SCW AL/ GL WD/GL SCW GL/WD AL/ GL   | MTL AL HM AL MTL HM HM HM MTL HM  | Y H P H V P V P H C P F C C C C C C C C C C C C C C C C C                           | 20MI<br>N<br>20MI<br>N<br>20MI                                | EXTERIOR STOREFRONT  EXTERIOR STOREFRONT  |
| 1246-3<br>1246-4<br>1246-5<br>1247-1<br>1247-2<br>1247-3<br>1248-1<br>1248-3<br>1248-5<br>1248-6<br>1249-1<br>1249-2<br>1249-3<br>1249-4   | BATH HOTEL ROOM  HOTEL ROOM HOTEL ROOM HOTEL ROOM  BATH HOTEL ROOM DINING  HOTEL ROOM  | HOTEL ROOM HOTEL ROOM  HOTEL ROOM  BATH  HOTEL ROOM  MASTER BEDROOM HOTEL ROOM   | 4' - 0" 2' - 10" 3' - 0" 2' - 10" 3' - 0" 2' - 10" 3' - 0" 3' - 0" 3' - 0" 3' - 0" 3' - 0" 3' - 0" 3' - 0" 2' - 10" 6' - 0" 3' - 0" 2' - 10"  | 7' - 0" 7' - 0" 7' - 0" 7' - 0" 7' - 0" 7' - 0" 7' - 0" 7' - 0" 7' - 0" 7' - 0" 7' - 0" 7' - 0" 7' - 0" 7' - 0" 7' - 0"   | 0' - 1 3/4"<br>0' - 1 1/2"<br>0' - 1 3/8"<br>0' - 1 3/4"<br>0' - 1 3/4"   | SCW SCW AL/GL GL/WD AL/ GL SCW AL/ GL WD/GL SCW GL/WD AL/ GL SCW GL/WD AL/ GL  | MTL AL HM AL HM  MTL HM  MTL  HM  MTL  AL   | Y H P H V H P V P H V K   | 20MI<br>N<br>20MI<br>N<br>20MI<br>N                           | EXTERIOR STOREFRONT  EXTERIOR STOREFRONT  |
| 1246-3<br>1246-4<br>1246-5<br>1247-1<br>1247-2<br>1247-3<br>1248-1<br>1248-3<br>1248-6<br>1249-1<br>1249-2<br>1249-3<br>1249-4<br>1250-1   | BATH HOTEL ROOM HOTEL ROOM HOTEL ROOM HOTEL ROOM BATH HOTEL ROOM DINING HOTEL ROOM HOTEL ROOM  | HOTEL ROOM HOTEL ROOM HOTEL ROOM  BATH HOTEL ROOM  MASTER BEDROOM HOTEL ROOM  BATH HOTEL ROOM  | 4' - 0" 2' - 10" 3' - 0" 2' - 10" 3' - 0" 2' - 10" 3' - 0" 3' - 0" 2' - 10" 3' - 0" 2' - 10" 3' - 0" 2' - 10" 3' - 0" 3' - 0" 3' - 0" 3' - 0" 3' - 0"   | 7' - 0" 7' - 0" 7' - 0" 7' - 0" 7' - 0" 7' - 0" 7' - 0" 7' - 0" 7' - 0" 7' - 0" 7' - 0" 7' - 0" 7' - 0" 7' - 0" 7' - 0" 7' - 0" 7' - 0"   | 0' - 1 3/4"<br>0' - 1 1/2"<br>0' - 1 3/8"<br>0' - 1 3/4"<br>0' - 1 3/4"<br>0' - 1 3/4"<br>0' - 1 3/4"<br>0' - 1 3/4"  | SCW SCW AL/GL GL/WD AL/ GL SCW AL/ GL WD/GL SCW GL/WD AL/ GL SCW GL/WD SCW AL/ GL SCW  | MTL AL HM AL HM MTL HM MTL AL HM  | V Y H P H V P H V P H V V P K V   | 20MI<br>N<br>20MI<br>N<br>20MI                                | EXTERIOR STOREFRONT  EXTERIOR STOREFRONT  EXTERIOR STOREFRONT   |
| 1246-3<br>1246-4<br>1246-5<br>1247-1<br>1247-2<br>1247-3<br>1248-1<br>1248-3<br>1248-5<br>1248-6<br>1249-1<br>1249-2<br>1249-3<br>1249-4   | BATH HOTEL ROOM  HOTEL ROOM HOTEL ROOM HOTEL ROOM  BATH HOTEL ROOM DINING  HOTEL ROOM  | HOTEL ROOM HOTEL ROOM  HOTEL ROOM  BATH  HOTEL ROOM  MASTER BEDROOM HOTEL ROOM  BATH   | 4' - 0" 2' - 10" 3' - 0" 2' - 10" 3' - 0" 2' - 10" 3' - 0" 3' - 0" 3' - 0" 3' - 0" 3' - 0" 3' - 0" 3' - 0" 3' - 0" 3' - 0" 2' - 10" 3' - 0" 2' - 10" 3' - 0"  | 7' - 0" 7' - 0" 7' - 0" 7' - 0" 7' - 0" 7' - 0" 7' - 0" 7' - 0" 7' - 0" 7' - 0" 7' - 0" 7' - 0" 7' - 0" 7' - 0" 7' - 0"   | 0' - 1 3/4"<br>0' - 1 1/2"<br>0' - 1 3/8"<br>0' - 1 3/4"<br>0' - 1 3/4"   | SCW SCW AL/GL GL/WD AL/ GL SCW AL/ GL WD/GL SCW GL/WD AL/ GL SCW GL/WD AL/ GL  | MTL AL HM AL MTL HM MTL HM MTL AL HM MTL HM MTL MTL HM MTL MTL MTL AL HM  | V Y H P H V P H V P K V P K   | 20MI<br>N<br>20MI<br>N<br>20MI<br>N                           | EXTERIOR STOREFRONT  EXTERIOR STOREFRONT  EXTERIOR STOREFRONT   |
| 1246-3<br>1246-4<br>1246-5<br>1247-1<br>1247-2<br>1247-3<br>1248-1<br>1248-5<br>1248-6<br>1249-1<br>1249-2<br>1249-3<br>1249-4<br>1250-1<br>1250-2<br>1250-3<br>1250-4   | BATH HOTEL ROOM  HOTEL ROOM HOTEL ROOM HOTEL ROOM  BATH HOTEL ROOM  DINING  HOTEL ROOM  HOTEL ROOM  HOTEL ROOM  HOTEL ROOM  HOTEL ROOM  HOTEL ROOM   | HOTEL ROOM HOTEL ROOM HOTEL ROOM  BATH HOTEL ROOM  MASTER BEDROOM HOTEL ROOM  BATH HOTEL ROOM  | 4' - 0" 2' - 10" 3' - 0" 2' - 10" 3' - 0" 2' - 10" 3' - 0" 3' - 0" 3' - 0" 3' - 0" 3' - 0" 3' - 0" 3' - 0" 3' - 0" 3' - 0" 2' - 10" 3' - 0" 2' - 10" 3' - 0"  | 7' - 0"   | 0' - 1 3/4"<br>0' - 1 1/2"<br>0' - 1 3/8"<br>0' - 1 3/4"<br>0' - 1 3/4"                                 | SCW SCW AL/GL GL/WD AL/ GL SCW AL/ GL WD/GL SCW GL/WD AL/ GL SCW GL/WD SCW AL/ GL SCW AL/ GL SCW   | MTL AL HM AL HM MTL AL HM MTL AL HM MTL AL HM MTL AL HM   | Y H P H V P H V P K Y Y   | 20MI<br>N<br>20MI<br>N<br>20MI<br>N                           | EXTERIOR STOREFRONT  EXTERIOR STOREFRONT  EXTERIOR STOREFRONT   |
| 1246-3<br>1246-4<br>1246-5<br>1247-1<br>1247-2<br>1247-3<br>1248-1<br>1248-3<br>1248-5<br>1248-6<br>1249-1<br>1249-2<br>1249-3<br>1249-4<br>1250-1<br>1250-2<br>1250-3<br>1250-4   | BATH HOTEL ROOM HOTEL ROOM HOTEL ROOM HOTEL ROOM BATH HOTEL ROOM DINING HOTEL ROOM   | HOTEL ROOM HOTEL ROOM  HOTEL ROOM  BATH  HOTEL ROOM  MASTER BEDROOM HOTEL ROOM  BATH HOTEL ROOM  HOTEL ROOM  | 4' - 0" 2' - 10" 3' - 0" 2' - 10" 3' - 0" 2' - 10" 3' - 0" 3' - 0" 3' - 0" 2' - 10" 6' - 0" 3' - 0" 2' - 10" 3' - 0" 2' - 10" 3' - 0" 2' - 10" 3' - 0" 2' - 10" 3' - 0" 2' - 10" 3' - 0"  | 7' - 0"   | 0' - 1 3/4"<br>0' - 1 1/2"<br>0' - 1 3/8"<br>0' - 1 3/4"<br>0' - 1 3/4"   | SCW SCW AL/GL GL/WD AL/ GL SCW AL/ GL WD/GL SCW GL/WD AL/ GL SCW GL/WD SCW AL/ GL SCW SCW SCW SCW SCW SCW  | MTL AL HM AL HM MTL AL HM MTL AL HM MTL AL HM HM HHM  | Y H P H V P H V P K V P K Y V   | 20MI<br>N<br>20MI<br>N<br>20MI<br>N                           | EXTERIOR STOREFRONT  EXTERIOR STOREFRONT  EXTERIOR STOREFRONT   |
| 1246-3<br>1246-4<br>1246-5<br>1247-1<br>1247-2<br>1247-3<br>1248-3<br>1248-5<br>1248-6<br>1249-1<br>1249-2<br>1249-3<br>1249-4<br>1250-1<br>1250-2<br>1250-3<br>1250-4<br>1251-1   | BATH HOTEL ROOM  HOTEL ROOM HOTEL ROOM HOTEL ROOM BATH HOTEL ROOM DINING  HOTEL ROOM HOTEL ROOM HOTEL ROOM HOTEL ROOM HOTEL ROOM BATH HOTEL ROOM HOTEL ROOM  | HOTEL ROOM HOTEL ROOM  HOTEL ROOM  BATH  HOTEL ROOM  MASTER BEDROOM HOTEL ROOM  BATH HOTEL ROOM  | 4' - 0" 2' - 10" 3' - 0" 2' - 10" 3' - 0" 2' - 10" 3' - 0" 3' - 0" 3' - 0" 3' - 0" 3' - 0" 3' - 0" 3' - 0" 2' - 10" 3' - 0" 3' - 0" 2' - 10" 3' - 0" 3' - 0" 3' - 0" 3' - 0" 3' - 0" 3' - 0" 3' - 0" 3' - 0" 3' - 0"  | 7' - 0"   | 0' - 1 3/4"  0' - 1 1/2"  0' - 1 3/8"  0' - 1 3/8"  0' - 1 3/4"  0' - 1 3/4"  0' - 1 3/4"  0' - 1 3/4"  0' - 1 3/4"  0' - 1 3/4"  0' - 1 3/4"  0' - 1 3/4"  | SCW SCW AL/GL GL/WD AL/ GL SCW AL/ GL WD/GL SCW GL/WD AL/ GL SCW GL/WD SCW AL/ GL SCW SCW AL/ GL SCW SCW AL/ GL SCW SCW AL/ GL SCW SCW SCW SCW SCW SCW   | MTL AL HM AL HM MTL AL HM MTL AL HM MTL HM MTL HM MTL AL HM   | Y H P H V P H V P K Y V P K Y V P Y   | 20MI<br>N<br>20MI<br>N<br>20MI<br>N<br>20MI<br>N              | EXTERIOR STOREFRONT  EXTERIOR STOREFRONT  EXTERIOR STOREFRONT  EXTERIOR STOREFRONT  |
| 1246-3<br>1246-4<br>1246-5<br>1247-1<br>1247-2<br>1247-3<br>1248-1<br>1248-3<br>1248-5<br>1248-6<br>1249-1<br>1249-2<br>1249-3<br>1249-4<br>1250-1<br>1250-2<br>1250-3<br>1250-4<br>1251-1   | BATH HOTEL ROOM HOTEL ROOM HOTEL ROOM HOTEL ROOM BATH HOTEL ROOM DINING HOTEL ROOM   | HOTEL ROOM HOTEL ROOM  HOTEL ROOM  BATH  HOTEL ROOM  MASTER BEDROOM HOTEL ROOM  BATH HOTEL ROOM  HOTEL ROOM  | 4' - 0" 2' - 10" 3' - 0" 2' - 10" 3' - 0" 2' - 10" 3' - 0" 3' - 0" 3' - 0" 3' - 0" 3' - 0" 3' - 0" 2' - 10" 3' - 0" 2' - 10" 3' - 0" 2' - 10" 3' - 0" 2' - 10" 3' - 0" 2' - 10" 3' - 0" 2' - 10" 3' - 0"  | 7' - 0"   | 0' - 1 3/4"<br>0' - 1 1/2"<br>0' - 1 3/8"<br>0' - 1 3/4"<br>0' - 1 3/4"                                 | SCW SCW AL/GL GL/WD AL/ GL SCW AL/ GL WD/GL SCW GL/WD AL/ GL SCW GL/WD SCW AL/ GL SCW SCW AL/ GL SCW SCW AL/ GL SCW GL/WD  | MTL AL HM AL HM MTL AL HM MTL AL HM MTL HM MTL HM MTL AL HM MTL AL HM MTL AL HM MTL AL MTL MTL AL MTL MTL AL MTL MTL MTL MTL   | Y H P H V P H V P K V P K Y V P F K P F F F F F F F F F F F F F F F F               | 20MI<br>N<br>20MI<br>N<br>20MI<br>N<br>20MI<br>N<br>20MI<br>N | EXTERIOR STOREFRONT  EXTERIOR STOREFRONT  EXTERIOR STOREFRONT   |
| 1246-3<br>1246-4<br>1246-5<br>1247-1<br>1247-2<br>1247-3<br>1248-1<br>1248-5<br>1248-6<br>1249-1<br>1249-2<br>1249-3<br>1249-4<br>1250-1<br>1250-2<br>1250-3<br>1250-4<br>1251-1   | BATH HOTEL ROOM  HOTEL ROOM HOTEL ROOM HOTEL ROOM BATH HOTEL ROOM DINING  HOTEL ROOM HOTEL ROOM HOTEL ROOM HOTEL ROOM HOTEL ROOM BATH HOTEL ROOM HOTEL ROOM  | HOTEL ROOM HOTEL ROOM  BATH  HOTEL ROOM  MASTER BEDROOM HOTEL ROOM  BATH HOTEL ROOM  HOTEL ROOM  HOTEL ROOM  HOTEL ROOM  | 4' - 0" 2' - 10" 3' - 0" 2' - 10" 3' - 0" 2' - 10" 3' - 0" 3' - 0" 3' - 0" 3' - 0" 3' - 0" 3' - 0" 3' - 0" 3' - 0" 3' - 0" 3' - 0" 3' - 0" 3' - 0" 3' - 0" 3' - 0" 3' - 0" 2' - 10" 3' - 0" 2' - 10" 3' - 0" 2' - 10" 3' - 0"   | 7' - 0"   | 0' - 1 3/4"  0' - 1 1/2"  0' - 1 3/8"  0' - 1 3/4"  0' - 1 3/4"  0' - 1 3/4"  0' - 1 3/4"  0' - 1 3/4"  0' - 1 3/4"  0' - 1 3/4"  0' - 1 3/4"  0' - 1 3/4"  0' - 1 3/4"                           | SCW SCW AL/GL GL/WD AL/ GL SCW AL/ GL WD/GL SCW GL/WD AL/ GL SCW GL/WD SCW AL/ GL SCW SCW AL/ GL SCW SCW AL/ GL  | MTL AL HM AL HM MTL AL HM AL HM AL HM AL HM   | Y H P H V P H V P K V P K Y V P H H   | 20MI<br>N<br>20MI<br>N<br>20MI<br>N<br>20MI<br>N              | EXTERIOR STOREFRONT  EXTERIOR STOREFRONT  EXTERIOR STOREFRONT  EXTERIOR STOREFRONT  |
| 1246-3<br>1246-4<br>1246-5<br>1247-1<br>1247-2<br>1247-3<br>1248-1<br>1248-3<br>1248-5<br>1248-6<br>1249-1<br>1249-2<br>1249-3<br>1249-4<br>1250-1<br>1250-2<br>1250-3<br>1250-4<br>1251-1<br>1251-2<br>1251-3<br>1251-4<br>1252-1<br>1252-2<br>1252-3                     | BATH HOTEL ROOM  HOTEL ROOM HOTEL ROOM HOTEL ROOM BATH HOTEL ROOM DINING  HOTEL ROOM HOTEL ROOM HOTEL ROOM HOTEL ROOM  BATH HOTEL ROOM HOTEL ROOM HOTEL ROOM HOTEL ROOM HOTEL ROOM   | HOTEL ROOM HOTEL ROOM  BATH  HOTEL ROOM  MASTER BEDROOM HOTEL ROOM  BATH HOTEL ROOM  HOTEL ROOM  HOTEL ROOM  HOTEL ROOM  | 4' - 0" 2' - 10" 3' - 0" 2' - 10" 3' - 0" 2' - 10" 3' - 0" 3' - 0" 3' - 0" 3' - 0" 3' - 0" 3' - 0" 3' - 0" 3' - 0" 3' - 0" 3' - 0" 3' - 0" 2' - 10" 3' - 0" 2' - 10" 3' - 0" 2' - 10" 3' - 0" 2' - 10" 3' - 0" 3' - 0" 3' - 0" 3' - 0" 3' - 0"  | 7' - 0"                         | 0' - 1 3/4"  0' - 1 3/8"  0' - 1 3/8"  0' - 1 3/4"  0' - 1 3/4"  0' - 1 3/4"  0' - 1 3/4"  0' - 1 3/4"  0' - 1 3/4"  0' - 1 3/4"  0' - 1 3/4"  0' - 1 3/4"  0' - 1 3/4"  0' - 1 3/4"              | SCW SCW AL/GL GL/WD AL/ GL SCW AL/ GL SCW GL/WD AL/ GL SCW GL/WD SCW AL/ GL SCW  | MTL AL MTL AL MTL HM  MTL AL  HM  MTL AL  HM  MTL  HM  MTL  HM  MTL  AL  MTL  HM  MTL  AL  MTL  HM  MTL  AL  MTL  HM  MTL  MTL  AL  MTL  MTL  MTL  MTL  MTL  | Y H P H V P H V P K Y V P K Y V P H D F F F F F F F F F F F F F F F F F F           | 20MI<br>N<br>20MI<br>N<br>20MI<br>N<br>20MI<br>N<br>20MI<br>N | EXTERIOR STOREFRONT  EXTERIOR STOREFRONT  EXTERIOR STOREFRONT  EXTERIOR STOREFRONT  EXTERIOR STOREFRONT  EXTERIOR STOREFRONT                      |
| 1246-3<br>1246-4<br>1246-5<br>1247-1<br>1247-2<br>1247-3<br>1248-3<br>1248-5<br>1248-6<br>1249-1<br>1249-2<br>1249-3<br>1249-4<br>1250-1<br>1250-2<br>1250-3<br>1250-4<br>1251-1<br>1251-2<br>1251-3<br>1251-4<br>1252-1   | BATH HOTEL ROOM  HOTEL ROOM HOTEL ROOM HOTEL ROOM BATH HOTEL ROOM DINING  HOTEL ROOM   | HOTEL ROOM HOTEL ROOM  HOTEL ROOM  BATH  HOTEL ROOM  MASTER BEDROOM HOTEL ROOM  BATH HOTEL ROOM      | 4' - 0" 2' - 10" 3' - 0" 2' - 10" 3' - 0" 2' - 10" 3' - 0" 3' - 0" 3' - 0" 3' - 0" 3' - 0" 3' - 0" 2' - 10" 3' - 0" 2' - 10" 3' - 0" 2' - 10" 3' - 0" 2' - 10" 3' - 0" 2' - 10" 3' - 0" 2' - 10" 3' - 0" 2' - 10" 3' - 0" 6' - 0"   | 7' - 0"                         | 0' - 1 3/4"  0' - 1 3/8"  0' - 1 3/8"  0' - 1 3/4"  0' - 1 3/4"  0' - 1 3/4"  0' - 1 3/4"  0' - 1 3/4"  0' - 1 3/4"  0' - 1 3/4"  0' - 1 3/4"  0' - 1 3/4"  0' - 1 3/4"                           | SCW SCW AL/GL GL/WD AL/ GL SCW AL/ GL WD/GL SCW GL/WD AL/ GL SCW GL/WD SCW AL/ GL SCW SCW AL/ GL SCW SCW AL/ GL  | MTL AL MTL AL MTL HM  MTL AL  HM  MTL AL  HM  MTL  HM  MTL  HH  MTL  AL  HHM  MTL  AL  HM  MTL  HM  MTL  HM  MTL  HM  MTL  HM  MTL  MTL   | Y H P H V P H V P K V P K Y V H H H H H H H H H H H H H H H H H H                   | 20MI<br>N<br>20MI<br>N<br>20MI<br>N<br>20MI<br>N<br>20MI<br>N | EXTERIOR STOREFRONT  EXTERIOR STOREFRONT  EXTERIOR STOREFRONT  EXTERIOR STOREFRONT  EXTERIOR STOREFRONT   |
| 1246-3<br>1246-4<br>1246-5<br>1247-1<br>1247-2<br>1247-3<br>1248-3<br>1248-5<br>1248-6<br>1249-1<br>1249-2<br>1249-3<br>1249-4<br>1250-1<br>1250-2<br>1250-3<br>1251-1<br>1251-2<br>1251-3<br>1251-4<br>1252-1<br>1252-2<br>1252-3<br>1252-5<br>1253-1                     | BATH HOTEL ROOM  HOTEL ROOM HOTEL ROOM HOTEL ROOM BATH HOTEL ROOM DINING  HOTEL ROOM | HOTEL ROOM HOTEL ROOM  BATH  HOTEL ROOM  MASTER BEDROOM HOTEL ROOM  BATH HOTEL ROOM  BATH HOTEL ROOM | 4' - 0" 2' - 10" 3' - 0" 2' - 10" 3' - 0" 2' - 10" 3' - 0" 3' - 0" 3' - 0" 3' - 0" 3' - 0" 3' - 0" 3' - 0" 2' - 10" 3' - 0" 2' - 10" 3' - 0" 2' - 10" 3' - 0" 2' - 10" 3' - 0" 2' - 10" 3' - 0" 2' - 10" 3' - 0" 2' - 10" 3' - 0" 2' - 10" 3' - 0" 2' - 10" 3' - 0" 2' - 10" 3' - 0" 2' - 10" 3' - 0" | 7' - 0" | 0' - 1 3/4"  0' - 1 3/8"  0' - 1 3/8"  0' - 1 3/4"  0' - 1 3/4"  0' - 1 3/4"  0' - 1 3/4"  0' - 1 3/4"  0' - 1 3/4"  0' - 1 3/4"  0' - 1 3/4"  0' - 1 3/4"  0' - 1 3/4"  0' - 1 3/4"  0' - 1 3/4" | SCW SCW AL/GL GL/WD AL/ GL SCW AL/ GL SCW GL/WD AL/ GL SCW GL/WD SCW AL/ GL  | MTL AL MTL AL MTL AL MTL AL MTL AL  HM  AL  | Y H P H V P H V P K V P K Y V H P H V H H H H H H H H H H H H H H H                 | 20MI<br>N<br>20MI<br>N<br>20MI<br>N<br>20MI<br>N<br>20MI<br>N | EXTERIOR STOREFRONT  EXTERIOR STOREFRONT  EXTERIOR STOREFRONT  EXTERIOR STOREFRONT  EXTERIOR STOREFRONT  EXTERIOR STOREFRONT                      |
| 1246-3<br>1246-4<br>1246-5<br>1247-1<br>1247-2<br>1247-3<br>1248-1<br>1248-3<br>1248-5<br>1248-6<br>1249-1<br>1249-2<br>1249-3<br>1249-4<br>1250-1<br>1250-2<br>1250-3<br>1250-4<br>1251-1<br>1251-2<br>1251-3<br>1251-4<br>1252-1<br>1252-2<br>1252-3<br>1252-5<br>1253-1 | BATH HOTEL ROOM HOTEL ROOM HOTEL ROOM HOTEL ROOM BATH HOTEL ROOM DINING HOTEL ROOM                                    | HOTEL ROOM HOTEL ROOM  HOTEL ROOM  BATH  HOTEL ROOM  MASTER BEDROOM HOTEL ROOM  BATH HOTEL ROOM      | 4' - 0" 2' - 10" 3' - 0" 2' - 10" 3' - 0" 2' - 10" 3' - 0" 3' - 0" 3' - 0" 3' - 0" 3' - 0" 3' - 0" 2' - 10" 3' - 0" 3' - 0" 2' - 10" 3' - 0" 2' - 10" 3' - 0" 2' - 10" 3' - 0" 2' - 10" 3' - 0" 2' - 10" 3' - 0" 2' - 10" 3' - 0" 2' - 10" 3' - 0"  | 7' - 0" | 0' - 1 3/4"  0' - 1 3/8"  0' - 1 3/8"  0' - 1 3/4"  0' - 1 3/4"  0' - 1 3/4"  0' - 1 3/4"  0' - 1 3/4"  0' - 1 3/4"  0' - 1 3/4"  0' - 1 3/4"  0' - 1 3/4"  0' - 1 3/4"  0' - 1 3/4"  0' - 1 3/4" | SCW  SCW  AL/GL  GL/WD  AL/ GL  SCW  GL/WD  AL/ GL  SCW  GL/WD  SCW  AL/ GL  SCW  SCW  AL/ GL  SCW  SCW  AL/ GL  SCW  SCW  AL/ GL  SCW  SCW  SCW  SCW  AL/ GL  SCW  SCW  AL/ GL  SCW | MTL AL MTL AL MTL AL MTL AL MTL AL MTL AL HM  MTL  AL HM  AL | V Y H P H V P H V P K Y V P K Y V P H D H V H P H F H F H F H F H F H F H F H F H F | 20MI<br>N<br>20MI<br>N<br>20MI<br>N<br>20MI<br>N<br>20MI<br>N | EXTERIOR STOREFRONT  EXTERIOR STOREFRONT  EXTERIOR STOREFRONT  EXTERIOR STOREFRONT  EXTERIOR STOREFRONT  EXTERIOR STOREFRONT  EXTERIOR STOREFRONT |



THESE PLANS AND SPECIFICATIONS HAVE BEEN PREPARED BY ME OR UNDER MY CLOSE PERSONAL SUPERVISION AND TO THE BEST OF MY KNOWLEDGE AND BELIEF THEY COMPLY WITH ALL CITY, STATE AND FEDERAL REQUIREMENTS, AND I AM NOT PROVIDING CONTRACT ADMINISTRATION.

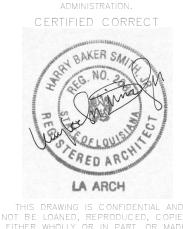

THIS DRAWING IS CONFIDENTIAL AND NOT BE LOANED, REPRODUCED, COPIED, EITHER WHOLLY OR IN PART, OR MADE PUBLIC IN ANY MANNER WITHOUT THE WRITTEN CONSENT OF HBSA II ARCHITECTS, A PROFESSIONAL L.L.C. ALL RIGHTS OF DESIGN OR INVENTION ARE RESERVED AND WILL REMAIN THE SOLE PROPERTY OF HBSA II ARCHITECTS A PROFESSIONAL L.L.C. REVISION HISTORY

| 1       L.I.S. #2 - CLOUD REVISION 1       4/27/2018         2       L.I.S. #2 - CLOUD REVISION 2       5/4/2018         3       L.I.S. #2 - CLOUD REVISION 4       5/11/2018         4       L.I.S. #2 - CLOUD REVISION 4       5/18/2018         5       L.I.S. #2 - CLOUD REVISION 6       6/1/2018         6       L.I.S. #2 - CLOUD REVISION 6       6/1/2018         7       L.I.S. #2 - CLOUD REVISION 7       6/8/2018 | 1 |                         |                         |                         |                         |                         |                         |                         |     |
|--|---|-------------------------|-------------------------|-------------------------|-------------------------|-------------------------|-------------------------|-------------------------|-----|
|  |   | 4/27/2018               | 5/4/2018                | 5/11/2018               | 5/18/2018               | 5/25/2018               | 6/1/2018                | 6/8/2018                |     |
|  |   | ON 1                    | ON 2                    | ON 3                    | ON 4                    | ON 5                    | ON 6                    | ON 7                    |     |
| - 0 0 4 0 0 r 0  |   | L.I.S. #2 - CLOUD REVIS |     |
|  |   | -                       | 0                       | ဇ                       | 4                       | 2                       | 9                       | 7                       | - ∞ |

SCHEDULES

PROJECT#: 1709
PHASE: DD
TEAM: Author
CHECKER: Checker
SCALE: AS NOTED
ISSUED: 4/20/2018
SHEET#:
A6.7

|  |  |                  | DOO   | R SCHE  | DULE - 13TH            | FLOOR                                |                        |                  |                |                     |
|--|--|------------------|---|---|------------------------|--------------------------------------|------------------------|------------------|----------------|---------------------|
| 关  | Σ  |                  | E   | THE   | THICKNESS              | DOOR MATERIAL                        | DOOR FRAME             | R TYPE           | FIRE RATING    | REMARKS             |
| MARK   | FROM   | 0                | WIDTH   | HEIGHT  | DHT.                   | 000                                  | 000                    | DOOR             | FIRE           | REM                 |
| 1300   |  |                  | 3' - 0"   | 7' - 0"   | 0' - 1 3/4"            |                                      |                        |                  | 20MIN          |                     |
| 1300-1   | DATIL  |                  | 3' - 0"   | 7' - 0"   | 0' - 1 3/4"            | SCW                                  | HM                     | ٧                | 20MIN          |                     |
| 1300-2<br>1300-3   | BATH   |                  | 3' - 0"<br>3' - 0"                                  | 7' - 0"<br>7' - 0"                                  |                        | WD/GL<br>SCW                         | MTL<br>MTL             | P<br>Y           |                |                     |
| 1300-4   | HOTEL ROOM                                       |                  | 2' - 10"  | 7' - 0"   | 0' - 1 3/8"            | AL/ GL                               | AL                     | Н                |                | EXTERIOR STOREFRONT |
|  | PUMP ROOM<br>HOTEL ROOM                          | GENERATOR        | 3' - 0"<br>3' - 0"                                  | 7' - 0"<br>7' - 0"                                  | 0' - 1 3/4"            | SCW                                  | НМ                     | V                | 45MIN<br>20MIN |                     |
| 1301-2   |  | HOTEL ROOM       | 4' - 0"   | 7' - 0"   | 0' - 1 1/2"            | SCW                                  | MTL                    | Υ                |                |                     |
|  | HOTEL ROOM                                       | BATH             | 2' - 10"<br>3' - 0"                                 | 7' - 0"<br>7' - 0"                                  | 0' - 1 3/8"            | AL/ GL<br>WD/GL                      | AL<br>MTL              | H<br>P           |                | EXTERIOR STOREFRONT |
| 1301-5   | HOTEL ROOM                                       |                  | 2' - 10"  | 7' - 0"   | 0' - 1 3/8"            | AL/ GL                               | AL                     | Н                |                | EXTERIOR STOREFRONT |
| 1302   | GENERATOR  | ELECTRIC<br>MEZZ | 10' - 0"  | 10' - 0"  | 0' - 1 3/4"            |                                      |                        |                  |                |                     |
| 1302-1   |  | HOTEL ROOM       | 3' - 0"   | 7' - 0"   | 0' - 1 3/4"            | SCW                                  | НМ                     | _                | 20MIN          |                     |
|  | HOTEL ROOM                                       | BATH             | 3' - 0"<br>2' - 8"                                  | 7' - 0"<br>7' - 0"                                  |                        | WD/GL<br>SCW                         | M<br>MTL               | P<br>Y           |                |                     |
| 1302-4   |  | HOTEL ROOM       | 2' - 9 7/32"  |   | 0' - 1 1/2"            | AL/GL                                | AL                     | K                |                | EXTERIOR STOREFRONT |
|  | HOTEL ROOM                                       | BATH             | 3' - 0"<br>3' - 0"                                  | 7' - 0"<br>7' - 0"                                  | 0' - 1 3/4"            | SCW<br>WD/GL                         | HM<br>MTL              | V<br>P           | 20MIN          |                     |
| 1303-3   |  | HOTEL ROOM       | 2' - 8"   | 7' - 0"   |                        | SCW                                  | MTL                    | Υ                |                |                     |
| 1303-4   | HOTEL ROOM                                       | HOTEL ROOM       | 6' - 8"<br>3' - 0"                                  | 7' - 0"<br>7' - 0"                                  | 0' - 2"                | AL/GL<br>SCW                         | AL<br>HM               | H<br>V           | 20MIN          | EXTERIOR STOREFRONT |
| 1304-2   |  |                  | 3' - 0"   | 7' - 0"   |                        | WD/GL                                | MTL                    | Р                |                |                     |
|  | HOTEL ROOM                                       |                  | 2' - 8"<br>6' - 8"                                  | 7' - 0"<br>7' - 0"                                  | 0' - 2"                | SCW<br>AL/GL                         | MTL<br>AL              | Y<br>H           |                | EXTERIOR STOREFRONT |
| 1305-1   | HOTEL ROOM                                       |                  | 3' - 0"   | 7' - 0"   | 0' - 1 3/4"            | SCW                                  | НМ                     | V                | 20MIN          | 2.1.2.2.2.1.10111   |
| 1305-2<br>1305-3   | HOTEL ROOM                                       |                  | 3' - 0"<br>2' - 8"                                  | 7' - 0"<br>7' - 0"                                  |                        | WD/GL<br>SCW                         | MTL<br>MTL             | P<br>Y           |                |                     |
| 1305-4   | HOTEL ROOM                                       |                  | 6' - 8"   | 7' - 0"   | 0' - 2"                | AL/GL                                | AL                     | Н                |                | EXTERIOR STOREFRONT |
| 1306-1<br>1306-2   | BATH   |                  | 3' - 0"<br>3' - 0"                                  | 7' - 0"<br>7' - 0"                                  | 0' - 1 3/4"            | SCW<br>WD/GL                         | HM<br>MTL              | V<br>P           | 20MIN          |                     |
| 1306-3   | HOTEL ROOM                                       | TIOTELTIOON      | 2' - 8"   | 7' - 0"   |                        | SCW                                  | MTL                    | Y                |                |                     |
|  | HOTEL ROOM                                       |                  | 6' - 8"<br>3' - 0"                                  | 7' - 0"<br>7' - 0"                                  | 0' - 2"                | AL/GL<br>SCW                         | AL<br>HM               | H<br>V           | 20MIN          | EXTERIOR STOREFRONT |
|  | HOTEL ROOM                                       | BATH             | 3' - 0"   | 7' - 0"   | 0 - 1 3/4              |                                      | MTL                    | P                | ZUIVIIIN       |                     |
| 1307-3   | LIOTEL DOOM                                      | HOTEL ROOM       | 2' - 8"<br>2' - 9 7/32"                             | 7' - 0"   | 0' - 1 1/2"            | SCW                                  | MTL                    | Υ                |                | EVIEDIOD STODEFDONT |
| 1307-4   | HOTEL ROOM                                       | HOTEL ROOM       |   | 7' - 0"   | 0' - 1 3/4"            | AL/GL<br>SCW                         | AL<br>HM               | K<br>V           | 20MIN          | EXTERIOR STOREFRONT |
|  | HOTEL ROOM                                       | LIOTEL BOOM      | 6' - 8"<br>6' - 0"                                  | 7' - 0"<br>7' - 0"                                  | 0' - 2"                | AL/ GL                               | AL                     | Н                |                | EXTERIOR STOREFRONT |
| 1308-3<br>1308-4   | BAIH   | HOTEL ROOM       |   | 7' - 0"   |                        | GL/WD<br>SCW                         | MTL<br>MTL             | Q<br>Y           |                |                     |
| 1309-1   | DATU   |                  | 3' - 0"   | 7' - 0"   | 0' - 1 3/4"            | SCW                                  | HM                     | _                | 20MIN          |                     |
| 1309-2<br>1309-3   | BATH   | HOTEL ROOM       | 3' - 0"<br>2' - 8"                                  | 7' - 0"<br>7' - 0"                                  |                        | WD/GL<br>SCW                         | MTL<br>MTL             | P<br>Y           |                |                     |
|  | HOTEL ROOM                                       |                  | 5' - 0"   | 7' - 0"   | 0' - 2"                | AL/ GL                               | AL                     | Н                | COMINI         | EXTERIOR STOREFRONT |
|  | HOTEL ROOM                                       | BATH             | 3' - 0"<br>3' - 0"                                  | 7' - 0"<br>7' - 0"                                  | 0' - 1 3/4"            | SCW<br>GL/WD                         | HM<br>MTL              | V<br>P           | 20MIN          |                     |
|  | HOTEL ROOM                                       |                  | 2' - 8"   | 7' - 0"   | 0' 0"                  | SCW                                  | MTL                    | Υ                |                | EVERIOR STORERONT   |
| 1310-4   | HOTEL ROOM                                       | HOTEL ROOM       | 6' - 8"<br>3' - 0"                                  | 7' - 0"<br>7' - 0"                                  | 0' - 2"                | AL/ GL<br>SCW                        | AL<br>HM               | H<br>V           | 20MIN          | EXTERIOR STOREFRONT |
|  | HOTEL ROOM                                       |                  | 3' - 0"   | 7' - 0"   |                        | WD/GL                                | MTL                    | Р                |                |                     |
| 1311-3<br>1311-4   | HOTEL ROOM                                       | HOTEL ROOM       | 3' - 0"<br>6' - 0"                                  | 7' - 0"<br>7' - 0"                                  | 0' - 2"                | SCW<br>AL/ GL                        | MTL<br>AL              | Y<br>H           |                | EXTERIOR STOREFRONT |
| 1312-1<br>1312-2   | DATH   |                  | 3' - 0"<br>3' - 0"                                  | 7' - 0"<br>7' - 0"                                  | 0' - 1 3/4"            | SCW<br>GL/WD                         | HM<br>MTL              | _                | 20MIN          |                     |
| 1312-2   | BAIH   |                  | 6' - 8"   | 7' - 0"   | 0' - 2"                | AL/ GL                               | AL                     | P<br>H           |                | EXTERIOR STOREFRONT |
| 1313-1<br>1313-2   | HOTEL ROOM                                       | LIOTEL BOOM      | 3' - 0"<br>3' - 0"                                  | 7' - 0"<br>7' - 0"                                  | 0' - 1 3/4"            | SCW<br>WD/GL                         | HM<br>MTL              | _                | 20MIN          |                     |
|  | HOTEL ROOM                                       | HOTEL ROOM       | 3' - 0"   | 7' - 0"   |                        | SCW                                  | MTL                    | P<br>Y           |                |                     |
|  | HOTEL ROOM                                       |                  | 6' - 0"<br>3' - 0"                                  | 7' - 0"<br>7' - 0"                                  | 0' - 2"<br>0' - 1 3/4" | AL/ GL<br>SCW                        | AL<br>HM               | H<br>V           | 20MIN          | EXTERIOR STOREFRONT |
|  | HOTEL ROOM                                       | BATH             | 3' - 0"   | 7' - 0"   | 0 - 1 3/4              | GL/WD                                | MTL                    | P                | ZUIVIIIN       |                     |
| 1314-3<br>1315-1   | HOTEL ROOM                                       | HOTEL ROOM       | 6' - 0"<br>3' - 0"                                  | 7' - 0"<br>7' - 0"                                  | 0' - 2"<br>0' - 1 3/4" | AL/ GL<br>HM                         | AL<br>HM               | H<br>V           | 20MIN          | EXTERIOR STOREFRONT |
| 1315-1   | BATH   | HOTEL ROOM       | 3' - 0"   | 7' - 0"   | 0 - 1 3/4              | GL/WD                                | MTL                    | v<br>P           | LUIVIIIN       |                     |
| 1315-3   | HOTEL ROOM                                       | HOTEL ROOM       | 2' - 8"<br>6' - 0"                                  | 7' - 0"<br>7' - 0"                                  | 0' - 2"                | SCW<br>AL/ GL                        | MTL<br>AL              | Y                |                | EXTERIOR STOREFRONT |
| 1316-1   | HOTEL ROOM                                       |                  | 3' - 0"   | 7' - 0"   | 0' - 2"                | SCW                                  | НМ                     |                  | 20MIN          | LATERIOR STOREFRONT |
|  | HOTEL ROOM                                       | BATH             | 3' - 0"<br>2' - 8"                                  | 7' - 0"<br>7' - 0"                                  |                        | GL/WD<br>SCW                         | MTL<br>MTL             | P<br>Y           |                |                     |
| 1316-4   | HOTEL ROOM                                       |                  | 6' - 0"   | 7' - 0"   | 0' - 2"                | AL/ GL                               | AL                     | H                |                | EXTERIOR STOREFRONT |
| 1317-1<br>1317-2   | ВДТН   |                  | 3' - 0"<br>3' - 0"                                  | 7' - 0"<br>7' - 0"                                  | 0' - 1 3/4"            | SCW<br>GL/WD                         | HM<br>MTL              | V<br>P           | 20MIN          |                     |
| 1317-3   |  |                  | 2' - 8"   | 7' - 0"   |                        | SCW                                  | MTL                    | Y                |                |                     |
|  | HOTEL ROOM                                       |                  | 6' - 0"<br>3' - 0"                                  | 7' - 0"<br>7' - 0"                                  | 0' - 2"<br>0' - 1 3/4" | AL/ GL<br>SCW                        | AL<br>HM               | H<br>V           | 20MIN          | EXTERIOR STOREFRONT |
| 1318-2   | HOTEL ROOM                                       |                  | 3' - 0"   | 7' - 0"   | 0 1 3/4                | GL/WD                                | MTL                    | Р                | COMIN          |                     |
| 1318-3   | HOTEL ROOM                                       | HOTEL ROOM       | 2' - 8"<br>6' - 0"                                  | 7' - 0"<br>7' - 0"                                  | 0' - 2"                | SCW<br>AL/ GL                        | MTL<br>HM              | Y<br>H           |                | EXTERIOR STOREFRONT |
| 1319-1   |  | HOTEL ROOM       | 3' - 0"   | 7' - 0"   | 0' - 1 3/4"            | SCW                                  | НМ                     | V                | 20MIN          |                     |
| 1319-2<br>1319-3   | BATH<br>HOTEL ROOM                               | HOTEL ROOM       | 3' - 0"<br>2' - 8"                                  | 7' - 0"<br>7' - 0"                                  |                        | GL/WD<br>SCW                         | MTL<br>MTL             | P<br>Y           |                |                     |
| 1319-4   | HOTEL ROOM                                       |                  | 6' - 0"   | 7' - 0"   | 0' - 2"                | AL/ GL                               | AL                     | Н                |                | EXTERIOR STOREFRONT |
|  | HOTEL ROOM                                       | ВАТН             | 3' - 0"<br>3' - 0"                                  | 7' - 0"<br>7' - 0"                                  | 0' - 1 3/4"            | SCW<br>GL/WD                         | HM<br>MTL              | V<br>P           | 20MIN          |                     |
| 1320-3   | HOTEL ROOM                                       | -, (III          | 2' - 8"   | 7' - 0"   |                        | SCW                                  | MTL                    | Υ                |                |                     |
| 1320-4<br>1321-1   | HOTEL ROOM                                       | HOTEL ROOM       | 6' - 0"<br>3' - 0"                                  | 7' - 0"<br>7' - 0"                                  | 0' - 2"<br>0' - 1 3/4" | AL/ GL<br>SCW                        | AL<br>HM               | H<br>V           | 20MIN          | EXTERIOR STOREFRONT |
|  | BATH   |                  | 3' - 0"   | 7' - 0"   | 0 1 3/4                | GL/WD                                | MTL                    | v<br>P           | COMIN          |                     |
|  |  |                  | 2' - 8"   | 7' - 0"   | 0' - 2"                | SCW                                  | MTL                    | Υ                |                | EYTEDIOD STOREDONT  |
| 1321-3   | HOTEL ROOM                                       |                  | 6' 0"   | 1 / / / / / / / / / / / / / / / / / / /             | U - Δ"                 | AL/ GL                               | AL                     | Н                | 1              | EXTERIOR STOREFRONT |
| 1321-3<br>1321-4   | HOTEL ROOM<br>HOTEL ROOM                         |                  | 6' - 0"<br>3' - 0"                                  | 7' - 0"<br>7' - 0"                                  | 0' - 1 3/4"            | SCW                                  | HM                     | V                | 20MIN          |                     |
| 1321-3<br>1321-4<br>1322-1<br>1322-2   | HOTEL ROOM<br>HOTEL ROOM                         | HOTEL ROOM       | 3' - 0"<br>2' - 8"                                  | 7' - 0"<br>7' - 0"                                  | 0' - 1 3/4"            | SCW<br>SCW                           | MTL                    | Υ                | 20MIN          |                     |
| 1321-3<br>1321-4<br>1322-1<br>1322-2<br>1322-3                               | HOTEL ROOM<br>HOTEL ROOM                         | HOTEL ROOM       | 3' - 0"<br>2' - 8"                                  | 7' - 0"   |                        | SCW<br>SCW<br>WD/GL                  | MTL<br>MTL             |                  | 20MIN          | EXTERIOR STOREFRONT |
| 1321-3<br>1321-4<br>1322-1<br>1322-2<br>1322-3<br>1322-6<br>1323-1           | HOTEL ROOM HOTEL ROOM BATH HOTEL ROOM HOTEL ROOM | HOTEL ROOM       | 3' - 0"<br>2' - 8"<br>3' - 0"<br>6' - 0"<br>3' - 0" | 7' - 0"<br>7' - 0"<br>7' - 0"<br>7' - 0"<br>7' - 0" |                        | SCW<br>SCW<br>WD/GL<br>AL/ GL<br>SCW | MTL<br>MTL<br>AL<br>HM | Y<br>P<br>H<br>V | 20MIN<br>20MIN | EXTERIOR STOREFRONT |
| 1321-3<br>1321-4<br>1322-1<br>1322-2<br>1322-3<br>1322-6<br>1323-1<br>1323-2 | HOTEL ROOM HOTEL ROOM BATH HOTEL ROOM            | HOTEL ROOM       | 3' - 0"<br>2' - 8"<br>3' - 0"<br>6' - 0"            | 7' - 0"<br>7' - 0"<br>7' - 0"<br>7' - 0"            | 0' - 2"                | SCW<br>SCW<br>WD/GL<br>AL/ GL<br>SCW | MTL<br>MTL<br>AL       | Y<br>P<br>H      |                | EXTERIOR STOREFRONT |

| MARK   | FROM  | 0  | WIDTH  | НЕІСНТ  | THICKNESS  | DOOR MATERIAL   | DOOR FRAME   | DOOR TYPE   | FIRE RATING             | REMARKS               |
|--|---|--|--|---|--|---|--|---|-------------------------|-----------------------|
| 1324-1   | HOTEL ROOM  |  | 3' - 0"  | 7' - 0"   | 0' - 1 3/4"  | SCW   | НМ   | V   | 20MIN                   |                       |
|  | HOTEL ROOM  | BATH   | 3' - 0"<br>2' - 8"   | 7' - 0"<br>7' - 0"  |  | WD/GL<br>SCW  | MTL<br>MTL   | P<br>Y  |                         |                       |
| 1324-4   |   |  | 6' - 0"  | 7' - 0"   | 0' - 2"  | AL/ GL  | AL   | Н   |                         | EXTERIOR STOREFRO     |
| 1325-1   |   | HOTEL ROOM   | 3' - 0"  | 7' - 0"   | 0' - 1 3/4"  | SCW   | НМ   | ٧   | 20MIN                   |                       |
| 1325-2<br>1325-3   | BATH<br>HOTEL ROOM  | HOTEL ROOM   | 3' - 0"<br>2' - 8"   | 7' - 0"<br>7' - 0"  |  | GL/WD<br>SCW  | MTL<br>MTL   | P<br>Y  |                         |                       |
| 1325-4   |   |  | 6' - 0"  | 7' - 0"   | 0' - 2"  | AL/ GL  | AL   | Н   |                         | EXTERIOR STOREFRO     |
| 1326-1   |   | HOTEL ROOM   | 3' - 0"  | 7' - 0"   | 0' - 1 3/4"  | SCW   | НМ   | ٧   | 20MIN                   |                       |
|  | BATH<br>HOTEL ROOM  | HOTEL ROOM   | 3' - 0"<br>2' - 8"   | 7' - 0"<br>7' - 0"  |  | WD/GL<br>SCW  | MTL<br>MTL   | P<br>Y  |                         |                       |
| 1326-4   |   |  | 6' - 0"  | 7' - 0"   | 0' - 2"  | AL/ GL  | AL   | Н   |                         | EXTERIOR STOREFRO     |
| 1327-1   | HOTEL ROOM  | BATH   | 3' - 0"  | 7' - 0"<br>7' - 0"  | 0' - 1 3/4"  | SCW<br>GL/WD  | HM<br>MTL  | V<br>P  | 20MIN                   |                       |
|  | HOTEL ROOM  | DAIN   | 2' - 8"  | 7' - 0"   |  | SCW   | MTL  | Y   |                         |                       |
|  | HOTEL ROOM  |  | 6' - 0"  | 7' - 0"   | 0' - 2"  | AL/ GL  | AL   | Н   |                         | EXTERIOR STOREFRO     |
| 1328-1<br>1328-2   |   | BATH   | 3' - 0"<br>3' - 0"   | 7' - 0"<br>7' - 0"  | 0' - 1 3/4"  | SCW<br>WD/GL  | HM<br>MTL  | V   | 20MIN                   |                       |
| 1328-3   |   | DATIT  | 6' - 0"  | 7' - 0"   | 0' - 2"  | AL/ GL  | AL   | Н   |                         | EXTERIOR STOREFRO     |
| 1329-1   |   | HOTEL ROOM   | 3' - 0"  | 7' - 0"   | 0' - 1 3/4"  | SCW   | НМ   | ٧   | 20MIN                   |                       |
| 1329-2<br>1329-3   | BATH<br>HOTEL ROOM  | HOTEL ROOM   | 3' - 0"<br>6' - 0"   | 7' - 0"<br>7' - 0"  | 0' - 2"  | WD/GL<br>AL/ GL   | MTL<br>AL  | P<br>H  |                         | EXTERIOR STOREFRO     |
| 1330-1   |   |  | 3' - 0"  | 7' - 0"   | 0' - 1 3/4"  | SCW   | HM   | ٧   | 20MIN                   | EXTERIOR OF OTHER TRO |
|  | HOTEL ROOM  | BATH   | 3' - 0"  | 7' - 0"   |  | WD/GL   | MTL  | Р   |                         |                       |
| 1330-3<br>1331-1   | HOTEL ROOM  | HOTEL ROOM   | 6' - 8"<br>3' - 0"   | 7' - 0"<br>7' - 0"  | 0' - 2"  | AL/ GL<br>SCW   | AL<br>HM   | H   | 20MIN                   | EXTERIOR STOREFRO     |
|  | HOTEL ROOM  | BATH   | 3' - 0"  | 7' - 0"   |  | WD/GL   | MTL  | P   | _ JIVIII N              |                       |
| 1331-3   | HOTEL ROOM  |  | 6' - 8"  | 7' - 0"   | 0' - 2"  | AL/ GL  | AL   | Н   | 001                     | EXTERIOR STOREFRO     |
| 1332-1<br>1332-2   |   | HOTEL ROOM   |  | 7' - 0"<br>7' - 0"  | 0' - 1 3/4"  | SCW   | HM<br>MTL  | V<br>Y  | 20MIN                   |                       |
|  | HOTEL ROOM  | BATH   | 3' - 0"  | 7' - 0"   |  | GL/WD   | MTL  | P   |                         |                       |
|  | HOTEL ROOM  |  | 6' - 8"  | 7' - 0"   | 0' - 2"  | AL/ GL  | AL   | Н   |                         | EXTERIOR STOREFRO     |
| 1332-5<br>1333-1   | HOTEL ROOM  | HOTEL ROOM   | 6' - 8"<br>3' - 0"   | 7' - 0"<br>7' - 0"  | 0' - 2"  | AL/ GL<br>SCW   | AL<br>HM   | H<br>V  | 20MIN                   | EXTERIOR STOREFRO     |
|  | BATH  | HOTEL ROOM   | 3' - 0"  | 7' - 0"   | 0 1 0/ 1   | WD/GL   | MTL  | P   | ZOWIII                  |                       |
| 1334-1   |   | HOTEL ROOM   | 3' - 0"<br>3' - 0"   | 7' - 0"<br>7' - 0"  | 0' - 1 3/4"  | SCW   | HM   | V   | 20MIN                   |                       |
| 1334-2<br>1334-3   | BATH<br>HOTEL ROOM  | HOTEL ROOM   | 6' - 8"  | 7' - 0"   | 0' - 2"  | GL/WD<br>AL/ GL   | MTL<br>AL  | P<br>H  |                         | EXTERIOR STOREFRO     |
| 1335-1   |   | HOTEL ROOM   |  | 7' - 0"   | 0' - 1 3/4"  | SCW   | НМ   | ٧   | 20MIN                   |                       |
|  | BATH<br>HOTEL ROOM  | HOTEL ROOM   | 3' - 0"<br>2' - 8"   | 7' - 0"<br>7' - 0"  |  | GL/WD<br>SCW  | MTL<br>MTL   | P<br>Y  |                         |                       |
|  | HOTEL ROOM  |  | 6' - 8"  | 7' - 0"   | 0' - 2"  | AL/GL   | AL   | Н   |                         | EXTERIOR STOREFRO     |
|  | HOTEL ROOM  | DATU   | 3' - 0"  | 7' - 0"   | 0' - 1 3/4"  | SCW   | HM   | ٧   | 20MIN                   |                       |
|  | HOTEL ROOM  | BATH   | 3' - 0"<br>2' - 8"   | 7' - 0"<br>7' - 0"  |  | GL/WD<br>SCW  | MTL<br>MTL   | P<br>Y  |                         |                       |
| 1336-4   | HOTEL ROOM  |  | 6' - 8"  | 7' - 0"   | 0' - 2"  | AL/ GL  | AL   | Н   |                         | EXTERIOR STOREFRO     |
| 1337-1   | BATH  | HOTEL ROOM   | 3' - 0"  | 7' - 0"<br>7' - 0"  | 0' - 1 3/4"  | SCW<br>GL/WD  | HM<br>MTL  | V<br>P  | 20MIN                   |                       |
|  | HOTEL ROOM  | TIOTEE TIOON   | 2' - 8"  | 7' - 0"   |  | SCW   | MTL  | Y   |                         |                       |
|  | HOTEL ROOM  |  | 6' - 8"  | 7' - 0"   | 0' - 2"  | AL/ GL  | AL   | Н   | OOMAINI                 | EXTERIOR STOREFRO     |
| 1338-1<br>1338-2   | HOTEL ROOM  | BATH   | 3' - 0"  | 7' - 0"<br>7' - 0"  | 0' - 1 3/4"  | HM<br>GL/WD   | HM<br>MTL  | V   | 20MIN                   |                       |
| 1338-3   | HOTEL ROOM  |  | 2' - 8"  | 7' - 0"   |  | SCW   | MTL  | Υ   |                         |                       |
| 1338-4<br>1339-1   | HOTEL ROOM  | HOTEL ROOM   | 6' - 8"<br>3' - 0"   | 7' - 0"<br>7' - 0"  | 0' - 2"  | AL/ GL<br>HM  | AL<br>HM   | H<br>V  | 20MIN                   | EXTERIOR STOREFRO     |
|  | BATH  | HOTEL ROOM   | 3' - 0"  | 7' - 0"   | 0 - 1 3/4  | GL/WD   | MTL  | P   | ZUIVIIIN                |                       |
|  | HOTEL ROOM  |  | 2' - 8"  | 7' - 0"   |  | SCW   | MTL  | Υ   |                         |                       |
| 1339-4<br>1340-1   |   |  | 6' - 8"<br>3' - 0"   | 7' - 0"<br>7' - 0"  | 0' - 2"  | AL/ GL<br>SCW   | AL<br>HM   | H   | 20MIN                   | EXTERIOR STOREFRO     |
| 1340-2   |   | HOTEL ROOM   |  | 7' - 0"   | 0' - 2"  |   | AL   | Н   | ZOWIII                  | EXTERIOR STOREFRO     |
|  | BATH  | HOTEL ROOM   |  | 7' - 0"   | 01 4 0/411   |   | MTL  | Р   | 0014111                 |                       |
|  | VESTIBULE<br>BATH   | HOTEL ROOM   |  | 7' - 0"<br>7' - 0"  | 0' - 1 3/4"  | SCW<br>WD/GL  | HM<br>MTL  | V<br>P  | 20MIN                   |                       |
| 1341-3   |   | HOTEL ROOM   | 6' - 0"  | 7' - 0"   | 0' - 2"  | AL/ GL  | AL   | Н   |                         | EXTERIOR STOREFRO     |
| 1341-4   |   | HOTEL ROOM   |  | 7' - 0"   | 0' 10'0"   | SCW   | MTL  | Υ   |                         | EVTEDIOD OTODEED      |
|  | HOTEL ROOM  | VESTIBULE  | 2' - 10"<br>3' - 0"  | 7' - 0"<br>7' - 0"  | 0' - 1 3/8"  | AL/ GL<br>SCW   | AL<br>HM   | H<br>V  | 20MIN                   | EXTERIOR STOREFRO     |
| 1342-2   |   | HOTEL ROOM   | 2' - 8"  | 7' - 0"   |  | SCW   | MTL  | Υ   |                         |                       |
| 1342-3   | HOTEL ROOM  | HOTEL ROOM<br>BATH   | 2' - 10"<br>3' - 0"  | 7' - 0"<br>7' - 0"  | 0' - 1 3/8"  | AL/ GL<br>WD/GL   | AL<br>MTL  | H<br>P  |                         | EXTERIOR STOREFRO     |
|  | HOTEL ROOM  | העוון  | 2' - 10"   | 7' - 0"   | 0' - 1 3/8"  | AL/ GL  | AL   | Н   |                         | EXTERIOR STOREFRO     |
| 1343-1   |   | HOTEL ROOM   | 3' - 0"  | 7' - 0"   | 0' - 1 3/4"  | SCW   | НМ   | ٧   | 20MIN                   |                       |
|  | HOTEL ROOM  | BATH   | 3' - 0"<br>3' - 0"   | 7' - 0"<br>7' - 0"  | 0' - 1 3/8"  | AL/ GL<br>WD/GL   | AL<br>MTL  | H<br>P  |                         | DOUBLE DOOR / PAIR    |
| 1343-2   | 11 11 / 1   | ا ۱۱۱۱ ر <u>ت</u>  | 3' - 0"  | 7' - 0"   | 0' - 1 3/4"  | SCW   | HM   | V   | 20MIN                   |                       |
| 1343-2<br>1343-3   | HOTEL ROOM  |  |  | 7' - 0"   | 01 4 2 (5)   | GL/WD   | MTL  | Р   |                         | EVTERIOR OTTO         |
| 1343-2<br>1343-3<br>1344-1<br>1344-3   | HOTEL ROOM<br>BATH  | HOTEL ROOM   |  |   | 0' - 1 3/8"  | AL/ GL<br>SCW   | AL<br>HM   | H<br>V  | 20MIN                   | EXTERIOR STOREFRO     |
| 1343-2<br>1343-3<br>1344-1<br>1344-3<br>1344-5   | HOTEL ROOM BATH HOTEL ROOM  |  | 2' - 10"   | 7' - 0"<br>7' - 0"  | 0 - 1 3/4  |   |  | P   |                         |                       |
| 1343-2<br>1343-3<br>1344-1<br>1344-3<br>1344-5<br>1345-1   | HOTEL ROOM BATH HOTEL ROOM HOTEL ROOM   | HOTEL ROOM<br>BATH   | 2' - 10"<br>3' - 0"<br>3' - 0"   | 7' - 0"<br>7' - 0"  | 0' - 1 3/4"  | GL/WD   | MTL  | -   |                         | i —                   |
| 1343-2<br>1344-1<br>1344-3<br>1344-5<br>1345-1<br>1345-2<br>1345-3   | HOTEL ROOM BATH HOTEL ROOM HOTEL ROOM   | HOTEL ROOM   | 2' - 10"<br>3' - 0"<br>3' - 0"<br>2' - 8"  | 7' - 0"<br>7' - 0"<br>7' - 0"   |  | GL/WD<br>SCW  | MTL  | Y   |                         | EXTERIOR STORES       |
| 1343-2<br>1343-3<br>1344-1<br>1344-3<br>1345-1<br>1345-1<br>1345-2<br>1345-3<br>1345-4   | HOTEL ROOM BATH HOTEL ROOM HOTEL ROOM   | HOTEL ROOM<br>BATH   | 2' - 10"<br>3' - 0"<br>3' - 0"   | 7' - 0"<br>7' - 0"<br>7' - 0"   | 0' - 1 3/8"  | GL/WD<br>SCW  |  | Y<br>K<br>V   | 20MIN                   | EXTERIOR STOREFRO     |
| 1343-2<br>1343-3<br>1344-1<br>1344-3<br>1344-5<br>1345-1<br>1345-2<br>1345-3<br>1345-4<br>1346-1<br>1346-2   | HOTEL ROOM BATH HOTEL ROOM HOTEL ROOM HOTEL ROOM HOTEL ROOM BATH  | HOTEL ROOM BATH HOTEL ROOM   | 2' - 10"<br>3' - 0"<br>3' - 0"<br>2' - 8"<br>3' - 0"<br>3' - 0"<br>3' - 0"   | 7' - 0"<br>7' - 0"<br>7' - 0"<br>7' - 0"<br>7' - 0"<br>7' - 0"  | 0' - 1 3/8"  | GL/WD<br>SCW<br>AL/ GL<br>SCW<br>WD/GL  | MTL<br>AL<br>HM<br>MTL   | K<br>V<br>P   | 20MIN                   | EXTERIOR STOREFRO     |
| 1343-2<br>1343-3<br>1344-1<br>1344-3<br>1345-1<br>1345-2<br>1345-3<br>1345-4<br>1346-1<br>1346-2<br>1346-3   | HOTEL ROOM BATH HOTEL ROOM HOTEL ROOM HOTEL ROOM HOTEL ROOM BATH  | HOTEL ROOM<br>BATH<br>HOTEL ROOM   | 2' - 10"<br>3' - 0"<br>3' - 0"<br>2' - 8"<br>3' - 0"<br>3' - 0"<br>3' - 0"<br>2' - 8"  | 7' - 0"<br>7' - 0"<br>7' - 0"<br>7' - 0"<br>7' - 0"<br>7' - 0"<br>7' - 0"   | 0' - 1 3/8"<br>0' - 1 3/4"   | GL/WD<br>SCW<br>AL/ GL<br>SCW<br>WD/GL<br>SCW   | MTL<br>AL<br>HM<br>MTL<br>MTL                                      | K<br>V<br>P<br>Y                                    | 20MIN                   |                       |
| 1343-2<br>1343-3<br>1344-1<br>1344-3<br>1345-1<br>1345-2<br>1345-3<br>1345-4<br>1346-1<br>1346-2<br>1346-3<br>1346-4   | HOTEL ROOM BATH HOTEL ROOM HOTEL ROOM HOTEL ROOM HOTEL ROOM BATH  | HOTEL ROOM BATH HOTEL ROOM   | 2' - 10"<br>3' - 0"<br>3' - 0"<br>2' - 8"<br>3' - 0"<br>3' - 0"<br>3' - 0"   | 7' - 0"<br>7' - 0"<br>7' - 0"<br>7' - 0"<br>7' - 0"<br>7' - 0"  | 0' - 1 3/8"  | GL/WD<br>SCW<br>AL/ GL<br>SCW<br>WD/GL  | MTL<br>AL<br>HM<br>MTL   | K<br>V<br>P   | 20MIN<br>20MIN          |                       |
| 1343-2<br>1344-1<br>1344-3<br>1344-5<br>1345-1<br>1345-2<br>1345-4<br>1346-1<br>1346-2<br>1346-4<br>1347-1<br>1347-2   | HOTEL ROOM BATH HOTEL ROOM HOTEL ROOM HOTEL ROOM BATH HOTEL ROOM BATH   | HOTEL ROOM  BATH HOTEL ROOM  HOTEL ROOM HOTEL ROOM                                     | 2' - 10"<br>3' - 0"<br>3' - 0"<br>2' - 8"<br>3' - 0"<br>3' - 0"<br>2' - 8"<br>3' - 0"<br>2' - 8"<br>3' - 0"<br>3' - 0"                                   | 7' - 0"<br>7' - 0"   | 0' - 1 3/8"<br>0' - 1 3/4"<br>0' - 1 3/8"  | GL/WD<br>SCW<br>AL/ GL<br>SCW<br>WD/GL<br>SCW<br>AL/ GL<br>SCW<br>GL/WD                                   | MTL AL HM MTL MTL AL HM MTL  | K<br>V<br>P<br>Y<br>K<br>V                          |                         |                       |
| 1343-2<br>1343-3<br>1344-1<br>1344-3<br>1345-1<br>1345-2<br>1345-3<br>1345-4<br>1346-2<br>1346-3<br>1346-4<br>1347-1<br>1347-2<br>1347-3   | HOTEL ROOM BATH HOTEL ROOM HOTEL ROOM HOTEL ROOM BATH HOTEL ROOM HOTEL ROOM BATH  | HOTEL ROOM BATH HOTEL ROOM HOTEL ROOM  | 2' - 10"<br>3' - 0"<br>3' - 0"<br>2' - 8"<br>3' - 0"<br>3' - 0"<br>2' - 8"<br>3' - 0"<br>3' - 0"<br>3' - 0"<br>2' - 8"                                   | 7' - 0"<br>7' - 0"   | 0' - 1 3/8"<br>0' - 1 3/4"<br>0' - 1 3/8"<br>0' - 1 3/4"                               | GL/WD<br>SCW<br>AL/ GL<br>SCW<br>WD/GL<br>SCW<br>AL/ GL<br>SCW<br>GL/WD<br>SCW                            | MTL AL HM MTL AL HM AL HM MTL HM                                   | K<br>V<br>P<br>Y<br>K<br>V<br>P<br>Y                |                         | EXTERIOR STOREFRO     |
| 1343-2<br>1343-3<br>1344-1<br>1344-3<br>1345-1<br>1345-2<br>1345-3<br>1345-4<br>1346-2<br>1346-3<br>1346-4<br>1347-1<br>1347-2<br>1347-3   | HOTEL ROOM BATH HOTEL ROOM HOTEL ROOM HOTEL ROOM HOTEL ROOM HOTEL ROOM BATH HOTEL ROOM HOTEL ROOM HOTEL ROOM HOTEL ROOM   | HOTEL ROOM  BATH HOTEL ROOM  HOTEL ROOM HOTEL ROOM                                     | 2' - 10"<br>3' - 0"<br>3' - 0"<br>2' - 8"<br>3' - 0"<br>3' - 0"<br>3' - 0"<br>2' - 8"<br>3' - 0"<br>3' - 0"<br>2' - 8"<br>2' - 8"<br>2' - 10"            | 7' - 0"<br>7' - 0"   | 0' - 1 3/8"<br>0' - 1 3/4"<br>0' - 1 3/8"  | GL/WD<br>SCW<br>AL/ GL<br>SCW<br>WD/GL<br>SCW<br>AL/ GL<br>SCW<br>GL/WD                                   | MTL AL HM MTL MTL AL HM MTL  | K<br>V<br>P<br>Y<br>K<br>V                          |                         | EXTERIOR STOREFRO     |
| 1343-2<br>1344-1<br>1344-3<br>1344-5<br>1345-1<br>1345-2<br>1345-4<br>1345-4<br>1346-1<br>1346-3<br>1346-4<br>1347-1<br>1347-2<br>1347-3<br>1347-4<br>1348-1<br>1348-1   | HOTEL ROOM BATH HOTEL ROOM HOTEL ROOM HOTEL ROOM BATH HOTEL ROOM HOTEL ROOM BATH HOTEL ROOM HOTEL ROOM HOTEL ROOM HOTEL ROOM  | HOTEL ROOM BATH HOTEL ROOM HOTEL ROOM HOTEL ROOM HOTEL ROOM HOTEL ROOM                 | 2' - 10"<br>3' - 0"<br>2' - 8"<br>3' - 0"<br>2' - 8"<br>3' - 0"<br>2' - 8"<br>3' - 0"<br>3' - 0"<br>2' - 8"<br>2' - 8"<br>2' - 10"<br>3' - 0"<br>6' - 0" | 7' - 0"<br>7' - 0"   | 0' - 1 3/8"<br>0' - 1 3/4"<br>0' - 1 3/8"<br>0' - 1 3/4"                               | GL/WD<br>SCW<br>AL/ GL<br>SCW<br>WD/GL<br>SCW<br>AL/ GL<br>SCW<br>GL/WD<br>SCW<br>AL/ GL<br>SCW           | MTL AL HM MTL AL HM MTL AL HM MTL HM AL HM AL                      | K<br>V<br>P<br>Y<br>K<br>V<br>P<br>Y<br>H           | 20MIN                   | EXTERIOR STOREFRO     |
| 1343-2<br>1344-1<br>1344-3<br>1344-5<br>1345-1<br>1345-2<br>1345-3<br>1345-4<br>1346-1<br>1346-2<br>1347-1<br>1347-2<br>1347-3<br>1347-4<br>1348-1<br>1348-1<br>1348-3   | HOTEL ROOM BATH HOTEL ROOM HOTEL ROOM HOTEL ROOM BATH HOTEL ROOM  | HOTEL ROOM BATH HOTEL ROOM HOTEL ROOM HOTEL ROOM HOTEL ROOM HOTEL ROOM                 | 2' - 10" 3' - 0" 3' - 0" 2' - 8" 3' - 0" 3' - 0" 3' - 0" 2' - 8" 3' - 0" 3' - 0" 3' - 0" 3' - 0" 2' - 8" 2' - 10" 3' - 0" 3' - 0" 3' - 0"                | 7' - 0"<br>7' - 0"  | 0' - 1 3/8"<br>0' - 1 3/4"<br>0' - 1 3/8"<br>0' - 1 3/4"<br>0' - 1 3/4"<br>0' - 2"     | GL/WD<br>SCW<br>AL/ GL<br>SCW<br>WD/GL<br>SCW<br>AL/ GL<br>SCW<br>GL/WD<br>SCW<br>AL/ GL<br>SCW<br>AL/ GL | MTL AL HM AL HM AL         | K<br>V<br>P<br>Y<br>K<br>V<br>P<br>Y<br>H<br>V      | 20MIN                   | EXTERIOR STOREFRO     |
| 1343-2<br>1344-1<br>1344-3<br>1344-5<br>1345-1<br>1345-2<br>1345-3<br>1345-4<br>1346-3<br>1346-3<br>1347-1<br>1347-2<br>1347-3<br>1347-4<br>1348-1<br>1348-3<br>1348-3   | HOTEL ROOM BATH HOTEL ROOM HOTEL ROOM HOTEL ROOM BATH HOTEL ROOM HOTEL ROOM BATH HOTEL ROOM HOTEL ROOM HOTEL ROOM HOTEL ROOM  | HOTEL ROOM BATH HOTEL ROOM HOTEL ROOM HOTEL ROOM HOTEL ROOM HOTEL ROOM                 | 2' - 10"<br>3' - 0"<br>2' - 8"<br>3' - 0"<br>2' - 8"<br>3' - 0"<br>2' - 8"<br>3' - 0"<br>3' - 0"<br>2' - 8"<br>2' - 8"<br>2' - 10"<br>3' - 0"<br>6' - 0" | 7' - 0"<br>7' - 0"   | 0' - 1 3/8"<br>0' - 1 3/4"<br>0' - 1 3/8"<br>0' - 1 3/4"<br>0' - 1 3/8"<br>0' - 1 3/4" | GL/WD<br>SCW<br>AL/ GL<br>SCW<br>WD/GL<br>SCW<br>AL/ GL<br>SCW<br>GL/WD<br>SCW<br>AL/ GL<br>SCW           | MTL AL HM MTL AL HM MTL AL HM MTL HM AL HM AL                      | K<br>V<br>P<br>Y<br>K<br>V<br>P<br>Y<br>H<br>V<br>H | 20MIN                   | EXTERIOR STOREFRO     |
| 1343-2<br>1343-3<br>1344-1<br>1344-5<br>1345-1<br>1345-2<br>1345-4<br>1345-4<br>1346-1<br>1346-2<br>1346-3<br>1347-1<br>1347-2<br>1347-3<br>1347-4<br>1348-1<br>1348-1<br>1348-3<br>1348-5<br>1349-1<br>1349-2 | HOTEL ROOM BATH HOTEL ROOM HOTEL ROOM HOTEL ROOM HOTEL ROOM BATH HOTEL ROOM            | HOTEL ROOM BATH HOTEL ROOM HOTEL ROOM HOTEL ROOM HOTEL ROOM HOTEL ROOM HOTEL ROOM BATH | 2' - 10" 3' - 0" 3' - 0" 2' - 8" 3' - 0" 3' - 0" 2' - 8" 3' - 0" 2' - 8" 3' - 0" 2' - 8" 2' - 10" 3' - 0" 2' - 10" 3' - 0" 2' - 10" 3' - 0"              | 7' - 0"<br>7' - 0" | 0' - 1 3/8"<br>0' - 1 3/4"<br>0' - 1 3/8"<br>0' - 1 3/4"<br>0' - 1 3/4"<br>0' - 2"     | GL/WD SCW AL/ GL SCW AL/ GL SCW GL/WD SCW AL/ GL   | MTL AL HM MTL AL HM MTL AL HM MTL AL HM AL HM AL HM AL HM AL HM AL | K<br>V<br>P<br>Y<br>K<br>V<br>P<br>Y<br>H<br>V<br>H | 20MIN<br>20MIN<br>20MIN | EXTERIOR STOREFRO     |
| 1343-2<br>1343-3<br>1344-1<br>1344-5<br>1345-1<br>1345-2<br>1345-4<br>1345-4<br>1346-1<br>1346-2<br>1346-3<br>1347-1<br>1347-2<br>1347-3<br>1347-4<br>1348-1<br>1348-1<br>1348-3<br>1348-5<br>1349-1<br>1349-2 | HOTEL ROOM BATH HOTEL ROOM HOTEL ROOM HOTEL ROOM HOTEL ROOM BATH HOTEL ROOM | HOTEL ROOM BATH HOTEL ROOM HOTEL ROOM HOTEL ROOM HOTEL ROOM HOTEL ROOM                 | 2' - 10" 3' - 0" 3' - 0" 2' - 8" 3' - 0" 3' - 0" 3' - 0" 2' - 8" 3' - 0" 3' - 0" 2' - 8" 2' - 10" 3' - 0" 3' - 0" 2' - 10" 3' - 0" 3' - 0"               | 7' - 0"<br>7' - 0"                       | 0' - 1 3/8"<br>0' - 1 3/4"<br>0' - 1 3/4"<br>0' - 1 3/4"<br>0' - 1 3/4"<br>0' - 2"     | GL/WD SCW AL/ GL SCW AL/ GL SCW GL/WD SCW AL/ GL SCW          | MTL AL HM MTL AL HM MTL HM MTL AL HM AL HM AL HM AL HM AL          | K<br>V<br>P<br>Y<br>K<br>V<br>P<br>Y<br>H<br>V<br>H | 20MIN<br>20MIN<br>20MIN | EXTERIOR STOREFRO     |

HARRY
BAKER
SMITH
SMITH
ARCHITECTS II
P 1 t C

189 Maple Ridge Drive Metairie, LA 70001
(504)-885-4477
central@hbsaii.com :: hbsaii.com

faple Ridge Drive Metairie, LA 70 (504)-885-4477 tral@hbsaii.com :: hbsaii.con SINCE 1961

1031 CANAL STREET
NEW ORLEANS, LOUISIANA

CERTIFIED CORRECT

BAKER S

NO.

THIS DRAWING IS CONFIDENTIAL AND

THESE PLANS AND SPECIFICATIONS HAVE
BEEN PREPARED BY ME OR UNDER MY
CLOSE PERSONAL SUPERVISION AND TO
THE BEST OF MY KNOWLEDGE AND
BELIEF THEY COMPLY WITH ALL CITY,
STATE AND FEDERAL REQUIREMENTS, AND
I AM NOT PROVIDING CONTRACT
ADMINISTRATION.

THIS DRAWING IS CONFIDENTIAL AND NOT BE LOANED, REPRODUCED, COPIED, EITHER WHOLLY OR IN PART, OR MADE PUBLIC IN ANY MANNER WITHOUT THE WRITTEN CONSENT OF HBSA II ARCHITECT A PROFESSIONAL L.L.C. ALL RIGHTS OF DESIGN OR INVENTION ARE RESERVED ANI WILL REMAIN THE SOLE PROPERTY OF HBS

|                              | R                            | EVIS                         | NOI                          | HIS                          | TOR                          | Υ                            |   |
|------------------------------|------------------------------|------------------------------|------------------------------|------------------------------|------------------------------|------------------------------|---|
| 4/27/2018                    | 5/4/2018                     | 5/11/2018                    | 5/18/2018                    | 5/25/2018                    | 6/1/2018                     | 6/8/2018                     |   |
|                              |                              |                              |                              |                              |                              |                              |   |
| REVISION 1                   | ) REVISION 2                 | ) REVISION 3                 | REVISION 4                   | ) REVISION 5                 | ) REVISION 6                 | REVISION 7                   |   |
| L.I.S. #2 - CLOUD REVISION 1 | L.I.S. #2 - CLOUD REVISION 2 | L.I.S. #2 - CLOUD REVISION 3 | L.I.S. #2 - CLOUD REVISION 4 | L.I.S. #2 - CLOUD REVISION 5 | L.I.S. #2 - CLOUD REVISION 6 | L.I.S. #2 - CLOUD REVISION 7 |   |
| -                            | 2                            | က                            | 4                            | 2                            | 9                            | 7                            | 8 |

SCHEDULES

PROJECT#: 1709
PHASE: DD
TEAM: Author
CHECKER: Checker
SCALE: AS NOTED

| MARK             | FROM                  | Q.                       | WIDTH              | НЕІСНТ             | THICKNESS              | DOOR MATERIAL   | DOOR FRAME | DOOR TYPE | FIRE RATING | REMARKS                  |
|------------------|-----------------------|--------------------------|--------------------|--------------------|------------------------|-----------------|------------|-----------|-------------|--------------------------|
| 1400-1<br>1400-2 | BATH                  | HOTEL ROOM               | 3' - 0"<br>3' - 0" | 7' - 0"<br>7' - 0" | 0' - 1 3/4"            | SCW<br>WD/GL    | HM<br>MTL  | V<br>P    | 20MIN       |                          |
| 1400-3<br>1400-4 | HOTEL ROOM            | HOTEL ROOM               | 3' - 0"<br>5' - 0" | 7' - 0"<br>7' - 0" | 0' - 2"                | SCW<br>AL/ GL   | MTL<br>AL  | Υ         |             | EXTERIOR STOREFRON       |
| 1400-4           | HOTEL ROOM            |                          | 3' - 0"            | 7' - 0"            | 0' - 1 3/4"            | SCW             | HM         | H<br>V    | 20MIN       | EXTERIOR STOREFRON       |
| 1401-2<br>1401-3 | HOTEL ROOM HOTEL ROOM | BATH                     | 3' - 0"<br>3' - 0" | 7' - 0"<br>7' - 0" |                        | GL/WD<br>SCW    | MTL<br>MTL | P<br>Y    |             |                          |
| 1401-4           | HOTEL ROOM            |                          | 6' - 8"            | 7' - 0"            | 0' - 2"                | AL/ GL          | AL         | Н         |             | EXTERIOR STOREFRON       |
| 1402-1<br>1402-2 | BATH                  | HOTEL ROOM HOTEL ROOM    | 3' - 0"<br>3' - 0" | 7' - 0"<br>7' - 0" | 0' - 1 3/4"            | SCW<br>GL/WD    | HM<br>MTL  | V<br>P    | 20MIN       |                          |
| 1402-3           |                       | HOTEL ROOM               | 6' - 8"            | 7' - 0"            | 0' - 2"                | AL/ GL          | AL         | Н         | 001411      | EXTERIOR STOREFROM       |
| 1403-1           | HOTEL ROOM            | HOTEL ROOM<br>BATH       | 3' - 0"<br>3' - 0" | 7' - 0"<br>7' - 0" | 0' - 1 3/4"            | SCW<br>WD/GL    | HM<br>MTL  | V<br>P    | 20MIN       |                          |
| 1403-3<br>1403-4 | HOTEL BOOM            | HOTEL ROOM               | 3' - 0"            | 7' - 0"            | 0' - 2"                | SCW             | MTL        | Y         |             | EVIEDIOD STODEFDON       |
| 1403-4           | HOTEL ROOM            | HOTEL ROOM               | 6' - 0"<br>3' - 0" | 7' - 0"<br>7' - 0" | 0' - 2"                | AL/ GL<br>SCW   | AL<br>HM   | H<br>V    | 20MIN       | EXTERIOR STOREFRON       |
| 404-2<br>404-3   | HOTEL ROOM HOTEL ROOM | BATH                     | 3' - 0"<br>6' - 0" | 7' - 0"<br>7' - 0" | 0' - 2"                | GL/WD<br>AL/ GL | MTL<br>AL  | P<br>H    |             | EXTERIOR STOREFROM       |
| 1404-3           | HOTEL ROOM            | HOTEL ROOM               | 3' - 0"            | 7 - 0"             | 0' - 1 3/4"            | SCW             | HM         | V         | 20MIN       | EXTERIOR STOREFRON       |
| 1405-2<br>1405-3 | BATH<br>HOTEL ROOM    | HOTEL ROOM               | 3' - 0"<br>3' - 0" | 7' - 0"<br>7' - 0" |                        | WD/GL<br>SCW    | MTL<br>MTL | P<br>Y    |             |                          |
| 1405-3           | HOTEL ROOM            |                          | 6' - 0"            | 7' - 0"            | 0' - 2"                | AL/ GL          | AL         | Н         |             | EXTERIOR STOREFRON       |
| 1406-1<br>1406-2 | BATH                  | HOTEL ROOM HOTEL ROOM    | 3' - 0"<br>3' - 0" | 7' - 0"<br>7' - 0" | 0' - 1 3/4"            | SCW<br>GL/WD    | HM<br>MTL  | V<br>P    | 20MIN       |                          |
| 406-3            |                       | HOTEL ROOM               | 3' - 0"            | 7' - 0"            |                        | SCW             | MTL        | Υ         |             |                          |
| 1406-4<br>1407-1 | HOTEL ROOM HOTEL ROOM |                          | 6' - 0"<br>3' - 0" | 7' - 0"<br>7' - 0" | 0' - 2"                | AL/ GL<br>SCW   | AL<br>HM   | H         | 20MIN       | EXTERIOR STOREFRON       |
| 1407-2           | HOTEL ROOM            | BATH                     | 3' - 0"            | 7' - 0"            | 0 1 3/4                | WD/GL           | MTL        | P         | ZOIVIII     |                          |
| 1407-3<br>1407-4 | HOTEL ROOM            | HOTEL ROOM               | 3' - 0"<br>6' - 0" | 7' - 0"<br>7' - 0" | 0' - 2"                | SCW<br>AL/ GL   | MTL<br>AL  | Y<br>H    |             | EXTERIOR STOREFRON       |
| 1408-1           |                       | HOTEL ROOM               | 3' - 0"            | 7' - 0"            | 0' - 1 3/4"            | SCW             | НМ         | V         | 20MIN       | EXTERIOR OF OTHER FIGURE |
| 1408-2<br>1408-3 | HOTEL ROOM HOTEL ROOM | BATH                     | 3' - 0"<br>3' - 0" | 7' - 0"<br>7' - 0" |                        | GL/WD<br>SCW    | MTL<br>MTL | P<br>Y    |             |                          |
| 1408-4           | HOTEL ROOM            |                          | 6' - 0"            | 7' - 0"            | 0' - 2"                | AL/ GL          | AL         | Н         |             | EXTERIOR STOREFRON       |
| 1409-1<br>1409-2 | BATH                  | HOTEL ROOM HOTEL ROOM    | 3' - 0"<br>3' - 0" | 7' - 0"<br>7' - 0" | 0' - 1 3/4"            | SCW<br>WD/GL    | HM<br>MTL  | V<br>P    | 20MIN       |                          |
| 1409-3           | HOTEL ROOM            |                          | 3' - 0"            | 7' - 0"            | 01 011                 | SCW             | MTL        | Υ         |             | EVERIOR OTORERON         |
| 1409-4<br>1410-1 | HOTEL ROOM            | HOTEL ROOM               | 6' - 0"<br>3' - 0" | 7' - 0"<br>7' - 0" | 0' - 2"                | AL/ GL<br>SCW   | AL<br>HM   | H         | 20MIN       | EXTERIOR STOREFRON       |
| 1410-2           | BATH                  | HOTEL ROOM               | 3' - 0"            | 7' - 0"            |                        | GL/WD           | MTL        | Р         |             |                          |
| 1410-3<br>1410-4 | HOTEL ROOM            | HOTEL ROOM               | 3' - 0"<br>6' - 0" | 7' - 0"<br>7' - 0" | 0' - 2"                | SCW<br>AL/ GL   | MTL<br>AL  | Y<br>H    |             | EXTERIOR STOREFRON       |
| 1411-1<br>1411-2 |                       | HOTEL ROOM               | 3' - 0"            | 7' - 0"            | 0' - 1 3/4"            | SCW             | HM         | V         | 20MIN       |                          |
| 1411-2           | HOTEL ROOM            | HOTEL ROOM<br>BATH       | 3' - 0"<br>3' - 0" | 7' - 0"<br>7' - 0" |                        | SCW<br>WD/GL    | MTL<br>MTL | P         |             |                          |
| 1411-4<br>1412-1 | HOTEL ROOM            | HOTEL ROOM               | 6' - 8"<br>3' - 0" | 7' - 0"<br>7' - 0" | 0' - 2"<br>0' - 1 3/4" | AL/ GL<br>SCW   | AL<br>HM   | H         | 20MIN       | EXTERIOR STOREFRON       |
| 1412-1           | HOTEL ROOM            | BATH                     | 3' - 0"            | 7 - 0"             | 0 - 1 3/4              | GL/WD           | MTL        | P         | ZUIVIIIN    |                          |
| 1412-3<br>1412-4 | HOTEL ROOM            | HOTEL ROOM               | 3' - 0"<br>6' - 0" | 7' - 0"<br>7' - 0" | 0' - 2"                | SCW<br>AL/ GL   | MTL<br>AL  | Y<br>H    |             | EXTERIOR STOREFRON       |
| 1413-1           |                       | HOTEL ROOM               | 3' - 0"            | 7' - 0"            | 0' - 1 3/4"            | SCW             | НМ         | V         | 20MIN       | EXTERIOR GROTELITION     |
| 1413-2<br>1413-3 | BATH<br>HOTEL ROOM    | HOTEL ROOM               | 3' - 0"<br>3' - 0" | 7' - 0"<br>7' - 0" |                        | GL/WD<br>SCW    | MTL<br>MTL | P<br>Y    |             |                          |
| 1413-4           | HOTEL ROOM            |                          | 6' - 0"            | 7' - 0"            | 0' - 2"                | AL/ GL          | AL         | Н         |             | EXTERIOR STOREFRON       |
| 1414-1<br>1414-2 | HOTEL ROOM HOTEL ROOM | BATH                     | 3' - 0"<br>3' - 0" | 7' - 0"<br>7' - 0" | 0' - 1 3/4"            | SCW<br>GL/WD    | HM<br>MTL  | V<br>P    | 20MIN       |                          |
| 1414-3           | HOTEL ROOM            |                          | 3' - 0"            | 7' - 0"            | 01 011                 | SCW             | MTL        | Υ         |             | EVERIOR OTORERON         |
| 414-4<br>415-1   | HOTEL ROOM HOTEL ROOM |                          | 6' - 0"<br>3' - 0" | 7' - 0"<br>7' - 0" | 0' - 2"                | AL/ GL<br>SCW   | AL<br>HM   | H<br>V    | 20MIN       | EXTERIOR STOREFRON       |
| 415-2            | BATH<br>HOTEL ROOM    | HOTEL ROOM               | 3' - 0"<br>3' - 0" | 7' - 0"<br>7' - 0" |                        | GL/WD<br>SCW    | MTL<br>MTL | P<br>Y    |             |                          |
| 1415-3<br>1415-4 | HOTEL ROOM            |                          | 6' - 0"            | 7 - 0"             | 0' - 2"                | AL/ GL          | AL         | H         |             | EXTERIOR STOREFRON       |
| 1416-1<br>1416-2 | HOTEL ROOM            | HOTEL ROOM<br>BATH       | 3' - 0"<br>3' - 0" | 7' - 0"<br>7' - 0" | 0' - 1 3/4"            | SCW<br>GL/WD    | HM<br>MTL  | V         | 20MIN       |                          |
| 1416-3           | HOTEL ROOM            | DATTI                    | 3' - 0"            | 7' - 0"            |                        | SCW             | MTL        | Υ         |             |                          |
| 1416-4<br>1417-1 | HOTEL ROOM HOTEL ROOM |                          | 6' - 0"<br>3' - 0" | 7' - 0"<br>7' - 0" | 0' - 2"                | AL/ GL<br>SCW   | AL<br>HM   | H<br>V    | 20MIN       | EXTERIOR STOREFRON       |
| 1417-2           |                       | HOTEL ROOM               | 3' - 0"            | 7' - 0"            | 0 10/1                 | SCW             | MTL        | Υ         | LOWING      |                          |
| 1417-3<br>1417-4 | HOTEL ROOM HOTEL ROOM |                          | 3' - 0"<br>6' - 0" | 7' - 0"<br>7' - 0" | 0' - 2"                | SCW<br>AL/ GL   | MTL<br>AL  | Y<br>H    |             | EXTERIOR STOREFROM       |
| 1417-5           | HOTEL ROOM            |                          | 6' - 0"            | 7' - 0"            | 0' - 2"                | AL/ GL          | AL         | Н         |             | EXTERIOR STOREFRON       |
| 1417-6<br>1418-1 | BATH                  | HOTEL ROOM HOTEL ROOM    | 3' - 0"<br>3' - 0" | 7' - 0"<br>7' - 0" | 0' - 1 3/4"            | WD/GL<br>SCW    | MTL<br>HM  | P<br>V    | 20MIN       |                          |
| 1418-2           | BATH                  | HOTEL ROOM               | 3' - 0"            | 7' - 0"            |                        | GL/WD           | MTL        | Р         |             |                          |
| 1418-3<br>1418-4 | HOTEL ROOM HOTEL ROOM |                          | 3' - 0"<br>6' - 0" | 7' - 0"<br>7' - 0" | 0' - 2"                | SCW<br>AL/ GL   | MTL<br>AL  | Y<br>H    |             | EXTERIOR STOREFRON       |
| 1419-1<br>1419-2 | BATH                  | HOTEL ROOM<br>HOTEL ROOM | 3' - 0"<br>3' - 0" | 7' - 0"<br>7' - 0" | 0' - 1 3/4"            | HM<br>WD/GL     | HM<br>MTL  | V         | 20MIN       |                          |
| 1419-2           | HOTEL ROOM            | HOTEL ROOM               | 3' - 0"            | 7' - 0"            |                        | SCW             | M          | Y         |             |                          |
| 1419-4<br>1420-1 | HOTEL ROOM            | HOTEL ROOM               | 6' - 0"<br>3' - 0" | 7' - 0"<br>7' - 0" | 0' - 2"<br>0' - 1 3/4" | AL/ GL<br>SCW   | AL<br>HM   | H         | 20MIN       | EXTERIOR STOREFRON       |
| 420-1            | HOTEL ROOM            | BATH                     | 3' - 0"            | 7 - 0"             | 0 - 1 3/4              | GL/WD           | MTL        | P         | ZUIVIIIN    |                          |
| 420-3<br>420-4   | HOTEL ROOM            |                          | 3' - 0"<br>6' - 0" | 7' - 0"<br>7' - 0" | 0' - 2"                | SCW<br>AL/GL    | MTL<br>AL  | Y         |             | EXTERIOR STOREFRON       |
| 421-1            | HOTEL ROOM            | HOTEL ROOM               | 3' - 0"            | 7' - 0"            | 0' - 2"                | SCW             | НМ         | V         | 20MIN       | LATERIOR STOREFRON       |
| 1421-2<br>1421-3 | HOTEL ROOM HOTEL ROOM | BATH                     | 3' - 0"<br>6' - 0" | 7' - 0"<br>7' - 0" | 0' - 2"                | WD/GL<br>AL/ GL | MTL<br>AL  | P<br>H    |             | EXTERIOR STOREFRON       |
| 1422-1           |                       | HOTEL ROOM               | 3' - 0"            | 7' - 0"            | 0' - 2"                | SCW             | НМ         | V         | 20MIN       | LATERIOR STUREFRUN       |
| 1422-2<br>1422-3 | BATH<br>HOTEL ROOM    | HOTEL ROOM               | 3' - 0"<br>6' - 0" | 7' - 0"<br>7' - 0" | 0' - 2"                | SCW<br>AL/ GL   | MTL<br>AL  | P         |             | EXTERIOR STOREFRON       |
| 1422-3<br>1423-1 | TIOTEL NOON           | HOTEL ROOM               | 3' - 0"            | 7' - 0"            | 0' - 2"                | SCW             | HM         | _         | 20MIN       | LATERIOR STUKEFKUN       |

| MARK             | FROM                            | D <u></u>                 | WIDTH               | HEIGHT             | THICKNESS     | DOOR MATERIAL   | DOOR FRAME | DOOR TYPE | FIRE RATING | REMARKS            |
|------------------|---------------------------------|---------------------------|---------------------|--------------------|---------------|-----------------|------------|-----------|-------------|--------------------|
| 1423-2           | HOTEL ROOM                      | BATH                      | 3' - 0"             | 7' - 0"            |               | WD/GL           | MTL        | Р         |             |                    |
| 1423-3           | HOTEL ROOM                      |                           | 6' - 8"             | 7' - 0"            | 0' - 2"       | AL/GL           | AL         | Н         | 0014111     | EXTERIOR STOREFRO  |
| 1424-1<br>1424-2 | HOTEL ROOM HOTEL ROOM           | BATH                      | 3' - 0"<br>3' - 0"  | 7' - 0"<br>7' - 0" | 0' - 1 3/4"   | SCW<br>WD/GL    | HM<br>MTL  | V         | 20MIN       |                    |
| 1424-3           | HOTEL ROOM                      | DATIT                     | 6' - 8"             | 7' - 0"            | 0' - 2"       | AL/ GL          | AL         | H         |             | EXTERIOR STOREFRO  |
| 1425-1           |                                 |                           | 3' - 0"             | 7' - 0"            | 0' - 1 3/4"   | SCW             | НМ         | ٧         | 20MIN       |                    |
| 1425-2           |                                 | BATH                      | 3' - 0"             | 7' - 0"            | 01 011        | WD/GL           | MTL        | P         |             | EVERIOR OTORES     |
| 1425-3<br>1425-4 |                                 |                           | 6' - 8"<br>6' - 8"  | 7' - 0"<br>7' - 0" | 0' - 2"       | AL/GL           | AL<br>AL   | H         |             | EXTERIOR STOREFRO  |
| 1425-5           |                                 |                           | 3' - 0"             | 7' - 0"            | 0 - 2         | SCW             | MTL        | Y         |             | EXTERIOR STORETTE  |
| 1426-1           |                                 | HOTEL ROOM                | 3' - 0"             | 7' - 0"            | 0' - 1 3/4"   | SCW             | НМ         | ٧         | 20MIN       |                    |
| 1426-2           | BATH BOOM                       | HOTEL ROOM                | 3' - 0"<br>6' - 8"  | 7' - 0"            | 0' 0"         | GL/WD           | MTL        | Р         |             | EVIEDIOD STODEED   |
| 1426-3<br>1427-1 | HOTEL ROOM                      | HOTEL ROOM                | 3' - 0"             | 7' - 0"<br>7' - 0" | 0' - 2"       | AL/ GL<br>SCW   | AL<br>HM   | V         | 20MIN       | EXTERIOR STOREFRO  |
| 1427-2           | BATH                            | HOTEL ROOM                | 3' - 0"             | 7' - 0"            | 0 1 0/ 1      | GL/WD           | MTL        | P         | 20111111    |                    |
| 1427-3           | HOTEL ROOM                      |                           | 3' - 0"             | 7' - 0"            |               | SCW             | MTL        | Υ         |             |                    |
| 1427-4           | HOTEL ROOM                      | HOTEL BOOM                | 6' - 8"             | 7' - 0"            | 0' - 2"       | AL/ GL          | AL         | Н         | OOMAINI     | EXTERIOR STOREFRO  |
| 1428-1<br>1428-2 | HOTEL ROOM                      | HOTEL ROOM<br>BATH        | 3' - 0"<br>3' - 0"  | 7' - 0"<br>7' - 0" | 0' - 1 3/4"   | SCW<br>GL/WD    | HM<br>MTL  | V<br>P    | 20MIN       |                    |
| 1428-3           | HOTEL ROOM                      |                           | 3' - 0"             | 7' - 0"            |               | SCW             | MTL        | Υ         |             |                    |
| 1428-4           | HOTEL ROOM                      |                           | 6' - 8"             | 7' - 0"            | 0' - 2"       | AL/GL           | AL         | Н         |             | EXTERIOR STOREFRO  |
| 1429-1           | DATU                            | HOTEL ROOM                | 3' - 0"             | 7' - 0"<br>7' - 0" | 0' - 1 3/4"   | SCW             | HM         | V         | 20MIN       |                    |
| 1429-2<br>1429-3 | BATH<br>HOTEL ROOM              | HOTEL ROOM                | 3' - 0"<br>3' - 0"  | 7' - 0"            |               | GL/WD<br>SCW    | MTL<br>MTL | P<br>Y    |             |                    |
| 1429-4           | HOTEL ROOM                      |                           | 6' - 8"             | 7' - 0"            | 0' - 2"       | AL/ GL          | AL         | Н         |             | EXTERIOR STOREFRO  |
| 1430-1           |                                 | HOTEL ROOM                | 3' - 0"             | 7' - 0"            | 0' - 1 3/4"   | HM              | НМ         | ٧         | 20MIN       |                    |
| 1430-2<br>1430-3 | HOTEL ROOM HOTEL ROOM           | BATH                      | 3' - 0"<br>3' - 0"  | 7' - 0"<br>7' - 0" |               | GL/WD<br>SCW    | MTL<br>MTL | P<br>Y    |             |                    |
| 1430-3           | HOTEL ROOM                      |                           | 6' - 8"             | 7' - 0"            | 0' - 2"       | AL/ GL          | AL         | Н         |             | EXTERIOR STOREFRO  |
| 1431-1           |                                 | HOTEL ROOM                | 3' - 0"             | 7' - 0"            | 0' - 1 3/4"   | SCW             | НМ         |           | 20MIN       |                    |
| 1431-2           | BATH                            | HOTEL ROOM                | 3' - 0"             | 7' - 0"            |               | GL/WD           | MTL        | Р         |             |                    |
| 1431-3<br>1431-4 | HOTEL ROOM HOTEL ROOM           |                           | 3' - 0"<br>6' - 8"  | 7' - 0"<br>7' - 0" | 0' - 2"       | SCW<br>AL/ GL   | MTL<br>AL  | Y<br>H    |             | EXTERIOR STOREFRO  |
| 1432-1           | HOTEL ROOM                      |                           | 3' - 0"             | 7' - 0"            | 0' - 1 3/4"   | SCW             | HM         | V         | 20MIN       | EXTERIOR STORETT   |
| 1432-2           |                                 | HOTEL ROOM                | 6' - 0"             | 7' - 0"            | 0' - 2"       | AL/ GL          | AL         | Н         |             | EXTERIOR STOREFRO  |
| 1432-3           | BATH                            | HOTEL ROOM                | 3' - 0"             | 7' - 0"            | 01 4 0 / 4 11 | GL/WD           | MTL        | Р         | 0014111     |                    |
| 1433-1<br>1433-2 | HOTEL ROOM                      | HOTEL ROOM<br>BATH        | 3' - 0"<br>3' - 0"  | 7' - 0"<br>7' - 0" | 0' - 1 3/4"   | SCW<br>GL/WD    | HM<br>MTL  | V<br>P    | 20MIN       |                    |
| 1433-3           | HOTEL ROOM                      | D/(III                    | 3' - 0"             | 7' - 0"            |               | AL/ GL          | AL         | Η         |             | EXTERIOR STOREFRO  |
| 1434-1           | HOTEL ROOM                      |                           | 3' - 0"             | 7' - 0"            | 0' - 1 3/4"   | SCW             | НМ         | ٧         | 20MIN       |                    |
| 1434-2<br>1434-3 | BATH                            | HOTEL ROOM HOTEL ROOM     | 3' - 0"<br>6' - 0"  | 7' - 0"<br>7' - 0" | 0' - 2"       | WD/GL<br>AL/ GL | SCW        | P<br>H    |             | EXTERIOR STOREFRO  |
| 1434-4           |                                 | HOTEL ROOM                | 2' - 8"             | 7' - 0"            | 0 - 2         | SCW             | MTL        | Y         |             | EXTERIOR STORETRO  |
| 1434-5           | HOTEL ROOM                      |                           | 2' - 10"            | 7' - 0"            | 0' - 1 3/8"   | AL/ GL          | AL         | Н         |             | EXTERIOR STOREFRO  |
| 1435-1           |                                 | HOTEL ROOM                | 3' - 0"             | 7' - 0"            | 0' - 1 3/4"   | SCW             | HM         | ٧         | 20MIN       |                    |
| 1435-2<br>1435-3 |                                 | HOTEL ROOM HOTEL ROOM     | 2' - 8"<br>2' - 10" | 7' - 0"<br>7' - 0" | 0' - 1 3/8"   | SCW<br>AL/ GL   | MTL<br>AL  | V<br>H    |             | EXTERIOR STOREFRO  |
| 1435-4           | BATH                            | HOTEL ROOM                | 3' - 0"             | 7' - 0"            | 0 - 1 3/0     | GL/WD           | MTL        | P         |             | EXTERIOR STORETTE  |
| 1435-5           | HOTEL ROOM                      |                           | 2' - 10"            | 7' - 0"            | 0' - 1 3/8"   | AL/ GL          | AL         | F         |             | EXTERIOR STOREFRO  |
| 1436-1           | HOTEL ROOM                      |                           | 3' - 0"             | 7' - 0"            | 0' - 1 3/4"   | SCW             | HM         | _         | 20MIN       | EVIEDIOD CTODEED   |
| 1436-2<br>1436-3 | HOTEL ROOM HOTEL ROOM           | BATH                      | 3' - 0"<br>3' - 0"  | 7' - 0"<br>7' - 0" | 0' - 1 3/8"   | AL/ GL<br>WD/GL | AL<br>MTL  | H<br>P    |             | EXTERIOR STOREFRO  |
| 1437-1           |                                 | HOTEL ROOM                | 3' - 0"             | 7' - 0"            | 0' - 1 3/4"   | SCW             | HM         | С         | 20MIN       |                    |
| 1437-2           | HOTEL ROOM                      |                           | 6' - 0"             | 7' - 0"            | 0' - 2"       | AL/GL           | AL         | Н         |             |                    |
| 1437-3<br>1437-4 | HOTEL ROOM                      | HOTEL ROOM                | 3' - 0"<br>6' - 0"  | 7' - 0"<br>7' - 0" | 0' - 2"       | SCW<br>WD/GL    | MTL<br>AL  | Y<br>H    |             | EXTERIOR STOREFRO  |
| 1438-1           | TIOTEL ROOM                     | ROCK STAR SUITE           | 6' - 0"             | 7' - 0"            | 0' - 1 3/4"   | HM              | HM         | _         | 20MIN       | DOUBLE DOOR / PAIR |
| 1438-4           | ROCK STAR SUITE                 |                           | 2' - 10"            | 7' - 0"            | 0' - 1 3/8"   | AL/ GL          | AL         | Н         |             | EXTERIOR STOREFRO  |
| 1438-5           | ROCK STAR SUITE                 |                           | 3' - 0"             | 7' - 0"            | 0' - 1 3/8"   | AL/ GL          | AL         | K         |             | EXTERIOR STOREFRO  |
| 1438-6<br>1438-7 | ROCK STAR SUITE ROCK STAR SUITE |                           | 3' - 0"<br>2' - 10" | 7' - 0"<br>7' - 0" | 0' - 1 3/8"   | AL/ GL          | AL<br>AL   | K         |             | EXTERIOR STOREFRO  |
| 1438-8           | ROCK STAR SUITE                 |                           | 2' - 10"            | 7' - 0"            | 0' - 1 3/8"   | AL/ GL          | AL         | Н         |             | EXTERIOR STOREFRO  |
| 1438-10          | ROCK STAR SUITE                 |                           | 6' - 0"             | 7' - 0"            | 0' - 2"       | AL/ GL          | AL         | Н         |             | EXTERIOR STOREFRO  |
| 1439-1<br>1439-2 | MECH.                           | MECH.                     | 3' - 0"<br>6' - 0"  | 7' - 0"<br>7' - 0" | 0' - 1 3/4"   | SCW             | MTL<br>HM  | V<br>D    |             |                    |
| 1440-1           | MEGH.                           | CONDO OFFICE              | 3' - 0"             | 7' - 0"            | 0' - 1 3/4"   | SCW             | MTL        | V         | 20MIN       |                    |
| 1440-2           | CONDO OFFICE                    |                           | 2' - 10"            | 7' - 0"            | 0' - 1 3/8"   | AL/ GL          | AL         | Н         |             | EXTERIOR STOREFRO  |
| 1440-3           | CONDO OFFICE                    | 001100 00000              | 2' - 10"            | 7' - 0"            | 0' - 1 3/8"   | AL/ GL          | AL         | Н         |             | EXTERIOR STOREFRO  |
| 1440-4<br>1440-5 | CONDO OFFICE                    | CONDO OFFICE CONDO OFFICE | 3' - 0"<br>3' - 0"  | 7' - 0"<br>7' - 0" |               | SCW<br>WD/GL    | MTL<br>MTL | Y<br>P    |             |                    |
| 1440-5           | OUNDO OFFICE                    | RR                        | 3' - 0"             | 7' - 0"            | 0' - 1 3/4"   | SCW             |            | V         |             |                    |
| 1442-1           |                                 | POOL SNACK                | 3' - 0"             | 7' - 0"            | 0' - 1 3/4"   | SCW             | НМ         | V         |             |                    |
| 1442-2           | POOL SNACK                      |                           | 6' - 8"             | 7' - 0"            | 0' - 2"       | AL/ GL          | AL         |           | 41.75       | EXTERIOR STOREFRO  |
| 1443<br>1445     | Room                            | ELEV. LOBBY               | 6' - 0"<br>6' - 0"  | 7' - 0"<br>7' - 0" | 0' - 1 3/4"   | HM<br>HM        | HM<br>HM   | D<br>D    | 1HR         |                    |
| 1445             |                                 | LLL V. LODD I             | 6' - 0"             | 7' - 0"            | 0' - 1 3/4"   | HM              | HM         |           | 1HR         |                    |
| 1449             |                                 |                           | 6' - 0"             | 8' - 0"            |               | AL/GL           | AL         | A         | <u> </u>    | EXTERIOR STOREFRO  |
|                  |                                 |                           | 6' - 0"             |                    |               |                 |            |           |             |                    |

189 Maple Ridge Drive Metairie, LA 70001 (504)-885-4477 central@hbsaii.com :-: hbsaii.com

SINCE 1961

THESE PLANS AND SPECIFICATIONS HAVE
BEEN PREPARED BY ME OR UNDER MY
CLOSE PERSONAL SUPERVISION AND TO
THE BEST OF MY KNOWLEDGE AND
BELIEF THEY COMPLY WITH ALL CITY,
STATE AND FEDERAL REQUIREMENTS, AND
I AM NOT PROVIDING CONTRACT
ADMINISTRATION.

CERTIFIED CORRECT

REVISION HISTORY

1 L.I.S. #2 - CLOUD REVISION 1
2 L.I.S. #2 - CLOUD REVISION 2
3 L.I.S. #2 - CLOUD REVISION 3
4 L.I.S. #2 - CLOUD REVISION 4
5 L.I.S. #2 - CLOUD REVISION 6
6 L.I.S. #2 - CLOUD REVISION 6
7 L.I.S. #2 - CLOUD REVISION 6
8

SCHEDULES

PROJECT#: 1709 PHASE: DD TEAM: Author CHECKER: Checker SCALE: AS NOTED


ISSUED: 4/20/2018
SHEET#:

A6.9

|                    |                     |  |                    |                    |                            | ٦              |            |           |             |   |
|--------------------|---------------------|--|--------------------|--------------------|----------------------------|----------------|------------|-----------|-------------|---|
| MARK               | FROM                | 0  | WIDTH              | НЕІСНТ             | THICKNESS                  | DOOR MATERIAL  | DOOR FRAME | DOOR TYPE | FIRE RATING | REMARKS                                 |
| 1500<br>1500-1     | GYM                 | YOGA ROOM<br>ENTRY   | 3' - 0"<br>3' - 0" | 7' - 0"<br>8' - 0" | 0' - 1 3/4"<br>0' - 1 3/4" | WD             | HM<br>WD   | C<br>AA   | 1HR         | 1 HOUR RATED                            |
| 1500-2             | CLO.                | ENTRY  | 2' - 8"            | 8' - 0"            | 0' - 1 3/4"                |                | WD         | AA        |             |   |
| 1500-3<br>1500-4   | KITCHEN             | BEDROOM 1  | 2' - 8"            | 8' - 0"<br>8' - 0" | 0' - 1 3/4"                |                | WD         | AA<br>AA  |             |   |
| 1500-5             | CLO.                | BEDROOM 1  | 4' - 0"            | 8' - 0"            | 0' - 1 1/2"                |                | WD         | L         |             |   |
| 1500-6             | KITCHEN             | BATH 1   | 3' - 0"            | 8' - 0"            | 0' - 1 3/4"                |                | WD         | AA        |             |   |
| 500-7              | LIVING<br>CLO.      | BEDROOM 2<br>BEDROOM 2   | 3' - 0"<br>4' - 0" | 8' - 0"<br>8' - 0" | 0' - 1 3/4"                |                | WD<br>WD   | AA<br>L   |             |   |
| 500-9              | BEDROOM 2           | BATH 2   | 2' - 8"            | 8' - 0"            | 0' - 1 3/4"                |                | WD         | AA        |             |   |
| 500-10             | BEDROOM 2           |  | 6' - 8"            | 7' - 0"            | 0' - 2"                    | WD             | AL         | Н         |             | EXTERIOR STOREFRONT                     |
| 500-11             | LIVING              | ENTEN  | 6' - 8"            | 7' - 0"            | 0' - 2"                    | AL/GL          | AL         | Н         | 4110        | EXTERIOR STOREFRONT                     |
| 501-1<br>501-2     | A/C                 | ENTRY<br>ENTRY   | 3' - 0"<br>2' - 0" | 8' - 0"<br>8' - 0" | 0' - 1 3/4"                | WD<br>WD       | WD<br>WD   | AA<br>AA  | 1HR         | 1 HOUR RATED                            |
| 501-3              | HALL                | BATH 1   | 2' - 8"            | 8' - 0"            | 0' - 1 3/4"                | WD             | WD         | AA        |             |   |
| 501-4              | HALL                | BEDROOM 1  | 2' - 8"            | 8' - 0"            | 0' - 1 3/4"                | WD             | WD         | AA        |             |   |
| 501-5<br>501-6     | LAUNDRY<br>CLOSET   | BEDROOM 1 BEDROOM 1  | 4' - 0"<br>2' - 0" | 8' - 0"<br>8' - 0" | 0' - 1 1/2"                | WD<br>WD       | WD<br>WD   | L<br>AA   |             |   |
| 501-6              | BEDROOM 2           | BATH 2   | 3' - 0"            | 8' - 0"            | 0' - 1 3/4"                | WD             | WD         | AA        |             |   |
| 501-8              | CLOSET              | BEDROOM 2  | 4' - 0"            | 8' - 0"            | 0' - 1 1/2"                | WD             | WD         | AA        |             |   |
| 501-9              | BEDROOM 2           | LIVING   | 3' - 0"            | 8' - 0"            | 0' - 1 3/4"                | WD             | WD         | AA        |             | EVTERIOR OTORETE ::-                    |
| 501-10<br>501-11   | LIVING              | BEDROOM 2  | 6' - 8"<br>6' - 0" | 7' - 0"<br>7' - 0" | 0' - 2"                    | AL/GL<br>AL/GL | AL<br>AL   | H         |             | EXTERIOR STOREFRONT EXTERIOR STOREFRONT |
| 502                | GYM                 | GYM RR   | 3' - 0"            | 7' - 0"            | 0' - 1 3/4"                | , .L, GL       | HM         | С         |             | -/ LINGIT GIGILLI NONI                  |
| 502-1              |                     | ENTRY  | 3' - 0"            | 8' - 0"            | 0' - 1 3/4"                |                | WD         | AA        | 1HR         | 1 HOUR RATED                            |
| 502-2              | LAUNDRY             | ENTRY  | 2' - 8"            | 8' - 0"            | 0' - 1 3/4"                | WD             | WD         | AA        |             |   |
| 502-3<br>502-4     | HALL<br>HALL        | BATH<br>KITCHEN  | 3' - 0"            | 8' - 0"<br>8' - 0" | 0' - 1 3/4"                | WD<br>WD       | WD<br>WD   | AA<br>CC  |             | DOUBLE DOOR / PAIR                      |
| 502-4              | HALL                | CLOSET   | 5' - 0"            | 8' - 0"            | 0' - 1 1/2"                | WD             | WD         | L         |             | SOULL BOOM FAIN                         |
| 502-6              | A/C                 | HALL   | 2' - 0"            | 8' - 0"            | 0' - 1 3/4"                | WD             | WD         | AA        |             |   |
| 502-7              | HALL                | BEDROOM  | 3' - 0"            | 8' - 0"            | 0' - 1 3/4"                | WD             | WD         | AA        |             | EVTERIOR CTORESONT                      |
| 502-8<br>502-9     | BEDROOM<br>LIVING   |  | 6' - 0"<br>6' - 0" | 7' - 0"<br>7' - 0" | 0' - 2"                    | AL/GL<br>AL/GL | AL<br>AL   | H         |             | EXTERIOR STOREFRONT EXTERIOR STOREFRONT |
| 503                | GYM                 | IDF  | 3' - 0"            | 7' - 0"            | 0' - 1 3/4"                | , GL           | HM         | С         |             |   |
| 503-1              |                     | ENTRY  | 3' - 0"            | 8' - 0"            | 0' - 1 3/4"                | WD             | WD         | AA        | 1HR         | 1 HOUR RATED                            |
| 503-2              | KITCHEN             | LAUNDRY  | 2' - 8"            | 8' - 0"            | 0' - 1 3/4"                | WD             | WD         | AA<br>AA  |             |   |
| 503-3<br>503-4     | HALL<br>HALL        | BATH<br>KITCHEN  | 2' - 8"            | 8' - 0"<br>8' - 0" | 0' - 1 3/4"                | WD<br>WD       | WD         | AA        |             |   |
| 503-5              | A/C                 | HALL   | 2' - 0"            | 8' - 0"            | 0' - 1 3/4"                | WD             | WD         | AA        |             |   |
| 503-6              | HALL                | BEDROOM  | 3' - 6"            | 8' - 0"            | 0' - 1 3/4"                | WD             | WD         | AA        |             |   |
| 503-7<br>503-8     | HALL<br>BEDROOM     | CLOSET   | 2' - 8"<br>6' - 0" | 8' - 0"<br>7' - 0" | 0' - 1 3/4"                | WD<br>AL/GL    | WD<br>AL   | AA<br>H   |             | EXTERIOR STOREFRONT                     |
| 503-9              | LIVING              |  | 6' - 0"            | 7' - 0"            | 0' - 2"                    | AL/GL          | AL         | Н         |             | EXTERIOR STOREFRONT                     |
| 504                | YOGA ROOM           |  | 6' - 8"            | 7' - 0"            | 0' - 2"                    |                |            |           |             |   |
| 504-1              | 10                  | ENTRY  | 3' - 0"            | 8' - 0"            | 0' - 1 3/4"                | WD             | WD         | AA        | 1HR         | 1 HOUR RATED                            |
| 504-2<br>504-3     | A/C<br>H20          | ENTRY<br>ENTRY   | 2' - 0"<br>2' - 0" | 8' - 0"<br>8' - 0" | 0' - 1 3/4"                | WD<br>WD       | WD<br>WD   | AA<br>AA  |             |   |
| 504-4              | HALL                | BATH 2   | 2' - 8"            | 8' - 0"            | 0' - 1 3/4"                | WD             | WD         | AA        |             |   |
| 504-5              | BEDROOM 2           | HALL   | 2' - 8"            | 8' - 0"            | 0' - 1 3/4"                | WD             | WD         | AA        |             |   |
| 504-6<br>504-7     | CLOSET              | BEDROOM 2<br>BATH 1  | 4' - 0"<br>2' - 8" | 8' - 0"<br>8' - 0" | 0' - 1 1/2"                | WD<br>WD       | WD         | L<br>AA   |             |   |
| 504-7              | LAUNDRY             | HALL   | 3' - 6"            | 8' - 0"            | 0' - 1 3/4"                | WD             | WD         | CC        |             | DOUBLE DOOR / PAIR                      |
| 504-9              | BEDROOM 1           | CLOSET   | 4' - 0"            | 8' - 0"            | 0' - 1 1/2"                | WD             | WD         | L         |             |   |
| 504-10             | HALL<br>BEDDOOM 1   | BEDROOM 1  | 3' - 0"            | 8' - 0"            | 0' - 1 3/4"                | WD             | WD         | AA        |             | EVTERIOR OTORSES OF                     |
| 504-11<br>504-12   | BEDROOM 1<br>LIVING |  | 6' - 0"<br>6' - 0" | 7' - 0"<br>7' - 0" | 0' - 2"                    | AL/GL<br>AL/GL | AL<br>AL   | H         |             | EXTERIOR STOREFRONT EXTERIOR STOREFRONT |
| 504-12             | BEDROOM 2           |  | 6' - 0"            | 7' - 0"            | 0' - 2"                    | AL/GL          | AL         | Н         |             | EXTERIOR STOREFRONT                     |
| 505                | GYM                 |  | 6' - 0"            | 7' - 0"            | 0' - 1 3/4"                |                | НМ         | D         |             |   |
| 505-1<br>505-2     | STOD                | KITCHEN  | 3' - 0"            | 8' - 0"            | 0' - 1 3/4"                | 1              | WD         | 1         |             | 1 HOUR RATED                            |
| 505-2<br>505-3     | STOR.<br>KITCHEN    | KITCHEN<br>A/C   | 2' - 0"<br>2' - 8" | 8' - 0"<br>8' - 0" | 0' - 1 3/4"                | WD             | WD<br>WD   | AA<br>AA  |             |   |
| 505-4              | HALL                | BATH   | 2' - 8"            | 8' - 0"            | 0' - 1 3/4"                | WD             | WD         | AA        |             |   |
| 505-5              | HALL                | H2O  | 2' - 0"            | 8' - 0"            | 0' - 1 3/4"                | WD             | WD         | AA        |             | DOUBLE BOOK := ::-                      |
| 505-6<br>505-7     | HALL<br>HALL        | LAUNDRY<br>BEDROOM   | 3' - 6"<br>2' - 8" | 8' - 0"<br>8' - 0" | 0' - 1 3/4"                | WD<br>WD       | WD<br>WD   | CC<br>AA  |             | DOUBLE DOOR / PAIR                      |
| 505-7<br>505-8     | BEDROOM             | CLOSET   | 4' - 0"            | 8' - 0"            | 0' - 1 1/2"                | WD             |            | L         |             |   |
| 505-9              | BEDROOM             |  | 6' - 0"            | 7' - 0"            | 0' - 2"                    | AL/GL          | AL         | Н         |             | EXTERIOR STOREFRONT                     |
| 505-10<br>506      | LIVING              | QTAID 1  | 6' - 0"<br>3' - 0" | 7' - 0"<br>7' - 0" | 0' - 2"                    | AL/GL          | AL         | H         | 2UD         | EXTERIOR STOREFRONT                     |
| 506<br>506-1       |                     | STAIR 1 KITCHEN  | 3' - 0"            | 8' - 0"            | 0' - 1 3/4"                | WD             | HM<br>WD   | AA        | 2HR<br>1HR  | 1 HOUR RATED                            |
| 506-2              | KITCHEN             | STOR.  | 2' - 0"            | 8' - 0"            | 0' - 1 3/4"                | WD             | WD         | AA        |             |   |
| 506-3              | CLOS.               | KITCHEN  | 2' - 8"            | 7' - 0"            | 0' - 2"                    | WD             | WD         | AA        | 1HR         |   |
| 506-4<br>506-5     | BATH<br>HALL        | HALL<br>A/C  | 2' - 8"<br>2' - 0" | 8' - 0"<br>8' - 0" | 0' - 1 3/4"                | WD<br>WD       | WD<br>WD   | AA<br>AA  |             |   |
| 506-6              | HALL                | LAUNDRY  | 3' - 6"            | 8' - 0"            | 0' - 1 3/4"                | WD             | WD         | CC        |             | DOUBLE DOOR / PAIR                      |
| 506-7              | HALL                | BEDROOM  | 2' - 8"            | 8' - 0"            | 0' - 1 3/4"                | WD             | WD         | AA        |             |   |
| 506-8<br>506-9     | BEDROOM<br>LIVING   | CLOSET   | 4' - 0"<br>6' - 0" | 8' - 0"<br>7' - 0" | 0' - 1 1/2"                | WD<br>AL/GL    | WD<br>AL   | AA<br>H   |             | EXTERIOR STOREFRONT                     |
| 506-9<br>506-10    | BEDROOM             |  | 6' - 0"            | 7' - 0"            | 0' - 2"                    | AL/GL          | AL         | Н         |             | EXTERIOR STOREFRONT                     |
| 507                | STAIR 1             |  | 3' - 0"            | 7' - 0"            | 0' - 2"                    |                | НМ         | С         |             |   |
| 507-1              | MAID                | ENTRY  | 3' - 0"            | 8' - 0"            | 0' - 1 3/4"                | WD             | WD         | AA        | 1HR         | 1 HOUR RATED                            |
| 507-2<br>507-3     | WD<br>BATH 2        | ENTRY<br>ENTRY   | 2' - 0"            | 7' - 0"<br>8' - 0" | 0' - 2"                    | WD<br>WD       | WD         | AA<br>AA  |             |   |
| 507-3              | CLOSET              | BEDROOM 2  | 4' - 0"            | 8' - 0"            | 0' - 1 3/4"                | WD             | WD         | AB        |             | DOUBLE DOOR / PAIR                      |
| 507-5              | KITCHEN             | BEDROOM 2  | 2' - 8"            | 8' - 0"            | 0' - 1 3/4"                | WD             | WD         | AA        |             |   |
| 507-6              | WATER               | KITCHEN  | 2' - 0"            | 8' - 0"            | 0' - 1 3/4"                | WD             | WD         | AA        |             |   |
| 507-7<br>507-8     | BEDROOM 1           | LIVING<br>BEDROOM 1  | 2' - 8"            | 8' - 0"<br>8' - 0" | 0' - 1 3/4"                | WD             | WD<br>WD   | AA        |             |   |
| 507-8<br>507-9     | BEDROOM 1           | BEDROOM 1  | 3' - 0"<br>6' - 8" | 8' - 0"<br>7' - 0" | 0' - 1 1/2"                | WD<br>AL/GL    | AL         | H         |             | EXTERIOR STOREFRONT                     |
| 507-10             | LIVING              |  | 6' - 8"            | 7' - 0"            | 0' - 2"                    | AL/GL          | AL         | Н         |             | EXTERIOR STOREFRONT                     |
| 507-11             | BEDROOM 2           | BATH 2   | 2' - 8"            | 8' - 0"            | 0' - 1 3/4"                |                | WD         | AA        | 6           |   |
| 507-127<br>507-128 | STAIR 3             |  | 3' - 0"<br>3' - 0" | 7' - 0"<br>7' - 0" | 0' - 1 3/4"                |                | HM<br>HM   | C<br>E    | 2HR<br>2HR  |   |
| L() / = · · · ·    |                     | and the second s |                    |                    | 1111                       | 1              |            |           |             | 1                                       |

|                   |                      |                        |                     |                    |             | 7             |            |           |             |   |
|-------------------|----------------------|------------------------|---------------------|--------------------|-------------|---------------|------------|-----------|-------------|---|
| MARK              | FROM                 | 0                      | WIDTH               | HEIGHT             | THICKNESS   | DOOR MATERIAL | DOOR FRAME | DOOR TYPE | FIRE RATING | REMARKS                                 |
| 1507-157          | ELEC.                |                        | 6' - 0"             | 7' - 0"            | 0' - 1 3/4" |               |            |           |             | T                                       |
| 1508              |                      |                        | 6' - 0"             | 7' - 0"            | 0' - 1 3/4" |               | НМ         | D         |             |   |
| 1508-1<br>1508-2  | ENTRY<br>A/C         | HALL                   | 3' - 0"<br>2' - 0"  | 8' - 0"<br>8' - 0" | 0' - 1 3/4" | WD<br>WD      | WD<br>WD   | AA<br>AA  | 1HR         | 1 HOUR RATED                            |
| 1508-2            | HALL                 | LAUNDRY                | 3' - 6"             | 8' - 0"            | 0' - 1 3/4" | WD            | WD         | CC        |             | DOUBLE DOOR / PAIR                      |
| 1508-4            | STOR.                | HALL                   | 2' - 0"             | 8' - 0"            | 0' - 1 3/4" | WD            | WD         | AA        |             | BOOBLE BOOTT, I AIT                     |
| 1508-6            | CLOSET               | BEDROOM 2              | 5' - 0"             | 8' - 0"            | 0' - 1 1/2" | WD            | WD         | L         |             |   |
| 1508-7            | BEDROOM 2            | HALL                   | 2' - 8"             | 8' - 0"            | 0' - 1 3/4" |               | WD         | AA        |             |   |
| 1508-8            | HALL                 | BEDROOM 1              | 2' - 8"             | 8' - 0"            | 0' - 1 3/4" | WD            | WD         | AA        |             |   |
| 1508-9<br>1508-10 | HALL<br>BEDROOM 1    | BATH 1<br>BATH 1       | 2' - 8"             | 8' - 0"<br>8' - 0" | 0' - 1 3/4" |               | WD<br>WD   | AA<br>AA  |             |   |
| 1508-10           | CLOS.                | BEDROOM 1              | 4' - 0"             | 8' - 0"            | 0' - 1 1/2" | WD            | WD         | L         |             |   |
| 1508-12           | BEDROOM 1            | CLOS.                  | 4' - 0"             | 8' - 0"            | 0' - 1 1/2" | WD            | WD         | L         |             |   |
| 1508-13           | CLOSET               | BEDROOM 1              | 3' - 6"             | 8' - 0"            | 0' - 1 3/4" |               | WD         | CC        |             | DOUBLE DOOR / PAIR                      |
| 1508-14           | BEDROOM 1            | DEDDO0140              | 6' - 8"             | 7' - 0"            | 0' - 2"     | AL/GL         | AL         | Н         |             | EXTERIOR STOREFRONT                     |
| 1508-15           | CLOSET<br>BEDROOM 2  | BEDROOM 2              | 2' - 0"<br>6' - 8"  | 8' - 0"<br>7' - 0" | 0' - 1 3/4" | WD<br>AL/GL   | WD<br>AL   | AA<br>H   |             | EVTEDIOD CTODEEDONI                     |
| 508-16<br> 508-17 | CLOSET               | BEDROOM 2              | 3' - 6"             | 8' - 0"            | 0' - 1 3/4" | WD            | WD         | СС        |             | EXTERIOR STOREFRONT DOUBLE DOOR / PAIR  |
| 1508-18           | LIVING               | BEBT (GGIVI E          | 6' - 8"             | 7' - 0"            | 0' - 2"     | 1115          | 111        |           |             | BOOBLE BOOTT, I 7 till t                |
| 1509              | GYM                  | IDF                    | 3' - 0"             | 7' - 0"            | 0' - 1 3/4" |               |            | С         | _           |   |
| 1509-1            |                      | KITCHEN                | 3' - 0"             | 8' - 0"            | 0' - 1 3/4" |               |            | AA        | 1HR         | 1 HOUR RATED                            |
| 1509-2            | A/C                  | KITCHEN                | 2' - 0"             | 8' - 0"            | 0' - 1 3/4" | WD            | WD         | AA        |             |   |
| 1509-3<br>1509-4  | KITCHEN<br>KITCHEN   | BATH<br>LAUNDRY        | 2' - 8"             | 8' - 0"<br>8' - 0" | 0' - 1 3/4" |               | WD<br>WD   | AA<br>AA  |             |   |
| 1509-4            | BEDROOM 2            | BATH 2                 | 2' - 8"             | 8' - 0"            | 0' - 1 3/4" |               | WD         |           |             | +                                       |
| 1509-5            | KITCHEN              | H20                    | 2' - 0"             | 8' - 0"            | 0' - 1 3/4" | WD            | WD         | AA        |             |   |
| 1509-6            | KITCHEN              | BEDROOM                | 2' - 8"             | 8' - 0"            | 0' - 1 3/4" |               | WD         | AA        |             |   |
| 1509-7            | BATH                 | BEDROOM                | 3' - 0"             | 8' - 0"            | 0' - 1 3/4" | WD            | WD         | AA        | 1HR         | 1 HOUR RATED                            |
| 1509-8            | CLOSET               | BEDROOM                | 4' - 0"             | 8' - 0"            | 0' - 1 3/4" | WD            | WD         | CC        |             | DOUBLE DOOR / PAIR                      |
| 1509-9<br>1509-10 | BEDROOM<br>LIVING    |                        | 6' - 8"<br>6' - 8"  | 7' - 0"<br>7' - 0" | 0' - 2"     | AL<br>AL      | AL<br>AL   | H         |             | EXTERIOR STOREFRONT EXTERIOR STOREFRONT |
| 1510              | GYM                  |                        | 3' - 0"             | 7' - 0"            | 0' - 1 3/4" | AL            | HM         | С         |             | EXTERIOR STORE RON                      |
| 1510-1            |                      | KITCHEN                | 3' - 0"             | 8' - 0"            | 0' - 1 3/4" | WD            | WD         | AA        | 1HR         | 1 HOUR RATED                            |
| 1510-2            | A/C                  | KITCHEN                | 2' - 0"             | 8' - 0"            | 0' - 1 3/4" | WD            | WD         | AA        |             |   |
| 1510-3            | KITCHEN              | BATH                   | 2' - 8"             | 8' - 0"            | 0' - 1 3/4" | WD            | WD         | AA        |             |   |
| 1510-4            | KITCHEN              | LAUNDRY                | 2' - 0"             | 8' - 0"            | 0' - 1 3/4" | WD            | WD         | AA        |             |   |
| 510-5<br> 510-6   | KITCHEN              | H2O<br>BEDROOM         | 2' - 0"<br>3' - 0"  | 8' - 0"<br>8' - 0" | 0' - 1 3/4" | WD<br>WD      | WD         | AA<br>AA  | 1HR         | 1 HOUR RATED                            |
| 1510-0            | BATH                 | BEDROOM                | 2' - 8"             | 8' - 0"            | 0' - 1 3/4" | WD            | WD         | AA        | HIIIX       | THOOR NATED                             |
| 1510-8            | CLOSET               | BEDROOM                | 4' - 0"             | 8' - 0"            | 0' - 1 3/4" | WD            | WD         | CC        |             | DOUBLE DOOR / PAIR                      |
| 1510-9            | BEDROOM              |                        | 6' - 8"             | 7' - 0"            | 0' - 2"     | WD            | AL         | Н         |             | EXTERIOR STOREFRONT                     |
| 1510-10           | LIVING               |                        | 6' - 8"             | 7' - 0"            | 0' - 2"     | WD            | AL         | Н         |             | EXTERIOR STOREFRONT                     |
| 1511              |                      | ENTEN                  | 6' - 0"             | 7' - 0"            | 0' - 1 3/4" | WD            | HM         | D         | 41.15       | 4 HOUR DATED                            |
| 511-1<br> 511-2   | CLOSET               | ENTRY<br>ENTRY         | 3' - 0"<br>3' - 6"  | 8' - 0"<br>8' - 0" | 0' - 1 3/4" | WD<br>WD      | WD<br>WD   | AA<br>CC  | 1HR         | 1 HOUR RATED DOUBLE DOOR / PAIR         |
| 1511-2            | HALL                 | BATH 1                 | 2' - 8"             | 8' - 0"            | 0' - 1 3/4" |               | WD         | AA        |             | DOOBLE DOOR / FAIR                      |
| 511-4             | STOR.                | HALL                   | 2' - 6"             | 8' - 0"            | 0' - 1 3/4" | WD            | WD         | СС        |             | DOUBLE DOOR / PAIR                      |
| 1511-5            | HALL                 | BEDROOM 1              | 2' - 8"             | 8' - 0"            | 0' - 1 3/4" | WD            | WD         | М         |             |   |
| 1511-6            | BEDROOM 1            | CLOSET                 | 4' - 0"             | 8' - 0"            | 0' - 1 1/2" | WD            | WD         | L         |             |   |
| 1511-7<br>1511-8  | BEDROOM 1 BEDROOM 1  | CLOSET                 | 4' - 0"<br>6' - 8"  | 8' - 0"<br>7' - 0" | 0' - 1 1/2" | WD<br>AL/GL   | WD<br>AL   | H         |             | EXTERIOR STOREFRONT                     |
| 1511-9            | BEDROOM 2            | BATH 2                 | 3' - 6"             | 8' - 0"            | 0' - 1 3/4" | WD            | WD         | CC        |             | DOUBLE DOOR / PAIR                      |
| 1511-10           | CLOS.                | BEDROOM 2              | 3' - 6"             | 8' - 0"            | 0' - 1 3/4" | WD            | WD         | CC        |             | DOUBLE DOOR / PAIR                      |
| 1511-11           | BEDROOM 2            | LAUNDRY                | 3' - 6"             | 8' - 0"            | 0' - 1 3/4" | WD            | WD         | CC        |             | DOUBLE DOOR / PAIR                      |
| 1511-12           | LIVING               | LAUNDRY                | 2' - 0"             | 8' - 0"            | 0' - 1 3/4" | WD            | WD         | AA        |             |   |
| 511-13<br> 511-14 | A/C                  | BEDROOM 2<br>BEDROOM 2 | 2' - 0"<br>2' - 10" | 8' - 0"<br>7' - 0" | 0' - 1 3/4" | WD<br>AL/GL   | WD<br>AL   | AA<br>H   |             | EXTERIOR STOREFRONT                     |
| 1511-14           | KITCHEN              | BEDROOM 2              | 2' - 10"            | 7' - 0"            | 0' - 1 3/8" | WD            | AL         | Н         |             | EXTERIOR STOREFRONT                     |
| 512               |                      |                        | 6' - 0"             | 7' - 0"            | 0' - 1 3/4" |               | HM         | D         |             |   |
| 1512-1            | ENTRY                |                        | 3' - 0"             | 8' - 0"            | 0' - 1 3/4" | WD            | WD         | AA        | 1HR         | 1 HOUR RATED                            |
| 1512-2            | A/C                  | ENTRY                  | 2' - 0"             | 8' - 0"            | 0' - 1 3/4" | WD            | WD         | AA        |             |   |
| 1512-3            | LAUNDRY              | ENTRY                  | 5' - 0"<br>3' - 0"  | 8' - 0"<br>8' - 0" | 0' - 1 1/2" | WD            | WD         | L<br>^^   |             |   |
| 512-4<br> 512-5   | ENTRY<br>BEDROOM     | BEDROOM<br>CLOSET      | 4' - 0"             | 8' - 0"            | 0' - 1 3/4" | WD            | WD<br>WD   | AA<br>L   |             |   |
| 1512-6            |                      | BEDROOM                | 6' - 0"             | 7' - 0"            | 0' - 2"     | AL/GL         | AL         | Н         |             | EXTERIOR STOREFRONT                     |
| 1512-7            | BEDROOM              |                        | 2' - 8"             | 8' - 0"            | 0' - 1 3/4" | WD            | WD         | AA        |             |   |
| 1512-8            | IZITOL :=:           | LIVING                 | 2' - 8"             | 8' - 0"            | 0' - 1 3/4" | WD            | WD         | AA        |             | EVTEDIOD CTOTES                         |
| 512-10            | KITCHEN              |                        | 2' - 10"            | 7' - 0"<br>7' - 0" | 0' - 1 3/8" | AL/GL         | AL         | H<br>D    |             | EXTERIOR STOREFRONT                     |
| 513<br> 513-1     |                      | ENTRY                  | 6' - 0"<br>2' - 6"  | 8' - 0"            | 0' - 1 3/4" | WD            | HM<br>WD   | D<br>AA   |             | +                                       |
| 1513-2            | ENTRY                |                        | 2' - 8"             | 8' - 0"            | 0' - 1 3/4" |               | WD         | AA        |             |   |
| 1513-3            | CLOS.                | ENTRY                  | 2' - 0"             | 8' - 0"            | 0' - 1 3/4" | AL/GL         | WD         | AA        |             |   |
| 1513-4            | ENTRY                | BEDROOM 1              | 3' - 0"             | 8' - 0"            | 0' - 1 3/4" | WD            | WD         | AA        |             |   |
| 513-5<br> 513-6   | CLOSET<br>A/C        | BEDROOM 1 KITCHEN      | 4' - 0"<br>2' - 0"  | 8' - 0"<br>8' - 0" | 0' - 1 1/2" | WD            | WD<br>WD   | L<br>ΛΛ   |             |   |
| 513-6<br> 513-7   | BEDROOM 2            | BATH 2                 | 2' - 0"             | 8' - 0"<br>8' - 0" | 0' - 1 3/4" | WD<br>WD      | WD         | AA<br>AA  |             | +                                       |
| 513-7             | LAUNDRY              | BEDROOM 2              | 3' - 0"             | 8' - 0"            | 0' - 1 3/4" | WD            | WD         | CC        |             | DOUBLE DOOR / PAIR                      |
| 1513-9            | BEDROOM 2            | CLOSET                 | 3' - 0"             | 8' - 0"            | 0' - 1 3/4" |               | WD         | CC        |             | DOUBLE DOOR / PAIR                      |
| 1513-10           | LIVING               | BEDROOM 2              | 3' - 0"             | 8' - 0"            | 0' - 1 3/4" |               | WD         | AA        |             |   |
| 513-11            | LIVING               |                        | 6' - 0"             | 7' - 0"            | 0' - 2"     | AL/GL         | AL         | Н         |             | EXTERIOR STOREFRONT                     |
| 513-12<br> 514    | BEDROOM 2            |                        | 6' - 0"<br>6' - 0"  | 7' - 0"<br>7' - 0" | 0' - 2"     | AL/GL         | AL<br>HM   | H<br>D    |             | EXTERIOR STOREFRONT                     |
| 1514<br>1514-1    |                      | ENTRY                  | 3' - 0"             | 8' - 0"            | 0' - 1 3/4" | WD            | WD         | AA        | 1HR         | 1 HOUR RATED                            |
| 1514-1            | ENTRY                | BATH 1                 | 2' - 8"             | 8' - 0"            | 0' - 1 3/4" |               | WD         | AA        |             |   |
| 1514-3            | CLOS.                | ENTRY                  | 2' - 8"             | 8' - 0"            | 0' - 1 3/4" |               | WD         | AA        |             |   |
| 1514-4            | ENTRY                | BEDROOM 1              | 3' - 0"             | 8' - 0"            | 0' - 1 3/4" | WD            | WD         | AA        |             |   |
| 1514-5            | CLOSET               | BEDROOM 1              | 4' - 0"             | 7' - 0"            | 0' - 1 1/2" | WD            | WD         | CC        |             | DOUBLE DOOR / PAIR                      |
| 514-6<br> 514-7   | A/C                  | KITCHEN<br>BATH 2      | 2' - 0"             | 8' - 0"<br>8' - 0" | 0' - 1 3/4" | WD<br>WD      | WD         | AA<br>AA  |             | DOUBLE DOOR / PAIR                      |
| 514-7<br> 514-8   | BEDROOM 2<br>LAUNDRY | BATH 2<br>BEDROOM 2    | 2' - 8"             | 8' - 0"<br>8' - 0" | 0' - 1 3/4" | WD            | WD         | AA<br>AA  |             |   |
| 514-6             | BEDROOM 2            | CLOSET                 | 3' - 0"             | 8' - 0"            | 0' - 1 3/4" |               | WD         | CC        |             | DOUBLE DOOR / PAIR                      |
| -                 |                      |                        |                     |                    |             |               |            |           |             |   |
| 514-10            | BEDROOM 2            | LIVING                 | 3' - 0"             | 8' - 0"            | 0' - 1 3/4" | WD            | WD         | AA        |             |   |

|   |                                 |                           |  |   | SS  | TERIA          | FRAME          | Д              | Ŋ           |                              |
|---|---------------------------------|---------------------------|--|---|---|----------------|----------------|----------------|-------------|------------------------------|
| MARK  | FROM                            | <u>6</u>                  | WIDTH                                    | HEIGHT  | THICKNESS                                 | DOOR MATERIAL  | DOOR FRA       | DOOR TYPE      | FIRE RATING | REMARKS                      |
| 1515-1  |                                 | LIVING                    | 3' - 0"                                  | 8' - 0"   | 0' - 1 3/4"                               | WD             | WD             | AA             | 1HR         | 1 HOUR RATED                 |
| 1515-1  | A/C                             | BEDROOM 1                 | 2' - 0"                                  | 8' - 0"   | 0' - 1 3/4"                               | WD             | WD             | AA             | 11111       | THOORTIALED                  |
| 1515-3  | BEDROOM 1                       | BATH 1                    | 2' - 8"                                  | 8' - 0"   | 0' - 1 3/4"                               | WD             | WD             | AA             |             |                              |
| 1515-4  | TOILET                          | BATH 1                    | 2' - 8"                                  | 8' - 0"   | 0' - 1 3/4"                               | 14/D           | 14/5           |                |             | DOUBLE DOOD / DA             |
| 1515-5  | LAUNDRY                         | BEDROOM 1                 | 3' - 0"                                  | 8' - 0"   | 0' - 1 3/4"                               | WD             | WD             | CC             |             | DOUBLE DOOR / PA             |
| 1515-6<br>1515-7  | CLOS. BEDROOM 1                 | BEDROOM 1                 | 3' - 0"<br>6' - 0"                       | 8' - 0"<br>7' - 0"                                  | 0' - 1 3/4"                               | WD<br>AL/GL    | WD<br>AL       | CC<br>H        |             | DOUBLE DOOR / PA             |
| 1515-8  | LIVING                          | BEDROOM 1                 | 3' - 0"                                  | 8' - 0"   | 0' - 1 3/4"                               | WD             | WD             | AA             | 1HR         | 1 HOUR RATED                 |
| 1515-9  | LIVING                          |                           | 6' - 0"                                  | 7' - 0"   | 0' - 2"                                   | AL/GL          | AL             | Н              |             | EXTERIOR STOREF              |
| 1515-10   | LIVING                          | BATH 2                    | 2' - 8"                                  | 8' - 0"   | 0' - 1 3/4"                               | WD             | WD             | AA             |             |                              |
| 1515-11<br>1515-12  | BATH 2                          | LIVING                    | 3' - 0"                                  | 8' - 0"   | 0' - 1 3/4"                               | WD             | WD<br>WD       | AA<br>AA       |             |                              |
| 1515-12   | BATH 2<br>BATH 2                | BATH 2<br>CLOS.           | 2' - 8"                                  | 8' - 0"<br>8' - 0"                                  | 0' - 1 3/4"                               | WD<br>WD       | WD             | L              |             |                              |
| 1515-14   | BATH 2                          | OLOO.                     | 6' - 0"                                  | 7' - 0"   | 0' - 2"                                   | AL/GL          | AL             | Н              |             | EXTERIOR STOREF              |
| 1516  |                                 |                           | 6' - 0"                                  | 7' - 0"   | 0' - 1 3/4"                               |                | НМ             | D              |             |                              |
| 1516-1  |                                 | ENTRY                     | 3' - 0"                                  | 8' - 0"   | 0' - 1 3/4"                               | WD             | WD             | AA             | 1HR         | 1 HOUR RATED                 |
| 1516-2  | ENTRY                           | LAUNDRY                   | 4' - 0"                                  | 8' - 0"   | 0' - 1 3/4"                               | WD             | WD             | CC             |             | DOUBLE DOOR / PA             |
| 1516-3  | CLOS.                           | ENTRY<br>ENTRY            | 2' - 6"<br>2' - 6"                       | 8' - 0"   | 0' - 1 3/4"                               | WD             | WD<br>WD       | AA<br>AA       |             |                              |
| 1516-4<br>1516-5  | BATH 2                          | BEDROOM 2                 | 2' - 8"                                  | 8' - 0"<br>8' - 0"                                  | 0' - 1 3/4"                               | WD<br>WD       | WD             | AA             |             |                              |
| 1516-6  | CLOSET                          | BEDROOM 2                 | 4' - 0"                                  | 8' - 0"   | 0' - 1 1/2"                               | WD             | WD             | L              |             |                              |
| 1516-7  | BEDROOM 2                       |                           | 6' - 0"                                  | 7' - 0"   | 0' - 2"                                   | AL/GL          | AL             | Н              |             | EXTERIOR STOREF              |
| 1516-8  | LIVING                          | BEDROOM 2                 | 3' - 0"                                  | 8' - 0"   | 0' - 1 3/4"                               | WD             | WD             | AA             |             |                              |
| 1516-9  | ENTRY                           | H20                       | 2' - 6"                                  | 8' - 0"   | 0' - 1 3/4"                               | WD             | WD             | AA             |             |                              |
| 1516-10<br>1516-11  | H20<br>LIVING                   | LIVING                    | 2' - 6"                                  | 8' - 0"<br>8' - 0"                                  | 0' - 1 3/4"                               | WD<br>WD       | WD             | AA<br>M        |             |                              |
| 1516-11<br>1516-12  | HALL                            | HALL<br>BATH 1            | 2' - 8"                                  | 8' - 0"   | 0' - 1 3/4"                               | WD             | WD<br>WD       | AA             |             |                              |
| 1516-12   | HALL                            | BEDROOM 1                 | 3' - 0"                                  | 8' - 0"   | 0' - 1 3/4"                               | WD             | WD             | AA             |             |                              |
| 1516-14   | CLOSET                          | BEDROOM 1                 | 3' - 6"                                  | 8' - 0"   | 0' - 1 3/4"                               | WD             | WD             | CC             |             | DOUBLE DOOR / PA             |
| 1516-16   | BEDROOM 1                       |                           | 2' - 10"                                 | 7' - 0"   | 0' - 1 3/8"                               | AL/GL          | AL             | Н              |             | EXTERIOR STOREF              |
| 1516-17   | KITCHEN                         | ENTEN:                    | 2' - 10"                                 | 7' - 0"   | 0' - 1 3/8"                               | AL/GL          | AL             | Н              | 41.15       | EXTERIOR STOREF              |
| 1517-1<br>1517-2  | ENTRY                           | ENTRY<br>CLOS.            | 3' - 0"<br>2' - 6"                       | 8' - 0"<br>8' - 0"                                  | 0' - 1 3/4"                               | WD<br>WD       | WD<br>WD       | AA<br>AA       | 1HR         | 1 HOUR RATED                 |
| 1517-2  | LAUNDRY                         | ENTRY                     | 4' - 0"                                  | 8' - 0"   | 0' - 1 3/4"                               | WD             | WD             | CC             |             | DOUBLE DOOR / PA             |
| 1517-4  | BEDROOM 2                       | BATH 2                    | 2' - 8"                                  | 8' - 0"   | 0' - 1 3/4"                               | WD             | WD             | AA             |             | BOOBLE BOOK IT               |
| 1517-6  | BEDROOM 2                       | CLOS.                     | 4' - 0"                                  | 8' - 0"   | 0' - 1 1/2"                               | WD             | WD             | L              |             |                              |
| 1517-7  | ENTRY                           | A/C                       | 2' - 6"                                  | 8' - 0"   | 0' - 1 3/4"                               | WD             | WD             | AA             |             |                              |
| 1517-8  | H2O                             | ENTRY                     | 2' - 6"                                  | 8' - 0"   | 0' - 1 3/4"                               | WD             | WD             | AA             |             |                              |
| 1517-9<br>1517-10   | LIVING<br>HALL                  | H2O<br>LIVING             | 2' - 6"<br>3' - 0"                       | 8' - 0"<br>8' - 0"                                  | 0' - 1 3/4"                               | WD<br>WD       | WD<br>WD       | AA<br>M        |             |                              |
| 1517-10   | BATH 1                          | HALL                      | 2' - 8"                                  | 8' - 0"   | 0' - 1 3/4"                               | WD             | WD             | AA             |             |                              |
| 1517-12   | HALL                            | BEDROOM 1                 | 3' - 0"                                  | 8' - 0"   | 0' - 1 3/4"                               | WD             | WD             | AA             |             |                              |
| 1517-13   | BEDROOM 1                       | CLOSET                    | 3' - 6"                                  | 8' - 0"   | 0' - 1 3/4"                               | WD             | WD             | CC             |             |                              |
| 1517-15   | KITCHEN                         |                           | 2' - 10"                                 | 7' - 0"   | 0' - 1 3/8"                               | AL/GL          | AL             | Н              |             | EXTERIOR STOREF              |
| 1517-16   | BEDROOM 1                       |                           | 2' - 10"                                 | 7' - 0"   | 0' - 1 3/8"                               | AL/GL          | AL             | Н              | 4110        | EXTERIOR STOREF              |
| 1518-1<br>1518-2  | LIVING<br>KITCHEN               |                           | 3' - 0"<br>2' - 10"                      | 8' - 0"<br>7' - 0"                                  | 0' - 1 3/4"                               | WD<br>AL       | WD<br>AL       | AA<br>H        | 1HR         | 1 HOUR RATED EXTERIOR STOREF |
| 1518-3  | LAUNDRY                         | LIVING                    | 3' - 6"                                  | 8' - 0"   | 0' - 1 3/4"                               | WD             | WD             | CC             |             | DOUBLE DOOR / PA             |
| 1518-4  | LIVING                          | BEDROOM                   | 3' - 0"                                  | 8' - 0"   | 0' - 1 3/4"                               | WD             | WD             | AA             |             |                              |
| 1518-5  | POWDER                          | LIVING                    | 2' - 8"                                  | 8' - 0"   | 0' - 1 3/4"                               | WD             | WD             | AA             |             |                              |
| 1518-6<br>1518-7  | A/C<br>STORAGE                  | LIVING<br>BATH            | 2' - 0"<br>3' - 0"                       | 8' - 0"<br>8' - 0"                                  | 0' - 1 3/4"                               | WD<br>WD       | WD<br>WD       | AA<br>AA       |             |                              |
| 1518-8  | BATH                            | BEDROOM                   | 2' - 8"                                  | 8' - 0"   | 0' - 1 3/4"                               | WD             | WD             | AA             |             |                              |
| 1518-9  | CLOSET                          | BEDROOM                   | 4' - 0"                                  | 8' - 0"   | 0' - 1 1/2"                               | WD             | WD             | L              |             |                              |
| 1518-10   | CLOSET                          | BEDROOM                   | 4' - 0"                                  | 8' - 0"   | 0' - 1 1/2"                               | WD             | WD             | L              |             |                              |
| 1518-11   | STUDY                           |                           | 6' - 0"                                  | 7' - 0"   | 0' - 2"                                   | AL/GL          | AL             | Н              |             | EXTERIOR STOREF              |
| 1519-1  | ENTOV                           | ENTRY                     | 3' - 0"                                  | 8' - 0"   | 0' - 1 3/4"                               | WD             | WD             | AA             | 1HR         | 1 HOUR RATED                 |
| 1519-2<br>1519-3  | ENTRY<br>H2O                    | BATH<br>ENTRY             | 2' - 8"                                  | 8' - 0"<br>8' - 0"                                  | 0' - 1 3/4"                               | WD<br>WD       | WD<br>WD       | AA<br>AA       |             |                              |
| 1519-4  | ENTRY                           | A/C                       | 2' - 8"                                  | 8' - 0"   |   | WD             | WD             |                |             |                              |
| 1519-5  | LAUNDRY                         | ENTRY                     | 3' - 0"                                  | 8' - 0"   | 0' - 1 3/4"                               | WD             | WD             | CC             |             | DOUBLE DOOR / PA             |
| 1519-6  | ENTRY                           | BEDROOM 1                 | 2' - 8"                                  | 8' - 0"   | 0' - 1 3/4"                               | WD             | WD             | AA             |             |                              |
| 1519-7  | BEDROOM 1                       | CLOSET                    | 5' - 0"                                  | 8' - 0"   | 0' - 1 1/2"                               | WD             | WD             | L              |             |                              |
| 1519-8  | BEDROOM 2                       | BATH 2<br>CLOSET          | 2' - 8"                                  | 8' - 0"<br>8' - 0"                                  | 0' - 1 3/4"                               | WD             | WD             | М              |             | DOUBLE BOOK (E.              |
| 1519-10<br>1519-11  | BEDROOM 2<br>KITCHEN            | BEDROOM 2                 | 2' - 8"                                  | 8' - 0"   | 0' - 1 3/8"                               | WD<br>WD       | WD<br>WD       | AB<br>AA       |             | DOUBLE DOOR / PA             |
| 1519-11   | LIVING                          |                           | 6' - 0"                                  | 7' - 0"   | 0' - 2"                                   | AL/GL          | AL             | Н              |             | EXTERIOR STOREF              |
| 1519-13   | BEDROOM 2                       | CLOSET                    | 3' - 0"                                  | 8' - 0"   | 0' - 1 3/8"                               |                |                |                |             |                              |
| 1520-1  | ENTRY                           |                           | 3' - 0"                                  | 8' - 0"   | 0' - 1 3/4"                               | WD             | WD             | AA             | 1HR         | 1 HOUR RATED                 |
| 1520-2  |                                 | ENTRY                     | 5' - 0"                                  | 8' - 0"   | 0' - 1 1/2"                               | WD             | WD             | L              |             |                              |
| 1520-3  | CLOSET                          | ENTRY<br>BEDROOM 1        | 2' - 6"<br>3' - 0"                       | 8' - 0"<br>8' - 0"                                  | 0' - 1 3/4"                               | WD             | WD<br>WD       | AA<br>CC       |             |                              |
| 1520-4<br>1520-5  | CLOSET<br>KITCHEN               | BEDROOM 1 PANTRY          | 2' - 6"                                  | 8' - 0"   | 0' - 1 3/8"                               | WD<br>WD       | WD             | AA             |             |                              |
| 1520-5  | HALL                            | BEDROOM 1                 | 3' - 0"                                  | 8' - 0"   | 0' - 1 3/4"                               | WD             | WD             | AA             |             |                              |
| 1520-7  | HALL                            | BATH 1                    | 2' - 8"                                  | 8' - 0"   | 0' - 1 3/4"                               | WD             | WD             | AA             |             |                              |
| 1520-8  | HALL                            | KITCHEN                   | 3' - 0"                                  | 8' - 0"   | 0' - 1 3/8"                               | WD             | WD             | CC             |             | DOUBLE DOOR / PA             |
| 1520-9  | A/C                             | HALL                      | 2' - 0"                                  | 8' - 0"   | 0' - 1 3/4"                               | WD             | WD             | AA             |             |                              |
| 1520-10<br>1520-11  | BATH 2<br>BEDROOM 2             | TOILET<br>BATH 2          | 3' - 0"<br>2' - 8"                       | 8' - 0"<br>8' - 0"                                  | 0' - 1 3/4"                               | WD<br>WD       | WD<br>WD       | M<br>AA        |             |                              |
| 1520-11<br>1520-12  | CLOSET                          | BEDROOM 2                 | 3' - 0"                                  | 8' - 0"   | 0' - 1 3/4"                               | AL/GL          | WD             | H              |             |                              |
| 1520-12   | KITCHEN                         | BEDROOM 2                 | 3' - 6"                                  | 8' - 0"   | 0' - 1 3/8"                               | WD             | WD             | СС             |             | DOUBLE DOOR / PA             |
| 1520-14   | BEDROOM 2                       | CLOSET                    | 3' - 0"                                  | 8' - 0"   | 0' - 1 1/2"                               | WD             | WD             | L              |             |                              |
| 1520-15   | CLOSET                          | BATH 3                    | 2' - 0"                                  | 8' - 0"   | 0' - 1 3/4"                               | WD             | WD             | AA             |             |                              |
| 1520-16   | BEDROOM 3                       | BATH 3                    | 2' - 8"                                  | 8' - 0"   | 0' - 1 3/4"                               | WD             | WD             | AA             |             |                              |
| 1520-17   | BEDROOM 3                       | LIVING                    | 3' - 0"                                  | 8' - 0"   | 0' - 1 3/4"                               | WD             | WD             | AA             |             |                              |
|   | CLOSET                          | BEDROOM 3                 | 5' - 0"                                  | 8' - 0"   | 0' - 1 1/2"                               | WD             | WD             | L              |             | EVTEDIOD OTODES              |
| 1520-18   | BEDROOM 3<br>LIVING             |                           | 6' - 0"<br>6' - 0"                       | 7' - 0"<br>7' - 0"                                  | 0' - 2"<br>0' - 2"                        |                | AL<br>AL       | H              |             | EXTERIOR STOREF              |
| 1520-19   |                                 |                           | 6' - 0"                                  | 7' - 0"   | 0' - 2"                                   | AL/GL          | AL             | Н              |             | EXTERIOR STORES              |
| 1520-19<br>1520-20  |                                 | i .                       |  | 8' - 0"   | 0' - 1 3/4"                               | WD             | WD             | AA             | 1HR         | 1 HOUR RATED                 |
| 1520-19   | BEDROOM 2                       | ENTRY                     | 3' - 0"                                  | 0 0   |   |                |                |                |             | · · ·                        |
| 1520-19<br>1520-20<br>1520-21   |                                 | ENTRY<br>CLOS.            | 3' - 0"<br>2' - 0"                       | 8' - 0"   | 0' - 1 3/4"                               | WD             | WD             | AA             |             |                              |
| 1520-19<br>1520-20<br>1520-21<br>1521-1<br>1521-2<br>1521-3                     | BEDROOM 2  ENTRY BATH           | CLOS.<br>ENTRY            | 2' - 0"<br>2' - 8"                       | 8' - 0"<br>8' - 0"                                  | 0' - 1 3/4"                               | WD<br>WD       | WD             | AA             |             |                              |
| 1520-19<br>1520-20<br>1520-21<br>1521-1<br>1521-2<br>1521-3<br>1521-4           | BEDROOM 2  ENTRY BATH A/C       | CLOS.<br>ENTRY<br>ENTRY   | 2' - 0"<br>2' - 8"<br>2' - 0"            | 8' - 0"<br>8' - 0"<br>8' - 0"                       | 0' - 1 3/4"<br>0' - 1 3/4"                | WD<br>WD       | WD<br>WD       | AA<br>AA       |             |                              |
| 1520-19<br>1520-20<br>1520-21<br>1521-1<br>1521-2<br>1521-3<br>1521-4<br>1521-5 | BEDROOM 2  ENTRY BATH A/C ENTRY | CLOS. ENTRY ENTRY BEDROOM | 2' - 0"<br>2' - 8"<br>2' - 0"<br>3' - 0" | 8' - 0"<br>8' - 0"<br>8' - 0"<br>7' - 0"            | 0' - 1 3/4"<br>0' - 1 3/4"<br>0' - 1 3/4" | WD<br>WD<br>WD | WD<br>WD       | AA<br>AA<br>AA |             |                              |
| 1520-19<br>1520-20<br>1520-21<br>1521-1<br>1521-2<br>1521-3<br>1521-4           | BEDROOM 2  ENTRY BATH A/C       | CLOS. ENTRY ENTRY BEDROOM | 2' - 0"<br>2' - 8"<br>2' - 0"<br>3' - 0" | 8' - 0"<br>8' - 0"<br>8' - 0"<br>7' - 0"<br>8' - 0" | 0' - 1 3/4"<br>0' - 1 3/4"                | WD<br>WD<br>WD | WD<br>WD<br>WD | AA<br>AA<br>AA |             | EXTERIOR STOREF              |

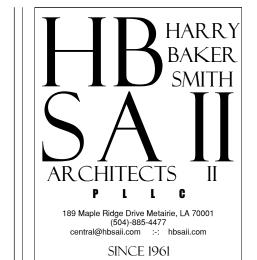

RD ROCK HOTE

THESE PLANS AND SPECIFICATIONS HAVE
BEEN PREPARED BY ME OR UNDER MY
CLOSE PERSONAL SUPERVISION AND TO
THE BEST OF MY KNOWLEDGE AND
BELIEF THEY COMPLY WITH ALL CITY,
STATE AND FEDERAL REQUIREMENTS, AND
I AM NOT PROVIDING CONTRACT
ADMINISTRATION.

CERTIFIED CORRECT



THIS DRAWING IS CONFIDENTIAL AND NOT BE LOANED, REPRODUCED, COPIED, EITHER WHOLLY OR IN PART, OR MADE PUBLIC IN ANY MANNER WITHOUT THE WRITTEN CONSENT OF HBSA II ARCHITECTS, A PROFESSIONAL L.L.C. ALL RIGHTS OF DESIGN OR INVENTION ARE RESERVED AND WILL REMAIN THE SOLE PROPERTY OF HBSA II ARCHITECTS A PROFESSIONAL L.L.C.

|                              | R                            | EVIS                         | ION                          | HIS                          | TOR                          | Υ                            |   |
|------------------------------|------------------------------|------------------------------|------------------------------|------------------------------|------------------------------|------------------------------|---|
| 4/27/2018                    | 5/4/2018                     | 5/11/2018                    | 5/18/2018                    | 5/25/2018                    | 6/1/2018                     | 6/8/2018                     |   |
|                              |                              |                              |                              |                              |                              |                              |   |
|                              |                              |                              |                              |                              |                              |                              |   |
| SION 1                       | SION 2                       | SION 3                       | SION 4                       | SION 5                       | 9 NOIS                       | SION 7                       |   |
| UD REVI                      |   |
| L.I.S. #2 - CLOUD REVISION 1 | L.I.S. #2 - CLOUD REVISION 2 | L.I.S. #2 - CLOUD REVISION 3 | L.I.S. #2 - CLOUD REVISION 4 | L.I.S. #2 - CLOUD REVISION 5 | L.I.S. #2 - CLOUD REVISION 6 | L.I.S. #2 - CLOUD REVISION 7 |   |
| L.I.S.                       |   |
| -                            | 2                            | က                            | 4                            | 2                            | 9                            | 7                            | 8 |

SCHEDULES

PROJECT#: 1709
PHASE: DD
TEAM: Author
CHECKER: Checker
SCALE: AS NOTED

|                             |                             |                                     | DOOR SCH                      | IEDULE                                       | - 16TH FLOC                           | )R             |            |                |             |   |
|-----------------------------|-----------------------------|-------------------------------------|-------------------------------|--|---------------------------------------|----------------|------------|----------------|-------------|---|
|                             |                             |                                     |                               |  | တ္                                    | TERIAL         | \ME        | J.             | ΰν          |   |
| MARK                        | FROM                        | ρ                                   | WIDTH                         | HEIGHT                                       | THICKNESS                             | DOOR MATERIAL  | DOOR FRAME | DOOR TYPE      | FIRE RATING | REMARKS                                 |
| 1600-1                      | ш.                          | DINING                              | 3' - 0"                       | 8' - 0"                                      | 0' - 1 3/4"                           | WD             | WD         | AA             |             | 1 HOUR RATED                            |
| 1600-3<br>1600-4            | MASTER BEDROOM              | DINING MASTER BATH                  | 3' - 0" 2' - 8"               | 8' - 0"<br>8' - 0"                           | 0' - 1 3/4"                           | WD<br>WD       | WD<br>WD   | AA<br>L        |             |   |
| 1600-5<br>1600-8            | CLOSET<br>UTILITY           | MASTER BATH HALL                    | 2' - 8"<br>5' - 0"<br>3' - 0" | 8' - 0"<br>8' - 0"                           | 0' - 1 3/4" 0' - 1 1/2"               | WD             | WD<br>WD   | L              |             |   |
|                             | HALL<br>BEDROOM<br>BEDROOM  | BATH<br>CLOSET                      | 2' - 8"<br>3' - 0"            | 8' - 0"<br>6' - 8"<br>8' - 0"                | 0' - 1 3/4"<br>0' - 2"<br>0' - 1 3/4" | WD             | WD<br>WD   | AA<br>AA<br>CC |             |   |
|                             | CLOSET STAIR 1              | BEDROOM                             | 3' - 0"<br>3' - 0"            | 8' - 0"<br>8' - 0"                           | 0' - 1 3/4" 0' - 1 3/4"               | WD<br>WD<br>HM | WD<br>HM   | CC             |             |   |
| 1601-1                      | MASTER BEDROOM<br>LIVING    |                                     | 3' - 0"<br>3' - 0"            | 8' - 2"<br>8' - 2"                           | 0' - 1 1/2" 0' - 1 1/2"               | AL/GL          | AL<br>AL   | K              |             | EXTERIOR STOREFRONT EXTERIOR STOREFRONT |
| 1601-3                      | MASTER BEDROOM MASTER BATH  | LIVING MASTER BEDROOM               | 3' - 0"                       | 8' - 0"                                      | 0' - 1 3/4" 0' - 1 3/4"               | WD             | WD<br>WD   | AA             |             | EXTERIOR STOREFRONT                     |
| 1601-4<br>1601-5<br>1601-6  | TOILET ROOM  MASTER BEDROOM | MASTER BEDROOM  MASTER BATH  CLOSET | 2' - 8"<br>2' - 8"<br>2' - 6" | 8' - 0"<br>8' - 0"<br>8' - 0"                | 0' - 1 3/4" 0' - 1 3/4" 0' - 1 3/4"   | WD<br>WD       | WD<br>WD   | L              |             |   |
| 1601-8<br>1601-8            | LAUNDRY HALL                | HALL<br>BEDROOM                     | 5' - 0"<br>3' - 0"            | 8' - 0"<br>8' - 0"                           | 0' - 1 3/4"                           | WD<br>WD       | WD<br>WD   | L<br>L<br>AA   |             |   |
| 1601-8<br>1601-9<br>1601-10 | CLOSET                      | BEDROOM<br>HALL                     | 4' - 0"<br>2' - 8"            | 8' - 0"<br>8' - 0"                           | 0' - 1 3/4" 0' - 1 3/4"               | WD<br>WD       | WD<br>WD   | CC             |             | DOUBLE DOOR / PAIR                      |
| 1601-11                     |                             | KITCHEN<br>KITCHEN                  | 2' - 8"                       | 8' - 0"<br>8' - 0"                           | 0' - 1 3/4" 0' - 1 3/4"               | WD<br>WD       | WD<br>WD   | AA<br>AA       |             |   |
| 1601-12<br>1601-13<br>1602  | PAININI                     | KITCHEN<br>STAIR 1                  | 3' - 0"<br>3' - 0"            | 8' - 0"                                      | 0' - 1 3/4" 0' - 1 3/4"               | WD<br>HM       | WD<br>HM   | AA<br>E        | 1HR<br>2HR  | 1 HOUR RATED                            |
| 1602-1                      | LIVING                      |                                     | 3' - 4"<br>3' - 6"            | 8' - 2"                                      | 0' - 1 1/2"<br>0' - 0 15/32"          | AL/GL<br>WD    |            | K<br>AA        | ZHK         | EXTERIOR STOREFRONT                     |
| 1602-2<br>1602-3            | LIVING                      | BEDROOM<br>BEDROOM                  | 3' - 0"                       | 8' - 0"                                      | 0' - 1 3/4"                           | WD             | WD         | AA             |             |   |
|                             | BEDROOM                     | BEDROOM<br>BATH                     | 3' - 0"<br>2' - 8"            | 7' - 0"<br>8' - 0"                           | 0' - 2"                               | WD             | WD         | CC<br>AA       |             |   |
| 1602-7                      | BEDROOM<br>KITCHEN          | CLOSET<br>LAUNDRY                   | 2' - 6"                       | 8' - 0"<br>8' - 0"                           | 0' - 1 3/4"                           | WD             | WD         | M<br>AA        |             |   |
| 1602-9                      | WATER HEATER A/C            | ENTRY<br>ENTRY                      | 3' - 0"<br>2' - 6"            | 8' - 0"<br>8' - 0"                           | 0' - 1 3/4"                           | WD             | WD<br>WD   | CC             |             |   |
| 1602-10                     |                             | POWDER<br>CLOSET                    | 2' - 8"                       | 8' - 0"<br>8' - 0"                           | 0' - 1 3/4"                           | WD             | WD         | CC             | 4110        | A HOUR DATED                            |
| 1602-12                     |                             | ENTRY                               | 3' - 0"<br>6' - 0"            | 8' - 0"<br>7' - 0"                           | 0' - 1 3/4"                           | WD<br>HM       | WD<br>HM   | AA<br>D        | 1HK         | 1 HOUR RATED                            |
| 1603-1<br>1603-2            |                             | LIVING<br>BEDROOM                   | 3' - 6"                       | 7' - 10"                                     | 0' - 0 15/32"                         | AL/GL          | AL         | K              |             | EXTERIOR STOREFRONT EXTERIOR STOREFRONT |
| 1603-3<br>1603-4            | HALL                        | BEDROOM<br>A/C                      | 3' - 6"                       | 8' - 0"<br>8' - 0"                           | 0' - 1 3/4"                           | WD<br>WD       | WD         | CC             |             | DOUBLE DOOR / PAIR                      |
| 1603-6                      | HALL<br>KITCHEN             | CLOSET<br>HALL                      | 5' - 0"<br>3' - 0"            | 8' - 0"<br>8' - 0"                           | 0' - 1 1/2"<br>0' - 1 3/4"            | WD<br>WD       | WD<br>WD   | CC             |             |   |
| 1603-7<br>1603-8            | HALL<br>LAUNDRY             | WATER HEATER<br>HALL                | 2' - 0"<br>3' - 0"            | 8' - 0"<br>8' - 0"                           | 0' - 1 3/4"<br>0' - 1 3/4"            | WD<br>WD       | WD<br>WD   | CC<br>AA       |             |   |
| 1603-10                     | HALL<br>KITCHEN             | BATH<br>PANTRY                      | 2' - 8"<br>2' - 8"            | 8' - 0"<br>8' - 0"                           | 0' - 1 3/4"<br>0' - 1 3/4"            | WD<br>WD       | WD<br>WD   | L<br>AA        |             |   |
| 1603-11<br>1604             |                             | KITCHEN                             | 3' - 0"<br>6' - 0"            | 8' - 0"<br>7' - 0"                           | 0' - 1 3/4"<br>0' - 1 3/4"            | WD<br>HM       | WD<br>HM   | AA<br>D        | 1HR         | 1 HOUR RATED                            |
| 1604-1<br>1604-2            |                             | LIVING<br>BEDROOM                   | 3' - 6"<br>3' - 6"            |  | 0' - 0 15/32"<br>0' - 0 15/32"        | AL/GL<br>AL/GL | AL<br>AL   | K              |             | EXTERIOR STOREFRONT EXTERIOR STOREFRONT |
| 1604-3<br>1604-4            | HALL<br>HALL                | BEDROOM<br>LAUNDRY                  | 2' - 8"<br>2' - 0"            | 8' - 0"<br>8' - 0"                           | 0' - 1 3/4"<br>0' - 1 3/4"            | WD<br>WD       | WD<br>WD   | L<br>CC        |             |   |
| 1604-5<br>1604-6            | HALL<br>CLOSET              | KITCHEN<br>HALL                     | 2' - 8"<br>5' - 0"            | 8' - 0"<br>8' - 0"                           | 0' - 1 3/4"<br>0' - 1 1/2"            | WD<br>WD       | WD<br>WD   | L              |             |   |
| 1604-7<br>1604-8            | A/C<br>HALL                 | HALL<br>BATH                        | 2' - 0"<br>2' - 8"            | 8' - 0"<br>8' - 0"                           | 0' - 1 3/4"<br>0' - 1 3/4"            | WD<br>WD       | WD<br>WD   | CC<br>L        |             |   |
| 1604-9<br>1604-10           | KITCHEN<br>WATER HEATER     | PANTRY<br>KITCHEN                   | 2' - 8"<br>2' - 6"            |  | 0' - 1 3/4"<br>0' - 1 3/4"            | WD<br>WD       | WD<br>WD   | AA<br>AA       |             |   |
| 1604-11<br>1605             |                             | KITCHEN                             | 3' - 0"<br>6' - 0"            | 7' - 0"                                      | 0' - 1 3/4"<br>0' - 1 3/4"            | WD<br>HM       | WD<br>HM   | AA<br>D        | 1HR         | 1 HOUR RATED                            |
| 1605-1<br>1605-2            | BEDROOM                     | LIVING                              | 3' - 6"<br>3' - 6"            | 7' - 10"                                     | 0' - 0 15/32"<br>0' - 0 15/32"        | AL/GL<br>AL/GL | AL         | K              |             |   |
| 1605-4                      | LIVING<br>BEDROOM           | BEDROOM<br>HALL                     | 3' - 0"<br>2' - 8"            | 8' - 0"<br>8' - 0"                           | 0' - 1 3/4"<br>0' - 1 3/4"            | WD<br>WD       | WD<br>WD   | AA<br>L        |             |   |
| 1605-5<br>1605-6            | HALL<br>CLOSET              | CLOSET<br>HALL                      | 4' - 0"<br>4' - 0"            | 8' - 0"<br>8' - 0"                           | 0' - 1 1/2"<br>0' - 1 1/2"            | WD<br>WD       | WD<br>WD   | K              |             |   |
| 1605-7<br>1605-8            | BATH<br>HALL                | HALL<br>CLOSET                      | 2' - 8"<br>2' - 0"            | 8' - 0"<br>8' - 0"                           | 0' - 1 3/4"<br>0' - 1 3/4"            | WD<br>WD       | WD<br>WD   | L<br>CC        |             |   |
| 1605-9<br>1605-10           | UTILITY<br>HALL             | HALL<br>A/C                         | 4' - 0"<br>2' - 0"            | 8' - 0"<br>8' - 0"                           | 0' - 1 1/2"<br>0' - 1 3/4"            | WD<br>WD       | WD<br>WD   | K<br>CC        |             |   |
| 1605-11<br>1605-12          | DINING                      | HALL<br>ENTRY                       | 2' - 8"                       | 8' - 0"<br>8' - 0"                           | 0' - 1 3/4"<br>0' - 1 3/4"            | WD<br>WD       | WD<br>WD   | L<br>AA        | 1HR         | 1 HOUR RATED                            |
| 1606<br>1606-1              |                             | LIVING                              | 6' - 0"<br>3' - 6"            | 7' - 10"                                     | 0' - 1 3/4"<br>0' - 0 15/32"          | HM<br>AL/GL    | HM<br>AL   | D<br>K         |             |   |
| 1606-2<br>1606-3            | HALL                        | BEDROOM<br>BEDROOM                  | 3' - 6"<br>2' - 8"            | 8' - 0"                                      | 0' - 0 15/32"<br>0' - 1 3/4"          | AL/GL<br>WD    | WD         | L              |             |   |
| 1606-4<br>1606-5            | HALL<br>HALL                | LAUNDRY<br>KITCHEN                  | 2' - 8"<br>3' - 0"            | 8' - 0"<br>8' - 0"                           | 0' - 1 3/4"<br>0' - 1 3/4"            | WD<br>WD       | WD<br>WD   | AA<br>CC       |             |   |
|                             | CLOSET<br>A/C               | HALL<br>HALL                        | 5' - 0"<br>2' - 0"            | 8' - 0"<br>8' - 0"                           | 0' - 1 1/2"<br>0' - 1 3/4"            | WD<br>WD       | WD<br>WD   | L<br>CC        |             |   |
| 1606-8<br>1606-9            | BATH<br>WATER HEATER        | HALL<br>ENTRY                       | 2' - 8"<br>2' - 0"            | 8' - 0"<br>8' - 0"                           | 0' - 1 3/4"<br>0' - 1 3/4"            | WD<br>WD       | WD<br>WD   | L<br>CC        |             |   |
| 1606-10<br>1607             |                             | ENTRY                               | 3' - 0"<br>6' - 0"            | 8' - 0"<br>7' - 0"                           | 0' - 1 3/4"<br>0' - 1 3/4"            | WD<br>HM       | WD<br>HM   | AA<br>D        | 1HR         | 1 HOUR RATED                            |
|                             | LIVING                      | BEDROOM                             | 3' - 6"<br>3' - 6"            | 7' - 10"                                     | 0' - 0 15/32"<br>0' - 0 15/32"        | AL/GL<br>AL/GL | AL         | K<br>K         |             | EXTERIOR STOREFRONT                     |
| 1607-3<br>1607-4            | BEDROOM<br>HALL             | HALL<br>A/C                         | 2' - 8"<br>2' - 0"            | 8' - 0"<br>8' - 0"                           | 0' - 1 3/4"<br>0' - 1 3/4"            | WD<br>WD       | WD<br>WD   | L<br>CC        | _           |   |
| 1607-5<br>1607-6            | CLOSET<br>LAUNDRY           | HALL<br>HALL                        | 5' - 0"<br>2' - 8"            | 8' - 0"<br>8' - 0"                           | 0' - 1 1/2"<br>0' - 1 3/4"            | WD<br>WD       | WD<br>WD   | L<br>AA        |             |   |
| 1607-7<br>1607-8            | BATH<br>HALL                | HALL<br>WATER HEATER                | 2' - 8"<br>2' - 0"            |  | 0' - 1 3/4"<br>0' - 1 3/4"            | WD<br>WD       | WD<br>WD   | L<br>CC        |             |   |
| 1607-10                     | KITCHEN<br>PANTRY           | HALL<br>KITCHEN                     | 3' - 0"<br>2' - 8"            | 8' - 0"                                      | 0' - 1 3/4"<br>0' - 1 3/4"            | WD<br>WD       | WD<br>WD   | CC<br>AA       |             |   |
| 1607-11<br>1608             |                             | KITCHEN                             | 3' - 0"<br>6' - 0"            | 7' - 0"                                      | 0' - 1 3/4"<br>0' - 1 3/4"            | WD<br>HM       | WD<br>HM   | AA<br>D        | 1HR         | 1 HOUR RATED                            |
| 1608-2                      | LIVING<br>BEDROOM           |                                     | 3' - 6"<br>3' - 0"            | 8' - 2"                                      | 0' - 0 15/32"<br>0' - 1 1/2"          | AL/GL<br>AL/GL | AL         | K<br>K         |             |   |
|                             | HALL<br>HALL                | BEDROOM<br>LAUNDRY                  | 2' - 8"<br>2' - 8"            | 8' - 0"<br>8' - 0"                           | 0' - 1 3/4"<br>0' - 1 3/4"            | WD<br>WD       | WD<br>WD   | L<br>AA        |             |   |
| 1608-5<br>1608-6            | HALL                        | CLOSET<br>KITCHEN                   | 4' - 0"<br>3' - 0"            |  | 0' - 1 1/2"<br>0' - 1 3/4"            | WD<br>WD       | WD<br>WD   | CC             |             |   |
| 1608-7                      | HALL<br>HALL                | A/C<br>BATHROOM                     | 2' - 6"                       | 8' - 0"<br>8' - 0"                           | 0' - 1 3/4"                           | WD<br>WD       | WD<br>WD   | CC<br>L        |             |   |
|                             | WATER HEATER                | HALL<br>ENTRY                       | 2' - 6"                       | 8' - 0"<br>8' - 0"                           | 0' - 1 3/4"                           | WD<br>WD       | WD<br>WD   | CC             | 1HR         |   |
| 1609-1                      | KITCHEN<br>MASTER BEDROOM   |                                     | 3' - 0"<br>3' - 0"            | 8' - 2"<br>8' - 2"                           | 0' - 1 1/2"                           | AL/GL<br>AL/GL | AL         | K<br>K         |             |   |
| 1609-4                      |                             | HALL<br>MASTER BEDROOM              | 3' - 0"                       | 8' - 0"<br>8' - 0"                           | 0' - 1 3/4"                           | WD<br>WD       | WD<br>WD   | L              |             |   |
| 1609-7                      | CLOSET                      | KITCHEN KITCHEN                     | 2' - 0"                       |  | 0' - 1 3/4"                           | WD<br>WD       | WD<br>WD   | CC             |             | DOUBLE DOOR / PAIR DOUBLE DOOR / PAIR   |
|                             | A/C                         | KITCHEN                             | 2' - 0"                       | 8' - 0"<br>8' - 0"                           | 0' - 1 3/4" 0' - 1 3/4"               | WD<br>WD       | WD<br>WD   | AA<br>AA       |             | 2.2.2.30.17.17.11                       |
| 220 10                      | 1                           | 1                                   |                               | <u>,                                    </u> | . 5, 1                                |                |            |                | 1           |   |

|   |   |   |  |  |  | ERIAL                         | JE NE                      |                           | G           |  |
|---|---|---|--|--|--|-------------------------------|----------------------------|---------------------------|-------------|--|
| MARK  | FROM  | 0   | WIDTH  | НЕІСНТ                                   | THICKNESS  | DOOR MATERIAL                 | DOOR FRAME                 | DOOR TYPE                 | FIRE RATING | REMARKS  |
| 1609-11<br>1609-12<br>1609-13<br>1609-14        | BATH<br>CLOSET                                  | BEDROOM<br>ENTRY<br>BEDROOM                 | 2' - 8"<br>3' - 0"<br>3' - 0"<br>3' - 0"                       | 8' - 0"<br>8' - 0"                       | 0' - 1 3/4"<br>0' - 1 3/4"<br>0' - 1 3/4"<br>0' - 1 3/4"                               | WD<br>WD<br>WD                | WD<br>WD<br>HM<br>WD       | L<br>CC<br>AA<br>AA       | 1HR         | DOUBLE DOOR / PAIR   |
| 1610-1<br>1610-2<br>1610-3<br>1610-4            | DINING<br>HALL<br>HALL                          | ENTRY<br>CLOSET<br>A/C<br>BATH              | 3' - 0"<br>2' - 0"<br>2' - 0"<br>2' - 8"                       | 8' - 0"<br>8' - 0"                       | 0' - 1 3/4"<br>0' - 1 3/4"<br>0' - 1 3/4"<br>0' - 1 3/4"                               | WD<br>WD<br>WD                | WD<br>WD<br>WD             | AA<br>CC<br>CC<br>AA      | 1HR         | DOUBLE DOOR / PAIR<br>DOUBLE DOOR / PAIR                   |
| 1610-5<br>1610-6<br>1610-7                      | LAUNDRY<br>CLOSET<br>BEDROOM                    | BATH<br>HALL<br>HALL                        | 2' - 8"<br>4' - 0"<br>3' - 0"                                  | 8' - 0"<br>8' - 0"<br>8' - 0"            | 0' - 1 3/4"<br>0' - 1 3/4"<br>0' - 1 3/4"  | WD<br>WD<br>WD                | WD<br>WD<br>WD             | L<br>CC<br>AA             |             | DOUBLE DOOR / PAIR   |
| 1610-8<br>1610-9<br>1610-10<br>1610-11          | HALL  | BEDROOM<br>LIVING<br>HALL<br>MASTER BEDROOM |  | 8' - 2"<br>8' - 0"<br>7' - 0"            | 0' - 1 1/2"<br>0' - 1 1/2"<br>0' - 1 3/4"  | WD                            | WD<br>AL<br>WD             | L<br>K<br>L               |             | FRAMED OPENING   |
| 1610-13<br>1610-14                              | CLOSET MASTER BATH MASTER BATH                  | HALL<br>HALL                                | 3' - 6"<br>2' - 8"<br>2' - 8"                                  | 8' - 0"<br>8' - 0"                       | 0' - 1 3/4"<br>0' - 1 3/4"<br>0' - 1 3/4"  | WD<br>WD<br>WD                | WD<br>WD<br>WD             | CC<br>L<br>L              |             | DOUBLE DOOR / PAIR   |
| 1611-3<br>1611-4                                | ENTRY<br>ENTRY<br>CLOSET                        | ENTRY LAUNDRY POWDER ENTRY                  | 3' - 0"<br>3' - 0"<br>3' - 0"                                  | 8' - 0"<br>8' - 0"                       | 0' - 1 3/4"<br>0' - 1 3/4"<br>0' - 1 3/4"<br>0' - 1 3/4"                               | WD<br>WD<br>WD                | WD<br>WD<br>WD             | AA<br>AA<br>AA            | 1HR         |  |
| 1611-7  | CLOSET OFFICE CLOS. OFFICE                      | HALL OFFICE A/C MASTER BEDROOM              | 2' - 0"<br>2' - 8"<br>2' - 0"<br>3' - 0"                       | 8' - 0"<br>8' - 0"<br>8' - 0"            | 0' - 1 3/4"<br>0' - 1 3/4"<br>0' - 1 3/4"<br>0' - 1 3/4"<br>0' - 1 3/4"                | WD<br>WD<br>WD<br>WD          | WD<br>WD<br>WD<br>WD       | CC<br>L<br>CC<br>CC       |             | DOUBLE DOOR / PAIR  DOUBLE DOOR / PAIR  DOUBLE DOOR / PAIR |
| 1611-12<br>1611-13<br>1611-14<br>1611-17        | HALL<br>HALL<br>HALL                            | MASTER BEDROOM TOILET MASTER CLOSET HALL    |  | 8' - 0"<br>8' - 0"<br>8' - 0"            | 0' - 1 3/4"<br>0' - 1 3/4"<br>0' - 1 3/4"  | WD<br>WD                      | WD<br>WD                   | L<br>L<br>CC              |             | FRAMED OPENING DOUBLE DOOR / PAIR                          |
| 1611-18<br>1611-19<br>1611-20<br>1611-21        | BATH  | BEDROOM HALL TOILET ROOM TOILET ROOM        | 3' - 0"<br>2' - 8"<br>2' - 8"<br>2' - 0"                       | 8' - 0"<br>8' - 0"<br>8' - 0"            | 0' - 1 3/4"<br>0' - 1 3/4"<br>0' - 1 3/4"<br>0' - 1 3/4"                               | WD<br>WD<br>WD                | WD<br>WD<br>WD             | AA<br>L<br>L<br>CC        |             |  |
| 1612-2<br>1612-3<br>1612-4                      | KITCHEN KITCHEN BATH KITCHEN A/C                | UTILITY CLOSET BATH LIVING                  | 3' - 0"<br>4' - 0"<br>2' - 8"<br>2' - 8"                       | 8' - 0"<br>8' - 0"<br>8' - 0"            | 0' - 1 3/4"<br>0' - 1 3/4"<br>0' - 1 3/4"<br>0' - 1 3/4"<br>0' - 1 3/4"                | WD<br>WD<br>WD<br>WD          | WD<br>WD<br>WD<br>WD       | AA<br>CC<br>L<br>AA<br>CC | 1HR         | 1 HOUR RATED DOUBLE DOOR / PAIR                            |
| 1612-6<br>1612-7<br>1613-1<br>1613-2            | BATH LIVING LAUNDRY CLOSET                      | BEDROOM BEDROOM KITCHEN KITCHEN BATH        | 2' - 8"<br>3' - 0"<br>3' - 0"<br>4' - 0"<br>2' - 8"            | 8' - 0"<br>8' - 0"<br>8' - 0"<br>8' - 0" | 0' - 1 3/4"<br>0' - 1 3/4"<br>0' - 1 3/4"<br>0' - 1 3/4"<br>0' - 1 3/4"                | WD<br>WD<br>WD<br>WD          | WD<br>WD<br>WD<br>WD       | AA<br>AA<br>CC<br>L       | 1HR         | 1 HOUR RATED<br>DOUBLE DOOR / PAIR                         |
| 1613-5<br>1613-6<br>1613-7                      | KITCHEN A/C BATH BEDROOM LIVING                 | BATH<br>KITCHEN<br>BEDROOM<br>LIVING        | 2' - 8"<br>2' - 0"<br>2' - 8"<br>3' - 0"<br>3' - 0"            | 8' - 0"<br>8' - 0"<br>8' - 0"            | 0' - 1 3/4"<br>0' - 1 3/4"<br>0' - 1 3/4"<br>0' - 1 3/4"<br>0' - 1 1/2"                | WD<br>WD<br>WD<br>WD<br>AL/GL | WD<br>WD<br>WD<br>WD       | AA<br>CC<br>L<br>AA<br>K  |             |  |
| 1614-1<br>1614-2                                | CLOSET<br>LAUNDRY                               | KITCHEN<br>KITCHEN<br>HALL                  | 3' - 0"<br>2' - 6"<br>2' - 8"                                  | 8' - 0"<br>8' - 0"                       | 0' - 1 3/4"<br>0' - 1 3/4"<br>0' - 1 3/4"  | WD<br>WD<br>WD                | HM<br>WD<br>WD             | C<br>CC<br>AA             | 1HR         |  |
|   | HALL HALL A/C                                   | POWDER WATER HEATER BEDROOM BEDROOM         | 2' - 8"<br>2' - 0"<br>3' - 0"<br>2' - 0"                       | 8' - 0"<br>8' - 0"<br>8' - 0"            | 0' - 1 3/4"<br>0' - 1 3/4"<br>0' - 1 3/4"<br>0' - 1 3/4"                               | WD<br>WD<br>WD                | WD<br>WD<br>HM<br>WD       | AA<br>CC<br>AA<br>CC      |             |  |
| 1614-9<br>1614-10<br>1615-1<br>1615-2           | BEDROOM<br>CLOSET<br>ENTRY                      | BATH BATH LIVING ENTRY                      | 2' - 8"<br>2' - 8"<br>3' - 0"<br>3' - 0"<br>4' - 0"            | 8' - 0"<br>8' - 2"<br>8' - 0"<br>8' - 0" | 0' - 1 3/4"<br>0' - 1 3/4"<br>0' - 1 1/2"<br>0' - 1 3/4"<br>0' - 1 3/4"                | WD<br>WD<br>AL/GL<br>WD<br>WD | WD<br>WD<br>AL<br>WD<br>WD | L<br>K<br>AA<br>CC        | 1HR         | DOUBLE DOOR / PAIR   |
| 1615-4  | BATH LIVIING BEDROOM LAUNDRY                    | ENTRY BEDROOM BEDROOM BEDROOM LIVIING ENTRY | 2' - 0"<br>2' - 8"<br>2' - 8"<br>5' - 0"<br>4' - 0"<br>2' - 8" | 8' - 0"<br>8' - 0"                       | 0' - 1 3/4"<br>0' - 1 3/4"<br>0' - 1 3/4"<br>0' - 1 1/2"<br>0' - 1 1/2"<br>0' - 1 3/4" | WD<br>WD<br>WD<br>WD<br>AL/GL | WD<br>WD<br>WD<br>AL<br>WD | L<br>L<br>K<br>AA         |             |  |
| 1616-4<br>1616-5<br>1616-9<br>1616-10           |   | CLOSET MASTER BEDROOM CLOSET                | 2' - 8"<br>2' - 8"<br>2' - 8"<br>2' - 8"                       | 8' - 0"<br>8' - 0"<br>8' - 0"            | 0' - 1 3/4"<br>0' - 1 3/4"<br>0' - 1 3/4"<br>0' - 1 3/4"                               | WD<br>WD<br>WD                | WD<br>WD<br>WD             | AA<br>CC<br>CC            |             |  |
| 1616-16<br>1617-1                               | CLOSET<br>BEDROOM 2<br>ENTRY                    | ENTRY                                       | 2' - 8"<br>3' - 0"<br>3' - 0"                                  | 8' - 0"<br>8' - 0"<br>8' - 0"            | 0' - 1 3/4"<br>0' - 1 3/4"<br>0' - 1 3/4"<br>0' - 1 3/4"                               | WD<br>WD<br>WD                | WD<br>WD<br>WD<br>WD       | AA<br>CC<br>AA<br>AA      | 1HR         |  |
| 1617-3<br>1617-4<br>1617-5<br>1617-6            | KITCHEN LAUNDRY KITCHEN BEDROOM BEDROOM         | PANTRY KITCHEN BATH BATH KITCHEN            | 2' - 8"<br>4' - 0"<br>2' - 8"<br>2' - 8"<br>2' - 8"            | 8' - 0"<br>8' - 0"<br>8' - 0"<br>8' - 0" | 0' - 1 3/4"<br>0' - 1 3/4"<br>0' - 1 3/4"<br>0' - 1 3/4"<br>0' - 1 3/4"                | WD<br>WD<br>WD<br>WD          | WD<br>WD<br>WD<br>WD       | CC<br>L<br>L              |             | DOUBLE DOOR / PAIR   |
| 1617-9<br>1617-10                               | CLOSET A/C LIVING MASTER BEDROOM MASTER BEDROOM |   | 5' - 0"<br>2' - 0"<br>2' - 8"<br>2' - 8"<br>2' - 8"            | 8' - 0"<br>8' - 0"<br>8' - 0"            | 0' - 1 1/2"<br>0' - 1 3/4"<br>0' - 1 3/4"<br>0' - 1 3/4"<br>0' - 1 3/4"                | WD<br>WD<br>WD<br>WD          | WD<br>WD<br>WD<br>WD       | CC<br>L<br>AA<br>L        |             |  |
| 1617-12<br>1618-1<br>1618-2<br>1618-3<br>1618-4 | BATH CLOSET ENTRY                               | ENTRY ENTRY BEDROOM BEDROOM                 | 3' - 7 15/32"<br>3' - 0"<br>2' - 8"<br>5' - 0"<br>3' - 0"      | 8' - 0"<br>8' - 0"                       | 0' - 1 1/2"<br>0' - 1 3/4"<br>0' - 1 3/4"<br>0' - 1 1/2"<br>0' - 1 3/4"                | AL/GL<br>WD<br>WD<br>WD       | AL<br>WD<br>WD<br>WD       | K<br>AA<br>L<br>L         | 1HR         | 1 HOUR RATED   |
| 1618-5<br>1618-6<br>1618-7                      | TOILET<br>CLOSET<br>HALL                        | MASTER BATH<br>MASTER BATH<br>MASTER BATH   | 2' - 8"<br>2' - 0"<br>2' - 8"                                  | 8' - 0"<br>8' - 0"<br>8' - 0"            | 0' - 1 3/4"<br>0' - 1 3/4"<br>0' - 1 3/4"  | WD<br>WD<br>WD                | WD<br>WD<br>WD             | AA<br>CC<br>L             |             |  |
| 1618-9<br>1618-10<br>1618-11                    |   | HALL CLOSET MASTER BEDROOM A/C              | 4' - 0"<br>4' - 0"<br>4' - 0"<br>2' - 8"<br>2' - 0"            | 8' - 0"<br>8' - 0"<br>8' - 0"            | 0' - 1 3/4"<br>0' - 1 1/2"<br>0' - 1 1/2"<br>0' - 1 3/4"<br>0' - 1 3/4"                | WD<br>WD<br>WD<br>WD          | WD<br>WD<br>WD<br>WD       | L<br>L<br>CC              |             | DOUBLE DOOR / PAIR   |
| 1619-1<br>1619-2<br>1619-3                      | MASTER BEDROOM  BATH CLOSET ENTRY               | LIVIING ENTRY ENTRY BEDROOM BEDROOM         | 3' - 0"<br>3' - 0"<br>2' - 8"<br>5' - 0"<br>3' - 0"            | 8' - 0"<br>8' - 0"<br>8' - 0"            | 0' - 1 3/4"<br>0' - 1 3/4"<br>0' - 1 3/4"<br>0' - 1 1/2"<br>0' - 1 3/4"                | WD<br>WD<br>WD<br>WD          | WD<br>WD<br>WD<br>WD       | AA<br>AA<br>L<br>L        | 1HR         | 1 HOUR RATED   |
| 1619-5<br>1619-6<br>1619-7<br>1619-8            | TOILET CLOSET HALL UTILITY                      | MASTER BATH MASTER BATH MASTER BATH KITCHEN | 2' - 8"<br>2' - 0"<br>2' - 8"<br>4' - 0"                       | 8' - 0"<br>8' - 0"<br>8' - 0"<br>8' - 0" | 0' - 1 3/4"<br>0' - 1 3/4"<br>0' - 1 3/4"<br>0' - 1 3/4"                               | WD<br>WD<br>WD<br>WD          | WD<br>WD<br>WD             | AA<br>CC<br>L<br>CC       |             | DOUBLE DOOR / PAIR   |
| 1619-9<br>1619-10<br>1619-11                    | CLOSET<br>HALL                                  | HALL<br>CLOSET<br>MASTER BEDROOM            | 4' - 0"<br>4' - 0"<br>2' - 8"<br>2' - 0"                       | 8' - 0"<br>8' - 0"<br>8' - 0"            | 0' - 1 1/2"<br>0' - 1 1/2"<br>0' - 1 3/4"<br>0' - 1 3/4"                               | WD<br>WD<br>WD                | WD<br>WD<br>WD             | L<br>M<br>L<br>CC         |             |  |

| SS TERIAL NG                                    |      |   | DOOR SCH | EDULE | - 16TH FLOO | R    |        |     |         |         |
|---|------|---|----------|-------|-------------|------|--------|-----|---------|---------|
| MARK TO TO THICKNES DOOR FR/ DOOR TYF FIRE RATI | FROM | 9 | WIDTH    |       | THICKNESS   | ATEI | R FRAM | TYP | E RATIN | REMARKS |

HABA BA SN SN ARCHITECTS

ARCHITECTS II

P L L C

189 Maple Ridge Drive Metairie, LA 70001
(504)-885-4477
central@hbsaii.com :-: hbsaii.com

SINCE 1961

DROCKHOTE

1031 CANAL STREET

NEW ORLEANS, LOUISIANA

THESE PLANS AND SPECIFICATIONS HAVE
BEEN PREPARED BY ME OR UNDER MY
CLOSE PERSONAL SUPERVISION AND TO
THE BEST OF MY KNOWLEDGE AND
BELIEF THEY COMPLY WITH ALL CITY,
STATE AND FEDERAL REQUIREMENTS, AND
I AM NOT PROVIDING CONTRACT
ADMINISTRATION.
CERTIFIED CORRECT



THIS DRAWING IS CONFIDENTIAL AND NOT BE LOANED, REPRODUCED, COPIED, EITHER WHOLLY OR IN PART, OR MADE PUBLIC IN ANY MANNER WITHOUT THE WRITTEN CONSENT OF HBSA II ARCHITECTS, A PROFESSIONAL L.L.C. ALL RIGHTS OF DESIGN OR INVENTION ARE RESERVED AND WILL REMAIN THE SOLE PROPERTY OF HBSA II ARCHITECTS A PROFESSIONAL L.L.C.

|                              | R                            | EVIS                         | SION                         | HIS                          | TOR                          | Υ                            |   |
|------------------------------|------------------------------|------------------------------|------------------------------|------------------------------|------------------------------|------------------------------|---|
| 4/27/2018                    | 5/4/2018                     | 5/11/2018                    | 5/18/2018                    | 5/25/2018                    | 6/1/2018                     | 6/8/2018                     |   |
|                              |                              |                              |                              |                              |                              |                              |   |
|                              |                              |                              |                              |                              |                              |                              |   |
| ION 1                        | SION 2                       | SION 3                       | NOIN 4                       | 10N 5                        | 9 NOI                        | NOI 7                        |   |
| L.I.S. #2 - CLOUD REVISION 1 | L.I.S. #2 - CLOUD REVISION 2 | L.I.S. #2 - CLOUD REVISION 3 | L.I.S. #2 - CLOUD REVISION 4 | L.I.S. #2 - CLOUD REVISION 5 | L.I.S. #2 - CLOUD REVISION 6 | L.I.S. #2 - CLOUD REVISION 7 |   |
| . #2 - CLC                   | : #2 - CLC                   | . #2 - CLC                   | . #2 - CLC                   | : #2 - CLC                   | : #2 - CLC                   | . #2 - CLC                   |   |
| L.I.S                        |   |
| -                            | 2                            | က                            | 4                            | 2                            | 9                            |                              | 8 |

SCHEDULES


PROJECT#: 1709
PHASE: DD
TEAM: Author
CHECKER: Checker
SCALE: AS NOTED

| MARK               | FROM                          |                               | WIDTH              | НЕІСНТ              |                  | THICKNESS            | DOOR MATERIAL  | DOOR FRAME | DOOR TYPE | RE RATING | REMARKS              |
|--------------------|-------------------------------|-------------------------------|--------------------|---------------------|------------------|----------------------|----------------|------------|-----------|-----------|----------------------|
|                    | Щ.                            | 0                             |                    |                     |                  | -                    | _              |            | 0         | FIR       | Щ.                   |
| 700-1<br>700-2     | MASTER BEDROOM                | LIVING<br>LIVING              | 3' - 0"<br>4' - 0" | 8' - 0"<br>8' - 0"  |                  | 3/4"                 | WD<br>WD       | WD<br>WD   | AA<br>CC  | 1HR       | 1 HOUR RATED         |
| 700-3<br>700-4     | MASTER BEDROOM                | LIVING<br>MASTER BATH         | 3' - 0"<br>2' - 8" | 8' - 0"<br>8' - 0"  |                  | 3/4"                 | WD<br>WD       | WD<br>WD   | AA<br>M   |           |                      |
| 1700-5             | MASTER CLOSET                 | MASTER BATH                   | 2' - 8"            | 8' - 0"             | 0' - 1           | 3/4"                 | WD             | WD         | M         |           |                      |
| 1700-6<br>1700-7   | LAUNDRY<br>KITCHEN            | KITCHEN<br>BEDROOM            | 5' - 0"<br>3' - 0" | 8' - 0"<br>8' - 0"  |                  | 1/2"<br>3/4"         | WD<br>WD       | WD<br>WD   | L<br>AA   |           |                      |
| 1700-8             | BEDROOM                       | BATH                          | 2' - 8"            | 8' - 0"             | 0' - 1           | 3/4"                 | WD             | WD         | AA        |           |                      |
| 1700-9<br>1700-10  | BEDROOM<br>CLOS.              | CLOS.<br>BEDROOM              | 3' - 0"<br>3' - 0" | 8' - 0"<br>8' - 0"  |                  | 3/4"                 | WD<br>WD       | WD<br>WD   | CC        |           |                      |
| 1701-1             |                               | KITCHEN                       | 3' - 0"            | 8' - 0"             | 0' - 1           | 3/4"                 | WD             | WD         | AA        | 1HR       | 1 HOUR RATED         |
| 1701-2<br>1701-3   | A/C<br>PANTRY                 | KITCHEN<br>KITCHEN            | 2' - 8"<br>2' - 8" | 8' - 0"<br>8' - 0"  |                  | 3/4"                 | WD<br>WD       | WD<br>WD   | AA<br>AA  |           |                      |
| 1701-4             | ВАТН                          |                               | 2' - 8"            | 8' - 0"             | 0' - 1           | 3/4"                 | WD             | WD         | AA        |           |                      |
| 1701-5<br>1701-6   | CLOS.                         | BEDROOM<br>BEDROOM            | 3' - 0"<br>4' - 0" | 8' - 0"<br>8' - 0"  |                  | 3/4"                 | WD<br>WD       | WD<br>WD   | AA<br>CC  |           | DOUBLE DOOR / PAIR   |
| 1701-7             | LAUNDRY                       | 1.11/11/0                     | 5' - 0"            | 8' - 0"             |                  | 1/2"                 | WD             | WD         | М         |           |                      |
| 1701-8<br>1701-9   | MASTER BEDROOM MASTER BEDROOM | CLOS.                         | 3' - 0"<br>2' - 8" | 8' - 0"<br>8' - 0"  |                  | 3/4"                 | WD<br>WD       | WD<br>WD   | AA<br>M   |           |                      |
| 1701-10<br>1701-11 | MASTER BATH                   | MASTER BEDROOM                | 3' - 0"<br>2' - 8" | 8' - 0"<br>8' - 0"  |                  | 3/4"                 | WD             | WD         | M         |           |                      |
|                    |                               | MASTER BATH<br>BALCONY        | 3' - 0"            | 8' - 2"             |                  | 1/2"                 | WD<br>AL/GL    | WD<br>AL   | M<br>K    |           |                      |
| 1701-13<br>1702-1  | LIVING                        | BALCONY<br>ENTRY              | 3' - 0"<br>3' - 0" | 8' - 2"<br>8' - 0"  | 0' - 1           |                      | AL/GL<br>WD    | AL<br>WD   | K<br>AA   | 1HR       |                      |
| 1702-1             | ENTRY                         | CLOS.                         | 2' - 8"            | 8' - 0"             |                  | 3/4"                 | WD             | WD         | AA        | IIII      |                      |
| 1702-3<br>1702-4   | ENTRY<br>A/C                  | POWDER<br>ENTRY               | 2' - 8"<br>2' - 6" | 8' - 0"<br>8' - 0"  |                  | 3/4"<br>3/4"         | WD<br>WD       | WD<br>WD   | M<br>AA   |           |                      |
| 1702-5             | LAUNDRY                       | KITCHEN                       | 3' - 0"            | 8' - 0"             | 0' - 1           | 3/4"                 | WD             | WD         | СС        |           |                      |
| 1702-6<br>1702-7   | KITCHEN<br>LIVING/ DINING     | PANTRY<br>BEDROOM             | 2' - 8"<br>3' - 0" | 8' - 0"<br>8' - 0"  |                  | 3/4"                 | WD<br>WD       | WD<br>WD   | AA<br>AA  |           |                      |
| 1702-8             | CLOSET                        | BATH                          | 2' - 8"            | 8' - 0"             | 0' - 1           | 3/4"                 | WD             | WD         | AA        |           |                      |
| 1702-9<br>1702-10  | CLOSET<br>LIVING/ DINING      | CLOSET<br>BALCONY             | 2' - 6"<br>3' - 0" | 8' - 0"<br>8' - 2"  |                  | 3/4"<br>1/2"         | WD<br>AL/GL    | WD<br>AL   | M<br>K    |           |                      |
| 1703-1             |                               | KITCHEN                       | 3' - 0"            | 8' - 0"             | 0' - 1           | 3/4"                 | WD             | WD         | AA        | 1HR       | 1 HOUR RATED         |
| 1703-2<br>1703-3   | KITCHEN<br>KITCHEN            | PANTRY<br>HALL                | 2' - 8"<br>3' - 0" | 8' - 0"<br>8' - 0"  |                  | 3/4"<br>3/4"         | WD<br>WD       | WD<br>WD   | AA<br>CC  |           |                      |
| 1703-4             | HALL                          | WATER HEATER                  | 2' - 0"            | 8' - 0"             | 0' - 1           | 3/4"                 | WD             | WD         | AA        |           |                      |
| 1703-5<br>1703-6   | HALL<br>LAUNDRY               | BATH<br>HALL                  | 2' - 8"<br>3' - 0" | 8' - 0"<br>8' - 0"  |                  | 3/4"                 | WD<br>WD       | WD<br>WD   | M<br>AA   |           |                      |
| 1703-7             | HALL                          | CLOSET                        | 5' - 0"            | 8' - 0"             | 0' - 1           | 1/2"                 | WD             | WD         | L         |           |                      |
| 1703-8<br>1703-9   | HALL                          | A/C<br>BEDROOM                | 2' - 0"<br>3' - 6" | 8' - 0"<br>8' - 0"  |                  | 3/4"                 | WD<br>WD       | WD<br>WD   | AA<br>CC  |           |                      |
| 1703-10            | BALCONY                       | LIVING                        | 3' - 6"            | 7' - 10"            | 0' - 0           | 15/32"               | AL/GL          | AL         | K         |           |                      |
| 1704-1<br>1704-2   | WATER HEATER                  | KITCHEN<br>KITCHEN            | 3' - 0"<br>2' - 6" | 8' - 0"<br>8' - 0"  | 0' - 1           | 3/4"                 | WD<br>WD       | WD<br>WD   | AA<br>AA  | 1HR       | 1 HOUR RATED         |
| 1704-3             | KITCHEN                       | PANTRY                        | 2' - 8"            | 8' - 0"             | 0' - 1           | 3/4"                 | WD             | WD         | AA        |           |                      |
| 1704-4<br>1704-5   | HALL<br>A/C                   | KITCHEN<br>HALL               | 3' - 0"<br>2' - 0" | 8' - 0"<br>8' - 0"  |                  | 3/4"                 | WD<br>WD       | WD<br>WD   | CC<br>AA  |           |                      |
| 1704-6             | HALL                          | BATH                          | 2' - 8"            | 8' - 0"             | 0' - 1           | 3/4"                 | WD             | WD         | М         |           |                      |
| 1704-7<br>1704-8   | CLOSET<br>HALL                | HALL<br>LAUNDRY               | 5' - 0"<br>2' - 0" | 8' - 0"<br>8' - 0"  |                  | 1/2"<br>3/4"         | WD<br>WD       | WD<br>WD   | L<br>AA   |           |                      |
| 1704-9             | HALL                          | BEDROOM                       | 3' - 0"            | 8' - 0"             | 0' - 1           | 3/4"                 | WD             | WD         | М         |           |                      |
|                    | BALCONY<br>BALCONY            | BEDROOM<br>LIVING             | 3' - 6"<br>3' - 6" |                     |                  | ) 15/32"<br>) 15/32" | AL/GL<br>AL/GL | AL<br>AL   | K         |           |                      |
| 1705-1             |                               | ENTRY                         | 3' - 0"            | 8' - 0"             | 0' - 1           |                      | WD             | WD         | AA        | 1HR       |                      |
| 1705-2<br>1705-3   | DINING Room HALL              | HALL<br>A/C                   | 3' - 0"<br>2' - 0" | 8' - 0"<br>8' - 0"  | 0' - 1           | 3/4"                 | WD<br>WD       | WD<br>WD   | M<br>AA   |           |                      |
| 1705-4             | LAUNDRY                       | HALL                          | 4' - 0"            | 8' - 0"             | 0' - 1           |                      | WD             | WD         | L         |           |                      |
| 1705-5<br>1705-6   | HALL<br>BATH                  | CLOSET<br>HALL                | 2' - 0"<br>2' - 8" | 8' - 0"<br>8' - 0"  | 0' - 1           | 3/4"                 | WD<br>WD       | WD<br>WD   | AA<br>M   |           |                      |
| 1705-7             | CLOS.                         | HALL                          | 4' - 0"            | 8' - 0"             | 0' - 1           | 1/2"                 | WD             | WD         | L         |           |                      |
| 1705-8<br>1705-9   | HALL<br>BEDROOM               | CLOS.<br>HALL                 | 4' - 0"<br>3' - 0" | 8' - 0"<br>8' - 0"  | 0' - 1           | 1/2"<br>3/4"         | WD<br>WD       | WD<br>WD   | M         |           |                      |
| 1705-10            | BALCONY                       | LIVING                        | 3' - 6"            |                     | 0' - 0           | 15/32"               | AL/GL          | AL         | K         |           |                      |
| 1706-1<br>1706-2   | WATER HEATER                  | ENTRY<br>ENTRY                | 3' - 0"<br>2' - 0" | 8' - 0"<br>8' - 0"  | 0' - 1           | 3/4"                 | WD<br>WD       | WD<br>WD   | AA<br>AA  | 1HR       |                      |
| 1706-3             | HALL                          | KITCHEN                       | 3' - 0"            | 8' - 0"             | 0' - 1           | 3/4"                 | WD             | WD         | CC        |           |                      |
| 706-4              | STOR.<br>BATH                 | HALL<br>HALL                  | 2' - 0"<br>2' - 8" | 8' - 0"<br>8' - 0"  |                  | 3/4"                 | WD<br>WD       | WD<br>WD   | AA<br>M   |           |                      |
| 1706-6             | CLOSET                        | HALL                          | 5' - 0"            | 8' - 0"             | 0' - 1           | 1/2"                 | WD             | WD         | L         |           |                      |
| 1706-7<br>1706-8   | HALL                          | LAUNDRY<br>BEDROOM            | 2' - 8"<br>3' - 0" | 8' - 0"<br>8' - 0"  |                  | 3/4"                 | WD<br>WD       | WD<br>WD   | AA<br>M   |           |                      |
| 706-9              | BALCONY                       | BEDROOM                       | 3' - 6"            |                     | 0' - 0           | 15/32"               | AL/GL          | AL         | K         |           |                      |
| 1706-10<br>1707-1  | BALCONY                       | LIVING<br>KITCHEN             | 3' - 6"<br>3' - 0" | 7' - 10"<br>8' - 0" |                  | 3/4"                 | AL/GL<br>WD    | AL<br>WD   | K<br>AA   | 1HR       |                      |
| 1707-2             | PANTRY                        | KITCHEN                       | 2' - 8"            | 8' - 0"             | 0' - 1           | 3/4"                 | WD             | WD         | AA        |           |                      |
| 1707-3<br>1707-4   | DINING<br>HALL                | HALL<br>WATER HEATER          | 3' - 0"<br>2' - 0" | 8' - 0"<br>8' - 0"  |                  | 3/4"                 | WD<br>WD       | WD<br>WD   | CC<br>AA  |           |                      |
| 1707-5             | BATH                          | HALL                          | 2' - 8"            | 8' - 0"             | 0' - 1           | 3/4"                 | WD             | WD         | М         |           |                      |
| 707-6              | LAUNDRY<br>CLOSET             | HALL<br>HALL                  | 2' - 8"<br>5' - 0" | 8' - 0"<br>8' - 0"  |                  | 3/4"<br>1/2"         | WD<br>WD       | WD<br>WD   | AA<br>L   |           |                      |
| 707-8              | HALL                          | A/C                           | 2' - 0"            | 8' - 0"             | 0' - 1           | 3/4"                 | WD             | WD         | AA        |           |                      |
| 707-9              | BEDROOM<br>LIVING             | HALL                          | 3' - 0"<br>3' - 6" | 8' - 0"<br>7' - 10" |                  | 3/4"<br>) 15/32"     | WD<br>AL/GL    | WD<br>AL   | M<br>K    |           |                      |
| 1708-1             |                               | KITCHEN                       | 3' - 0"            | 8' - 0"             | 0' - 1           | 3/4"                 | WD             | WD         | AA        | 1HR       |                      |
| 708-2<br>708-3     | HALL<br>HALL                  | DINING<br>A/C                 | 3' - 0"<br>2' - 6" | 8' - 0"<br>8' - 0"  |                  | 3/4"                 | WD<br>WD       | WD<br>HM   | CC<br>AA  |           |                      |
| 1708-4<br>1708-5   | HALL<br>WATER HEATER          | BATH<br>HALL                  | 2' - 8"            | 8' - 0"<br>8' - 0"  |                  | 3/4"                 | WD<br>WD       | WD         | Μ         |           |                      |
| 708-5              | WATER HEATER<br>HALL          | CLOSET                        | 2' - 6"<br>4' - 0" | 8' - 0"             |                  | 3/4"<br>1/2"         | WD             | HM<br>WD   | AA<br>L   |           |                      |
| 1708-7<br>1708-8   | HALL<br>HALL                  | LAUNDRY<br>BEDROOM            | 2' - 8"<br>3' - 0" | 8' - 0"<br>8' - 0"  |                  | 3/4"                 | WD<br>WD       | WD<br>WD   | AA<br>M   |           |                      |
| 708-9              | BEDROOM                       |                               | 3' - 0"            | 8' - 2"             | 0' - 1           | 1/2"                 | AL/GL          | AL         | K         |           |                      |
| 709-1<br>709-2     | KITCHEN                       | KITCHEN                       | 3' - 0"<br>3' - 0" | 8' - 0"<br>8' - 0"  | 0' - 1<br>0' - 1 |                      | WD<br>WD       | WD<br>WD   | AA<br>AA  | 1HR       |                      |
| 709-3              | BATHROOM                      |                               | 2' - 8"            | 8' - 0"             | 0' - 1           | 3/4"                 | WD             | WD         | М         |           |                      |
| 709-4<br>709-5     | CLOSET<br>A/C                 | BEDROOM<br>KITCHEN            | 3' - 0"<br>2' - 0" | 8' - 0"<br>8' - 0"  | 0' - 1<br>0' - 1 | 3/4"                 | WD<br>WD       | WD<br>WD   | CC<br>AA  |           |                      |
| 709-6              | LAUNDRY                       | KITCHEN                       | 4' - 0"            | 8' - 0"             | 0' - 1           | 3/4"                 | WD             | WD         | СС        |           | DOUBLE DOOR / PAIR   |
| 709-7<br>709-9     | CLOSET<br>LVING               | KITCHEN<br>MASTER BEDROOM     | 2' - 0"<br>3' - 0" | 8' - 0"<br>8' - 0"  |                  | 3/4"                 | WD<br>WD       | WD<br>WD   | CC<br>M   |           | DOUBLE DOOR / PAIR   |
| 709-11             | MASTER BATH                   | MASTER BEDROOM MASTER BEDROOM | 2' - 8"            | 8' - 0"             | 0' - 1           | 3/4"                 | WD             | WD         | М         |           |                      |
| 709-12             | MASTER BEDROOM                |                               | 3' - 0"<br>3' - 0" | 8' - 2"<br>8' - 2"  |                  | 1/2"<br>1/2"         | AL/GL<br>AL/GL | AL<br>AL   | K<br>K    |           |                      |
| 710-1              |                               | DINING                        | 3' - 0"            | 8' - 0"             | 0' - 1           | 3/4"                 | WD             | WD         | AA        | 1HR       |                      |
| 710-2<br>710-3     | LIVING<br>WATER HEATER        | WATER HEATER MASTER BEDROOM   | 2' - 8"<br>4' - 0" | 8' - 0"<br>7' - 0"  | 0' - 1           | 3/4"                 | WD<br>N/A      | WD<br>WD   | M<br>N/A  |           | FRAMED OPENING       |
| 710-4              | CLOSET                        | WATER HEATER                  | 3' - 6"            | 8' - 0"             | 0' - 1           |                      | WD             | WD         | CC        |           | . TUSIVILD OF EINING |
| 710-5<br>710-6     | MASTER BATH MASTER BATH       | WATER HEATER<br>TOILET        | 3' - 0"<br>2' - 8" | 8' - 0"<br>8' - 0"  |                  | 3/4"<br>3/4"         | WD<br>WD       | WD<br>WD   | M<br>M    |           |                      |
| 710-7              | DINING                        | CLOSET                        | 2' - 0"            | 8' - 0"             | 0' - 1           | 3/4"                 | WD             | WD         | AA        |           |                      |
| 710-8              | HALL<br>CLOSET                | A/C                           | 2' - 0"            | 8' - 0"             | 0' - 1           | 3/4"                 | WD<br>WD       | WD<br>WD   | AA<br>CC  |           | DOUBLE DOOR / PAIR   |
| 710-9              |                               | HALL                          | 4' - 0"            | 8' - 0"             |                  | 2//!"                | · WILL         | 10//13     |           |           | L 17/7/10 / DAID     |

| MARK               | FROM                     | OL.                           | МІДТН                  | НЕІСНТ             |        | THICKNESS    | DOOR MATERIAL | DOOR FRAME | DOOR TYPE | FIRE RATING | REMARKS                          |
|--------------------|--------------------------|-------------------------------|------------------------|--------------------|--------|--------------|---------------|------------|-----------|-------------|----------------------------------|
|                    | BEDROOM                  | HALL                          | 3' - 0"                | 8' - 0"            | 0' - 1 | 3/4"         | WD            | WD         | AA        |             |                                  |
| 1710-13            | CLOSET                   | BEDROOM                       | 5' - 0"                | 8' - 0"            | 0' - 1 | 1/2"         | WD            | WD         | L         |             |                                  |
| 1710-14<br>1711-1  |                          | LIVING<br>ENTRY               | 2' - 10"<br>3' - 0"    | 8' - 2"<br>8' - 0" |        | 1/2"<br>3/4" | AL/GL<br>WD   | AL<br>WD   | K<br>AA   | 1HR         |                                  |
|                    | ENTRY                    | LAUNDRY                       | 3' - 0"                | 8' - 0"            |        | 3/4"         | WD            | WD         | AA        |             |                                  |
| 1711-3<br>1711-4   | ENTRY<br>BATHROOM        | POWDER<br>ENTRY               | 3' - 0"<br>3' - 0"     | 8' - 0"<br>8' - 0" |        | 3/4"         | WD<br>WD      | WD<br>WD   | AA<br>CC  |             |                                  |
| 1711-5             |                          | HALL                          | 3' - 6"                | 8' - 0"            |        | 3/4"         | WD            | WD         | CC        |             |                                  |
|                    | HALL<br>HALL             | BATHROOM<br>BEDROOM           | 2' - 8"<br>3' - 0"     | 8' - 0"<br>8' - 0" |        | 3/4"         | WD<br>WD      | WD<br>WD   | M<br>AA   |             |                                  |
|                    | BATHROOM                 | HALL                          | 3' - 0"                | 8' - 0"            |        | 3/4"         | WD            | WD         | М         |             |                                  |
|                    | BATHROOM<br>CLOSET       | TOILET<br>TOILET              | 2' - 8"                | 8' - 0"<br>8' - 0" |        | 3/4"         | WD<br>WD      | WD<br>WD   | M<br>AA   |             |                                  |
|                    | CLOSET                   | HALL                          | 2' - 0"                | 8' - 0"            |        | 3/4"         | WD            | WD         | CC        |             |                                  |
| 1711-12<br>1711-13 | OFFICE<br>CLSET          | HALL<br>OFFICE                | 3' - 0"<br>2' - 0"     | 8' - 0"<br>8' - 0" |        | 3/4"         | WD<br>WD      | WD<br>WD   | M<br>AA   |             |                                  |
|                    | OFFICE                   | A/C                           | 3' - 0"                | 8' - 0"            |        | 3/4"         | WD            | WD         | AA        |             |                                  |
| 1711-15<br>1711-16 |                          | MASTER BEDROOM MASTER BEDROOM |                        | 8' - 0"<br>8' - 0" |        | 3/4"         | WD<br>WD      | WD<br>WD   | CC<br>M   |             |                                  |
| 1711-17            |                          | TOILET                        | 2' - 8"                | 8' - 0"            | 0' - 1 | 3/4"         | WD            | WD         | M         |             | EDAMED ODENING                   |
| 1711-18<br>1711-19 | CLOSET                   | BEDROOM<br>HALL               | 3' - 0"<br>2' - 0"     | 8' - 0"<br>8' - 0" | 0' - 1 | 3/4"         | N/A<br>WD     | WD<br>WD   | N/A<br>CC |             | FRAMED OPENING DOUBLE DOOR / PAI |
| 1712-1             | KITCHEN                  |                               | 3' - 0"                | 8' - 0"            |        | 3/4"         | WD            | WD         | AA        | 1HR         | DOUBLE DOOD / DAV                |
|                    | KITCHEN<br>KITCHEN       | UTILITY<br>BATHROOM           | 4' - 0"<br>2' - 8"     | 8' - 0"<br>8' - 0" |        | 3/4"         | WD<br>WD      | WD<br>WD   | CC<br>AA  |             | DOUBLE DOOR / PAI                |
| 1712-4             | BATHROOM                 | CLOSET                        | 3' - 0"                | 8' - 0"            | 0' - 1 | 3/4"         | WD            | WD         | М         |             |                                  |
|                    | BATHROOM<br>DINING       | BEDROOM<br>BEDROOM            | 2' - 8"<br>3' - 0"     | 8' - 0"<br>8' - 0" |        | 3/4"         | WD<br>WD      | WD<br>WD   | M<br>AA   |             |                                  |
| 1712-7             | BEDROOM                  |                               | 3' - 0"                | 8' - 2"            | 0' - 1 | 1/2"         | AL/GL         | AL         | K         |             |                                  |
| 1712-8<br>1712-9   | DINING                   | A/C<br>BEDROOM                | 2' - 0"                | 8' - 0"<br>8' - 0" |        | 3/4"         | WD<br>WD      | WD<br>WD   | CC<br>AA  |             |                                  |
| 1713-1             |                          | KITCHEN                       | 3' - 0"                | 8' - 0"            | 0' - 1 | 3/4"         | WD            | WD         | AA        | 1HR         |                                  |
|                    | LAUNDRY<br>KITCHEN       | KITCHEN<br>BATHROOM           | 4' - 0"<br>2' - 8"     | 8' - 0"<br>8' - 0" | -      | 3/4"         | WD<br>WD      | WD<br>WD   | CC<br>AA  |             | DOUBLE DOOR / PAI                |
| 1713-4             | CLOSET                   | BATHROOM                      | 3' - 0"                | 8' - 0"            | 0' - 1 | 3/4"         | WD            | WD         | М         |             |                                  |
|                    | BATHROOM<br>A/C          | BEDROOM<br>KITCHEN            | 2' - 8"                | 8' - 0"<br>8' - 0" |        | 3/4"         | WD<br>WD      | WD<br>WD   | M<br>AA   |             |                                  |
| 1713-7             | BEDROOM                  | DINING                        | 3' - 0"                | 8' - 0"            | 0' - 1 | 3/4"         | WD            | WD         | AA        |             |                                  |
| 1713-8<br>1714-1   | LIVING                   | KITCHEN                       | 3' - 0"<br>3' - 0"     | 8' - 2"<br>8' - 0" |        | 1/2"         | AL/GL<br>WD   | AL<br>WD   | K<br>AA   |             |                                  |
| 1714-2             | CLOSET                   | KITCHEN                       | 2' - 6"                | 8' - 0"            |        | 3/4"         | WD            | HM         | AA        |             |                                  |
|                    | LAUNDRY<br>KITCHEN       | KITCHEN<br>BATHROOM           | 2' - 8"                | 8' - 0"<br>8' - 0" |        | 3/4"         | WD<br>WD      | WD<br>WD   | AA<br>AA  |             |                                  |
|                    | KITCHEN                  | WATER HEATER                  | 2' - 0"                | 8' - 0"            |        | 3/4"         | WD            | WD         | AA        |             |                                  |
|                    | KITCHEN<br>A/C           | BEDROOM<br>BEDROOM            | 3' - 0"<br>2' - 0"     | 8' - 0"<br>8' - 0" |        | 3/4"         | WD<br>WD      | WD<br>WD   | AA<br>AA  |             |                                  |
|                    | BEDROOM                  | BATHROOM                      | 2' - 8"                | 8' - 0"            |        | 3/4"         | WD            | WD         | AA        |             |                                  |
| 1714-9<br>1714-10  | CLOSET                   | BATHROOM                      | 2' - 8"<br>2' - 5 1/2" | 8' - 0"<br>8' - 2" |        | 3/4"         | WD<br>AL/GL   | WD         | M<br>K    |             |                                  |
|                    | ENTRY                    | LIVING                        | 2' - 5 1/2"            | 8' - 2"            |        | 3/4"         | WD            | AL<br>WD   | AA        |             |                                  |
|                    | ENTRY                    | ENTRY                         | 2' - 0"                | 8' - 0"            |        | 3/4"         | WD            | WD         | AA        |             |                                  |
| 1715-4<br>1715-5   | BEDROOM                  |                               | 2' - 8"<br>3' - 0"     | 8' - 0"<br>8' - 0" |        | 3/4"         | WD<br>WD      | WD<br>WD   | M         |             |                                  |
|                    | BATHROOM                 | BEDROOM                       | 5' - 0"                | 8' - 0"            |        | 1/2"         | WD            | WD         | L         |             |                                  |
| 1715-7<br>1715-8   | DINING                   | LIVING                        | 2' - 8"<br>4' - 0"     | 8' - 0"<br>8' - 2" |        | 3/4"         | WD<br>AL/GL   | WD<br>AL   | M<br>K    |             |                                  |
| 1716-1             | LAUNDEN                  | ENTRY                         | 3' - 0"                | 8' - 0"            |        | 3/4"         | WD            | WD         | AA        | 1HR         | 1 HOUR RATED                     |
| 1716-3<br>1716-4   | LAUNDRY                  | ENTRY<br>CLOSET               | 5' - 0"<br>4' - 0"     | 8' - 0"<br>7' - 0" | 0' - 1 | 1/2"         | WD<br>WD      | WD         | AA<br>AA  |             |                                  |
| 1716-5             | CLOSET                   | BATHROOM                      | 3' - 0"                | 8' - 0"            | _      |              | WD            | WD         | AA        | 1HR         |                                  |
| 1716-6<br>1716-7   | A/C                      | BATHROOM<br>ENTRY             | 2' - 8"<br>3' - 0"     | 8' - 0"<br>8' - 0" |        | 3/4"         | WD<br>WD      | WD<br>WD   | AA        | 1HR         |                                  |
| 1716-9             |                          | MASTER BEDROOM                | 3' - 6"                | 8' - 0"            | 0' - 1 | 3/4"         | WD            | WD         | CC        |             |                                  |
| 1716-10<br>1716-11 | CLOSET                   | ENTRY<br>MASTER BATH          | 3' - 6"<br>2' - 8"     | 8' - 0"<br>8' - 0" |        | 3/4"         | WD<br>WD      | WD         | M<br>AA   |             |                                  |
|                    | BATHROOM                 | MASTER BATH                   | 3' - 0"                | 8' - 0"            | 0' - 1 | 3/4"         | WD            | WD         | M         |             |                                  |
|                    | MASTER BATH<br>ENTRY     | ENTRY                         | 3' - 0"                | 8' - 0"<br>8' - 0" |        | 3/4"         | WD<br>WD      | WD<br>WD   | CC<br>AA  | 1HR<br>1HR  |                                  |
| 1717-2             | A/C                      | DINING                        | 2' - 0"                | 8' - 0"            | 0' - 1 | 3/4"         | WD            | WD         | AA        | 11111       |                                  |
|                    | LIVING<br>MASTER BEDROOM | MASTER BEDROOM MASTER BATH    | 2' - 8"<br>2' - 8"     | 8' - 0"<br>8' - 0" |        | 3/4"         | WD<br>WD      | WD<br>WD   | M         |             |                                  |
| 1717-5             |                          | CLOSET                        | 2' - 8"                | 8' - 0"            | 0' - 1 | 3/4"         | WD            | WD         | AA        |             |                                  |
|                    | Room<br>LAUNDRY          | PANTRY<br>Room                | 2' - 8"<br>4' - 0"     | 8' - 0"<br>8' - 0" |        | 3/4"         | WD<br>WD      | WD<br>WD   | M<br>CC   |             | DOUBLE DOOR / PA                 |
| 1717-8             | Room                     | BATH                          | 2' - 8"                | 8' - 0"            | 0' - 1 | 3/4"         | WD            | WD         | M         |             | SOULL DOOR / PAI                 |
|                    | BEDROOM<br>BEDROOM       | BATH<br>Room                  | 2' - 8"<br>2' - 8"     | 8' - 0"<br>8' - 0" |        | 3/4"         | WD<br>WD      | WD<br>WD   | M         |             |                                  |
|                    | CLOSET                   | BEDROOM                       | 5' - 0"                | 8' - 0"            |        | 1/2"         | WD            | WD         | L         |             |                                  |
| 1717-12            | LIVING                   | ENTDV                         |                        | 8' - 2"<br>8' - 0" |        | 1/2"<br>3/4" | AL/GL         | AL         | K         | 1110        | 1 HOUD DATED                     |
| 1718-1<br>1718-2   | BATH                     | ENTRY<br>ENTRY                | 3' - 0"<br>2' - 8"     | 8' - 0"            |        | 3/4"         | WD<br>WD      | WD<br>WD   | AA<br>M   | IHK         | 1 HOUR RATED                     |
|                    | ENTRY                    | BEDROOM                       | 3' - 0"                | 8' - 0"            |        | 3/4"         | WD            | WD         | AA        |             |                                  |
|                    | CLOSET<br>LAUNDRY        | BEDROOM<br>KITCHEN            | 5' - 0"<br>4' - 0"     | 8' - 0"<br>8' - 0" |        | 1/2"<br>3/4" | WD<br>WD      | WD<br>WD   | CC        |             | DOUBLE DOOR / PA                 |
| 1718-6             | MASTER BEDROOM           | DINING                        | 3' - 0"                | 8' - 0"            | 0' - 1 | 3/4"         | WD            | WD         | AA        |             |                                  |
|                    | MASTER BEDROOM<br>HALL   | A/C<br>MASTER BEDROOM         | 2' - 0"<br>2' - 8"     | 8' - 0"<br>8' - 0" |        | 3/4"         | WD<br>WD      | WD<br>WD   | AA<br>M   |             |                                  |
| 1718-9             | CLOSET                   | HALL                          | 4' - 0"                | 8' - 0"            | 0' - 1 | 1/2"         | WD            | WD         | L         |             |                                  |
| 1718-10<br>1718-11 |                          | CLOSET MASTER BATH            | 4' - 0"<br>2' - 8"     | 8' - 0"<br>8' - 0" |        | 1/2"<br>3/4" | WD<br>WD      | WD<br>WD   | M         |             |                                  |
| 1718-12            | WATER HEATER             | MASTER BATH                   | 2' - 0"                | 8' - 0"            | 0' - 1 | 3/4"         | WD            | WD         | AA        |             |                                  |
| 1718-13<br>1719-1  | roilet                   | MASTER BATH<br>ENTRY          | 2' - 8"                | 8' - 0"<br>8' - 0" |        | 3/4"         | WD<br>WD      | WD<br>WD   | AA<br>AA  | 1HR         | 1 HOUR RATED                     |
| 1719-2             | BATH                     | ENTRY                         | 2' - 8"                | 8' - 0"            | 0' - 1 | 3/4"         | WD            | WD         | М         | 11          |                                  |
|                    | ENTRY<br>CLOSET          | BEDROOM<br>BEDROOM            | 3' - 0"<br>5' - 0"     | 8' - 0"<br>8' - 0" |        | 3/4"         | WD<br>WD      | WD<br>WD   | AA<br>L   |             |                                  |
|                    | LAUNDRY                  | KITCHEN                       | 4' - 0"                | 8' - 0"            |        | 3/4"         | WD            | WD         | CC        |             | DOUBLE DOOR / PA                 |
|                    |                          | DINING                        | 3' - 0"                | 8' - 0"            |        | 3/4"         | WD            | WD         | AA        |             |                                  |
|                    | MASTER BEDROOM<br>HALL   | A/C<br>MASTER BEDROOM         | 2' - 0"<br>2' - 8"     | 8' - 0"<br>8' - 0" |        | 3/4"         | WD<br>WD      | WD<br>WD   | AA<br>M   |             |                                  |
|                    | CLOSET                   | HALL                          | 4' - 0"                | 8' - 0"            | 0' - 1 | 1/2"         | WD            | WD         | L         |             |                                  |
|                    |                          |                               |                        | 01 01              | 101    | 1/2"         | WD            | WD         | L         | 1           | 1                                |
| 1719-10<br>1719-11 |                          | CLOSET MASTER BATH            | 4' - 0"<br>2' - 8"     | 8' - 0"<br>8' - 0" |        | 3/4"         | WD            | WD         | M         |             |                                  |

|      | DOOR SCHEDULE - 17TH FLOOR |          |       |        |           |               |            |           |             |         |
|------|----------------------------|----------|-------|--------|-----------|---------------|------------|-----------|-------------|---------|
| MARK | FROM                       | <b>D</b> | WIDTH | НЕІСНТ | THICKNESS | DOOR MATERIAL | DOOR FRAME | DOOR TYPE | FIRE RATING | REMARKS |

|      |           | l                | DOOR S   | CHEDULE -    | 18TH FLO    | OR            |            |           |             |         |
|------|-----------|------------------|----------|--------------|-------------|---------------|------------|-----------|-------------|---------|
| MARK | FROM      | Q.               | WIDTH    | неіднт       | THICKNESS   | DOOR MATERIAL | DOOR FRAME | DOOR TYPE | FIRE RATING | REMARKS |
|      | T         |                  | 12. 2    | I            |             | 1             | T          | T         |             | T       |
| 1800 |           |                  | 3' - 0"  | 7' - 0"      | 0' - 1 3/8" |               |            |           |             |         |
| 1801 |           |                  | 6' - 0"  | 7' - 0"      | 0' - 2"     | НМ            | HM         | D         |             |         |
| 1802 |           | STAIR 1          | 3' - 0"  | 7' - 0"      | 0' - 1 3/4" | НМ            | НМ         | Е         | 2HR         |         |
| 1803 |           |                  | 5' - 0"  | 8' - 0"      |             |               |            |           |             |         |
| 1804 |           |                  | 5' - 0"  | 8' - 0"      |             |               |            |           |             |         |
| 1805 |           |                  | 6' - 0"  | 7' - 10 3/4" |             |               |            |           |             |         |
| 1806 |           | MEN'S RESTROOM   | 3' - 0"  | 7' - 0"      |             | НМ            | НМ         | С         |             |         |
| 1807 |           | FAMILY RESTROOM  | 3' - 0"  | 7' - 0"      | 0' - 1 3/4" | НМ            | НМ         | С         |             |         |
| 1808 |           | WOMEN'S RESTROOM | 3' - 0"  | 7' - 0"      |             | НМ            | НМ         | С         |             |         |
| 1811 |           | STORAGE          | 6' - 0"  | 7' - 0"      | 0' - 2"     | НМ            | НМ         | D         |             |         |
| 1812 | IDF RACKS | STORAGE          | 3' - 0"  | 7' - 0"      | 0' - 1 3/4" |               |            |           |             |         |
| 1813 |           | STORAGE          | 3' - 0"  | 7' - 0"      | 0' - 1 3/8" |               |            |           |             |         |
| 1814 | PANTRY    |                  | 3' - 0"  | 7' - 0"      | 0' - 1 3/4" | HM/GL         | HM         | E         |             |         |
| 1815 |           | PANTRY           | 3' - 0"  | 7' - 0"      | 0' - 1 3/4" | HM/GL         | НМ         | E         |             |         |
| 1816 |           |                  | 6' - 0"  | 7' - 0"      | 0' - 1 3/4" | НМ            | НМ         | D         |             |         |
| 1817 | STAIR 3   |                  | 3' - 0"  | 7' - 0"      | 0' - 1 3/4" | НМ            | НМ         | Е         | 2HR         |         |
| 1818 |           |                  | 5' - 10" | 7' - 9"      |             | AL/GL         | AL         | Α         |             |         |
| 1819 |           |                  |          |              |             |               |            |           |             |         |
| 1820 |           |                  |          |              |             |               |            |           |             |         |
| 1821 |           |                  |          |              |             |               |            |           |             |         |

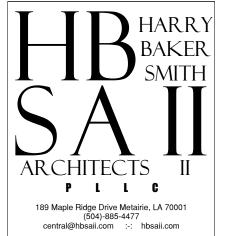

SINCE 1961

1031 CANAL STREET NEW ORLEANS, LOUISIANA

THESE PLANS AND SPECIFICATIONS HAVE
BEEN PREPARED BY ME OR UNDER MY
CLOSE PERSONAL SUPERVISION AND TO
THE BEST OF MY KNOWLEDGE AND
BELIEF THEY COMPLY WITH ALL CITY,
STATE AND FEDERAL REQUIREMENTS, AND
I AM NOT PROVIDING CONTRACT
ADMINISTRATION.



|                              | R                            | EVIS                         |                              |                              | TOR                          | Υ                            |   |
|------------------------------|------------------------------|------------------------------|------------------------------|------------------------------|------------------------------|------------------------------|---|
| 4/27/2018                    | 5/4/2018                     | 5/11/2018                    | 5/18/2018                    | 5/25/2018                    | 6/1/2018                     | 6/8/2018                     |   |
| L.I.S. #2 - CLOUD REVISION 1 | L.I.S. #2 - CLOUD REVISION 2 | L.I.S. #2 - CLOUD REVISION 3 | L.I.S. #2 - CLOUD REVISION 4 | L.I.S. #2 - CLOUD REVISION 5 | L.I.S. #2 - CLOUD REVISION 6 | L.I.S. #2 - CLOUD REVISION 7 |   |
| -                            | 2                            | ဇ                            | 4                            | 2                            | 9                            | 7                            | 8 |

SCHEDULES

PROJECT#: 1709
PHASE: DD
TEAM: Author
CHECKER: Checker
SCALE: AS NOTED
ISSUED: 4/20/2018
SHEET#:
A6.12



189 Maple Ridge Drive Metairie, LA 70001 (504)-885-4477 central@hbsaii.com :-: hbsaii.com SINCE 1961

1031 CANAL STREET NEW ORLEANS, LOUISIANA


HESE PLANS AND SPECIFICATIONS HAVE BEEN PREPARED BY ME OR UNDER MY CLOSE PERSONAL SUPERVISION AND TO THE BEST OF MY KNOWLEDGE AND BELIEF THEY COMPLY WITH ALL CITY, STATE AND FEDERAL REQUIREMENTS, AND I AM NOT PROVIDING CONTRACT ADMINISTRATION. CERTIFIED CORRECT





| 2. COUD REVISION 2 2. COUD REVISION 2 3. COUD REVISION 4 3. COUD REVISION 5 3. COUD REVISION 6 3. COUD REVISION 6 3. COUD REVISION 7 4/27/2018 5/4/2018 7 S/4/2018 |
|--|
| 5/4/2018<br>5/11/2018<br>5/18/2018<br>5/25/2018<br>6/1/2018  |
| 5/11/2018         5/18/2018         6/1/2018         6/1/2018  |
| 5/18/2018         5/25/2018         6/1/2018   |
| 6/1/2018   |
| 6/1/2018   |
| 6/8/2018   |
|  |
|  |

L.I.S. #2 - CLC
L.I.S. #2 - CLC
L.I.S. #2 - CLC
L.I.S. #2 - CLC
L.I.S. #2 - CLC STOREFRONT SCHEDULES (GROUND FLOOR)


PROJECT#: 1709 PHASE: DD TEAM: Author CHECKER: Checker SCALE: AS NOTED ISSUED: 4/20/2018

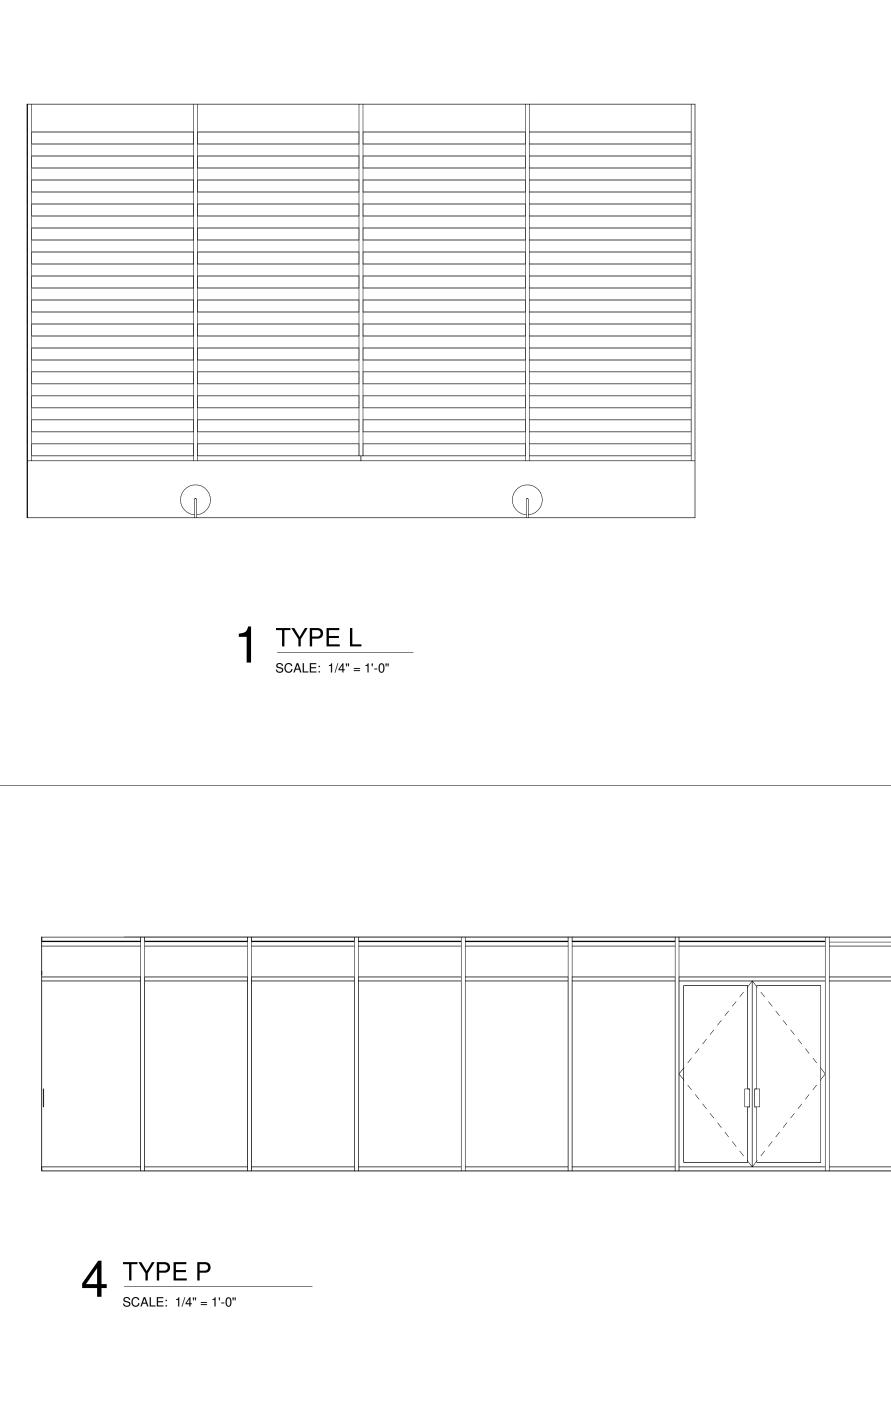

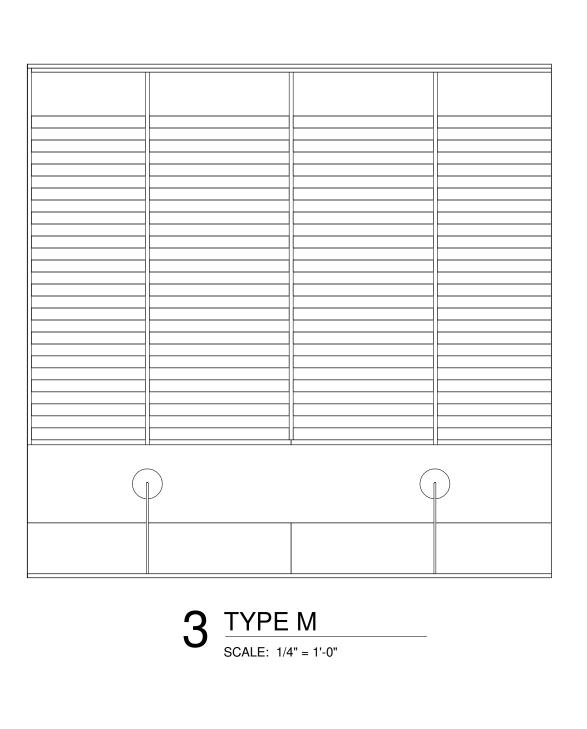

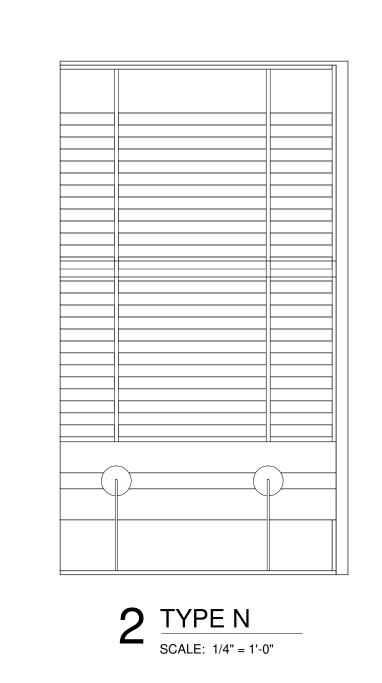


GROUND FLOOR

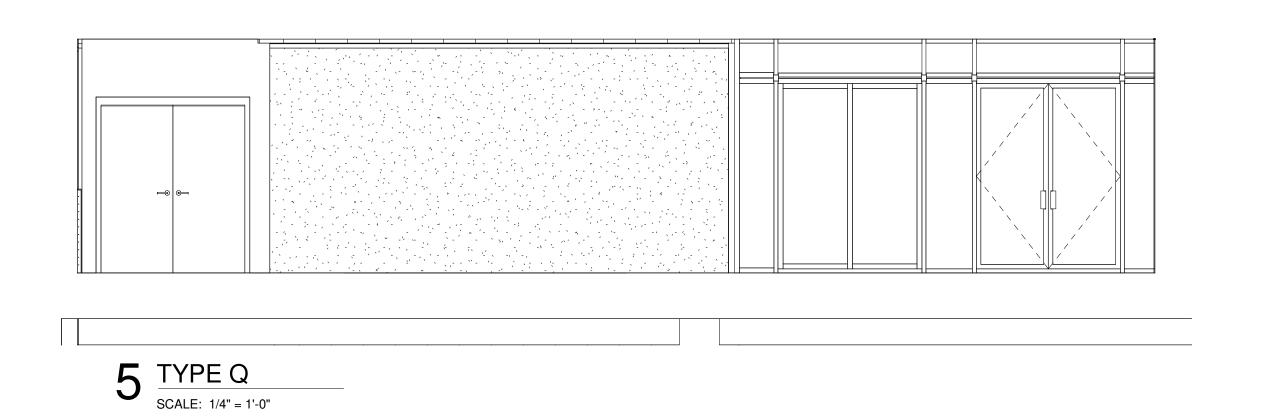


8TH FLOOR

14TH FLOOR

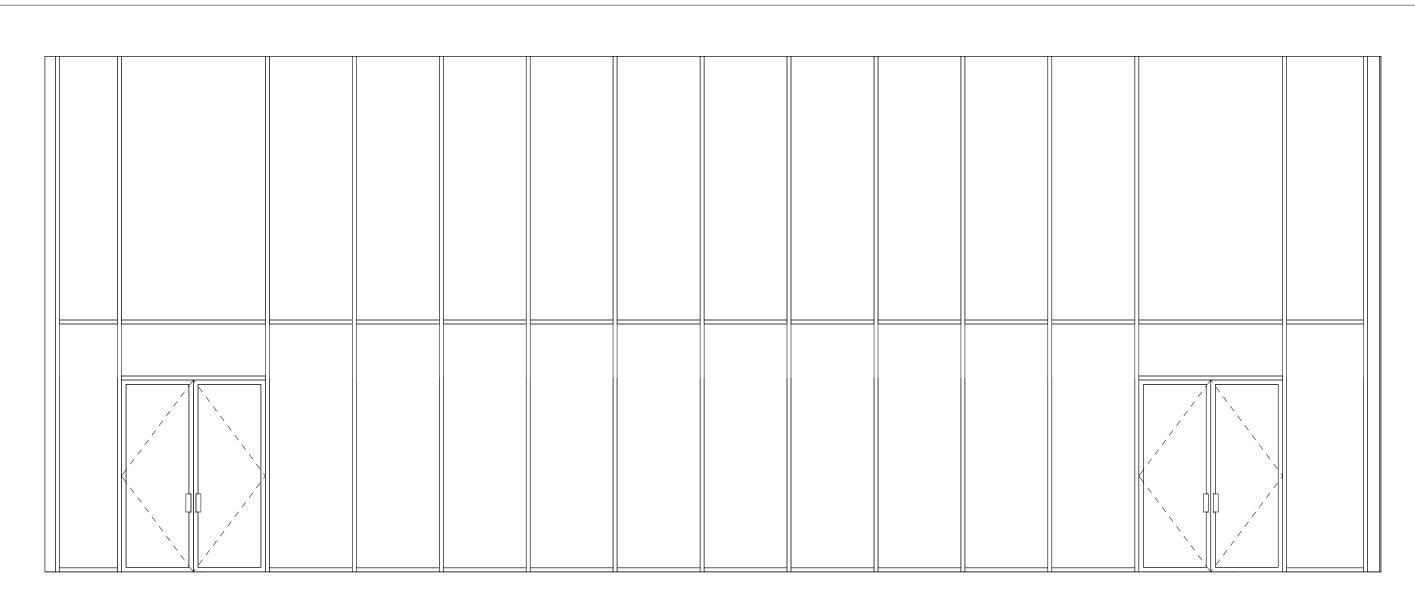

6 TYPE R

SCALE: 1/4" = 1'-0"

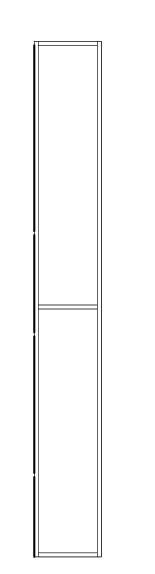


7 TYPE S

SCALE: 1/4" = 1'-0"

189 Maple Ridge Drive Metairie, LA 70001 (504)-885-4477 central@hbsaii.com :-: hbsaii.com SINCE 1961

1031 CANAL STREET NEW ORLEANS, LOUISIANA


HESE PLANS AND SPECIFICATIONS HAVE BEEN PREPARED BY ME OR UNDER MY CLOSE PERSONAL SUPERVISION AND TO THE BEST OF MY KNOWLEDGE AND BELIEF THEY COMPLY WITH ALL CITY, STATE AND FEDERAL REQUIREMENTS, AND I AM NOT PROVIDING CONTRACT ADMINISTRATION. CERTIFIED CORRECT

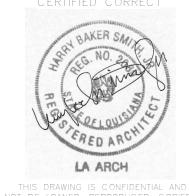


| LI.S. #2 - CLOUD REVISION 4 5/18/2018 | L.I.S. #2 - CLOUD REVISION 1 | TEVISION MISTORY |
|---------------------------------------|------------------------------|------------------|
| 5/18/2018                             | L.I.S. #2 - CLOUD REVISION 2 |                  |
| LI.S. #2 - CLOUD REVISION 3           |                              |                  |

STOREFRONT SCHEDULES PROJECT#: 1709
PHASE: DD
TEAM: Author
CHECKER: Checker
SCALE: AS NOTED
ISSUED: 4/20/2018
SHEET#:

A6.16

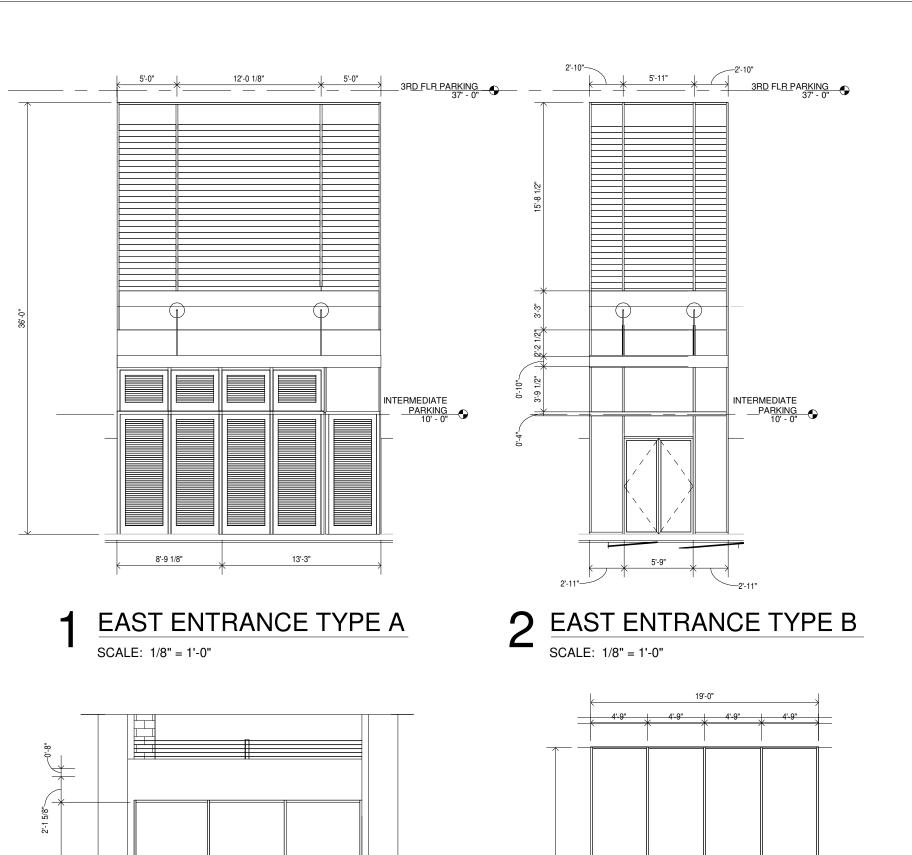


4 NORTH STOREFRONT AT PARKING
SCALE: 1/8" = 1'-0"

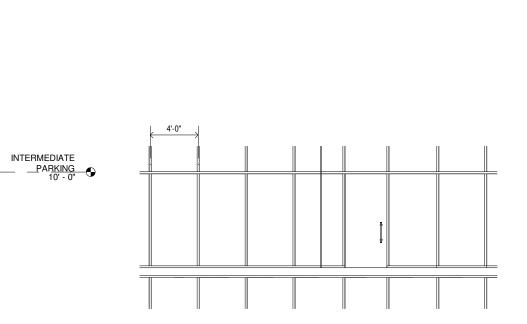


3 NORTH ENTRANCE
SCALE: 1/8" = 1'-0"

6'-3 1/2" 6'-3" 6'-4 1/2"

5 NORTH PENTHOUSE STOREFRONT
SCALE: 1/8" = 1'-0"

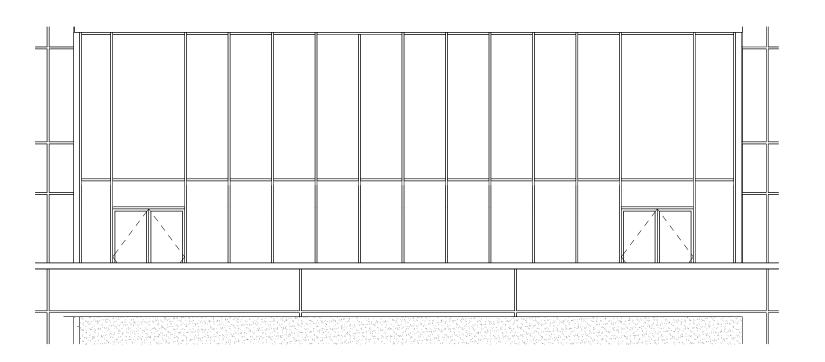

7 WEST POOL LEVEL STOREFRONT SCALE: 1/8" = 1'-0"

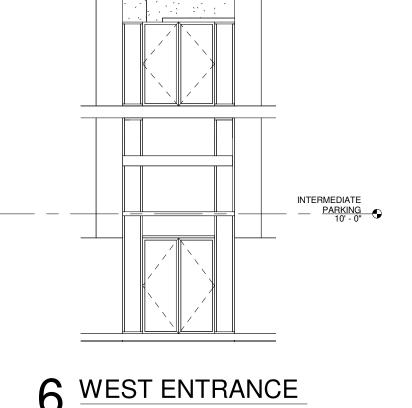

 $6 \frac{\text{WEST ENTRANCE}}{\text{SCALE: } 1/8" = 1'-0"}$ 

189 Maple Ridge Drive Metairie, LA 70001 (504)-885-4477 central@hbsaii.com :-: hbsaii.com SINCE 1961

1031 CANAL STREET NEW ORLEANS, LOUISIANA

THESE PLANS AND SPECIFICATIONS HAVE BEEN PREPARED BY ME OR UNDER MY CLOSE PERSONAL SUPERVISION AND TO THE BEST OF MY KNOWLEDGE AND BELIEF THEY COMPLY WITH ALL CITY, STATE AND FEDERAL REQUIREMENTS, AND I AM NOT PROVIDING CONTRACT ADMINISTRATION. CERTIFIED CORRECT



|                              | R                            | EVIS                         |                              |                              | TOR                          | Υ                            |   |
|------------------------------|------------------------------|------------------------------|------------------------------|------------------------------|------------------------------|------------------------------|---|
| 4/27/2018                    | 5/4/2018                     | 5/11/2018                    | 5/18/2018                    | 5/25/2018                    | 6/1/2018                     | 6/8/2018                     |   |
| L.I.S. #2 - CLOUD REVISION 1 | L.I.S. #2 - CLOUD REVISION 2 | L.I.S. #2 - CLOUD REVISION 3 | L.I.S. #2 - CLOUD REVISION 4 | L.I.S. #2 - CLOUD REVISION 5 | L.I.S. #2 - CLOUD REVISION 6 | L.I.S. #2 - CLOUD REVISION 7 |   |
| -                            | 2                            | က                            | 4                            | 5                            | 9                            | 7                            | α |

PROJECT#: 1709 PHASE: DD TEAM: Author CHECKER: Checker SCALE: AS NOTED

2" 20 GA MTL STUDS @ 16" O.C.

6 1-1/2" 20 GA MTL STUDS @ 16" O.C.

7 1 LAYER 5/8" GYPSUM BD.

2 LAYERS 5/8" FIRE CODE GYPSUM BD.

5/8" EXTERIOR GYPSUM SHEATING

(11) 1/2" CEMENT BD.

RESILIENT CHANNELS @ 24" O.C. VERTICALLY

12 EXTERIOR METAL PANELS - PRE FINISHED

1/2" PERMA BASE CEMENT BD

7/8" HAT CHANNELS

(16) R19 THERMAL BATT INSULATION

20 5/8" AIRSPACE

FLUID APPLIED VAPOR BARRIER

(18) GRANITE VENEER PANELS

CEMENT PLASTER SYSTEM - RE: SPECIFICATIONS

21) EXPOSED CAST IN PLACE CONCRETE

PRECAST CONCRETE WALL SYSTEM

23 LIFE SAFETY PLANS FOR RATING

(24) CEMENT PLASTER

SILOXANE WATER REPELLENT

METAL DECKING /
CONCRETE SLAB OR PT
SLAB

SEE STRUCTURAL
DRAWINGS FOR
STRUCTURAL GROUT,
RE-STEEL, BRACING REQ.,

AND JOINT SIZING

32 STRUCTURE PER PLAN

SPRAY APPLIED FIRE PROOFING

(34) 5/8" RESILIENT SOUND CLIPS

25 GA 3-5/8" MTL STUDS @ 24" O.C.

37 SLOTTED BOTTOM TRACK

38 FIRE CAULK / ACOUSTICAL

36 SLOTTED TOP TRACK

30 TV MOUNTING PADS

**31** ▼ TV

25 8" CMU

26 6" CMU

SHAFTWALL SYSTEM - RE:

MINERAL WALL SOUND INSULATION



SINCE 1961

CERTIFIED CORRECT

REVISION HISTORY

(39) CAST IN PLACE CONCRETE WALL

40 INSULATION

41) STRUCTURAL STEEL BEAM

5/8" CEMENT BOARD - 4' HIGH

43 1-5/8" METAL STUD 20 GA.

44 2-1/2" METAL STUD 20 GA.

COLUMN, WALL, OR OTHER SOLID CONTINUOUS SURFACE


46 1 LAYER OF 1" GYPSUM BD.


47 12" CMU

48 4" HIGH CIP CONCRETE CURB

(49) 8" CMU SOLID FILL GROUT

50 13.5" AIRSPACE (51) 6 3/8" AIRSPACE

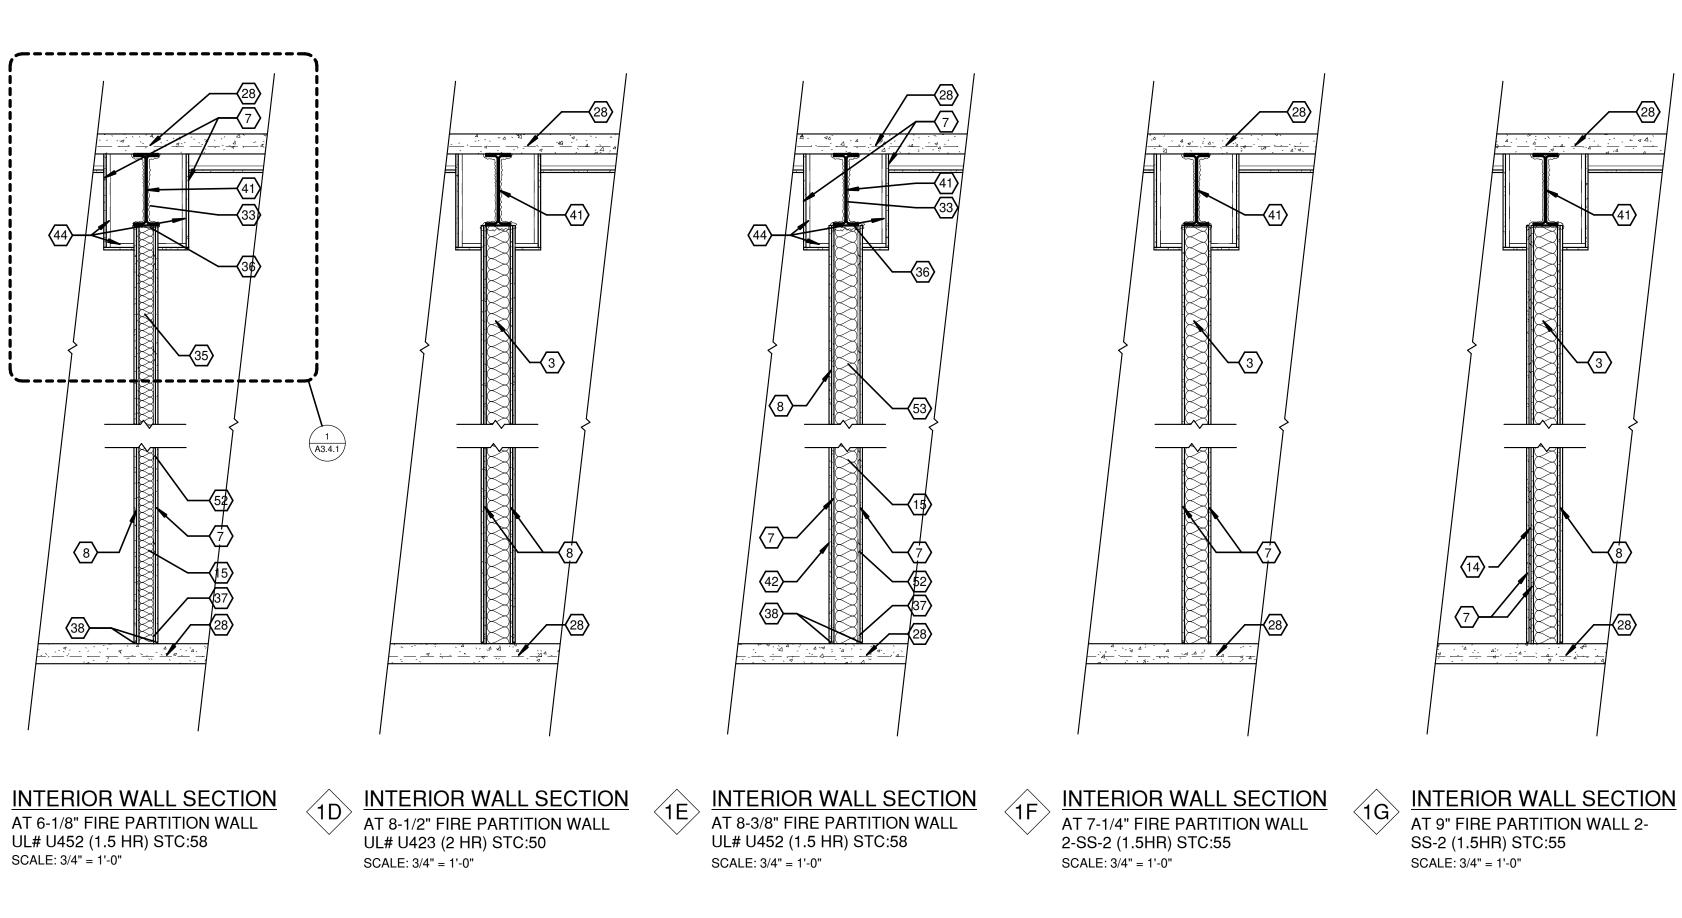

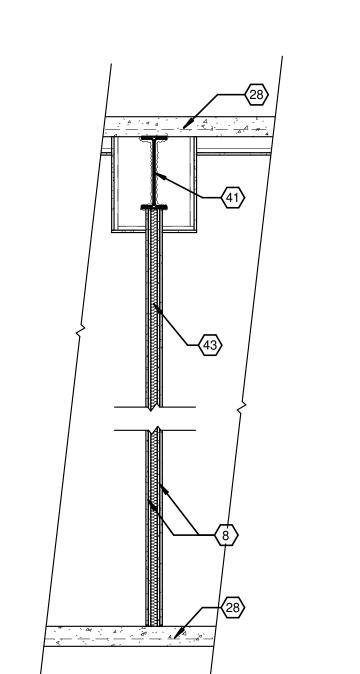


~~ <u>~</u> ~ <del>/</del> ~ <del>/</del> .

INTERIOR WALL SECTION

AT 4-7/8" FIRE PARTITION WALL

UL# U419 (1 HR) STC:50

SCALE: 3/4" = 1'-0"

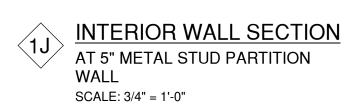

4 - 4 24 - 4 24


**INTERIOR WALL SECTION** 


44


AT 5-3/8" FIRE PARTITION WALL


UL# U407 (1 HR) STC:45


SCALE: 3/4" = 1'-0"

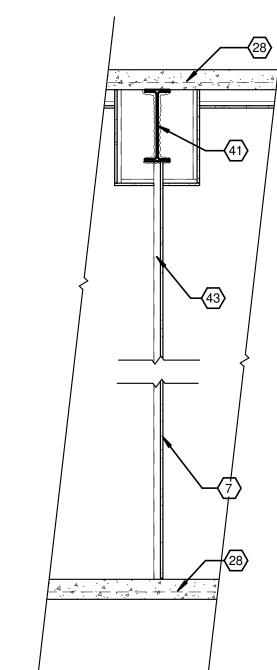


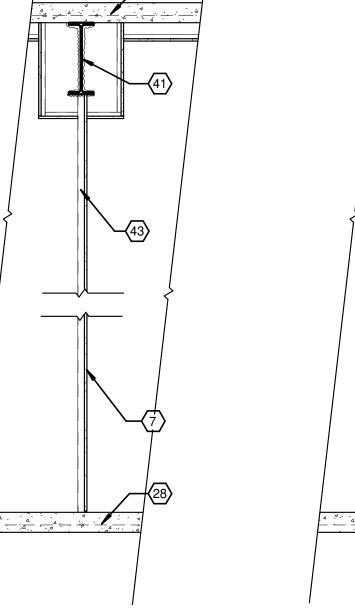

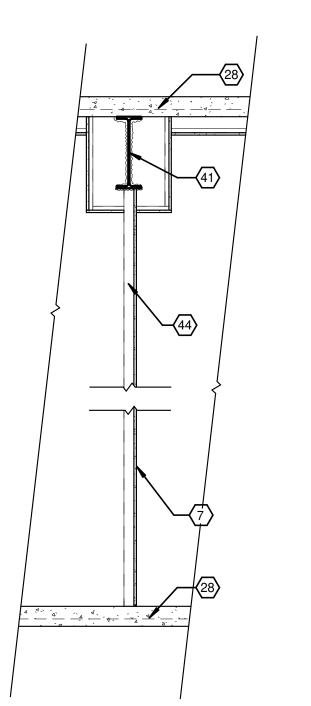

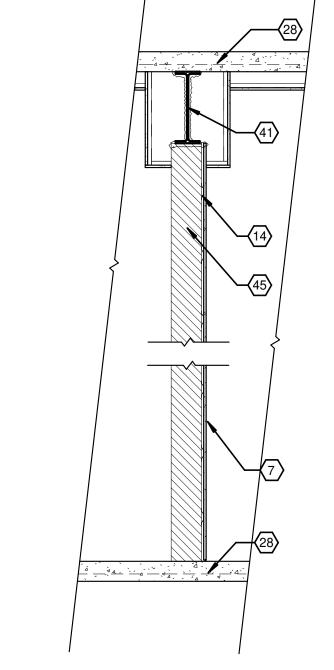

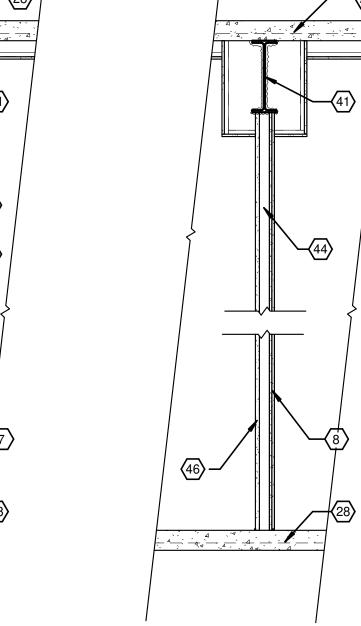

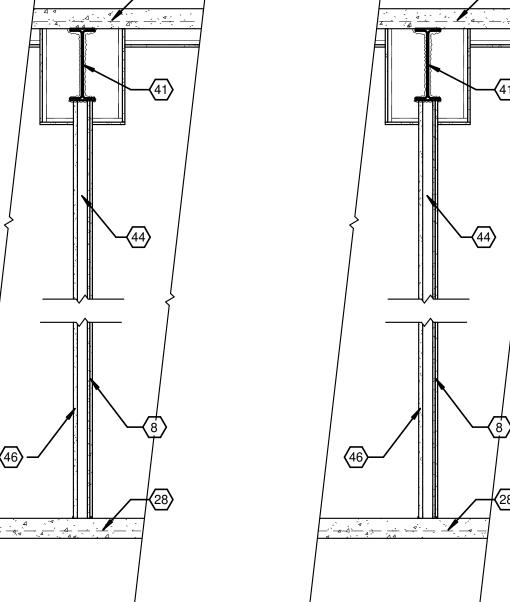












**INTERIOR WALL SECTION** AT 3-1/8" METAL STUD FURRING WALL SCALE: 3/4" = 1'-0"

WALL SCALE: 3/4" = 1'-0"

**INTERIOR WALL SECTION** AT 1-1/8" HAT CHANNEL FURRING

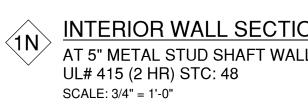

| <u>N</u> |
|----------|
|          |
|          |

# 1031 CANAL STREET NEW ORLEANS, LOUISIANA

|   | L.I.S. #2 - CLOUD REVISION 1 |
|---|------------------------------|
| N | L.I.S. #2 - CLOUD REVISION 2 |
| 3 | L.I.S. #2 - CLOUD REVISION 3 |
| 4 | L.I.S. #2 - CLOUD REVISION 4 |
| 2 | L.I.S. #2 - CLOUD REVISION 5 |
| 9 | L.I.S. #2 - CLOUD REVISION 6 |
| 7 | L.I.S. #2 - CLOUD REVISION 7 |
| m |                              |

- N W 4 W 0 V W PARTITION TYPES

PROJECT#: 1709 PHASE: DD TEAM: Author CHECKER: Checker SCALE: AS NOTED ISSUED: 4/20/2018

WALL PARTITION TYPEST KEYNOTE LEGEND 3 1/2" 20 GA MTL STUDS STAGGERED @ 16" O.C. 52 1/2" HAT CHAINELS 3 5/8" 22 GA MTL STUDS @ 16" O.C. PUTTY PADS @ ALL ELECTS II

MEMBRANE PENTRAPONSI I C (3) 6" 22 GA MTL STUDS @ 16" O.C.

189 Maple Ridge Drive Metairie, LA 70001 (504)-885-4477

DECK ANOPIORS :: hbsaii.com

5 2" 20 GA MTL STUDS @ 16" O.C.

6 1-1/2" 20 GA MTL STUDS @ 16" O.C.

7 1 LAYER 5/8" GYPSUM BD.

8 2 LAYERS 5/8" FIRE CODE GYPSUM BD.

9 5/8" EXTERIOR GYPSUM SHEATING

RESILIENT CHANNELS @ 24" O.C. VERTICALLY

12 EXTERIOR METAL PANELS - PRE FINISHED

1/2" PERMA BASE CEMENT BD

7/8" HAT CHANNELS

MINERAL WALL SOUND INSULATION

16) R19 THERMAL BATT INSULATION

FLUID APPLIED VAPOR BARRIER

(18) GRANITE VENEER PANELS

CEMENT PLASTER SYSTEM - RE: SPECIFICATIONS

EXPOSED CAST IN PLACE CONCRETE

PRECAST CONCRETE WALL SYSTEM

SHAFTWALL SYSTEM - RE: LIFE SAFETY PLANS FOR RATING

(24) CEMENT PLASTER

METAL DECKING /
CONCRETE SLAB OR PT
SLAB

SEE STRUCTURAL
DRAWINGS FOR
STRUCTURAL GROUT,
RE-STEEL, BRACING REQ.,
AND JOINT SIZING

30 TV MOUNTING PADS

32 STRUCTURE PER PLAN

SPRAY APPLIED FIRE PROOFING

34) 5/8" RESILIENT SOUND CLIPS

37 SLOTTED BOTTOM TRACK

\$\square{38}\) FIRE CAULK / ACOUSTICAL

5/8" CEMENT BOARD - 4' HIGH

43 1-5/8" METAL STUD 20 GA.

46 1 LAYER OF 1" GYPSUM BD.

49 8" CMU SOLID FILL GROUT

(51) 6 3/8" AIRSPACE

1031 CANAL STREET NEW ORLEANS, LOUISIANA

REVISION HISTORY

BEEN PREPARED BY ME OR UNDER MY CLOSE PERSONAL SUPERVISION AND TO THE BEST OF MY KNOWLEDGE AND BELIEF THEY COMPLY WITH ALL CITY, STATE AND FEDERAL REQUIREMENTS, AND I AM NOT PROVIDING CONTRACT ADMINISTRATION.


CERTIFIED CORRECT


PARTITION TYPES

PROJECT#: 1709 PHASE: DD TEAM: Author CHECKER: Checker


ISSUED: 4/20/2018

SCALE: AS NOTED

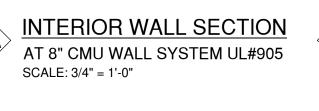


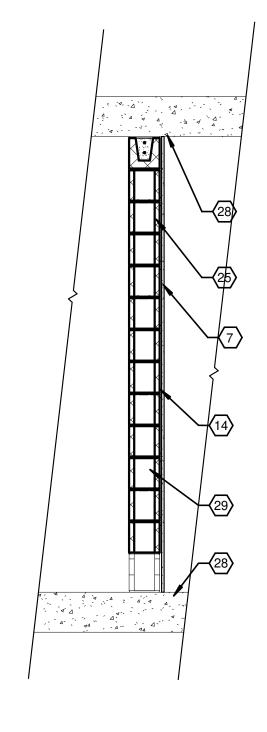


**INTERIOR WALL SECTION** AT 8" CMU W/ 5/8" GYP. ONE SIDE ON 7/8" HAT CHANNELS SCALE: 3/4" = 1'-0"

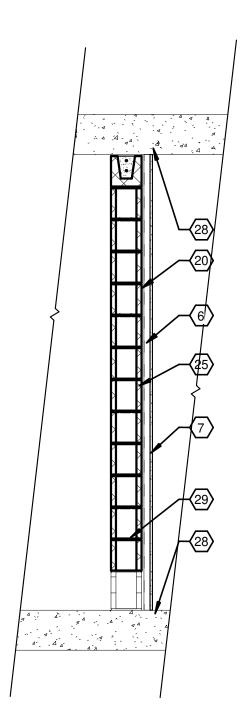


**INTERIOR WALL SECTION** AT 8" CMU WALL W/ 5/8" GYP. ON 1 1/2" MTL. STUDS W/ 5/8" AIR SPACE SCALE: 3/4" = 1'-0"

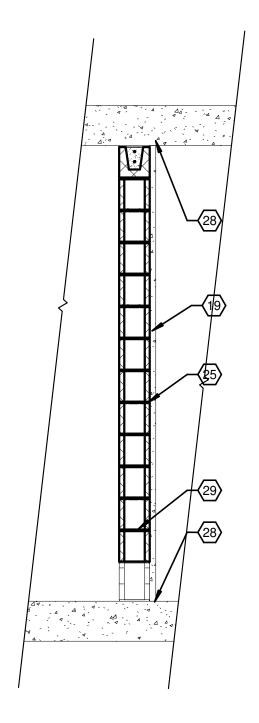


**INTERIOR WALL SECTION** AT 8" CMU WALL W/ CEMENT PLASTER SYSTEM - RE: SPECS SCALE: 3/4" = 1'-0"

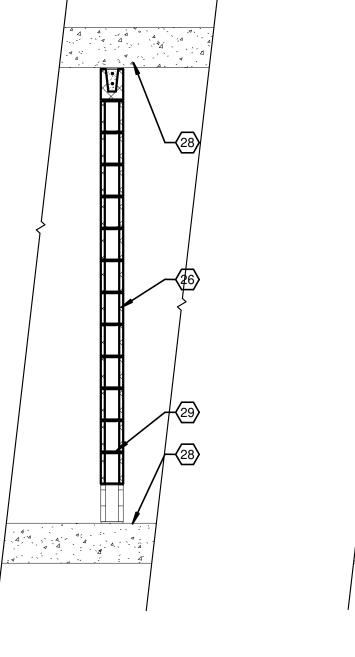


**INTERIOR WALL SECTION** AT 6" CMU WALL SYSTEM UL# SCALE: 3/4" = 1'-0"

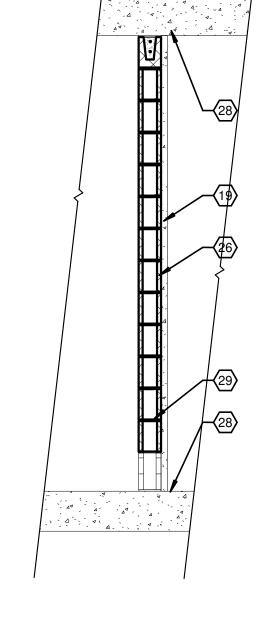


**INTERIOR WALL SECTION** AT 6" CMU WALL SYSTEM W/ CEMENT PLASTER SYSTEM - RE: SPECS UL# SCALE: 3/4" = 1'-0"

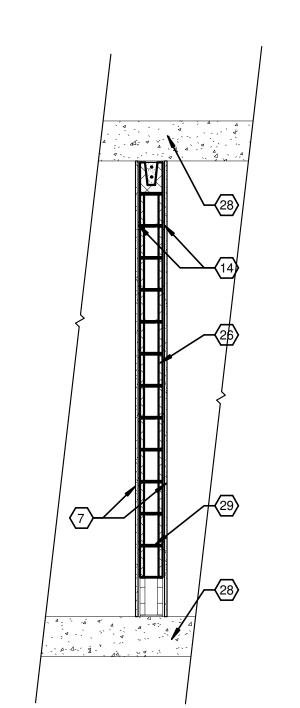


**INTERIOR WALL SECTION** AT 6" CMU WALL SYSTEM UL# SCALE: 3/4" = 1'-0"

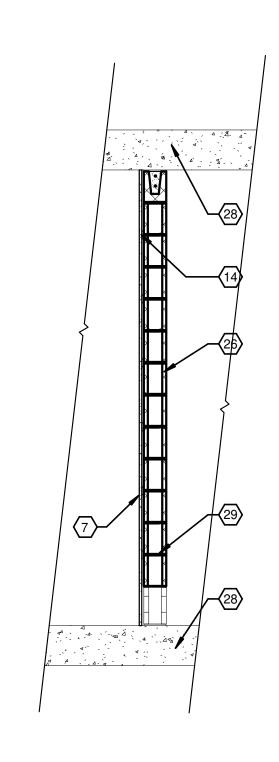


INTERIOR WALL SECTION AT 6" CMU WALL W/ 5/8" GYP. ONE SIDE ON 7/8" HAT CHANNELS UL# SCALE: 3/4" = 1'-0"

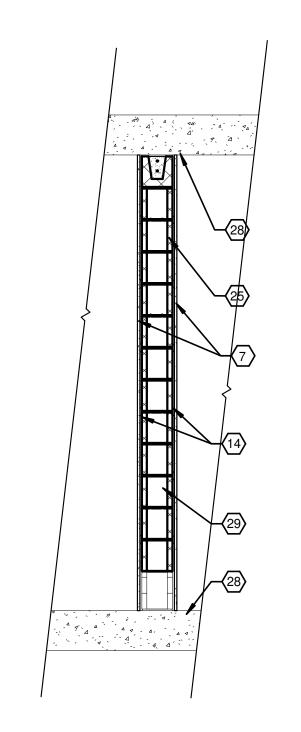


INTERIOR WALL SECTION AT 8" CMU W/ 5/8" GYP. BOTH SIDES ON 7/8" HAT CHANNELS SCALE: 3/4" = 1'-0"

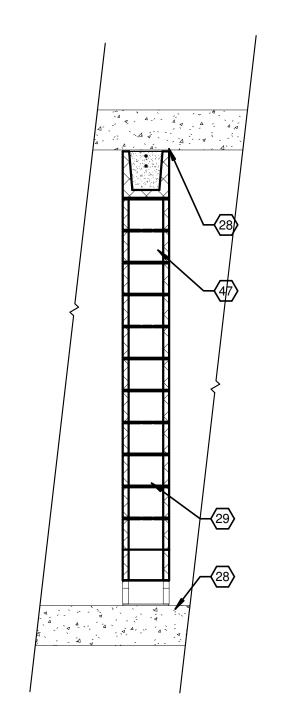

INTERIOR WALL SECTION AT 12" CMU SCALE: 3/4" = 1'-0"

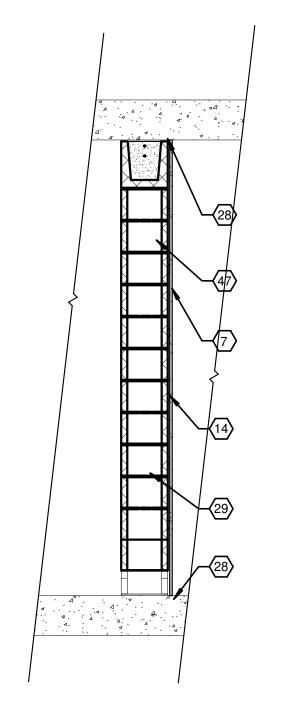

INTERIOR WALL SECTION AT 12" CMU W/ 5/8" GYP. ONE SIDE ON 7/8" HAT CHANNELS SCALE: 3/4" = 1'-0"

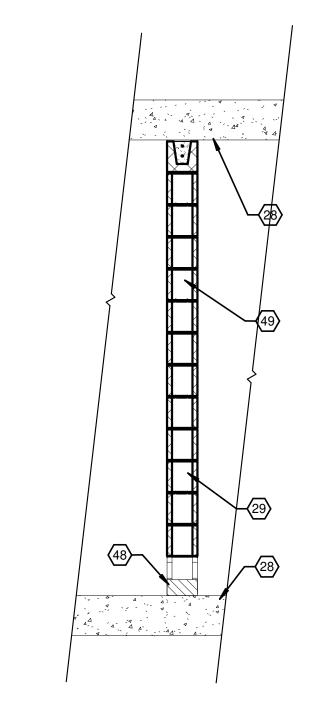

**INTERIOR WALL SECTION** AT 8" CMU SOLID FILL GROUT (3HR RATED) SCALE: 3/4" = 1'-0"

#### WALL PARTITION TYPES **KEYNOTE LEGEND**

3 1/2" 20 GA MTL STUDS STAGGERED @ 16" O.C.

2 3 5/8" 22 GA MTL STUDS @ 16" O.C.

52 1/2" HAT CHANNELS 6" 25 GA MTL STUDS @ 24" O.C.

(3) 6" 22 GA MTL STUDS @ 16" O.C.

PUTTY PADS @ ALL ELEC. MEMBRANE PENTRAIONS 6" 18 GA MTL STUDS @ 16" (55) DOVETAIL DECK ANCHORS

2" 20 GA MTL STUDS @ 16" O.C.

6 1-1/2" 20 GA MTL STUDS @ 16" O.C.

7 1 LAYER 5/8" GYPSUM BD.

8 2 LAYERS 5/8" FIRE CODE GYPSUM BD.

9 5/8" EXTERIOR GYPSUM SHEATING

RESILIENT CHANNELS @ 24" O.C. VERTICALLY

(11) 1/2" CEMENT BD.

EXTERIOR METAL PANELS - PRE FINISHED

1/2" PERMA BASE CEMENT BD

7/8" HAT CHANNELS

MINERAL WALL SOUND INSULATION

(16) R19 THERMAL BATT INSULATION

FLUID APPLIED VAPOR BARRIER

(18) GRANITE VENEER PANELS

(19) CEMENT PLASTER SYSTEM - RE: SPECIFICATIONS

20 5/8" AIRSPACE

EXPOSED CAST IN PLACE CONCRETE

PRECAST CONCRETE WALL SYSTEM SHAFTWALL SYSTEM - RE: LIFE SAFETY PLANS FOR RATING

(24) CEMENT PLASTER

SILOXANE WATER REPELLENT

METAL DECKING /
CONCRETE SLAB OR PT

SEE STRUCTURAL DRAWINGS FOR STRUCTURAL GROUT, RE-STEEL, BRACING REQ., AND JOINT SIZING

30 TV MOUNTING PADS

**31** ▼ TV

32 STRUCTURE PER PLAN

SPRAY APPLIED FIRE PROOFING

(34) 5/8" RESILIENT SOUND CLIPS

25 GA 3-5/8" MTL STUDS @ 24" O.C.

(36) SLOTTED TOP TRACK

37 SLOTTED BOTTOM TRACK

38) FIRE CAULK / ACOUSTICAL

CAST IN PLACE CONCRETE WALL

40 INSULATION

41) STRUCTURAL STEEL BEAM

5/8" CEMENT BOARD - 4' HIGH 43 1-5/8" METAL STUD 20 GA.

44 2-1/2" METAL STUD 20 GA.

COLUMN, WALL, OR OTHER SOLID CONTINUOUS SURFACE 46 1 LAYER OF 1" GYPSUM BD.

47 12" CMU

4" HIGH CIP CONCRETE CURB

49 8" CMU SOLID FILL GROUT

50 13.5" AIRSPACE

51 6 3/8" AIRSPACE

189 Maple Ridge Drive Metairie, LA 70001 (504)-885-4477 central@hbsaii.com :-: hbsaii.com SINCE 1961 1031 CANAL STREET NEW ORLEANS, LOUISIANA

PLLC




EITHER WHOLLY OR IN PART, OR MADE PUBLIC IN ANY MANNER WITHOUT THE RITTEN CONSENT OF HBSA II ARCHITEI A PROFESSIONAL L.L.C. ALL RIGHTS C

|                          | R                        | EVIS                     | SION                     | HIS                      | TOR                      | Υ                        |  |
|--------------------------|--------------------------|--------------------------|--------------------------|--------------------------|--------------------------|--------------------------|--|
| 4/27/2018                | 5/4/2018                 | 5/11/2018                | 5/18/2018                | 5/25/2018                | 6/1/2018                 | 6/8/2018                 |  |
|                          |                          |                          |                          |                          |                          |                          |  |
|                          |                          |                          |                          |                          |                          |                          |  |
| ION 1                    | ION 2                    | ION 3                    | 10N 4                    | ION 5                    | 9 NOI                    | ION 7                    |  |
| UD REVIS                 |  |
| S. #2 - CLOUD REVISION 1 | S. #2 - CLOUD REVISION 2 | S. #2 - CLOUD REVISION 3 | S. #2 - CLOUD REVISION 4 | S. #2 - CLOUD REVISION 5 | S. #2 - CLOUD REVISION 6 | S. #2 - CLOUD REVISION 7 |  |

- 0 8 4 0 0 V 8 PARTITION TYPES

PROJECT#: 1709 PHASE: DD TEAM: Author CHECKER: Checker SCALE: AS NOTED


SSUED: 4/20/2018

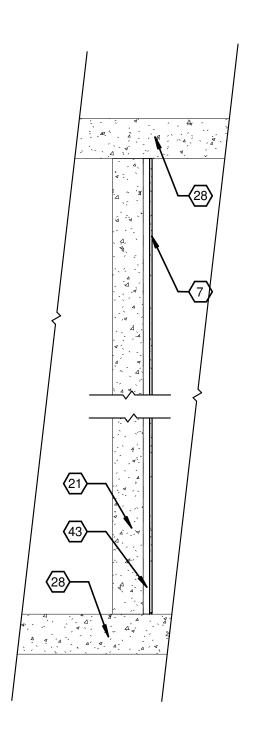

**INTERIOR WALL SECTION** 

AT 8" CONCRETE WALL


SCALE: 3/4" = 1'-0"

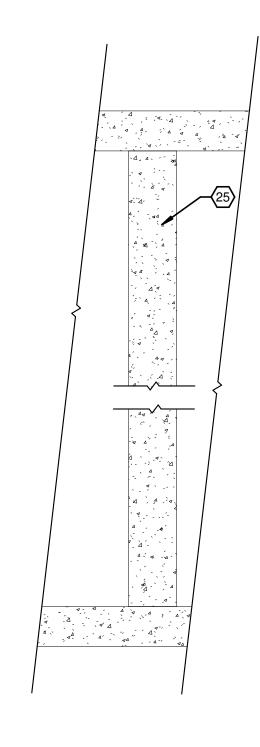



**INTERIOR WALL SECTION** 

AT 12" SHEAR WALL

SCALE: 3/4" = 1'-0"

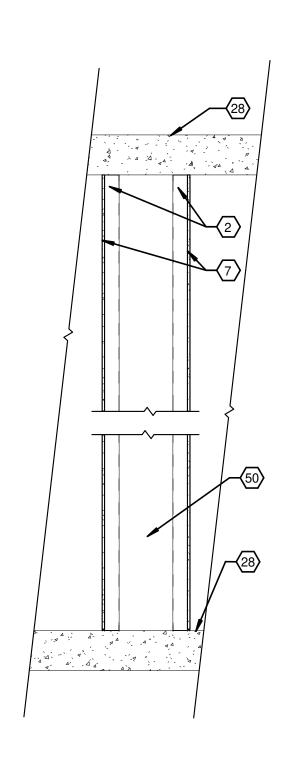

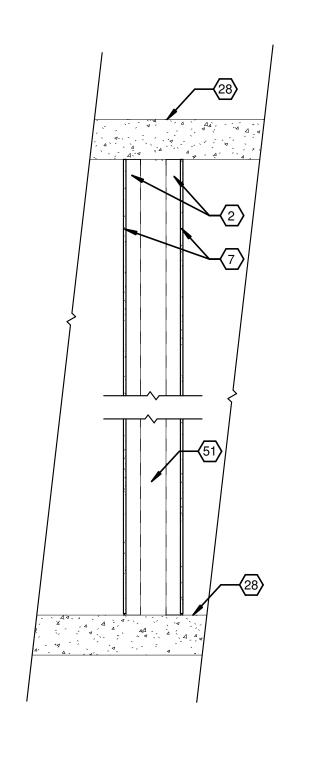

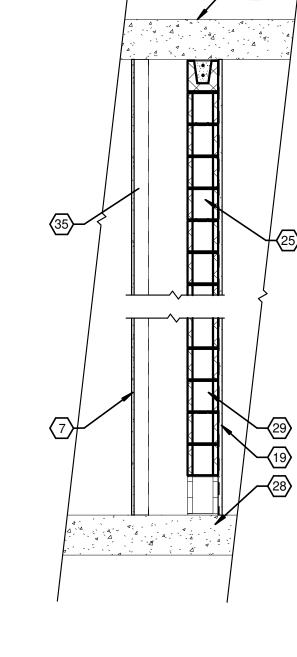

INTERIOR WALL SECTION AT 22" PLUMBING PARTITION WALL UL# U420 (1 HR) STC:50

SCALE: 3/4" = 1'-0"

**INTERIOR WALL SECTION** AT 14-5/8" PLUMBING PARTITION WALL UL# U420 (1 HR) STC:50 SCALE: 3/4" = 1'-0"

**INTERIOR WALL SECTION** AT 14-5/8" PLUMBING PARTITION WALL UL# U420 (1 HR) STC:50 SCALE: 3/4" = 1'-0"

#### **WALL PARTITION TYPES KEYNOTE LEGEND**

- 3 1/2" 20 GA MTL STUDS STAGGERED @ 16" O.C.
  - 52 1/2" HAT CHANNELS
- 2 3 5/8" 22 GA MTL STUDS @ 6" 25 GA MTL STUDS @ 24" O.C.
- PUTTY PADS @ ALL ELEC. MEMBRANE PENTRAIONS 3 6" 22 GA MTL STUDS @ 16" O.C.
- 6" 18 GA MTL STUDS @ 16" (55) DOVETAIL DECK ANCHORS
- 5 2" 20 GA MTL STUDS @ 16" O.C.
- 6 1-1/2" 20 GA MTL STUDS @ 16" O.C.
- 7 1 LAYER 5/8" GYPSUM BD.
- 2 LAYERS 5/8" FIRE CODE GYPSUM BD.
- 9 5/8" EXTERIOR GYPSUM SHEATING
- RESILIENT CHANNELS @ 24" O.C. VERTICALLY
- (11) 1/2" CEMENT BD.
- (12) EXTERIOR METAL PANELS PRE FINISHED
- 13 1/2" PERMA BASE CEMENT BD
- (14) 7/8" HAT CHANNELS
- MINERAL WALL SOUND INSULATION
- 16 R19 THERMAL BATT INSULATION
- FLUID APPLIED VAPOR BARRIER
- (18) GRANITE VENEER PANELS
- CEMENT PLASTER SYSTEM RE: SPECIFICATIONS
- 20 5/8" AIRSPACE
- EXPOSED CAST IN PLACE CONCRETE
- PRECAST CONCRETE WALL SYSTEM
- SHAFTWALL SYSTEM RE: LIFE SAFETY PLANS FOR RATING
- (24) CEMENT PLASTER
- 25 8" CMU
- 26 6" CMU
- SILOXANE WATER REPELLENT
- METAL DECKING /
  CONCRETE SLAB OR PT
  SLAB
- SEE STRUCTURAL DRAWINGS FOR STRUCTURAL GROUT, RESTELL, BRANDER REQ., AND JOINT SIZING
- (30) TV MOUNTING PADS
- **⟨**31**⟩** TV
- 32 STRUCTURE PER PLAN
- SPRAY APPLIED FIRE PROOFING
- (34) 5/8" RESILIENT SOUND CLIPS
- 25 GA 3-5/8" MTL STUDS @ 24" O.C.
- 36 SLOTTED TOP TRACK
- 37 SLOTTED BOTTOM TRACK
- (38) FIRE CAULK / ACOUSTICAL
- CAST IN PLACE CONCRETE WALL
- 40 INSULATION
- (41) STRUCTURAL STEEL BEAM
- 5/8" CEMENT BOARD 4' HIGH
- 43 1-5/8" METAL STUD 20 GA.
- 44 2-1/2" METAL STUD 20 GA.
- COLUMN, WALL, OR OTHER SOLID CONTINUOUS SURFACE
- 46 1 LAYER OF 1" GYPSUM BD.
- 47 12" CMU
- 4" HIGH CIP CONCRETE CURB
- (49) 8" CMU SOLID FILL GROUT
- 50 13.5" AIRSPACE
- 51 6 3/8" AIRSPACE

PLLC 189 Maple Ridge Drive Metairie, LA 70001 (504)-885-4477 central@hbsaii.com :-: hbsaii.com

SINCE 1961

1031 CANAL STREET NEW ORLEANS, LOUISIANA

BEEN PREPARED BY ME OR UNDER MY CLOSE PERSONAL SUPERVISION AND TO THE BEST OF MY KNOWLEDGE AND CERTIFIED CORRECT




EITHER WHOLLY OR IN PART, OR MADE PUBLIC IN ANY MANNER WITHOUT THE WRITTEN CONSENT OF HBSA II ARCHITECT A PROFESSIONAL L.L.C. ALL RIGHTS OF DESIGN OR INVENTION ARE RESERVED AND WILL REMAIN THE SOLE PROPERTY OF HBSA II ARCHITECTS A PROFESSIONAL L.L.C.


|                            | R                          | EVIS                       | NOI                        | HIS                        | TOR                         | Υ                          |  |
|----------------------------|----------------------------|----------------------------|----------------------------|----------------------------|-----------------------------|----------------------------|--|
| 4/27/2018                  | 5/4/2018                   | 5/11/2018                  | 5/18/2018                  | 5/25/2018                  | 6/1/2018                    | 6/8/2018                   |  |
|                            |                            |                            |                            |                            |                             |                            |  |
|                            |                            |                            |                            |                            |                             |                            |  |
|                            |                            | _                          | _                          |                            |                             |                            |  |
| I.S. #2 - CLOUD REVISION 1 | I.S. #2 - CLOUD REVISION 2 | I.S. #2 - CLOUD REVISION 3 | I.S. #2 - CLOUD REVISION 4 | I.S. #2 - CLOUD REVISION 5 | .I.S. #2 - CLOUD REVISION 6 | I.S. #2 - CLOUD REVISION 7 |  |
| - CLOUD F                   | - CLOUD F                  |  |
| .I.S. #2                    | .I.S. #2                   |  |

- N W 4 N W V W PARTITION TYPES

PROJECT#: 1709 PHASE: DD TEAM: Author CHECKER: Checker SCALE: AS NOTED

ISSUED: 4/20<u>/20</u>18

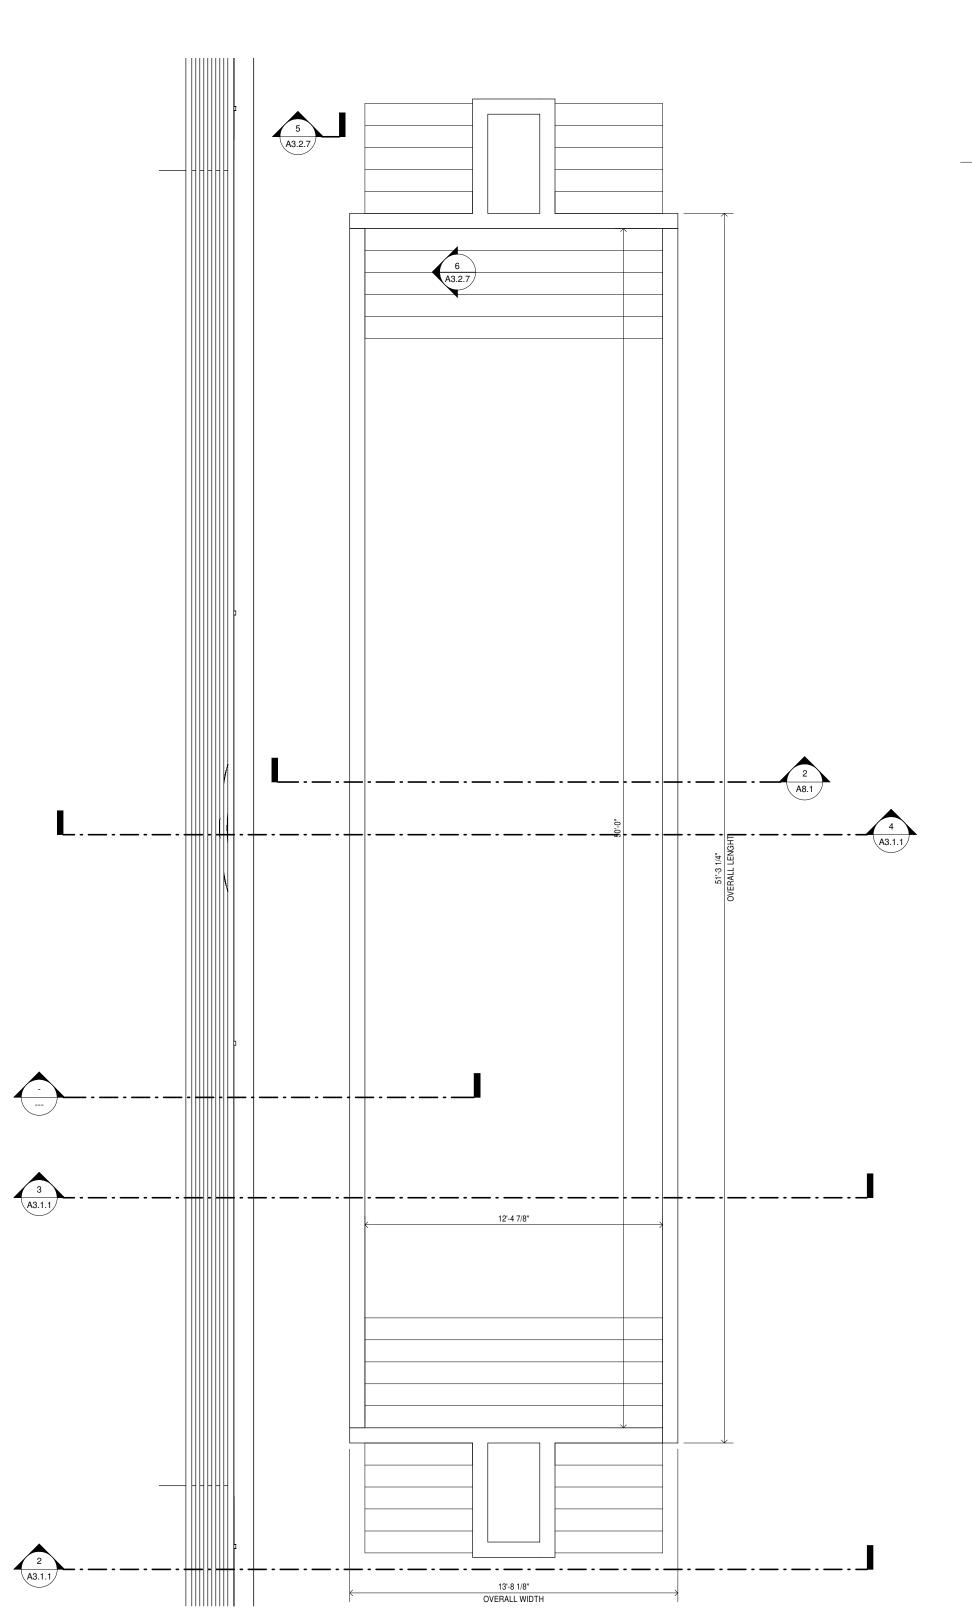

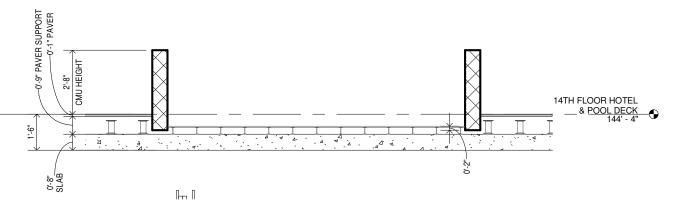

2 SECTION AT POOL
SCALE: 1/4" = 1'-0"

14TH FLOOR PRIVATE POOL-ENLARGED PLAN
SCALE: 1/4" = 1'-0"

HARRY
BAKER
SMITH
SMITH
ARCHITECTS II
P L C

189 Maple Ridge Drive Metairie, LA 70001
(504)-885-4477
central@hbsaii.com :: hbsaii.com
SINCE 1961

HARD ROCK HOTE

1031 CANAL STREET

NEW ORLEANS, LOUISIANA

THESE PLANS AND SPECIFICATIONS HAVE
BEEN PREPARED BY ME OR UNDER MY
CLOSE PERSONAL SUPERVISION AND TO
THE BEST OF MY KNOWLEDGE AND
BELIEF THEY COMPLY WITH ALL CITY,
STATE AND FEDERAL REQUIREMENTS, AND
I AM NOT PROVIDING CONTRACT
ADMINISTRATION.

CERTIFIED CORRECT




THIS DRAWING IS CONFIDENTIAL AND
NOT BE LOANED, REPRODUCED, COPIED,
EITHER WHOLLY OR IN PART, OR MADE
PUBLIC IN ANY MANNER WITHOUT THE
WRITTEN CONSENT OF HBSA II ARCHITECTS,
A PROFESSIONAL L.L.C. ALL RIGHTS OF
DESIGN OR INVENTION ARE RESERVED AND
WILL REMAIN THE SOLE PROPERTY OF HBSA

| 1 L.I.S. #2 - CLOUD REVISION 1 2 L.I.S. #2 - CLOUD REVISION 2 3 L.I.S. #2 - CLOUD REVISION 3 4 L.I.S. #2 - CLOUD REVISION 4 5 L.I.S. #2 - CLOUD REVISION 5 6 L.I.S. #2 - CLOUD REVISION 6 6 L.I.S. #2 - CLOUD REVISION 6 7 L.I.S. #2 - CLOUD REVISION 7 66/1/2018 8 | II AR                        | CHITE                        |                              |                              |                              | SIONA                        |                              |    |
|---|------------------------------|------------------------------|------------------------------|------------------------------|------------------------------|------------------------------|------------------------------|----|
| L.I.S. #2 - CLOUD REVISION 1 L.I.S. #2 - CLOUD REVISION 2 L.I.S. #2 - CLOUD REVISION 3 L.I.S. #2 - CLOUD REVISION 4 L.I.S. #2 - CLOUD REVISION 6 L.I.S. #2 - CLOUD REVISION 6 L.I.S. #2 - CLOUD REVISION 7  |                              | K                            | EVIS                         | ION                          | HIS                          | IOR                          | Y .                          |    |
|   | 4/27/2018                    | 5/4/2018                     | 5/11/2018                    | 5/18/2018                    | 5/25/2018                    | 6/1/2018                     | 6/8/2018                     |    |
| - α σ 4 ω σ ν ω   | L.I.S. #2 - CLOUD REVISION 1 | L.I.S. #2 - CLOUD REVISION 2 | L.I.S. #2 - CLOUD REVISION 3 | L.I.S. #2 - CLOUD REVISION 4 | L.I.S. #2 - CLOUD REVISION 5 | L.i.S. #2 - CLOUD REVISION 6 | L.i.S. #2 - CLOUD REVISION 7 |    |
|   | -                            | 5                            | က                            | 4                            | 22                           | 9                            | 7                            | 80 |

PRIVATE POOL LEVEL 14

PROJECT#: 1709
PHASE: DD
TEAM: Author
CHECKER: Checker
SCALE: AS NOTED
ISSUED: 4/20/2018

A8 1

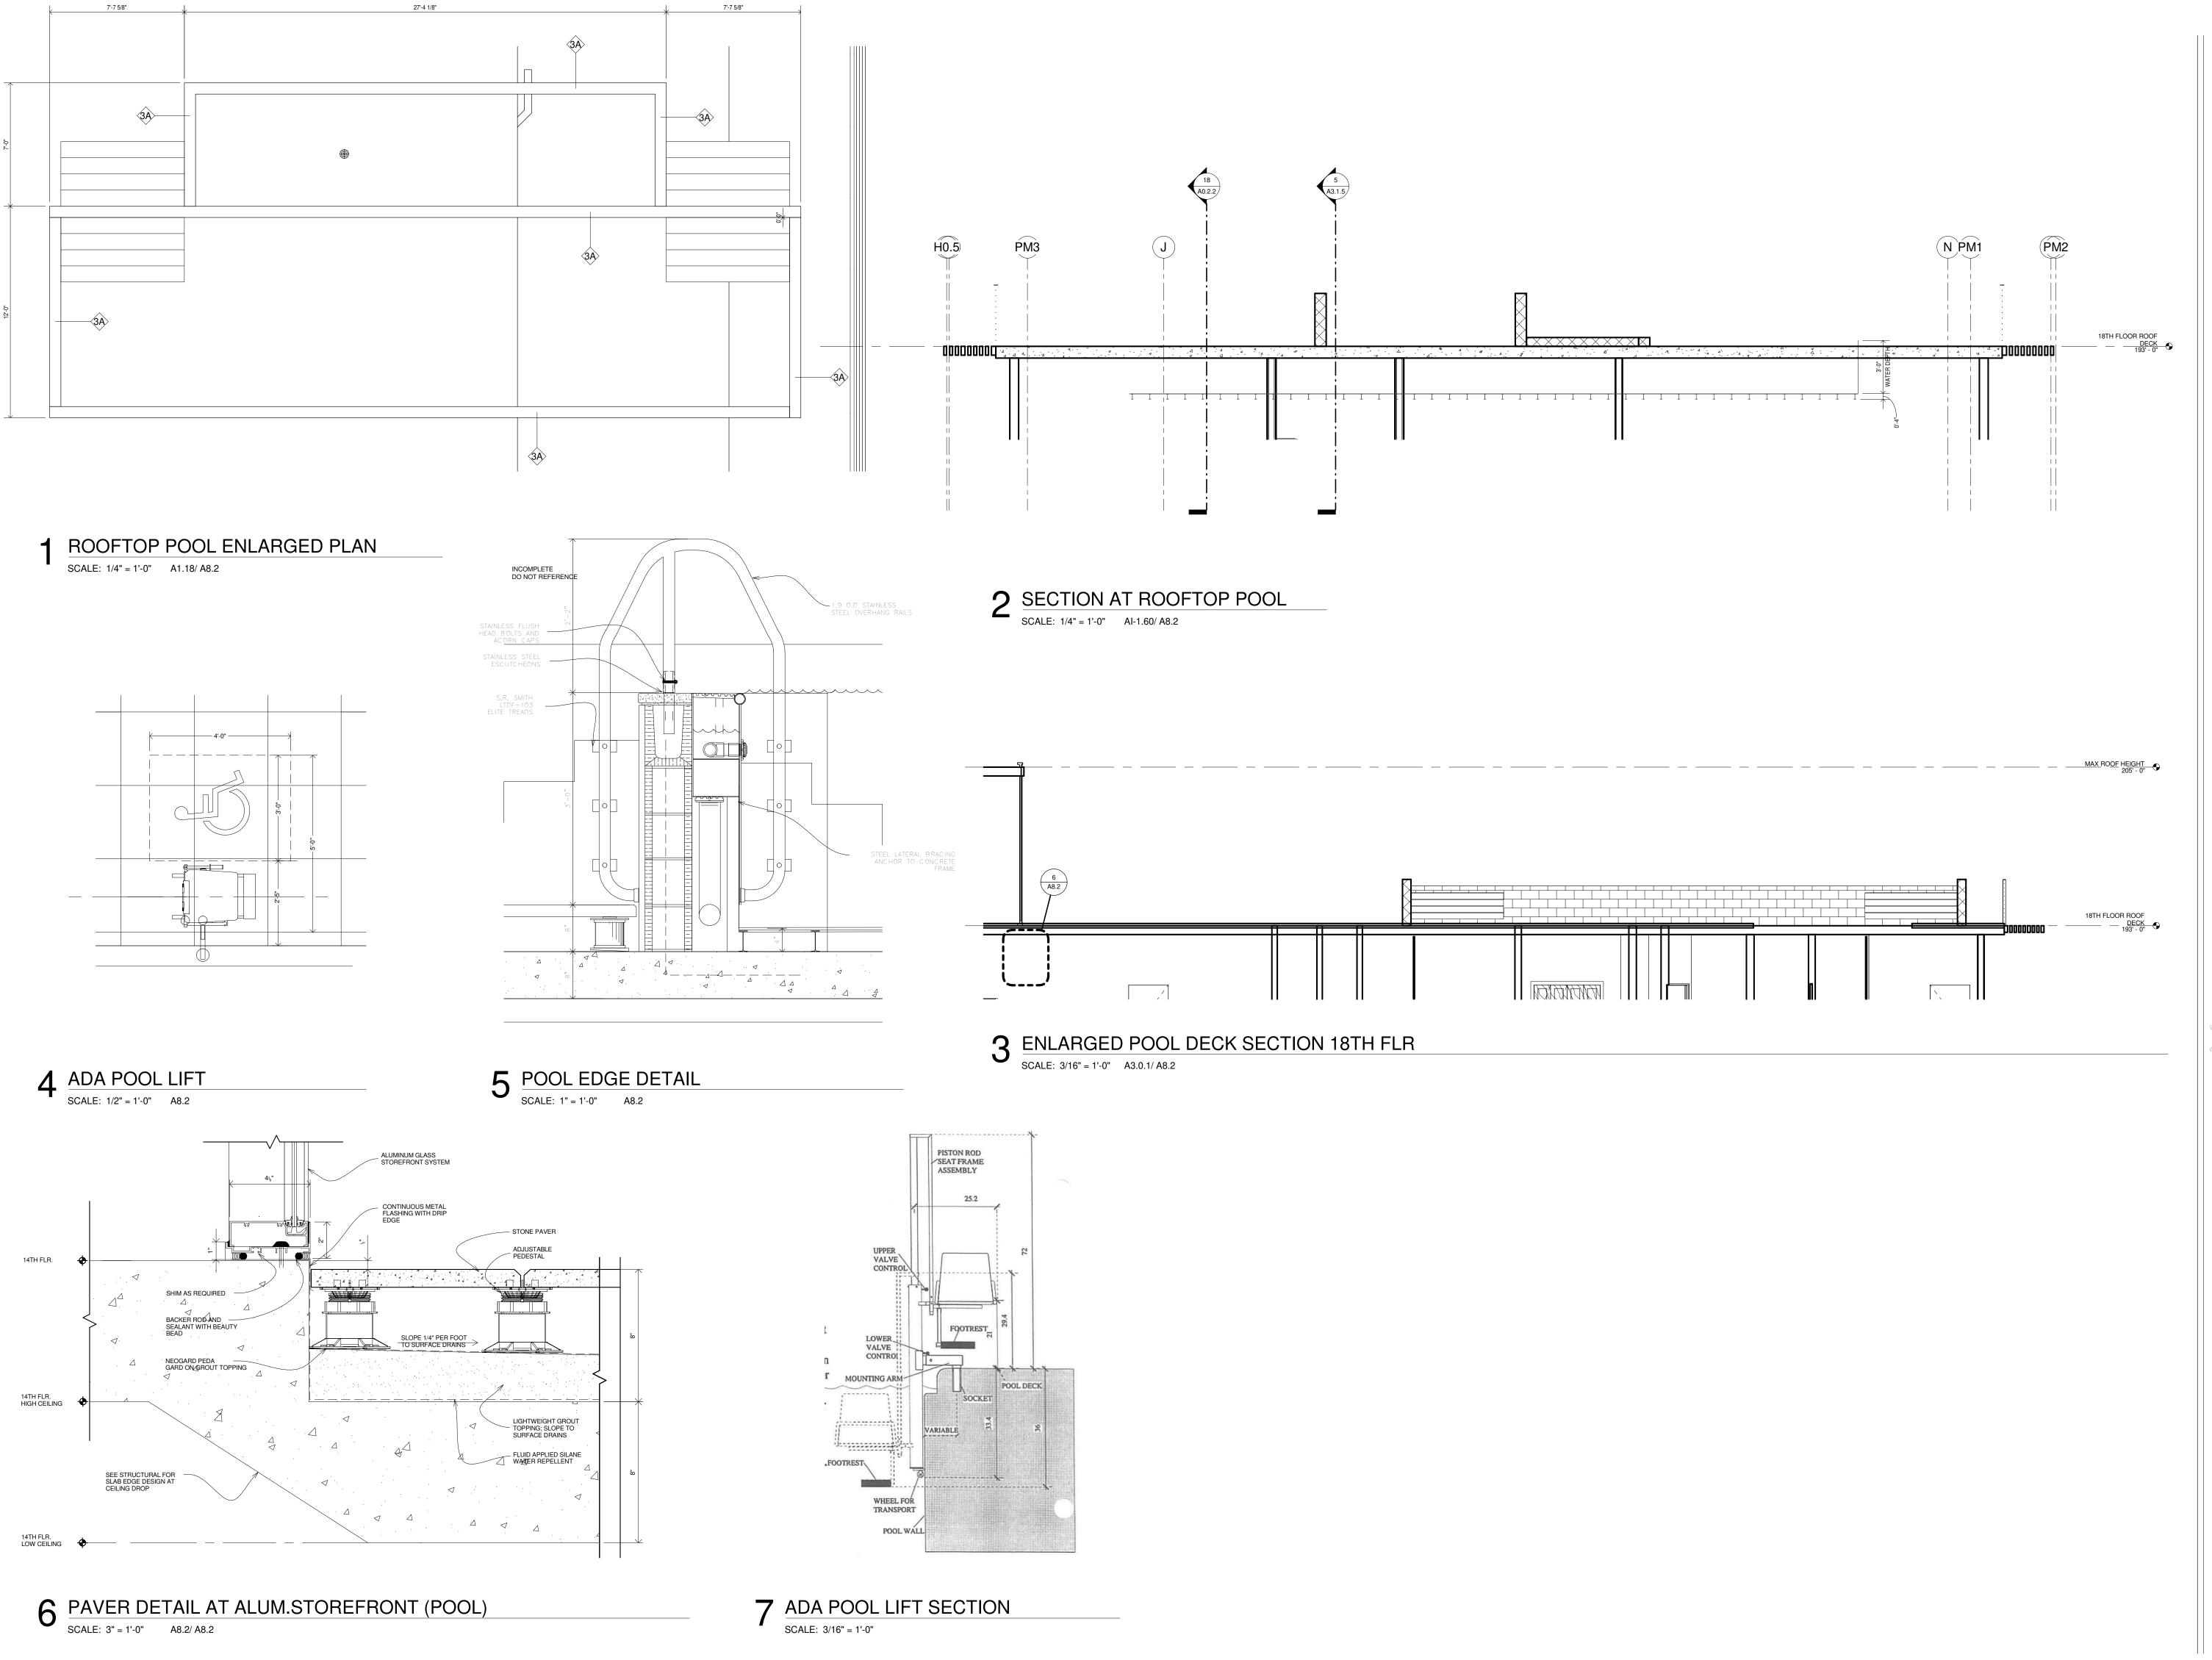

HARRY
BAKER
SMITH
SMITH
ARCHITECTS II
P 1 t c

189 Maple Ridge Drive Metairie, LA 70001
(504)-885-4477
central@hbsail.com :: hbsail.com
SINCE 1961

RD ROCK HOTEL

1031 CANAL STREET


NEW ORLEANS, LOUISIANA

THESE PLANS AND SPECIFICATIONS HAVE BEEN PREPARED BY ME OR UNDER MY CLOSE PERSONAL SUPERVISION AND TO THE BEST OF MY KNOWLEDGE AND BELIEF THEY COMPLY WITH ALL CITY, STATE AND FEDERAL REQUIREMENTS, AND I AM NOT PROVIDING CONTRACT ADMINISTRATION.

CERTIFIED CORRECT



THIS DRAWING IS CONFIDENTIAL AND
NOT BE LOANED, REPRODUCED, COPIED,
EITHER WHOLLY OR IN PART, OR MADE
PUBLIC IN ANY MANNER WITHOUT THE
WRITTEN CONSENT OF HBSA II ARCHITECT:
A PROFESSIONAL L.L.C. ALL RIGHTS OF
DESIGN OR INVENTION ARE RESERVED AND
WILL REMAIN THE SOLE PROPERTY OF HBS

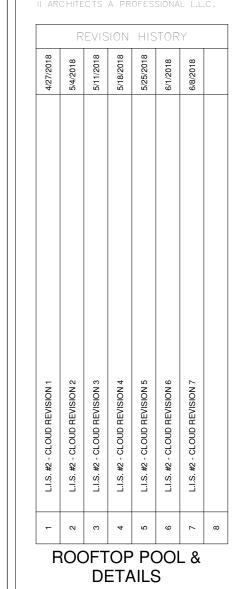


PROJECT#: 1709
PHASE: DD
TEAM: Author
CHECKER: Checker

SCALE: AS NOTED

Δ8 2

ISSUED: 4/20/2018

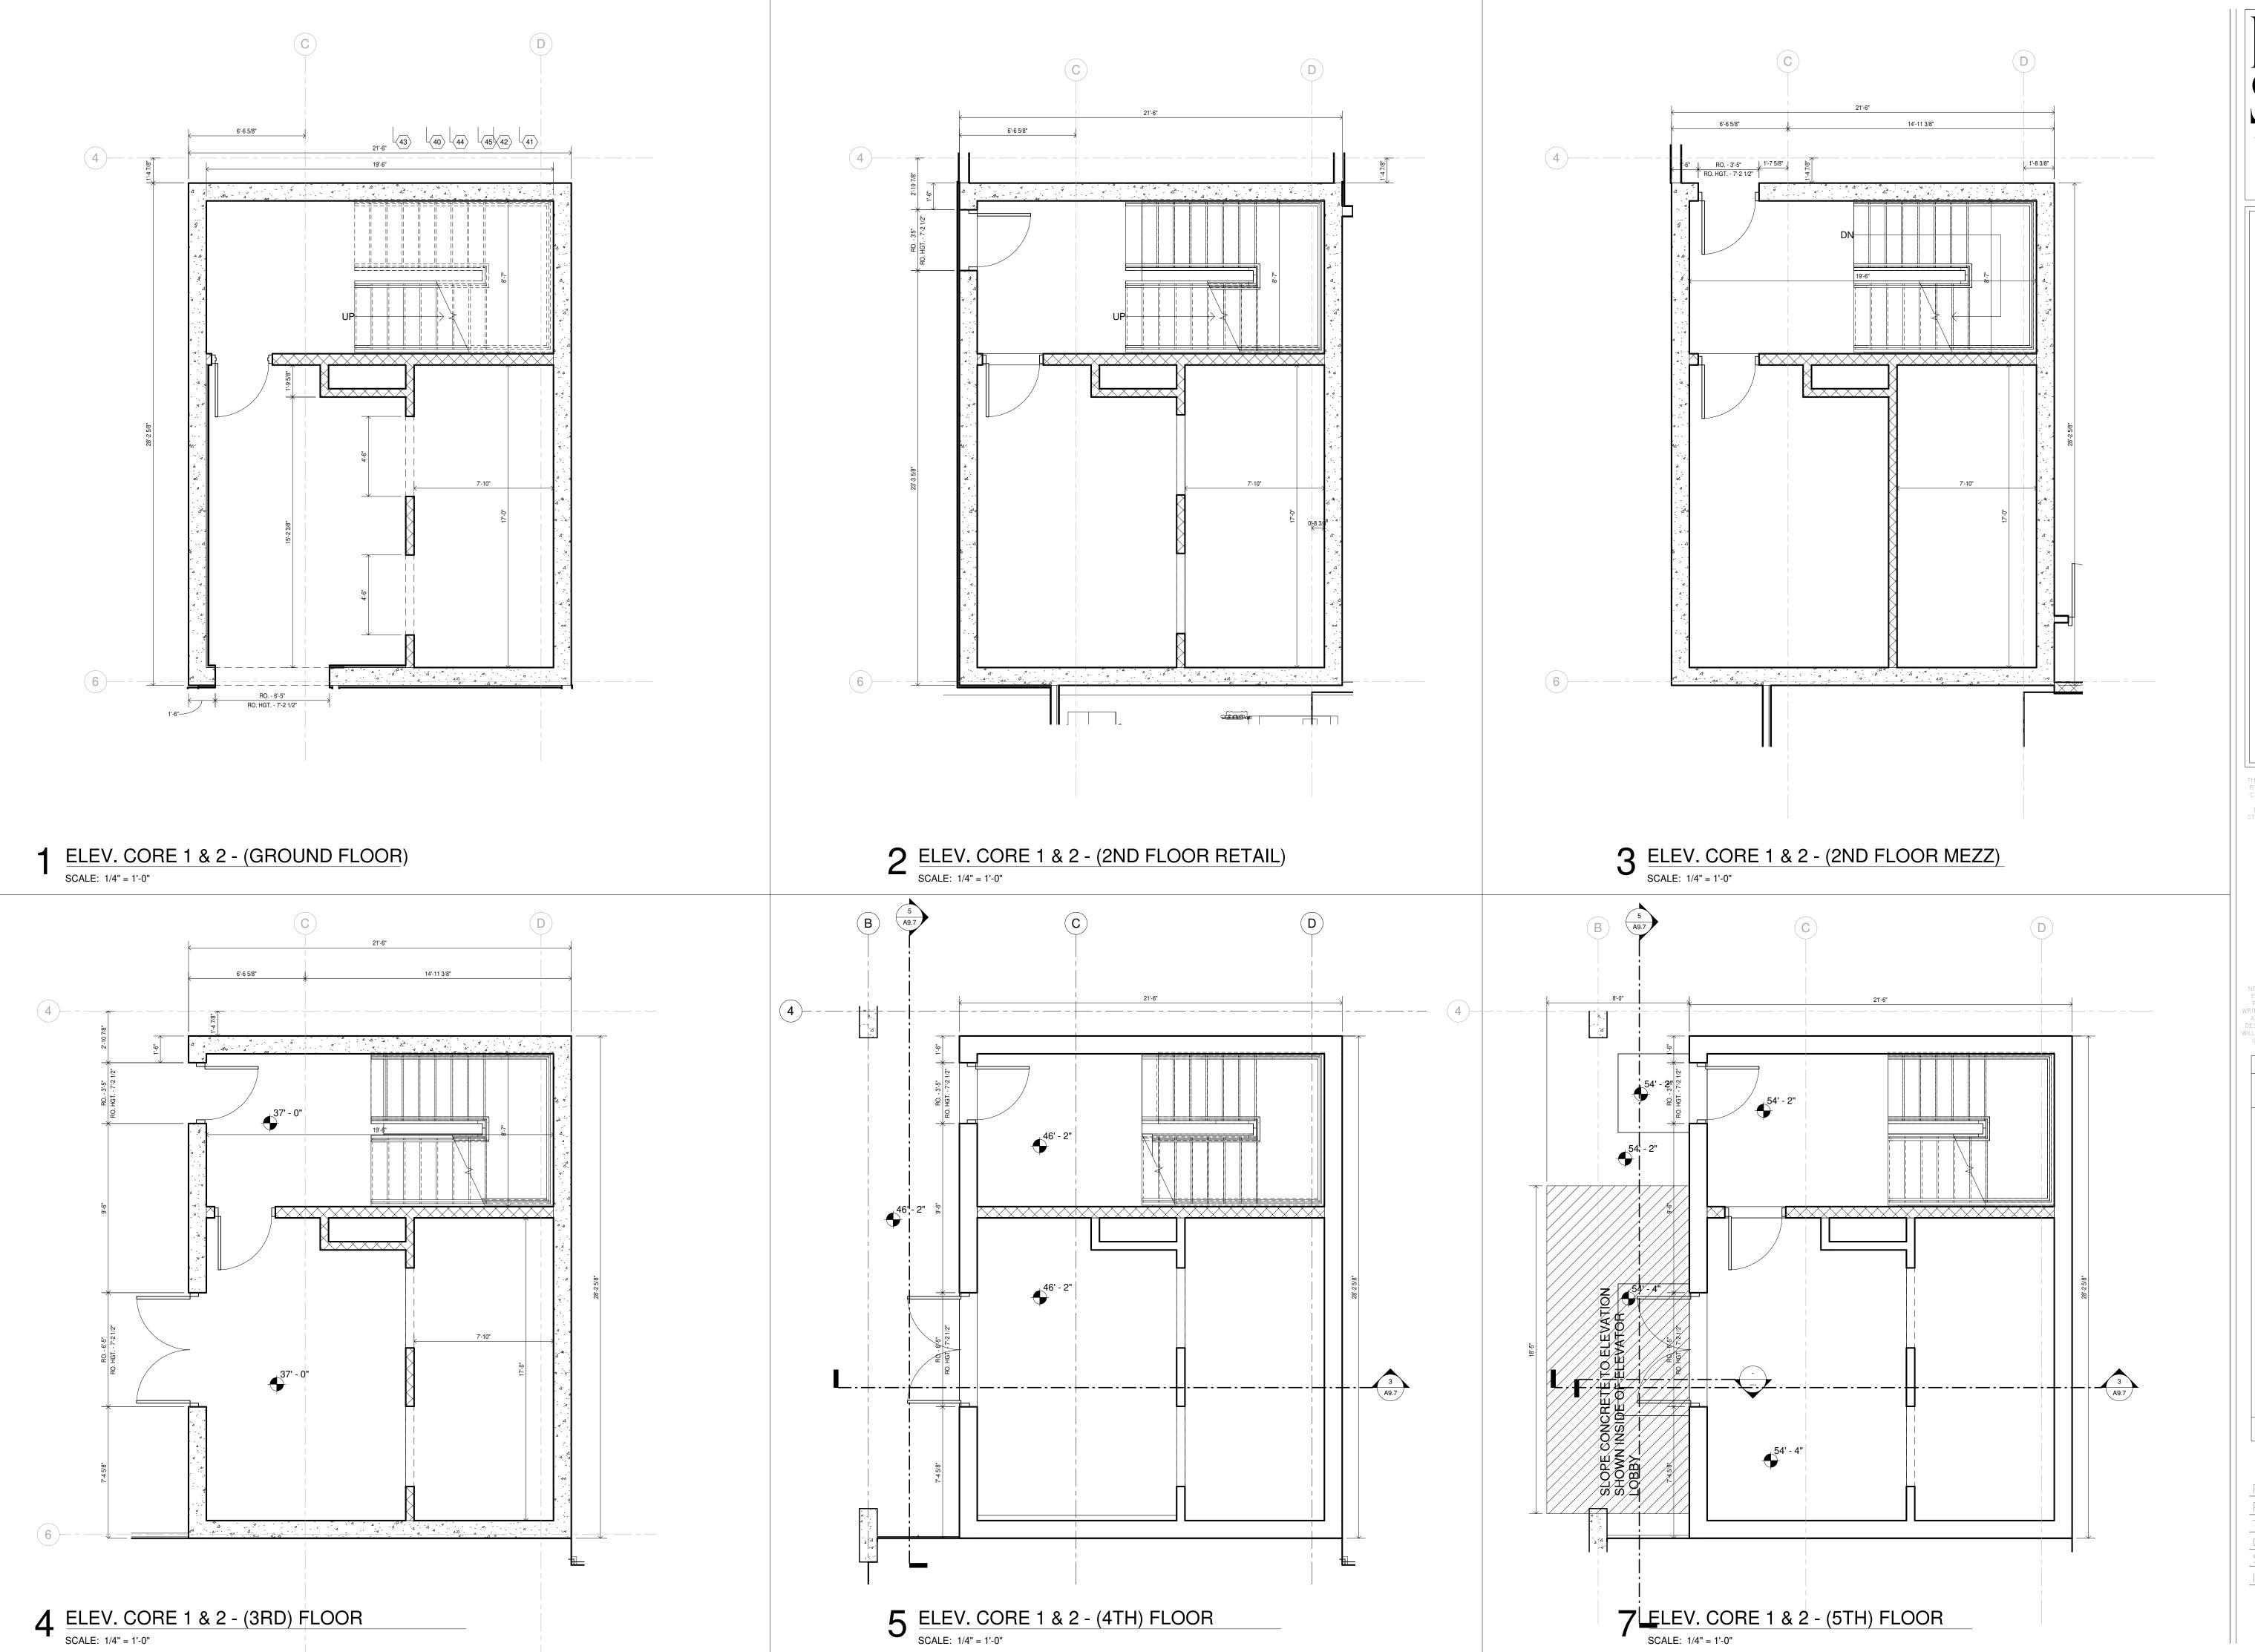

HARRY
BAKER
SMITH
SMITH
SMITH
ARCHITECTS II
P L C

189 Maple Ridge Drive Metairie, LA 70001
(504)-885-4477
central@hbsaii.com :: hbsaii.com
SINCE 1961

RD ROCK HOTEL

1031 CANAL STREET
NEW ORLEANS, LOUISIANA

THESE PLANS AND SPECIFICATIONS HAVE BEEN PREPARED BY ME OR UNDER MY CLOSE PERSONAL SUPERVISION AND TO THE BEST OF MY KNOWLEDGE AND BELIEF THEY COMPLY WITH ALL CITY, STATE AND FEDERAL REQUIREMENTS, AND I AM NOT PROVIDING CONTRACT ADMINISTRATION.

CERTIFIED CORRECT



THIS DRAWING IS CONFIDENTIAL AND NOT BE LOANED, REPRODUCED, COPIED, EITHER WHOLLY OR IN PART, OR MADE PUBLIC IN ANY MANNER WITHOUT THE WRITTEN CONSENT OF HBSA II ARCHITECTS, A PROFESSIONAL L.L.C. ALL RIGHTS OF DESIGN OR INVENTION ARE RESERVED AND WILL REMAIN THE SOLE PROPERTY OF HBSA II ARCHITECTS A PROFESSIONAL L.L.C.

ENLARGED SERVICE CORE

PROJECT#: 1709

PHASE: DD

TEAM: Author

PHASE: DD


TEAM: Author


CHECKER: Checker


SCALE: AS NOTED

ISSUED: 4/20/2018


A9.0

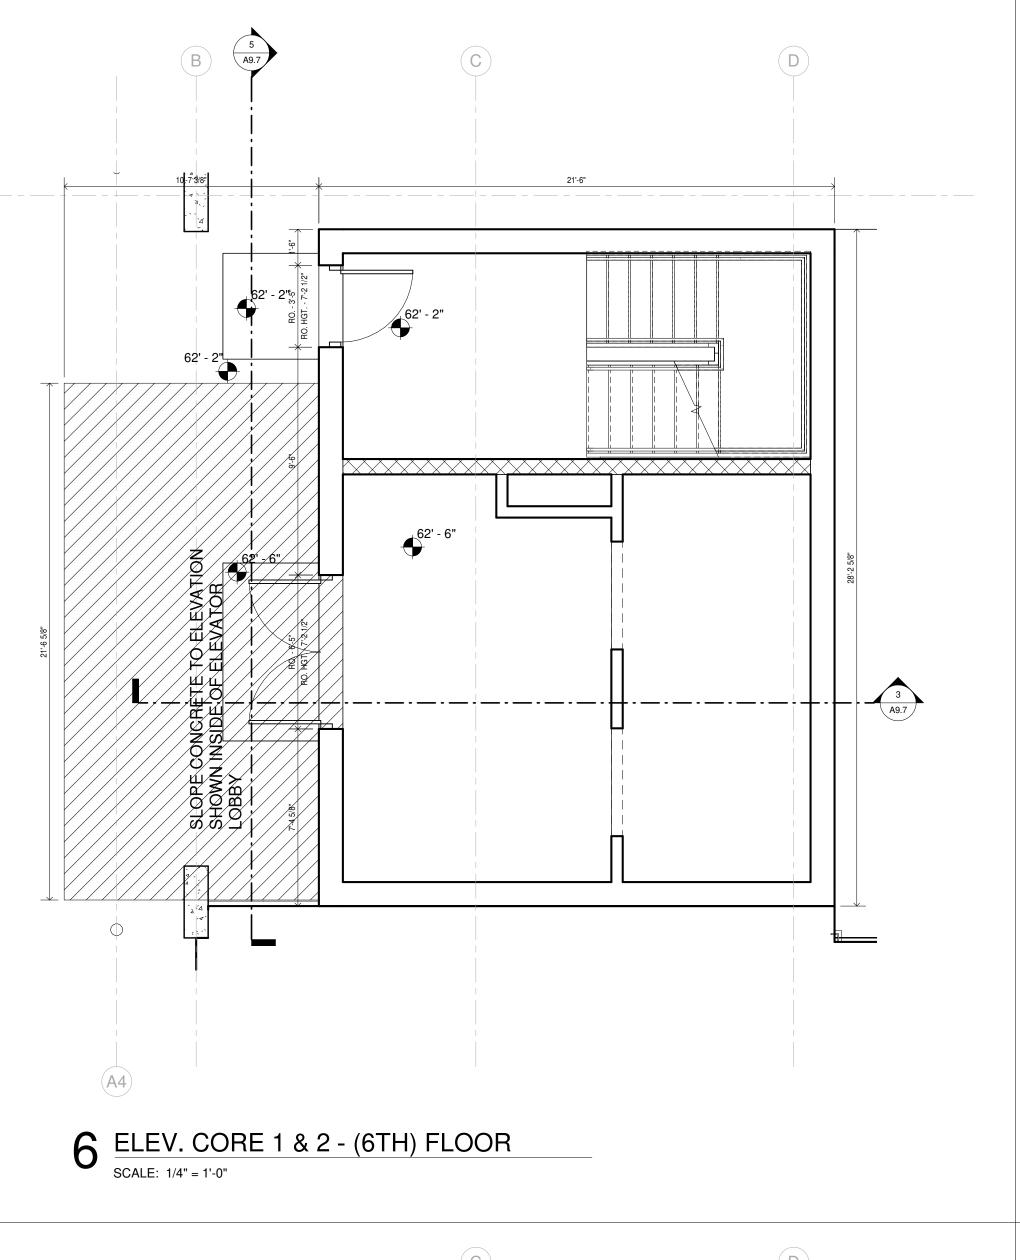


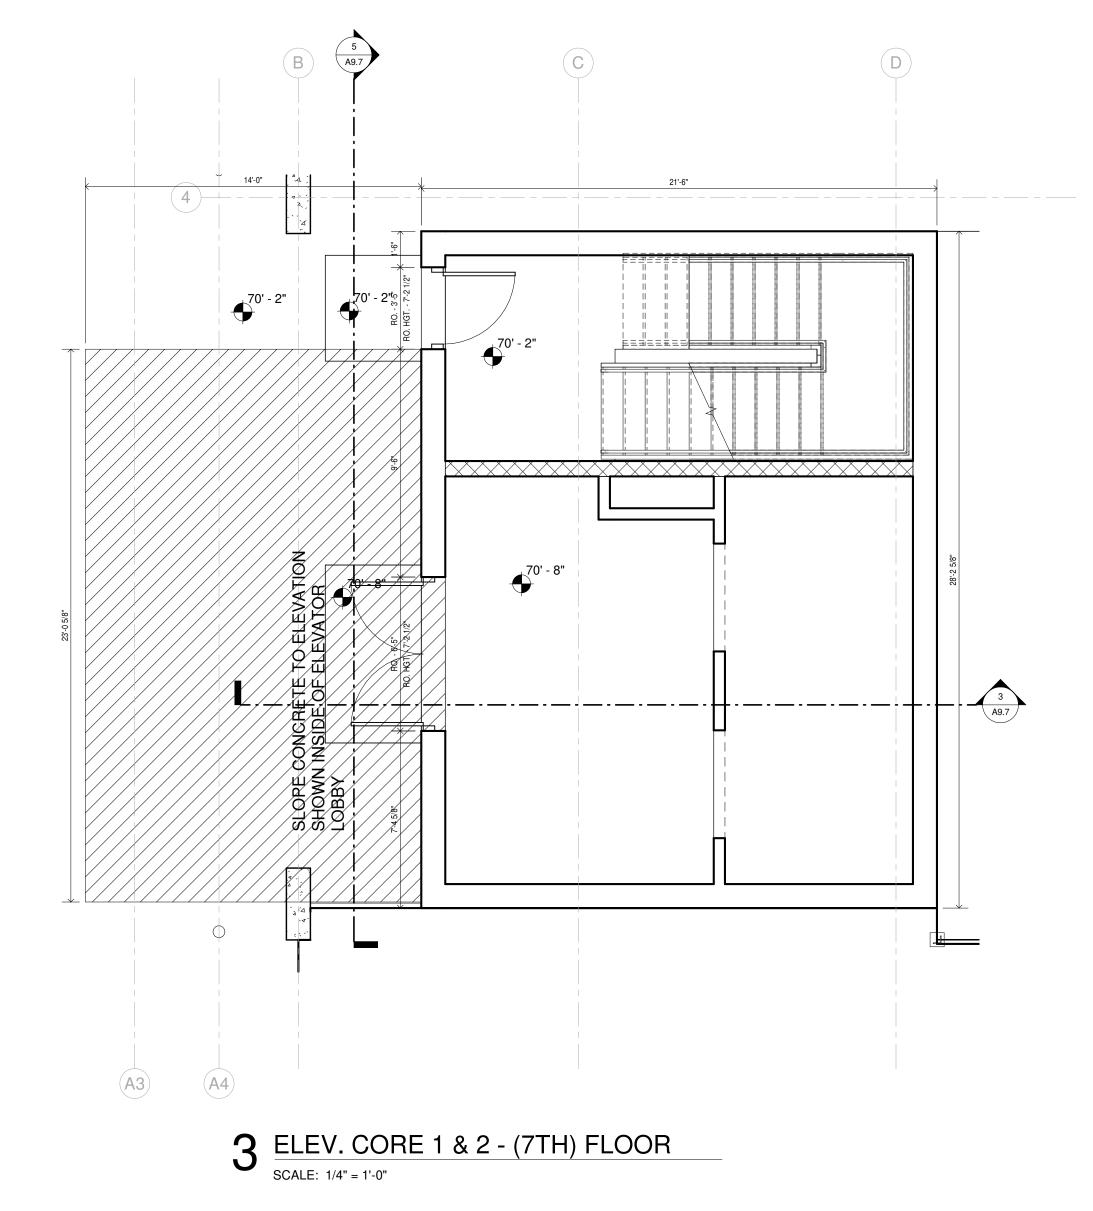

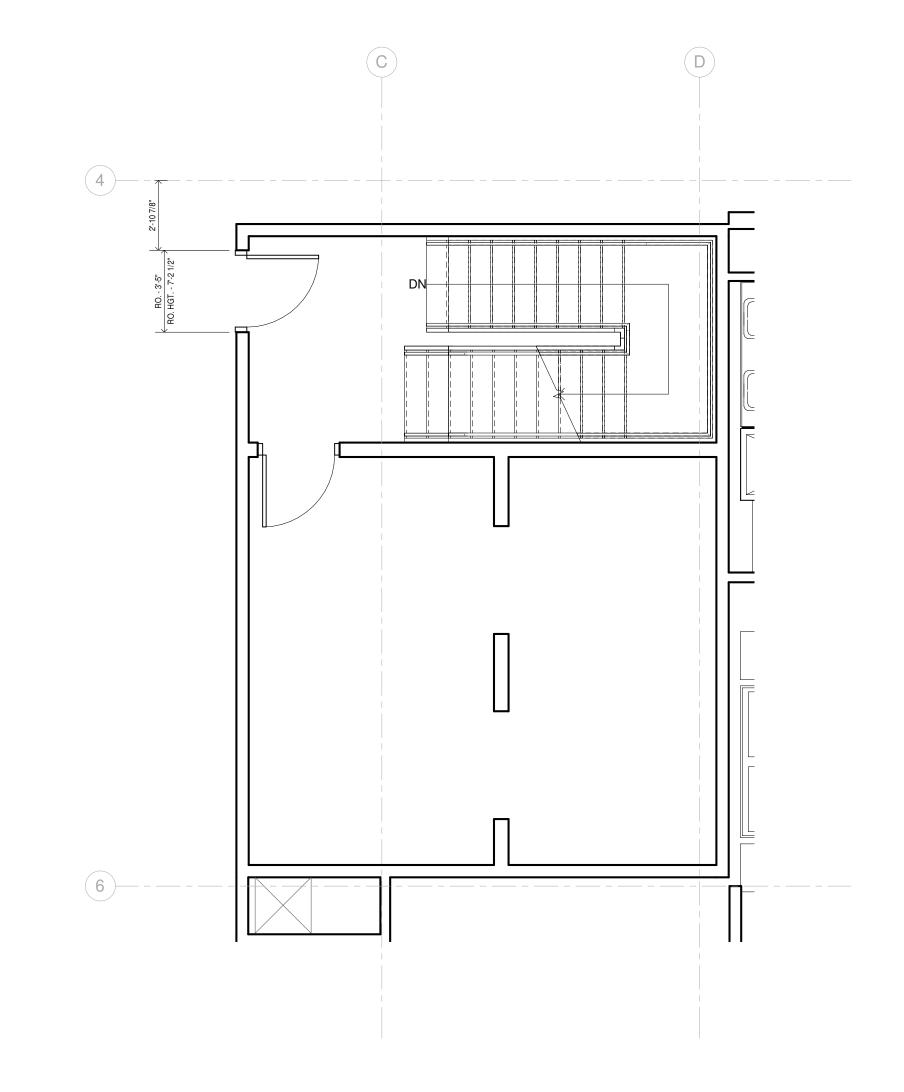

4 ELEV. CORE 1 & 2 - (8TH THRU. 13TH) FLOOR

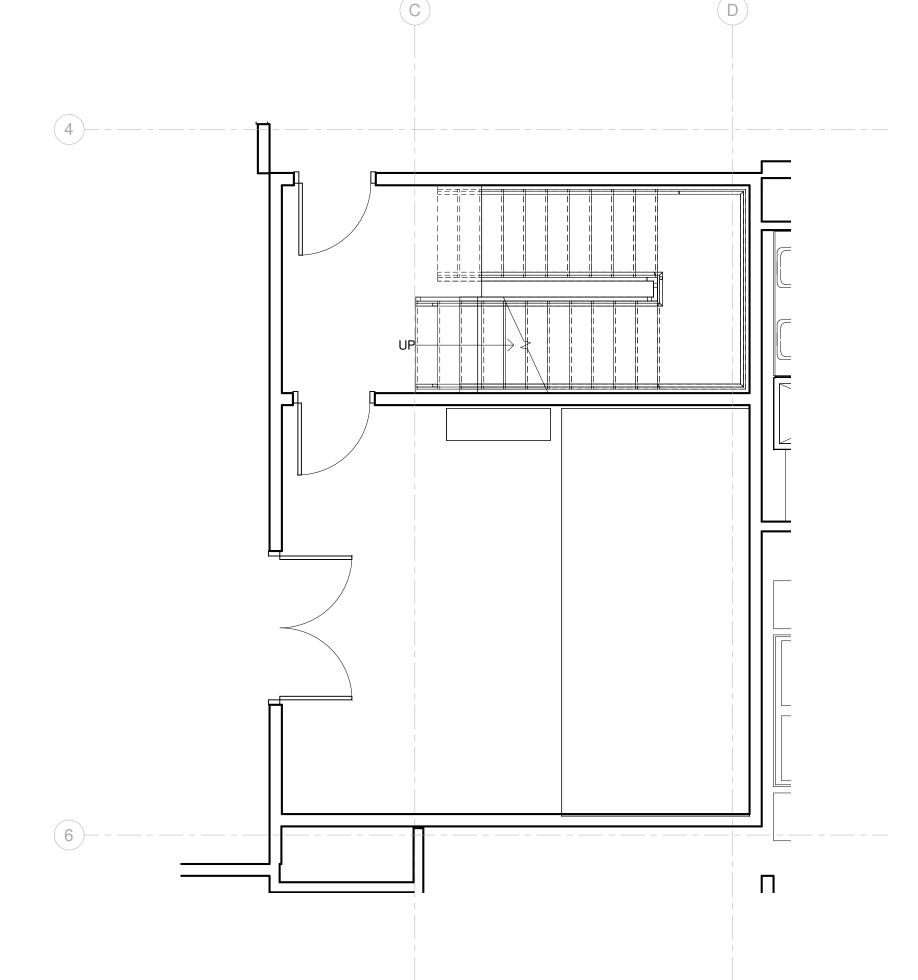

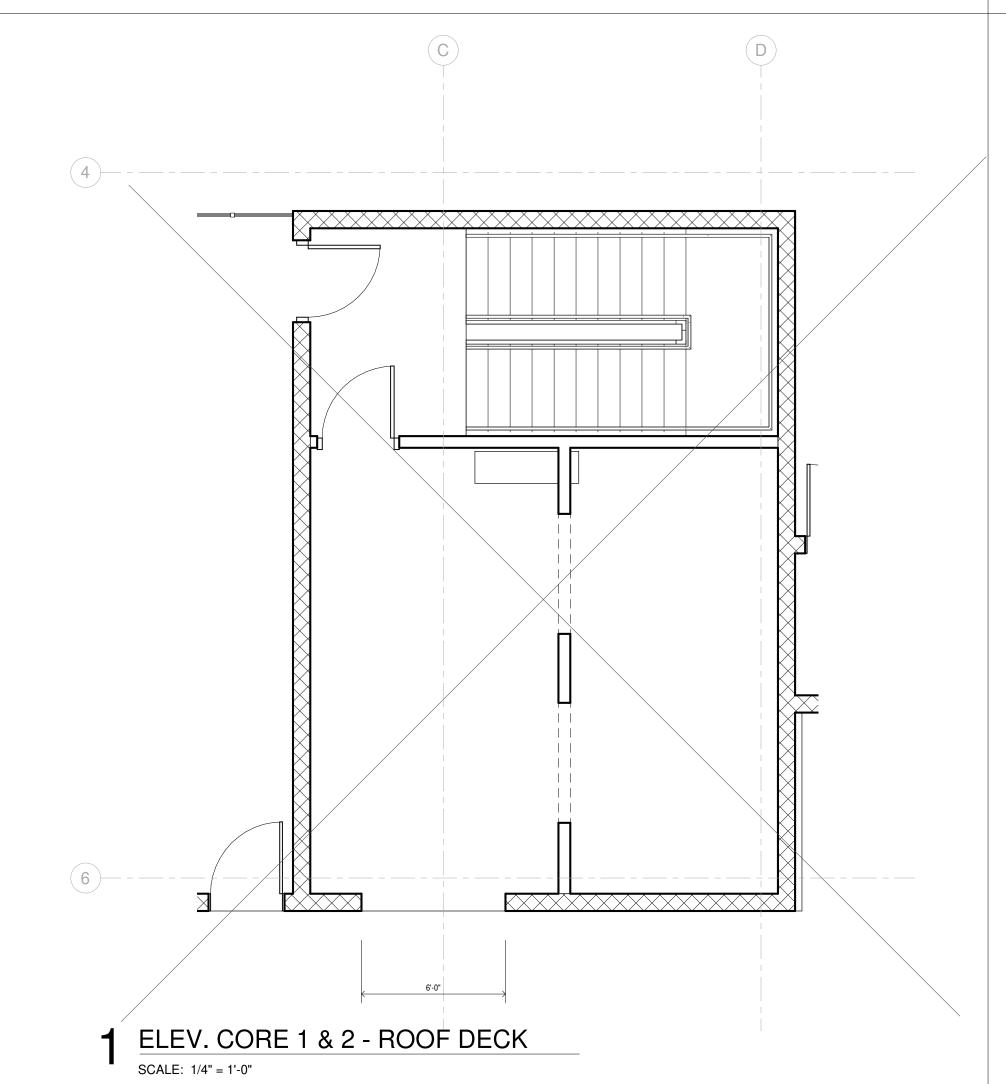



LI.S. #2 - CLOUD REVISION 1

LI.S. #2 - CLOUD REVISION 2

LI.S. #2 - CLOUD REVISION 2

LI.S. #2 - CLOUD REVISION 3

LI.S. #2 - CLOUD REVISION 4

LI.S. #2 - CLOUD REVISION 6

LI.S. #2 - CLOUD REVISION 6


LI.S. #2 - CLOUD REVISION 6


LI.S. #2 - CLOUD REVISION 7


SCALE: AS NOTED
ISSUED: 4/20/2018
SHEET#:


CHECKE<u>R: Check</u>er


PHASE: DD
TEAM: Author

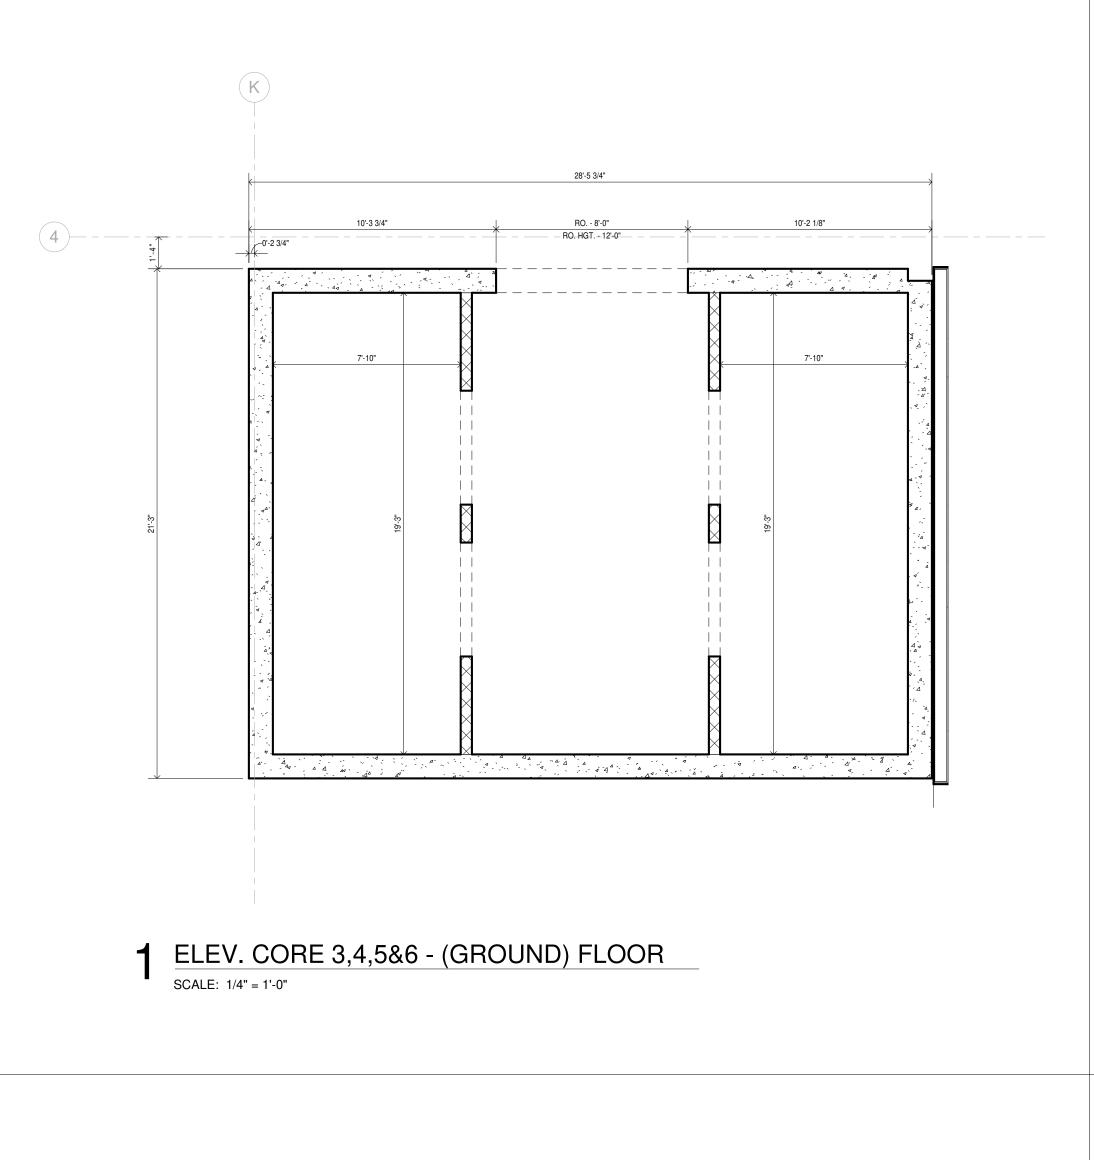

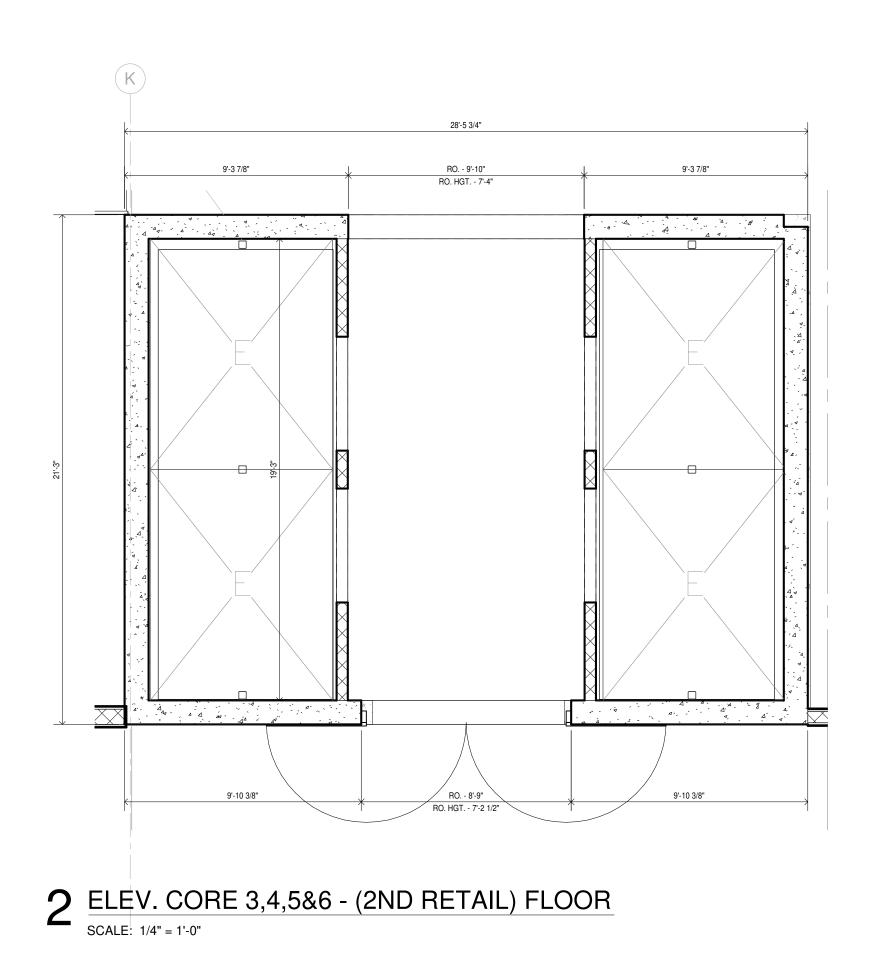


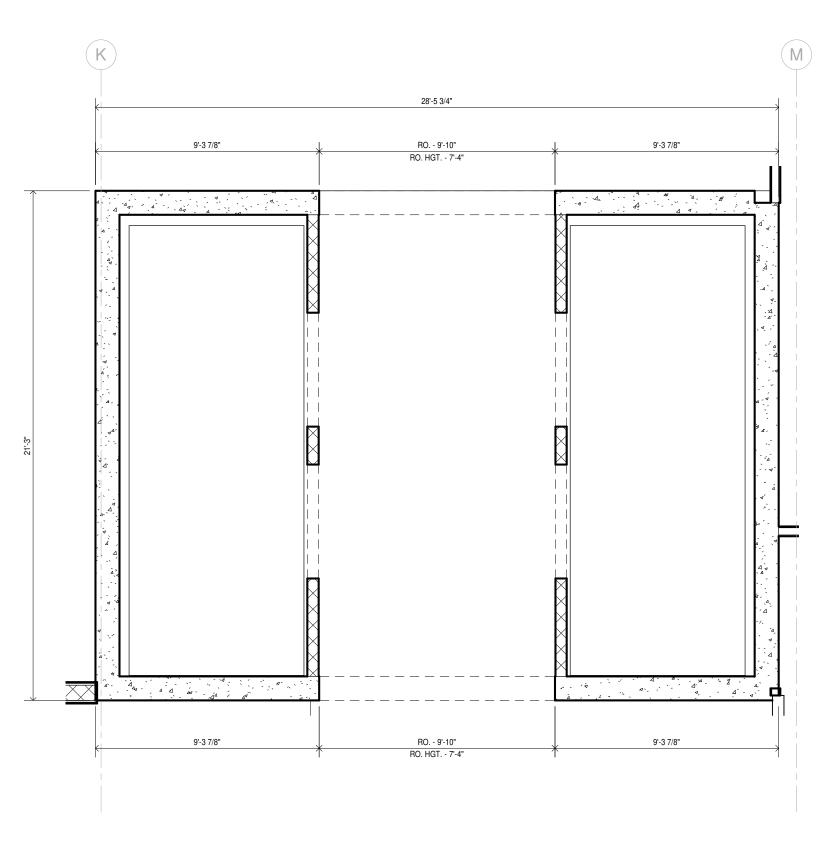

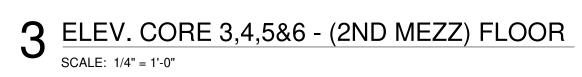


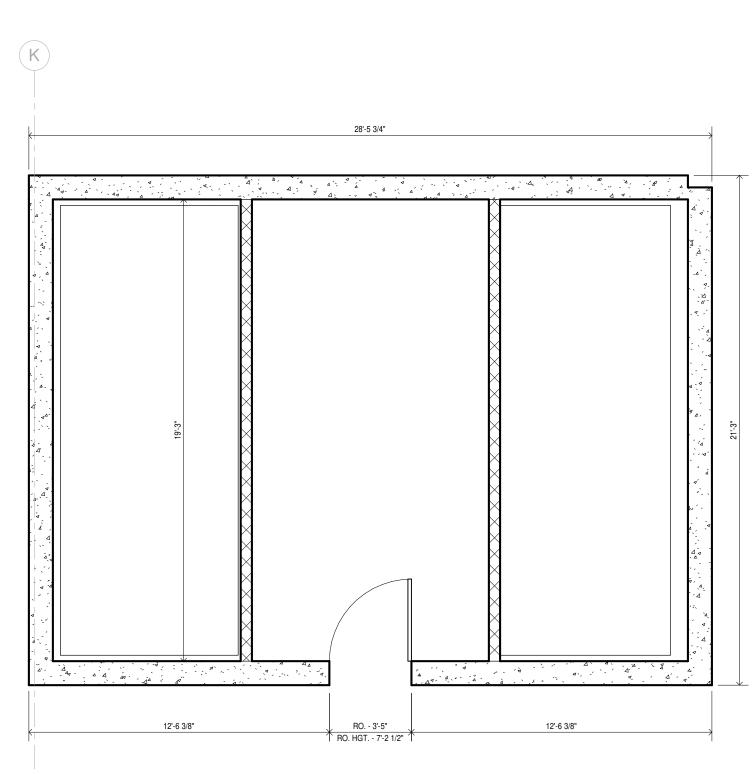

4 ELEV. CORE 3,4,5&6 - (3RD,4TH,6TH) FLOOR

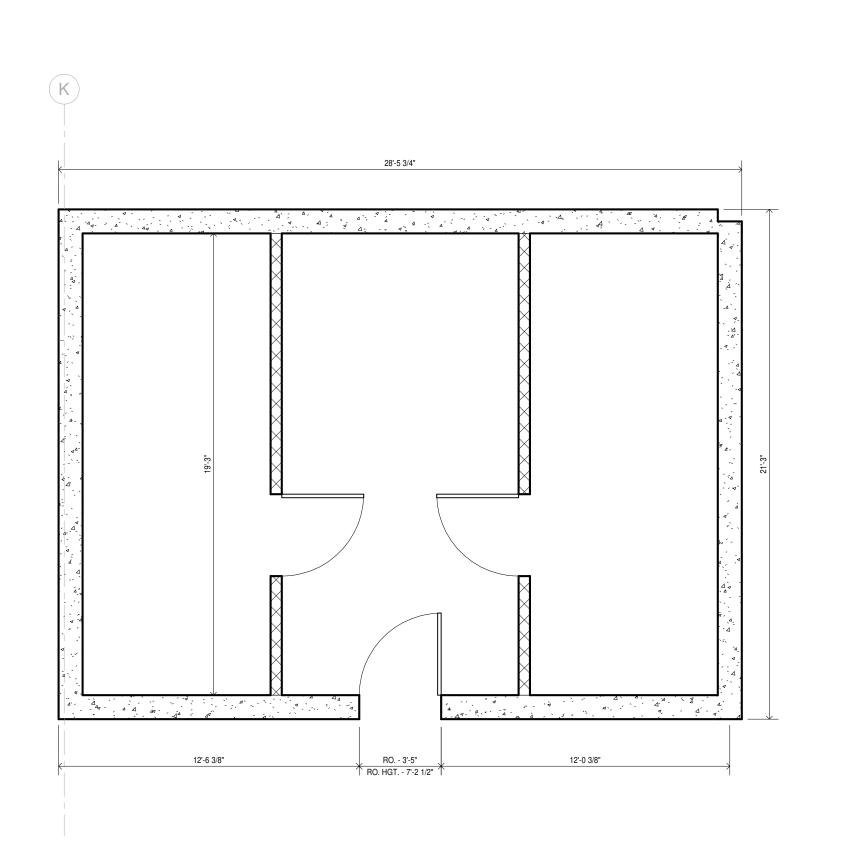

5 ELEV. CORE 3,4,5&6 - (5TH) FLOOR SCALE: 1/4" = 1'-0"

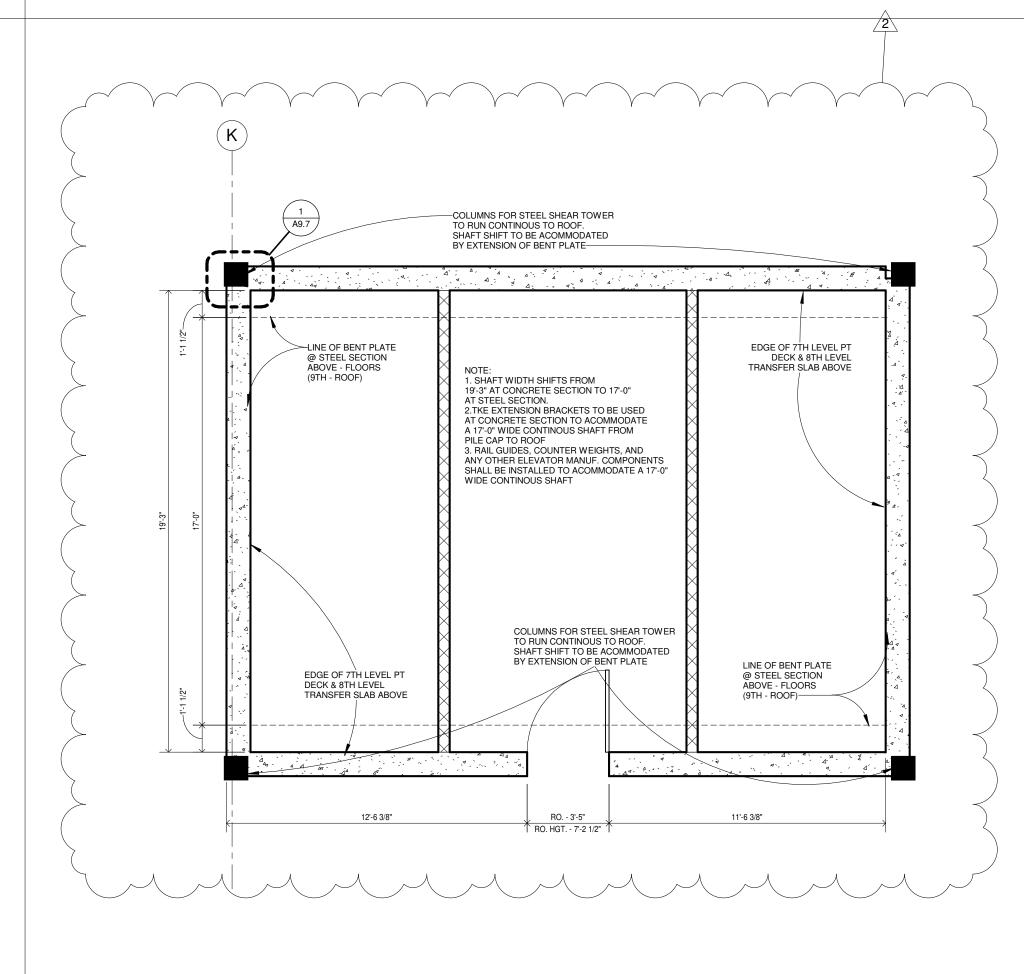

6 ELEV. CORE 3,4,5&6 - (7TH FLOOR)

SCALE: 1/4" = 1'-0"

HARRY
BAKER
SMITH
SMITH
ARCHITECTS II
P L C

189 Maple Ridge Drive Metairie, LA 70001
(504)-885-4477
central@hbsaii.com :: hbsaii.com
SINCE 1961

HARD ROCK HOTEL

1031 CANAL STREET

NEW ORLEANS, LOUISIANA

THE BEST OF MY KNOWLEDGE AND BELIEF THEY COMPLY WITH ALL CITY, ATE AND FEDERAL REQUIREMENTS, AND I AM NOT PROVIDING CONTRACT ADMINISTRATION.

CERTIFIED CORRECT


THIS DRAWING IS CONFIDENTIAL AND NOT BE LOANED, REPRODUCED, COPIED, EITHER WHOLLY OR IN PART, OR MADE PUBLIC IN ANY MANNER WITHOUT THE WRITTEN CONSENT OF HBSA II ARCHITECTS, A PROFESSIONAL L.L.C. ALL RIGHTS OF DESIGN OR INVENTION ARE RESERVED AND WILL REMAIN THE SOLE PROPERTY OF HBSA


|    | 6/8/2018                     | 6/1/2018 N                   | E/25/2018                    | 5/18/2018 |                              | O FOOT HIS   |  |
|----|------------------------------|------------------------------|------------------------------|-----------|------------------------------|--|--|
|    | L.I.S. #2 - CLOUD REVISION 7 | L.I.S. #2 - CLOUD REVISION 6 | L.I.S. #2 - CLOUD REVISION 5 |           | L.I.S. #2 - CLOUD REVISION 4 | L.I.S. #2 - CLOUD REVISION 3<br>L.I.S. #2 - CLOUD REVISION 4 | L.I.S. #2 - CLOUD REVISION 2 L.I.S. #2 - CLOUD REVISION 3 L.I.S. #2 - CLOUD REVISION 4 |
| 80 | 7                            | 9                            | 2                            |           | 4                            | ω 4  | α  |


PROJECT#: 1709
PHASE: DD
TEAM: Author
CHECKER: Checker


CHECKER: Checker SCALE: AS NOTED ISSUED: 4/20/2018

A9 2

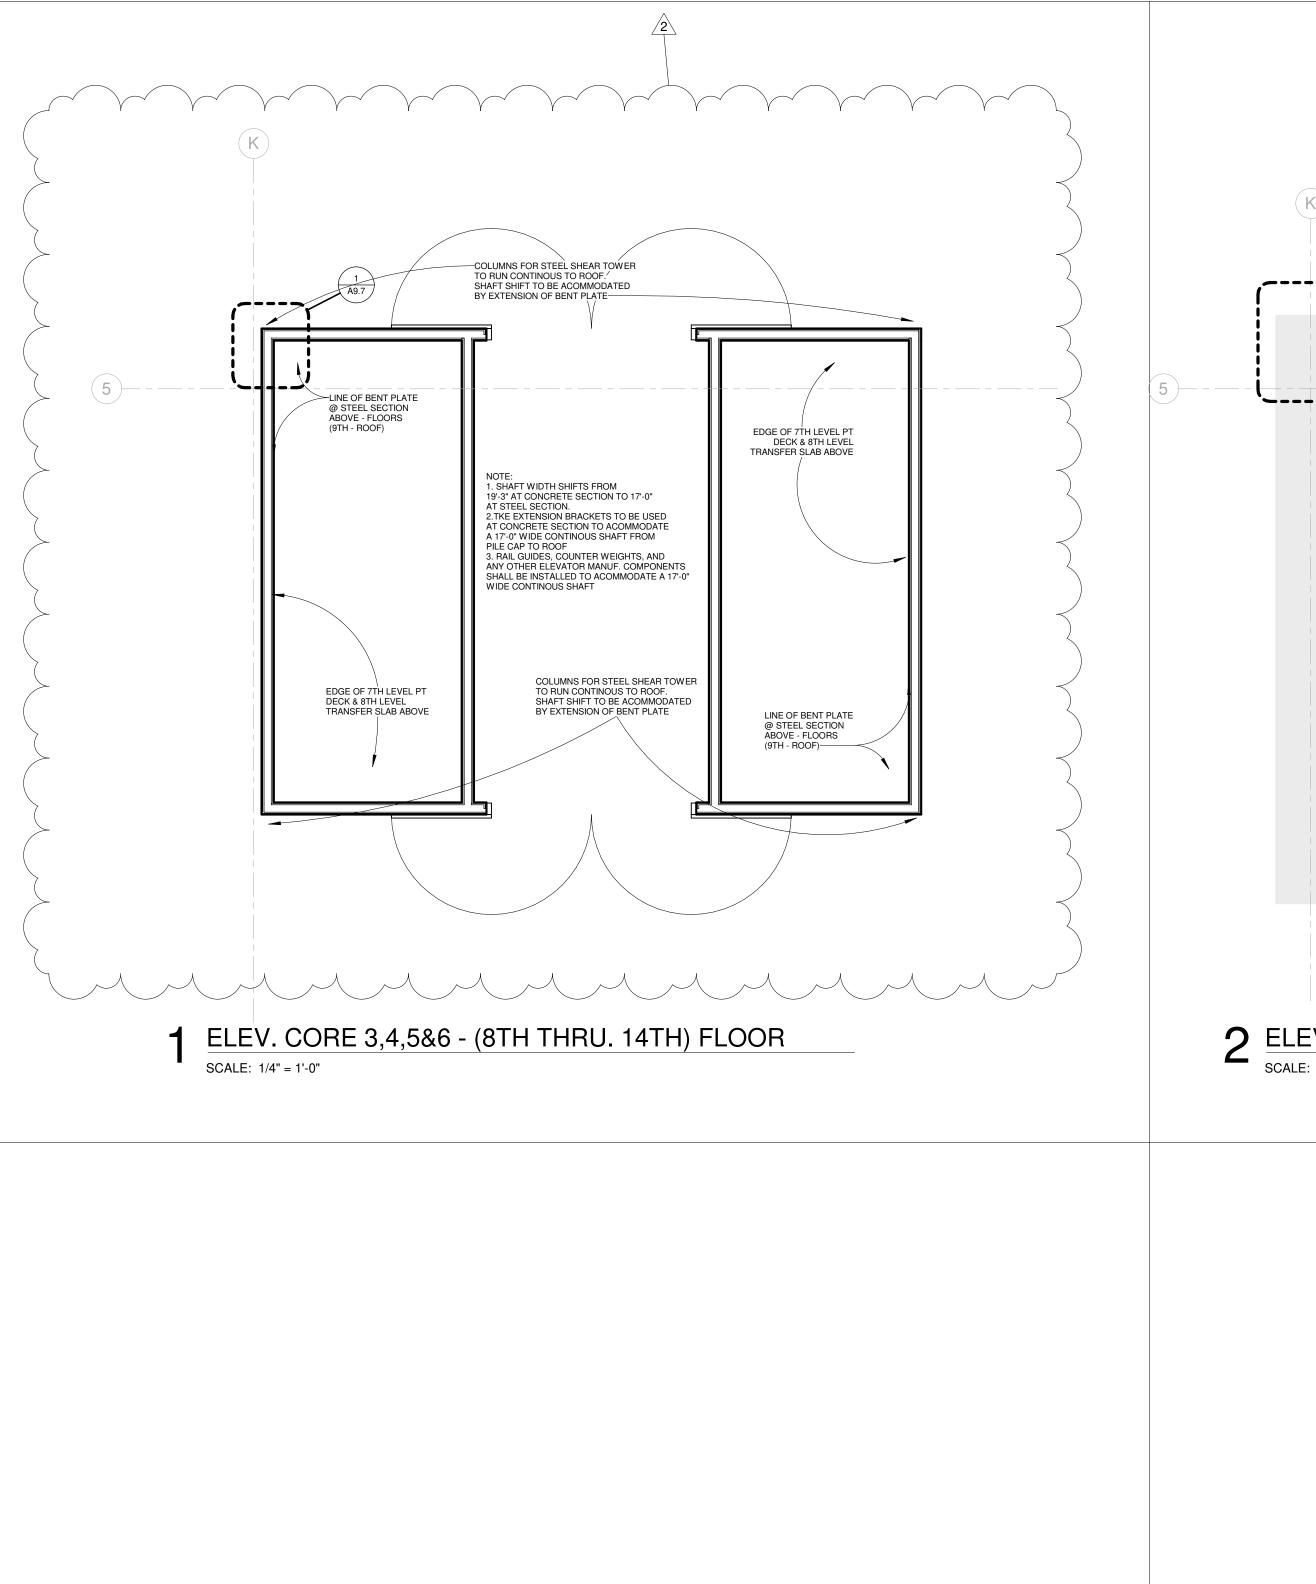

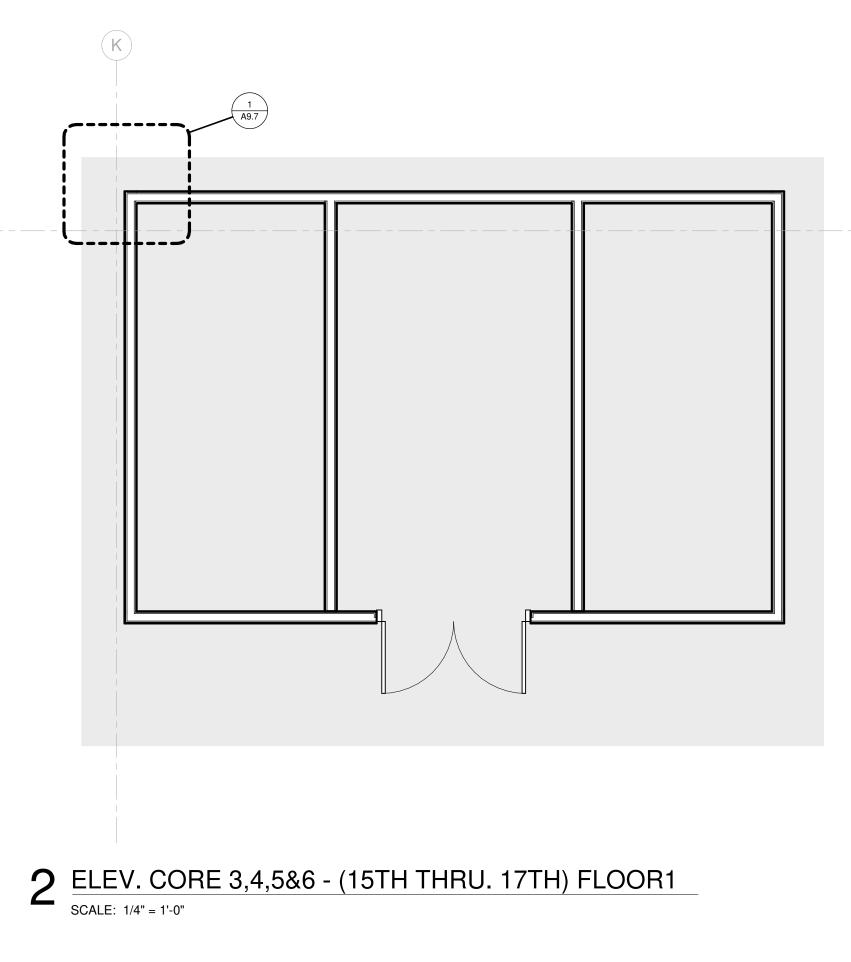

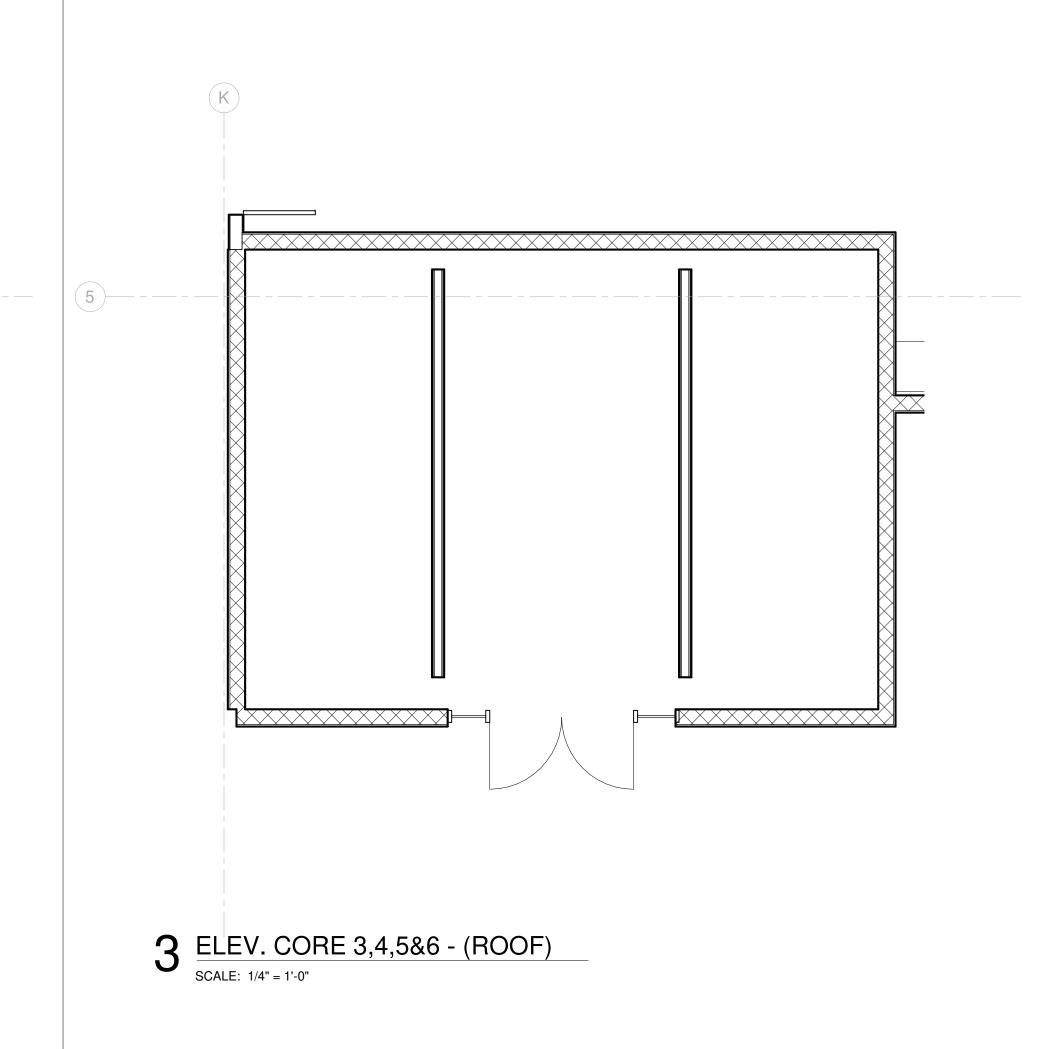

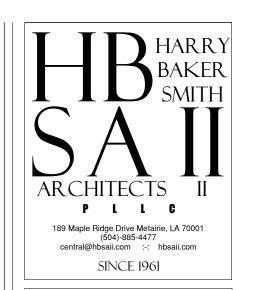

HARD ROCK HOTEL

1031 CANAL STREET

NEW ORLEANS, LOUISIANA

THESE PLANS AND SPECIFICATIONS HAVE BEEN PREPARED BY ME OR UNDER MY CLOSE PERSONAL SUPERVISION AND TO THE BEST OF MY KNOWLEDGE AND BELIEF THEY COMPLY WITH ALL CITY, STATE AND FEDERAL REQUIREMENTS, AND I AM NOT PROVIDING CONTRACT ADMINISTRATION.

CERTIFIED CORRECT



THIS DRAWING IS CONFIDENTIAL AND NOT BE LOANED, REPRODUCED, COPIED, EITHER WHOLLY OR IN PART, OR MADE PUBLIC IN ANY MANNER WITHOUT THE WRITTEN CONSENT OF HBSA II ARCHITECTS, A PROFESSIONAL L.L.C. ALL RIGHTS OF DESIGN OR INVENTION ARE RESERVED AND WILL REMAIN THE SOLE PROPERTY OF HBSA

|                              | REVISION HISTORY             |                              |                              |                              |                              |                              |   |  |  |  |  |
|------------------------------|------------------------------|------------------------------|------------------------------|------------------------------|------------------------------|------------------------------|---|--|--|--|--|
| 4/27/2018                    | 5/4/2018                     | 5/11/2018                    | 5/18/2018                    | 5/25/2018                    | 6/1/2018                     | 6/8/2018                     |   |  |  |  |  |
| L.I.S. #2 - CLOUD REVISION 1 | L.I.S. #2 - CLOUD REVISION 2 | L.I.S. #2 - CLOUD REVISION 3 | L.I.S. #2 - CLOUD REVISION 4 | L.I.S. #2 - CLOUD REVISION 5 | L.I.S. #2 - CLOUD REVISION 6 | L.I.S. #2 - CLOUD REVISION 7 |   |  |  |  |  |
|                              | 2                            | 8                            |                              | 5                            | 9                            |                              | 8 |  |  |  |  |

ENLARGED ELEVATOR
CORE PLAN

PROJECT#: 1709
PHASE: DD


TEAM: Author

CHECKER: Checker

SCALE: AS NOTED

ISSUED: 4/20/2018

ISSUED: 4/20/2018
SHEET#: **A9.2.A** 

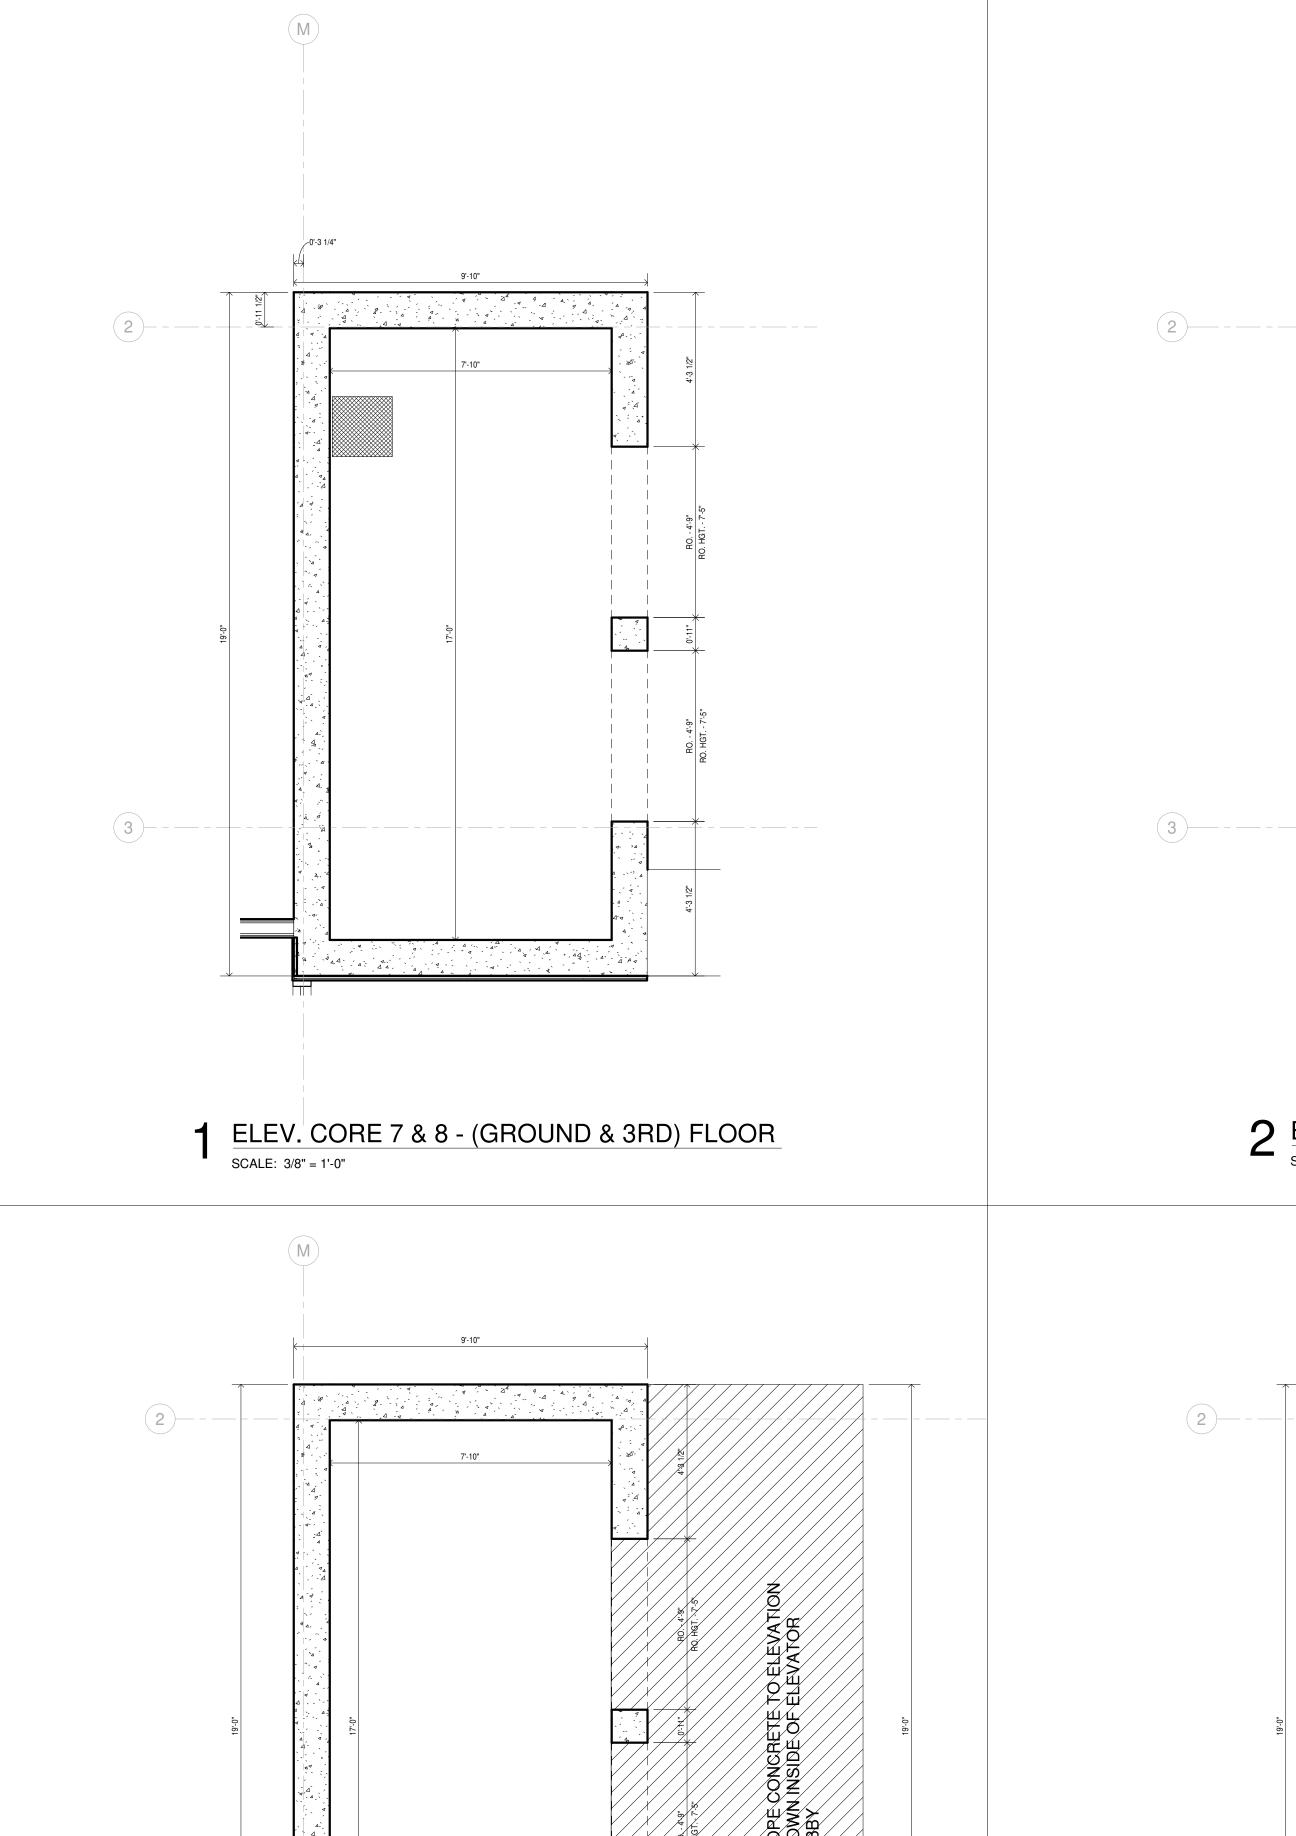

62'-2"


5'-11 7/8"


444


4 ELEV. CORE 7 & 8 - (6TH) FLOOR

SCALE: 3/8" = 1'-0"

61'-10"

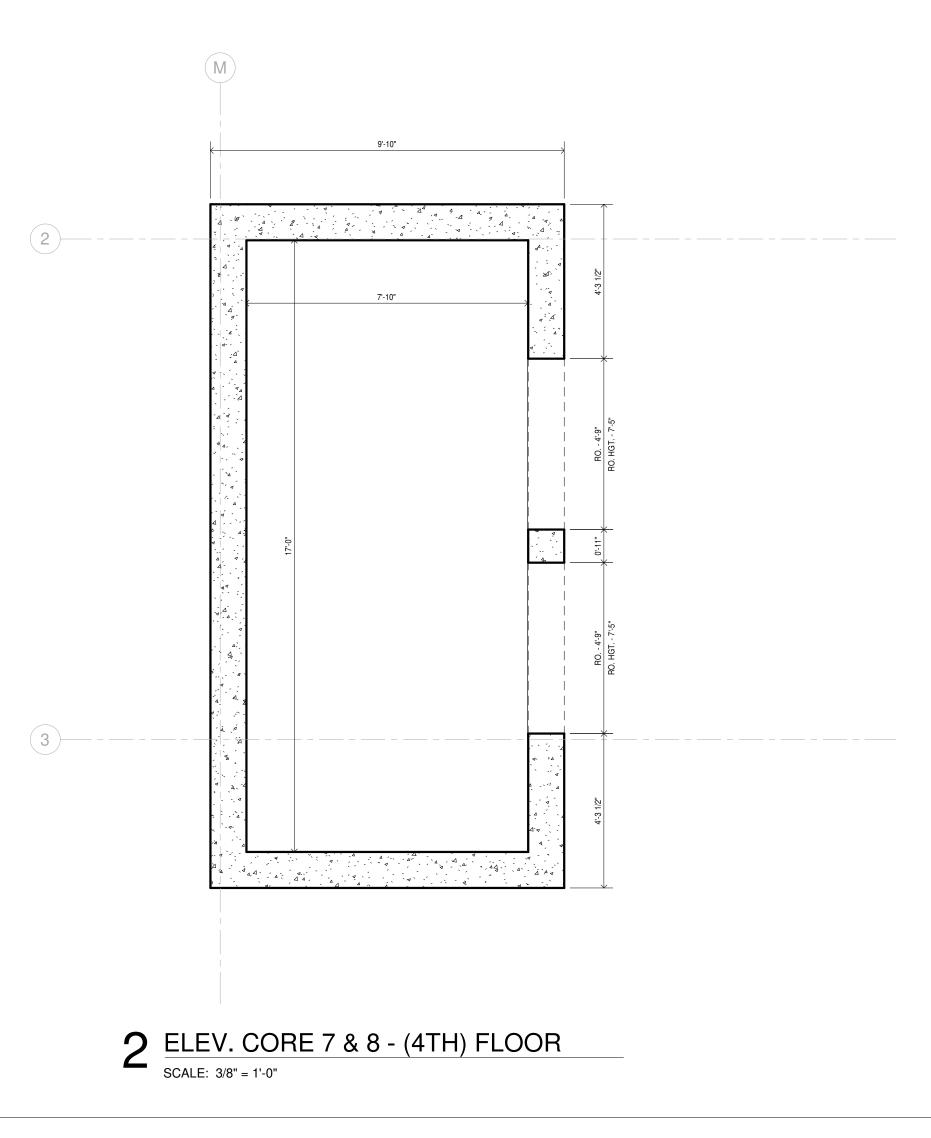

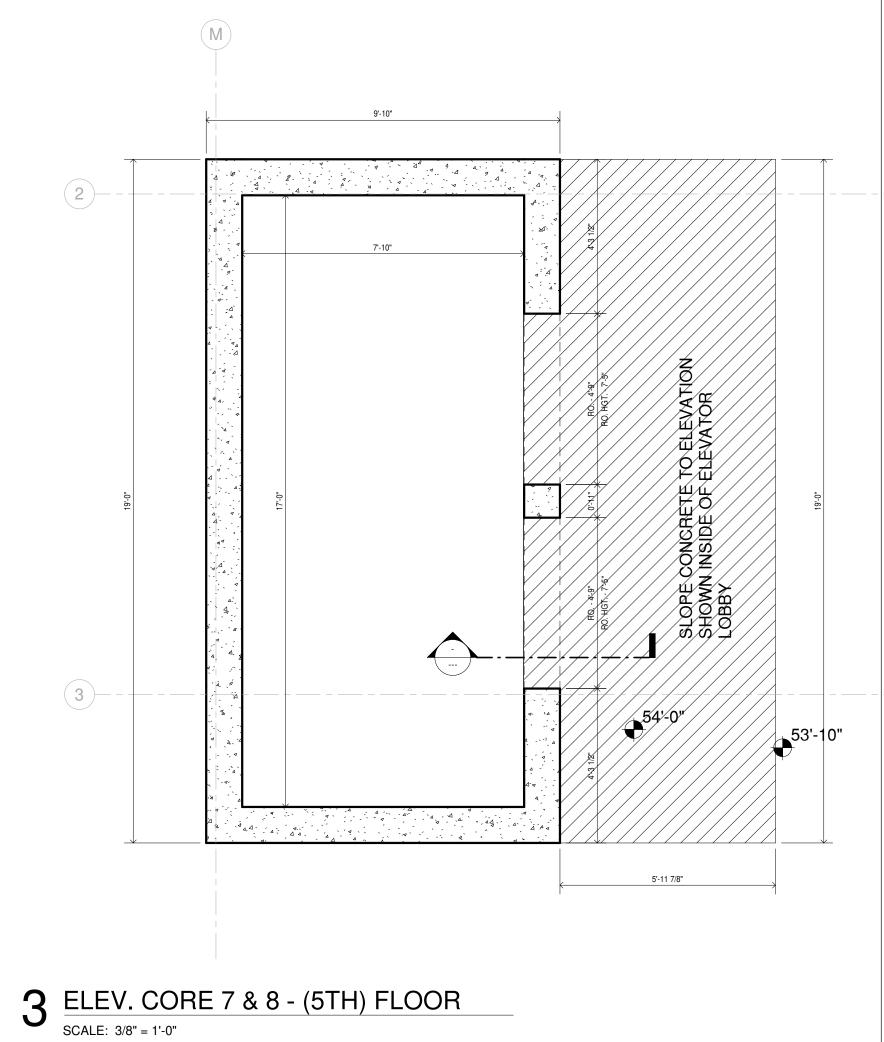

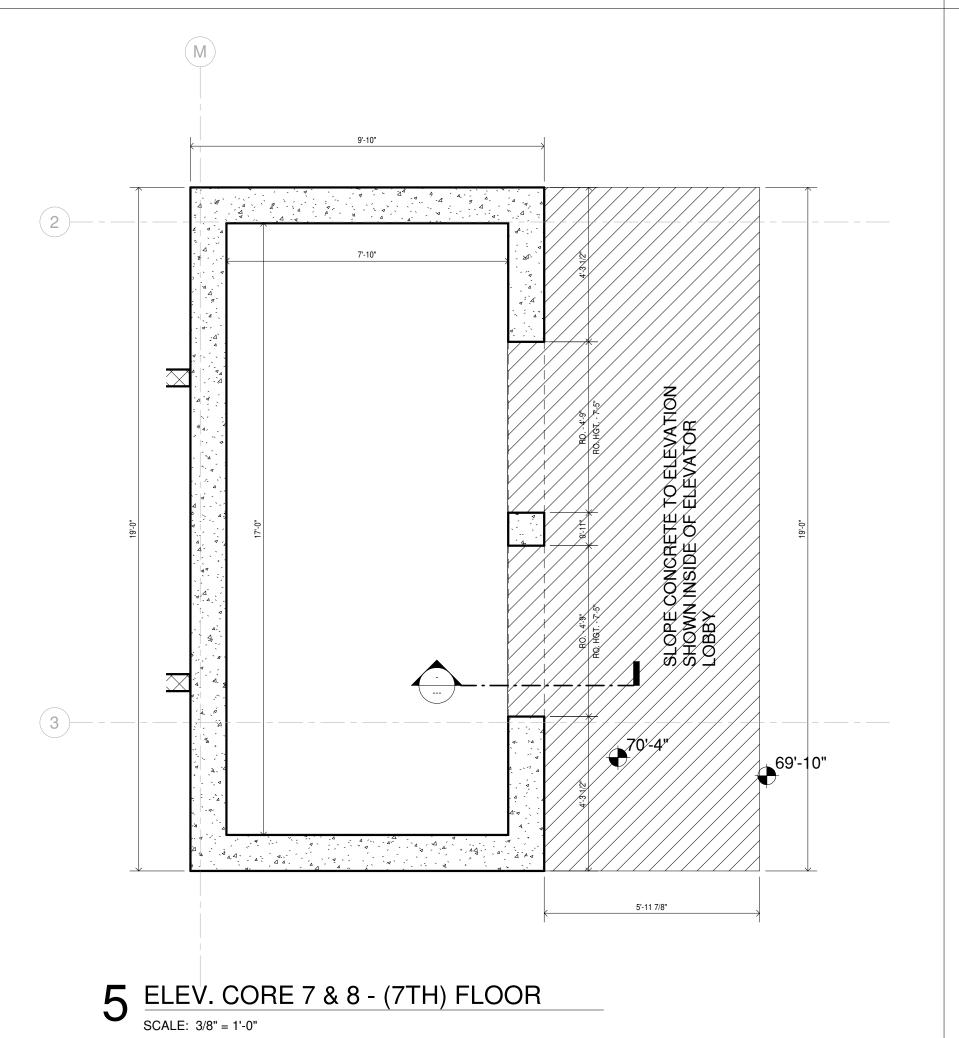






189 Maple Ridge Drive Metairie, LA 70001 (504)-885-4477 central@hbsaii.com :-: hbsaii.com


SINCE 1961


SHEET#: **A9.3** 

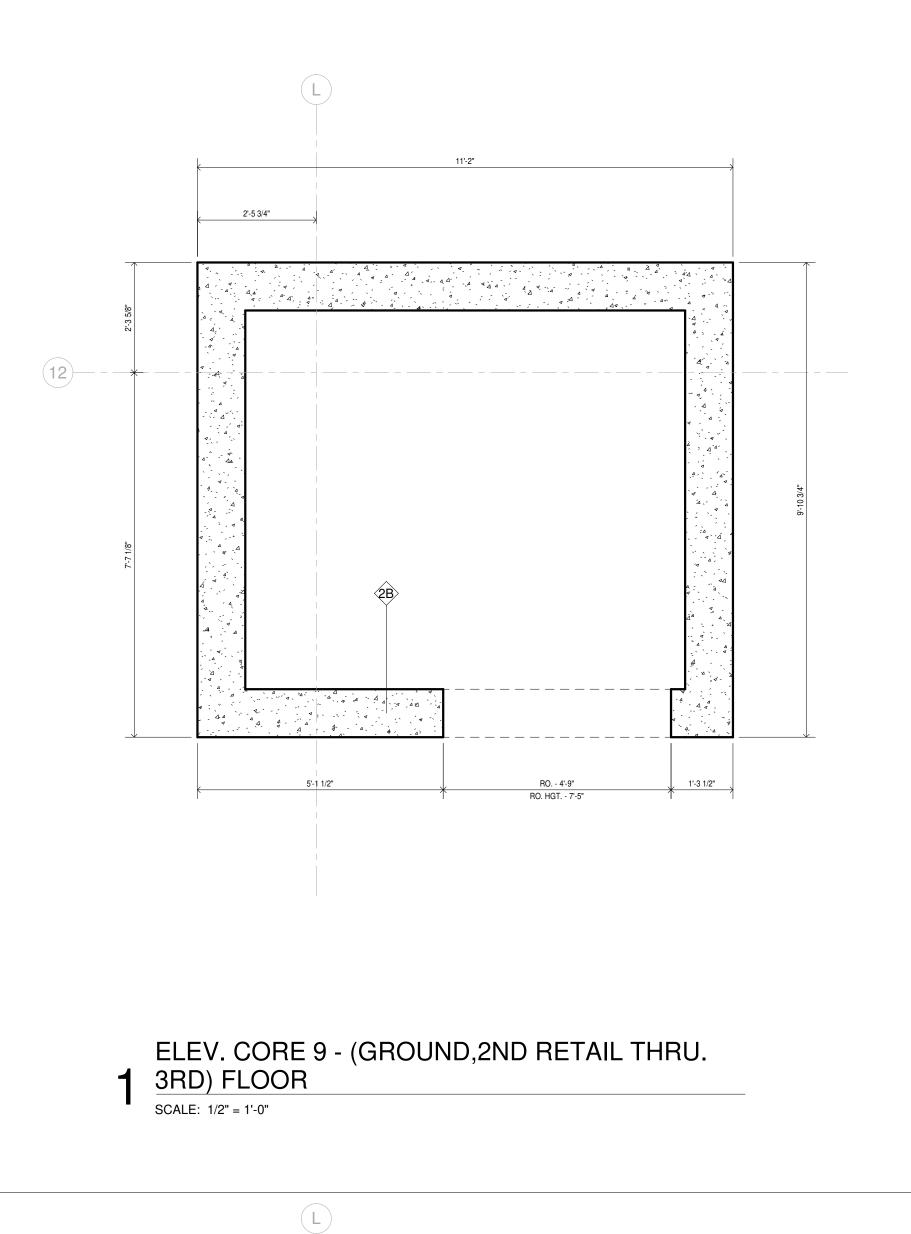


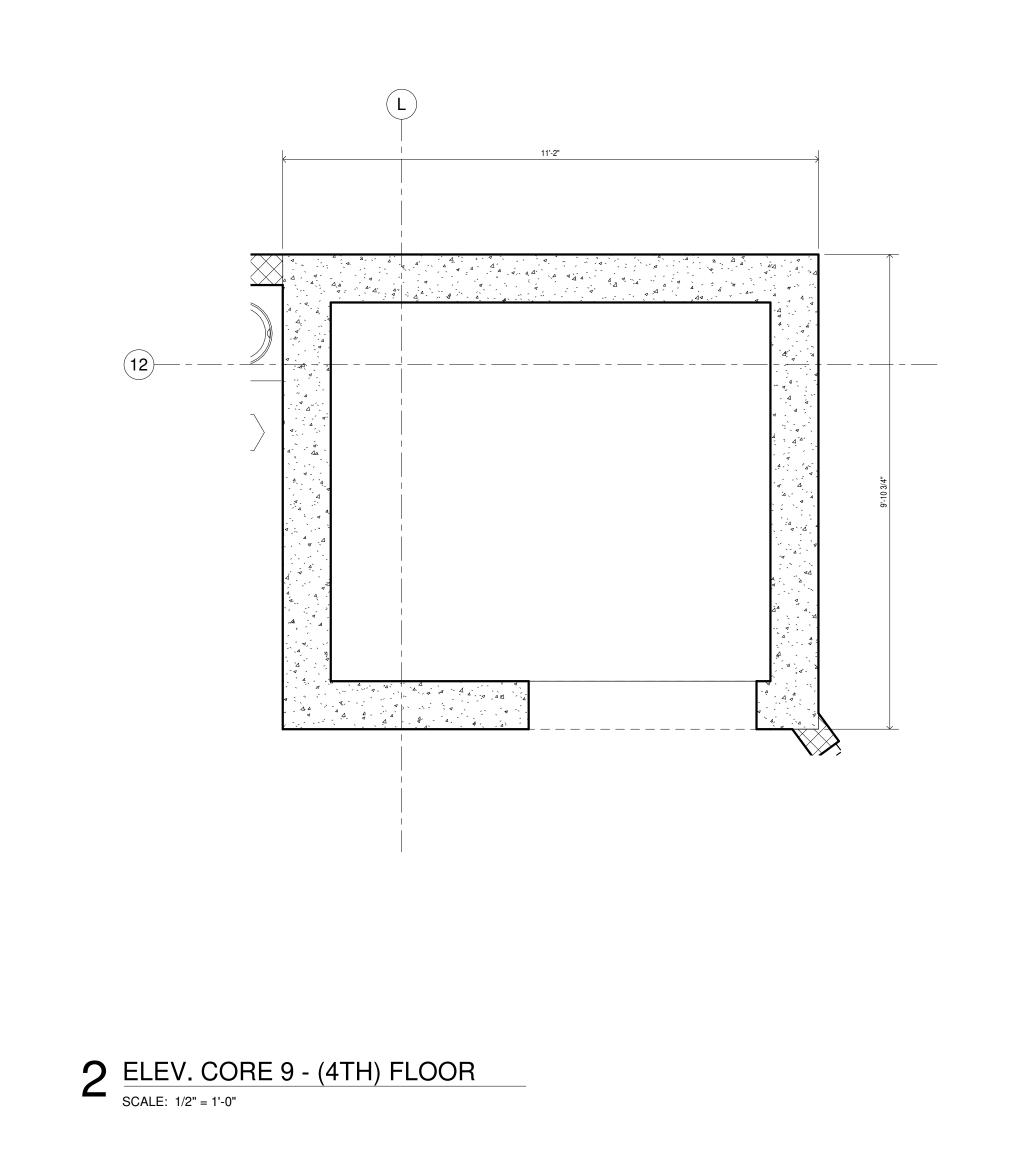

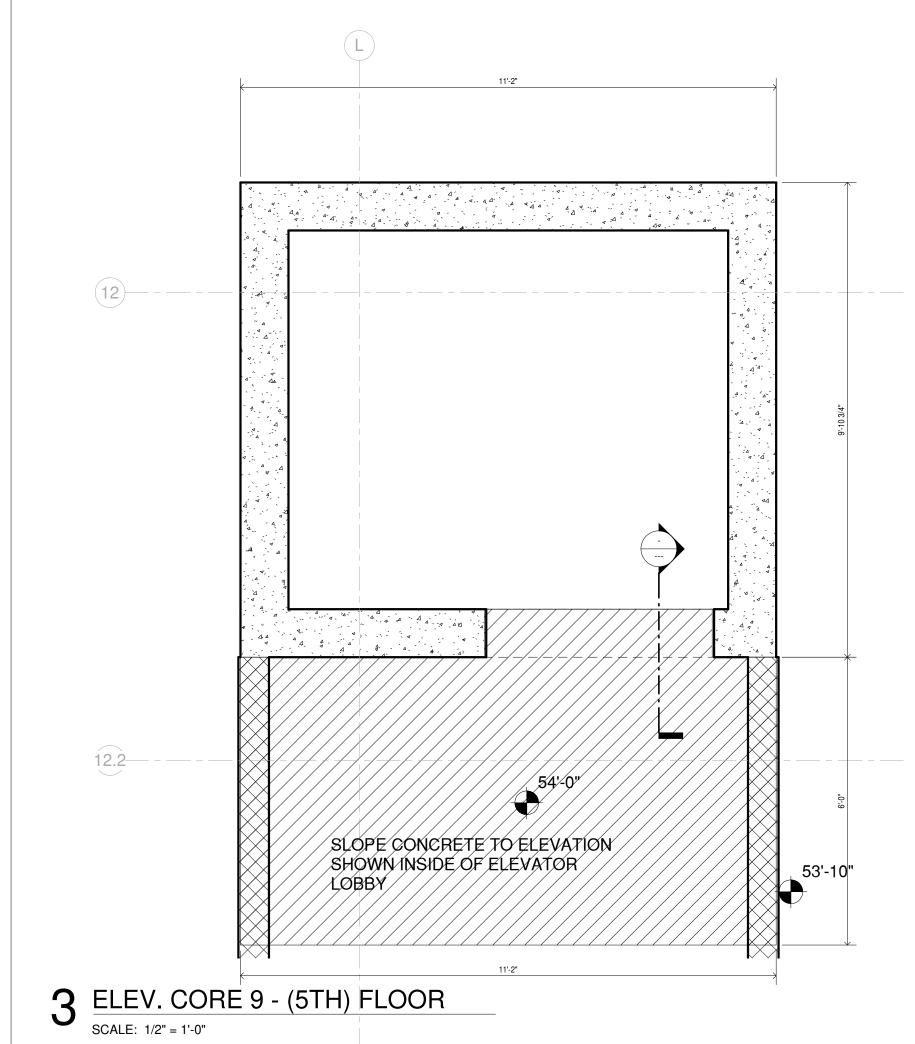

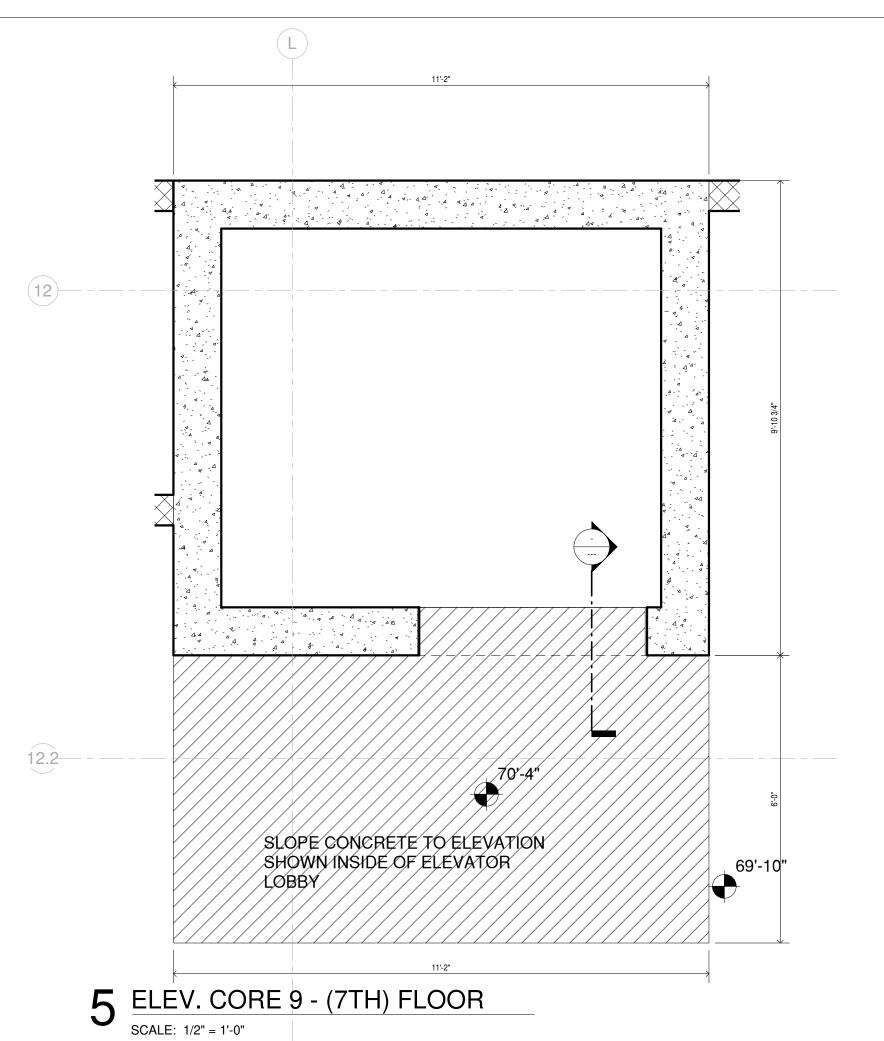

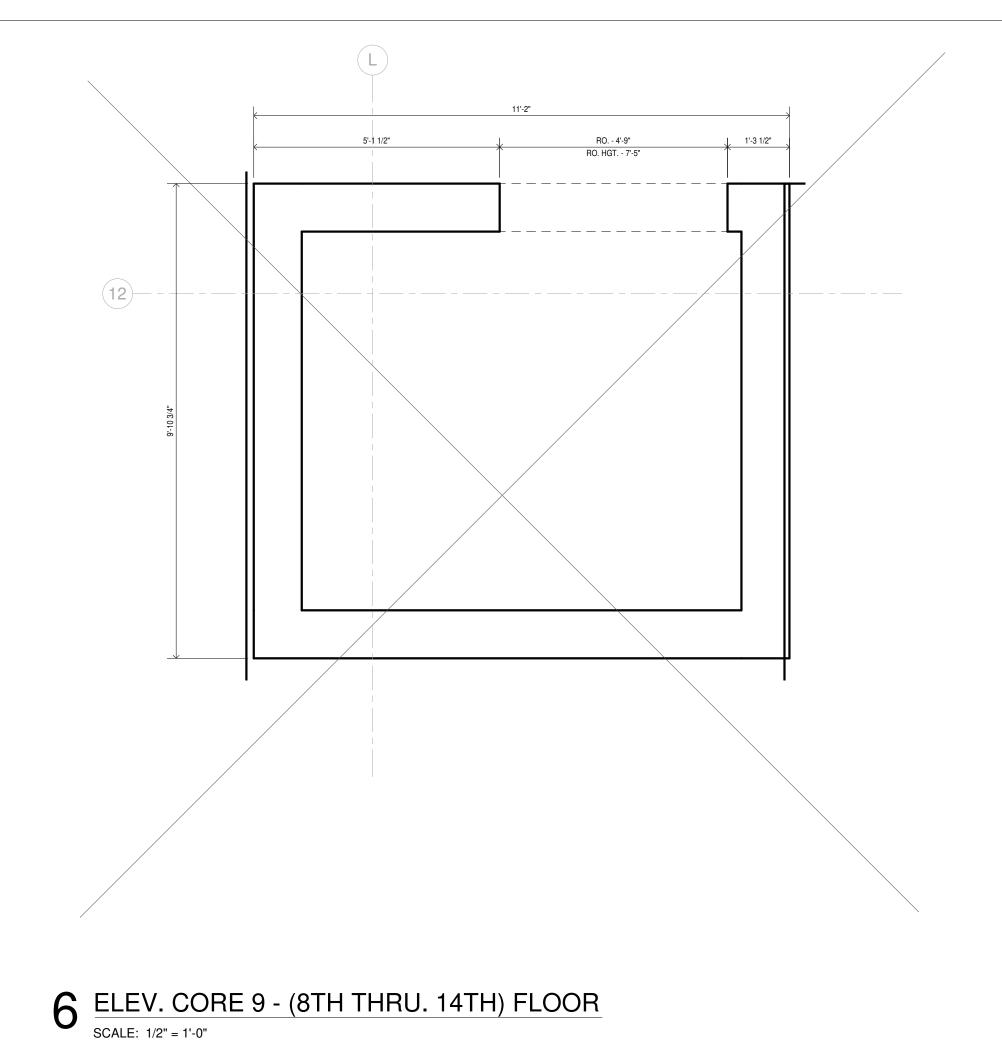

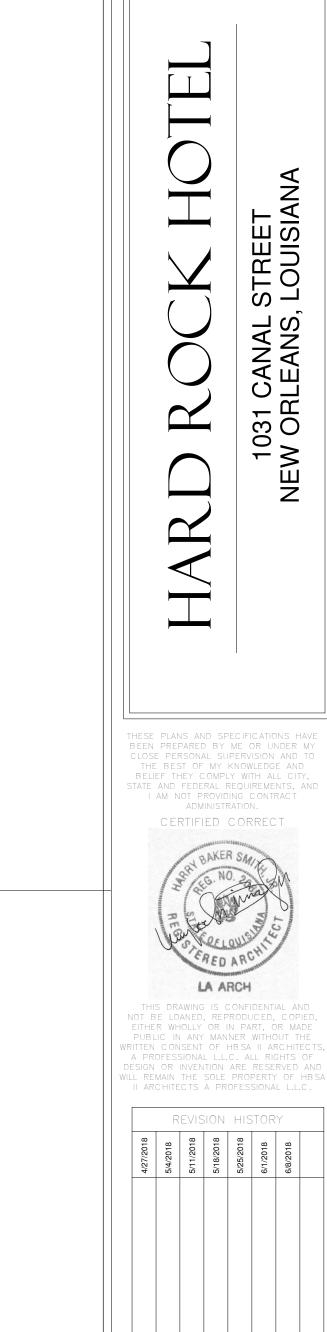


189 Maple Ridge Drive Metairie, LA 70001 (504)-885-4477 central@hbsaii.com :-: hbsaii.com


SINCE 1961


ENLARGED SERVICE
CORE PLAN

PROJECT#: 1709
PHASE: DD
TEAM: Author
CHECKER: Checker
SCALE: AS NOTED
ISSUED: 4/20/2018
SHEET#:

A A A

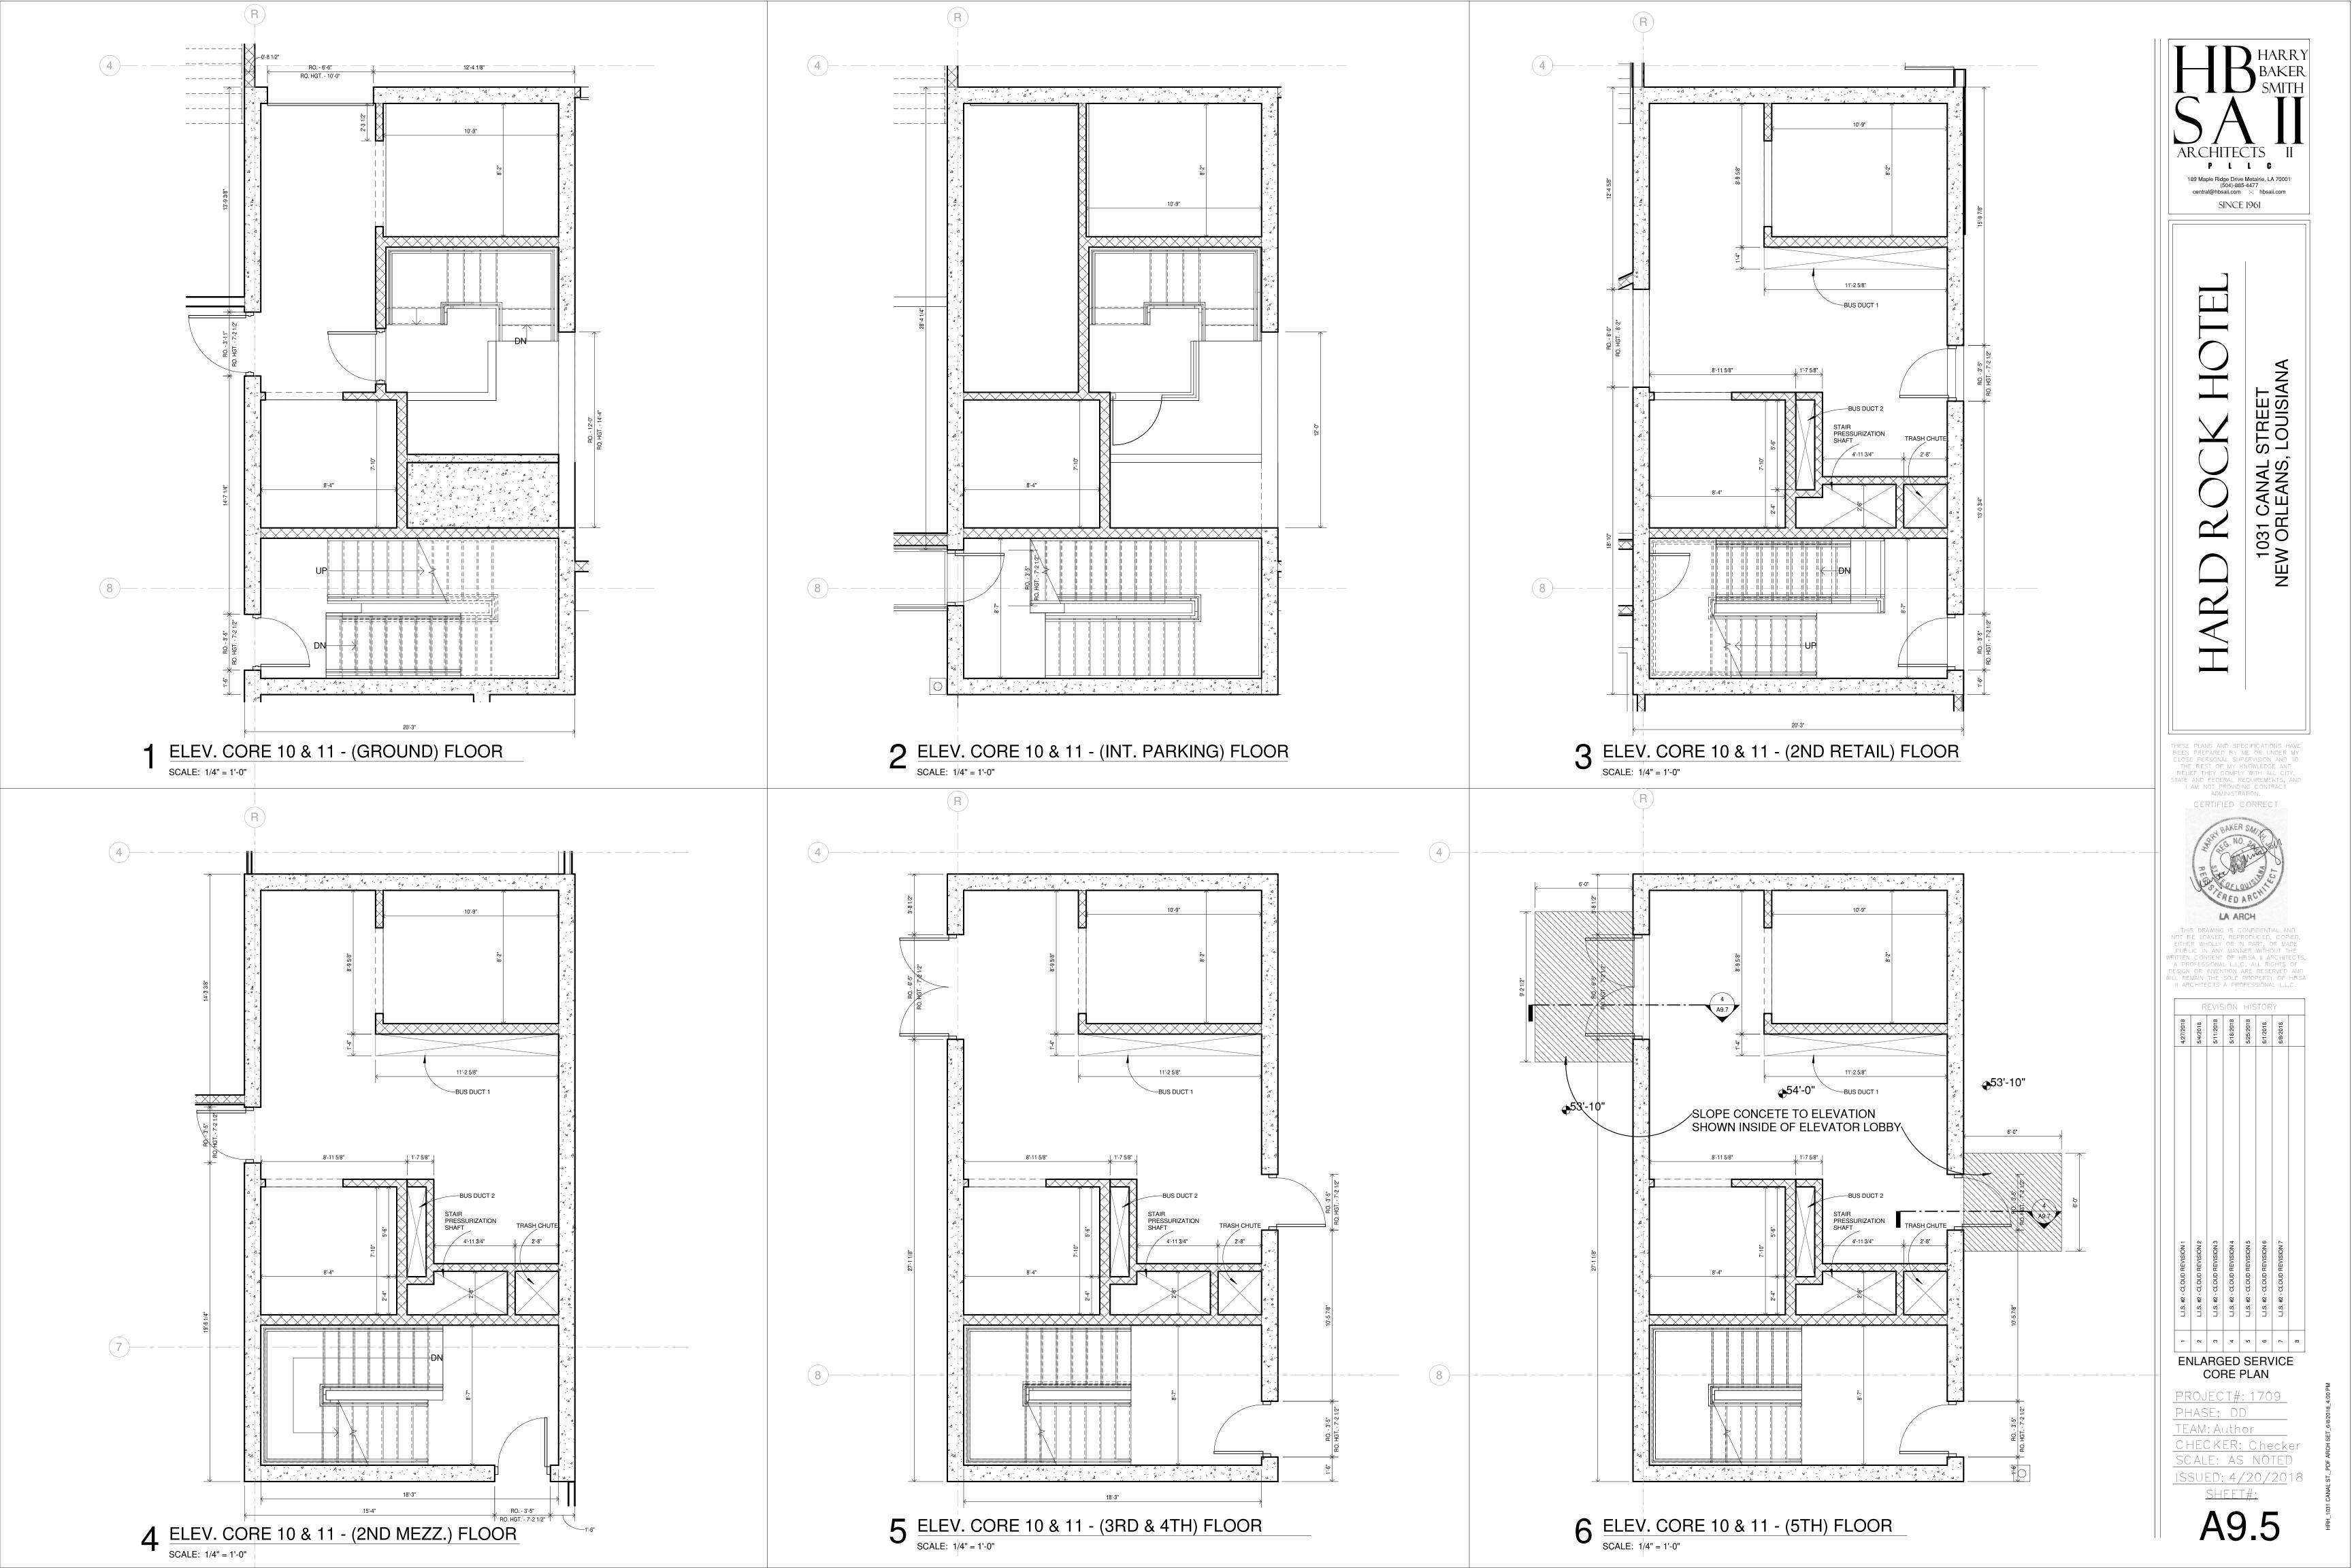

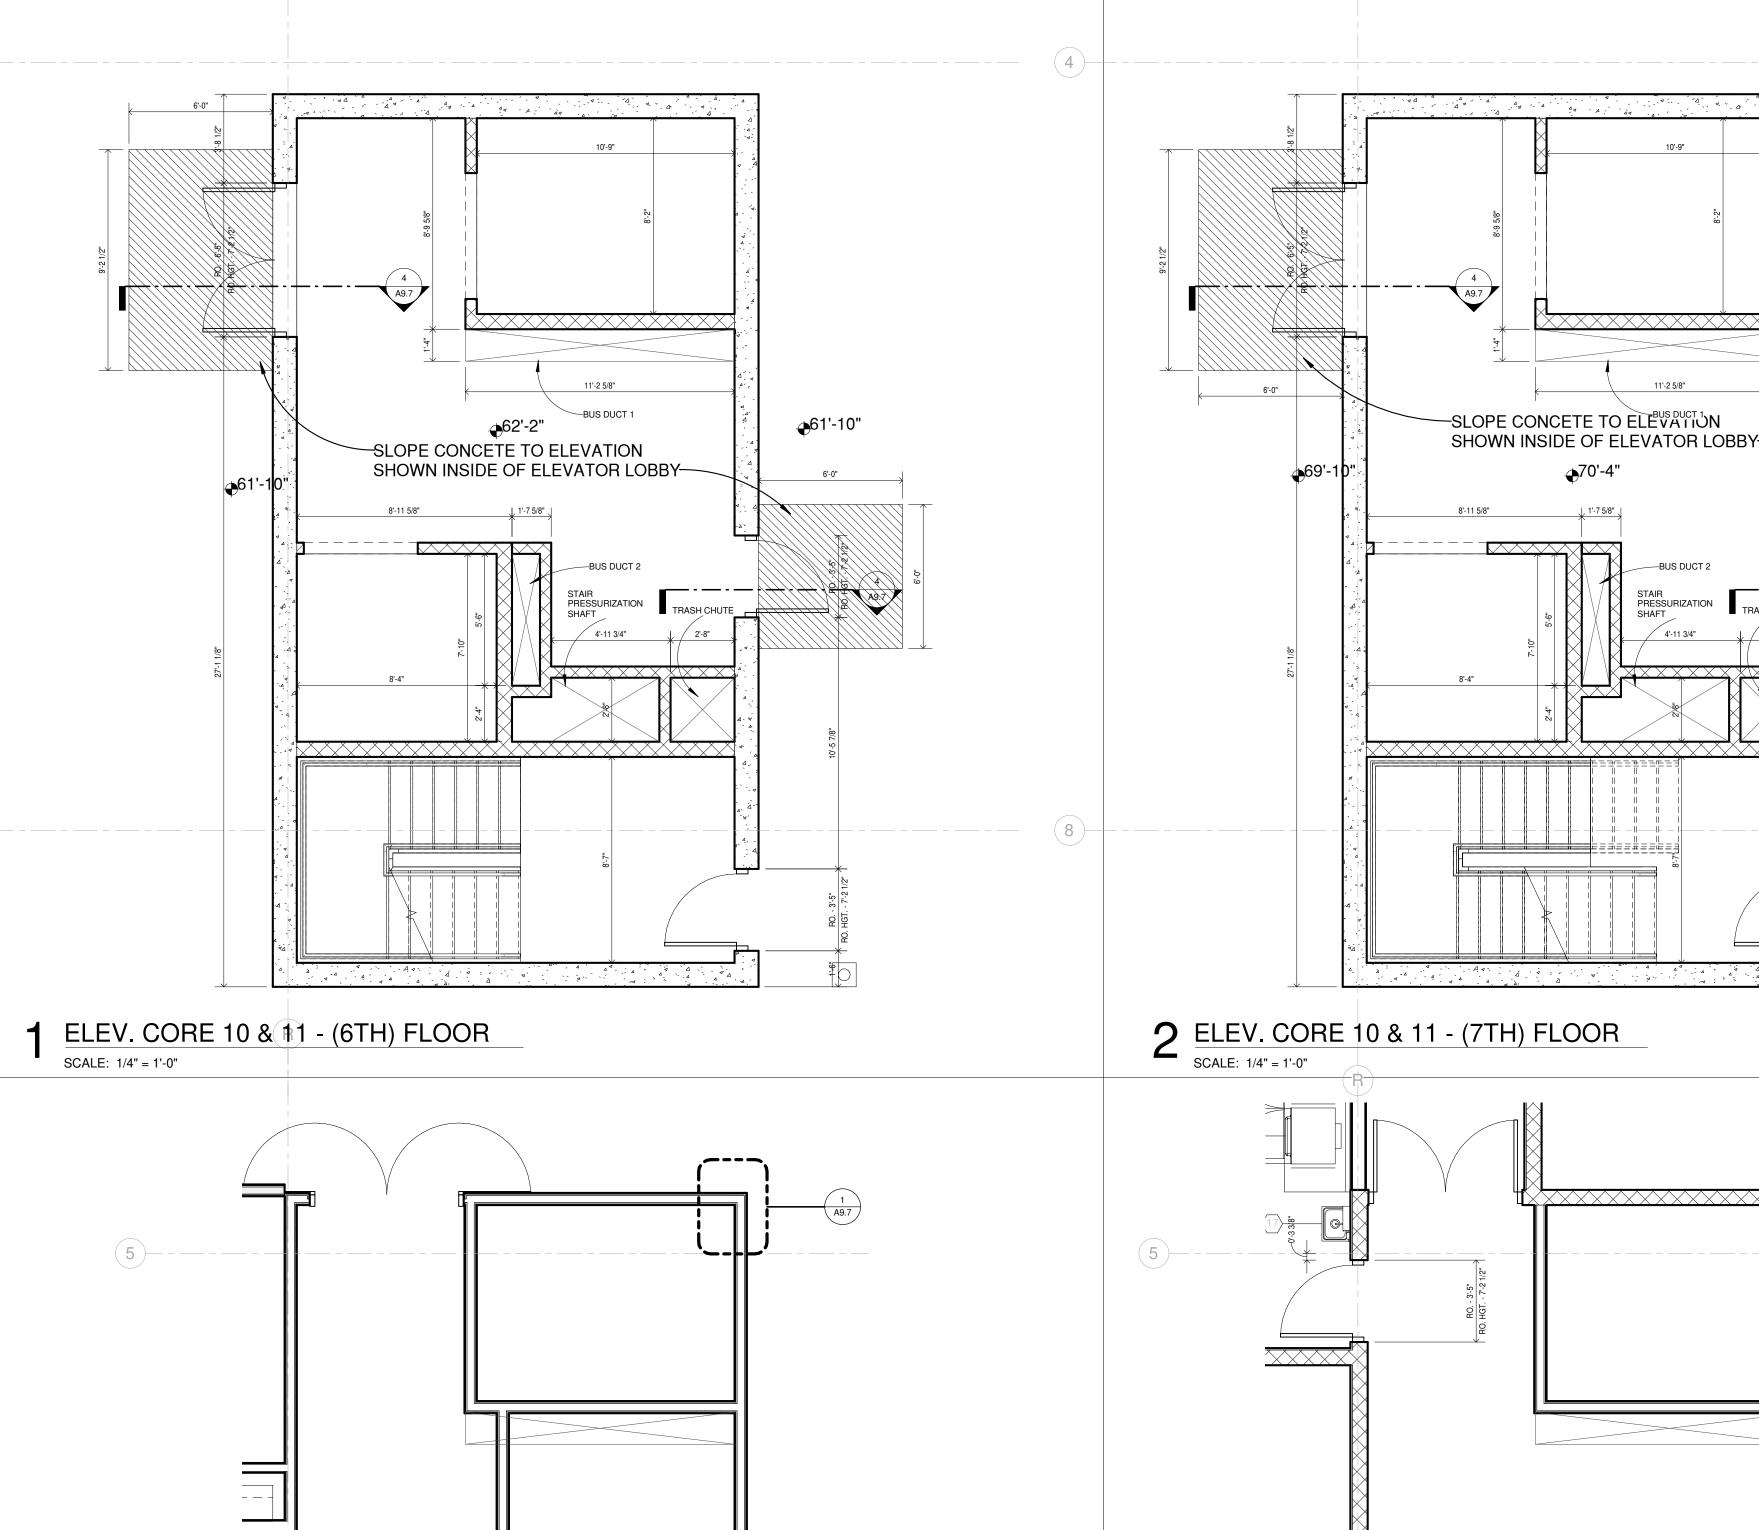


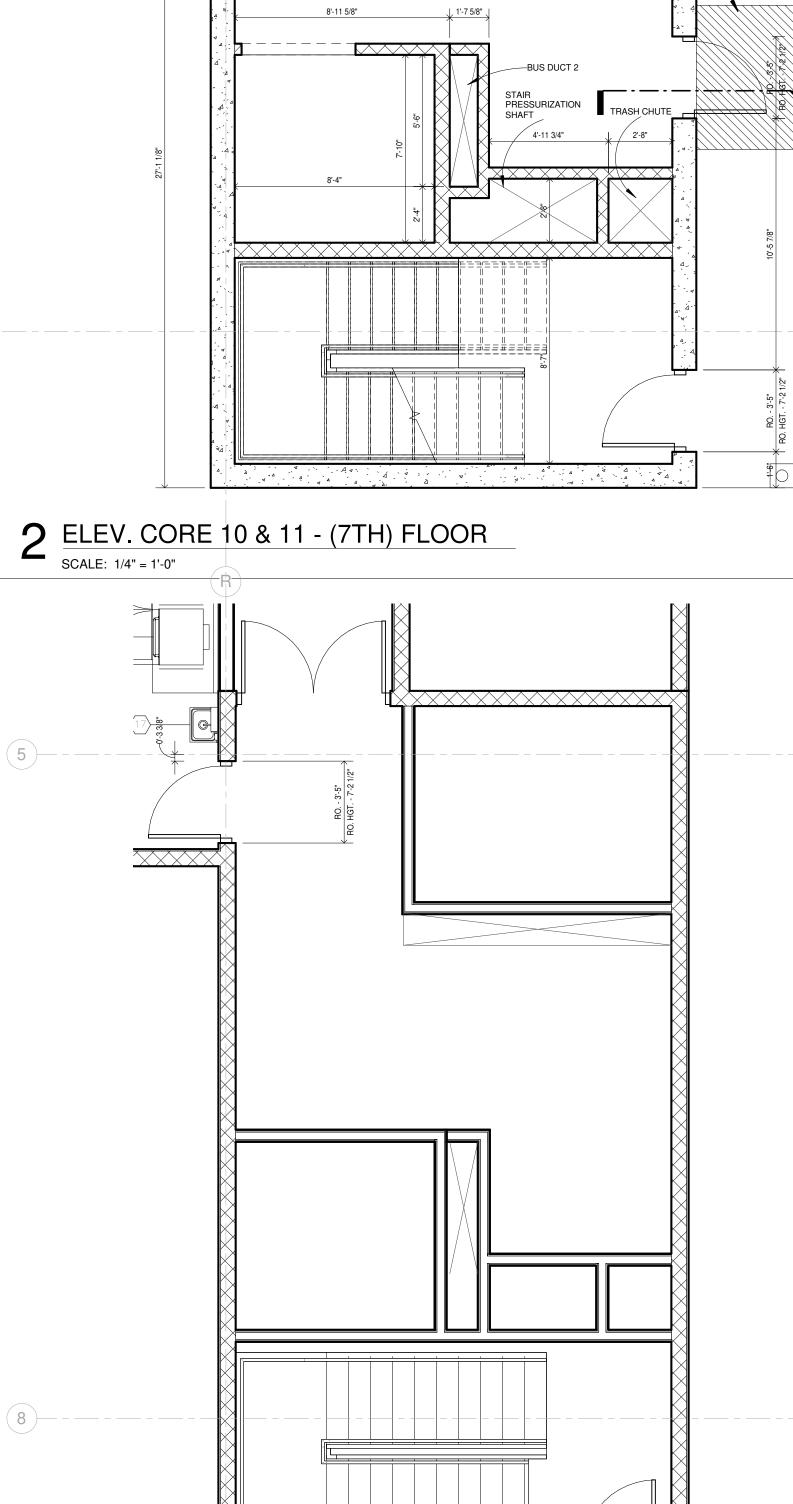



5 ELEV. CORE 10 & 11 - (ROOF)

SCALE: 1/4" = 1'-0"


**⊕**69'-10"

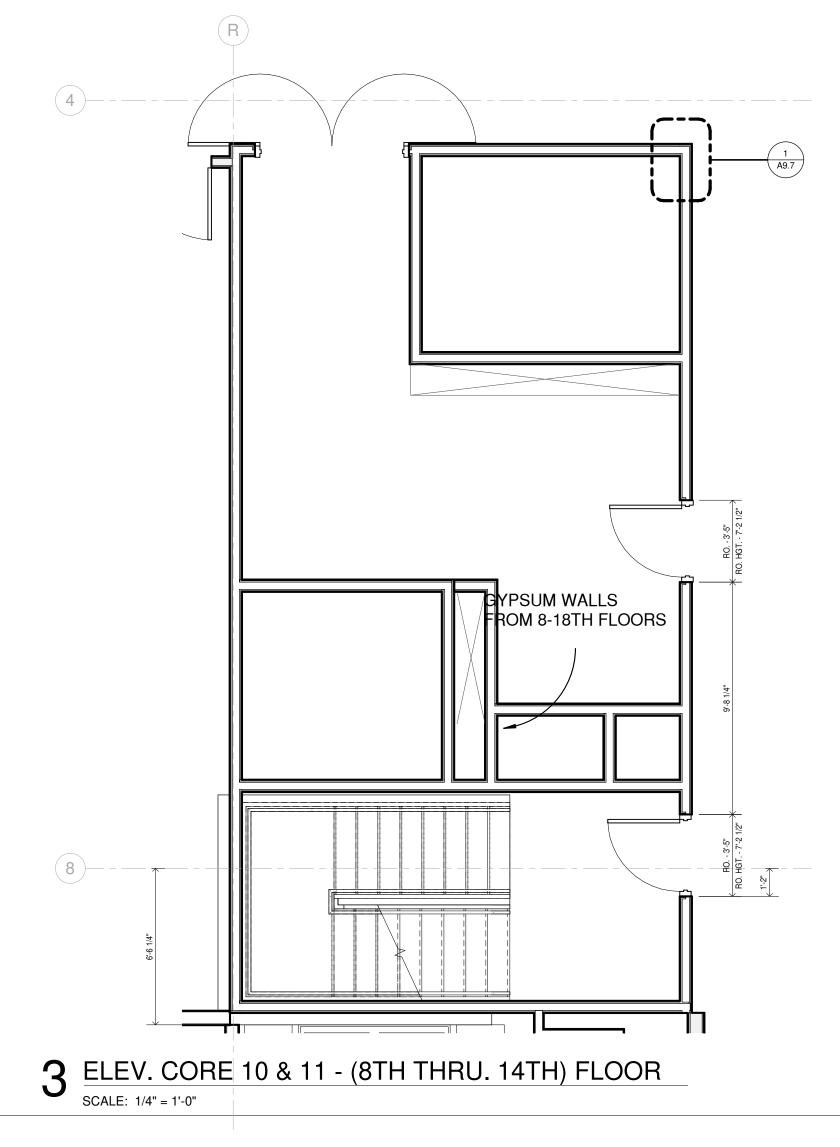

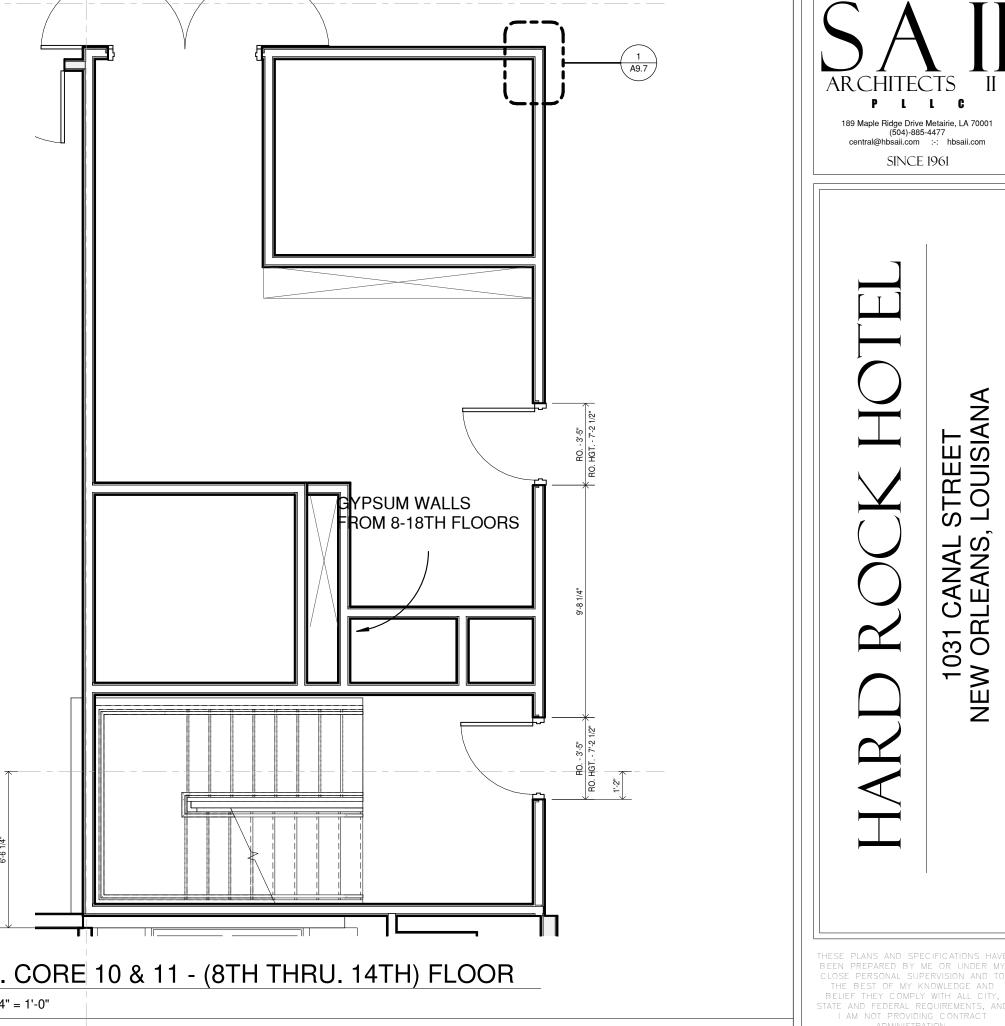

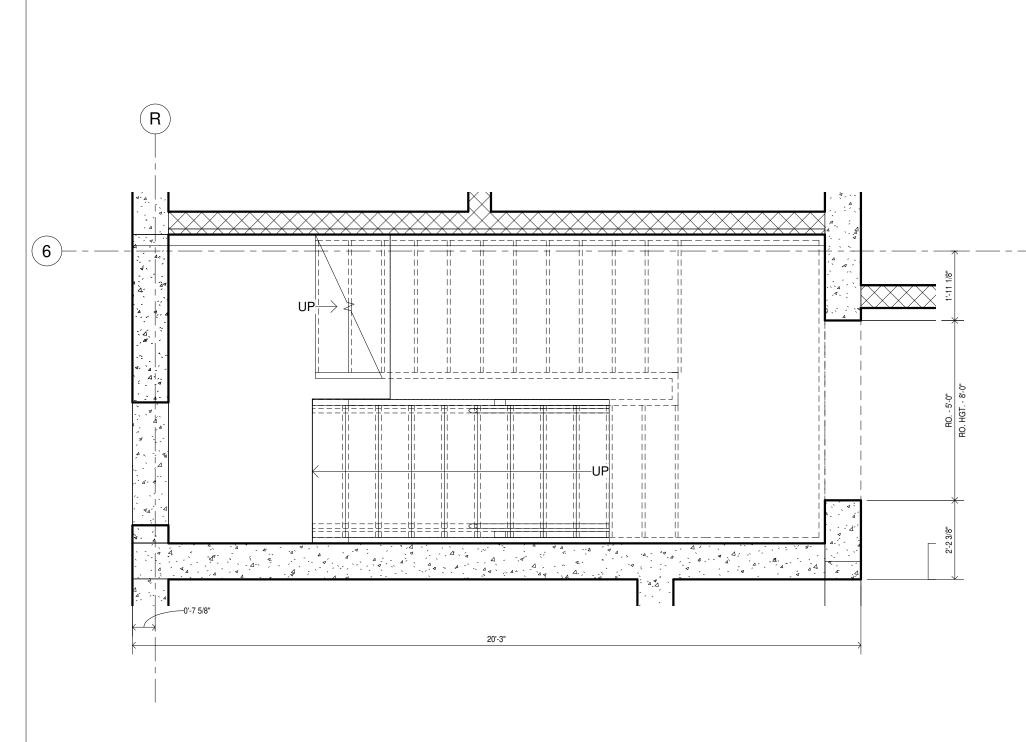



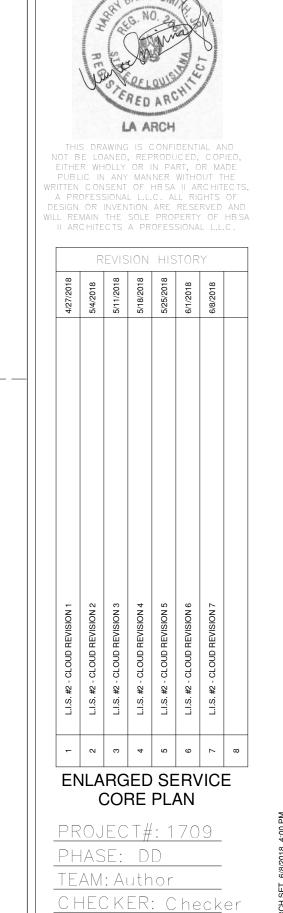


SCALE: AS NOTED ISSUED: 4/20/2018


4 ELEV. CORE 10 & 11 - (15TH THRU. 17TH) FLOOR


SCALE: 1/4" = 1'-0"


#### 3 ELEVATORS 1 & 2 SECTION SCALE: 1/8" = 1'-0"

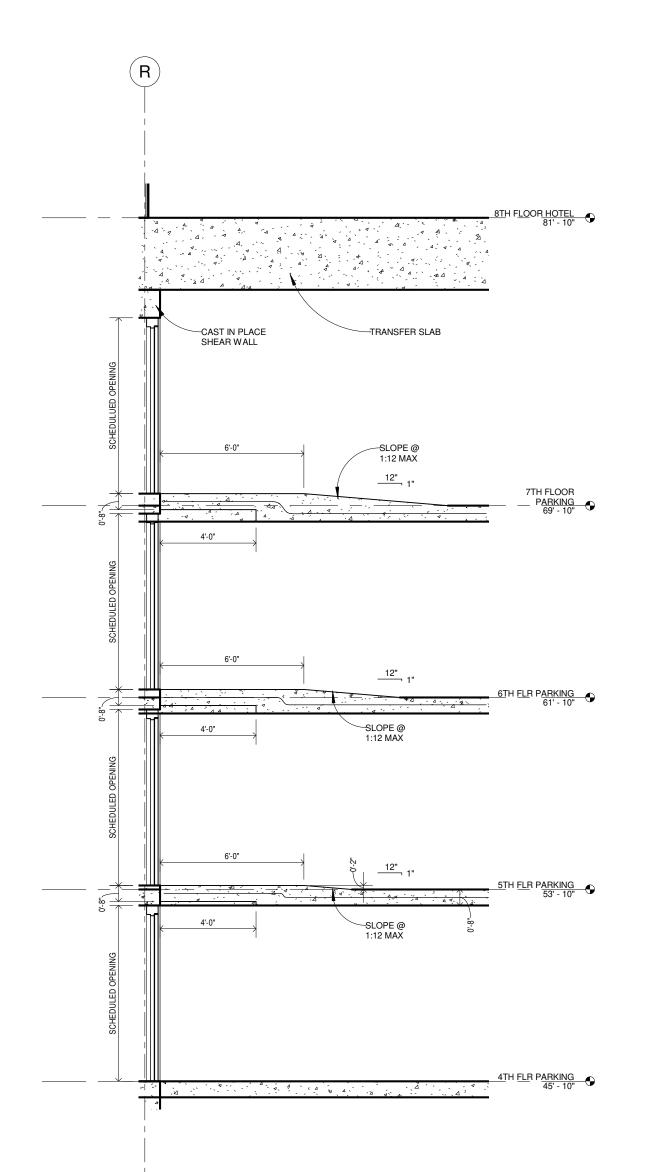




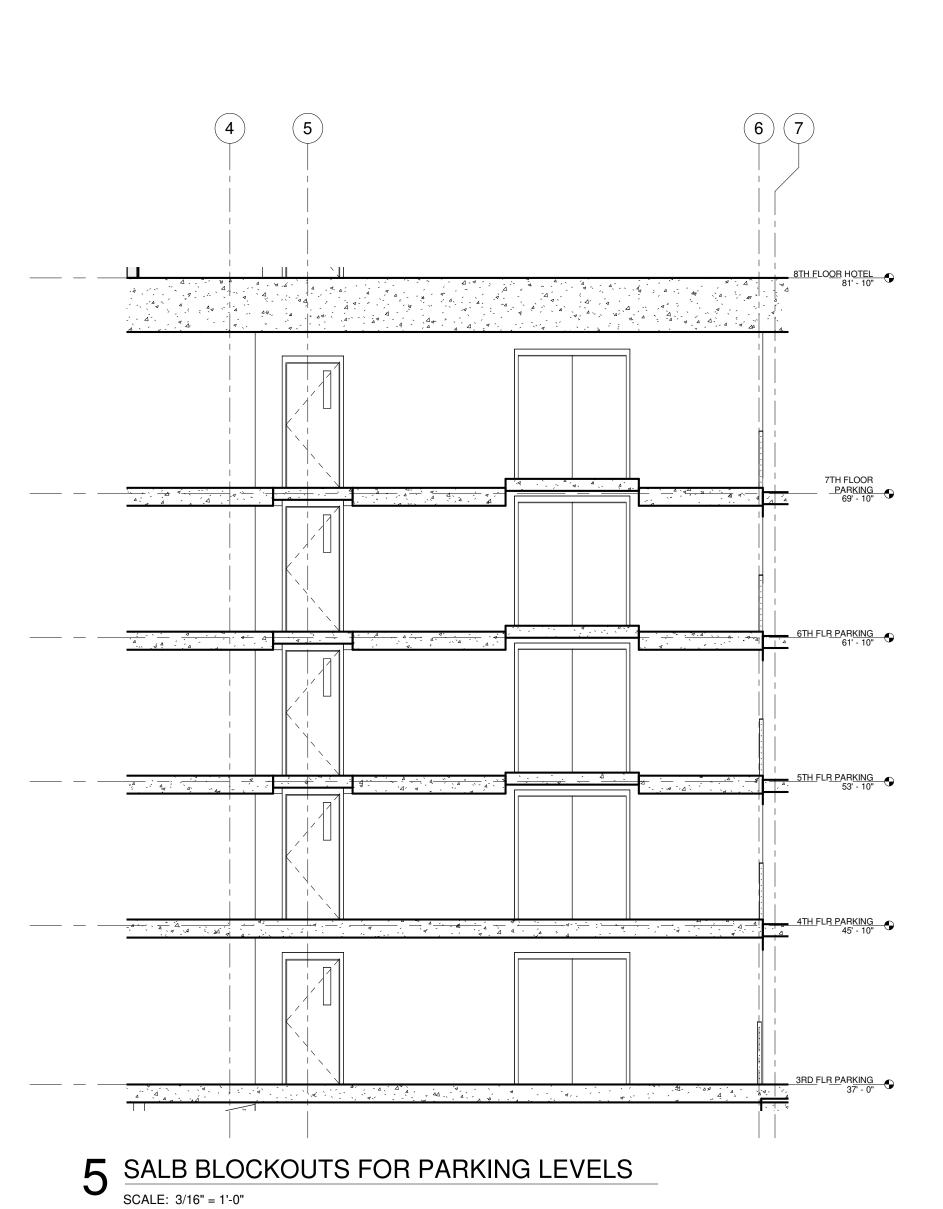

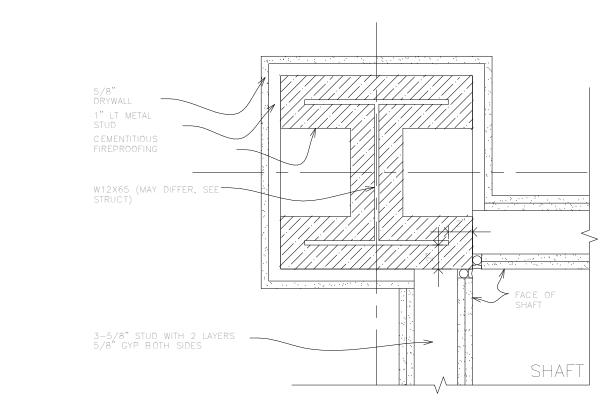

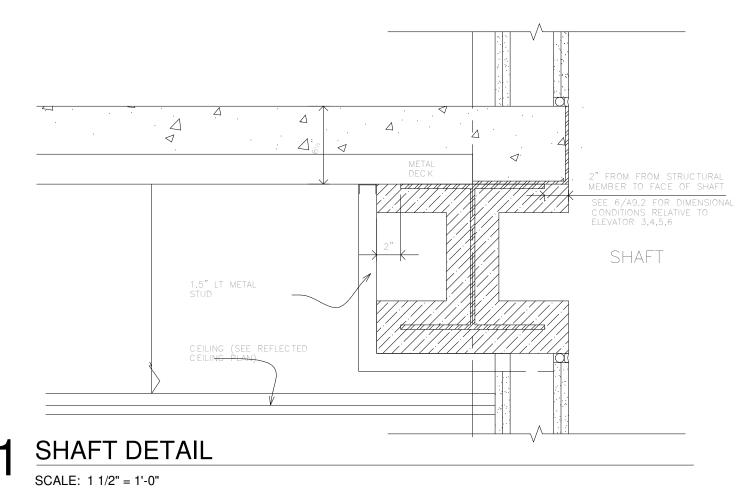

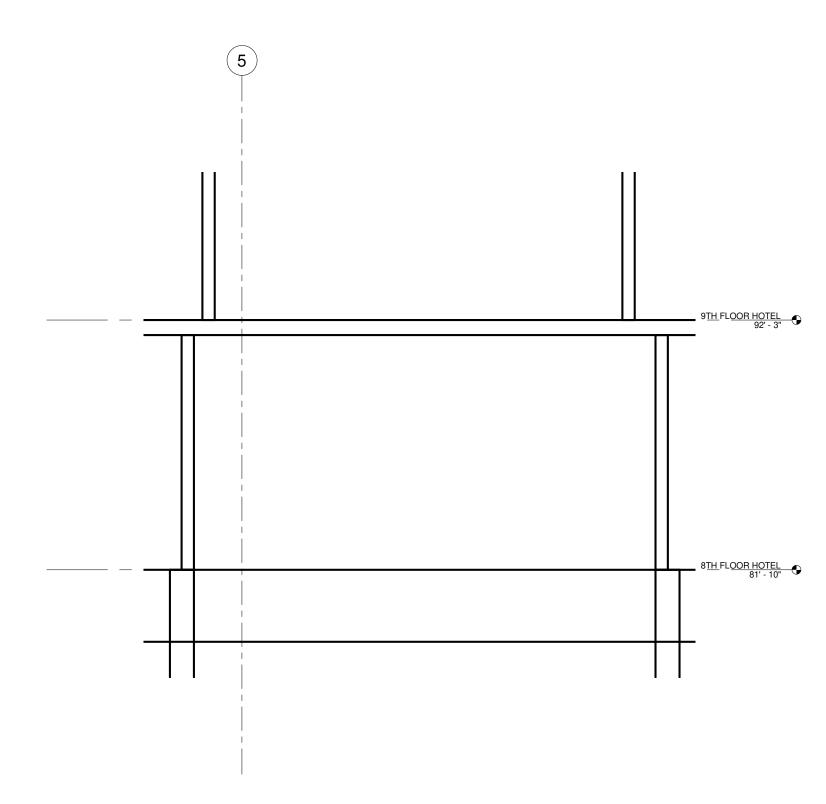

2 ELEV. 3,4,5&6 SHAFT TRANSITION

SCALE: 1/4" = 1'-0"

189 Maple Ridge Drive Metairie, LA 70001 (504)-885-4477 central@hbsaii.com :-: hbsaii.com SINCE 1961

1031 CANAL STREET NEW ORLEANS, LOUISIANA


STATE AND FEDERAL REQUIREMENTS, AND I AM NOT PROVIDING CONTRACT ADMINISTRATION. CERTIFIED CORRECT




| 8                            |                              | EVIS                         |                              |                              | TOR                          |                              |   |
|------------------------------|------------------------------|------------------------------|------------------------------|------------------------------|------------------------------|------------------------------|---|
| 4/27/2018                    | 5/4/2018                     | 5/11/2018                    | 5/18/2018                    | 5/25/2018                    | 6/1/2018                     | 6/8/2018                     |   |
| L.I.S. #2 - CLOUD REVISION 1 | L.I.S. #2 - CLOUD REVISION 2 | L.I.S. #2 - CLOUD REVISION 3 | L.I.S. #2 - CLOUD REVISION 4 | L.I.S. #2 - CLOUD REVISION 5 | L.I.S. #2 - CLOUD REVISION 6 | L.I.S. #2 - CLOUD REVISION 7 |   |
| L.I.S.                       |   |
| -                            | 2                            | 3                            | 4                            | 5                            | 9                            | 7                            | 8 |

PROJECT#: 1709 PHASE: DD TEAM: Author CHECKER: Checker SCALE: AS NOTED ISSUED: 4/20/2018

**DETAILS** 

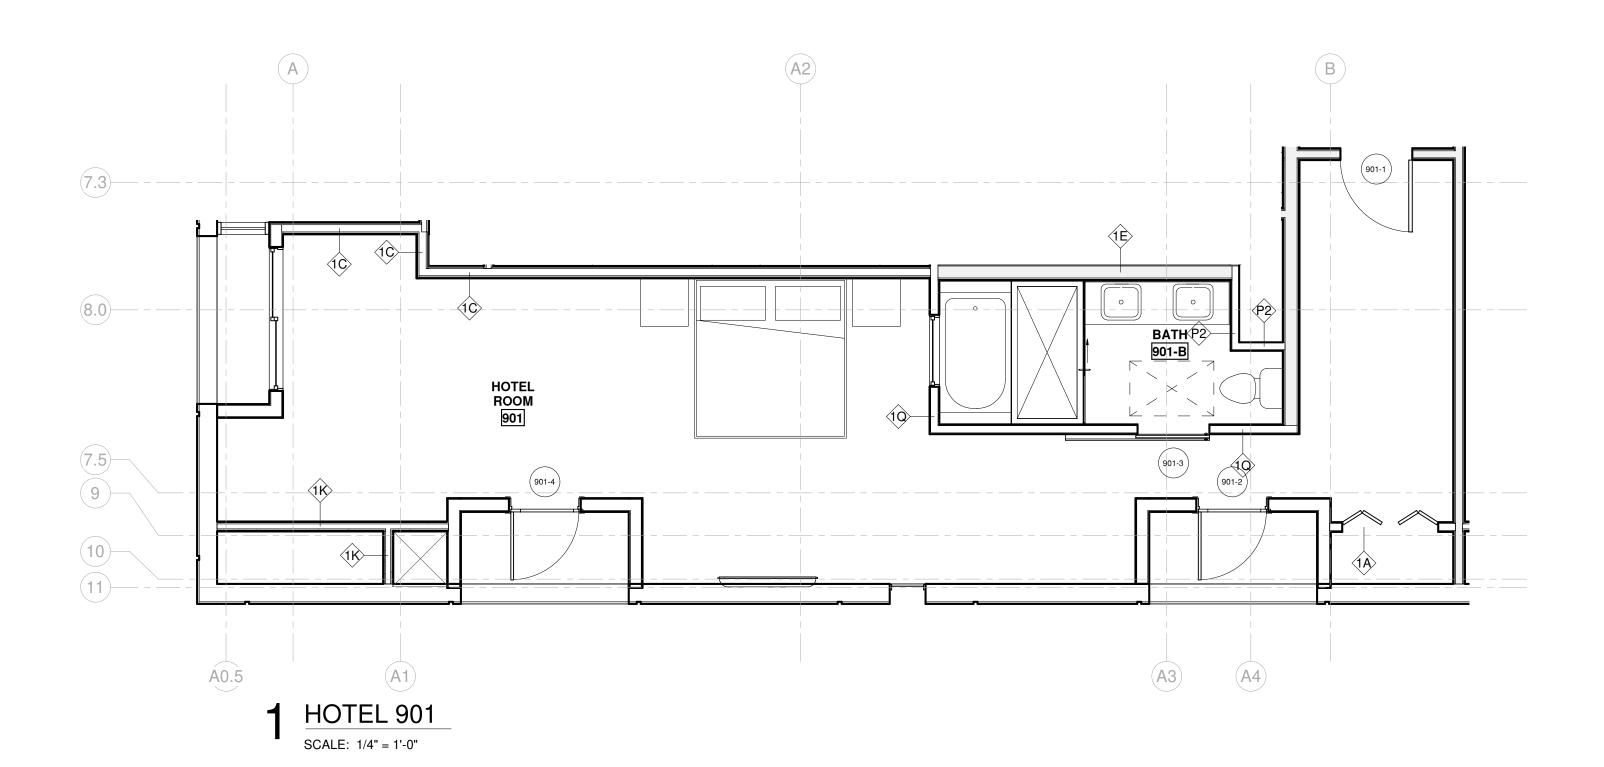

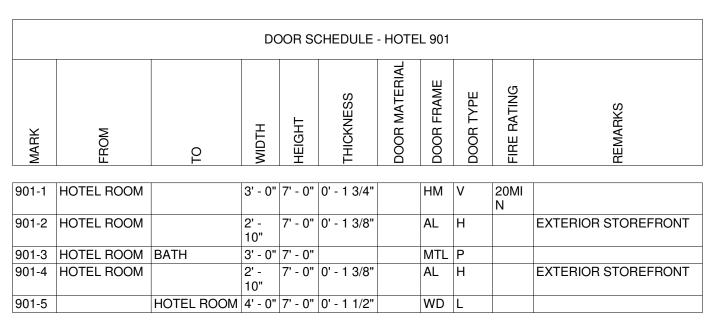

|        | FINISH SCHEDULE - HOTEL 901 |              |             |         |         |         |         |                |             |  |  |  |
|--------|-----------------------------|--------------|-------------|---------|---------|---------|---------|----------------|-------------|--|--|--|
| NUMBER | NAME                        | FLOOR FINISH | BASE FINISH | N. WALL | S. WALL | E. WALL | W. WALL | CEILING FINISH | CEILING HT. |  |  |  |
| 901    | HOTEL ROOM                  |              |             |         |         |         |         |                |             |  |  |  |
| 901-B  | BATH                        |              |             |         |         |         |         |                |             |  |  |  |

HARD ROCK HOTEL

1031 CANAL STREET

NEW ORLEANS, LOUISIANA

189 Maple Ridge Drive Metairie, LA 70001 (504)-885-4477 central@hbsaii.com :-: hbsaii.com

SINCE 1961

THESE PLANS AND SPECIFICATIONS HAVE BEEN PREPARED BY ME OR UNDER MY CLOSE PERSONAL SUPERVISION AND TO THE BEST OF MY KNOWLEDGE AND BELIEF THEY COMPLY WITH ALL CITY, STATE AND FEDERAL REQUIREMENTS, AND I AM NOT PROVIDING CONTRACT ADMINISTRATION.

CERTIFIED CORRECT




THIS DRAWING IS CONFIDENTIAL AND NOT BE LOANED, REPRODUCED, COPIED, EITHER WHOLLY OR IN PART, OR MADE PUBLIC IN ANY MANNER WITHOUT THE WRITTEN CONSENT OF HSSA II ARCHITECTS, A PROFESSIONAL L.L.C. ALL RICHTS OF DESIGN OR INVENTION ARE RESERVED AND WILL REMAIN THE SOLE PROPERTY OF HBSA II ARCHITECTS A PROFESSIONAL L.L.C.

|                              | R                            | EVIS                         | SION                         | HIS                          | TOR                          | Υ                            |  |
|------------------------------|------------------------------|------------------------------|------------------------------|------------------------------|------------------------------|------------------------------|--|
| 4/27/2018                    | 5/4/2018                     | 5/11/2018                    | 5/18/2018                    | 5/25/2018                    | 6/1/2018                     | 6/8/2018                     |  |
|                              |                              |                              |                              |                              |                              |                              |  |
|                              |                              |                              |                              |                              |                              |                              |  |
| ON 1                         | ON 2                         | ON 3                         | 0N 4                         | ON 5                         | 9 NO                         | ON 7                         |  |
| D REVISI                     |  |
| L.I.S. #2 - CLOUD REVISION 1 | L.I.S. #2 - CLOUD REVISION 2 | L.I.S. #2 - CLOUD REVISION 3 | L.I.S. #2 - CLOUD REVISION 4 | L.I.S. #2 - CLOUD REVISION 5 | L.I.S. #2 - CLOUD REVISION 6 | L.I.S. #2 - CLOUD REVISION 7 |  |
| L.I.S. #                     |  |

HOTEL 901


PROJECT#: 1709
PHASE: DD
TEAM: Author
CHECKER: Checker
SCALE: AS NOTED

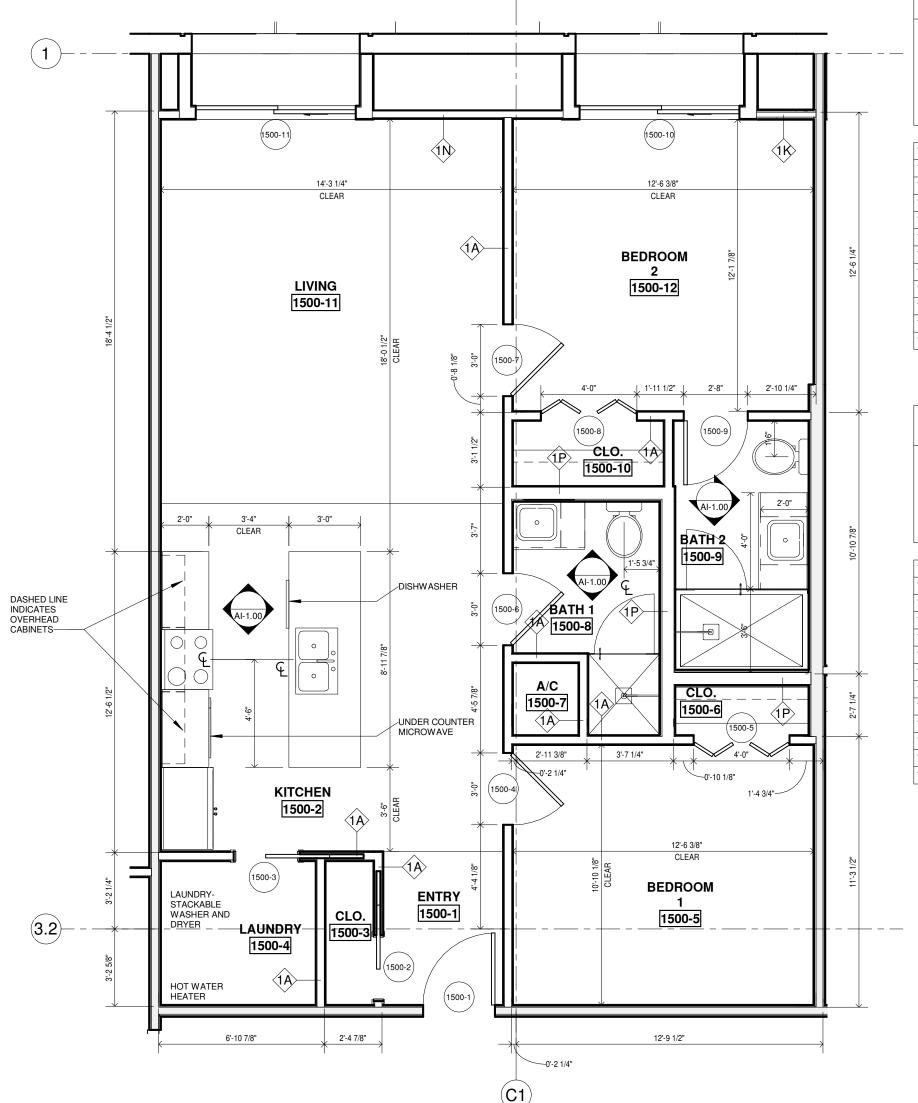


|         |           |           |         | DOOF    | R SCHEDU    | ILE - UN      | NIT 150    | 0         |                |                    |
|---------|-----------|-----------|---------|---------|-------------|---------------|------------|-----------|----------------|--------------------|
| MARK    | FROM      | TO        | WIDTH   | неіднт  | THICKNESS   | DOOR MATERIAL | DOOR FRAME | DOOR TYPE | FIRE<br>RATING | REMARKS            |
| 1500    | 0)/14     | VOOA BOOM | 01 011  | 71 011  | 01 4 0/41   |               | 1.15.4     |           |                | T                  |
| 1500    | GYM       | YOGA ROOM |         |         |             |               | НМ         | С         |                |                    |
| 1500-1  |           | ENTRY     |         |         | 0' - 1 3/4" | WD            | WD         | AA        | 1HR            | 1 HOUR RATED       |
| 1500-2  | CLO.      | ENTRY     | 2' - 8" | 8' - 0" | 0' - 1 3/4" |               | WD         | AA        |                |                    |
| 1500-3  | KITCHEN   | LAUNDRY   | 2' - 8" | 8' - 0" | 0' - 1 3/4" |               | WD         | AA        |                |                    |
| 1500-4  | KITCHEN   | BEDROOM 1 | 3' - 0" | 8' - 0" | 0' - 1 3/4" |               | WD         | AA        |                |                    |
| 1500-5  | CLO.      | BEDROOM 1 | 4' - 0" | 8' - 0" | 0' - 1 1/2" |               | WD         | L         |                |                    |
| 1500-6  | KITCHEN   | BATH 1    | 3' - 0" | 8' - 0" | 0' - 1 3/4" |               | WD         | AA        |                |                    |
| 1500-7  | LIVING    | BEDROOM 2 | 3' - 0" | 8' - 0" | 0' - 1 3/4" |               | WD         | AA        |                |                    |
| 1500-8  | CLO.      | BEDROOM 2 | 4' - 0" | 8' - 0" | 0' - 1 1/2" |               | WD         | L         |                |                    |
| 1500-9  |           |           |         |         | 0' - 1 3/4" |               | WD         | AA        |                |                    |
|         | BEDROOM 2 | _         |         | 7' - 0" |             | WD            | AL         | Н         |                | EXTERIOR STOREFRON |
| 1500-11 | LIVING    |           |         | 7' - 0" |             | AL/GL         | AL         | Н         |                | EXTERIOR STOREFRON |

|         | FINISH SCHEDULE - UNIT 1500 |              |             |         |         |         |         |                |             |  |  |  |
|---------|-----------------------------|--------------|-------------|---------|---------|---------|---------|----------------|-------------|--|--|--|
| NUMBER  | NAME                        | FLOOR FINISH | BASE FINISH | N. WALL | S. WALL | E. WALL | W. WALL | CEILING FINISH | CEILING HT. |  |  |  |
| 1500-1  | ENTRY                       |              |             |         |         |         |         |                |             |  |  |  |
| 1500-2  | KITCHEN                     |              |             |         |         |         |         |                |             |  |  |  |
| 1500-3  | CLO.                        |              |             |         |         |         |         |                |             |  |  |  |
| 1500-4  | LAUNDRY                     |              |             |         |         |         |         |                |             |  |  |  |
| 1500-5  | BEDROOM 1                   |              |             |         |         |         |         |                |             |  |  |  |
| 1500-6  | CLO.                        |              |             |         |         |         |         |                |             |  |  |  |
| 1500-7  | A/C                         |              |             |         |         |         |         |                |             |  |  |  |
| 1500-8  | BATH 1                      |              |             |         |         |         |         |                |             |  |  |  |
| 1500-9  | BATH 2                      |              |             |         |         |         |         |                |             |  |  |  |
| 1500-10 | CLO.                        |              |             |         |         |         |         |                |             |  |  |  |
| 1500-11 | LIVING                      |              |             |         |         |         |         |                |             |  |  |  |
| 1500-11 | LIVING                      | _            |             |         |         |         |         |                |             |  |  |  |
| 1500-12 | BEDROOM 2                   |              |             |         |         |         |         |                |             |  |  |  |


CONDO 1500 ENLARGED PLAN SCALE: 1/4" = 1'-0"

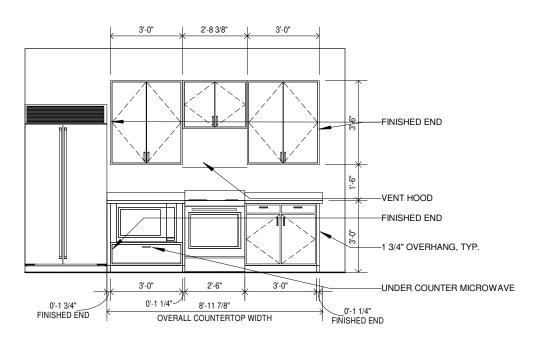

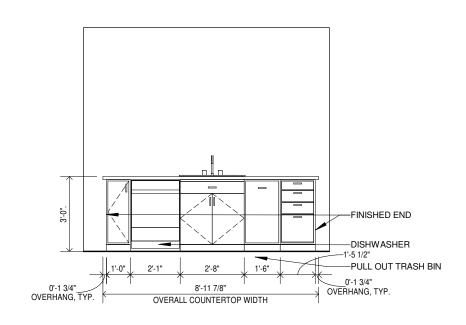


2 KITCHEN UNIT 1500 VIEW A

SCALE: 1/4" = 1'-0"

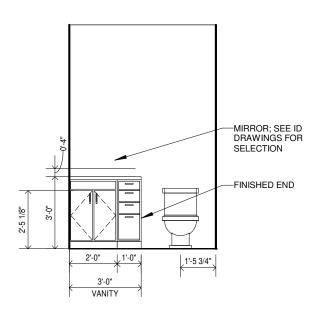


4 BATH 1 UNIT 1500 VIEW A

SCALE: 1/4" = 1'-0"

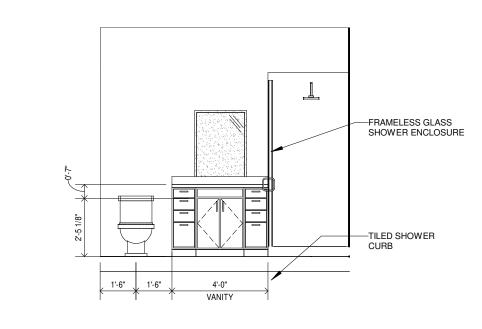

6 BATH 2 UNIT 1500 VIEW A


SCALE: 1/4" = 1'-0"

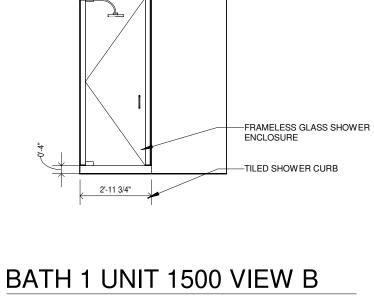


3 KITCHEN UNIT 1500 VIEW B (ISLAND)
SCALE: 1/4" = 1'-0"

5 BATH 1 UNIT 1500 VIEW B

SCALE: 1/4" = 1'-0"

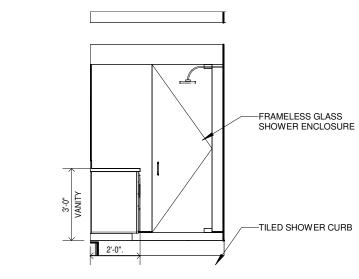


7 BATH 2 UNIT 1500 VIEW B

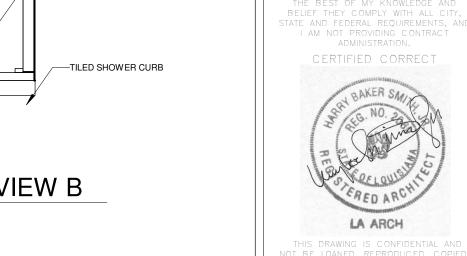

189 Maple Ridge Drive Metairie, LA 70001 (504)-885-4477 central@hbsaii.com :-: hbsaii.com


SINCE 1961

1031 CANAL STREET NEW ORLEANS, LOUISIANA

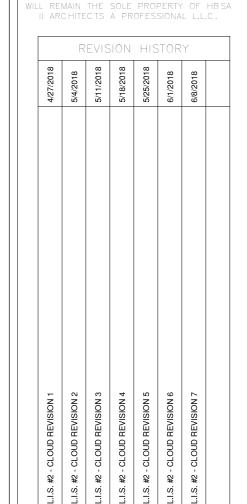

CONDO 1500


PROJECT#: 1709 PHASE: DD TEAM: Author CHECKER: Checker SCALE: AS NOTED

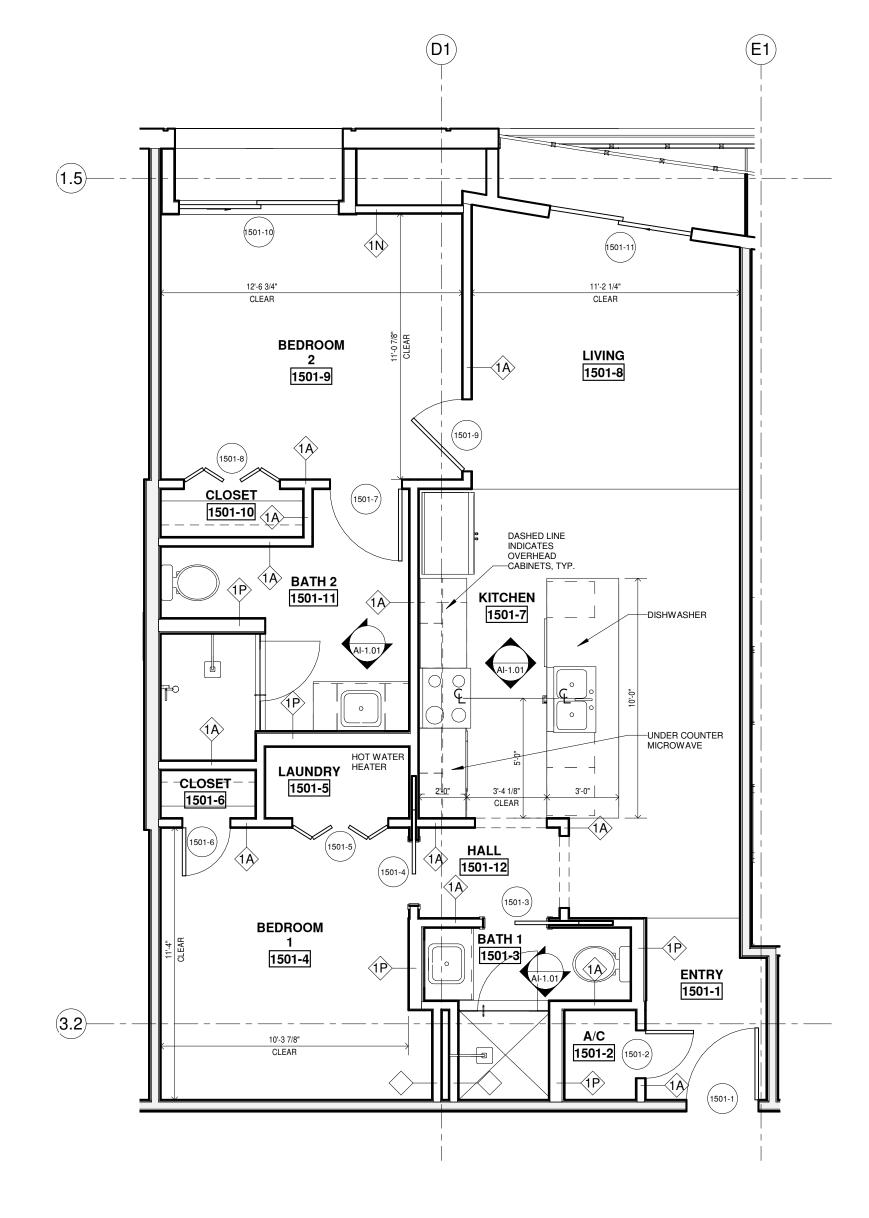


|         | DOOR SCHEDULE - UNIT 1501 |           |         |         |             |               |            |           |             |                        |  |  |  |
|---------|---------------------------|-----------|---------|---------|-------------|---------------|------------|-----------|-------------|------------------------|--|--|--|
| MARK    | FROM                      | 01        | WIDTH   | НЕІСНТ  | THICKNESS   | DOOR MATERIAL | DOOR FRAME | DOOR TYPE | FIRE RATING | REMARKS                |  |  |  |
| 1501-1  |                           | ENTRY     | 3' - 0" | 8' - 0" | 0' - 1 3/4" | WD            | WD         | AA        | 1HR         | 1 HOUR RATED           |  |  |  |
| 1501-2  | A/C                       | ENTRY     |         |         | 0' - 1 3/4" |               | WD         | AA        |             |                        |  |  |  |
| 1501-3  | HALL                      | BATH 1    |         |         | 0' - 1 3/4" |               | WD         | AA        |             |                        |  |  |  |
| 1501-4  | HALL                      | BEDROOM 1 | 2' - 8" | 8' - 0" | 0' - 1 3/4" | WD            | WD         | AA        |             |                        |  |  |  |
| 1501-5  | LAUNDRY                   | BEDROOM 1 | 4' - 0" | 8' - 0" | 0' - 1 1/2" | WD            | WD         | L         |             |                        |  |  |  |
| 1501-6  | CLOSET                    | BEDROOM 1 | 2' - 0" | 8' - 0" | 0' - 1 3/4" | WD            | WD         | AA        |             |                        |  |  |  |
| 1501-7  | BEDROOM 2                 | BATH 2    | 3' - 0" | 8' - 0" | 0' - 1 3/4" | WD            | WD         | AA        |             |                        |  |  |  |
| 1501-8  | CLOSET                    | BEDROOM 2 |         |         | 0' - 1 1/2" |               | WD         | AA        |             |                        |  |  |  |
| 1501-9  | BEDROOM 2                 | LIVING    | 3' - 0" | 8' - 0" | 0' - 1 3/4" | WD            | WD         | AA        |             |                        |  |  |  |
| 1501-10 |                           | BEDROOM 2 | 6' - 8" | 7' - 0" | 0' - 2"     | AL/GL         | AL         | Н         |             | EXTERIOR<br>STOREFRONT |  |  |  |
| 1501-11 | LIVING                    |           | 6' - 0" | 7' - 0" | 0' - 2"     | AL/GL         | AL         | Н         |             | EXTERIOR<br>STOREFRONT |  |  |  |
|         |                           |           |         |         |             |               |            |           |             |                        |  |  |  |


|         |           |              | FINISH      | SCHEDUL | E - UNIT 15 | 501     |         |                |             |
|---------|-----------|--------------|-------------|---------|-------------|---------|---------|----------------|-------------|
| NUMBER  | NAME      | FLOOR FINISH | BASE FINISH | N. WALL | S. WALL     | E. WALL | W. WALL | CEILING FINISH | CEILING HT. |
|         |           |              |             |         |             |         |         |                |             |
| 1501-1  | ENTRY     |              |             |         |             |         |         |                |             |
| 1501-2  | A/C       |              |             |         |             |         |         |                |             |
| 1501-3  | BATH 1    |              |             |         |             |         |         |                |             |
| 1501-4  | BEDROOM 1 |              |             |         |             |         |         |                |             |
| 1501-5  | LAUNDRY   |              |             |         |             |         |         |                |             |
| 1501-6  | CLOSET    |              |             |         |             |         |         |                |             |
| 1501-7  | KITCHEN   |              |             |         |             |         |         |                |             |
| 1501-8  | LIVING    |              |             |         |             |         |         |                |             |
| 1501-9  | BEDROOM 2 |              |             |         |             |         |         |                |             |
| 1501-10 | CLOSET    |              |             |         |             |         |         |                |             |
| 1501-11 | BATH 2    |              |             |         |             |         |         |                |             |
| 1501-12 | HALL      |              |             |         |             |         |         |                |             |

CONDO 1501 ENLARGED PLAN SCALE: 1/4" = 1'-0"

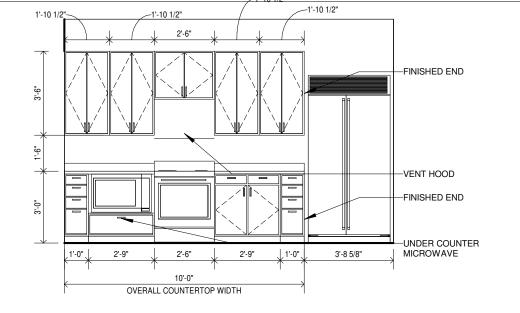


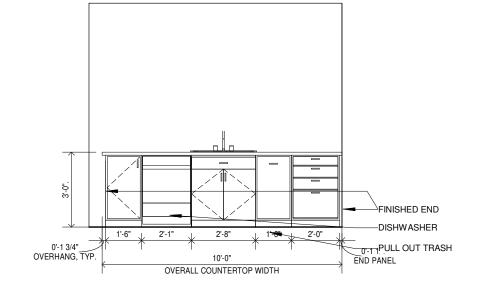


2 KITCHEN UNIT 1501 VIEW A
SCALE: 1/4" = 1'-0"

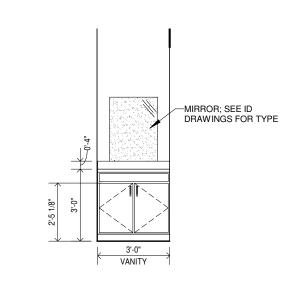


3 KITCHEN UNIT 1501 VIEW B
SCALE: 1/4" = 1'-0"

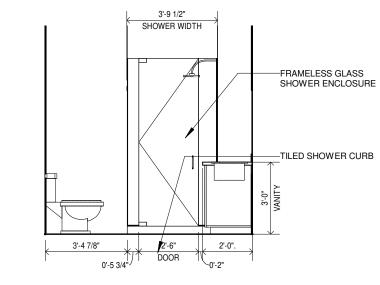


4 BATH 1 UNIT 1501 VIEW A
SCALE: 1/4" = 1'-0"

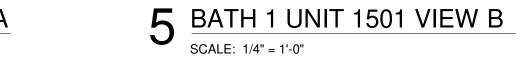

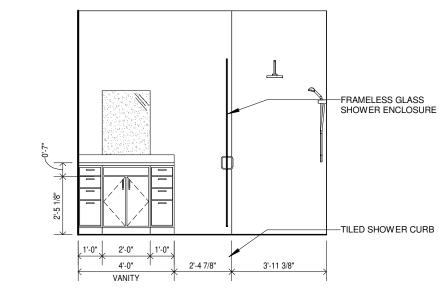


6 BATH 2 UNIT 1501 VIEW A

SCALE: 1/4" = 1'-0"

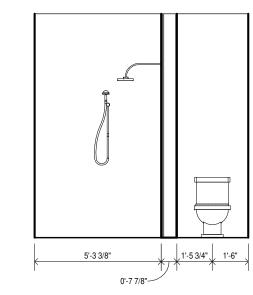

7 BATH 2 UNIT 1501 VIEW B
SCALE: 1/4" = 1'-0"

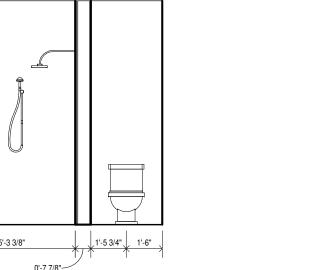


REVISION HISTORY

CERTIFIED CORRECT

189 Maple Ridge Drive Metairie, LA 70001 (504)-885-4477 central@hbsaii.com :-: hbsaii.com

SINCE 1961

1031 CANAL STREET NEW ORLEANS, LOUISIANA

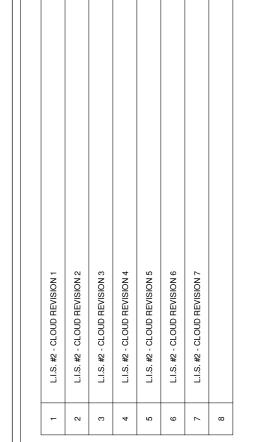

CONDO 1501

PROJECT#: 1709\_ PHASE: DD
TEAM: Author TEAM: Author


CHECKER: Checker

SCALE: AS NOTED

ISSUED: 4/20/2018

SHEET#:

Al-1.01

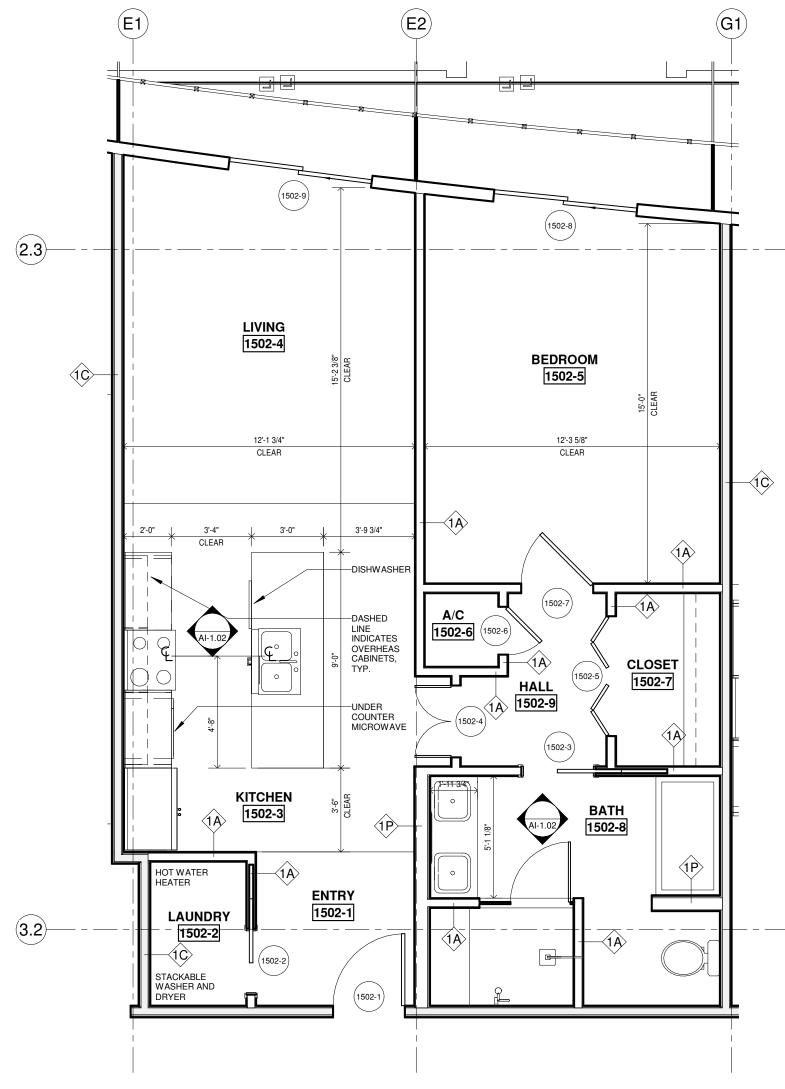


| 1 | CONDO 1502 ENLARGED PLAN |
|---|--------------------------|

SCALE: 1/4" = 1'-0"


|        | DOOR SCHEDULE - UNIT 1502 |         |         |         |             |               |            |           |             |                     |  |  |  |
|--------|---------------------------|---------|---------|---------|-------------|---------------|------------|-----------|-------------|---------------------|--|--|--|
| MARK   | FROM                      | TO.     | WIDTH   | HEIGHT  | THICKNESS   | DOOR MATERIAL | DOOR FRAME | DOOR TYPE | FIRE RATING | REMARKS             |  |  |  |
| 1502   | GYM                       | GYM RR  | 3' - 0" | 7' - 0" | 0' - 1 3/4" |               | НМ         | С         |             |                     |  |  |  |
| 1502-1 |                           | ENTRY   | 3' - 0" | 8' - 0" | 0' - 1 3/4" | WD            | WD         | AA        | 1HR         | 1 HOUR RATED        |  |  |  |
| 1502-2 | LAUNDRY                   | ENTRY   | 2' - 8" | 8' - 0" | 0' - 1 3/4" | WD            | WD         | AA        |             |                     |  |  |  |
| 1502-3 | HALL                      | BATH    | 3' - 0" | 8' - 0" | 0' - 1 3/4" | WD            | WD         | AA        |             |                     |  |  |  |
| 1502-4 | HALL                      | KITCHEN | 3' - 0" | 8' - 0" | 0' - 1 3/4" | WD            | WD         | CC        |             | DOUBLE DOOR / PAIR  |  |  |  |
| 1502-5 | HALL                      | CLOSET  | 5' - 0" | 8' - 0" | 0' - 1 1/2" | WD            | WD         | L         |             |                     |  |  |  |
| 1502-6 | A/C                       | HALL    | 2' - 0" | 8' - 0" | 0' - 1 3/4" | WD            | WD         | AA        |             |                     |  |  |  |
| 1502-7 | HALL                      | BEDROOM | 3' - 0" | 8' - 0" | 0' - 1 3/4" | WD            | WD         | AA        |             |                     |  |  |  |
| 1502-8 | BEDROOM                   |         | 6' - 0" | 7' - 0" | 0' - 2"     | AL/GL         | AL         | Н         |             | EXTERIOR STOREFRONT |  |  |  |
| 1502-9 | LIVING                    |         | 6' - 0" | 7' - 0" | 0' - 2"     | AL/GL         | AL         | Н         |             | EXTERIOR STOREFRONT |  |  |  |

|        |         |              | FINISH      | I SCHEDUL | .E - UNIT 1 | 502     |         |                |             |
|--------|---------|--------------|-------------|-----------|-------------|---------|---------|----------------|-------------|
| NUMBER | NAME    | FLOOR FINISH | BASE FINISH | N. WALL   | S. WALL     | E. WALL | W. WALL | CEILING FINISH | CEILING HT. |
|        |         |              |             |           |             |         |         |                |             |
| 1502   | GYM RR  |              |             |           |             |         |         |                |             |
| 1502-1 | ENTRY   |              |             |           |             |         |         |                |             |
| 1502-2 | LAUNDRY |              |             |           |             |         |         |                |             |
| 1502-3 | KITCHEN |              |             |           |             |         |         |                |             |
| 1502-4 | LIVING  |              |             |           |             |         |         |                |             |
| 1502-5 | BEDROOM |              |             |           |             |         |         |                |             |
| 1502-6 | A/C     |              |             |           |             |         |         |                |             |
| 1502-7 | CLOSET  |              |             |           |             |         |         |                |             |
| 1502-8 | BATH    |              |             |           |             |         |         |                |             |
| 1502-9 | HALL    |              |             |           |             |         |         |                |             |

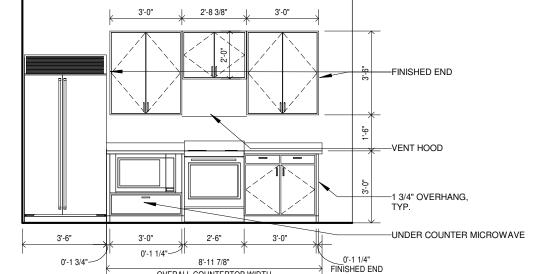


2 KITCHEN UNIT 1502 VIEW A

SCALE: 1/4" = 1'-0"

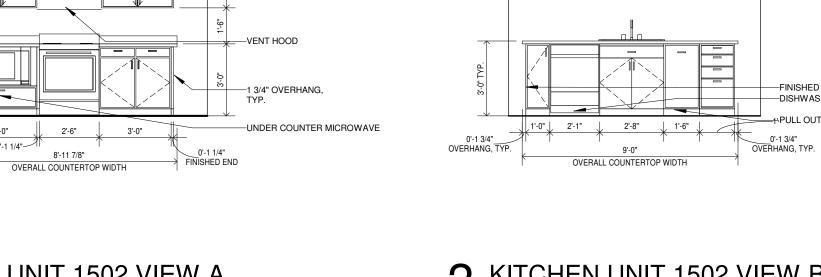


3 KITCHEN UNIT 1502 VIEW B
SCALE: 1/4" = 1'-0"

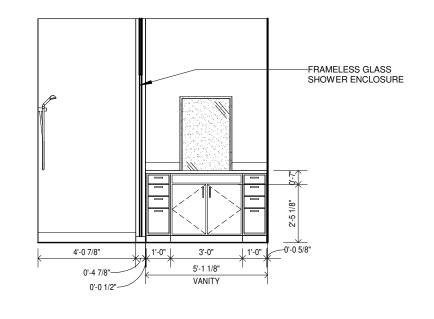


4 BATH UNIT 1502 VIEW A

SCALE: 1/4" = 1'-0"

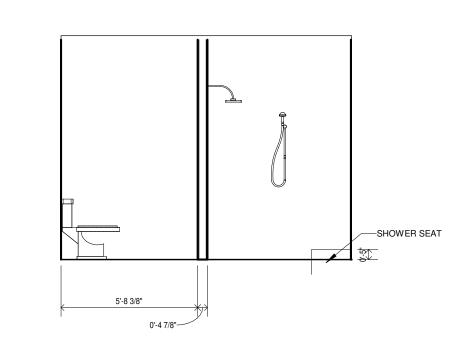


5 BATH UNIT 1502 VIEW B
SCALE: 1/4" = 1'-0"

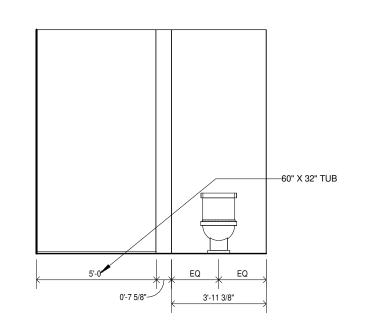

6 BATH UNIT 1502 VIEW C

SCALE: 1/4" = 1'-0"

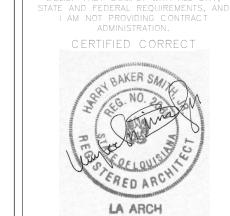


189 Maple Ridge Drive Metairie, LA 70001 (504)-885-4477 central@hbsaii.com :-: hbsaii.com

SINCE 1961


1031 CANAL STREET NEW ORLEANS, LOUISIANA

THIS DRAWING IS CONFIDENTIAL AND
NOT BE LOANED, REPRODUCED, COPIED,
EITHER WHOLLY OR IN PART, OR MADE
PUBLIC IN ANY MANNER WITHOUT THE
WRITTEN CONSENT OF HBSA II ARCHITECTS,
A PROFESSIONAL L.L.C. ALL RIGHTS OF
DESIGN OR INVENTION ARE RESERVED AND
WILL REMAIN THE SOLE PROPERTY OF HBSA
II ARCHITECTS A PROFESSIONAL L.L.C.

REVISION HISTORY

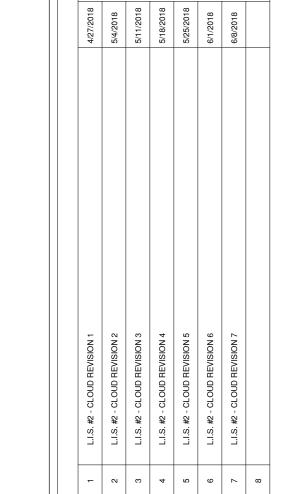

PROJECT#: 1709
PHASE: DD
TEAM: Author
CHECKER: Checker
SCALE: AS NOTED
ISSUED: 4/20/2018

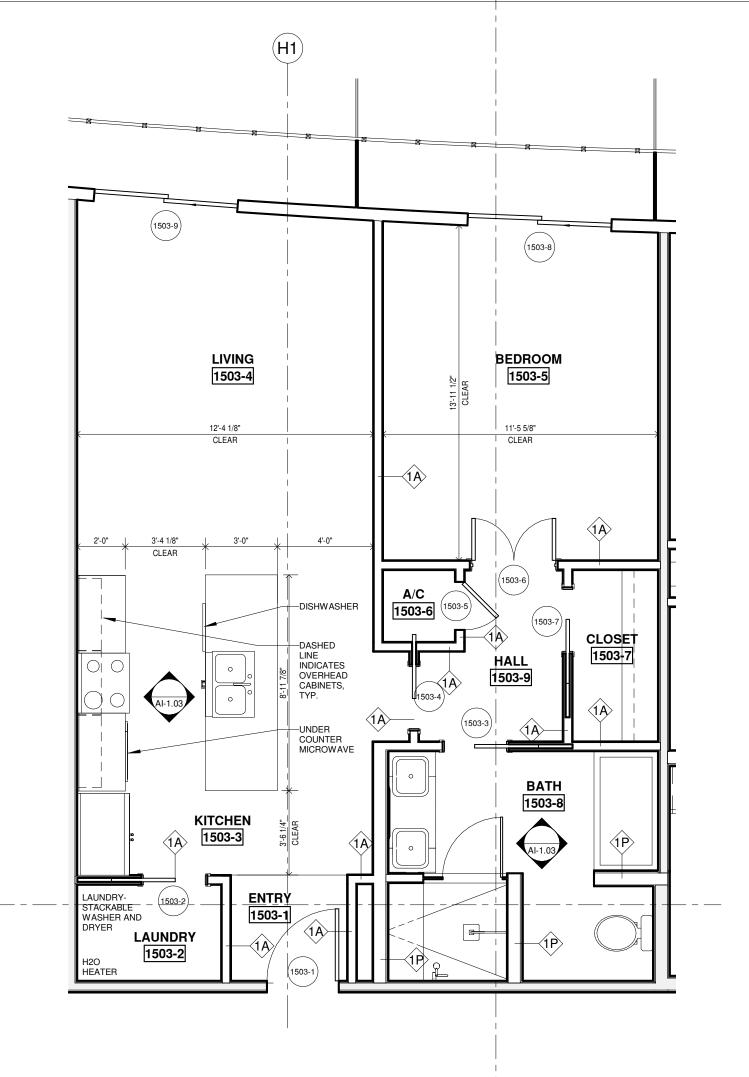


|        |         |         |         | DOOR    | SCHEDUI     | E - UN        | IT 1503    |           |             |                     |
|--------|---------|---------|---------|---------|-------------|---------------|------------|-----------|-------------|---------------------|
| MARK   | FROM    | 01      | WIDTH   | НЕІСНТ  | THICKNESS   | DOOR MATERIAL | DOOR FRAME | DOOR TYPE | FIRE RATING | REMARKS             |
|        |         |         |         |         |             |               |            |           |             |                     |
| 1503   | GYM     | IDF     | 3' - 0" | 7' - 0" | 0' - 1 3/4" |               | HM         | С         |             |                     |
| 1503-1 |         | ENTRY   | 3' - 0" | 8' - 0" | 0' - 1 3/4" | WD            | WD         | AA        | 1HR         | 1 HOUR RATED        |
| 1503-2 | KITCHEN | LAUNDRY | 2' - 8" | 8' - 0" | 0' - 1 3/4" | WD            | WD         | AA        |             |                     |
| 1503-3 | HALL    | BATH    | 2' - 8" | 8' - 0" | 0' - 1 3/4" | WD            | WD         | AA        |             |                     |
| 1503-4 | HALL    | KITCHEN | 2' - 8" | 8' - 0" | 0' - 1 3/4" | WD            | WD         | AA        |             |                     |
| 1503-5 | A/C     | HALL    | 2' - 0" | 8' - 0" | 0' - 1 3/4" | WD            | WD         | AA        |             |                     |
| 1503-6 | HALL    | BEDROOM | 3' - 6" | 8' - 0" | 0' - 1 3/4" | WD            | WD         | AA        |             |                     |
| 1503-7 | HALL    | CLOSET  | 2' - 8" | 8' - 0" | 0' - 1 3/4" | WD            | WD         | AA        |             |                     |
| 1503-8 | BEDROOM |         | 6' - 0" | 7' - 0" | 0' - 2"     | AL/GL         | AL         | Н         |             | EXTERIOR STOREFRONT |
| 1503-9 | LIVING  |         | 6' - 0" | 7' - 0" | 0' - 2"     | AL/GL         | AL         | Н         |             | EXTERIOR STOREFRONT |


|        |         |              | FINISH      | SCHEDUL | .E - UNIT 1 | 503     |         |                |             |
|--------|---------|--------------|-------------|---------|-------------|---------|---------|----------------|-------------|
| NUMBER | NAME    | FLOOR FINISH | BASE FINISH | N. WALL | S. WALL     | E. WALL | W. WALL | CEILING FINISH | CEILING HT. |
|        |         |              |             |         |             | -       |         |                |             |
| 1503   | IDF     |              |             |         |             |         |         |                |             |
| 1503-1 | ENTRY   |              |             |         |             |         |         |                |             |
| 1503-2 | LAUNDRY |              |             |         |             |         |         |                |             |
| 1503-3 | KITCHEN |              |             |         |             |         |         |                |             |
| 1503-4 | LIVING  |              |             |         |             |         |         |                |             |
| 1503-5 | BEDROOM |              |             |         |             |         |         |                |             |
| 1503-6 | A/C     |              |             |         |             |         |         |                |             |
| 1503-7 | CLOSET  |              |             |         |             |         |         |                |             |
| 1503-8 | BATH    |              |             |         |             |         |         |                |             |
| 1503-9 | HALL    |              |             |         |             |         |         |                |             |

CONDO 1503 ENLARGED PLAN

SCALE: 1/4" = 1'-0"

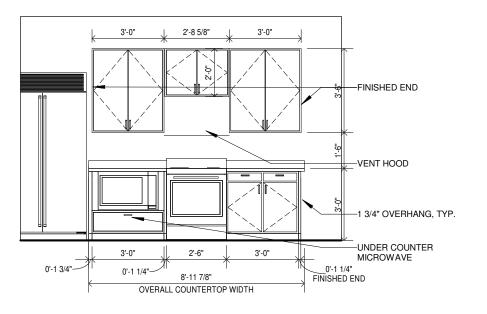


## 2 KITCHEN UNIT 1503 VIEW A SCALE: 1/4" = 1'-0"

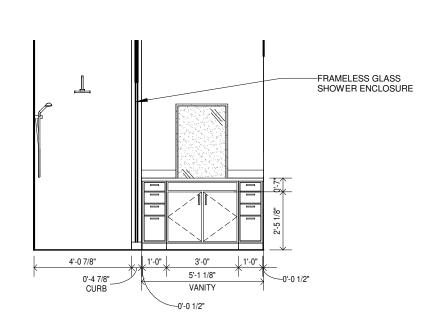


4 BATH UNIT 1503 VIEW A


SCALE: 1/4" = 1'-0"

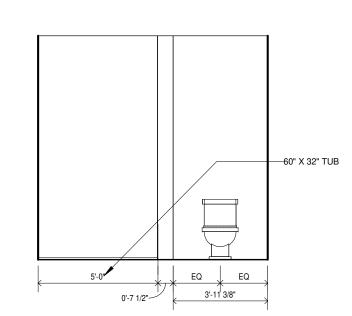

6 BATH UNIT 1503 VIEW C

SCALE: 1/4" = 1'-0"

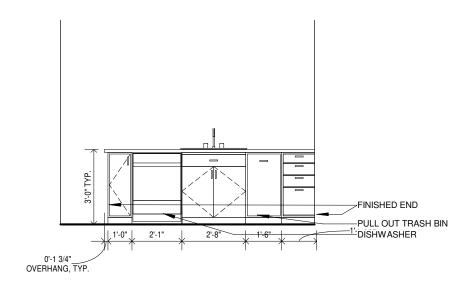

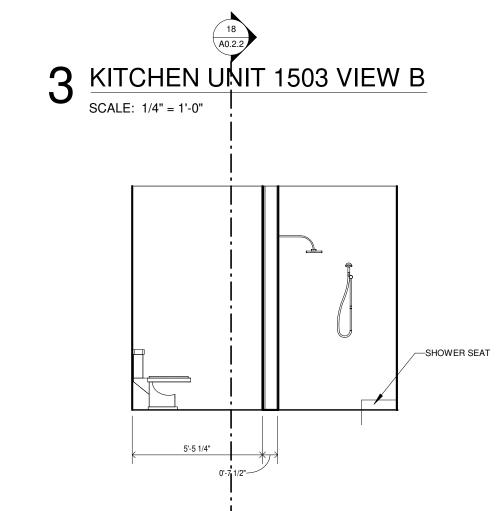

5 BATH UNIT 1503 VIEW B
SCALE: 1/4" = 1'-0"



189 Maple Ridge Drive Metairie, LA 70001 (504)-885-4477 central@hbsaii.com :-: hbsaii.com


SINCE 1961

THESE PLANS AND SPECIFICATIONS HAVE
BEEN PREPARED BY ME OR UNDER MY
CLOSE PERSONAL SUPERVISION AND TO
THE BEST OF MY KNOWLEDGE AND
BELIEF THEY COMPLY WITH ALL CITY,
STATE AND FEDERAL REQUIREMENTS, AND
I AM NOT PROVIDING CONTRACT
ADMINISTRATION.

CERTIFIED CORRECT




THIS DRAWING IS CONFIDENTIAL AND NOT BE LOANED, REPRODUCED, COPIED, EITHER WHOLLY OR IN PART, OR MADE PUBLIC IN ANY MANNER WITHOUT THE WRITTEN CONSENT OF HBSA II ARCHITECTS, A PROFESSIONAL L.L.C. ALL RIGHTS OF DESIGN OR INVENTION ARE RESERVED AND WILL REMAIN THE SOLE PROPERTY OF HBSA

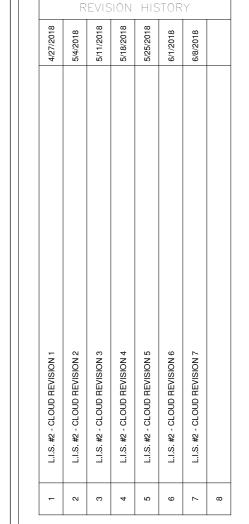

CONDO 1503

PROJECT#: 1709
PHASE: DD
TEAM: Author
CHECKER: Checker
SCALE: AS NOTED
ISSUED: 4/20/2018

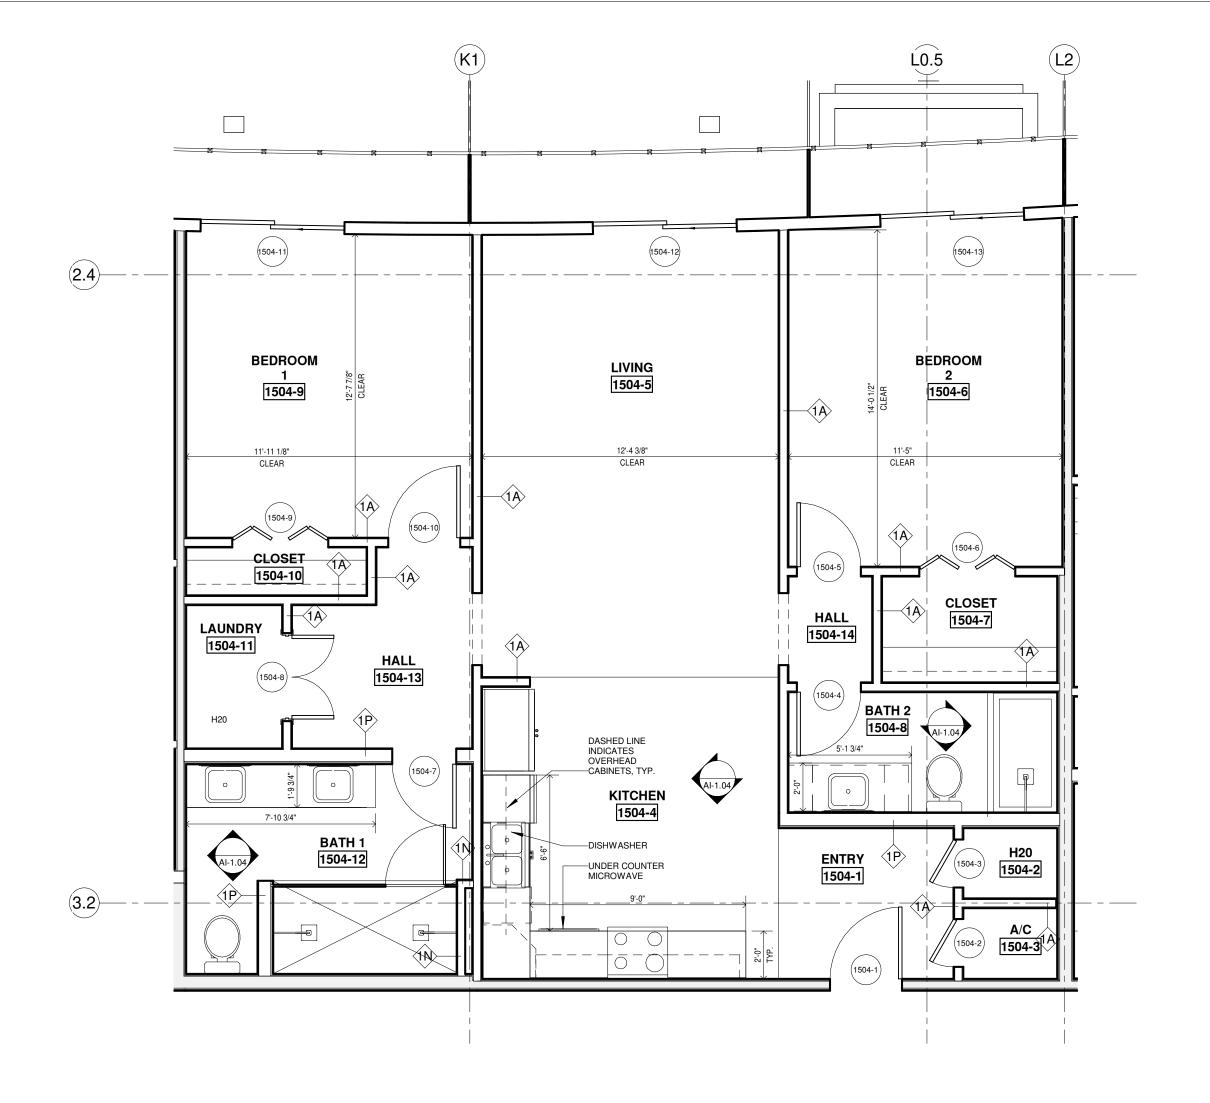

| 1504-4   | HALL   | BATH 2         |         |             | 0' - 1 3/ |                     | WD           | AA   |          |         |                |             |
|--|--|----------------|---------|-------------|-----------|---------------------|--------------|------|----------|---------|----------------|-------------|
| 1504-5   | BEDROOM 2  |                |         |             | 0' - 1 3/ |                     | WD           | AA   |          |         |                |             |
| 1504-6   | CLOSET   | BEDROOM 2      | 4' - 0" | 8' - 0"     | 0' - 1 1/ | 2" WD               | WD           | L    |          |         |                |             |
| 1504-7   | HALL   | BATH 1         |         |             | 0' - 1 3/ |                     | WD           | AA   |          |         |                |             |
| 1504-8   | LAUNDRY  | HALL           |         |             | 0' - 1 3/ |                     | WD           | CC   |          | DOUBLE  | DOOR / PAIR    |             |
| 1504-9   | BEDROOM 1  | CLOSET         |         |             | 0' - 1 1/ |                     | WD           | L    |          |         |                |             |
| 1504-10  |  | BEDROOM 1      |         |             | 0' - 1 3/ |                     | WD           | AA   |          |         |                |             |
| 1504-11  | BEDROOM 1  |                | 6' - 0" |             |           | AL/GL               |              | Н    |          |         | R STOREFRONT   |             |
| 1504-12  |  |                | 6' - 0" |             |           | AL/GL               |              | Н    |          |         | R STOREFRONT   |             |
| 1504-13  | BEDROOM 2  |                | 6' - 0" | 7' - 0"     | 0' - 2"   | AL/GL               | AL           | Н    |          | EXTERIO | R STOREFRONT   |             |
|  |  |                |         |             |           |                     |              |      |          |         |                |             |
|  |  |                |         | F           | INISH S   | CHEDULE             | E - UNIT     | 1504 |          |         |                |             |
|  |  |                |         | •           |           |                     |              |      |          |         |                |             |
|  |  | FLOOR FINISH   |         | SH          |           |                     |              |      |          |         | CEILING FINISH | Ŀ           |
| iii.   |  | Ē              |         | 롣           |           |                     |              |      | _        | -       | (5             | (5<br>T     |
| 18   | ш  | O <sub>R</sub> |         | Ш           |           | AL                  | Æ            |      | A        | \A      | Ĭ              | Ĭ.          |
|  |  |                |         |             |           |                     |              |      |          |         |                |             |
| ≧  | I ΔΥ   | 9              |         | AS          |           | <u>≶</u>            | ≥.           |      | ≥.       | >.      | <u> </u>       | E           |
| NUMBER   | NAME   | FLO            |         | BASE FINISH |           | N. WALL             | S. WALL      |      | E. WALL  | W. WALL | CEII           | CEILING HT. |
|  |  | L FLO          |         | BAS         |           | s<br>z              | <i>S</i><br> |      | ы<br>Ж   | N .     | CEII           | CEIL        |
| 1504   | IDF  | FLO            |         | BAS         |           | s<br>z              | <i>⊗</i>     |      | <u>ы</u> | W. V    | CEII           | CEIL        |
| 1504<br>1504-1   | IDF<br>ENTRY   | FLO            |         | BAS         |           | S<br>Z              | <u> </u>     |      | <u>ы</u> | W. V    | CEII           | CEIL        |
| 1504<br>1504-1<br>1504-2   | IDF<br>ENTRY<br>H20  | FLO            |         | BAS         |           | Z<br>S              | s<br>vi      |      | <u> </u> | W. V    | OEII           | CEIL        |
| 1504<br>1504-1   | IDF<br>ENTRY<br>H20<br>A/C   | FLO            |         | BAS         |           | X Z                 | S<br>Ø       |      | <u>ш</u> | W. W    | OEII           | CEIL        |
| 1504<br>1504-1<br>1504-2<br>1504-3   | IDF<br>ENTRY<br>H20  | FLO            |         | BAS         |           | S Z                 | S G          |      | <u>ы</u> | . W     | CEII           | CEIL        |
| 1504<br>1504-1<br>1504-2<br>1504-3<br>1504-4   | IDF<br>ENTRY<br>H20<br>A/C<br>KITCHEN  | FLO            |         | BAS         |           | <i>S</i> . <i>Z</i> | S O          |      | <u>ы</u> | W. V    | CEII           | CEIL        |
| 1504<br>1504-1<br>1504-2<br>1504-3<br>1504-4<br>1504-5   | IDF ENTRY H20 A/C KITCHEN LIVING   | FLO            |         | BAS         |           | <i>S</i> . <i>Z</i> | S O          |      | <u>ы</u> | W. W    | OEII           | CEIL        |
| 1504<br>1504-1<br>1504-2<br>1504-3<br>1504-4<br>1504-5<br>1504-6   | IDF<br>ENTRY<br>H20<br>A/C<br>KITCHEN<br>LIVING<br>BEDROOM 2                             | FLO            |         | BAS         |           | \$ Z                | × · · ·      |      | <u>ы</u> | W. W    | CEII           | CEIL        |
| 1504<br>1504-1<br>1504-2<br>1504-3<br>1504-4<br>1504-5<br>1504-6<br>1504-7   | IDF ENTRY H20 A/C KITCHEN LIVING BEDROOM 2 CLOSET  | FLO            |         | BAS         |           | <i>S</i> . <i>Z</i> | S G          |      | <u>ы</u> | W. W    | CEII           | CEIL        |
| 1504<br>1504-1<br>1504-2<br>1504-3<br>1504-4<br>1504-5<br>1504-6<br>1504-7<br>1504-8<br>1504-9                       | IDF ENTRY H20 A/C KITCHEN LIVING BEDROOM 2 CLOSET BATH 2                                 | FLO            |         | BAS         |           | <i>S</i> . <i>Z</i> | S O          |      | <u>ы</u> | W. W    | OEII           | CEIL        |
| 1504<br>1504-1<br>1504-2<br>1504-3<br>1504-4<br>1504-5<br>1504-6<br>1504-7<br>1504-8<br>1504-9<br>1504-10            | IDF ENTRY H20 A/C KITCHEN LIVING BEDROOM 2 CLOSET BATH 2 BEDROOM 1                       | FLO            |         | BAS         |           | <i>S</i> . <i>Z</i> | S O          |      | <u>ы</u> | W. W    | OEII           | CEIL        |
| 1504<br>1504-1<br>1504-2<br>1504-3<br>1504-4<br>1504-5<br>1504-6<br>1504-7<br>1504-8<br>1504-9<br>1504-10            | IDF ENTRY H20 A/C KITCHEN LIVING BEDROOM 2 CLOSET BATH 2 BEDROOM 1 CLOSET LAUNDRY        | FLO            |         | BAS         |           | \$ Z                | S G          |      | <u>ы</u> | W. W    | CEII           | CEIL        |
| 1504<br>1504-1<br>1504-2<br>1504-3<br>1504-4<br>1504-5<br>1504-6<br>1504-7<br>1504-8<br>1504-9<br>1504-10<br>1504-11 | IDF ENTRY H20 A/C KITCHEN LIVING BEDROOM 2 CLOSET BATH 2 BEDROOM 1 CLOSET LAUNDRY BATH 1 | FLO            |         | BAS         |           | \$ . Z              | × vi         |      | <u>ы</u> | W. W    | OEII           | CEIL        |

| 3' - 0" | 8' - 0" | 0' - 1 3/4" | WD | WD | AA | 1HR | 1 HOUR RATED | 2' - 0" | 8' - 0" | 0' - 1 3/4" | WD | WD | AA |

DOOR SCHEDULE - UNIT 1504

2' - 0" 8' - 0" 0' - 1 3/4" WD WD AA

1504

1504-1


1504-2 A/C


1504-3 H20

YOGA ROOM

ENTRY


#### 1 CONDO 1504 ENLARGED PLAN SCALE: 1/4" = 1'-0"

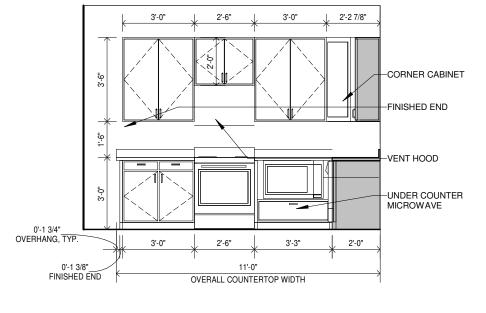


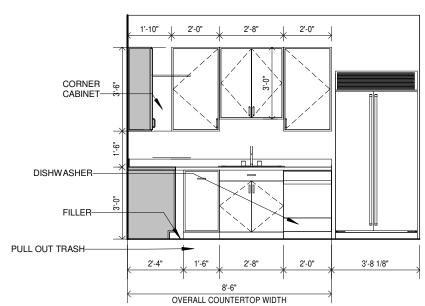

2 KITCHEN UNIT 1504 VIEW A SCALE: 1/4" = 1'-0"




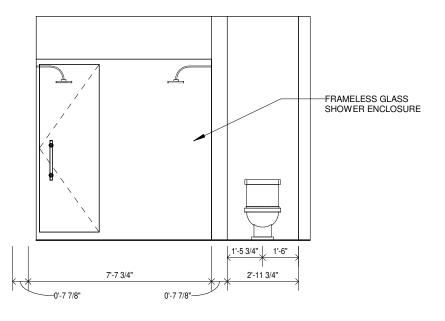


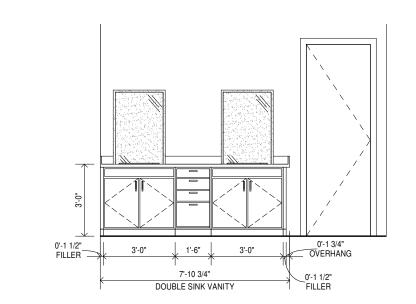

4 BATH 1 UNIT 1504 VIEW A
SCALE: 1/4" = 1'-0"




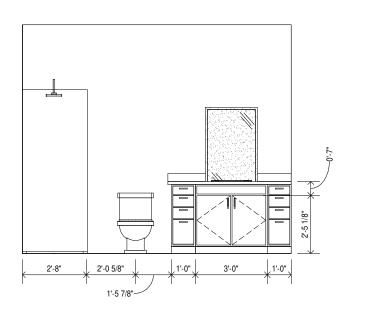


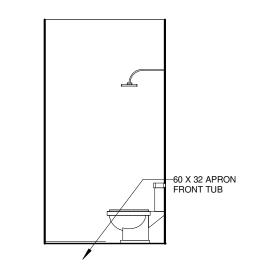

6 BATH 2 UNIT 1504 VIEW A

7 BATH 2 UNIT 1504 VIEW B
SCALE: 1/4" = 1'-0"

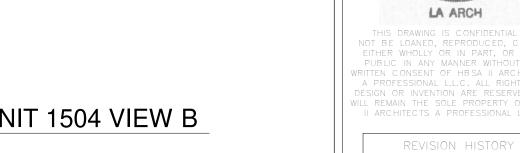

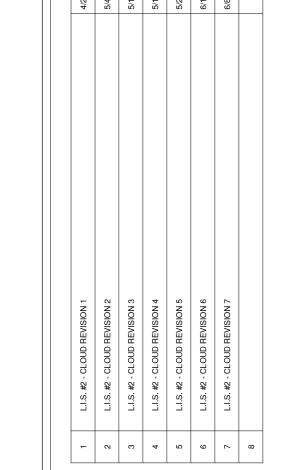

CERTIFIED CORRECT


189 Maple Ridge Drive Metairie, LA 70001 (504)-885-4477 central@hbsaii.com :-: hbsaii.com

SINCE 1961

1031 CANAL STREET NEW ORLEANS, LOUISIANA


CONDO 1504

PROJECT#: 1709
PHASE: DD
TEAM: Author
CHECKER: Checker
SCALE: AS NOTED
ISSUED: 4/20/2018

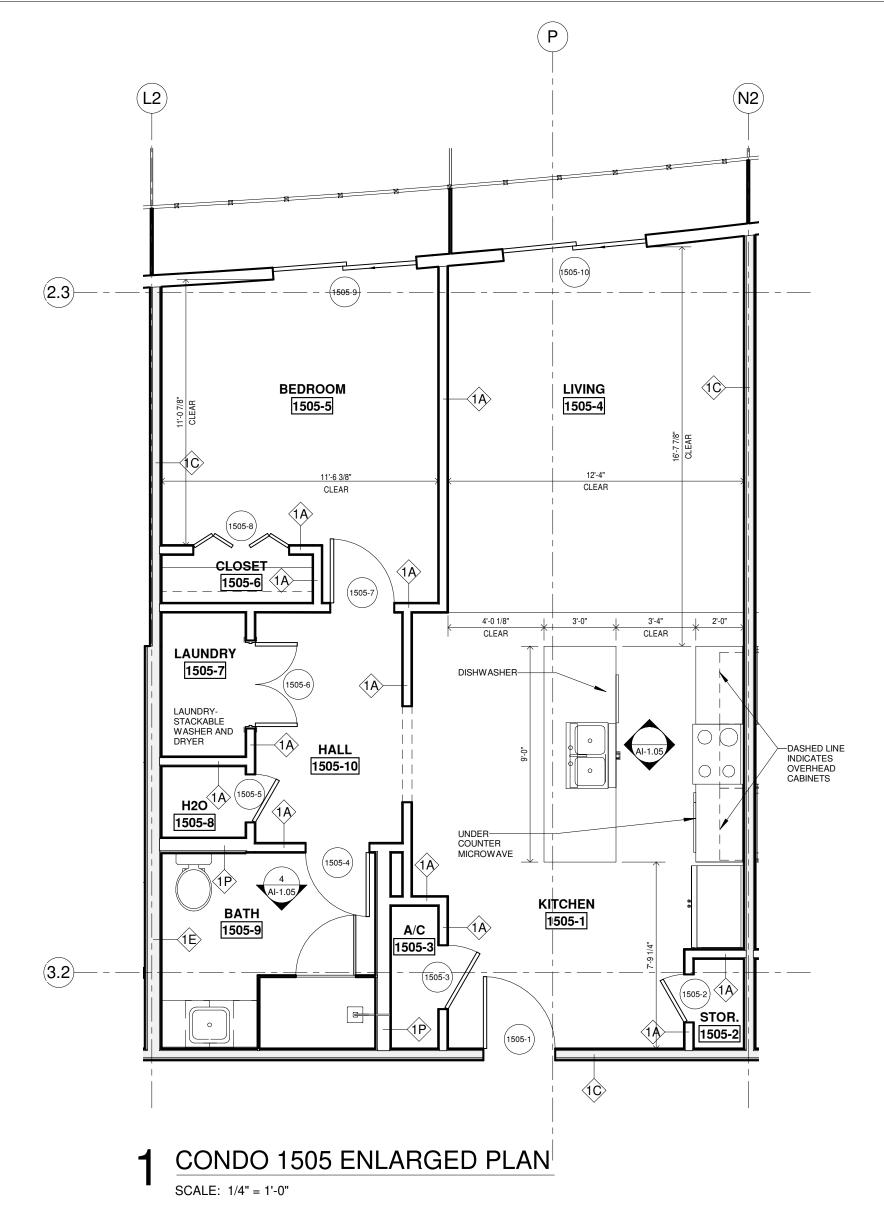


|         |         |         | С       | 000R S  | SCHEDULE      | E - UNIT      | 1505       |           |             |                    |
|---------|---------|---------|---------|---------|---------------|---------------|------------|-----------|-------------|--------------------|
| MARK    | FROM    | 0       | WIDTH   | НЕІСНТ  | THICKNESS     | DOOR MATERIAL | DOOR FRAME | DOOR TYPE | FIRE RATING | REMARKS            |
| 4505    | 0)/14   | I       | 01 011  | 71 011  | 01 4 0 / 4 !! |               | 1.18.4     | Б         |             |                    |
| 1505    | GYM     |         |         |         | 0' - 1 3/4"   |               | НМ         | D         |             |                    |
| 1505-1  |         | KITCHEN | 3' - 0" | 8' - 0" | 0' - 1 3/4"   | WD            | WD         | AA        |             | 1 HOUR RATED       |
| 1505-2  | STOR.   | KITCHEN | 2' - 0" | 8' - 0" | 0' - 1 3/4"   | WD            | WD         | AA        |             |                    |
| 1505-3  | KITCHEN | A/C     | 2' - 8" | 8' - 0" | 0' - 1 3/4"   | WD            | WD         | AA        |             |                    |
| 1505-4  | HALL    | BATH    | 2' - 8" | 8' - 0" | 0' - 1 3/4"   | WD            | WD         | AA        |             |                    |
| 1505-5  | HALL    | H2O     | 2' - 0" | 8' - 0" | 0' - 1 3/4"   | WD            | WD         | AA        |             |                    |
| 1505-6  | HALL    | LAUNDRY | 3' - 6" | 8' - 0" | 0' - 1 3/4"   | WD            | WD         | CC        |             | DOUBLE DOOR / PAIR |
| 1505-7  | HALL    | BEDROOM | 2' - 8" | 8' - 0" | 0' - 1 3/4"   | WD            | WD         | AA        |             |                    |
| 1505-8  | BEDROOM | CLOSET  | 4' - 0" | 8' - 0" | 0' - 1 1/2"   | WD            | WD         | L         |             |                    |
| 1505-9  | BEDROOM |         | 6' - 0" | 7' - 0" | 0' - 2"       | AL/GL         | AL         | Н         |             | EXTERIOR STOREFRON |
| 1505-10 | LIVING  |         | 6' - 0" | 7' - 0" | 0' - 2"       | AL/GL         | AL         | Н         |             | EXTERIOR STOREFRON |

|         | FINISH SCHEDULE - UNIT 1505 |              |             |         |         |         |         |                |             |  |  |  |  |
|---------|-----------------------------|--------------|-------------|---------|---------|---------|---------|----------------|-------------|--|--|--|--|
| NUMBER  | NAME                        | FLOOR FINISH | BASE FINISH | N. WALL | S. WALL | E. WALL | W. WALL | CEILING FINISH | CEILING HT. |  |  |  |  |
|         |                             |              |             |         |         |         |         |                |             |  |  |  |  |
| 1505-1  | KITCHEN                     |              |             |         |         |         |         |                |             |  |  |  |  |
| 1505-2  | STOR.                       |              |             |         |         |         |         |                |             |  |  |  |  |
| 1505-3  | A/C                         |              |             |         |         |         |         |                |             |  |  |  |  |
| 1505-4  | LIVING                      |              |             |         |         |         |         |                |             |  |  |  |  |
| 1505-5  | BEDROOM                     |              |             |         |         |         |         |                |             |  |  |  |  |
| 1505-6  | CLOSET                      |              |             |         |         |         |         |                |             |  |  |  |  |
| 1505-7  | LAUNDRY                     |              |             |         |         |         |         |                |             |  |  |  |  |
| 1505-8  | H2O                         |              |             |         |         |         |         |                |             |  |  |  |  |
| 1505-9  | BATH                        |              |             |         |         |         |         |                |             |  |  |  |  |
| 1505-10 | HALL                        |              |             |         |         |         |         |                |             |  |  |  |  |

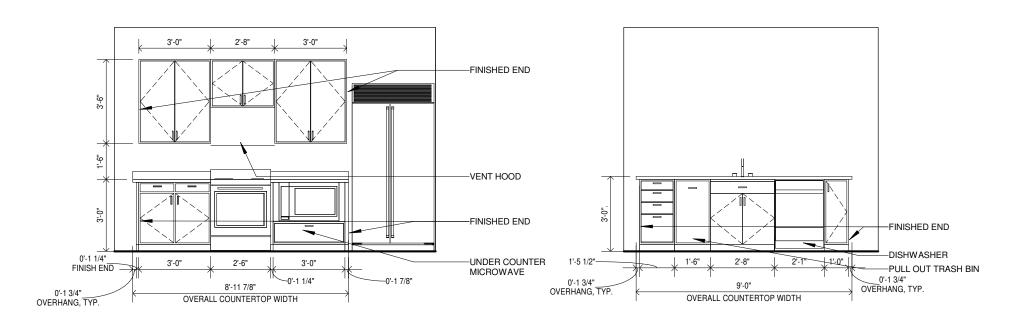

3 KITCHEN UNIT 1505 VIEW A SCALE: 1/4" = 1'-0"

2 KITCHEN UNIT 1505 VIEW B
SCALE: 1/4" = 1'-0"

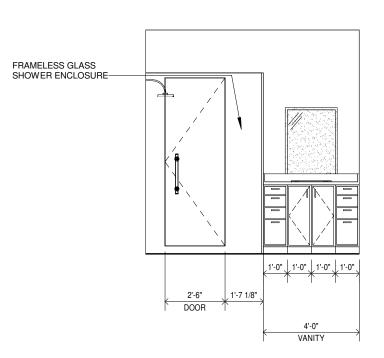

4 BATH UNIT 1505
SCALE: 1/4" = 1'-0"


HARRY
BAKER
SMITH
SMITH
ARCHITECTS II
P L C

189 Maple Ridge Drive Metairie, LA 70001
(504)-885-4477
central@hbsail.com :: hbsail.com
SINCE 1961

1031 CANAL STREET
NEW ORLEANS, LOUISIANA

THESE PLANS AND SPECIFICATIONS HAVE BEEN PREPARED BY ME OR UNDER MY CLOSE PERSONAL SUPERVISION AND TO THE BEST OF MY KNOWLEDGE AND BELIEF THEY COMPLY WITH ALL CITY, STATE AND FEDERAL REQUIREMENTS, AND I AM NOT PROVIDING CONTRACT ADMINISTRATION.

CERTIFIED CORRECT

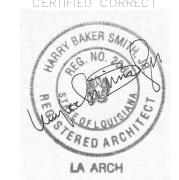


THIS DRAWING IS CONFIDENTIAL AND
NOT BE LOANED, REPRODUCED, COPIED,
EITHER WHOLLY OR IN PART, OR MADE
PUBLIC IN ANY MANNER WITHOUT THE
WRITTEN CONSENT OF HBSA II ARCHITECTS,
A PROFESSIONAL L.L.C. ALL RIGHTS OF
DESIGN OR INVENTION ARE RESERVED AND

| II AR                        | CHITE                        | CTS                          | A PR                         | OFES:                        | SIONA                        | L L.L.                       | .C . |  |  |  |  |
|------------------------------|------------------------------|------------------------------|------------------------------|------------------------------|------------------------------|------------------------------|------|--|--|--|--|
|                              | REVISION HISTORY             |                              |                              |                              |                              |                              |      |  |  |  |  |
| 4/27/2018                    | 5/4/2018                     | 5/11/2018                    | 5/18/2018                    | 5/25/2018                    | 6/1/2018                     | 6/8/2018                     |      |  |  |  |  |
| L.I.S. #2 - CLOUD REVISION 1 | L.I.S. #2 - CLOUD REVISION 2 | L.I.S. #2 - CLOUD REVISION 3 | L.I.S. #2 - CLOUD REVISION 4 | L.I.S. #2 - CLOUD REVISION 5 | L.I.S. #2 - CLOUD REVISION 6 | L.I.S. #2 - CLOUD REVISION 7 |      |  |  |  |  |
| -                            | 2                            | က                            | 4                            | 5                            | 9                            | 7                            | 8    |  |  |  |  |


CONDO 1505

PROJECT#: 1709
PHASE: DD
TEAM: Author
CHECKER: Checker
SCALE: AS NOTED

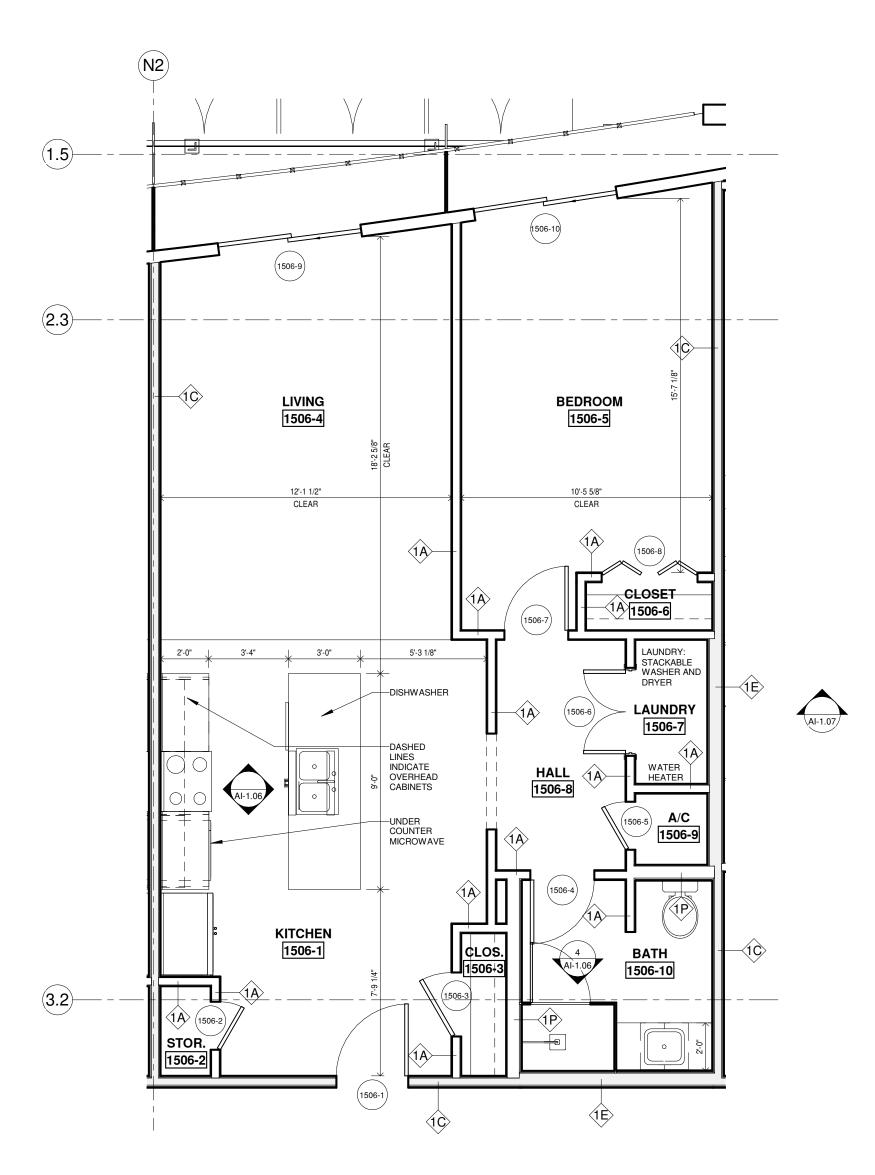


1 CONDO 1506 ENLARGED PLAN
SCALE: 1/4" = 1'-0"

|         |         |         | DOO     | R SCH   | EDULE - L   | JNIT 150      | 06         |           |             |                        |
|---------|---------|---------|---------|---------|-------------|---------------|------------|-----------|-------------|------------------------|
| MARK    | FROM    | 01      | WIDTH   | HEIGHT  | THICKNESS   | DOOR MATERIAL | DOOR FRAME | DOOR TYPE | FIRE RATING | REMARKS                |
|         | I       |         |         | 1       |             |               | 1          | 1_        |             |                        |
| 1506    |         | STAIR 1 |         |         | 0' - 1 3/4" |               | НМ         | E         | 2HR         |                        |
| 1506-1  |         | KITCHEN | 3' - 0" | 8' - 0" | 0' - 1 3/4" | WD            | WD         | AA        | 1HR         | 1 HOUR RATED           |
| 1506-2  | KITCHEN | STOR.   | 2' - 0" | 8' - 0" | 0' - 1 3/4" | WD            | WD         | AA        |             |                        |
| 1506-3  | CLOS.   | KITCHEN | 2' - 8" | 7' - 0" | 0' - 2"     | WD            | WD         | AA        | 1HR         |                        |
| 1506-4  | BATH    | HALL    | 2' - 8" | 8' - 0" | 0' - 1 3/4" | WD            | WD         | AA        |             |                        |
| 1506-5  | HALL    | A/C     | 2' - 0" | 8' - 0" | 0' - 1 3/4" | WD            | WD         | AA        |             |                        |
| 1506-6  | HALL    | LAUNDRY | 3' - 6" | 8' - 0" | 0' - 1 3/4" | WD            | WD         | CC        |             | DOUBLE DOOR /<br>PAIR  |
| 1506-7  | HALL    | BEDROOM | 2' - 8" | 8' - 0" | 0' - 1 3/4" | WD            | WD         | AA        |             |                        |
| 1506-8  | BEDROOM | CLOSET  | 4' - 0" | 8' - 0" | 0' - 1 1/2" | WD            | WD         | AA        |             |                        |
| 1506-9  | LIVING  |         | 6' - 0" | 7' - 0" | 0' - 2"     | AL/GL         | AL         | Н         |             | EXTERIOR<br>STOREFRONT |
| 1506-10 | BEDROOM |         | 6' - 0" | 7' - 0" | 0' - 2"     | AL/GL         | AL         | Н         |             | EXTERIOR<br>STOREFRONT |

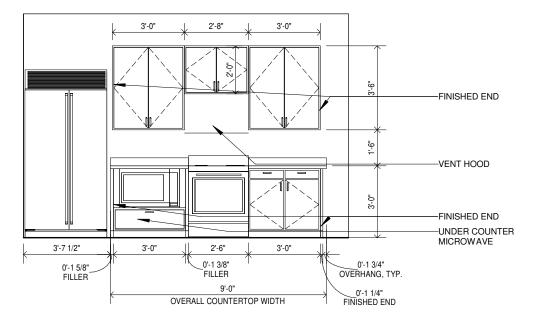


2 KITCHEN UNIT 1506 VIEW A


SCALE: 1/4" = 1'-0"

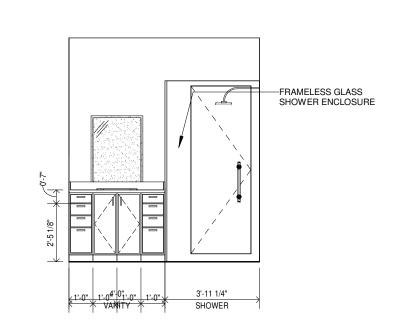

4 BATH UNIT 1506 VIEW A
SCALE: 1/4" = 1'-0"

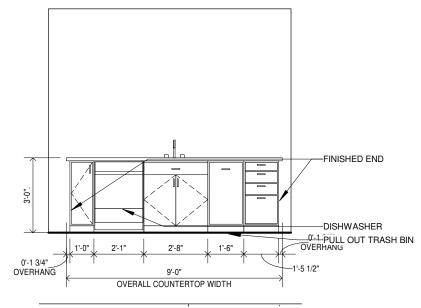

3 KITCHEN UNIT 1506 VIEW B
SCALE: 1/4" = 1'-0"

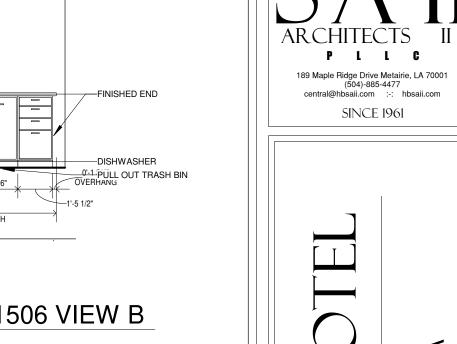

THESE PLANS AND SPECIFICATIONS HAVE
BEEN PREPARED BY ME OR UNDER MY
CLOSE PERSONAL SUPERVISION AND TO
THE BEST OF MY KNOWLEDGE AND
BELIEF THEY COMPLY WITH ALL CITY,
STATE AND FEDERAL REQUIREMENTS, AND
I AM NOT PROVIDING CONTRACT
ADMINISTRATION.
CERTIFIED CORRECT

1031 CANAL STREET NEW ORLEANS, LOUISIANA





THIS DRAWING IS CONFIDENTIAL AND NOT BE LOANED, REPRODUCED, COPIED, EITHER WHOLLY OR IN PART, OR MADE PUBLIC IN ANY MANNER WITHOUT THE WRITTEN CONSENT OF HBSA II ARCHITECTS, A PROFESSIONAL L.L.C. ALL RIGHTS OF DESIGN OR INVENTION ARE RESERVED AND WILL REMAIN THE SOLE PROPERTY OF HBSA


|                              | _                            |                              |                              |                              |                              |                              |  |
|------------------------------|------------------------------|------------------------------|------------------------------|------------------------------|------------------------------|------------------------------|--|
|                              | R                            | EVIS                         | SION                         | HIS                          | TOR                          | Υ                            |  |
| 4/27/2018                    | 5/4/2018                     | 5/11/2018                    | 5/18/2018                    | 5/25/2018                    | 6/1/2018                     | 6/8/2018                     |  |
|                              | 2                            | 3                            | 4                            | ۵                            | S.                           | _                            |  |
| L.I.S. #2 - CLOUD REVISION 1 | L.I.S. #2 - CLOUD REVISION 2 | L.I.S. #2 - CLOUD REVISION 3 | L.I.S. #2 - CLOUD REVISION 4 | L.I.S. #2 - CLOUD REVISION 5 | L.I.S. #2 - CLOUD REVISION 6 | L.I.S. #2 - CLOUD REVISION 7 |  |
|                              |                              |                              |                              |                              |                              |                              |  |

CONDO 1506


PROJECT#: 1709
PHASE: DD
TEAM: Author
CHECKER: Checker
SCALE: AS NOTED

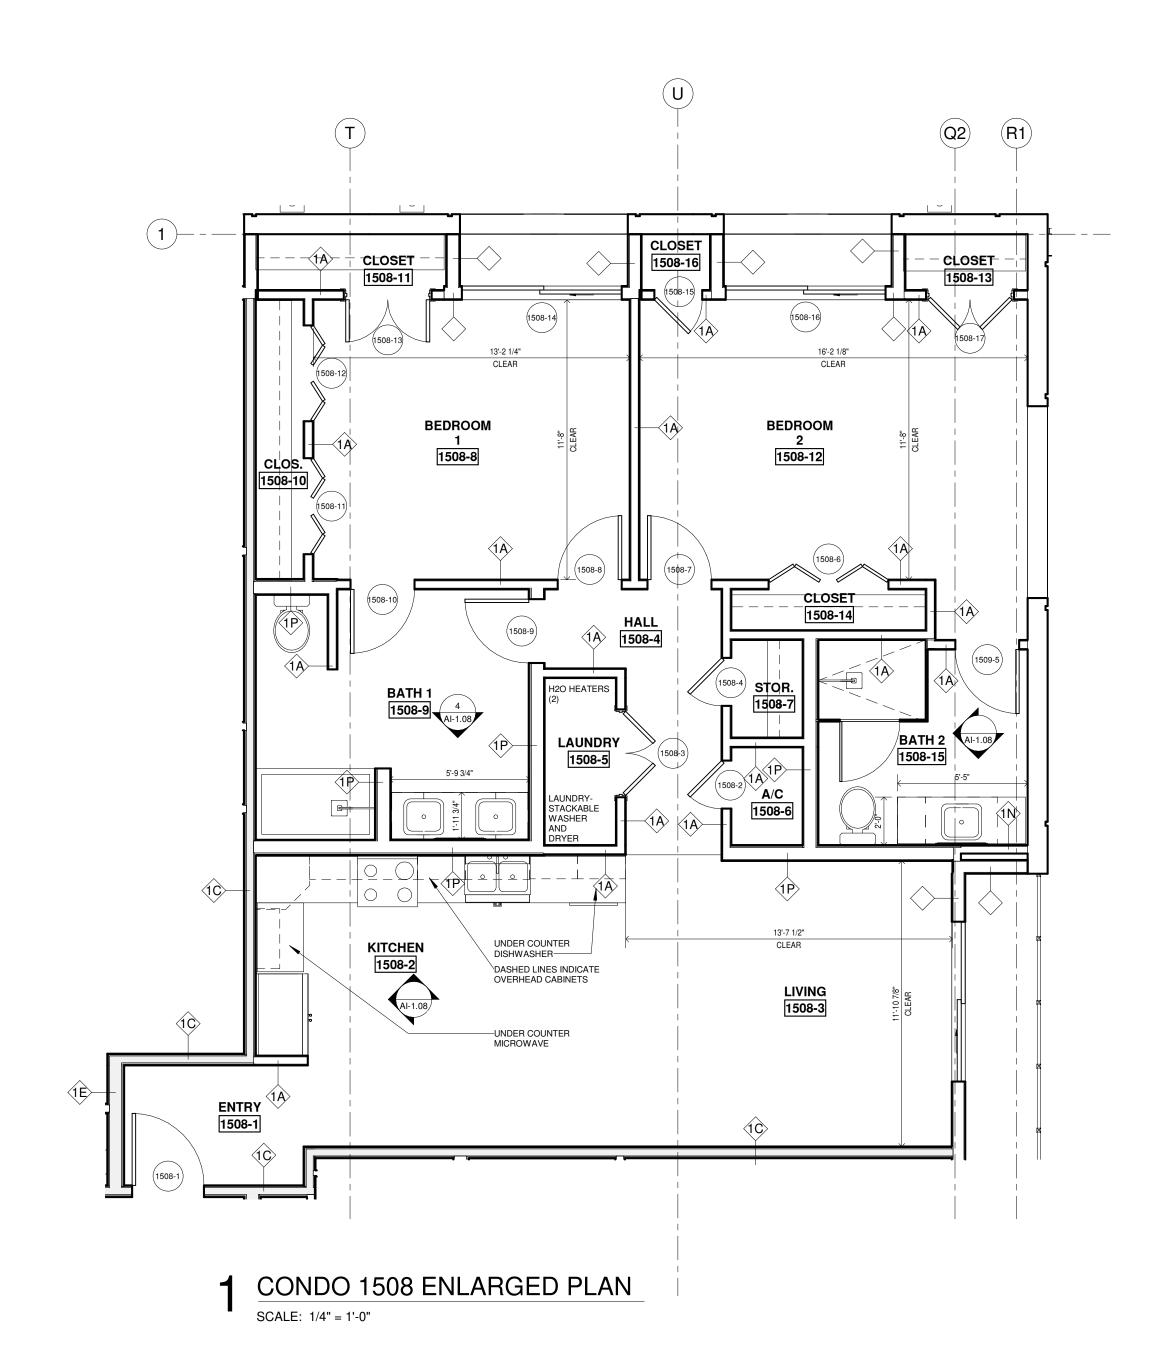

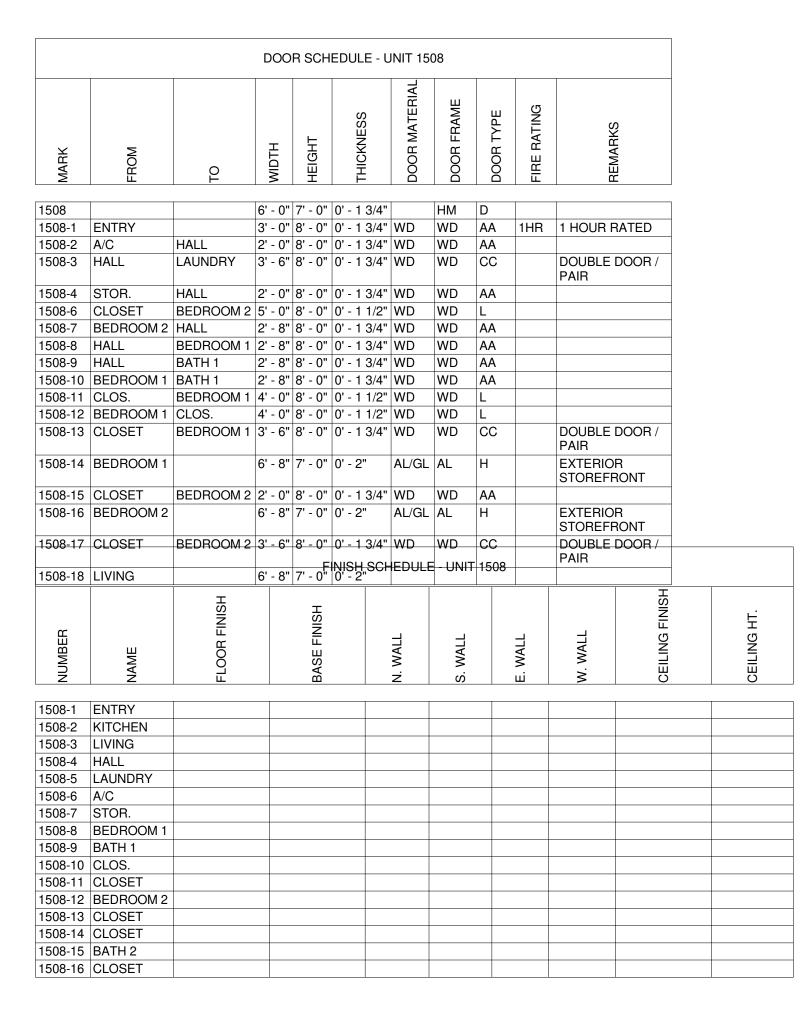


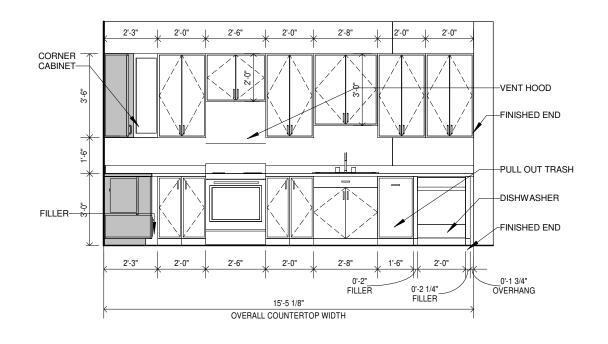


#### 2 KITCHEN UNIT 1508 VIEW A SCALE: 1/4" = 1'-0"

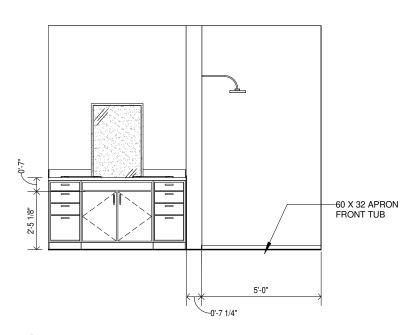


4 BATH 1 UNIT 1508 SCALE: 1/4" = 1'-0"

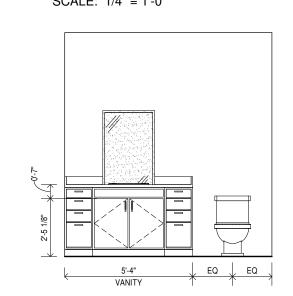


6 BATH 2 UNIT 1508 VIEW B
SCALE: 1/4" = 1'-0"

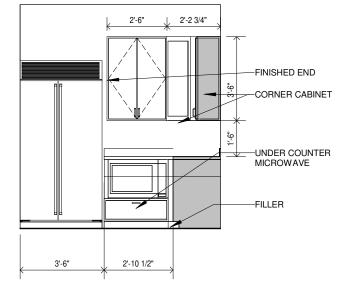



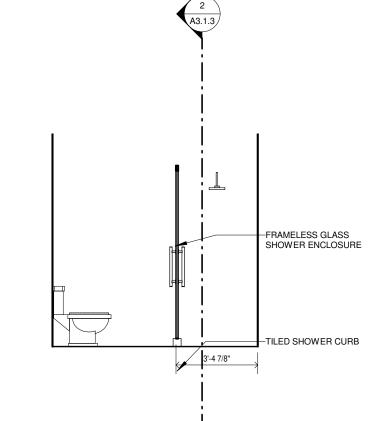

5 BATH 2 UNIT 1508 VIEW A

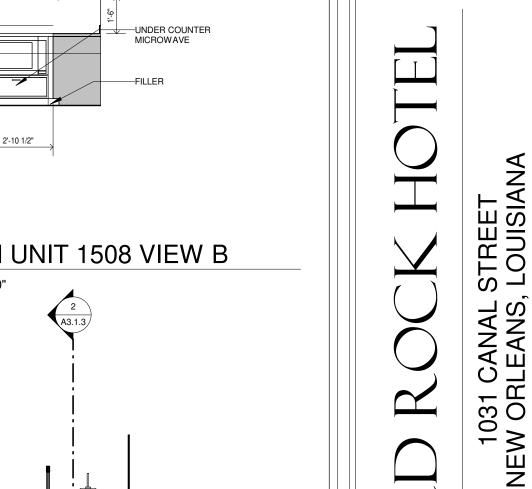

I AM NOT PROVIDING CONTRAC ADMINISTRATION. CERTIFIED CORRECT

189 Maple Ridge Drive Metairie, LA 70001 (504)-885-4477 central@hbsaii.com :-: hbsaii.com


SINCE 1961




|                              | R                            | EVIS                         | ION                          | HIS                          | TOR                          | Υ                            |  |
|------------------------------|------------------------------|------------------------------|------------------------------|------------------------------|------------------------------|------------------------------|--|
| 4/27/2018                    | 5/4/2018                     | 5/11/2018                    | 5/18/2018                    | 5/25/2018                    | 6/1/2018                     | 6/8/2018                     |  |
| L.I.S. #2 - CLOUD REVISION 1 | L.I.S. #2 - CLOUD REVISION 2 | L.I.S. #2 - CLOUD REVISION 3 | L.I.S. #2 - CLOUD REVISION 4 | L.I.S. #2 - CLOUD REVISION 5 | L.I.S. #2 - CLOUD REVISION 6 | L.I.S. #2 - CLOUD REVISION 7 |  |
|                              | 8                            | 8                            | 4                            | 2                            | 9                            |                              |  |


CONDO 1508

PROJECT#: 1709 PHASE: DD TEAM: Author CHECKER: Checker SCALE: AS NOTED ISSUED: 4/20/2018

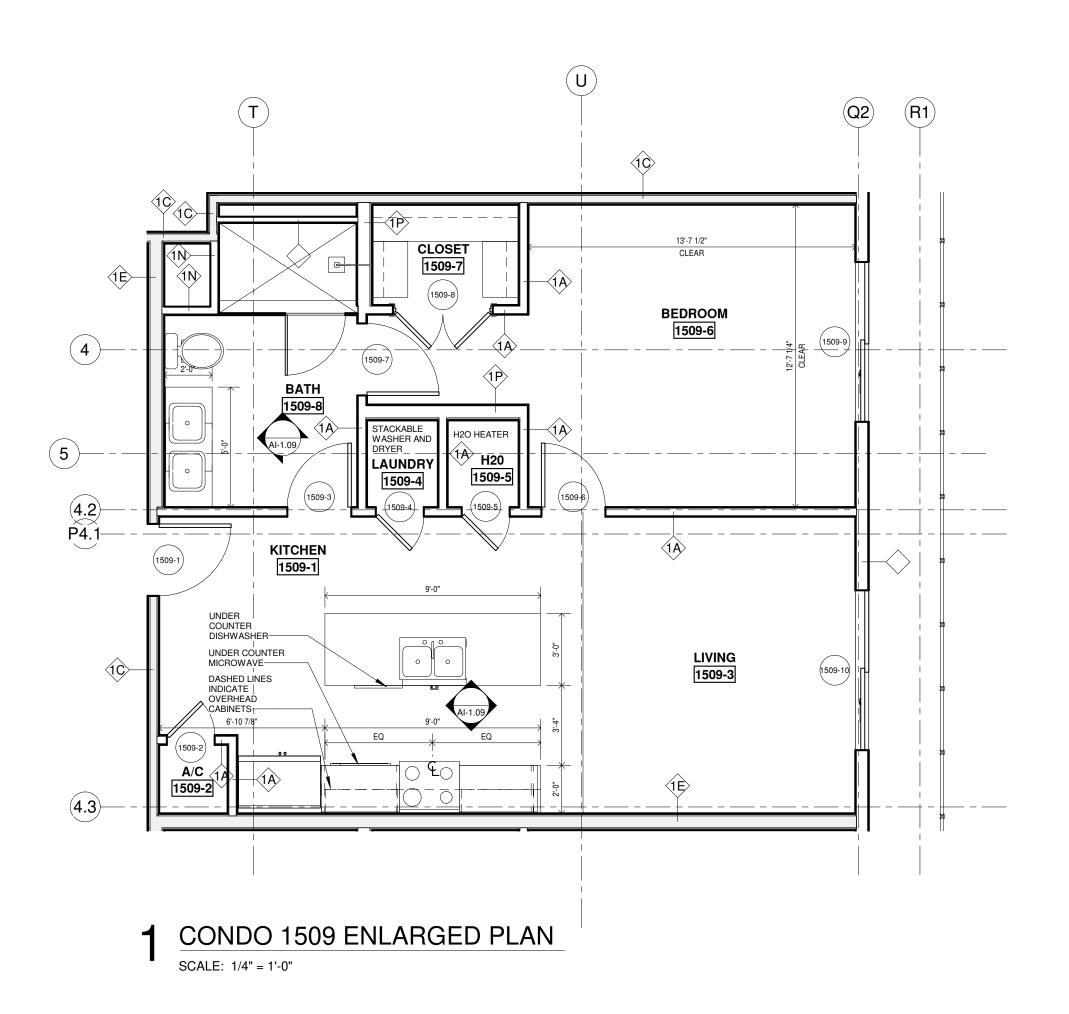


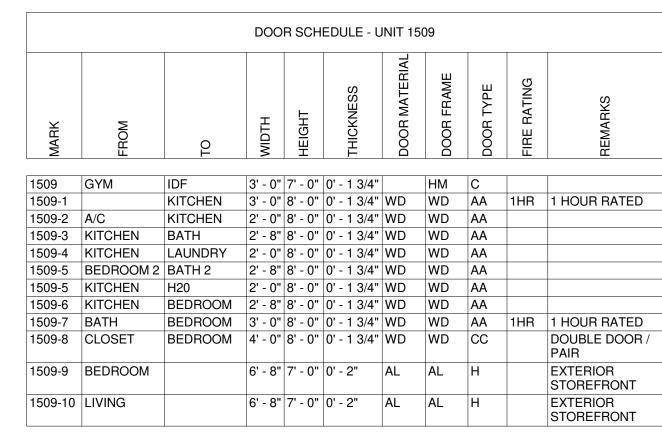

|        |         |              | FINISH      | SCHEDUL | E - UNIT 15 | 509     |         |                |          |
|--------|---------|--------------|-------------|---------|-------------|---------|---------|----------------|----------|
| NUMBER | NAME    | FLOOR FINISH | BASE FINISH | N. WALL | S. WALL     | E. WALL | W. WALL | CEILING FINISH | <u> </u> |
|        |         |              |             |         |             |         |         |                |          |
| 1509-1 | KITCHEN |              |             |         |             |         |         |                |          |
| 1509-2 | A/C     |              |             |         |             |         |         |                |          |
| 1509-3 | LIVING  |              |             |         |             |         |         |                |          |
| 1509-4 | LAUNDRY |              |             |         |             |         |         |                |          |
| 1509-5 | H20     |              |             |         |             |         |         |                |          |
| 1509-6 | BEDROOM |              |             |         |             |         |         |                |          |
| 1509-7 | CLOSET  |              |             |         |             |         |         |                |          |
| 1509-8 | BATH    |              |             |         |             |         |         |                |          |

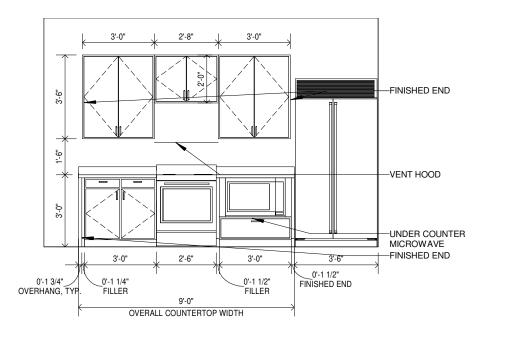




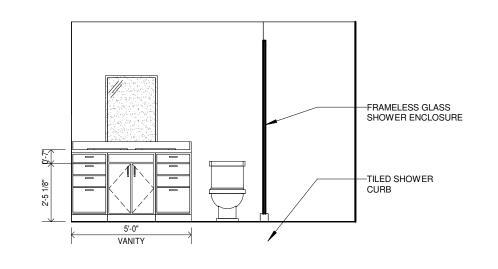


2 BATH UNIT 1509 VIEW A


SCALE: 1/4" = 1'-0"

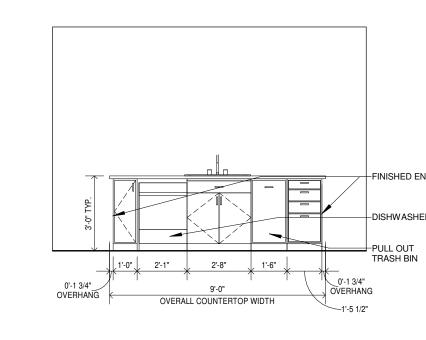

5 KITCHEN UNIT 1509 VIEW B
SCALE: 1/4" = 1'-0"

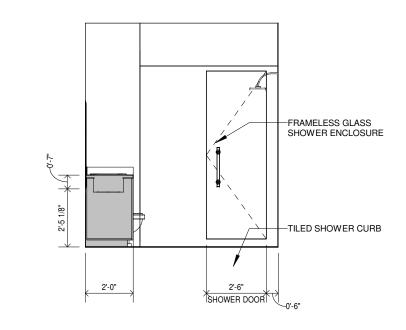

3 BATH UNIT 1509 VIEW B
SCALE: 1/4" = 1'-0"

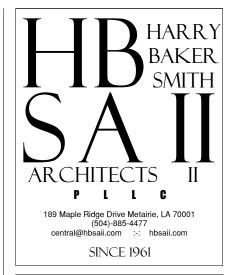

RD ROCK HOTT 1031 CANAL STREET NEW ORLEANS, LOUISIANA

THESE PLANS AND SPECIFICATIONS HAVE
BEEN PREPARED BY ME OR UNDER MY
CLOSE PERSONAL SUPERVISION AND TO
THE BEST OF MY KNOWLEDGE AND
BELIEF THEY COMPLY WITH ALL CITY,
STATE AND FEDERAL REQUIREMENTS, AND
I AM NOT PROVIDING CONTRACT
ADMINISTRATION.
CERTIFIED CORRECT





THIS DRAWING IS CONFIDENTIAL AND
NOT BE LOANED, REPRODUCED, COPIED,
EITHER WHOLLY OR IN PART, OR MADE
PUBLIC IN ANY MANNER WITHOUT THE
WRITTEN CONSENT OF HBSA II ARCHITECTS,
A PROFESSIONAL L.L.C. ALL RIGHTS OF
DESIGN OR INVENTION ARE RESERVED AND


| L.I.S. #2 - CLOUD REVISION 1  L.I.S. #2 - CLOUD REVISION 2  L.I.S. #2 - CLOUD REVISION 3  L.I.S. #2 - CLOUD REVISION 4  L.I.S. #2 - CLOUD REVISION 5  L.I.S. #2 - CLOUD REVISION 6  L.I.S. #2 - CLOUD REVISION 6  L.I.S. #2 - CLOUD REVISION 6  L.I.S. #2 - CLOUD REVISION 7  RANGE SALES AND A STATUTO 18  A STAT/2018 A STAT | II AR                        | CHIIE                        | .015                         | A PR                         | UFES:                        | SIUNA                        | L L.L.                       | . U . |
|--|------------------------------|------------------------------|------------------------------|------------------------------|------------------------------|------------------------------|------------------------------|-------|
|  |                              | R                            | EVIS                         | ION                          | HIS                          | TOR                          | Υ                            |       |
| L.I.S. #2 - CLOUD REVISION 1 L.I.S. #2 - CLOUD REVISION 2 L.I.S. #2 - CLOUD REVISION 3 L.I.S. #2 - CLOUD REVISION 4 L.I.S. #2 - CLOUD REVISION 5 L.I.S. #2 - CLOUD REVISION 6 L.I.S. #2 - CLOUD REVISION 7   | 4/27/2018                    | 5/4/2018                     | 5/11/2018                    | 5/18/2018                    | 5/25/2018                    | 6/1/2018                     | 6/8/2018                     |       |
|  | L.I.S. #2 - CLOUD REVISION 1 | L.I.S. #2 - CLOUD REVISION 2 | L.I.S. #2 - CLOUD REVISION 3 | L.I.S. #2 - CLOUD REVISION 4 | L.I.S. #2 - CLOUD REVISION 5 | L.I.S. #2 - CLOUD REVISION 6 | L.I.S. #2 - CLOUD REVISION 7 |       |

CONDO 1509


PROJECT#: 1709
PHASE: DD
TEAM: Author
CHECKER: Checker
SCALE: AS NOTED

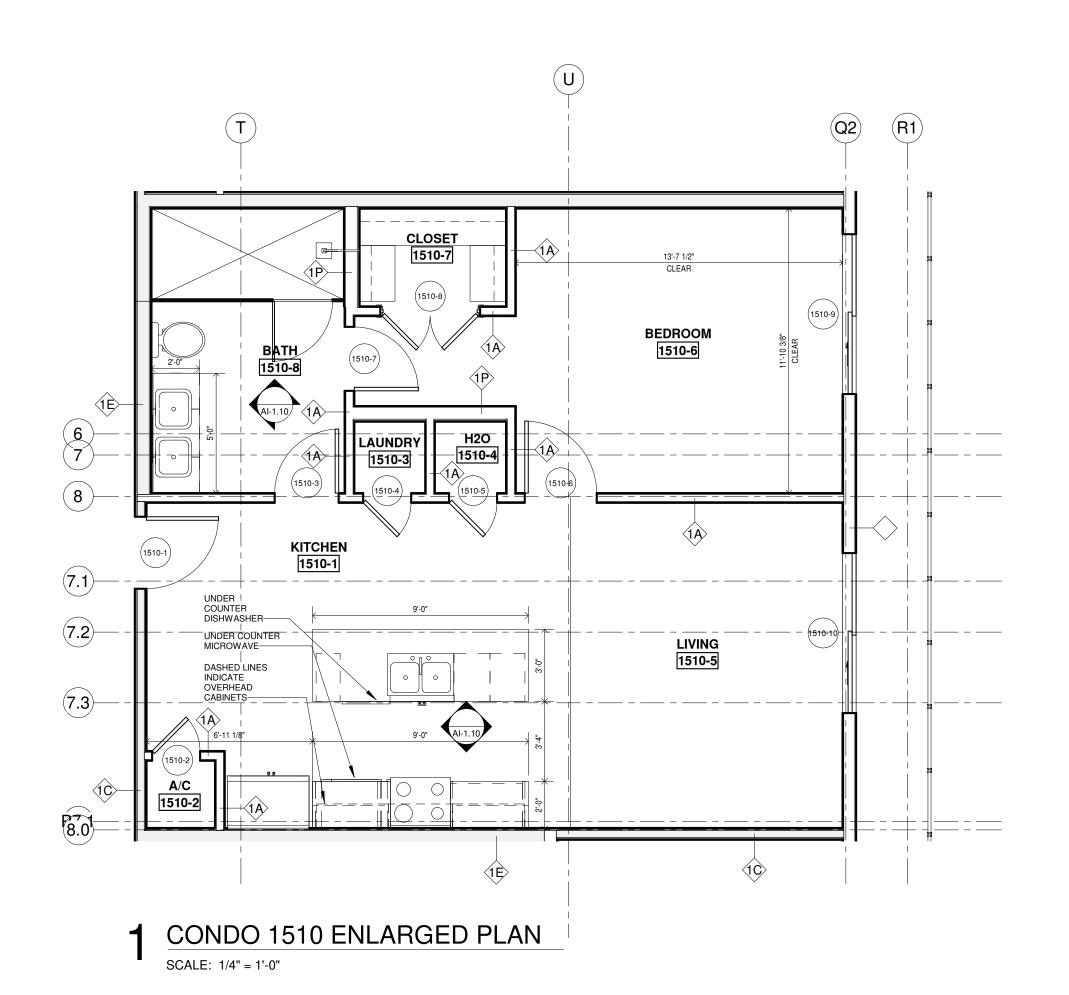


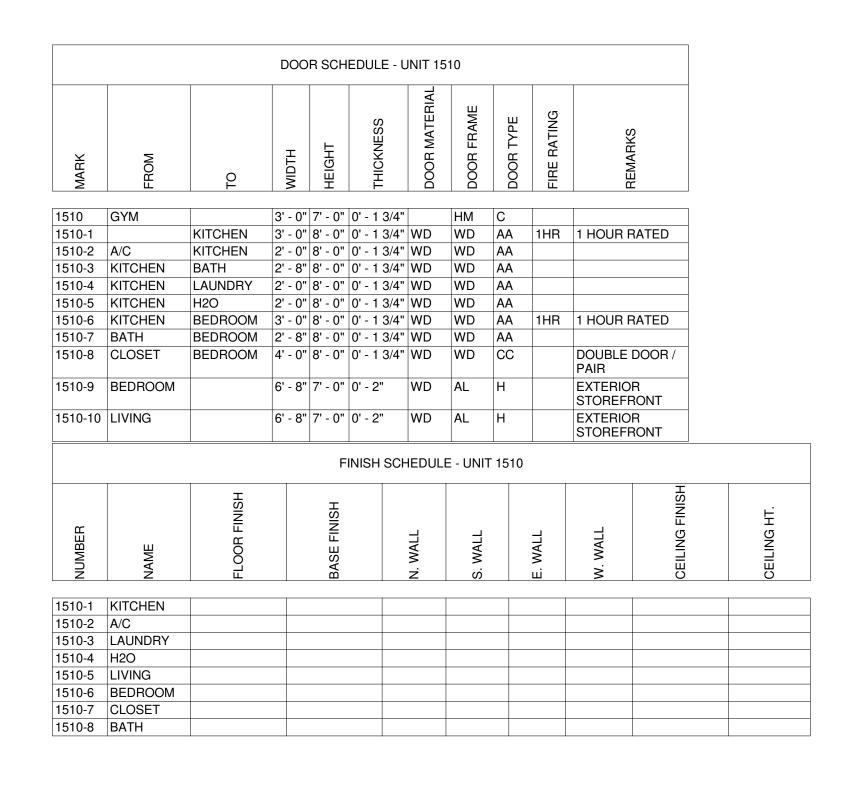


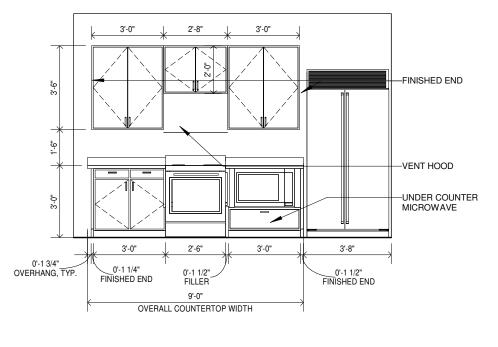


# 2 KITCHEN UNIT 1510 VIEW A SCALE: 1/4" = 1'-0"

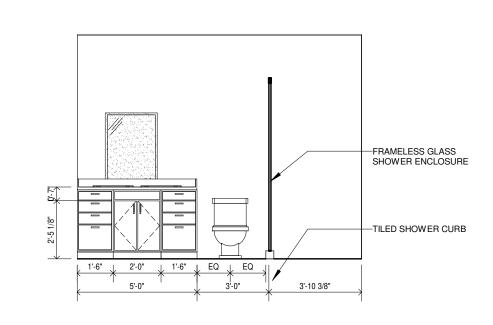

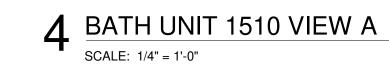


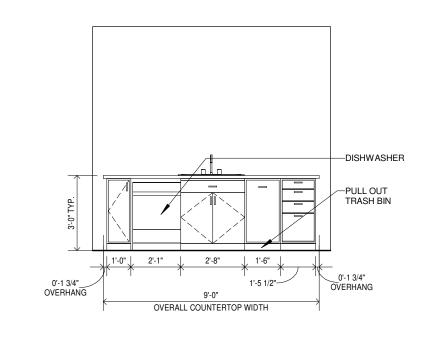

3 KITCHEN UNIT 1510 VIEW B
SCALE: 1/4" = 1'-0"

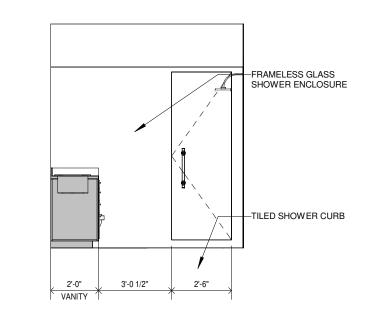

5 BATH UNIT 1510 VIEW B
SCALE: 1/4" = 1'-0"

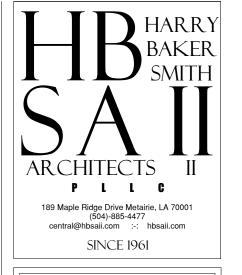

DROCKHOTE

1031 CANAL STREET

NEW ORLEANS, LOUISIANA

THESE PLANS AND SPECIFICATIONS HAVE BEEN PREPARED BY ME OR UNDER MY CLOSE PERSONAL SUPERVISION AND TO THE BEST OF MY KNOWLEDGE AND BELIEF THEY COMPLY WITH ALL CITY, STATE AND FEDERAL REQUIREMENTS, AND I AM NOT PROVIDING CONTRACT ADMINISTRATION.

CERTIFIED CORRECT




THIS DRAWING IS CONFIDENTIAL AND
NOT BE LOANED, REPRODUCED, COPIED,
EITHER WHOLLY OR IN PART, OR MADE
PUBLIC IN ANY MANNER WITHOUT THE
WRITTEN CONSENT OF HBSA II ARCHITECTS,
A PROFESSIONAL L.L.C. ALL RIGHTS OF
DESIGN OR INVENTION ARE RESERVED AND

|                              | R                            | EVIS                         |                              |                              | TOR                          | Υ                            |  |
|------------------------------|------------------------------|------------------------------|------------------------------|------------------------------|------------------------------|------------------------------|--|
| 4/27/2018                    | 5/4/2018                     | 5/11/2018                    | 5/18/2018                    | 5/25/2018                    | 6/1/2018                     | 6/8/2018                     |  |
| L.I.S. #2 - CLOUD REVISION 1 | L.I.S. #2 - CLOUD REVISION 2 | L.I.S. #2 - CLOUD REVISION 3 | L.I.S. #2 - CLOUD REVISION 4 | L.I.S. #2 - CLOUD REVISION 5 | L.I.S. #2 - CLOUD REVISION 6 | L.I.S. #2 - CLOUD REVISION 7 |  |


CONDO 1510

PROJECT#: 1709
PHASE: DD
TEAM: Author
CHECKER: Checker
SCALE: AS NOTED

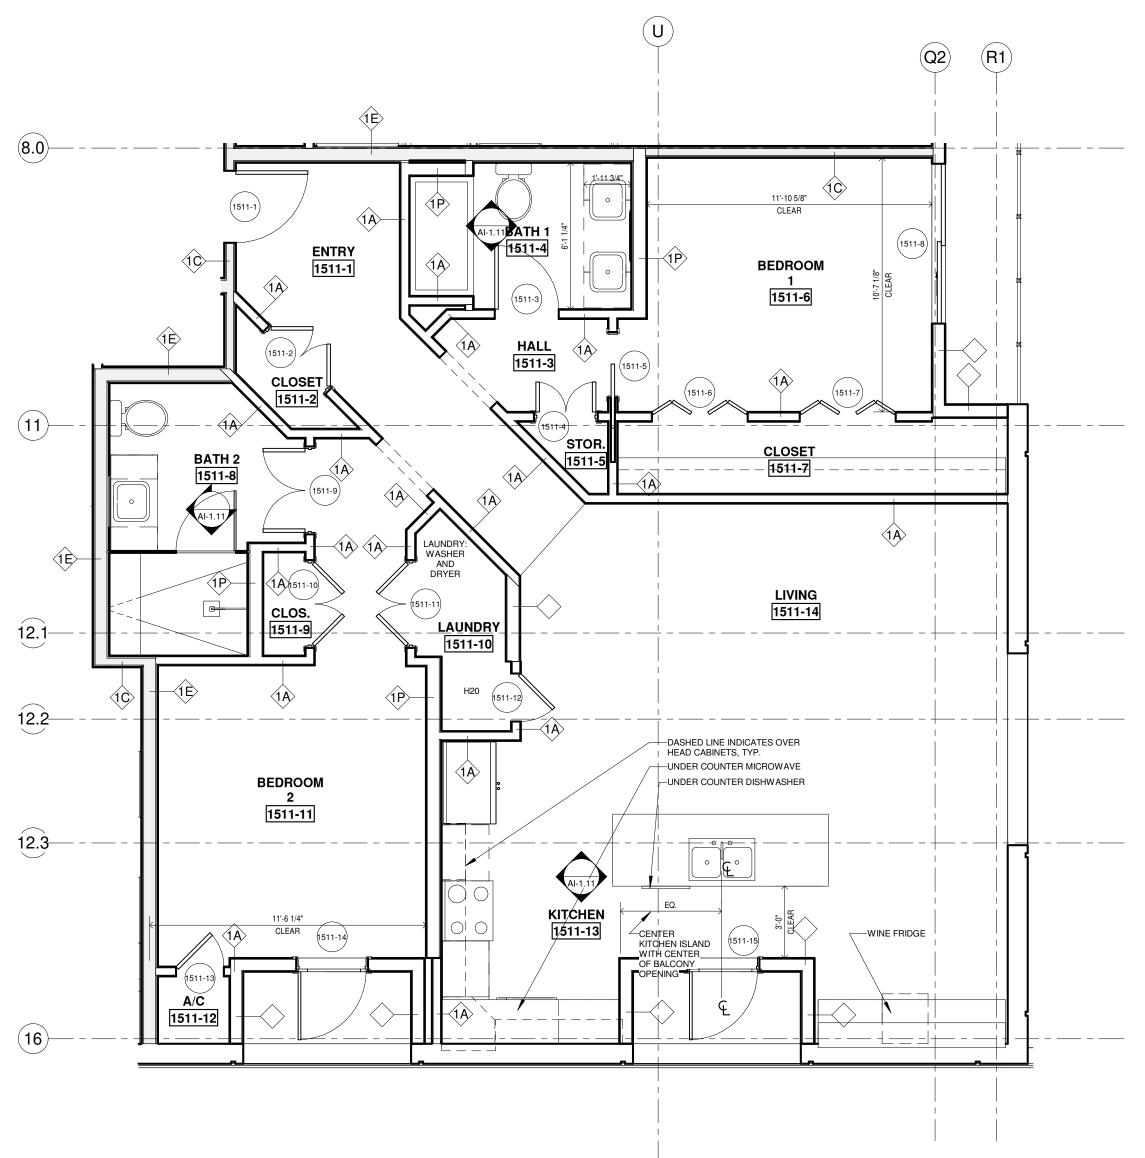


|                  |                  |              | DOOF        | R SCHE      | EDULE     | ≣ - U | NIT 15        | 11         |           |             |      |   |            |             |
|------------------|------------------|--------------|-------------|-------------|-----------|-------|---------------|------------|-----------|-------------|------|---|------------|-------------|
| MARK             | FROM             | 01           | WIDTH       | НЕІСНТ      | THICKNESS |       | DOOR MATERIAL | DOOR FRAME | DOOR TYPE | FIRE RATING |      | REMARKS                                       |            |             |
| 1511             |                  |              | 6' 0"       | 7' - 0"     | 0' 1      | 2/4"  | WD            | НМ         | D         |             |      |   |            |             |
| 1511-1           |                  | ENTRY        |             | 8' - 0"     |           |       |               | WD         | AA        | 1HR         | 1 11 | OUR RATED                                     | 1          |             |
| 1511-2           | CLOSET           | ENTRY        |             | 8' - 0"     |           |       |               | WD         | CC        | 11111       |      | JBLE DOOF                                     |            |             |
| 1511-3           | HALL             | BATH 1       |             | 8' - 0"     |           |       |               | WD         | AA        |             | 000  | DEL DOOI                                      | I/ I AII I |             |
| 1511-4           | STOR.            | HALL         |             | 8' - 0"     |           |       |               | WD         | CC        |             | DOL  | JBLE DOOF                                     | PAIR       |             |
| 1511-5           | HALL             | BEDROOM 1    |             |             |           |       |               | WD         | M         |             | 000  | DEL DOOL                                      | 17171111   |             |
| 1511-6           | BEDROOM 1        |              |             | 8' - 0"     |           |       |               | WD         | L         |             |      |   |            |             |
| 1511-7           | BEDROOM 1        | CLOSET       |             | 8' - 0"     |           |       |               | WD         | L         |             |      |   |            |             |
| 1511-8           | BEDROOM 1        | OLOGET       | -           | 7' - 0"     | -         |       | AL/G          |            | Н         |             |      | ERIOR<br>DREFRONT                             |            |             |
| 1511-9           | BEDROOM 2        | RATH 2       | 3' - 6"     | 8' - 0"     | 0' - 1    | 3/4"  | WD            | WD         | СС        |             |      | JBLE DOOF                                     | PAIR       |             |
| 1511-10          |                  | BEDROOM 2    |             |             |           |       |               | WD         | CC        |             |      | JBLE DOOF                                     |            |             |
|                  | BEDROOM 2        | LAUNDRY      |             | 8' - 0"     |           |       |               | WD         | CC        |             |      | JBLE DOOF                                     |            |             |
| 1511-12          |                  | LAUNDRY      |             | 8' - 0"     |           |       |               | WD         | AA        |             |      | , <u>, , , , , , , , , , , , , , , , , , </u> | ., . ,     |             |
| 1511-13          |                  | BEDROOM 2    |             |             |           |       |               | WD         | AA        |             |      |   |            |             |
| 1511-14          | 7.00             | BEDROOM 2    |             | 7' - 0"     |           |       |               |            | Н         |             | FXT  | ERIOR   |            |             |
| 1011 14          |                  | DEDITIONI E  | 10"         |             |           | 0/0   | L             | /\_        | ''        |             |      | REFRONT                                       |            |             |
| 1511-15          | KITCHEN          |              | 2' -<br>10" | 7' - 0"     | 0' - 1    | 3/8"  | WD            | AL         | Н         |             |      | ERIOR<br>REFRONT                              |            |             |
|                  |                  |              | I           | F           | INISH     | SCH   | HEDUL         | .E - U     | NIT 1     | 511         | ı    |   |            |             |
| NUMBER           | NAME             | FLOOR FINISH |             | BASE FINISH |           |       | N. WALL       |            | S. WALL   | I WALL      |      | W. WALL                                       | O IVI      | CEILING HT. |
|                  | ı                | ı            |             |             |           |       |               |            |           |             |      |   |            |             |
| 1511-1           | ENTRY            |              |             |             |           |       |               |            |           | -           |      |   |            |             |
| 1511-2           | CLOSET           |              |             |             |           |       |               |            |           | 1           |      |   |            |             |
| 1511-3           | HALL             |              |             |             |           | -     |               |            |           | +           |      |   |            |             |
| 1511-4           | BATH 1           |              |             |             |           |       |               |            |           | 1           |      |   |            |             |
| 1511-5           | STOR.            |              |             |             |           |       |               |            |           | 1           |      |   |            |             |
| 1511-6           | BEDROOM 1        |              |             |             |           |       |               |            |           | 1           |      |   |            |             |
| 1511-7<br>1511-8 | CLOSET<br>BATH 2 |              |             |             |           | -     |               |            |           | +           |      |   |            |             |
| 1511-8           | CLOS.            |              |             |             |           |       |               |            |           |             |      |   |            |             |
|                  | LAUNDRY          |              |             |             |           |       |               |            |           | 1           |      |   |            |             |
|                  |                  |              |             |             |           |       |               |            |           | -           |      |   |            |             |
| 1511-11          | BEDROOM 2        |              |             |             |           |       |               |            |           | +           |      |   |            |             |
|                  | KITCHEN          |              |             |             |           | -     |               |            |           | +           |      |   |            |             |
| 1511-13          |                  |              |             |             |           |       |               |            |           | 1           |      |   |            |             |
| 1311-14          | LIVING           |              |             |             |           |       |               |            |           |             |      |   |            |             |

CONDO 1511 ENLARGED PLAN SCALE: 1/4" = 1'-0"

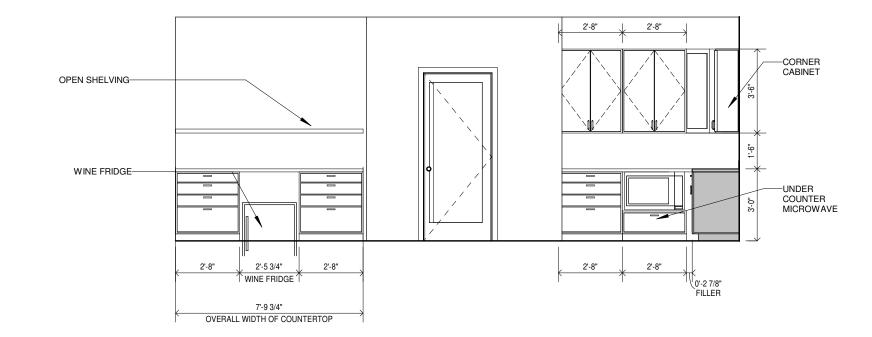


## 2 KITCHEN UNIT 1511 VIEW A SCALE: 1/4" = 1'-0"

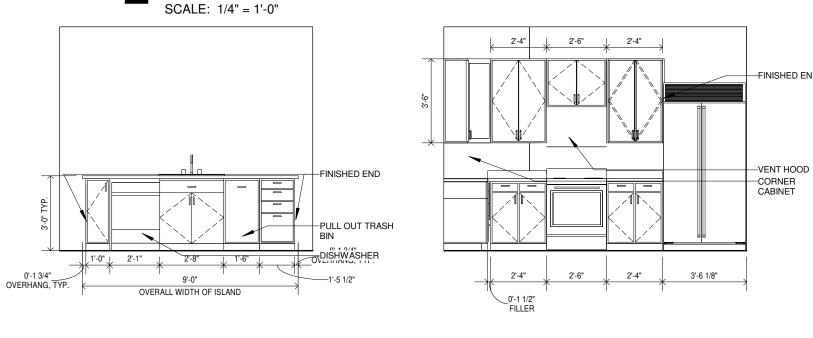


3 KITCHEN UNIT 1511 VIEW B
SCALE: 1/4" = 1'-0"




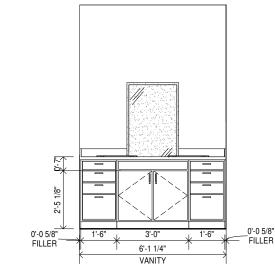




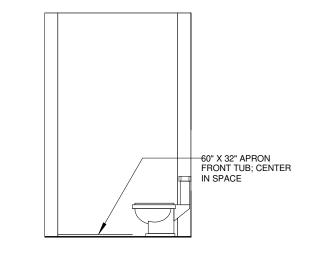

6 BATH 1 UNIT 1511 VIEW B
SCALE: 1/4" = 1'-0"

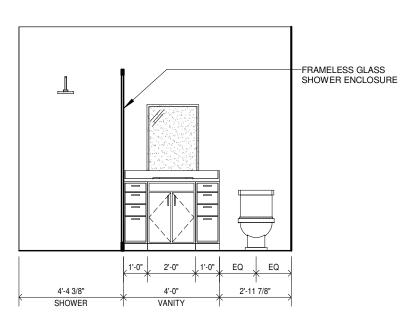

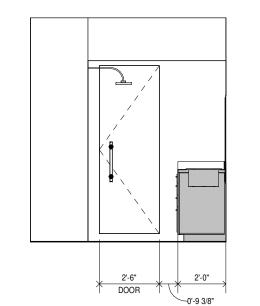

7 BATH 2 UNIT 1511 VIEW A

SCALE: 1/4" = 1'-0"

8 BATH 2 UNIT 1511 VIEW B SCALE: 1/4" = 1'-0"




REVISION HISTORY


189 Maple Ridge Drive Metairie, LA 70001 (504)-885-4477 central@hbsaii.com :-: hbsaii.com

SINCE 1961


1 L.I.S. #2 - CLOUD
2 L.I.S. #2 - CLOUD
3 L.I.S. #2 - CLOUD
4 L.I.S. #2 - CLOUD
5 L.I.S. #2 - CLOUD
6 L.I.S. #2 - CLOUD
7 L.I.S. #2 - CLOUD
8 CONDO 1511

PROJECT#: 1709 PHASE: DD TEAM: Author CHECKER: Checker SCALE: AS NOTED <u>ISSUED: 4/20/20</u>18

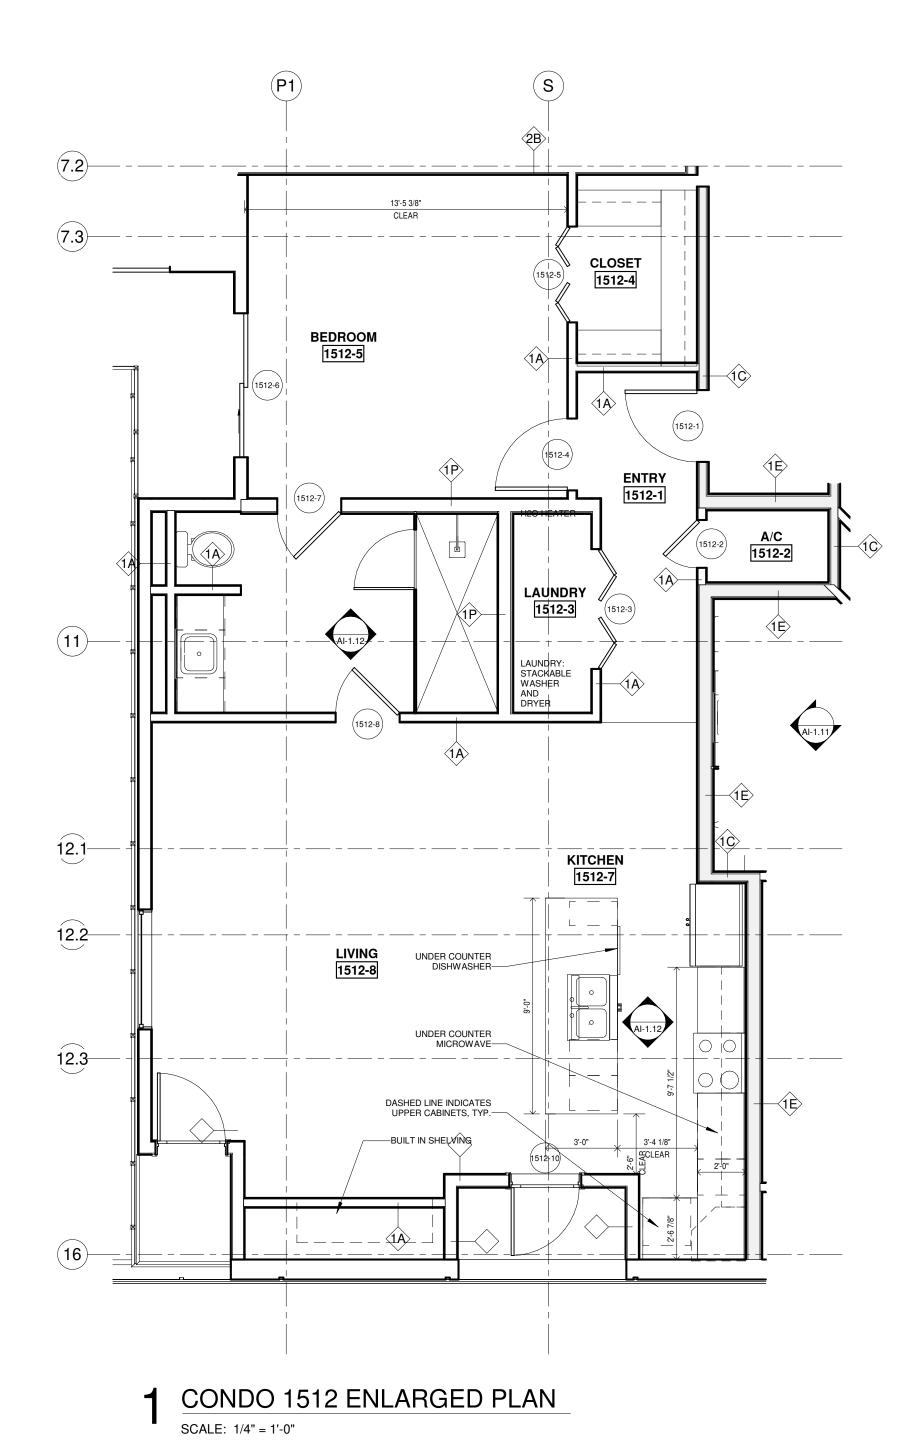

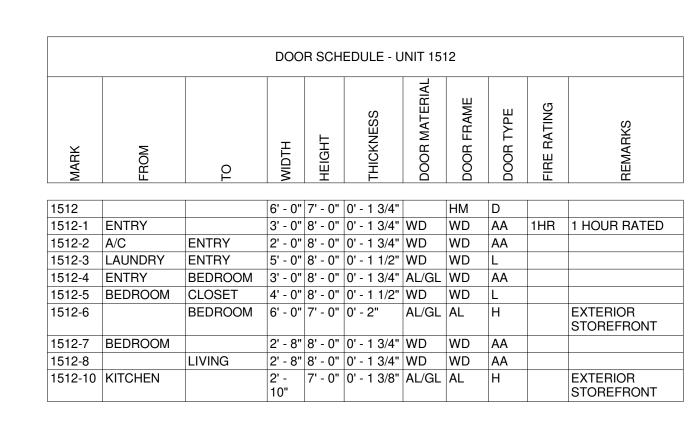


|        |         |              | EINIIQLI    | SCHEDUL  | E LINIT 15   | 510     |         |                |             |
|--------|---------|--------------|-------------|----------|--------------|---------|---------|----------------|-------------|
|        |         |              | TINIOTT     | SOFILDOL | L - OINII IX | 712     |         |                |             |
| NUMBER | NAME    | FLOOR FINISH | BASE FINISH | N. WALL  | S. WALL      | E. WALL | W. WALL | CEILING FINISH | CEILING HT. |
| 1-10   |         |              |             | T        | T            |         | T       | I              |             |
| 1512-1 | ENTRY   |              |             |          |              |         |         |                |             |
| 1512-2 | A/C     |              |             |          |              |         |         |                |             |
| 1512-3 | LAUNDRY |              |             |          |              |         |         |                |             |
| 1512-4 | CLOSET  |              |             |          |              |         |         |                |             |
| 1512-5 | BEDROOM |              |             |          |              |         |         |                |             |
| 1512-6 | BATH    |              |             |          |              |         |         |                |             |
| 1512-7 | KITCHEN |              |             |          |              |         |         |                |             |
| 1512-8 | LIVING  |              |             |          |              |         |         |                |             |

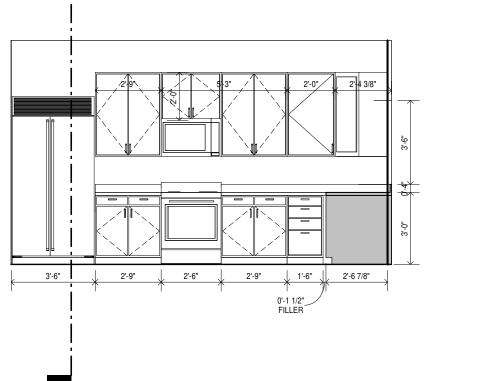


2 KITCHEN UNIT 1512 VIEW A

SCALE: 1/4" = 1'-0"

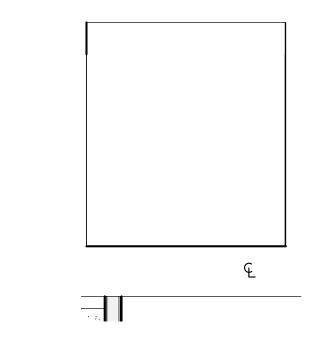


4 BATH UNIT 1512 VIEW A

SCALE: 1/4" = 1'-0"

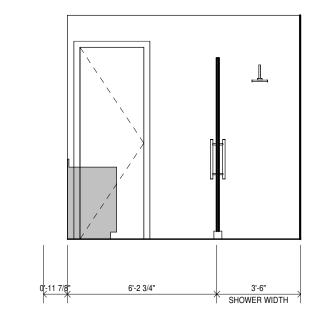


6 BATH UNIT 1512 VIEW C


SCALE: 1/4" = 1'-0"

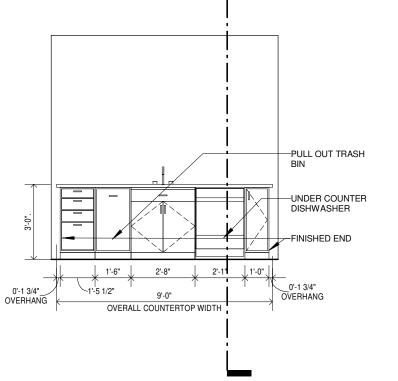

3 KITCHEN UNIT 1512 VIEW B
SCALE: 1/4" = 1'-0"

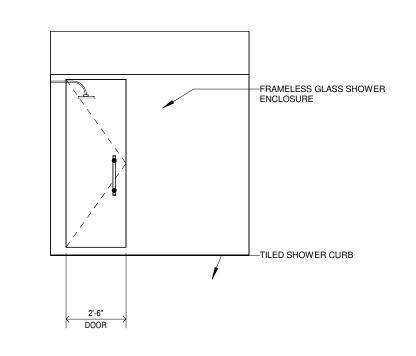


5 BATH UNIT 1512 VIEW B
SCALE: 1/4" = 1'-0"

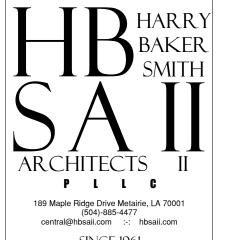


SINCE 1961

1031 CANAL STREET NEW ORLEANS, LOUISIANA


STATE AND FEDERAL REQUIREMENTS, AN
I AM NOT PROVIDING CONTRACT
ADMINISTRATION.

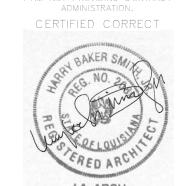


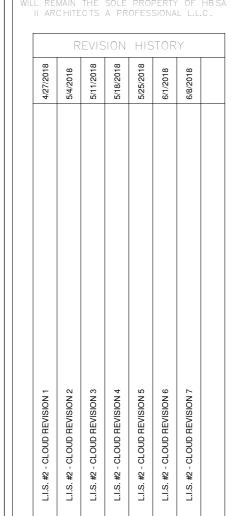


CONDO 1512

PROJECT#: 1709 PHASE: DD TEAM: Author CHECKER: Checker SCALE: AS NOTED ISSUED: 4/20/2018

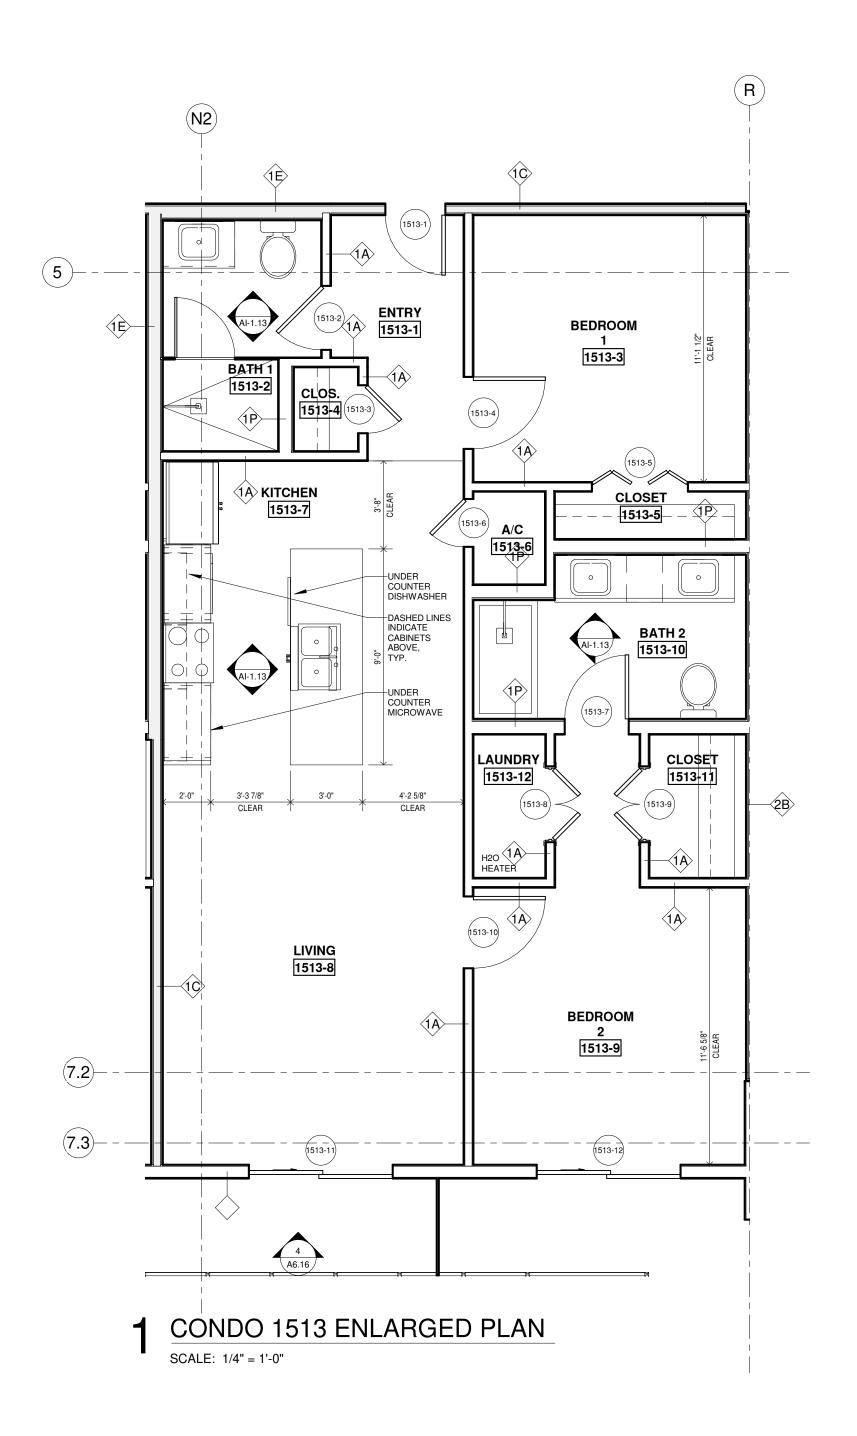


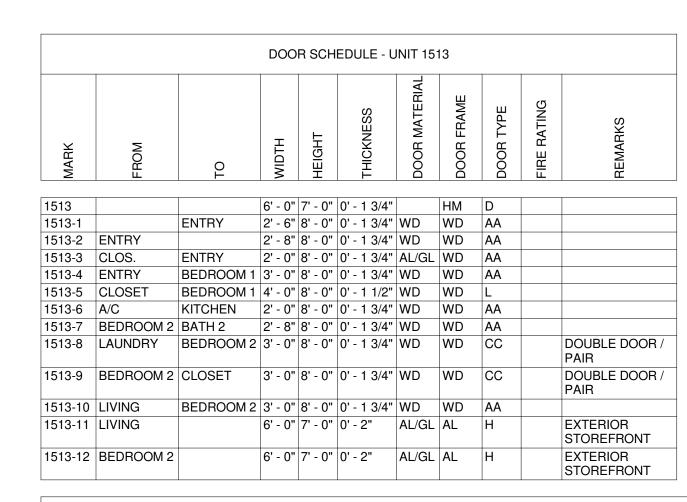


|         |           |              | FINISH      | SCHEDULI | E - UNIT 15 | 513     |         |                |             |
|---------|-----------|--------------|-------------|----------|-------------|---------|---------|----------------|-------------|
| NUMBER  | NAME      | FLOOR FINISH | BASE FINISH | N. WALL  | S. WALL     | E. WALL | W. WALL | CEILING FINISH | CEILING HT. |
|         | I I       |              |             |          |             | 1       |         |                |             |
| 1513-1  | ENTRY     |              |             |          |             |         |         |                |             |
| 1513-2  | BATH 1    |              |             |          |             |         |         |                |             |
| 1513-3  | BEDROOM 1 |              |             |          |             |         |         |                |             |
| 1513-4  | CLOS.     |              |             |          |             |         |         |                |             |
| 1513-5  | CLOSET    |              |             |          |             |         |         |                |             |
| 1513-6  | A/C       |              |             |          |             |         |         |                |             |
| 1513-7  | KITCHEN   |              |             |          |             |         |         |                |             |
| 1513-8  | LIVING    |              |             |          |             |         |         |                |             |
| 1513-9  | BEDROOM 2 |              |             |          |             |         |         |                |             |
| 1513-10 | BATH 2    |              |             |          |             |         |         |                |             |
| 1513-11 | CLOSET    |              |             |          |             |         |         |                |             |
|         | LAUNDRY   |              |             |          |             |         |         |                |             |

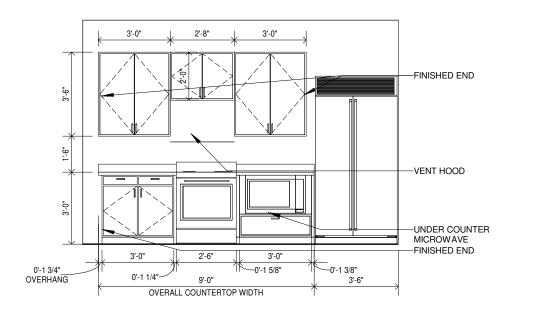


#### 2 KITCHEN UNIT 1513 VIEW A SCALE: 1/4" = 1'-0"

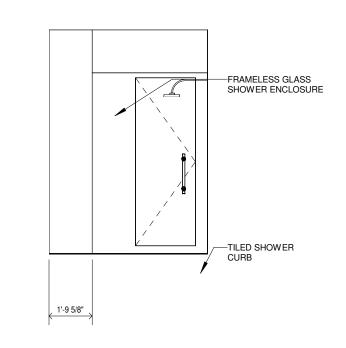


## 4 BATH 1 UNIT 1513 VIEW A SCALE: 1/4" = 1'-0"

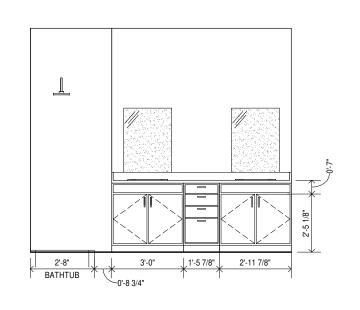


6 BATH 2 UNIT 1513 VIEW A

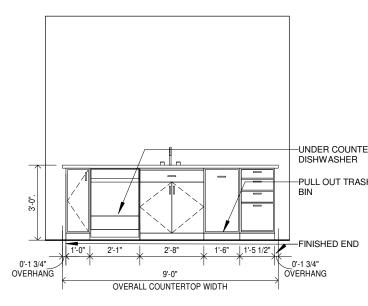


3 KITCHEN UNIT 1513 VIEW B

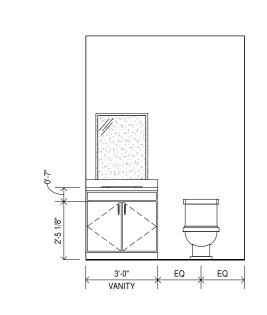


5 BATH 1 UNIT 1513 VIEW B

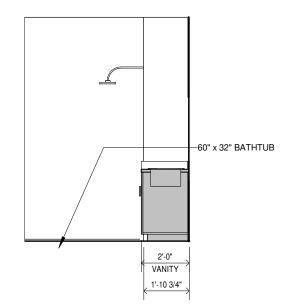


BATH 2 UNIT 1513 VIEW B

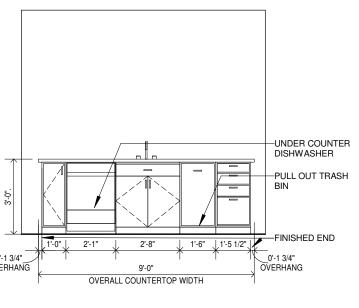

SCALE: 1/4" = 1'-0"

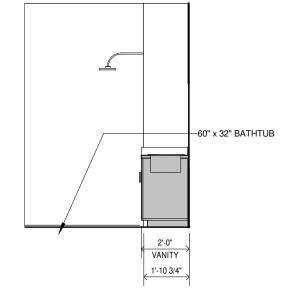

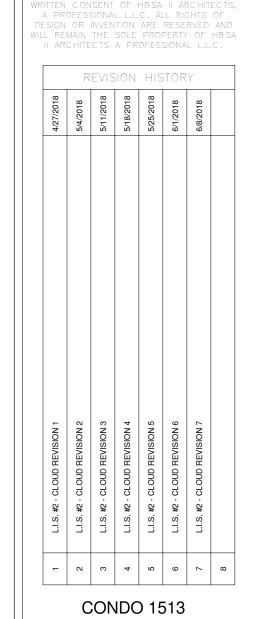

STATE AND FEDERAL REQUIREMENTS, AN
I AM NOT PROVIDING CONTRACT
ADMINISTRATION. CERTIFIED CORRECT


189 Maple Ridge Drive Metairie, LA 70001 (504)-885-4477 central@hbsaii.com :-: hbsaii.com


SINCE 1961


1031 CANAL STREET NEW ORLEANS, LOUISIANA

PROJECT#: 1709 PHASE: DD TEAM: Author CHECKE<u>R: Check</u>er SCALE: AS NOTED


ISSUE<u>D: 4/20/20</u>18

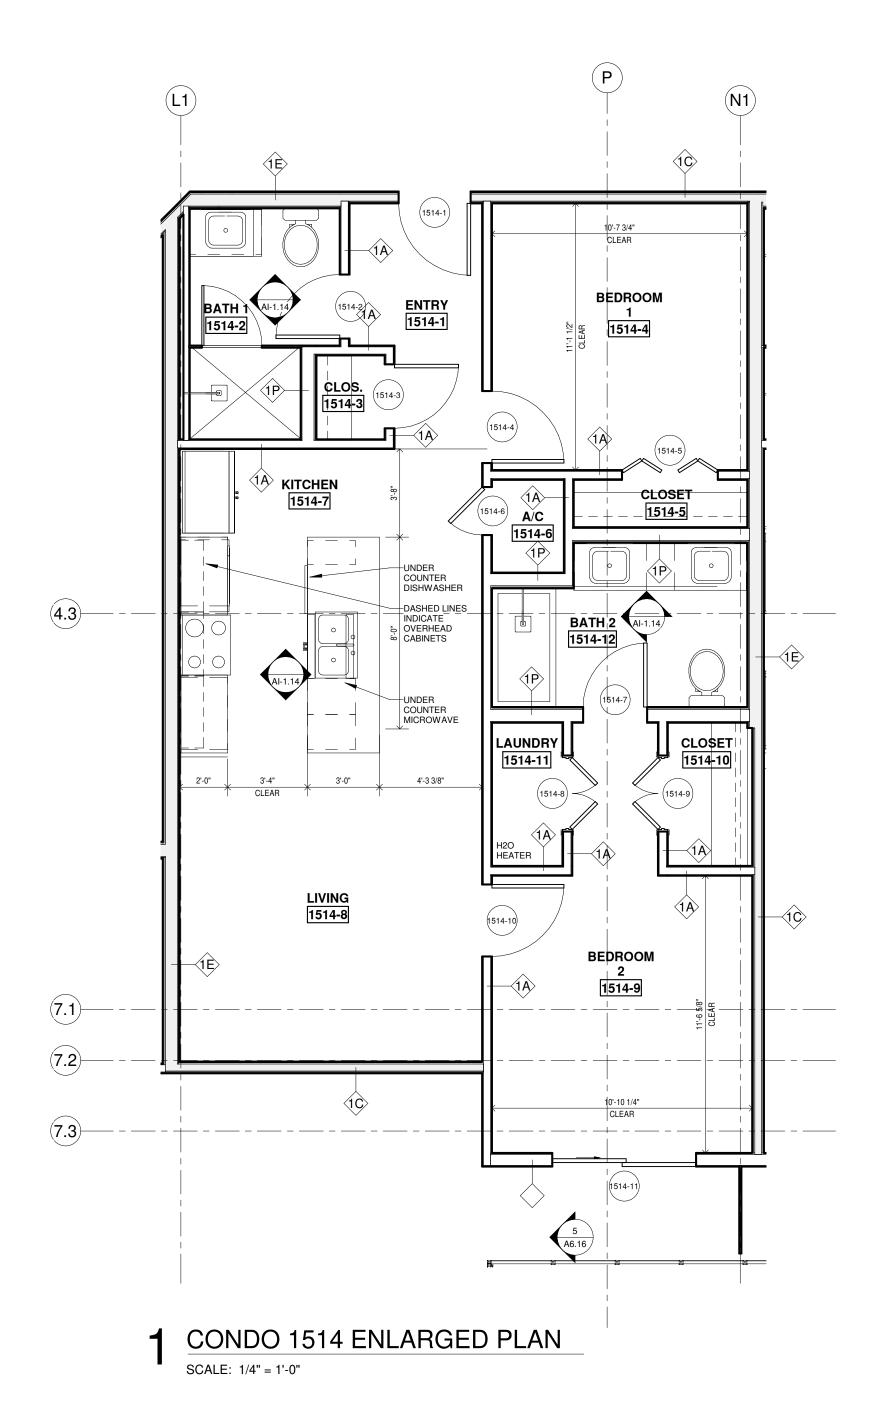

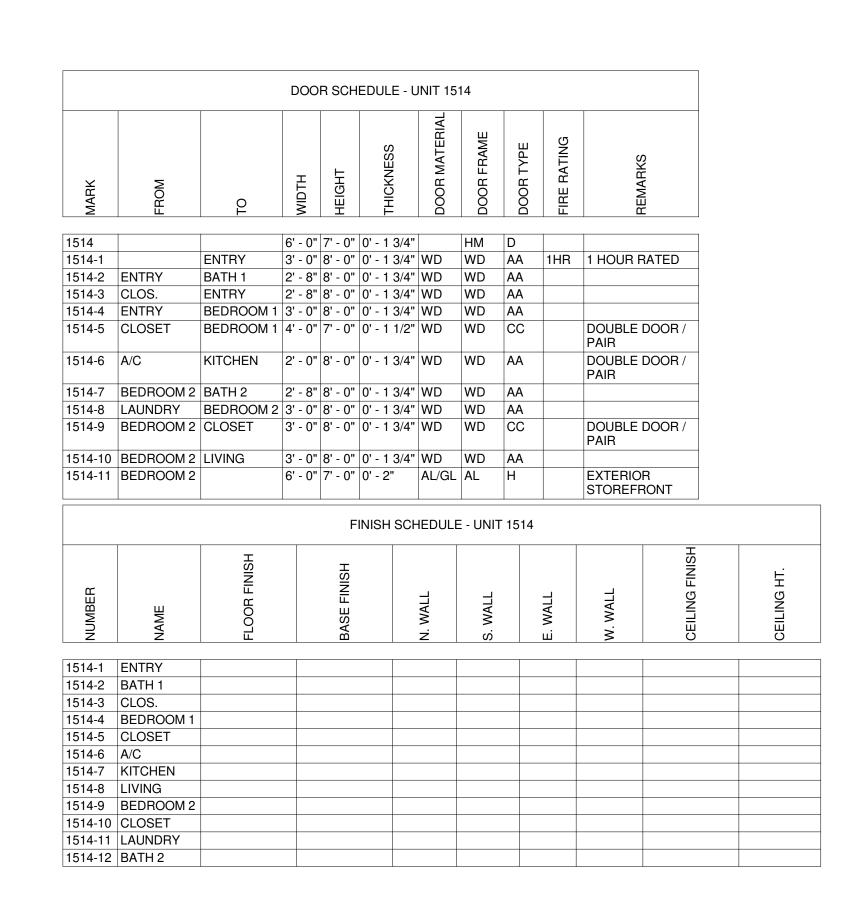

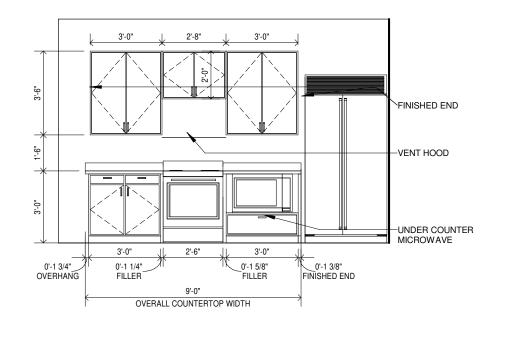




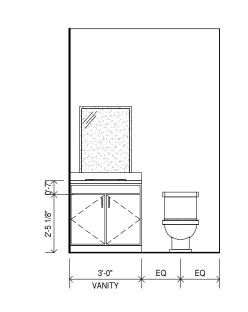


4 BATH 1 UNIT 1514 VIEW A


SCALE: 1/4" = 1'-0"

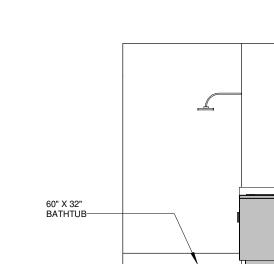


6 BATH 2 UNIT 1514 VIEW A SCALE: 1/4" = 1'-0"

2'-8" 3'-0 3/8" 1'-2" 3'-0 3/8" 0'-8 7/8" 7'-2 7/8"

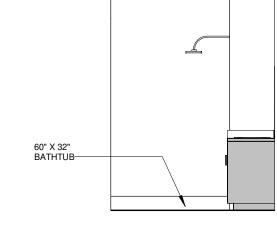


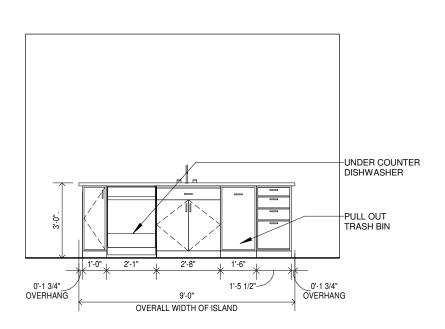


3 KITCHEN UNIT 1514 VIEW B
SCALE: 1/4" = 1'-0"

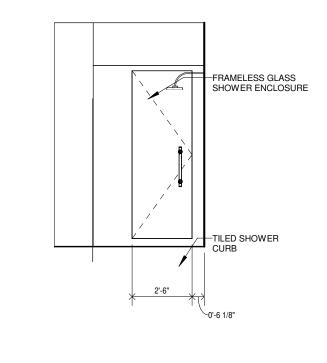

5 BATH 1 UNIT 1514 VIEW B SCALE: 1/4" = 1'-0"

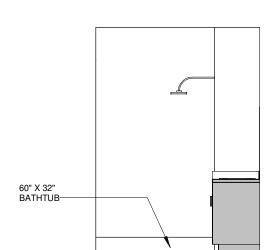

**7** BATH 2 UNIT 1514 VIEW B SCALE: 1/4" = 1'-0"

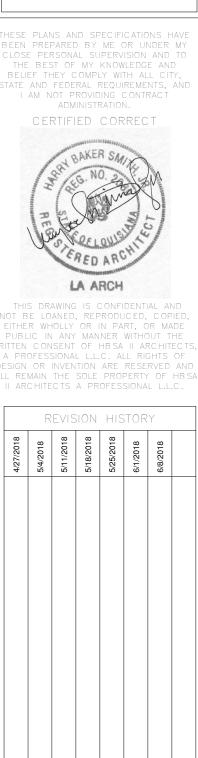

1 L.I.S. #2 - CLO
2 L.I.S. #2 - CLO
3 L.I.S. #2 - CLO
4 L.I.S. #2 - CLO
5 L.I.S. #2 - CLO
6 L.I.S. #2 - CLO
7 L.I.S. #2 - CLO
8

CONDO 1514

SCALE: AS NOTED


PROJECT#: 1709

PHASE: DD TEAM: Author

189 Maple Ridge Drive Metairie, LA 70001 (504)-885-4477 central@hbsaii.com :-: hbsaii.com


SINCE 1961

1031 CANAL STREET NEW ORLEANS, LOUISIANA

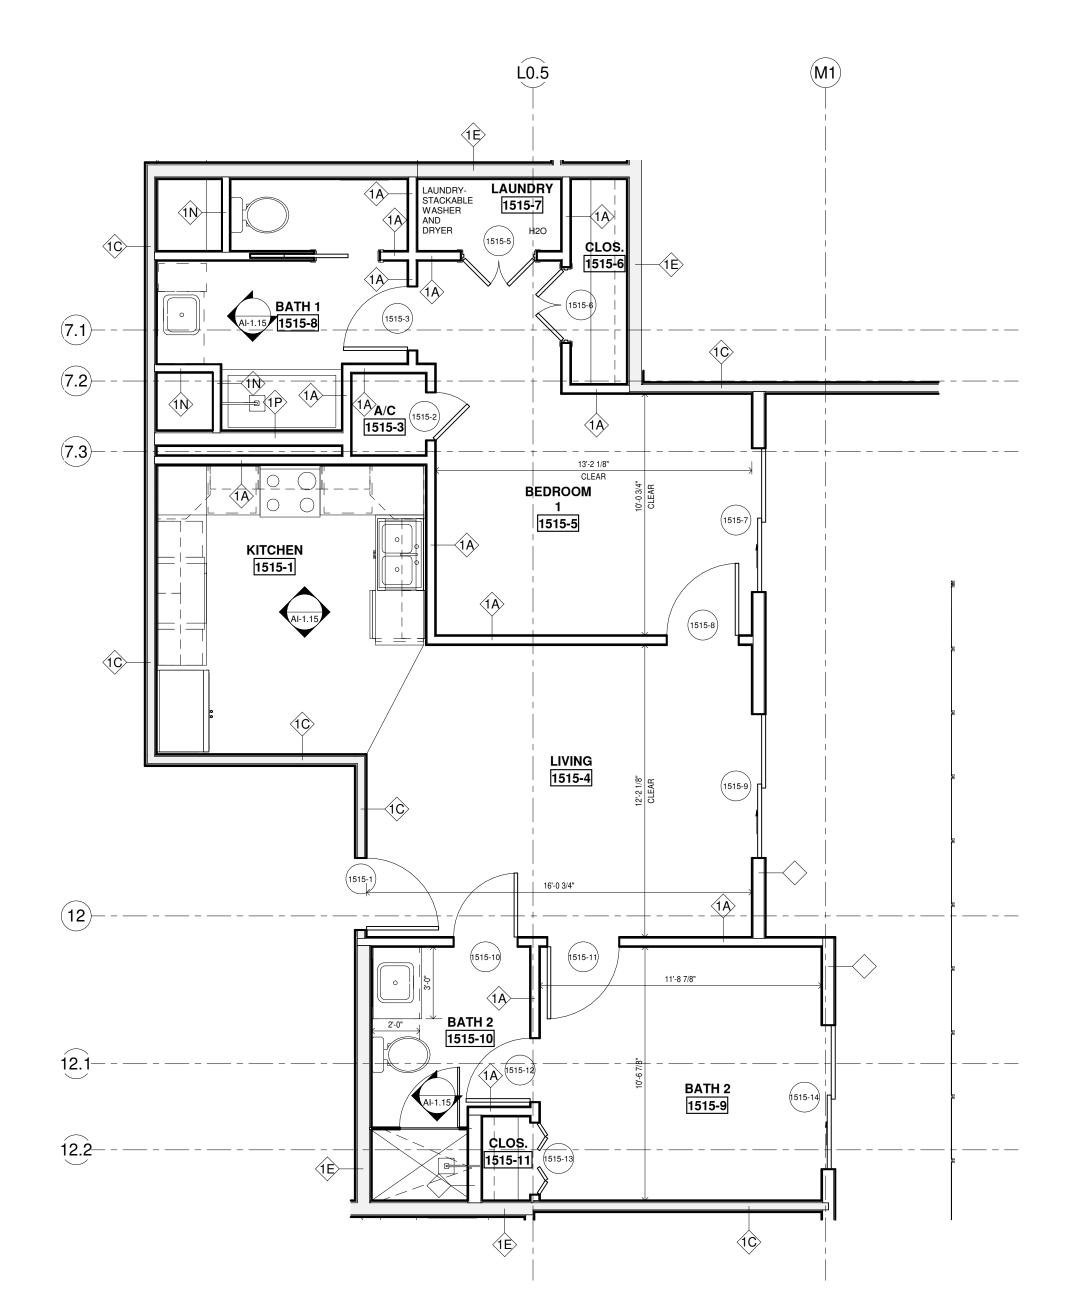



CONDO 1515 ENLARGED PLAN


SCALE: 1/4" = 1'-0"

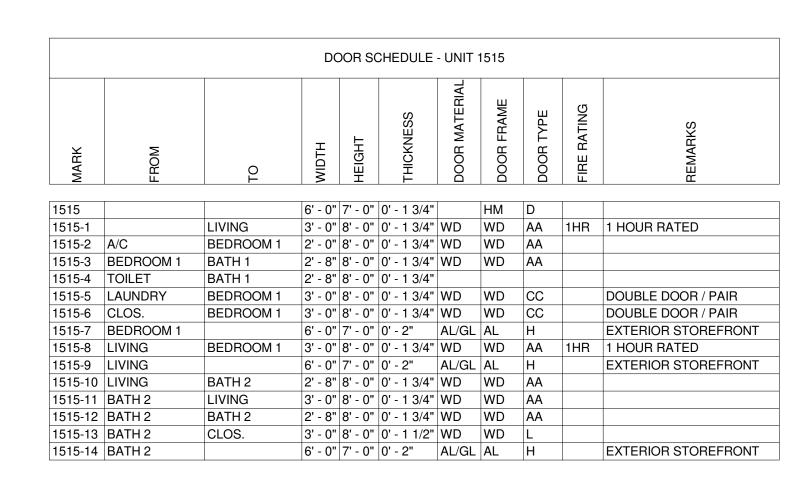


|         |           |              | FINISH      | SCHEDULI | E - UNIT 15 | 515     |         |                |             |
|---------|-----------|--------------|-------------|----------|-------------|---------|---------|----------------|-------------|
| NUMBER  | NAME      | FLOOR FINISH | BASE FINISH | N. WALL  | S. WALL     | E. WALL | W. WALL | CEILING FINISH | CEILING HT. |
|         |           |              |             | •        |             |         |         |                |             |
| 1515-1  | KITCHEN   |              |             |          |             |         |         |                |             |
| 1515-2  | H20       |              |             |          |             |         |         |                |             |
| 1515-2  | TOILET    |              |             |          |             |         |         |                |             |
| 1515-3  | A/C       |              |             |          |             |         |         |                |             |
| 1515-4  | LIVING    |              |             |          |             |         |         |                |             |
| 1515-5  | BEDROOM 1 |              |             |          |             |         |         |                |             |
| 1515-6  | CLOS.     |              |             |          |             |         |         |                |             |
| 1515-7  | LAUNDRY   |              |             |          |             |         |         |                |             |
| 1515-8  | BATH 1    |              |             |          |             |         |         |                |             |
| 1515-9  | BATH 2    |              |             |          |             |         |         |                |             |
| 1515-10 | BATH 2    |              |             |          |             |         |         |                |             |
| 1515-11 | CLOS.     |              |             |          |             |         |         |                |             |

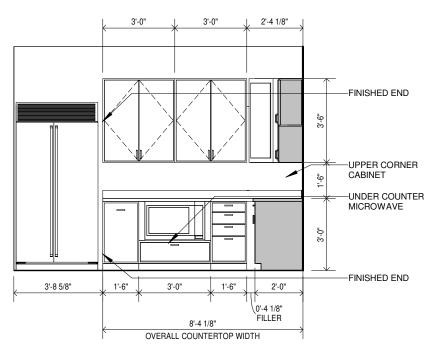

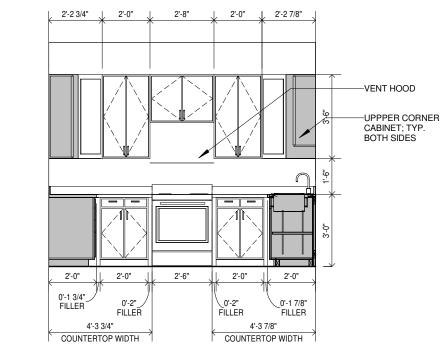

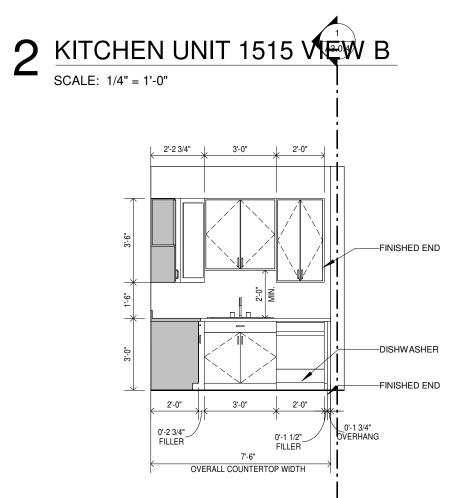


3 KITCHEN UNIT 1515 VIEW A
SCALE: 1/4" = 1'-0"

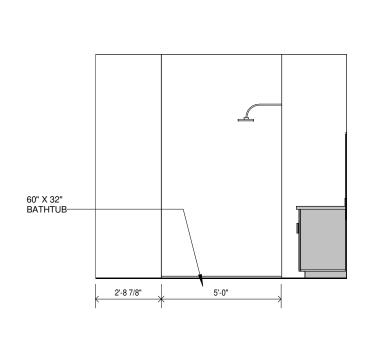


4 KITCHEN UNIT 1515 VIEW C

SCALE: 1/4" = 1'-0"



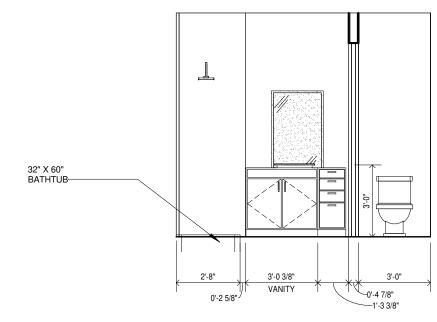


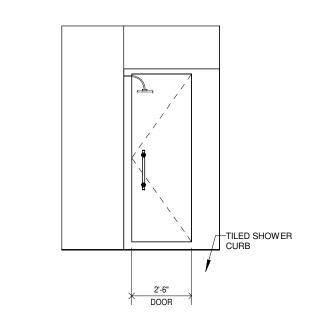


6 BATH 1 UNIT 1515 VIEW B
SCALE: 1/4" = 1'-0"

7 BATH 2 UNIT 1515 VIEW A

SCALE: 1/4" = 1'-0"

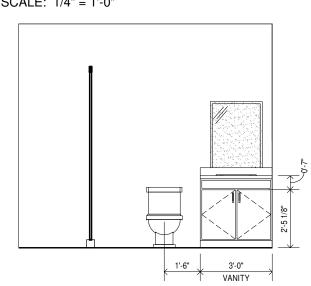

8 BATH 2 UNIT 1515 VIEW B
SCALE: 1/4" = 1'-0"

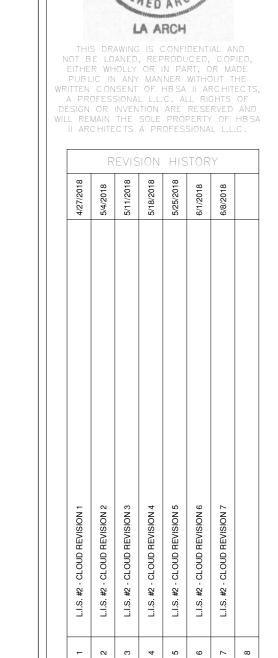

BEEN PREPARED BY ME OR UNDER MY CLOSE PERSONAL SUPERVISION AND TO THE BEST OF MY KNOWLEDGE AND BELIEF THEY COMPLY WITH ALL CITY, STATE AND FEDERAL REQUIREMENTS, AND I AM NOT PROVIDING CONTRACT ADMINISTRATION.

CERTIFIED CORRECT

PLLC

189 Maple Ridge Drive Metairie, LA 70001 (504)-885-4477 central@hbsaii.com :-: hbsaii.com

SINCE 1961

1031 CANAL STREET NEW ORLEANS, LOUISIANA

CONDO 1515

PROJECT#: 1709

PHASE: DD


TEAM: Author

CHECKER: Checker

SCALE: AS NOTED

ISSUED: 4/20/2018

AI-1.15

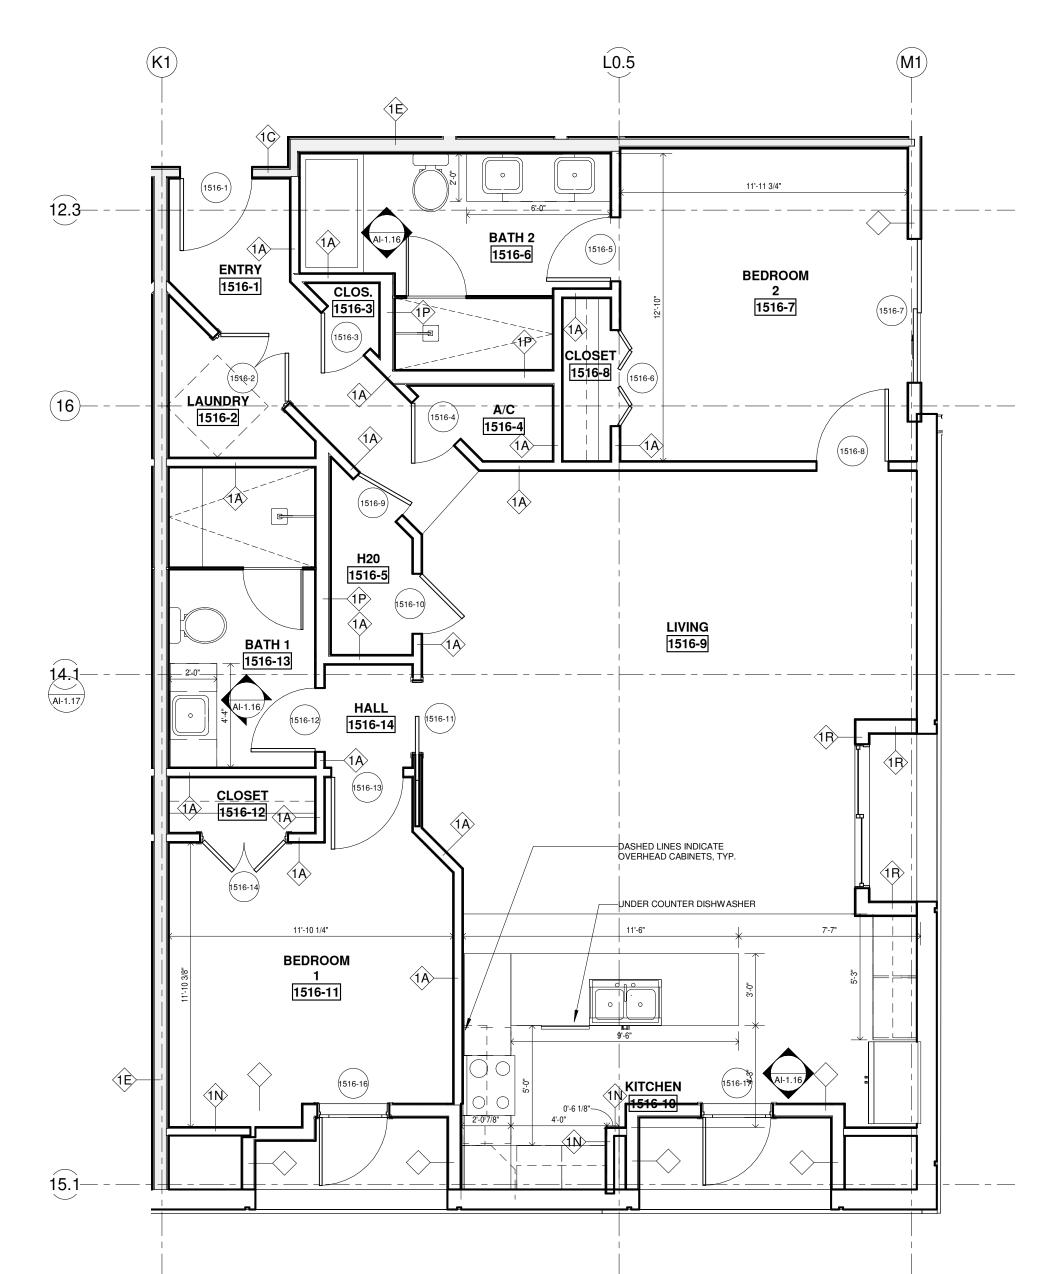


|         |           |           | DOO         | R SCH   | EDULE - U   | INIT 15       | 16         |           |             |                        |
|---------|-----------|-----------|-------------|---------|-------------|---------------|------------|-----------|-------------|------------------------|
| MARK    | FROM      | 70        | WIDTH       | неіднт  | THICKNESS   | DOOR MATERIAL | DOOR FRAME | DOOR TYPE | FIRE RATING | REMARKS                |
| 1516    |           |           | 6' - 0"     | 7' - 0" | 0' - 1 3/4" |               | НМ         | D         |             |                        |
| 1516-1  |           | ENTRY     |             | 8' - 0" | 0' - 1 3/4" |               | WD         | AA        | 1HR         | 1 HOUR RATED           |
| 1516-2  | ENTRY     | LAUNDRY   |             |         | 0' - 1 3/4" | WD            | WD         | СС        |             | DOUBLE DOOR /<br>PAIR  |
| 1516-3  | CLOS.     | ENTRY     | 2' - 6"     | 8' - 0" | 0' - 1 3/4" | WD            | WD         | AA        |             |                        |
| 1516-4  | A/C       | ENTRY     | 2' - 6"     | 8' - 0" | 0' - 1 3/4" | WD            | WD         | AA        |             |                        |
| 1516-5  | BATH 2    | BEDROOM 2 | 2' - 8"     | 8' - 0" | 0' - 1 3/4" | WD            | WD         | AA        |             |                        |
| 1516-6  | CLOSET    | BEDROOM 2 | 4' - 0"     | 8' - 0" | 0' - 1 1/2" | WD            | WD         | L         |             |                        |
| 1516-7  | BEDROOM 2 |           | 6' - 0"     | 7' - 0" | 0' - 2"     | AL/GL         | AL         | Н         |             | EXTERIOR<br>STOREFRONT |
| 1516-8  | LIVING    | BEDROOM 2 | 3' - 0"     | 8' - 0" | 0' - 1 3/4" | WD            | WD         | AA        |             |                        |
| 1516-9  | ENTRY     | H20       | 2' - 6"     | 8' - 0" | 0' - 1 3/4" | WD            | WD         | AA        |             |                        |
| 1516-10 | H20       | LIVING    | 2' - 6"     | 8' - 0" | 0' - 1 3/4" | WD            | WD         | AA        |             |                        |
| 1516-11 | LIVING    | HALL      |             |         | 0' - 1 3/4" |               | WD         | М         |             |                        |
| 1516-12 | HALL      | BATH 1    | 2' - 8"     | 8' - 0" | 0' - 1 3/4" | WD            | WD         | AA        |             |                        |
| 1516-13 | HALL      | BEDROOM 1 | 3' - 0"     | 8' - 0" | 0' - 1 3/4" | WD            | WD         | AA        |             |                        |
| 1516-14 | CLOSET    | BEDROOM 1 | 3' - 6"     | 8' - 0" | 0' - 1 3/4" | WD            | WD         | CC        |             | DOUBLE DOOR /<br>PAIR  |
| 1516-16 | BEDROOM 1 |           | 2' -<br>10" | 7' - 0" | 0' - 1 3/8" | AL/GL         | AL         | Н         |             | EXTERIOR<br>STOREFRONT |
| 1516-17 | KITCHEN   |           | 2' -<br>10" | 7' - 0" | 0' - 1 3/8" | AL/GL         | AL         | Н         |             | EXTERIOR<br>STOREFRONT |


|         |           |              | FINISH      | SCHEDUL | E - UNIT 15 | 16      |         |                |             |
|---------|-----------|--------------|-------------|---------|-------------|---------|---------|----------------|-------------|
| NUMBER  | NAME      | FLOOR FINISH | BASE FINISH | N. WALL | S. WALL     | E. WALL | W. WALL | CEILING FINISH | CEILING HT. |
| 1516-1  | ENTRY     |              |             |         |             |         |         |                |             |
| 1516-2  | LAUNDRY   |              |             |         |             |         |         |                |             |
| 1516-3  | CLOS.     |              |             |         |             |         |         |                |             |
| 1516-4  | A/C       |              |             |         |             |         |         |                |             |
| 1516-5  | H20       |              |             |         |             |         |         |                |             |
| 1516-6  | BATH 2    |              |             |         |             |         |         |                |             |
| 1516-7  | BEDROOM 2 |              |             |         |             |         |         |                |             |
| 1516-8  | CLOSET    |              |             |         |             |         |         |                |             |
| 1516-9  | LIVING    |              |             |         |             |         |         |                |             |
| 1516-10 | KITCHEN   |              |             |         |             |         |         |                |             |
| 1516-11 | BEDROOM 1 |              |             |         |             |         |         |                |             |
| 1516-12 | CLOSET    |              |             |         |             |         |         |                |             |
| 1516-13 |           |              |             |         |             |         |         |                |             |
| 1516-14 | HALL      |              |             |         |             |         |         |                |             |

1 CONDO 1516 ENLARGED PLAN


SCALE: 1/4" = 1'-0"

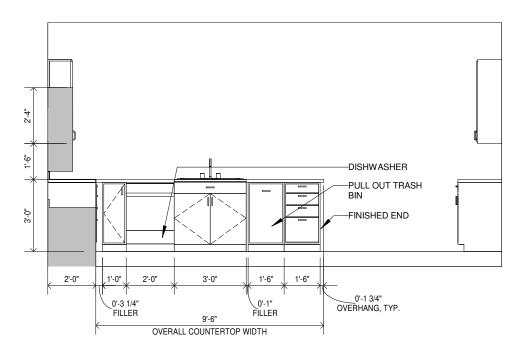


## 2 KITCHEN UNIT 1516 VIEW A SCALE: 1/4" = 1'-0"

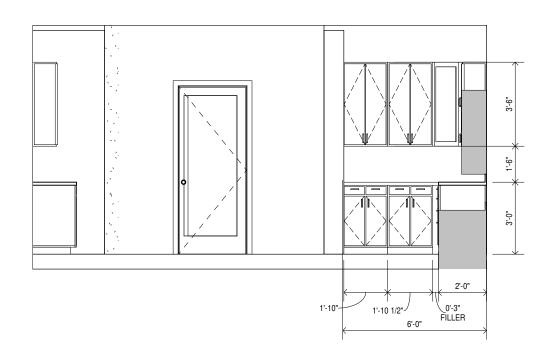


# 4 KITCHEN UNIT 1516 VIEW C SCALE: 1/4" = 1'-0"

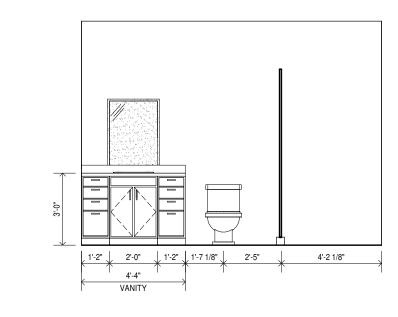


#### 6 BATH 1 UNIT 1516 VIEW A SCALE: 1/4" = 1'-0"

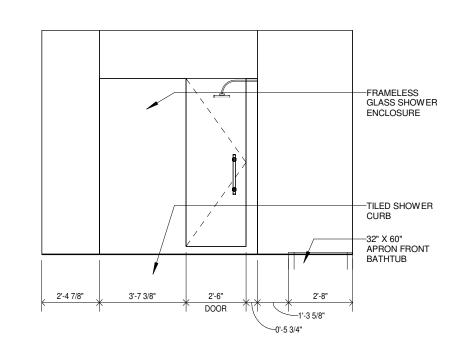


## 8 BATH 2 UNIT 1516 VIEW A SCALE: 1/4" = 1'-0"

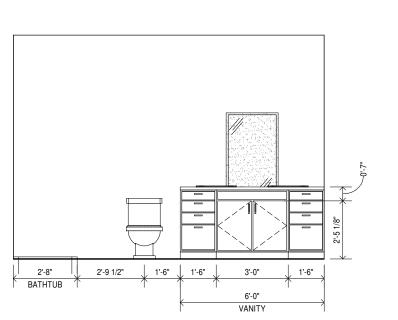


1 0 BATH 2 UNIT 1516 VIEW C
SCALE: 1/4" = 1'-0"

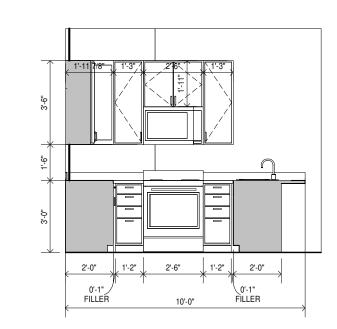


#### 3 KITCHEN UNIT 1516 VIEW B

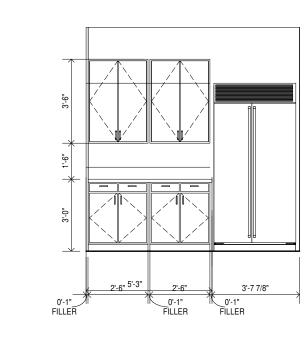


#### 5 KITCHEN UNIT 1516 VIEW D

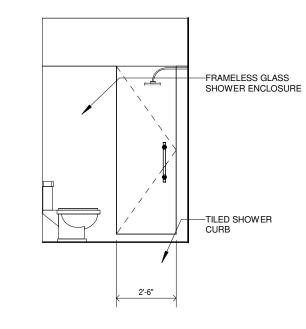

#### 7 BATH 1 UNIT 1516 VIEW B SCALE: 1/4" = 1'-0"

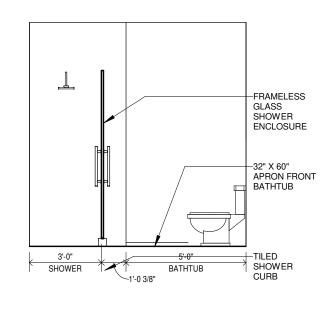

## 9 BATH 2 UNIT 1516 VIEW B SCALE: 1/4" = 1'-0"

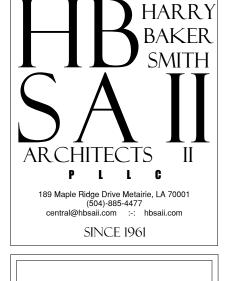

@hbsaii.com :: hbsaii.com
SINCE 1961

DROCKHO]

1031 CANAL STREET

NEW ORLEANS, LOUISIANA

TAK 10 10 NEW

SE PLANS AND SPECIFICATIONS HAVE
EN PREPARED BY ME OR UNDER MY
OSE PERSONAL SUPERVISION AND TO
THE BEST OF MY KNOWLEDGE AND
ELIEF THEY COMPLY WITH ALL CITY,
TE AND FEDERAL REQUIREMENTS, AND
I AM NOT PROVIDING CONTRACT
ADMINISTRATION.

CERTIFIED CORRECT




THIS DRAWING IS CONFIDENTIAL AND
NOT BE LOANED, REPRODUCED, COPIED
EITHER WHOLLY OR IN PART, OR MADE
PUBLIC IN ANY MANNER WITHOUT THE
WRITTEN CONSENT OF HBSA II ARCHITECT
A PROFESSIONAL L.L.C. ALL RIGHTS OF
DESIGN OR INVENTION ARE RESERVED AN
WILL REMAIN THE SOLE PROPERTY OF HB

|                              | R                            | EVIS                         |                              |                              | TOR                          | Υ                            |  |
|------------------------------|------------------------------|------------------------------|------------------------------|------------------------------|------------------------------|------------------------------|--|
| 4/27/2018                    | 5/4/2018                     | 5/11/2018                    | 5/18/2018                    | 5/25/2018                    | 6/1/2018                     | 6/8/2018                     |  |
| 4                            | is.                          | <u></u>                      | is .                         | is.                          | 0                            | 0                            |  |
| L.I.S. #2 - CLOUD REVISION 1 | L.I.S. #2 - CLOUD REVISION 2 | L.I.S. #2 - CLOUD REVISION 3 | L.I.S. #2 - CLOUD REVISION 4 | L.I.S. #2 - CLOUD REVISION 5 | L.I.S. #2 - CLOUD REVISION 6 | L.I.S. #2 - CLOUD REVISION 7 |  |


CONDO 1516

PROJECT#: 1709
PHASE: DD
TEAM: Author
CHECKER: Checker
SCALE: AS NOTED
ISSUED: 4/20/2018

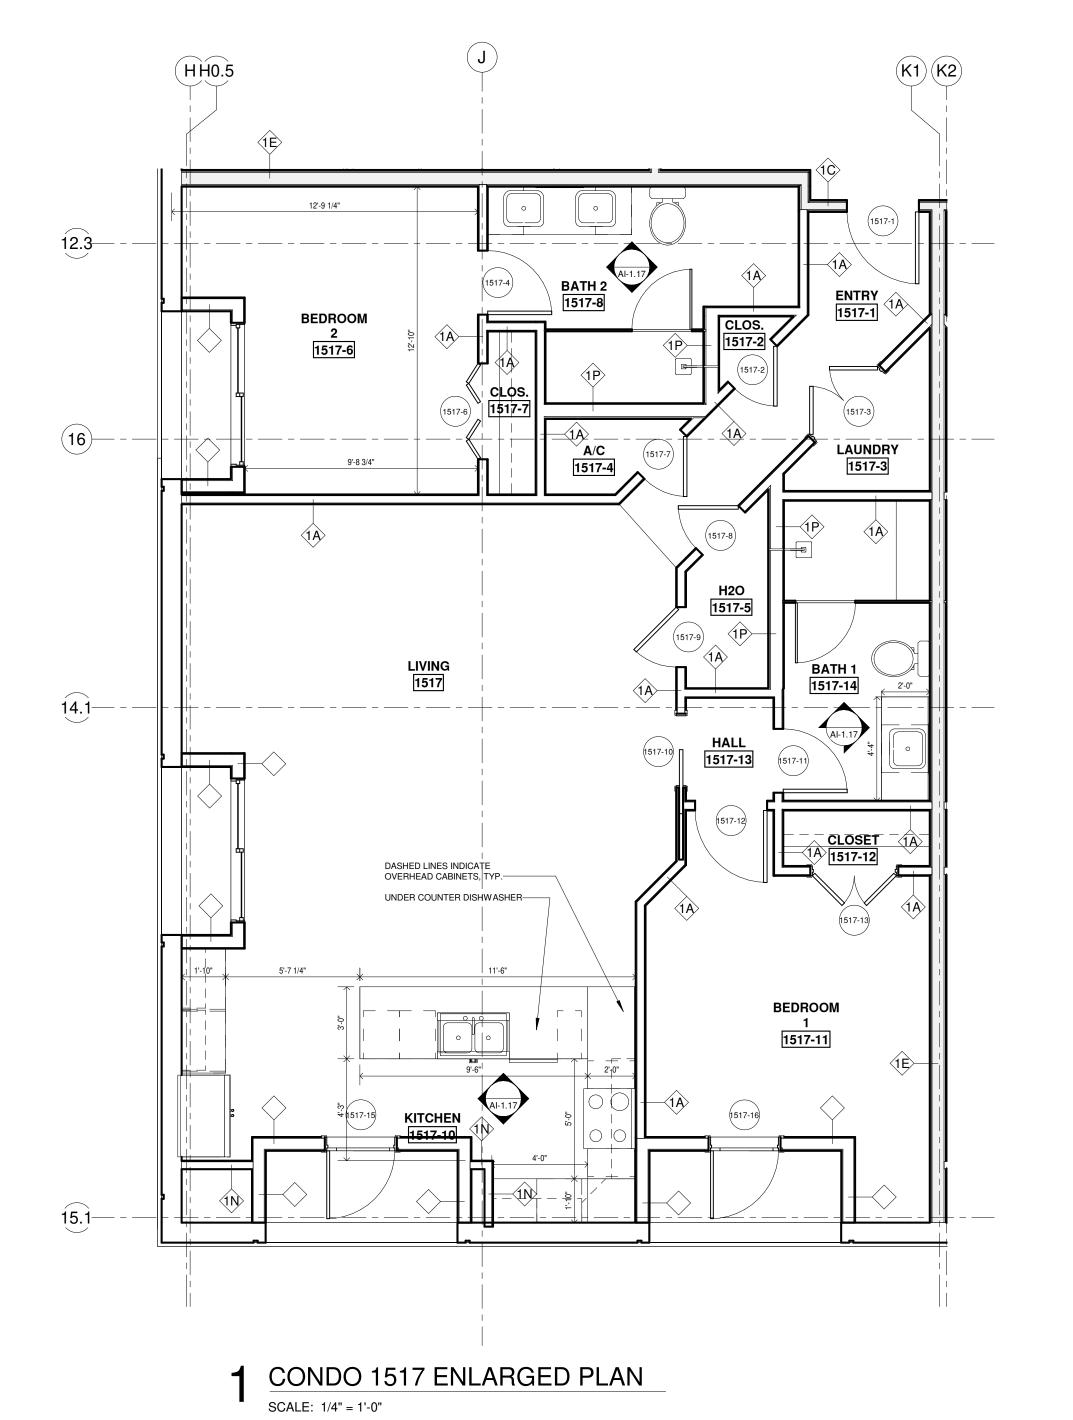


|         |           |           | DOO         | R SCH   | EDULE - L   | JNIT 15       | 17         |           |             |                        |
|---------|-----------|-----------|-------------|---------|-------------|---------------|------------|-----------|-------------|------------------------|
| MARK    | FROM      | TO        | WIDTH       | НЕІСНТ  | THICKNESS   | DOOR MATERIAL | DOOR FRAME | DOOR TYPE | FIRE RATING | REMARKS                |
| 1517-1  |           | ENTRY     | 3' N"       | מי חיי  | 0' - 1 3/4" | WD            | WD         | AA        | 1HR         | 1 HOUR RATED           |
| 1517-1  | ENTRY     | CLOS.     |             |         | 0' - 1 3/4" |               | WD         | AA        | IIII        | THOOR RATED            |
| 1517-2  | LAUNDRY   | ENTRY     |             |         | 0' - 1 3/4" |               | WD         | CC        |             | DOUBLE DOOR /<br>PAIR  |
| 1517-4  | BEDROOM 2 | BATH 2    | 2' - 8"     | 8' - 0" | 0' - 1 3/4" | WD            | WD         | AA        |             |                        |
| 1517-6  | BEDROOM 2 | CLOS.     | 4' - 0"     | 8' - 0" | 0' - 1 1/2" | WD            | WD         | L         |             |                        |
| 1517-7  | ENTRY     | A/C       | 2' - 6"     | 8' - 0" | 0' - 1 3/4" | WD            | WD         | AA        |             |                        |
| 1517-8  | H2O       | ENTRY     | 2' - 6"     | 8' - 0" | 0' - 1 3/4" | WD            | WD         | AA        |             |                        |
| 1517-9  | LIVING    | H2O       | 2' - 6"     | 8' - 0" | 0' - 1 3/4" | WD            | WD         | AA        |             |                        |
| 1517-10 | HALL      | LIVING    | 3' - 0"     | 8' - 0" | 0' - 1 3/4" | WD            | WD         | М         |             |                        |
| 1517-11 | BATH 1    | HALL      | 2' - 8"     | 8' - 0" | 0' - 1 3/4" | WD            | WD         | AA        |             |                        |
| 1517-12 | HALL      | BEDROOM 1 | 3' - 0"     | 8' - 0" | 0' - 1 3/4" | WD            | WD         | AA        |             |                        |
| 1517-13 | BEDROOM 1 | CLOSET    | 3' - 6"     | 8' - 0" | 0' - 1 3/4" | WD            | WD         | CC        |             |                        |
| 1517-15 | KITCHEN   |           | 2' -<br>10" | 7' - 0" | 0' - 1 3/8" | AL/GL         | AL         | Н         |             | EXTERIOR<br>STOREFRONT |
| 1517-16 | BEDROOM 1 |           | 2' -<br>10" | 7' - 0" | 0' - 1 3/8" | AL/GL         | AL         | Н         |             | EXTERIOR<br>STOREFRONT |


|         |           |              | FINISH      | SCHEDUL | E - UNIT 15 | 517     |         |                |             |
|---------|-----------|--------------|-------------|---------|-------------|---------|---------|----------------|-------------|
| NUMBER  | NAME      | FLOOR FINISH | BASE FINISH | N. WALL | S. WALL     | E. WALL | W. WALL | CEILING FINISH | CEILING HT. |
|         |           |              |             | T.      |             |         | T       | 1              |             |
| 1517    | LIVING    |              |             |         |             |         |         |                |             |
| 1517-1  | ENTRY     |              |             |         |             |         |         |                |             |
| 1517-2  | CLOS.     |              |             |         |             |         |         |                |             |
| 1517-3  | LAUNDRY   |              |             |         |             |         |         |                |             |
| 1517-4  | A/C       |              |             |         |             |         |         |                |             |
| 1517-5  | H2O       |              |             |         |             |         |         |                |             |
| 1517-6  | BEDROOM 2 |              |             |         |             |         |         |                |             |
| 1517-7  | CLOS.     |              |             |         |             |         |         |                |             |
| 1517-8  | BATH 2    |              |             |         |             |         |         |                |             |
| 1517-10 | KITCHEN   |              |             |         |             |         |         |                |             |
| 1517-11 | BEDROOM 1 |              |             |         |             |         |         |                |             |
| 1517-12 | CLOSET    |              |             |         |             |         |         |                |             |
| 1517-13 | HALL      |              |             |         |             |         |         |                |             |
| 1517-14 | BATH 1    |              |             |         |             |         |         |                |             |

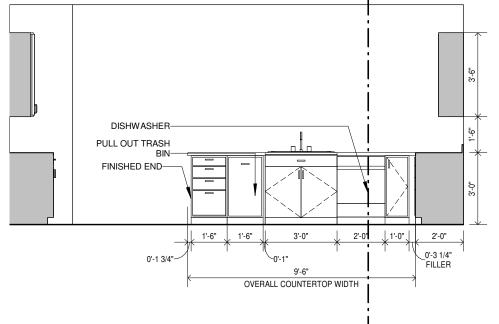




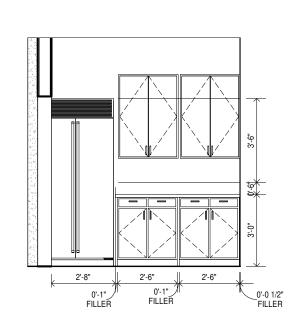




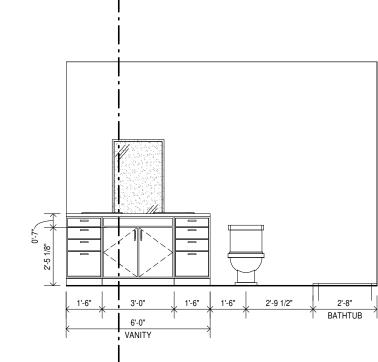


6 BATH 2 UNIT 1517 VIEW A

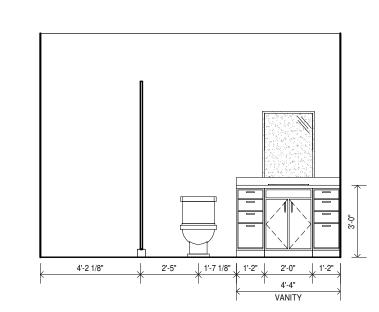


8 BATH 1 UNIT 1517 VIEW A
SCALE: 1/4" = 1'-0"

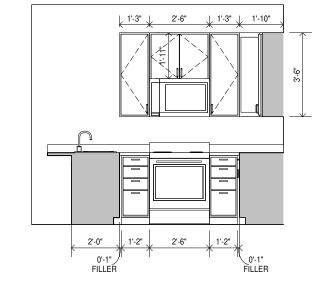


3 KITCHEN UNIT 1517 VIEW B
SCALE: 1/4" = 1'-0"

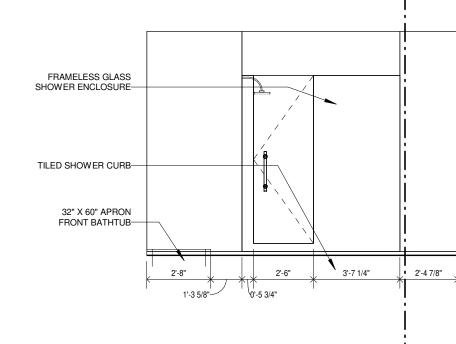


5 BATH 2 UNIT 1517 VIEW SCALE: 1/4" = 1'-0"

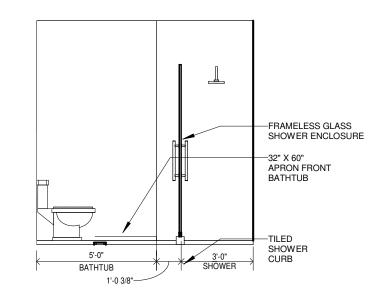

7 BATH 2 UNIT 1517 VIEW B

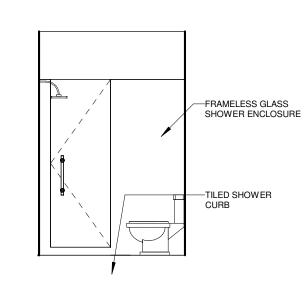


9 BATH 1 UNIT 1517 VIEW B
SCALE: 1/4" = 1'-0"

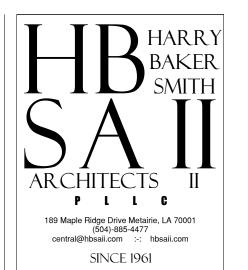

1031 CANAL STREET
NEW ORLEANS, LOUISIANA

SE PLANS AND SPECIFICATIONS HAVE EN PREPARED BY ME OR UNDER MY OSE PERSONAL SUPERVISION AND TO THE BEST OF MY KNOWLEDGE AND ELIEF THEY COMPLY WITH ALL CITY, TE AND FEDERAL REQUIREMENTS, AND I AM NOT PROVIDING CONTRACT ADMINISTRATION.

CERTIFIED CORRECT

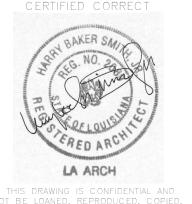


THIS DRAWING IS CONFIDENTIAL AND NOT BE LOANED, REPRODUCED, COPIED, EITHER WHOLLY OR IN PART, OR MADE PUBLIC IN ANY MANNER WITHOUT THE WRITTEN CONSENT OF HBSA II ARCHITECTS, A PROFESSIONAL L.L.C. ALL RIGHTS OF DESIGN OR INVENTION ARE RESERVED AND WILL REMAIN THE SOLE PROPERTY OF HBSA


|                              | REVISION HISTORY             |                              |                              |                              |                              |                              |  |  |  |  |  |
|------------------------------|------------------------------|------------------------------|------------------------------|------------------------------|------------------------------|------------------------------|--|--|--|--|--|
|                              | K                            |                              |                              |                              | IUK                          | Y                            |  |  |  |  |  |
| 4/27/2018                    | 5/4/2018                     | 5/11/2018                    | 5/18/2018                    | 5/25/2018                    | 6/1/2018                     | 6/8/2018                     |  |  |  |  |  |
| L.I.S. #2 - CLOUD REVISION 1 | L.I.S. #2 - CLOUD REVISION 2 | L.I.S. #2 - CLOUD REVISION 3 | L.I.S. #2 - CLOUD REVISION 4 | L.I.S. #2 - CLOUD REVISION 5 | L.I.S. #2 - CLOUD REVISION 6 | L.I.S. #2 - CLOUD REVISION 7 |  |  |  |  |  |
|                              |                              |                              |                              | 5                            | 9                            |                              |  |  |  |  |  |

CONDO 1517


PROJECT#: 1709
PHASE: DD
TEAM: Author
CHECKER: Checker
SCALE: AS NOTED
ISSUED: 4/20/2018

AI-1.17

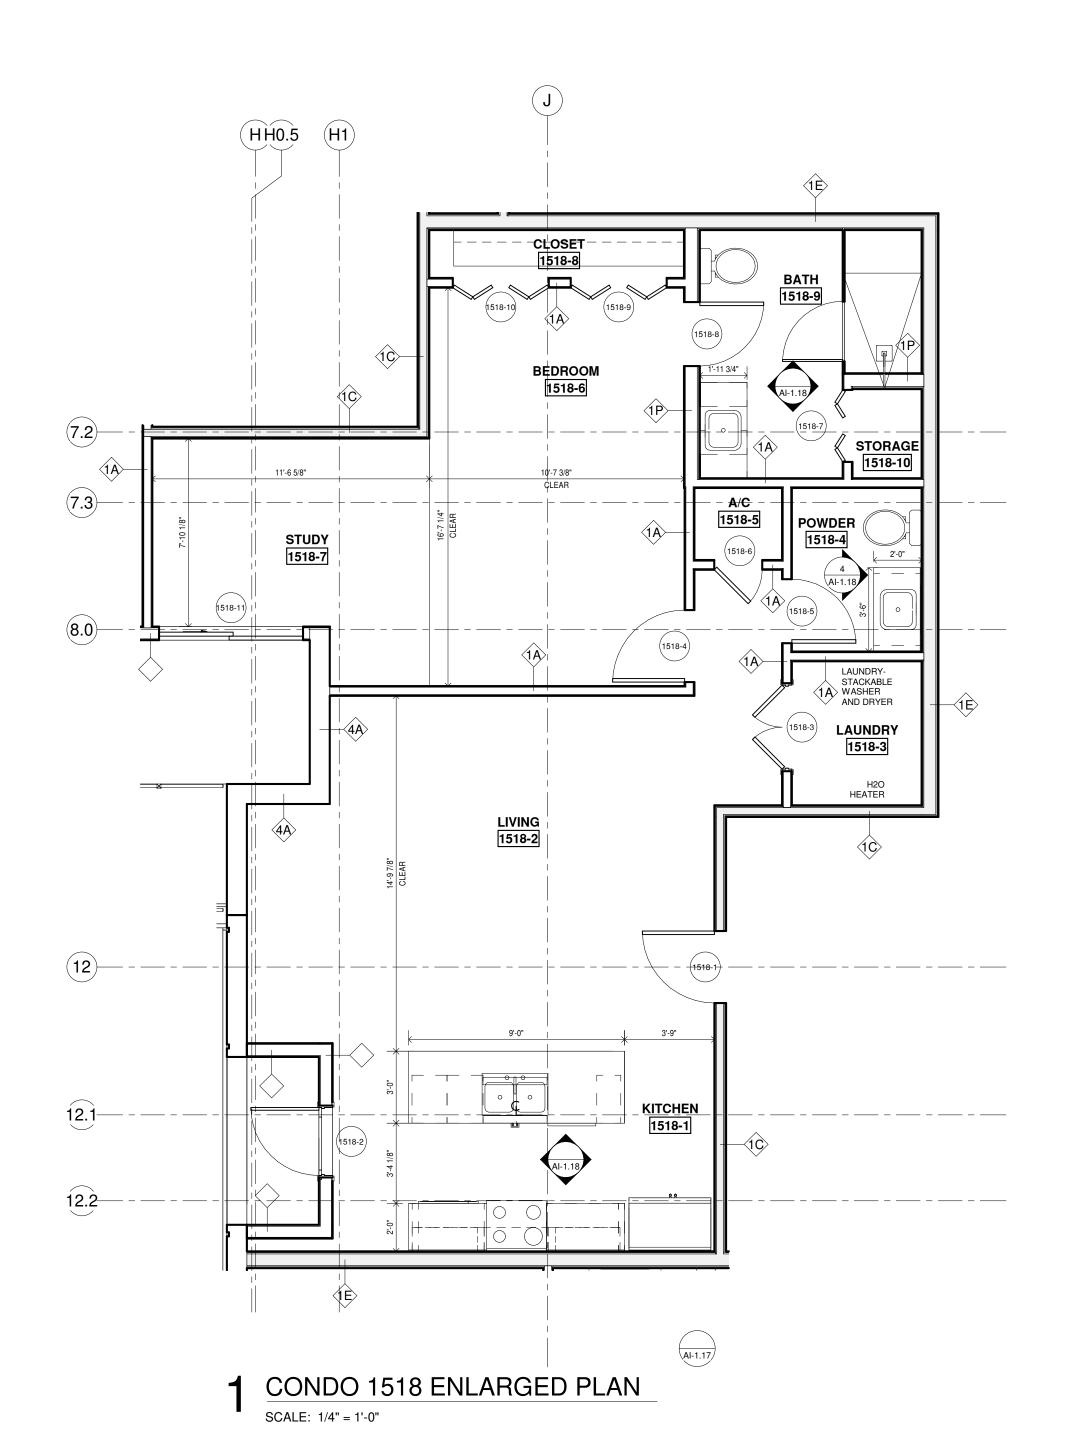


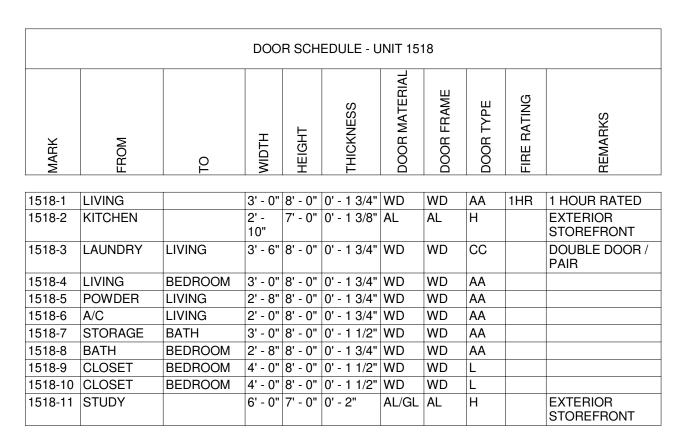


|         |         |              | FINISH      | SCHEDUL | E - UNIT 15 | 518     |         |                |             |
|---------|---------|--------------|-------------|---------|-------------|---------|---------|----------------|-------------|
| NUMBER  | NAME    | FLOOR FINISH | BASE FINISH | N. WALL | S. WALL     | E. WALL | W. WALL | CEILING FINISH | CEILING HT. |
|         |         |              |             |         |             |         |         |                |             |
| 1518-1  | KITCHEN |              |             |         |             |         |         |                |             |
| 1518-2  | LIVING  |              |             |         |             |         |         |                |             |
| 1518-3  | LAUNDRY |              |             |         |             |         |         |                |             |
| 1518-4  | POWDER  |              |             |         |             |         |         |                |             |
| 1518-5  | A/C     |              |             |         |             |         |         |                |             |
| 1518-6  | BEDROOM |              |             |         |             |         |         |                |             |
| 1518-7  | STUDY   |              |             |         |             |         |         |                |             |
| 1518-8  | CLOSET  |              |             |         |             |         |         |                |             |
| 1518-9  | BATH    |              |             |         |             |         |         |                |             |
| 1518-10 | STORAGE |              |             |         |             |         |         |                |             |

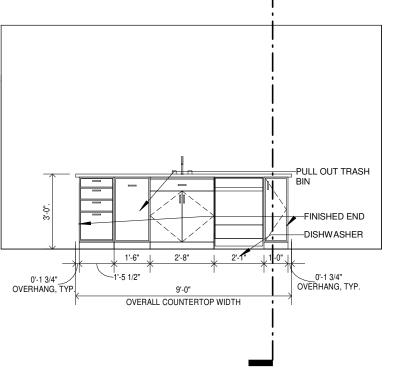




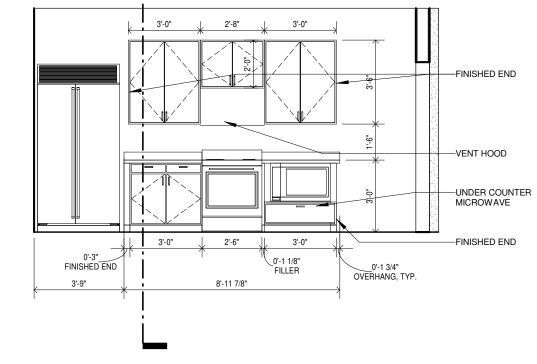


3 KITCHEN UNIT 1518 VIEW B
SCALE: 1/4" = 1'-0"

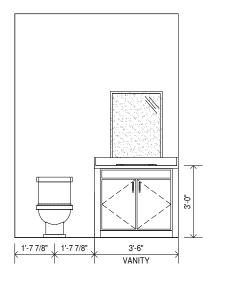

4 POWDER ROOM UNIT 1518
SCALE: 1/4" = 1'-0"

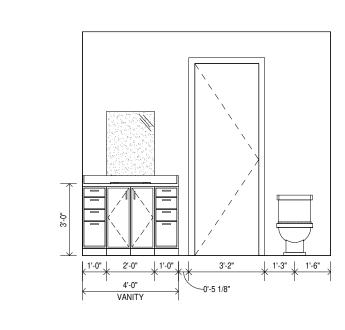

5 BATH 1 UNIT 1518 VIEW A SCALE: 1/4" = 1'-0"

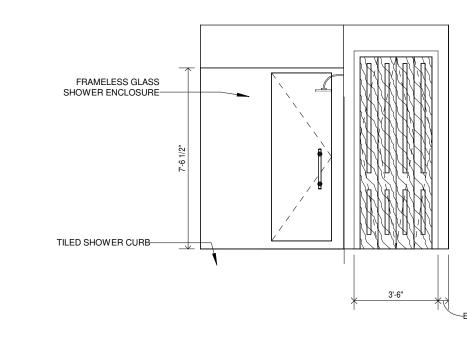

6 BATH 1 UNIT 1518 VIEW B
SCALE: 1/4" = 1'-0"



P L L C

189 Maple Ridge Drive Metairie, LA 70001 (504)-885-4477 central@hbsaii.com :-: hbsaii.com

SINCE 1961


1031 CANAL STREET NEW ORLEANS, LOUISIANA



|                              | R                            | EVIS                         | ION                          | HIS                          | TOR                          | Υ                            |   |
|------------------------------|------------------------------|------------------------------|------------------------------|------------------------------|------------------------------|------------------------------|---|
| 4/27/2018                    | 5/4/2018                     | 5/11/2018                    | 5/18/2018                    | 5/25/2018                    | 6/1/2018                     | 6/8/2018                     |   |
|                              |                              |                              |                              |                              |                              |                              |   |
| L.I.S. #2 - CLOUD REVISION 1 | L.I.S. #2 - CLOUD REVISION 2 | L.I.S. #2 - CLOUD REVISION 3 | L.I.S. #2 - CLOUD REVISION 4 | L.I.S. #2 - CLOUD REVISION 5 | L.I.S. #2 - CLOUD REVISION 6 | L.I.S. #2 - CLOUD REVISION 7 |   |
| -                            | 2                            | က                            | 4                            | 5                            | 9                            | 7                            | 8 |


CONDO 1518

PROJECT#: 1709
PHASE: DD
TEAM: Author
CHECKER: Checker
SCALE: AS NOTED
ISSUED: 4/20/2018
SHEET#:
Al-1.18

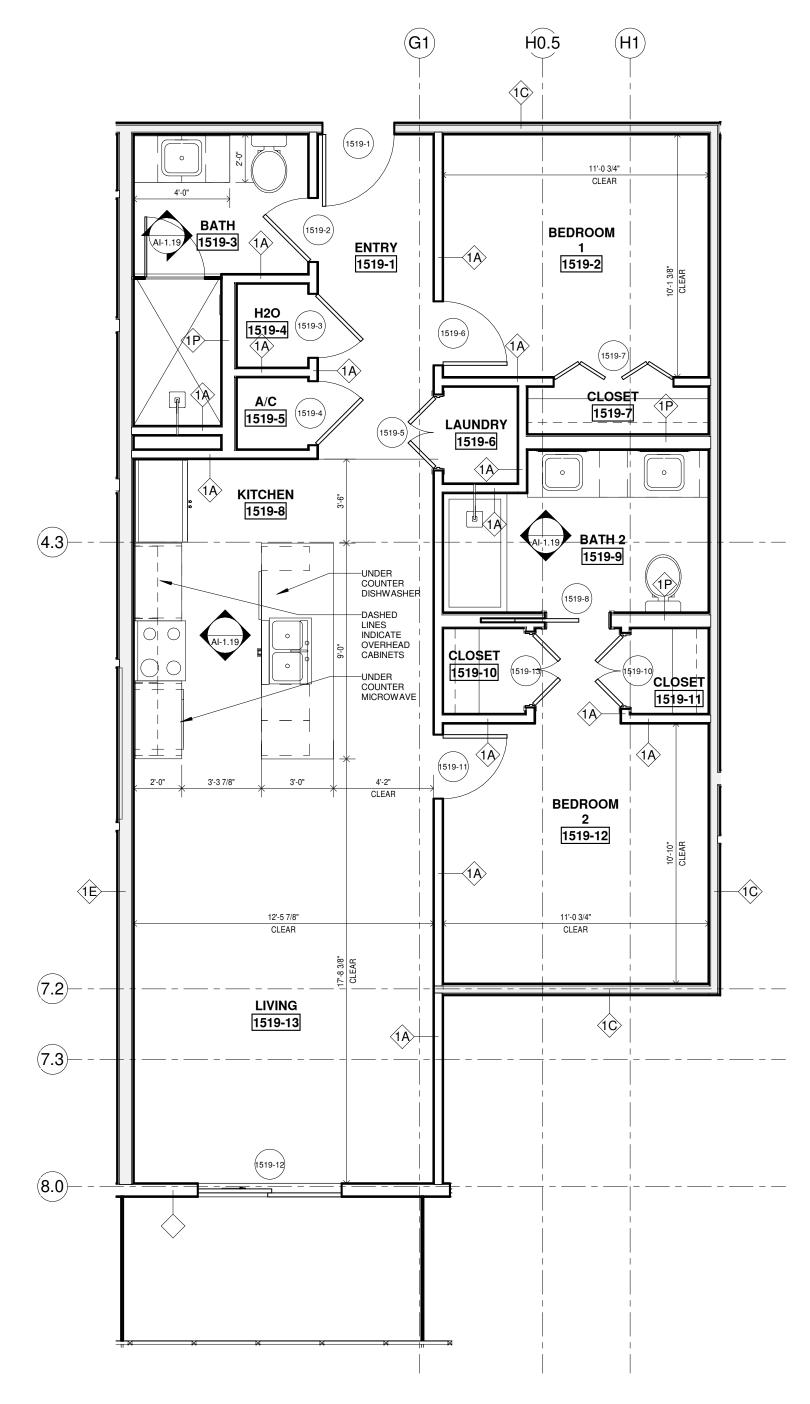


CONDO 1519 ENLARGED PLAN

SCALE: 1/4" = 1'-0"

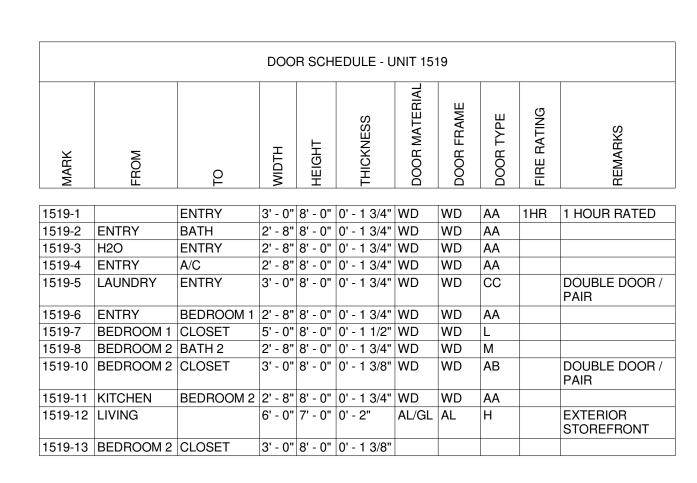


|         |           |              | FINISH      | SCHEDUL | E - UNIT 15 | 519     |         |                |             |
|---------|-----------|--------------|-------------|---------|-------------|---------|---------|----------------|-------------|
| NUMBER  | NAME      | FLOOR FINISH | BASE FINISH | N. WALL | S. WALL     | E. WALL | W. WALL | CEILING FINISH | CEILING HT. |
|         | 1         |              |             |         |             | 1       |         | I              |             |
| 1519-1  | ENTRY     |              |             |         |             |         |         |                |             |
| 1519-2  | BEDROOM 1 |              |             |         |             |         |         |                |             |
| 1519-3  | BATH      |              |             |         |             |         |         |                |             |
| 1519-4  | H2O       |              |             |         |             |         |         |                |             |
| 1519-5  | A/C       |              |             |         |             |         |         |                |             |
| 1519-6  | LAUNDRY   |              |             |         |             |         |         |                |             |
| 1519-7  | CLOSET    |              |             |         |             |         |         |                |             |
| 1519-8  | KITCHEN   |              |             |         |             |         |         |                |             |
| 1519-9  | BATH 2    |              |             |         |             |         |         |                |             |
| 1519-10 | CLOSET    |              |             |         |             |         |         |                |             |
| 1519-11 | CLOSET    |              |             |         |             |         |         |                |             |
| 1519-12 | BEDROOM 2 |              |             |         |             |         |         |                |             |
|         |           |              |             |         |             |         |         |                |             |
| 1519-15 |           |              |             |         |             |         |         |                |             |

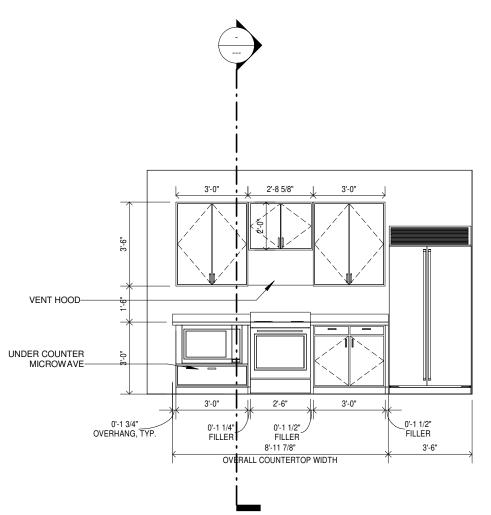


2 KITCHEN UNIT 1519 VIEW A


SCALE: 1/4" = 1'-0"

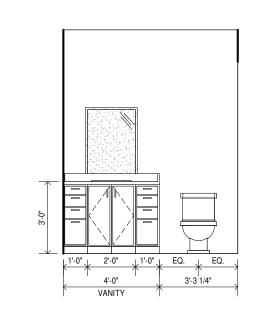


4 BATH 1 UNIT 1519 VIEW A
SCALE: 1/4" = 1'-0"

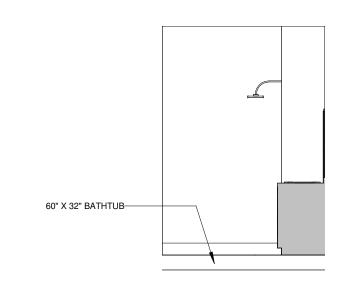


6 BATH 2 UNIT 1519 VIEW A

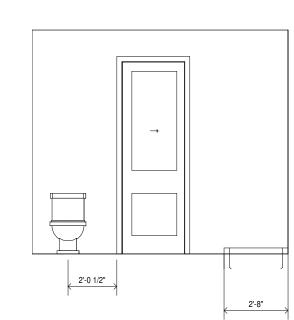

8 BATH 2 UNIT 1519 VIEW C

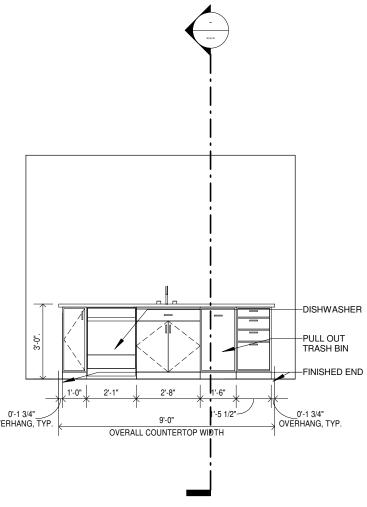


3 KITCHEN UNIT 1519 VIEW B
SCALE: 1/4" = 1'-0"

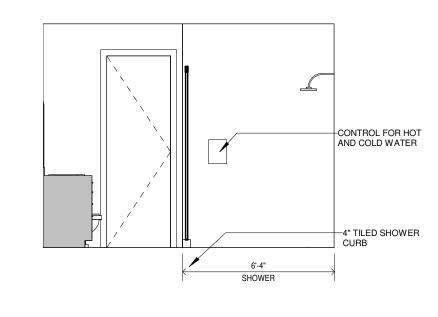


5 BATH 1 UNIT 1519 VIEW B

SCALE: 1/4" = 1'-0"

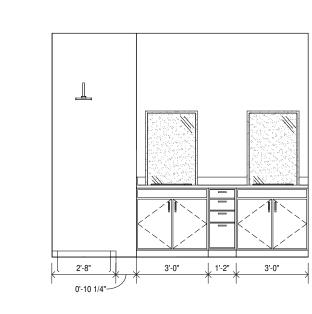

7 BATH 2 UNIT 1519 VIEW B

SCALE: 1/4" = 1'-0"

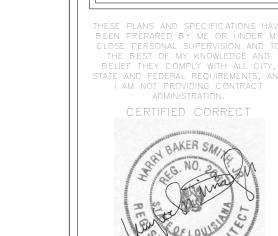

189 Maple Ridge Drive Metairie, LA 70001 (504)-885-4477 central@hbsaii.com :-: hbsaii.com

SINCE 1961

1031 CANAL STREET NEW ORLEANS, LOUISIANA


THIS DRAWING IS CONFIDENTIAL AND NOT BE LOANED, REPRODUCED, COPIED, EITHER WHOLLY OR IN PART, OR MADE PUBLIC IN ANY MANNER WITHOUT THE WRITTEN CONSENT OF HBSA II ARCHITECTS A PROFESSIONAL L.L.C. ALL RIGHTS OF DESIGN OR INVENTION ARE RESERVED AND WILL REMAIN THE SOLE PROPERTY OF HBS II ARCHITECTS A PROFESSIONAL L.L.C.

|           | R                            | EVIS      | NOI  | HIS       | TOR  | Υ  |   |
|-----------|------------------------------|-----------|--|-----------|--|--|---|
| 4/27/2018 | 5/4/2018                     | 5/11/2018 | 5/18/2018                                    | 5/25/2018 | 6/1/2018   | 6/8/2018   |   |
|           |                              |           |  |           |  |  |   |
| L.I.S. #2 | L.I.S. #2                    | L.I.S. #2 | L.I.S. #2                                    | L.I.S. #2 | L.I.S. #2  | L.I.S. #2  |   |
|           | L.I.S. #2 - CLOUD REVISION 1 | 4/27/2018 | 4/27/2018         5/4/2018         5/11/2018 |           | 4/27/2018         5/4/2018         5/11/2018         5/18/2018         5/25/2018 | 4/27/2018         5/4/2018         5/11/2018         5/18/2018         5/25/2018 | 4/27/2018         5/4/2018         5/11/2018         5/18/2018         6/1/2018 |

CONDO 1519


PROJECT#: 1709
PHASE: DD
TEAM: Author
CHECKER: Checker
SCALE: AS NOTED
ISSUED: 4/20/2018

AI-1.19

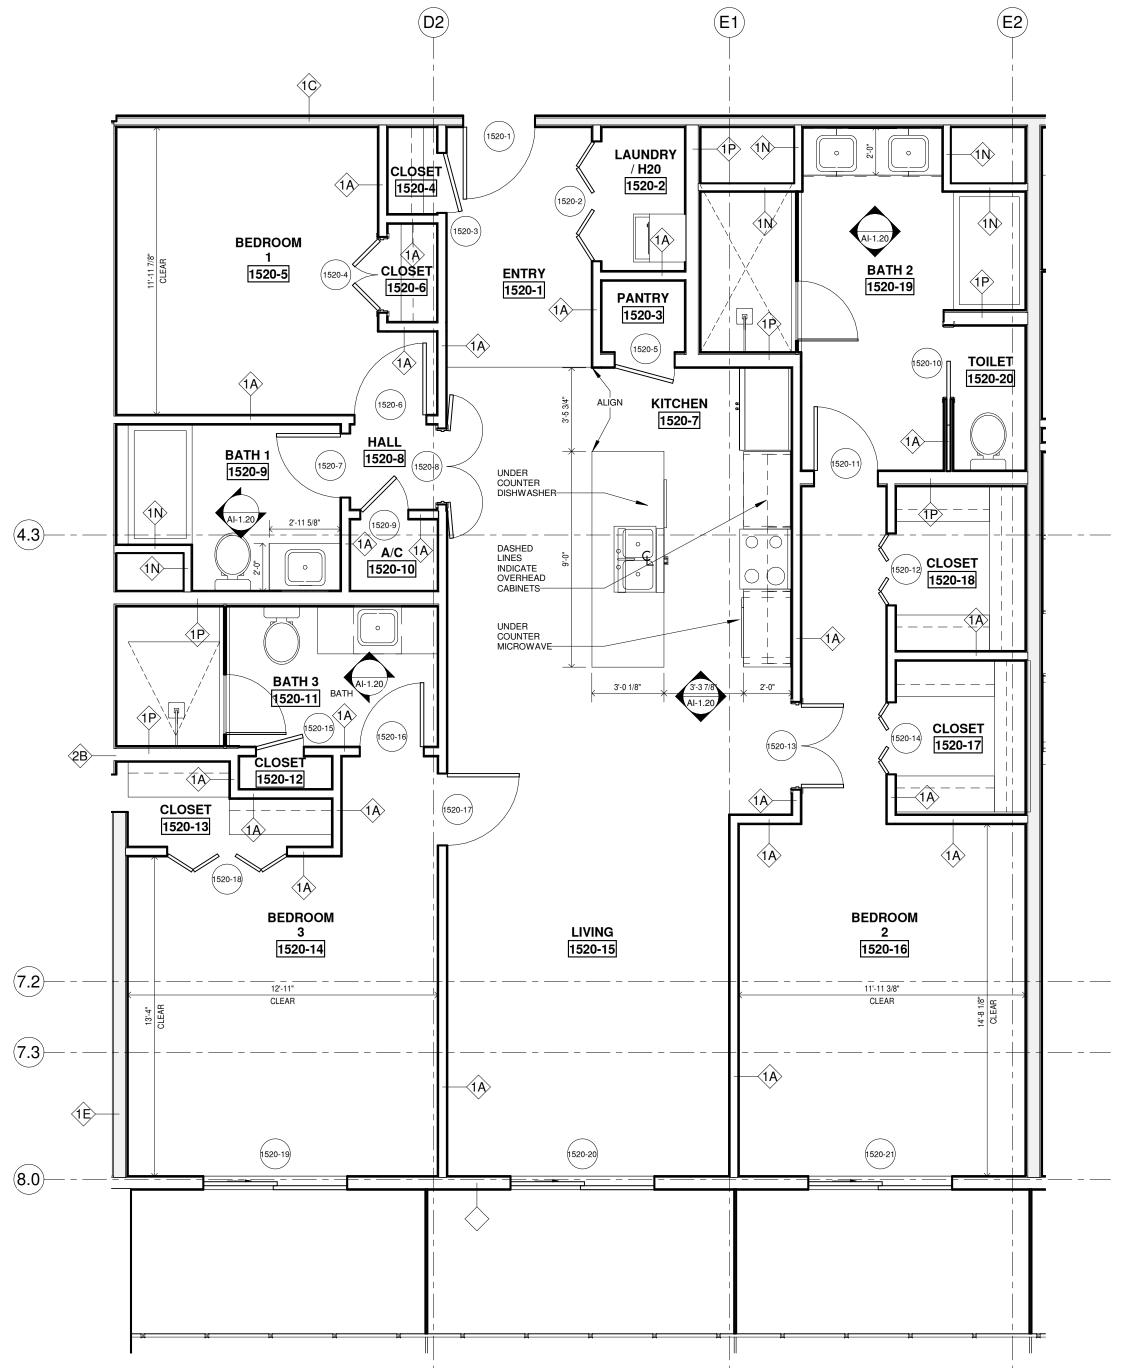





SCALE: 1/4" = 1'-0"

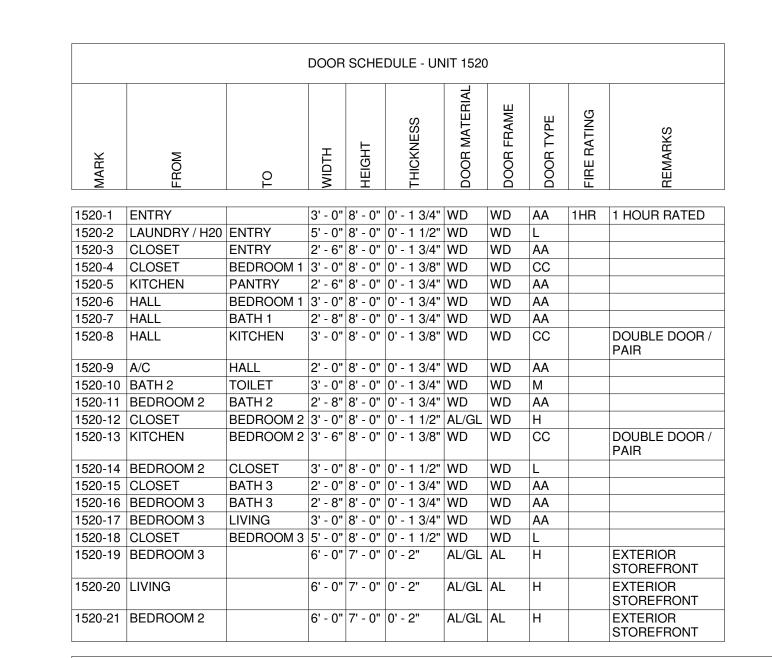


|         |                  |              | FINISH      | SCHEDUL | E - UNIT 15 | 520     |         |                |             |
|---------|------------------|--------------|-------------|---------|-------------|---------|---------|----------------|-------------|
| NUMBER  | NAME             | FLOOR FINISH | BASE FINISH | N. WALL | S. WALL     | E. WALL | W. WALL | CEILING FINISH | CEILING HT. |
| 1520-1  | ENTRY            |              |             |         |             |         |         |                |             |
| 1520-2  | LAUNDRY /<br>H20 |              |             |         |             |         |         |                |             |
| 1520-3  | PANTRY           |              |             |         |             |         |         |                |             |
| 1520-4  | CLOSET           |              |             |         |             |         |         |                |             |
| 1520-5  | BEDROOM 1        |              |             |         |             |         |         |                |             |
| 1520-6  | CLOSET           |              |             |         |             |         |         |                |             |
| 1520-7  | KITCHEN          |              |             |         |             |         |         |                |             |
| 1520-8  | HALL             |              |             |         |             |         |         |                |             |
| 1520-9  | BATH 1           |              |             |         |             |         |         |                |             |
| 1520-10 | A/C              |              |             |         |             |         |         |                |             |
| 1520-11 | BATH 3           |              |             |         |             |         |         |                |             |
|         | CLOSET           |              |             |         |             |         |         |                |             |
| 1520-13 | CLOSET           |              |             |         |             |         |         |                |             |
|         | BEDROOM 3        |              |             |         |             |         |         |                |             |
| 1520-15 |                  |              |             |         |             |         |         |                |             |
|         | BEDROOM 2        |              |             |         |             |         |         |                |             |
|         | CLOSET           |              |             |         |             |         |         |                |             |
|         | CLOSET           |              |             |         |             |         |         |                |             |
|         | BATH 2           |              |             |         |             |         |         |                |             |
| 1520-20 | TOILET           |              |             |         |             |         |         |                |             |

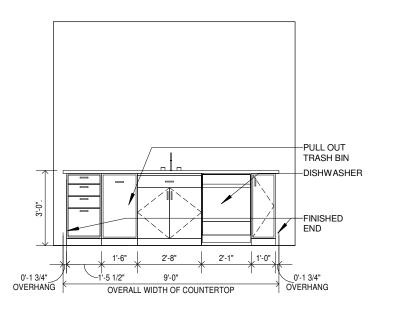


## 2 KITCHEN UNIT 1520 VIEW A

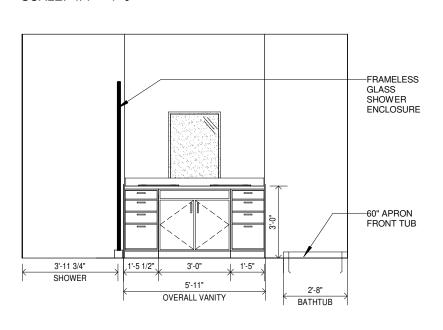


BATH 2 UNIT 1520 VIEW A SCALE: 1/4" = 1'-0"

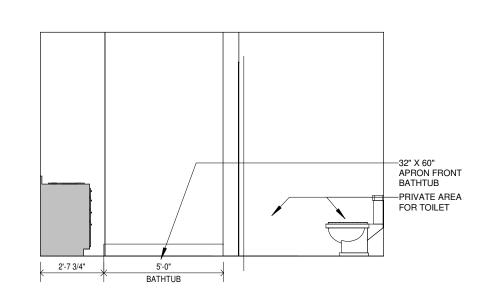


6 BATH 2 UNIT1520 VIEW C

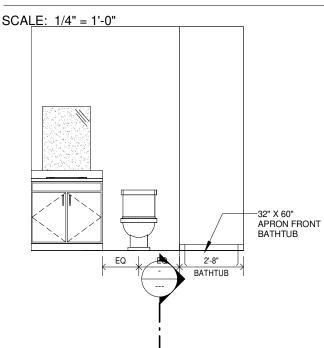


8 BATH 1 UNIT 1520 VIEW B

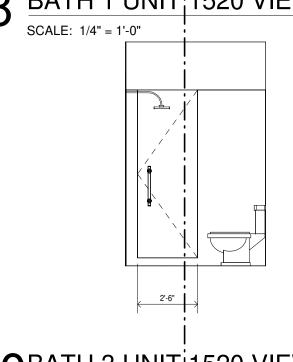


1 0 BATH 3 UNIT 1520 VIEW B
SCALE: 1/4" = 1'-0"

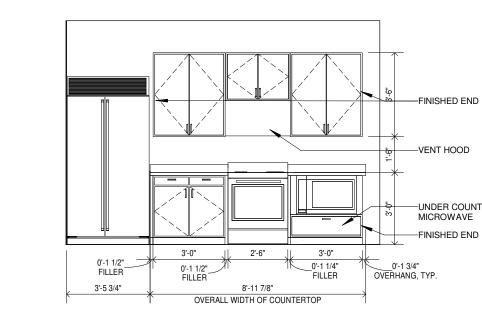


3 KITCHEN UNIT 1520 VIEW B SCALE: 1/4" = 1'-0"

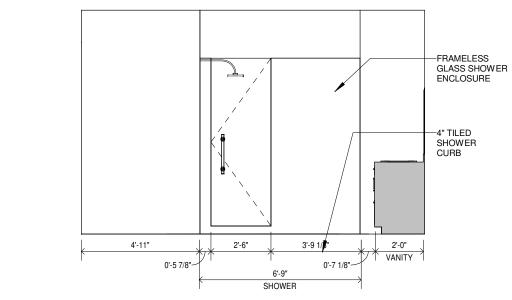

5 BATH 2 UNIT 1520 VIEW B

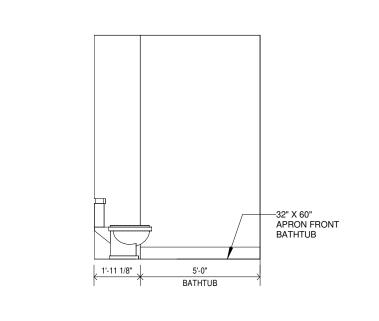

BATH 1 UNIT 1520

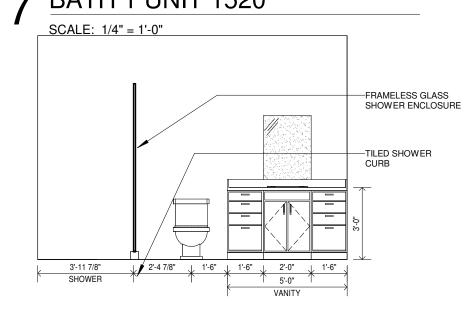


9 BATH 3 UNIT 1520 VIEW A
SCALE: 1/4" = 1'-0"



1031 CANAL STREET NEW ORLEANS, LOUISIANA

STATE AND FEDERAL REQUIREMENTS, A I AM NOT PROVIDING CONTRACT ADMINISTRATION. CERTIFIED CORRECT

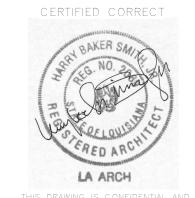


|                              | REVIS  |                              | HIS                          | TOR                          | Υ                            |    |
|------------------------------|--|------------------------------|------------------------------|------------------------------|------------------------------|----|
| 4/27/2018                    | 5/4/2018   | 5/18/2018                    | 5/25/2018                    | 6/1/2018                     | 6/8/2018                     |    |
| L.I.S. #2 - CLOUD HEVISION 1 | L.I.S. #2 - CLOUD REVISION 2<br>L.I.S. #2 - CLOUD REVISION 3 | L.I.S. #2 - CLOUD REVISION 4 | L.I.S. #2 - CLOUD REVISION 5 | L.I.S. #2 - CLOUD REVISION 6 | L.I.S. #2 - CLOUD REVISION 7 |    |
|                              | 3 8  |                              | 5                            | 9                            |                              | 80 |


CONDO 1520

PROJECT#: 1709 PHASE: DD TEAM: Author CHECKER: Checker SCALE: AS NOTED ISSUED: 4/20/2018


AI-1.20

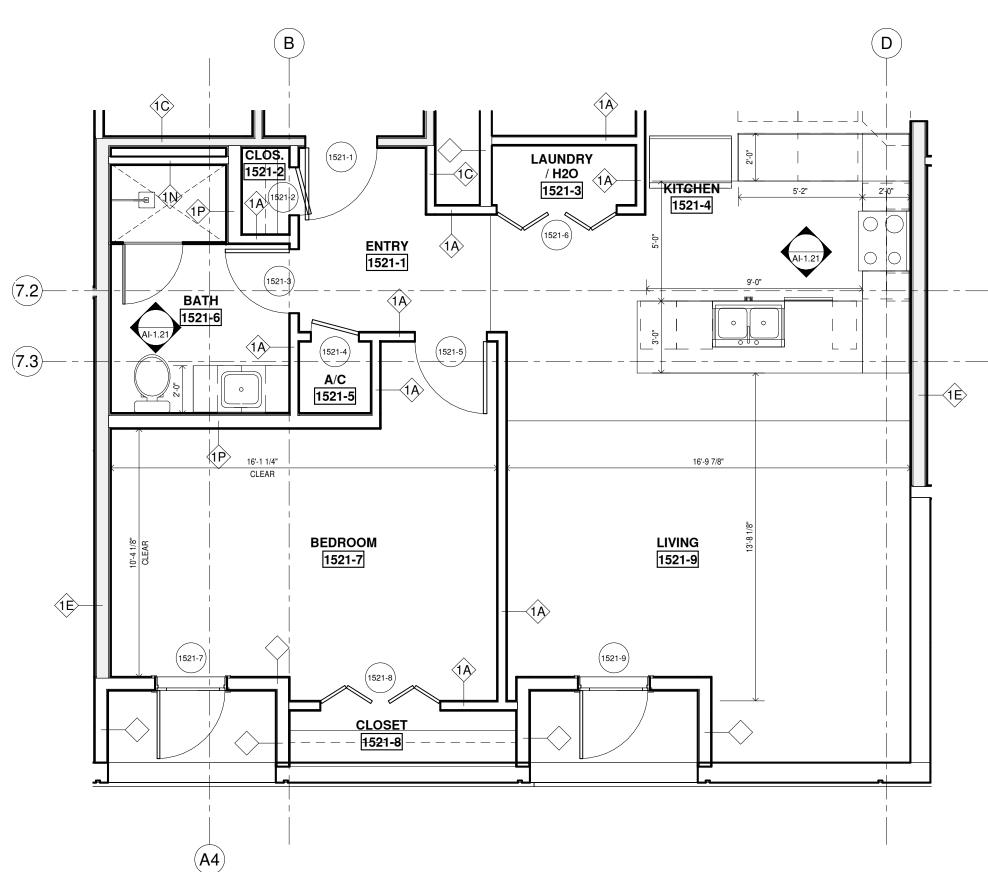




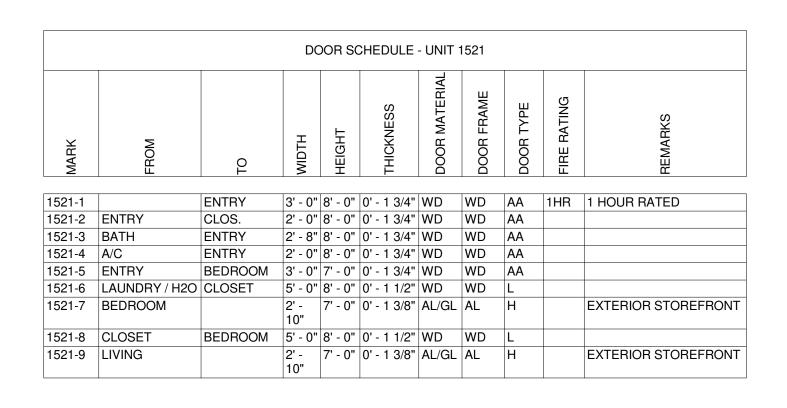


|        |               |              | FINISH S    | CHEDULE | - UNIT 152 <sup>-</sup> | 1       |         |                |             |
|--------|---------------|--------------|-------------|---------|-------------------------|---------|---------|----------------|-------------|
| NUMBER | NAME          | FLOOR FINISH | BASE FINISH | N. WALL | S. WALL                 | E. WALL | W. WALL | CEILING FINISH | CEILING HT. |
|        |               |              |             |         |                         |         |         |                |             |
| 1521   | ENGINEERING   |              |             |         |                         |         |         |                |             |
| 1521-1 | ENTRY         |              |             |         |                         |         |         |                |             |
| 1521-2 | CLOS.         |              |             |         |                         |         |         |                |             |
| 1521-3 | LAUNDRY / H2O |              |             |         |                         |         |         |                |             |
| 1521-4 | KITCHEN       |              |             |         |                         |         |         |                |             |
| 1521-5 | A/C           |              |             |         |                         |         |         |                |             |
| 1521-6 | BATH          |              |             |         |                         |         |         |                |             |
| 1521-7 | BEDROOM       |              |             |         |                         |         |         |                |             |
| 1521-8 | CLOSET        |              |             |         |                         |         |         |                |             |
| 1521-9 | LIVING        |              |             |         |                         |         |         |                |             |

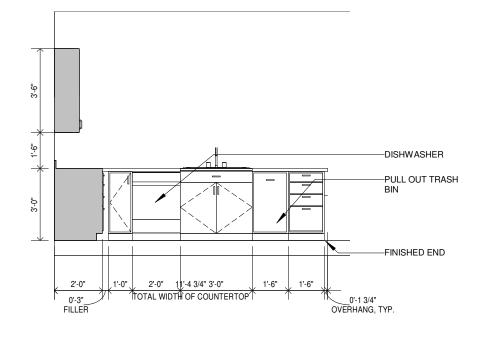


## 2 KITCHEN UNIT 1521 VIEW A SCALE: 1/4" = 1'-0"

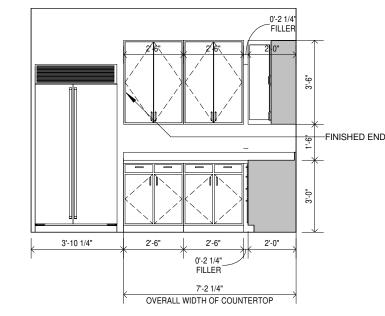


## 4 KITCHEN UNIT 1521 VIEW C

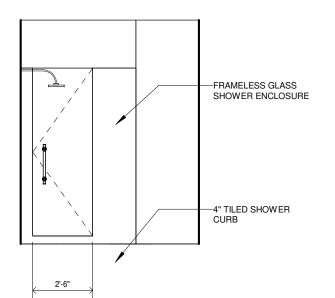


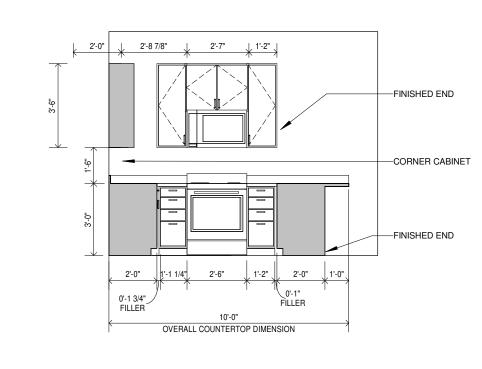


3 KITCHEN UNIT 1521 VIEW B SCALE: 1/4" = 1'-0"

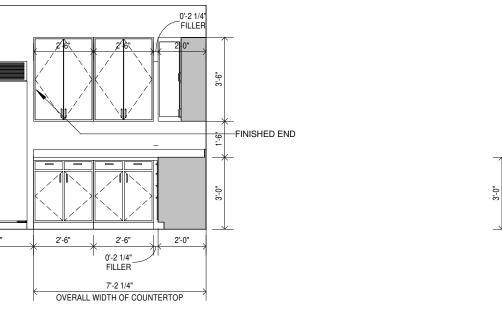


SCALE: 1/4" = 1'-0"

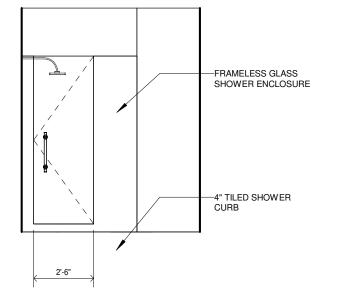

6 BATH 1 UNIT 1521 VIEW B

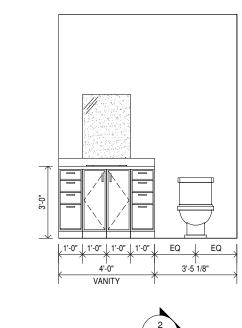

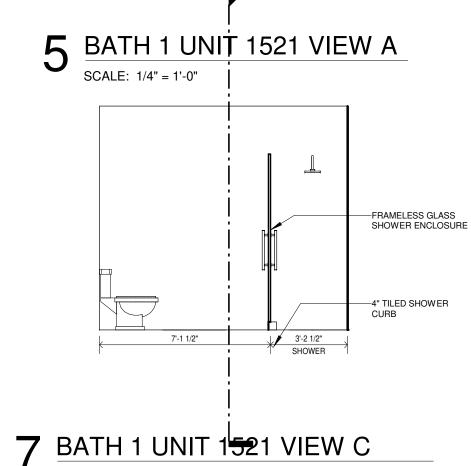

STATE AND FEDERAL REQUIREMENTS, AN I AM NOT PROVIDING CONTRACT ADMINISTRATION.


CERTIFIED CORRECT

P L L C


189 Maple Ridge Drive Metairie, LA 70001 (504)-885-4477 central@hbsaii.com :-: hbsaii.com

SINCE 1961

1031 CANAL STREET NEW ORLEANS, LOUISIANA

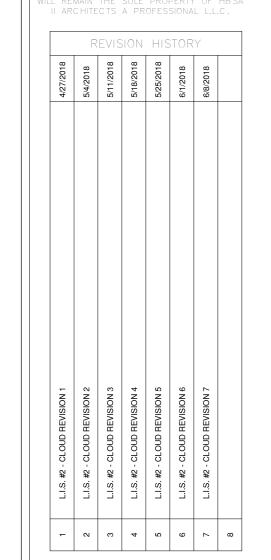

CONDO 1521

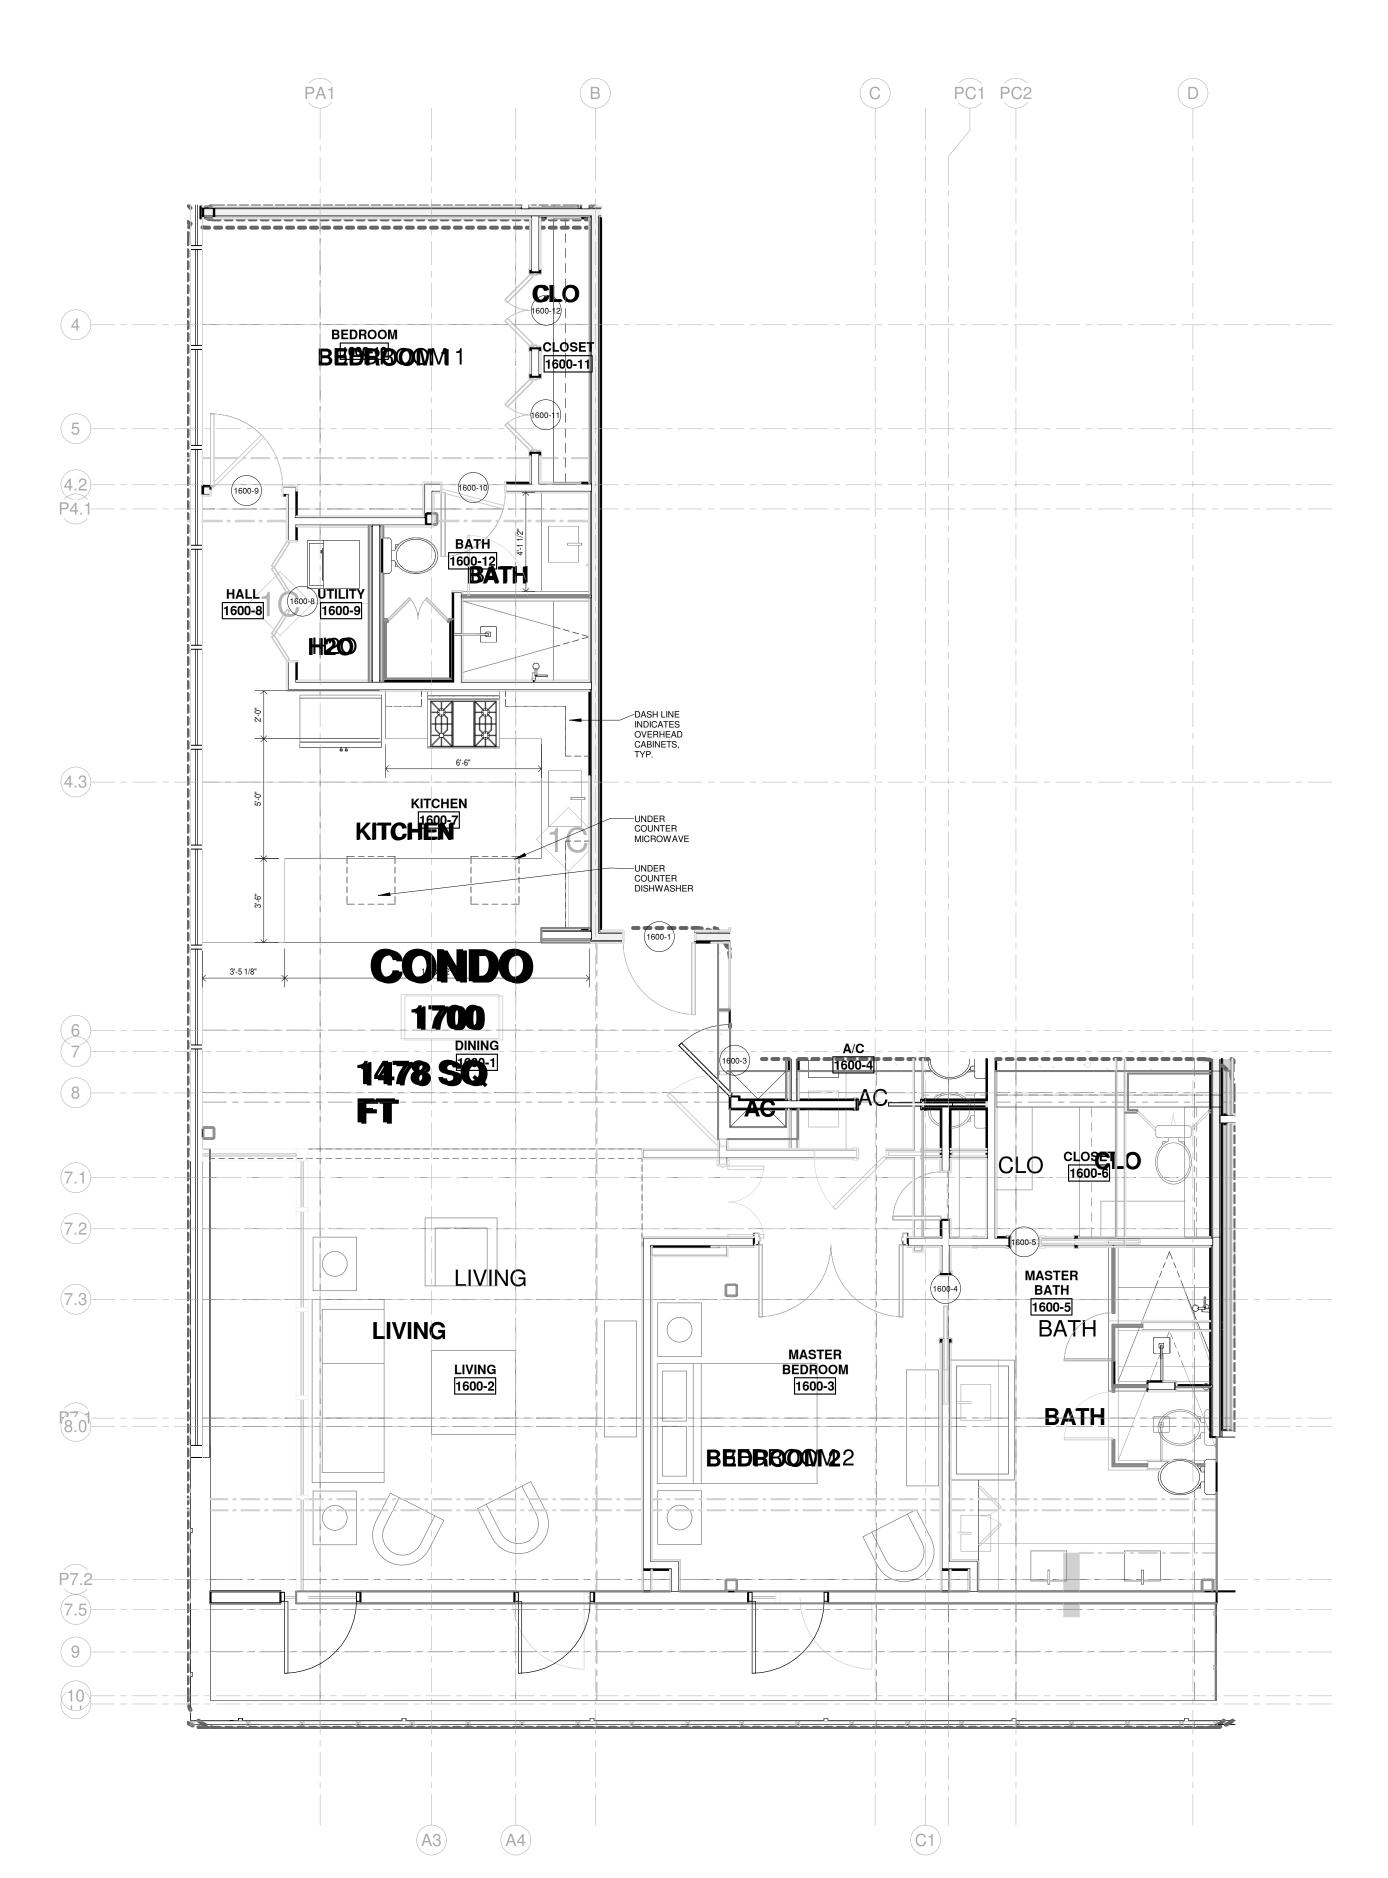

CONDO 1600 ENLARGED PLAN

SCALE: 1/4" = 1'-0"

|         | DOOR SCHEDULE - UNIT 1600 |             |         |         |             |               |            |           |             |                |  |  |  |
|---------|---------------------------|-------------|---------|---------|-------------|---------------|------------|-----------|-------------|----------------|--|--|--|
| MARK    | FROM                      | ТО          | WIDTH   | неіднт  | THICKNESS   | DOOR MATERIAL | DOOR FRAME | DOOR TYPE | FIRE RATING | REMARKS        |  |  |  |
| 1000 1  |                           | DIMINIC     | 0' 0"   | 0' 0"   | 0' 10/4"    | WD            | WD         | Δ Δ       | 41.ID       | 1 LIQUID DATED |  |  |  |
| 1600-1  |                           | DINING      | 3' - 0" |         |             | WD            | WD         | AA<br>AA  | 1HR         | 1 HOUR RATED   |  |  |  |
| 1600-3  | MACTED DEDDOOM            | DINING      | 3' - 0" |         |             | WD            | WD         | AA        |             |                |  |  |  |
| 1600-4  |                           | MASTER BATH | 2' - 8" |         | 0' - 1 3/4" | WD            | WD         | L         |             |                |  |  |  |
| 1600-5  | CLOSET                    | MASTER BATH | 2' - 8" | 8' - 0" | 0' - 1 3/4" | WD            | WD         | L         |             |                |  |  |  |
| 1600-8  | UTILITY                   | HALL        | 5' - 0" | 8' - 0" | 0' - 1 1/2" | WD            | WD         | L         |             |                |  |  |  |
| 1600-9  | HALL                      | BEDROOM     | 3' - 0" | 8' - 0" | 0' - 1 3/4" | WD            | WD         | AA        |             |                |  |  |  |
| 1600-10 | BEDROOM                   | BATH        | 2' - 8" | 6' - 8" | 0' - 2"     | WD            | WD         | AA        |             |                |  |  |  |
| 1600-11 | BEDROOM                   | CLOSET      | 3' - 0" | 8' - 0" | 0' - 1 3/4" | WD            | WD         | CC        |             |                |  |  |  |
| 1600-12 | CLOSET                    | BEDROOM     | 3' - 0" | 8' - 0" | 0' - 1 3/4" | WD            | WD         | СС        |             |                |  |  |  |

|         |                |              | FINISH SC   | HEDULE - U | JNIT 1600 |         |         |                |             |
|---------|----------------|--------------|-------------|------------|-----------|---------|---------|----------------|-------------|
| NUMBER  | NAME           | FLOOR FINISH | BASE FINISH | N. WALL    | S. WALL   | E. WALL | W. WALL | CEILING FINISH | CEILING HT. |
|         | I              |              | I           | T          | T         |         |         |                |             |
| 1600-1  | DINING         |              |             |            |           |         |         |                |             |
| 1600-2  | LIVING         |              |             |            |           |         |         |                |             |
| 1600-3  | MASTER BEDROOM |              |             |            |           |         |         |                |             |
| 1600-4  | A/C            |              |             |            |           |         |         |                |             |
| 1600-5  | MASTER BATH    |              |             |            |           |         |         |                |             |
| 1600-6  | CLOSET         |              |             |            |           |         |         |                |             |
| 1600-7  | KITCHEN        |              |             |            |           |         |         |                |             |
| 1600-8  | HALL           |              |             |            |           |         |         |                |             |
| 1600-9  | UTILITY        |              |             |            |           |         |         |                |             |
| 1600-10 |                |              |             |            |           |         |         |                |             |
| 1600-11 | CLOSET         |              |             |            |           |         |         |                |             |
| 1600-12 | BATH           |              |             |            |           |         |         |                |             |
| 1600-13 | GARAGE         |              |             |            |           |         |         |                |             |

189 Maple Ridge Drive Metairie, LA 70001 (504)-885-4477 central@hbsaii.com :-: hbsaii.com SINCE 1961


1031 CANAL STREET NEW ORLEANS, LOUISIANA

STATE AND FEDERAL REQUIREMENTS, AND I AM NOT PROVIDING CONTRACT ADMINISTRATION. CERTIFIED CORRECT



|                              | R                            | EVIS                         | ION                          | HIS                          | TOR                          | Υ                            |  |
|------------------------------|------------------------------|------------------------------|------------------------------|------------------------------|------------------------------|------------------------------|--|
| 4/27/2018                    | 5/4/2018                     | 5/11/2018                    | 5/18/2018                    | 5/25/2018                    | 6/1/2018                     | 6/8/2018                     |  |
|                              |                              |                              |                              |                              |                              |                              |  |
| L.I.S. #2 - CLOUD REVISION 1 | L.I.S. #2 - CLOUD REVISION 2 | L.I.S. #2 - CLOUD REVISION 3 | L.I.S. #2 - CLOUD REVISION 4 | L.I.S. #2 - CLOUD REVISION 5 | L.I.S. #2 - CLOUD REVISION 6 | L.I.S. #2 - CLOUD REVISION 7 |  |


CONDO 1600

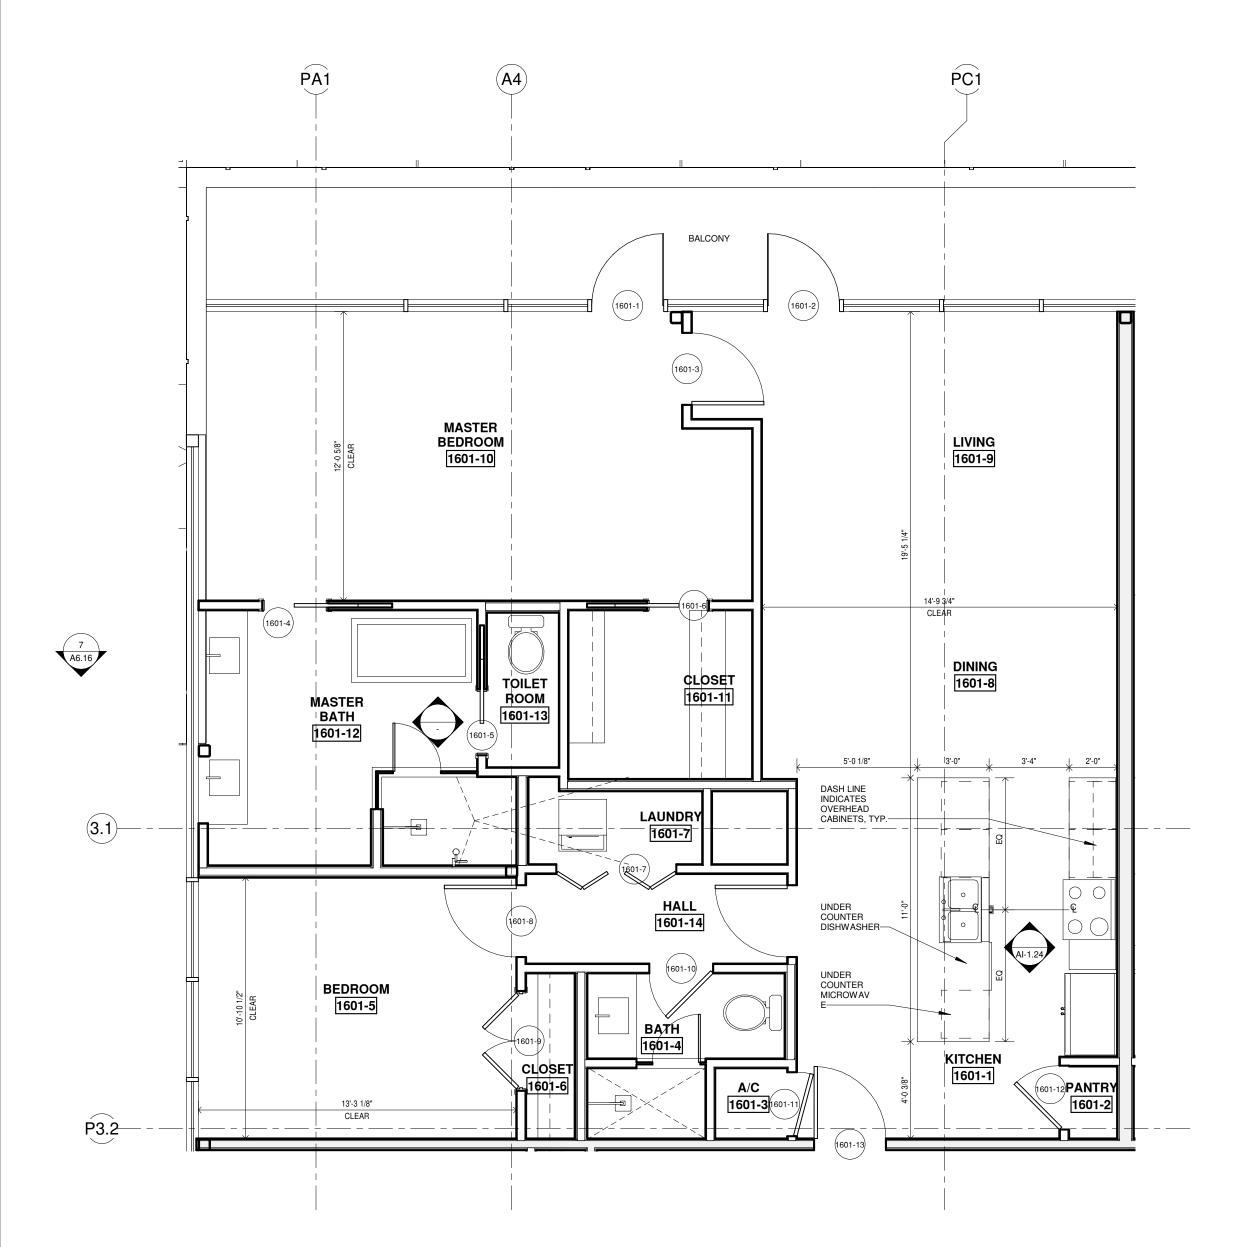

CONDO 1601 ENLARGED PLAN

|         |                | I              | DOOR    | SCHEDU  | JLE - UNIT 16 | 601           |            |           |             |                     |
|---------|----------------|----------------|---------|---------|---------------|---------------|------------|-----------|-------------|---------------------|
| MARK    | FROM           | 0              | WIDTH   | HEIGHT  | THICKNESS     | DOOR MATERIAL | DOOR FRAME | DOOR TYPE | FIRE RATING | REMARKS             |
|         |                |                |         |         |               | 1             |            | 1.,       |             |                     |
| 1601-1  | MASTER BEDROOM |                | 3' - 0" | 8' - 2" | 0' - 1 1/2"   | AL/GL         |            | K         |             | EXTERIOR STOREFRONT |
| 1601-2  | LIVING         |                | 3' - 0" | 8' - 2" | 0' - 1 1/2"   | AL/GL         | AL         | K         |             | EXTERIOR STOREFRONT |
| 1601-3  | MASTER BEDROOM | LIVING         | 3' - 0" | 8' - 0" | 0' - 1 3/4"   | WD            | WD         | AA        |             |                     |
| 1601-4  | MASTER BATH    | MASTER BEDROOM | 2' - 8" | 8' - 0" | 0' - 1 3/4"   | WD            | WD         | L         |             |                     |
| 1601-5  | TOILET ROOM    | MASTER BATH    | 2' - 8" | 8' - 0" | 0' - 1 3/4"   | WD            | WD         | L         |             |                     |
| 1601-6  | MASTER BEDROOM | CLOSET         | 2' - 6" | 8' - 0" | 0' - 1 3/4"   | WD            | WD         | L         |             |                     |
| 1601-7  | LAUNDRY        | HALL           | 5' - 0" | 8' - 0" | 0' - 1 1/2"   | WD            | WD         | L         |             |                     |
| 1601-8  | HALL           | BEDROOM        | 3' - 0" | 8' - 0" | 0' - 1 3/4"   | WD            | WD         | AA        |             |                     |
| 1601-9  | CLOSET         | BEDROOM        | 4' - 0" | 8' - 0" | 0' - 1 3/4"   | WD            | WD         | CC        |             | DOUBLE DOOR / PAIR  |
| 1601-10 | BATH           | HALL           | 2' - 8" | 8' - 0" | 0' - 1 3/4"   | WD            | WD         | AA        |             |                     |
| 1601-11 | A/C            | KITCHEN        | 2' - 8" | 8' - 0" | 0' - 1 3/4"   | WD            | WD         | AA        |             |                     |
| 1601-12 | PANTRY         | KITCHEN        | 2' - 8" | 8' - 0" | 0' - 1 3/4"   | WD            | WD         | AA        |             |                     |
| 1601-13 |                | KITCHEN        | 3' - 0" | 8' - 0" | 0' - 1 3/4"   | WD            | WD         | AA        | 1HR         | 1 HOUR RATED        |

|         |                |              | FINISH SCI  | HEDULE - U | JNIT 1601 |         |         |                |             |
|---------|----------------|--------------|-------------|------------|-----------|---------|---------|----------------|-------------|
| NUMBER  | NAME           | FLOOR FINISH | BASE FINISH | N. WALL    | S. WALL   | E. WALL | W. WALL | CEILING FINISH | CEILING HT. |
| 1001.1  | KITOLIEN       |              |             |            |           |         |         | T              |             |
| 1601-1  | KITCHEN        |              |             |            |           |         |         |                |             |
| 1601-2  | PANTRY         |              |             |            |           |         |         |                |             |
| 1601-3  | A/C            |              |             |            |           |         |         |                |             |
| 1601-4  | BATH           |              |             |            |           |         |         |                |             |
| 1601-5  | BEDROOM        |              |             |            |           |         |         |                |             |
| 1601-6  | CLOSET         |              |             |            |           |         |         |                |             |
| 1601-7  | LAUNDRY        |              |             |            |           |         |         |                |             |
| 1601-8  | DINING         |              |             |            |           |         |         |                |             |
| 1601-9  | LIVING         |              |             |            |           |         |         |                |             |
| 1601-10 | MASTER BEDROOM |              |             |            |           |         |         |                |             |
| 1601-11 | CLOSET         |              |             |            |           |         |         |                |             |
| 1601-12 | MASTER BATH    |              |             |            |           |         |         |                |             |
| 1601-13 | TOILET ROOM    |              |             |            |           |         |         |                |             |
| 1601-14 | HALL           |              |             |            |           |         |         |                |             |
|         |                |              |             |            |           |         |         |                |             |

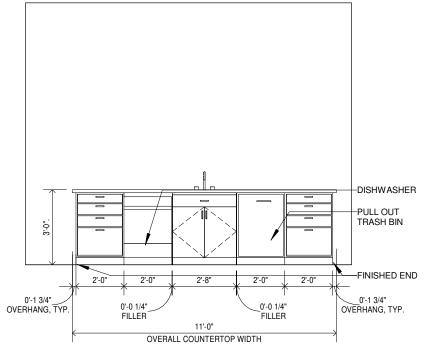



2 KITCHEN UNIT 1601 VIEW A SCALE: 1/4" = 1'-0"

3 KITCHEN UNIT 1601 VIEW B
SCALE: 1/4" = 1'-0"

189 Maple Ridge Drive Metairie, LA 70001 (504)-885-4477 central@hbsaii.com :-: hbsaii.com SINCE 1961


1031 CANAL STREET NEW ORLEANS, LOUISIANA

THESE PLANS AND SPECIFICATIONS HAVE BEEN PREPARED BY ME OR UNDER MY CLOSE PERSONAL SUPERVISION AND TO THE BEST OF MY KNOWLEDGE AND BELIEF THEY COMPLY WITH ALL CITY, STATE AND FEDERAL REQUIREMENTS, AND I AM NOT PROVIDING CONTRACT ADMINISTRATION. CERTIFIED CORRECT



| L.I.S. #2 - CLOUD REVISION 1 | 4/27/2018 |      |
|------------------------------|-----------|------|
| L.I.S. #2 - CLOUD REVISION 2 | 5/4/2018  | R    |
| L.I.S. #2 - CLOUD REVISION 3 | 5/11/2018 | EVIS |
| L.I.S. #2 - CLOUD REVISION 4 | 5/18/2018 | SION |
| L.I.S. #2 - CLOUD REVISION 5 | 5/25/2018 | HIS  |
| L.I.S. #2 - CLOUD REVISION 6 | 6/1/2018  | TOR  |
| L.I.S. #2 - CLOUD REVISION 7 | 6/8/2018  | Υ    |
|                              |           |      |

CONDO 1601

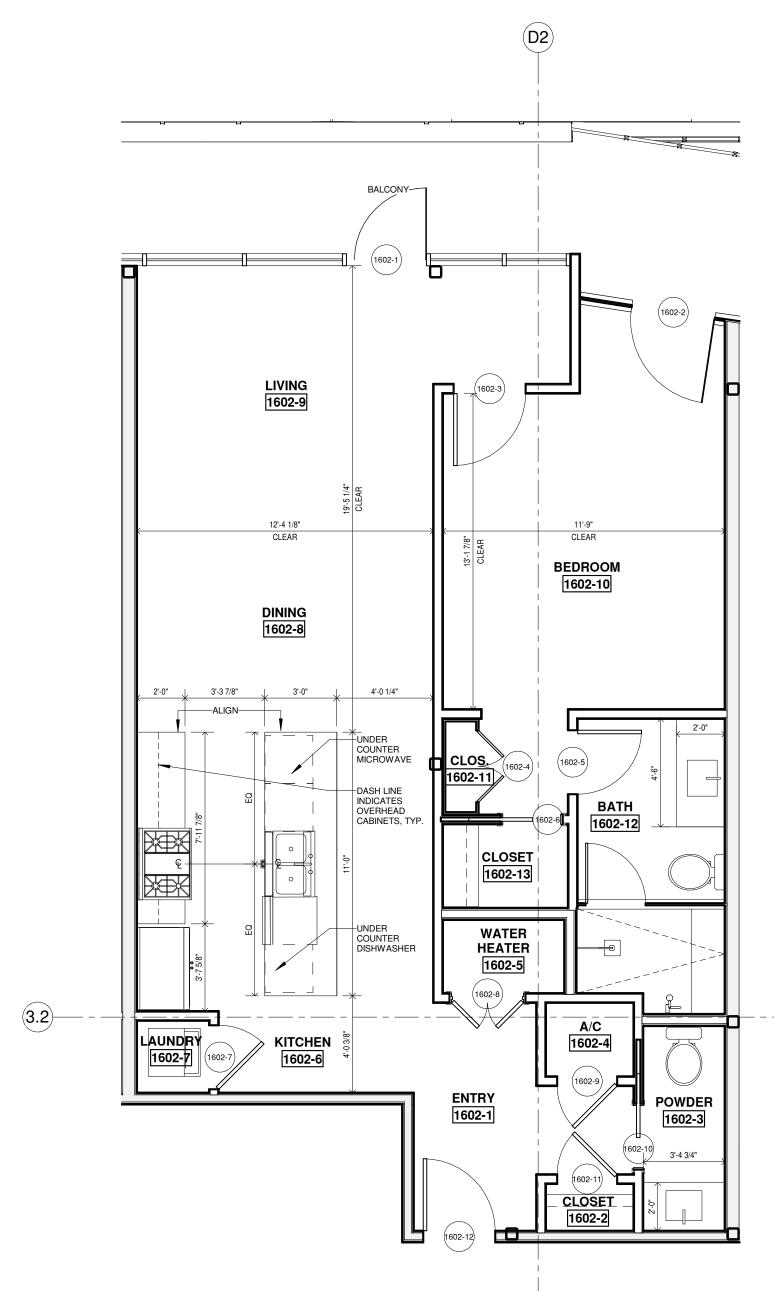

| 1 | CONDO 1602 ENLARGED PLAN |
|---|--------------------------|
|   | SCALE: 1/4" = 1'-0"      |

|         |              |         |         | DO       | OOR SCHEDU    | JLE - UNIT    | 1602       |           |             |                     |
|---------|--------------|---------|---------|----------|---------------|---------------|------------|-----------|-------------|---------------------|
| MARK    | FROM         | 70      | WIDTH   | HEIGHT   | THICKNESS     | DOOR MATERIAL | DOOR FRAME | DOOR TYPE | FIRE RATING | REMARKS             |
|         | 1            |         |         |          | 1             |               |            | 1         |             | T                   |
| 1602-1  | LIVING       |         |         | 8' - 2"  | 0' - 1 1/2"   | AL/GL         | AL         | K         |             | EXTERIOR STOREFRONT |
| 1602-2  |              | BEDROOM | 3' - 6" | 7' - 10" | 0' - 0 15/32" | WD            | WD         | AA        |             |                     |
| 1602-3  | LIVING       | BEDROOM | 3' - 0" | 8' - 0"  | 0' - 1 3/4"   | WD            | WD         | AA        |             |                     |
| 1602-4  |              | BEDROOM | 3' - 0" | 7' - 0"  | 0' - 2"       | WD            | WD         | CC        |             |                     |
| 1602-5  | BEDROOM      | BATH    | 2' - 8" | 8' - 0"  | 0' - 1 3/4"   | WD            | WD         | AA        |             |                     |
| 1602-6  | BEDROOM      | CLOSET  | 2' - 6" | 8' - 0"  | 0' - 1 3/4"   | WD            | WD         | М         |             |                     |
| 1602-7  | KITCHEN      | LAUNDRY | 2' - 8" | 8' - 0"  | 0' - 1 3/4"   | WD            | WD         | AA        |             |                     |
| 1602-8  | WATER HEATER | ENTRY   | 3' - 0" | 8' - 0"  | 0' - 1 3/4"   | WD            | WD         | CC        |             |                     |
| 1602-9  | A/C          | ENTRY   | 2' - 6" | 8' - 0"  | 0' - 1 3/4"   | WD            | WD         | CC        |             |                     |
| 1602-10 | ENTRY        | POWDER  | 2' - 8" | 8' - 0"  | 0' - 1 3/4"   | WD            | WD         | L         |             |                     |
| 1602-11 | ENTRY        | CLOSET  | 2' - 6" | 8' - 0"  | 0' - 1 3/4"   | WD            | WD         | CC        |             |                     |
| 1602-12 |              | ENTRY   | 3' - 0" | 8' - 0"  | 0' - 1 3/4"   | WD            | WD         | AA        | 1HR         | 1 HOUR RATED        |

|         |              |              | FINISH S    | CHEDULE | - UNIT 160 | 2       |         |                |             |
|---------|--------------|--------------|-------------|---------|------------|---------|---------|----------------|-------------|
| NUMBER  | NAME         | FLOOR FINISH | BASE FINISH | N. WALL | S. WALL    | E. WALL | W. WALL | CEILING FINISH | CEILING HT. |
| 1000 1  | ENTDY        |              |             | T       |            | T       |         | I              |             |
| 1602-1  | ENTRY        |              |             |         |            |         |         |                |             |
| 1602-2  | CLOSET       |              |             |         |            |         |         |                |             |
| 1602-3  | POWDER       |              |             |         |            |         |         |                |             |
| 1602-4  | A/C          |              |             |         |            |         |         |                |             |
| 1602-5  | WATER HEATER |              |             |         |            |         |         |                |             |
| 1602-6  | KITCHEN      |              |             |         |            |         |         |                |             |
| 1602-7  | LAUNDRY      |              |             |         |            |         |         |                |             |
| 1602-8  | DINING       |              |             |         |            |         |         |                |             |
| 1602-9  | LIVING       |              |             |         |            |         |         |                |             |
| 1602-10 | BEDROOM      |              |             |         |            |         |         |                |             |
| 1602-11 | CLOS.        |              |             |         |            |         |         |                |             |
| 1602-12 | BATH         |              |             |         |            |         |         |                |             |
| 1602-13 | CLOSET       |              |             |         |            |         |         |                |             |

HARRY
BAKER
SMITH
SMITH
ARCHITECTS II
P 1 1 C

189 Maple Ridge Drive Metairie, LA 70001
(504)-885-4477
central@hbsail.com :: hbsail.com
SINCE 1961

HARD ROCK HOTE 1031 CANAL STREET NEW ORLEANS, LOUISIANA

THESE PLANS AND SPECIFICATIONS HAVE BEEN PREPARED BY ME OR UNDER MY CLOSE PERSONAL SUPERVISION AND TO THE BEST OF MY KNOWLEDGE AND BELIEF THEY COMPLY WITH ALL CITY, STATE AND FEDERAL REQUIREMENTS, AND I AM NOT PROVIDING CONTRACT ADMINISTRATION.

CERTIFIED CORRECT



THIS DRAWING IS CONFIDENTIAL AND NOT BE LOANED, REPRODUCED, COPIED, EITHER WHOLLY OR IN PART, OR MADE PUBLIC IN ANY MANNER WITHOUT THE WRITTEN CONSENT OF HBSA II ARCHITECTS A PROFESSIONAL L.L.C. ALL RIGHTS OF DESIGN OR INVENTION ARE RESERVED AND WILL REMAIN THE SOLE PROPERTY OF HBSA


| _                           |
|-----------------------------|
| 4/27/2018                   |
| LI.S. #2 - CLOUD REVISION 1 |

CONDO 1602

PROJECT#: 1709
PHASE: DD
TEAM: Author
CHECKER: Checker
SCALE: AS NOTED

ISSUED: 4/20/2018
SHEET#:

AI-1.25

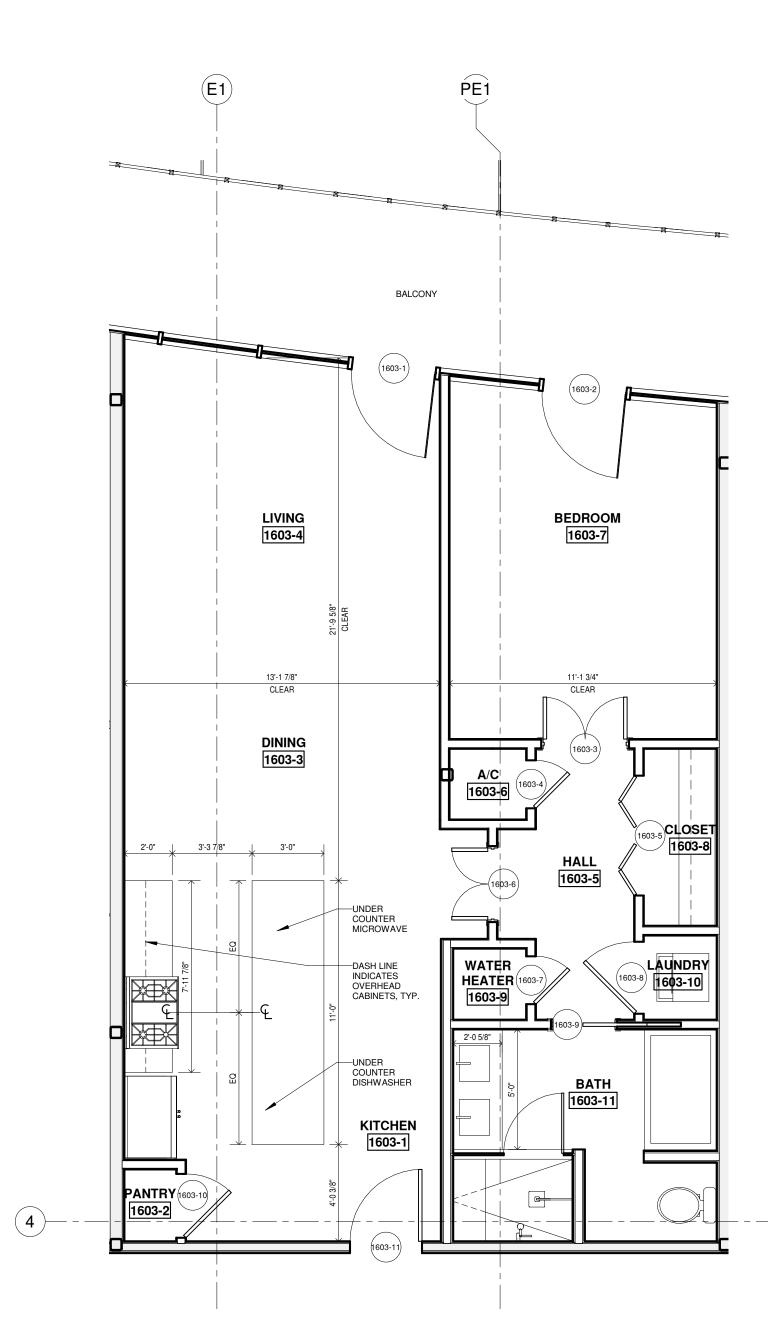

|         |              |         |         | DC       | OOR SCHED     | JLE - UNIT    | 1602       |           |             |                     |
|---------|--------------|---------|---------|----------|---------------|---------------|------------|-----------|-------------|---------------------|
| MARK    | FROM         | TO      | WIDTH   | HEIGHT   | THICKNESS     | DOOR MATERIAL | DOOR FRAME | DOOR TYPE | FIRE RATING | REMARKS             |
| 1602-1  | LIVING       |         | 3' - 4" | 8' - 2"  | 0' - 1 1/2"   | AL/GL         | AL         | K         |             | EXTERIOR STOREFRONT |
|         | LIVING       | DEDDOOM |         |          | - '           |               |            |           |             | EXTERIOR STOREFRONT |
| 1602-2  |              | BEDROOM | 3' - 6" | 7' - 10" | 0' - 0 15/32" | WD            | WD         | AA        |             |                     |
| 1602-3  | LIVING       | BEDROOM | 3' - 0" | 8' - 0"  | 0' - 1 3/4"   | WD            | WD         | AA        |             |                     |
| 1602-4  |              | BEDROOM | 3' - 0" | 7' - 0"  | 0' - 2"       | WD            | WD         | CC        |             |                     |
| 1602-5  | BEDROOM      | BATH    | 2' - 8" | 8' - 0"  | 0' - 1 3/4"   | WD            | WD         | AA        |             |                     |
| 1602-6  | BEDROOM      | CLOSET  | 2' - 6" | 8' - 0"  | 0' - 1 3/4"   | WD            | WD         | М         |             |                     |
| 1602-7  | KITCHEN      | LAUNDRY | 2' - 8" | 8' - 0"  | 0' - 1 3/4"   | WD            | WD         | AA        |             |                     |
| 1602-8  | WATER HEATER | ENTRY   | 3' - 0" | 8' - 0"  | 0' - 1 3/4"   | WD            | WD         | CC        |             |                     |
| 1602-9  | A/C          | ENTRY   | 2' - 6" | 8' - 0"  | 0' - 1 3/4"   | WD            | WD         | CC        |             |                     |
| 1602-10 | ENTRY        | POWDER  | 2' - 8" | 8' - 0"  | 0' - 1 3/4"   | WD            | WD         | L         |             |                     |
| 1602-11 | ENTRY        | CLOSET  | 2' - 6" | 8' - 0"  | 0' - 1 3/4"   | WD            | WD         | CC        |             |                     |
| 1602-12 |              | ENTRY   | 3' - 0" | 8' - 0"  | 0' - 1 3/4"   | WD            | WD         | AA        | 1HR         | 1 HOUR RATED        |

|         |              |              | FINISH S    | CHEDULE | - UNIT 1602 | 2       |         |                |             |
|---------|--------------|--------------|-------------|---------|-------------|---------|---------|----------------|-------------|
|         |              |              |             |         |             |         |         |                |             |
| NUMBER  | NAME         | FLOOR FINISH | BASE FINISH | N. WALL | S. WALL     | E. WALL | W. WALL | CEILING FINISH | CEILING HT. |
|         |              |              |             |         |             |         |         |                |             |
| 1602-1  | ENTRY        |              |             |         |             |         |         |                |             |
| 1602-2  | CLOSET       |              |             |         |             |         |         |                |             |
| 1602-3  | POWDER       |              |             |         |             |         |         |                |             |
| 1602-4  | A/C          |              |             |         |             |         |         |                |             |
| 1602-5  | WATER HEATER |              |             |         |             |         |         |                |             |
| 1602-6  | KITCHEN      |              |             |         |             |         |         |                |             |
| 1602-7  | LAUNDRY      |              |             |         |             |         |         |                |             |
| 1602-8  | DINING       |              |             |         |             |         |         |                |             |
| 1602-9  | LIVING       |              |             |         |             |         |         |                |             |
| 1602-10 | BEDROOM      |              |             |         |             |         |         |                |             |
| 1602-11 | CLOS.        |              |             |         |             |         |         |                |             |
| 1602-12 | BATH         |              |             |         |             |         |         |                |             |
| 1602-13 | CLOSET       |              |             |         |             |         |         |                |             |

CONDO 1603 ENLARGED PLAN

SCALE: 1/4" = 1'-0"

HARD ROCK HOTH

1031 CANAL STREET

NEW ORLEANS, LOUISIANA

189 Maple Ridge Drive Metairie, LA 70001 (504)-885-4477 central@hbsaii.com :-: hbsaii.com

SINCE 1961


THESE PLANS AND SPECIFICATIONS HAVE BEEN PREPARED BY ME OR UNDER MY CLOSE PERSONAL SUPERVISION AND TO THE BEST OF MY KNOWLEDGE AND BELIEF THEY COMPLY WITH ALL CITY, STATE AND FEDERAL REQUIREMENTS, AND I AM NOT PROVIDING CONTRACT ADMINISTRATION.

CERTIFIED CORRECT

THIS DRAWING IS CONFIDENTIAL AND
NOT BE LOANED, REPRODUCED, COPIED,
EITHER WHOLLY OR IN PART, OR MADE
PUBLIC IN ANY MANNER WITHOUT THE
WRITTEN CONSENT OF HBSA II ARCHITECTS
A PROFESSIONAL L.L.C. ALL RIGHTS OF
DESIGN OR INVENTION ARE RESERVED AND

| 81                    |                       | EVIS                  |                       | HIS                   |                       |                       |   |
|-----------------------|-----------------------|-----------------------|-----------------------|-----------------------|-----------------------|-----------------------|---|
| 4/27/2018             | 5/4/2018              | 5/11/2018             | 5/18/2018             | 5/25/2018             | 6/1/2018              | 6/8/2018              | - |
|                       |                       |                       |                       |                       |                       |                       |   |
| #2 - CLOUD REVISION 1 | #2 - CLOUD REVISION 2 | #2 - CLOUD REVISION 3 | #2 - CLOUD REVISION 4 | #2 - CLOUD REVISION 5 | #2 - CLOUD REVISION 6 | #2 - CLOUD REVISION 7 |   |

CONDO 1603

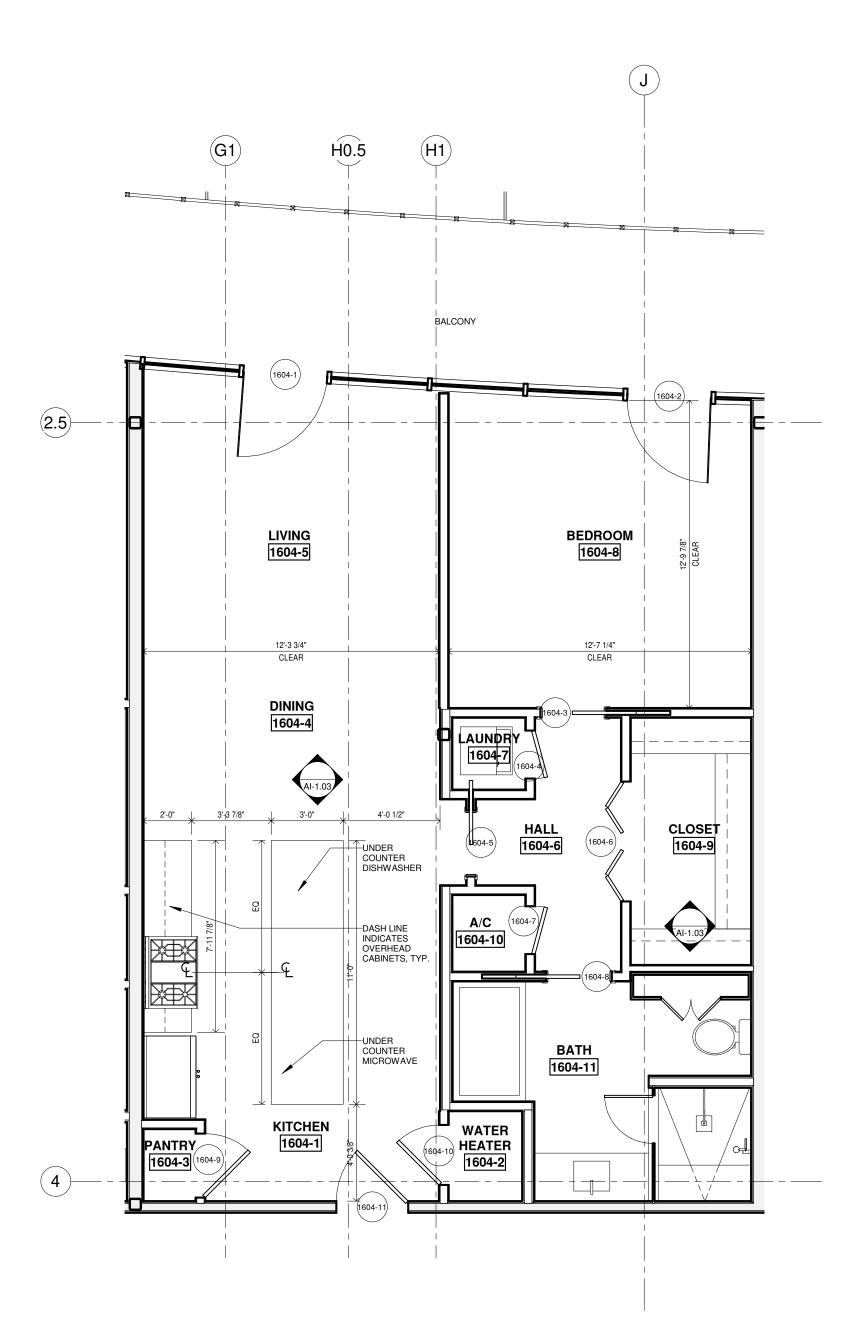

|         |                 |         |         | D        | OOR SCHED     | ULE - L       | INIT 16    | 04        |             |                     |
|---------|-----------------|---------|---------|----------|---------------|---------------|------------|-----------|-------------|---------------------|
| MARK    | FROM            | 01      | WIDTH   | НЕІGНТ   | THICKNESS     | DOOR MATERIAL | DOOR FRAME | DOOR TYPE | FIRE RATING | REMARKS             |
| 1604    |                 |         | 6' - 0" | 7' - 0"  | 0' - 1 3/4"   | НМ            | НМ         | D         |             | T                   |
| 1604-1  |                 | LIVING  |         | 7' - 10" | 0' - 0 15/32" | AL/GL         | AL         | K         |             | EXTERIOR STOREFRONT |
| 1604-2  |                 | BEDROOM | 3' - 6" | 7' - 10" | 0' - 0 15/32" | AL/GL         | AL         | K         |             | EXTERIOR STOREFRONT |
| 1604-3  | HALL            | BEDROOM |         | 8' - 0"  | 0' - 1 3/4"   | WD            | WD         | L         |             | EXTERNOLOGICATION   |
| 1604-4  | HALL            | LAUNDRY | 2' - 0" | 8' - 0"  | 0' - 1 3/4"   | WD            | WD         | CC        |             |                     |
| 1604-5  | HALL            | KITCHEN |         | 8' - 0"  | 0' - 1 3/4"   | WD            | WD         | L         |             |                     |
| 1604-6  | CLOSET          | HALL    | 5' - 0" | 8' - 0"  | 0' - 1 1/2"   | WD            | WD         | L         |             | +                   |
| 1604-7  | A/C             | HALL    | 2' - 0" | 8' - 0"  | 0' - 1 3/4"   | WD            | WD         | СС        |             | 1                   |
| 1604-8  | HALL            | BATH    | 2' - 8" | 8' - 0"  | 0' - 1 3/4"   | WD            | WD         | L         |             |                     |
| 1604-9  | KITCHEN         | PANTRY  | 2' - 8" | 8' - 0"  | 0' - 1 3/4"   | WD            | WD         | AA        |             |                     |
| 1604-10 | WATER<br>HEATER | KITCHEN | 2' - 6" | 8' - 0"  | 0' - 1 3/4"   | WD            | WD         | AA        |             |                     |
| 1604-11 |                 | KITCHEN | 3' - 0" | 8' - 0"  | 0' - 1 3/4"   | WD            | WD         | AA        | 1HR         | 1 HOUR RATED        |

|         |                 |              | FINISH      | I SCHEDUL | E - UNIT 1 | 604     |         |                |             |
|---------|-----------------|--------------|-------------|-----------|------------|---------|---------|----------------|-------------|
| NUMBER  | NAME            | FLOOR FINISH | BASE FINISH | N. WALL   | S. WALL    | E. WALL | W. WALL | CEILING FINISH | CEILING HT. |
|         | I               |              | I           |           | -<br>-     | T       | T       |                |             |
| 1604-1  | KITCHEN         |              |             |           |            |         |         |                |             |
| 1604-2  | WATER<br>HEATER |              |             |           |            |         |         |                |             |
| 1604-3  | PANTRY          |              |             |           |            |         |         |                |             |
| 1604-4  | DINING          |              |             |           |            |         |         |                |             |
| 1604-5  | LIVING          |              |             |           |            |         |         |                |             |
| 1604-6  | HALL            |              |             |           |            |         |         |                |             |
| 1604-7  | LAUNDRY         |              |             |           |            |         |         |                |             |
| 1604-8  | BEDROOM         |              |             |           |            |         |         |                |             |
| 1604-9  | CLOSET          |              |             |           |            |         |         |                |             |
| 1604-10 | A/C             |              |             |           |            |         |         |                |             |
| 1604-11 | BATH            |              |             |           |            |         |         |                |             |

1 CONDO 1604 ENLARGED PLAN
SCALE: 1/4" = 1'-0"

HARD ROCK HOT 1031 CANAL STREET NEW ORLEANS, LOUISIANA

189 Maple Ridge Drive Metairie, LA 70001 (504)-885-4477 central@hbsaii.com :-: hbsaii.com

SINCE 1961

THIS DRAWING IS CONFIDENTIAL AND NOT BE LOANED, REPRODUCED, COPIED, EITHER WHOLLY OR IN PART, OR MADE PUBLIC IN ANY MANNER WITHOUT THE


THESE PLANS AND SPECIFICATIONS HAVE BEEN PREPARED BY ME OR UNDER MY CLOSE PERSONAL SUPERVISION AND TO THE BEST OF MY KNOWLEDGE AND BELIEF THEY COMPLY WITH ALL CITY, STATE AND FEDERAL REQUIREMENTS, AND I AM NOT PROVIDING CONTRACT ADMINISTRATION.

\_CERTIFIED CORRECT

THIS DRAWING IS CONFIDENTIAL AND NOT BE LOANED, REPRODUCED, COPIED, EITHER WHOLLY OR IN PART, OR MADE PUBLIC IN ANY MANNER WITHOUT THE WRITTEN CONSENT OF HBSA II ARCHITECTS A PROFESSIONAL L.L.C. ALL RIGHTS OF DESIGN OR INVENTION ARE RESERVED AND WILL REMAIN THE SOLE PROPERTY OF HBSA II ARCHITECTS A PROFESSIONAL L.L.C.

| 4/27/2018                   |
|-----------------------------|
| LI.S. #2 - CLOUD REVISION 1 |

CONDO 1604

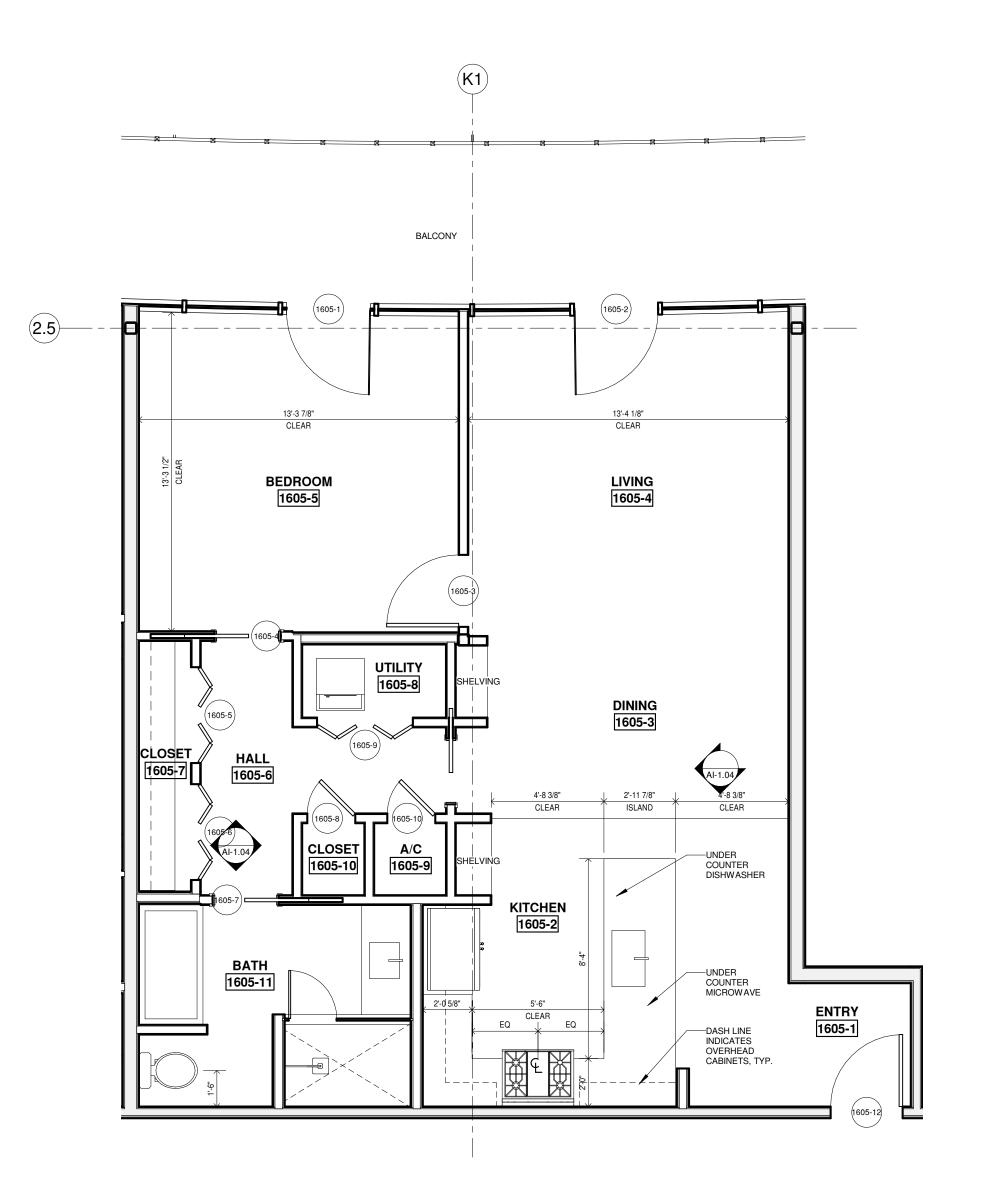

|         | DOOR SCHEDULE - UNIT 1605 |         |         |          |               |               |            |           |             |              |  |  |
|---------|---------------------------|---------|---------|----------|---------------|---------------|------------|-----------|-------------|--------------|--|--|
| MARK    | FROM                      | 10      | WIDTH   | HEIGHT   | THICKNESS     | DOOR MATERIAL | DOOR FRAME | DOOR TYPE | FIRE RATING | REMARKS      |  |  |
| 1605    | I                         |         | C! O"   | 7' - 0"  | 0' - 1 3/4"   | НМ            | НМ         | D         |             |              |  |  |
|         | DEDDOOM                   |         | 6' - 0" |          |               |               |            |           |             |              |  |  |
| 1605-1  | BEDROOM                   |         | 3' - 6" |          |               | AL/GL         | AL         | K         |             |              |  |  |
| 1605-2  |                           | LIVING  | 3' - 6" | 7' - 10" | 0' - 0 15/32" | AL/GL         | AL         | K         |             |              |  |  |
| 1605-3  | LIVING                    | BEDROOM | 3' - 0" | 8' - 0"  | 0' - 1 3/4"   | WD            | WD         | AA        |             |              |  |  |
| 1605-4  | BEDROOM                   | HALL    | 2' - 8" | 8' - 0"  | 0' - 1 3/4"   | WD            | WD         | L         |             |              |  |  |
| 1605-5  | HALL                      | CLOSET  | 4' - 0" | 8' - 0"  | 0' - 1 1/2"   | WD            | WD         | K         |             |              |  |  |
| 1605-6  | CLOSET                    | HALL    | 4' - 0" | 8' - 0"  | 0' - 1 1/2"   | WD            | WD         | K         |             |              |  |  |
| 1605-7  | BATH                      | HALL    | 2' - 8" | 8' - 0"  | 0' - 1 3/4"   | WD            | WD         | L         |             |              |  |  |
| 1605-8  | HALL                      | CLOSET  | 2' - 0" | 8' - 0"  | 0' - 1 3/4"   | WD            | WD         | CC        |             |              |  |  |
| 1605-9  | UTILITY                   | HALL    | 4' - 0" | 8' - 0"  | 0' - 1 1/2"   | WD            | WD         | K         |             |              |  |  |
| 1605-10 | HALL                      | A/C     | 2' - 0" | 8' - 0"  | 0' - 1 3/4"   | WD            | WD         | CC        |             |              |  |  |
| 1605-11 | DINING                    | HALL    | 2' - 8" | 8' - 0"  | 0' - 1 3/4"   | WD            | WD         | L         |             |              |  |  |
| 1605-12 |                           | ENTRY   | 3' - 0" | 8' - 0"  | 0' - 1 3/4"   | WD            | WD         | AA        | 1HR         | 1 HOUR RATED |  |  |

|         | FINISH SCHEDULE - UNIT 1605 |              |             |         |         |         |         |                |             |  |  |  |
|---------|-----------------------------|--------------|-------------|---------|---------|---------|---------|----------------|-------------|--|--|--|
| NUMBER  | NAME                        | FLOOR FINISH | BASE FINISH | N. WALL | S. WALL | E. WALL | W. WALL | CEILING FINISH | CEILING HT. |  |  |  |
|         |                             |              |             |         |         |         |         |                |             |  |  |  |
| 1605-1  | ENTRY                       |              |             |         |         |         |         |                |             |  |  |  |
| 1605-2  | KITCHEN                     |              |             |         |         |         |         |                |             |  |  |  |
| 1605-3  | DINING                      |              |             |         |         |         |         |                |             |  |  |  |
| 1605-4  | LIVING                      |              |             |         |         |         |         |                |             |  |  |  |
| 1605-5  | BEDROOM                     |              |             |         |         |         |         |                |             |  |  |  |
| 1605-6  | HALL                        |              |             |         |         |         |         |                |             |  |  |  |
| 1605-7  | CLOSET                      |              |             |         |         |         |         |                |             |  |  |  |
| 1605-8  | UTILITY                     |              |             |         |         |         |         |                |             |  |  |  |
| 1605-9  | A/C                         |              |             |         |         |         |         |                |             |  |  |  |
| 1605-10 | CLOSET                      |              |             |         |         |         |         |                |             |  |  |  |
| 1605-11 | BATH                        |              |             |         |         |         |         |                |             |  |  |  |

CONDO 1605 ENLARGED PLAN

SCALE: 1/4" = 1'-0"

HARRY
BAKER
SMITH
SMITH
ARCHITECTS II
P L C

189 Maple Ridge Drive Metairie, LA 70001
(504)-885-4477
central@hbsaii.com :: hbsaii.com
SINCE 1961

HARD ROCK HOTT 1031 CANAL STREET NEW ORLEANS, LOUISIANA


THESE PLANS AND SPECIFICATIONS HAVE
BEEN PREPARED BY ME OR UNDER MY
CLOSE PERSONAL SUPERVISION AND TO
THE BEST OF MY KNOWLEDGE AND
BELIEF THEY COMPLY WITH ALL CITY,
STATE AND FEDERAL REQUIREMENTS, AND
I AM NOT PROVIDING CONTRACT
ADMINISTRATION.
CERTIFIED CORRECT



THIS DRAWING IS CONFIDENTIAL AND
NOT BE LOANED, REPRODUCED, COPIED,
EITHER WHOLLY OR IN PART, OR MADE
PUBLIC IN ANY MANNER WITHOUT THE
WRITTEN CONSENT OF HBSA II ARCHITECTS
A PROFESSIONAL L.L.C. ALL RIGHTS OF
DESIGN OR INVENTION ARE RESERVED AND
WILL REMAIN THE SOLE PROPERTY OF HBSA

|                              | R                            | EVIS                         | SION                         | HIS                          | TOR                          | Y                            |  |
|------------------------------|------------------------------|------------------------------|------------------------------|------------------------------|------------------------------|------------------------------|--|
| 4/27/2018                    | 5/4/2018                     | 5/11/2018                    | 5/18/2018                    | 5/25/2018                    | 6/1/2018                     | 6/8/2018                     |  |
|                              |                              |                              |                              |                              | )                            |                              |  |
| L.I.S. #2 - CLOUD REVISION 1 | L.i.S. #2 - CLOUD REVISION 2 | L.I.S. #2 - CLOUD REVISION 3 | L.I.S. #2 - CLOUD REVISION 4 | L.I.S. #2 - CLOUD REVISION 5 | L.I.S. #2 - CLOUD REVISION 6 | L.I.S. #2 - CLOUD REVISION 7 |  |

CONDO 1605

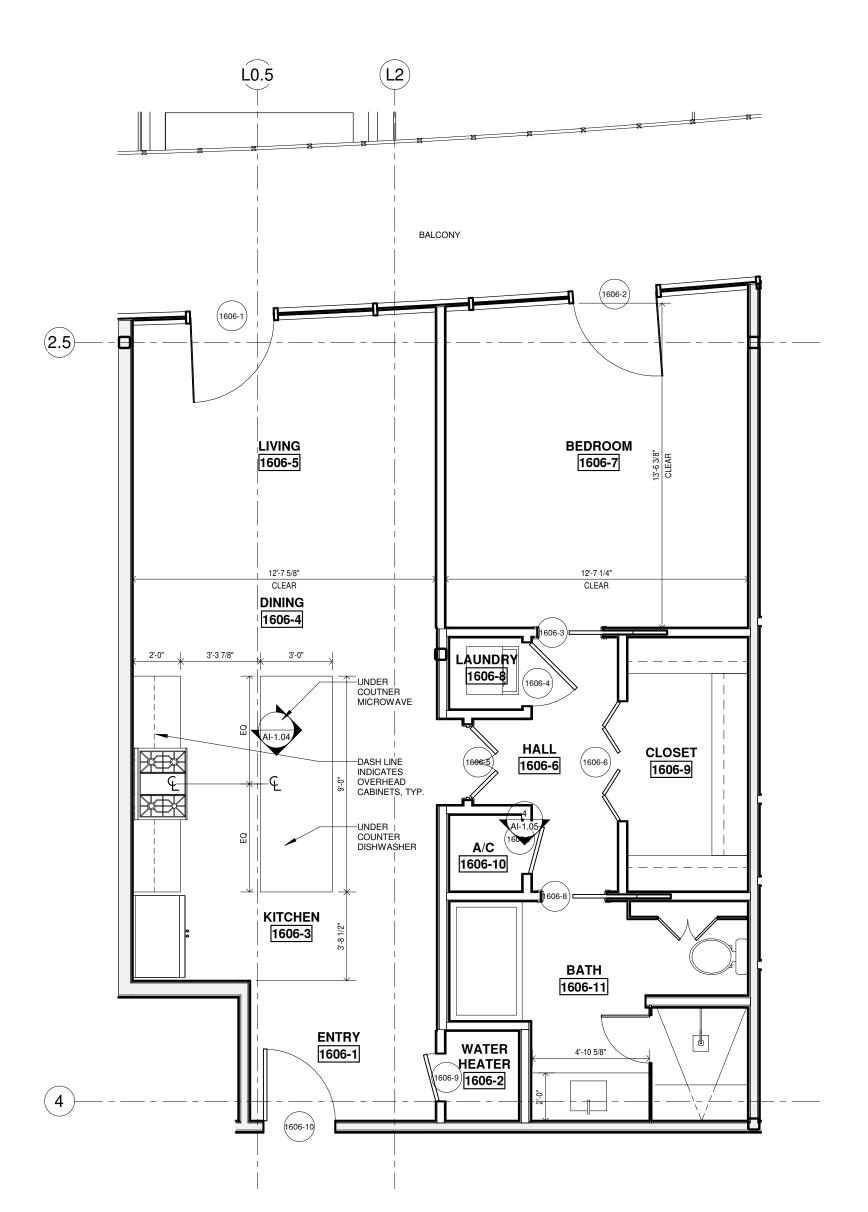

|         |                 |         |         | DOC      | R SCHEDUL     | E - UNI       | T 1606     |           |             |              |
|---------|-----------------|---------|---------|----------|---------------|---------------|------------|-----------|-------------|--------------|
| MARK    | FROM            | 01      | WIDTH   | НЕІСНТ   | THICKNESS     | DOOR MATERIAL | DOOR FRAME | DOOR TYPE | FIRE RATING | REMARKS      |
|         |                 |         |         |          |               |               |            |           |             |              |
| 1606    |                 |         | 6' - 0" | 7' - 0"  | 0' - 1 3/4"   | НМ            | HM         | D         |             |              |
| 1606-1  |                 | LIVING  | 3' - 6" | 7' - 10" | 0' - 0 15/32" | AL/GL         | AL         | K         |             |              |
| 1606-2  |                 | BEDROOM | 3' - 6" | 7' - 10" | 0' - 0 15/32" | AL/GL         | AL         |           |             |              |
| 1606-3  | HALL            | BEDROOM | 2' - 8" | 8' - 0"  | 0' - 1 3/4"   | WD            | WD         | L         |             |              |
| 1606-4  | HALL            | LAUNDRY | 2' - 8" | 8' - 0"  | 0' - 1 3/4"   | WD            | WD         | AA        |             |              |
| 606-5   | HALL            | KITCHEN | 3' - 0" | 8' - 0"  | 0' - 1 3/4"   | WD            | WD         | СС        |             |              |
| 1606-6  | CLOSET          | HALL    | 5' - 0" | 8' - 0"  | 0' - 1 1/2"   | WD            | WD         | L         |             |              |
| 1606-7  | A/C             | HALL    | 2' - 0" | 8' - 0"  | 0' - 1 3/4"   | WD            | WD         | СС        |             |              |
| 1606-8  | BATH            | HALL    | 2' - 8" | 8' - 0"  | 0' - 1 3/4"   | WD            | WD         | L         |             |              |
| 1606-9  | WATER<br>HEATER | ENTRY   | 2' - 0" | 8' - 0"  | 0' - 1 3/4"   | WD            | WD         | CC        |             |              |
| 1606-10 |                 | ENTRY   | 3' - 0" | 8' - 0"  | 0' - 1 3/4"   | WD            | WD         | AA        | 1HR         | 1 HOUR RATED |

|         |              |              | FINISH S    | CHEDULE - | UNIT 1606 | 6       |         |                |             |
|---------|--------------|--------------|-------------|-----------|-----------|---------|---------|----------------|-------------|
| NUMBER  | NAME         | FLOOR FINISH | BASE FINISH | N. WALL   | S. WALL   | E. WALL | W. WALL | CEILING FINISH | CEILING HT. |
|         |              |              |             |           |           |         |         |                |             |
| 1606-1  | ENTRY        |              |             |           |           |         |         |                |             |
| 1606-2  | WATER HEATER |              |             |           |           |         |         |                |             |
| 1606-3  | KITCHEN      |              |             |           |           |         |         |                |             |
| 1606-4  | DINING       |              |             |           |           |         |         |                |             |
| 1606-5  | LIVING       |              |             |           |           |         |         |                |             |
| 1606-6  | HALL         |              |             |           |           |         |         |                |             |
| 1606-7  | BEDROOM      |              |             |           |           |         |         |                |             |
| 1606-8  | LAUNDRY      |              |             |           |           |         |         |                |             |
| 1606-9  | CLOSET       |              |             |           |           |         |         |                |             |
| 1606-10 | A/C          |              |             |           |           |         |         |                |             |
| 1606-11 | BATH         |              |             |           |           |         |         |                |             |

CONDO 1606 ENLARGED PLAN

SCALE: 1/4" = 1'-0"

189 Maple Ridge Drive Metairie, LA 70001 (504)-885-4477 central@hbsaii.com :-: hbsaii.com SINCE 1961


1031 CANAL STREET NEW ORLEANS, LOUISIANA

THESE PLANS AND SPECIFICATIONS HAVE BEEN PREPARED BY ME OR UNDER MY CLOSE PERSONAL SUPERVISION AND TO THE BEST OF MY KNOWLEDGE AND BELIEF THEY COMPLY WITH ALL CITY, STATE AND FEDERAL REQUIREMENTS, AND I AM NOT PROVIDING CONTRACT ADMINISTRATION. CERTIFIED CORRECT



| _                          | R                          |                            | SION                        | HIS                         | TOR                         | Υ                           |  |
|----------------------------|----------------------------|----------------------------|-----------------------------|-----------------------------|-----------------------------|-----------------------------|--|
| 4/27/2018                  | 5/4/2018                   | 5/11/2018                  | 5/18/2018                   | 5/25/2018                   | 6/1/2018                    | 6/8/2018                    |  |
| I.S. #2 - CLOUD REVISION 1 | I.S. #2 - CLOUD REVISION 2 | I.S. #2 - CLOUD REVISION 3 | .I.S. #2 - CLOUD REVISION 4 | .I.S. #2 - CLOUD REVISION 5 | .I.S. #2 - CLOUD REVISION 6 | .I.S. #2 - CLOUD REVISION 7 |  |

CONDO 1606

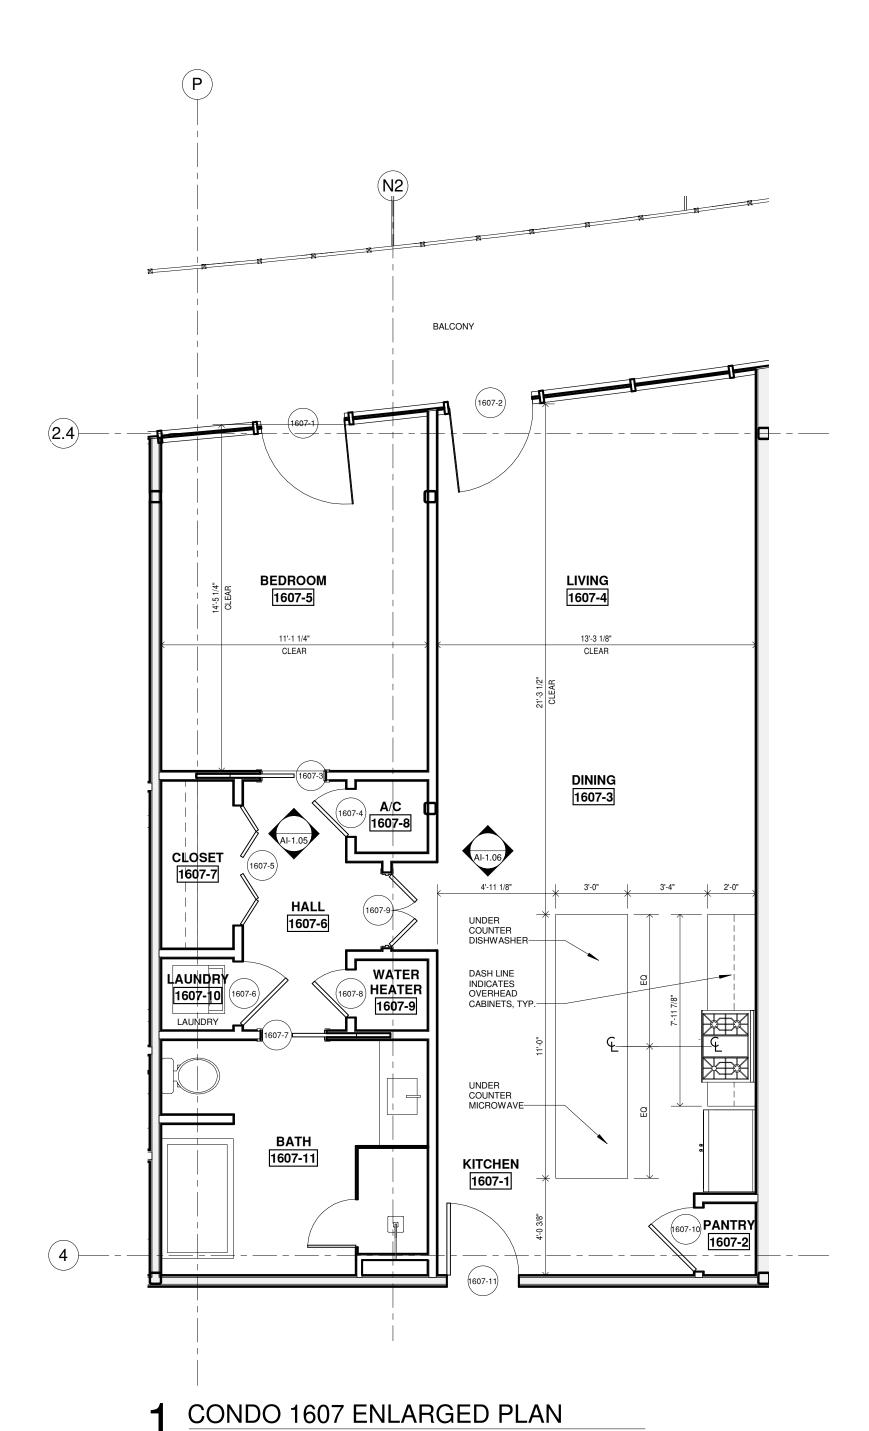

SCALE: 1/4" = 1'-0"

|         |         |                 |         | DOOF     | R SCHEDULE    | E - UNIT      | 1607       |           |             |                     |
|---------|---------|-----------------|---------|----------|---------------|---------------|------------|-----------|-------------|---------------------|
| MARK    | FROM    | ТО              | WIDTH   | HEIGHT   | THICKNESS     | DOOR MATERIAL | DOOR FRAME | DOOR TYPE | FIRE RATING | REMARKS             |
|         |         |                 |         |          |               |               |            |           |             |                     |
| 1607    |         |                 | 6' - 0" | 7' - 0"  | 0' - 1 3/4"   | HM            | НМ         | D         |             |                     |
| 1607-1  |         | BEDROOM         | 3' - 6" | 7' - 10" | 0' - 0 15/32" | AL/GL         | AL         | K         |             |                     |
| 1607-2  | LIVING  |                 | 3' - 6" | 7' - 10" | 0' - 0 15/32" | AL/GL         | AL         | K         |             | EXTERIOR STOREFRONT |
| 1607-3  | BEDROOM | HALL            | 2' - 8" | 8' - 0"  | 0' - 1 3/4"   | WD            | WD         | L         |             |                     |
| 1607-4  | HALL    | A/C             | 2' - 0" | 8' - 0"  | 0' - 1 3/4"   | WD            | WD         | CC        |             |                     |
| 1607-5  | CLOSET  | HALL            | 5' - 0" | 8' - 0"  | 0' - 1 1/2"   | WD            | WD         | L         |             |                     |
| 1607-6  | LAUNDRY | HALL            | 2' - 8" | 8' - 0"  | 0' - 1 3/4"   | WD            | WD         | AA        |             |                     |
| 1607-7  | BATH    | HALL            | 2' - 8" | 8' - 0"  | 0' - 1 3/4"   | WD            | WD         | L         |             |                     |
| 1607-8  | HALL    | WATER<br>HEATER | 2' - 0" | 8' - 0"  | 0' - 1 3/4"   | WD            | WD         | CC        |             |                     |
| 1607-9  | KITCHEN | HALL            | 3' - 0" | 8' - 0"  | 0' - 1 3/4"   | WD            | WD         | CC        |             |                     |
| 1607-10 | PANTRY  | KITCHEN         | 2' - 8" | 8' - 0"  | 0' - 1 3/4"   | WD            | WD         | AA        |             |                     |
| 1607-11 |         | KITCHEN         | 3' - 0" | 8' - 0"  | 0' - 1 3/4"   | WD            | WD         | AA        | 1HR         | 1 HOUR RATED        |

|         | FINISH SCHEDULE - UNIT 1607 |              |             |         |         |         |         |                |             |  |  |  |
|---------|-----------------------------|--------------|-------------|---------|---------|---------|---------|----------------|-------------|--|--|--|
| NUMBER  | NAME                        | FLOOR FINISH | BASE FINISH | N. WALL | S. WALL | E. WALL | W. WALL | CEILING FINISH | CEILING HT. |  |  |  |
|         |                             |              |             |         |         |         |         |                |             |  |  |  |
| 1607-1  | KITCHEN                     |              |             |         |         |         |         |                |             |  |  |  |
| 1607-2  | PANTRY                      |              |             |         |         |         |         |                |             |  |  |  |
| 1607-3  | DINING                      |              |             |         |         |         |         |                |             |  |  |  |
| 1607-4  | LIVING                      |              |             |         |         |         |         |                |             |  |  |  |
| 1607-5  | BEDROOM                     |              |             |         |         |         |         |                |             |  |  |  |
| 1607-6  | HALL                        |              |             |         |         |         |         |                |             |  |  |  |
| 1607-7  | CLOSET                      |              |             |         |         |         |         |                |             |  |  |  |
| 1607-8  | A/C                         |              |             |         |         |         |         |                |             |  |  |  |
| 1607-9  | WATER HEATER                |              |             |         |         |         |         |                |             |  |  |  |
| 1607-10 | LAUNDRY                     |              |             |         |         |         |         |                |             |  |  |  |
| 1607-11 | BATH                        |              |             |         |         |         |         |                |             |  |  |  |

HARD ROCK HOTEL

1031 CANAL STREET

NEW ORLEANS, LOUISIANA

189 Maple Ridge Drive Metairie, LA 70001 (504)-885-4477 central@hbsaii.com :-: hbsaii.com

SINCE 1961

THESE PLANS AND SPECIFICATIONS HAVE BEEN PREPARED BY ME OR UNDER MY CLOSE PERSONAL SUPERVISION AND TO THE BEST OF MY KNOWLEDGE AND BELIEF THEY COMPLY WITH ALL CITY, STATE AND FEDERAL REQUIREMENTS, AND I AM NOT PROVIDING CONTRACT ADMINISTRATION.

CERTIFIED CORRECT




THIS DRAWING IS CONFIDENTIAL AND
NOT BE LOANED, REPRODUCED, COPIED,
EITHER WHOLLY OR IN PART, OR MADE
PUBLIC IN ANY MANNER WITHOUT THE
WRITTEN CONSENT OF HBSA II ARCHITES
A PROFESSIONAL L.L.C. ALL RIGHTS OF
DESIGN OR INVENTION ARE RESERVED AND
WILL REMAIN THE SOLE PROPERTY OF HBSA

|                              | R                            | EVIS                         | ION                          | HIS                          | TOR                          | Υ                            |  |
|------------------------------|------------------------------|------------------------------|------------------------------|------------------------------|------------------------------|------------------------------|--|
| 4/27/2018                    | 5/4/2018                     | 5/11/2018                    | 5/18/2018                    | 5/25/2018                    | 6/1/2018                     | 6/8/2018                     |  |
|                              |                              |                              |                              |                              |                              |                              |  |
|                              |                              |                              |                              |                              |                              |                              |  |
| Z<br>-                       | 2<br>Z                       | e N                          | 4<br>4                       | N 5                          | 9 N                          | V 2                          |  |
| REVISIO                      |  |
| L.I.S. #2 - CLOUD REVISION 1 | L.I.S. #2 - CLOUD REVISION 2 | L.I.S. #2 - CLOUD REVISION 3 | L.I.S. #2 - CLOUD REVISION 4 | L.I.S. #2 - CLOUD REVISION 5 | L.I.S. #2 - CLOUD REVISION 6 | L.I.S. #2 - CLOUD REVISION 7 |  |
| .I.S. #2 -                   |  |
|                              |                              |                              |                              |                              |                              |                              |  |

CONDO 1607

PROJECT#: 1709
PHASE: DD
TEAM: Author
CHECKER: Checker
SCALE: AS NOTED
ISSUED: 4/20/2018

AI-1.30

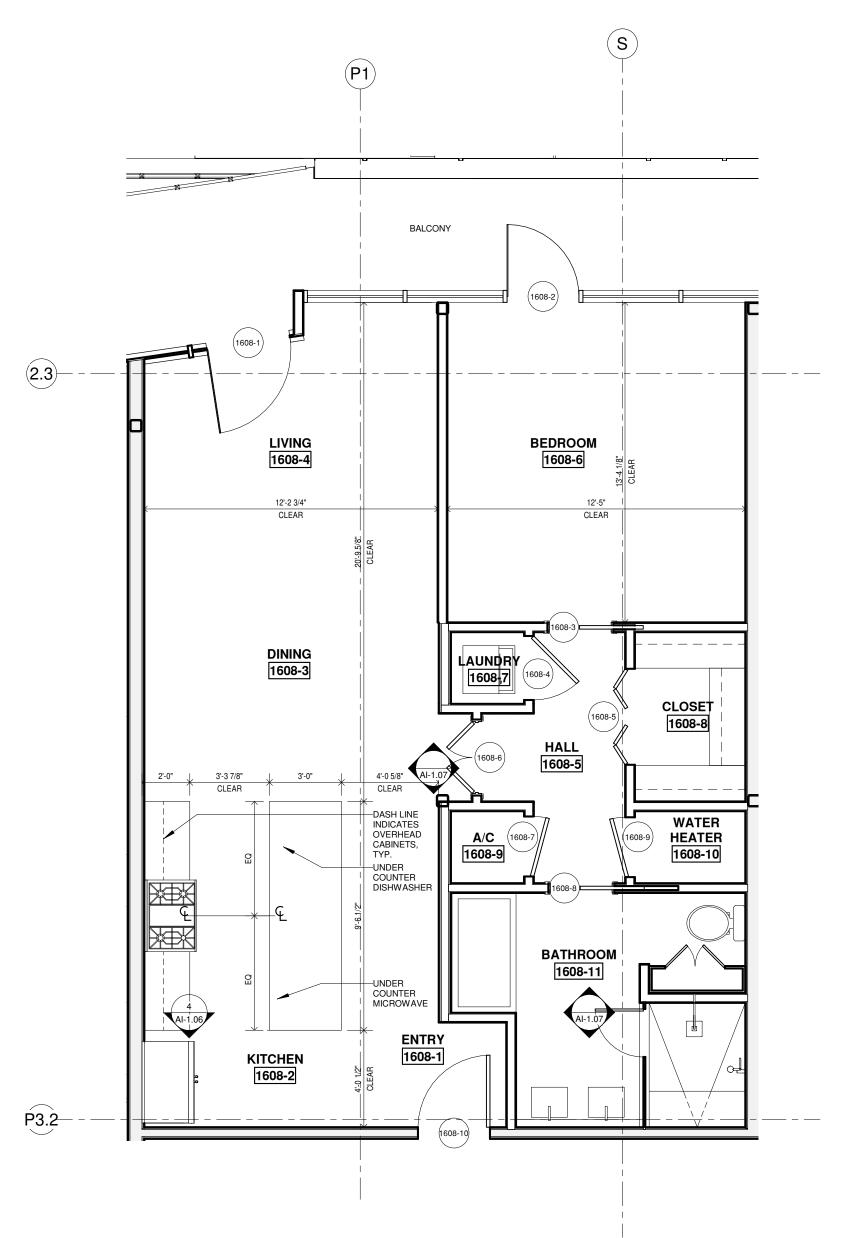

|         |              |          | DOOR    | SCHE        | DULE - UN        | IT 1608       |            |           |             |         |
|---------|--------------|----------|---------|-------------|------------------|---------------|------------|-----------|-------------|---------|
| MARK    | FROM         | 10       | WIDTH   | неіднт      | THICKNESS        | DOOR MATERIAL | DOOR FRAME | DOOR TYPE | FIRE RATING | REMARKS |
|         |              |          |         |             |                  |               |            |           |             |         |
| 1608    |              |          | 6' - 0" | 7' - 0"     | 0' - 1 3/4"      | НМ            | HM         | D         |             |         |
| 1608-1  | LIVING       |          | 3' - 6" | 7' -<br>10" | 0' - 0<br>15/32" | AL/GL         | AL         | K         |             |         |
| 1608-2  | BEDROOM      |          | 3' - 0" | 8' - 2"     | 0' - 1 1/2"      | AL/GL         | AL         | K         |             |         |
| 1608-3  | HALL         | BEDROOM  | 2' - 8" | 8' - 0"     | 0' - 1 3/4"      | WD            | WD         | L         |             |         |
| 1608-4  | HALL         | LAUNDRY  | 2' - 8" | 8' - 0"     | 0' - 1 3/4"      | WD            | WD         | AA        |             |         |
| 1608-5  | HALL         | CLOSET   | 4' - 0" | 8' - 0"     | 0' - 1 1/2"      | WD            | WD         |           |             |         |
| 1608-6  | HALL         | KITCHEN  | 3' - 0" | 8' - 0"     | 0' - 1 3/4"      | WD            | WD         | CC        |             |         |
| 1608-7  | HALL         | A/C      | 2' - 6" | 8' - 0"     | 0' - 1 3/4"      | WD            | WD         | CC        |             |         |
| 1608-8  | HALL         | BATHROOM | 2' - 8" | 8' - 0"     | 0' - 1 3/4"      | WD            | WD         | L         |             |         |
| 1608-9  | WATER HEATER | HALL     | 2' - 6" | 8' - 0"     | 0' - 1 3/4"      | WD            | WD         | CC        |             |         |
| 1608-10 |              | ENTRY    | 3' - 0" | 8' - 0"     | 0' - 1 3/4"      | WD            | WD         | С         | 1HR         |         |

|         |              |              | FINISH SC   | HEDULE - ( | JNIT 1608 |         |         |                |             |
|---------|--------------|--------------|-------------|------------|-----------|---------|---------|----------------|-------------|
| NUMBER  | NAME         | FLOOR FINISH | BASE FINISH | N. WALL    | S. WALL   | E. WALL | W. WALL | CEILING FINISH | CEILING HT. |
|         |              |              |             |            |           |         |         |                |             |
| 1608-1  | ENTRY        |              |             |            |           |         |         |                |             |
| 1608-2  | KITCHEN      |              |             |            |           |         |         |                |             |
| 1608-3  | DINING       |              |             |            |           |         |         |                |             |
| 1608-4  | LIVING       |              |             |            |           |         |         |                |             |
| 1608-5  | HALL         |              |             |            |           |         |         |                |             |
| 1608-6  | BEDROOM      |              |             |            |           |         |         |                |             |
| 1608-7  | LAUNDRY      |              |             |            |           |         |         |                |             |
| 1608-8  | CLOSET       |              |             |            |           |         |         |                |             |
| 1608-9  | A/C          |              |             |            |           |         |         |                |             |
| 1608-10 | WATER HEATER |              |             |            |           |         |         |                |             |
| 1608-11 | BATHROOM     |              |             |            |           |         |         |                |             |

CONDO 1608 ENLARGED PLAN

SCALE: 1/4" = 1'-0"

HARRY
BAKER
SMITH
SMITH
ARCHITECTS II
P L C

189 Maple Ridge Drive Metairie, LA 70001
(504)-885-4477
central@hbsaii.com :: hbsaii.com
SINCE 1961

HAKUKK HOILE 1031 CANAL STREET

THESE PLANS AND SPECIFICATIONS HAVE BEEN PREPARED BY ME OR UNDER MY CLOSE PERSONAL SUPERVISION AND TO THE BEST OF MY KNOWLEDGE AND BELIEF THEY COMPLY WITH ALL CITY, STATE AND FEDERAL REQUIREMENTS, AND I AM NOT PROVIDING CONTRACT ADMINISTRATION.

CERTIFIED CORRECT



THIS DRAWING IS CONFIDENTIAL AND NOT BE LOANED, REPRODUCED, COPIED, EITHER WHOLLY OR IN PART, OR MADE PUBLIC IN ANY MANNER WITHOUT THE WRITTEN CONSENT OF HBSA II ARCHITECTS, A PROFESSIONAL L.L.C. ALL RIGHTS OF DESIGN OR INVENTION ARE RESERVED AND WILL REMAIN THE SOLE PROPERTY OF HBSA


|                              | R                            | EVIS                         | ION                          | HIS                          | TOR                          | Υ                            |   |
|------------------------------|------------------------------|------------------------------|------------------------------|------------------------------|------------------------------|------------------------------|---|
| 4/27/2018                    | 5/4/2018                     | 5/11/2018                    | 5/18/2018                    | 5/25/2018                    | 6/1/2018                     | 6/8/2018                     |   |
| L.i.S. #2 - CLOUD REVISION 1 | L.i.S. #2 - CLOUD REVISION 2 | L.i.S. #2 - CLOUD REVISION 3 | L.i.S. #2 - CLOUD REVISION 4 | L.i.S. #2 - CLOUD REVISION 5 | L.i.S. #2 - CLOUD REVISION 6 | L.i.S. #2 - CLOUD REVISION 7 |   |
| -                            | N                            | က                            | 4                            | 2                            | 9                            | _                            | ω |

CONDO 1608

PROJECT#: 1709
PHASE: DD
TEAM: Author
CHECKER: Checker
SCALE: AS NOTED

ISSUED: 4/20/2018
SHEET#:

Al-1.31

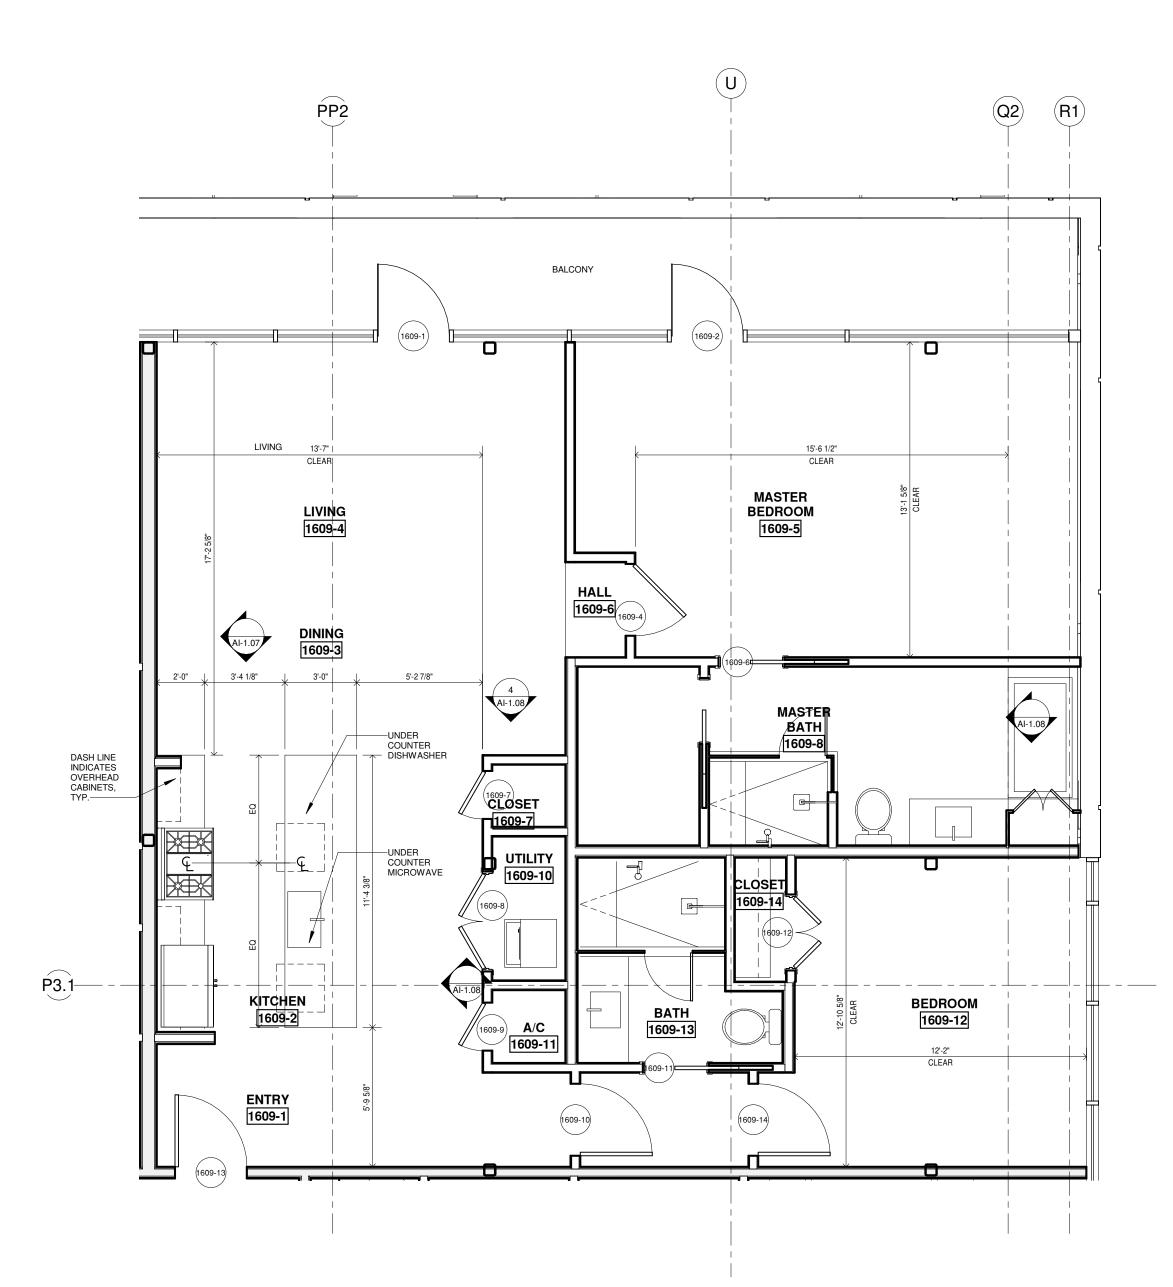

|         |                   |                | DO      | OR SCI  | HEDULE -    | UNIT 16       | 609        |           |             |                    |
|---------|-------------------|----------------|---------|---------|-------------|---------------|------------|-----------|-------------|--------------------|
| MARK    | FROM              | 0              | WIDTH   | HEIGHT  | THICKNESS   | DOOR MATERIAL | DOOR FRAME | DOOR TYPE | FIRE RATING | REMARKS            |
| 1000 1  | KITOLIEN          | T              | 01 011  | 01 011  | 01 4 4 /011 | A1 /O1        |            | 17        |             |                    |
| 1609-1  | KITCHEN           |                | 3' - 0" |         | 0' - 1 1/2" |               |            | K         |             |                    |
| 1609-2  | MASTER<br>BEDROOM |                | 3' - 0" | 8' - 2" | 0' - 1 1/2" | AL/GL         | AL         | K         |             |                    |
| 1609-4  | MASTER<br>BEDROOM | HALL           | 3' - 0" | 8' - 0" | 0' - 1 3/4" | WD            | WD         | L         |             |                    |
| 1609-6  | MASTER BATH       | MASTER BEDROOM | 2' - 8" | 8' - 0" | 0' - 1 3/4" | WD            | WD         | L         |             |                    |
| 1609-7  | CLOSET            | KITCHEN        | 2' - 0" | 8' - 0" | 0' - 1 3/4" | WD            | WD         | CC        |             | DOUBLE DOOR / PAIR |
| 1609-8  | UTILITY           | KITCHEN        | 4' - 0" | 8' - 0" | 0' - 1 3/4" | WD            | WD         | CC        |             | DOUBLE DOOR / PAIR |
| 1609-9  | A/C               | KITCHEN        | 2' - 0" | 8' - 0" | 0' - 1 3/4" | WD            | WD         | AA        |             |                    |
| 1609-10 |                   |                | 3' - 0" | 8' - 0" | 0' - 1 3/4" | WD            | WD         | AA        |             |                    |
| 1609-11 | BATH              |                | 2' - 8" | 8' - 0" | 0' - 1 3/4" | WD            | WD         | L         |             |                    |
| 1609-12 | CLOSET            | BEDROOM        | 3' - 0" | 8' - 0" | 0' - 1 3/4" | WD            | WD         | CC        |             | DOUBLE DOOR / PAIR |
| 1609-13 |                   | ENTRY          | 3' - 0" | 8' - 0" | 0' - 1 3/4" | WD            | НМ         | AA        | 1HR         |                    |
| 1609-14 |                   | BEDROOM        | 3' - 0" | 8' - 0" | 0' - 1 3/4" | WD            | WD         | AA        |             |                    |

|         | FINISH SCHEDULE - UNIT 1609 |              |             |         |         |         |         |                |             |  |  |  |  |
|---------|-----------------------------|--------------|-------------|---------|---------|---------|---------|----------------|-------------|--|--|--|--|
| NUMBER  | NAME                        | FLOOR FINISH | BASE FINISH | N. WALL | S. WALL | E. WALL | W. WALL | CEILING FINISH | CEILING HT. |  |  |  |  |
| 1609-1  | ENTRY                       |              |             |         |         |         |         |                |             |  |  |  |  |
| 1609-2  | KITCHEN                     |              |             |         |         |         |         |                |             |  |  |  |  |
| 1609-3  | DINING                      |              |             |         |         |         |         |                |             |  |  |  |  |
| 1609-4  | LIVING                      |              |             |         |         |         |         |                |             |  |  |  |  |
| 1609-5  | MASTER BEDROOM              |              |             |         |         |         |         |                |             |  |  |  |  |
| 1609-6  | HALL                        |              |             |         |         |         |         |                |             |  |  |  |  |
| 1609-6  | HALL                        |              |             |         |         |         |         |                |             |  |  |  |  |
| 1609-7  | CLOSET                      |              |             |         |         |         |         |                |             |  |  |  |  |
| 1609-8  | MASTER BATH                 |              |             |         |         |         |         |                |             |  |  |  |  |
| 1609-9  | CLOSET                      |              |             |         |         |         |         |                |             |  |  |  |  |
| 1609-10 |                             |              |             |         |         |         |         |                |             |  |  |  |  |
| 1609-11 |                             |              |             |         |         |         |         |                |             |  |  |  |  |
|         |                             |              |             |         |         |         |         |                |             |  |  |  |  |
| 1609-13 |                             |              |             |         |         |         |         |                |             |  |  |  |  |
| 1609-14 | CLOSET                      |              |             |         |         |         |         |                |             |  |  |  |  |

CONDO 1609 ENLARGED PLAN

SCALE: 1/4" = 1'-0"

HARD ROCK HOT

1031 CANAL STREET

NEW ORLEANS, LOUISIANA

189 Maple Ridge Drive Metairie, LA 70001 (504)-885-4477 central@hbsaii.com :-: hbsaii.com

SINCE 1961

THESE PLANS AND SPECIFICATIONS HAVE
BEEN PREPARED BY ME OR UNDER MY
CLOSE PERSONAL SUPERVISION AND TO
THE BEST OF MY KNOWLEDGE AND
BELIEF THEY COMPLY WITH ALL CITY,
STATE AND FEDERAL REQUIREMENTS, AND
I AM NOT PROVIDING CONTRACT
ADMINISTRATION.

CERTIFIED CORRECT



REVISION HISTORY


REVISION HISTORY

8102/11/9

8102/11/9

1 L.I.S. #2 - CLOUD REVISION 1
2 L.I.S. #2 - CLOUD REVISION 2
3 L.I.S. #2 - CLOUD REVISION 3
4 L.I.S. #2 - CLOUD REVISION 4
5 L.I.S. #2 - CLOUD REVISION 6
6 L.I.S. #2 - CLOUD REVISION 6
7 L.I.S. #2 - CLOUD REVISION 7
8

CONDO 1609

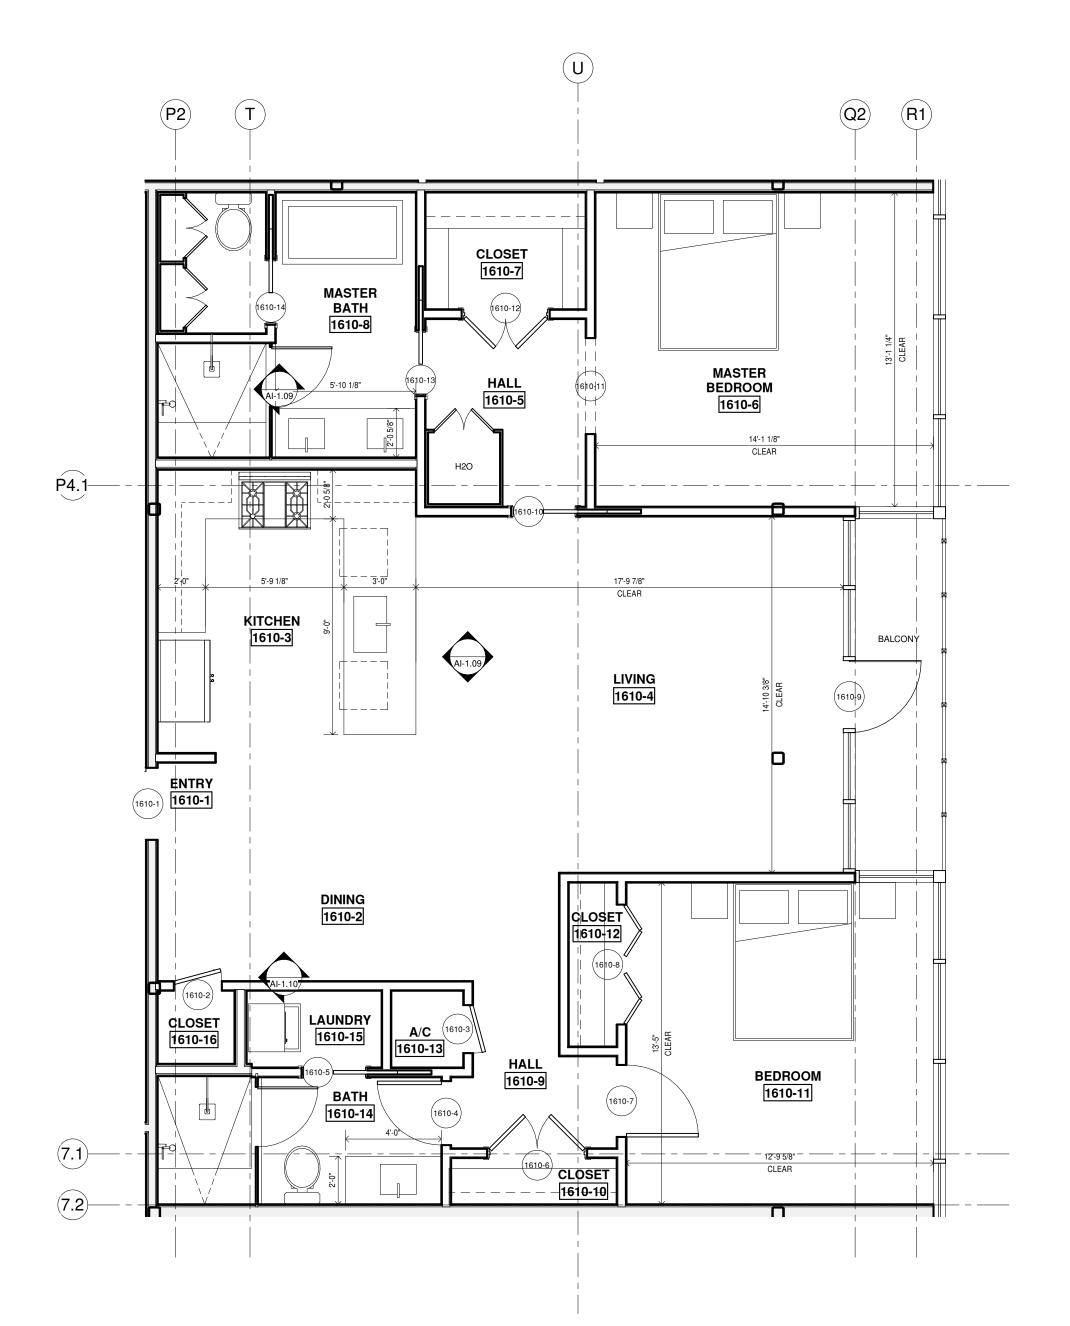

|         |             |                | DOOR        | SCHE    | DULE - UN   | IT 1610       |            |           |             |                    |
|---------|-------------|----------------|-------------|---------|-------------|---------------|------------|-----------|-------------|--------------------|
| MARK    | FROM        | O <sub>F</sub> | WIDTH       | HEIGHT  | THICKNESS   | DOOR MATERIAL | DOOR FRAME | DOOR TYPE | FIRE RATING | REMARKS            |
| 1610-1  |             | ENTRY          | 3' - 0"     | 8' - 0" | 0' - 1 3/4" | WD            | WD         | AA        | 1HR         |                    |
| 1610-2  | DINING      | CLOSET         |             |         | 0' - 1 3/4" |               | WD         | CC        |             | DOUBLE DOOR / PAIR |
| 1610-3  | HALL        | A/C            | 2' - 0"     | 8' - 0" | 0' - 1 3/4" | WD            | WD         | CC        |             | DOUBLE DOOR / PAIR |
| 1610-4  | HALL        | BATH           | 2' - 8"     | 8' - 0" | 0' - 1 3/4" | WD            | WD         | AA        |             |                    |
| 1610-5  | LAUNDRY     | BATH           | 2' - 8"     | 8' - 0" | 0' - 1 3/4" | WD            | WD         | L         |             |                    |
| 1610-6  | CLOSET      | HALL           | 4' - 0"     | 8' - 0" | 0' - 1 3/4" | WD            | WD         | CC        |             | DOUBLE DOOR / PAIR |
| 1610-7  | BEDROOM     | HALL           | 3' - 0"     | 8' - 0" | 0' - 1 3/4" | WD            | WD         | AA        |             |                    |
| 1610-8  | CLOSET      | BEDROOM        | 5' - 0"     | 8' - 0" | 0' - 1 1/2" | WD            | WD         | L         |             |                    |
| 1610-9  |             | LIVING         | 2' -<br>10" | 8' - 2" | 0' - 1 1/2" | AL/GL         | AL         | K         |             |                    |
| 1610-10 | LIVING      | HALL           | 2' - 8"     | 8' - 0" | 0' - 1 3/4" | WD            | WD         | L         |             |                    |
| 1610-11 | HALL        | MASTER BEDROOM | 4' - 0"     | 7' - 0" |             |               |            |           |             | FRAMED OPENING     |
| 1610-12 | CLOSET      | HALL           | 3' - 6"     | 8' - 0" | 0' - 1 3/4" | WD            | WD         | CC        |             | DOUBLE DOOR / PAIR |
| 1610-13 | MASTER BATH | HALL           | 2' - 8"     | 8' - 0" | 0' - 1 3/4" | WD            | WD         | L         |             |                    |
| 1610-14 | MASTER BATH |                | 2' - 8"     | 8' - 0" | 0' - 1 3/4" | WD            | WD         | L         |             |                    |

|         |                |              | FINISH SC   | HEDULE - l | JNIT 1610 |         |         |                |             |
|---------|----------------|--------------|-------------|------------|-----------|---------|---------|----------------|-------------|
| NUMBER  | NAME           | FLOOR FINISH | BASE FINISH | N. WALL    | S. WALL   | E. WALL | W. WALL | CEILING FINISH | CEILING HT. |
| 1010.1  | ENTDY          |              |             |            |           |         |         |                |             |
| 1610-1  | ENTRY          |              |             |            |           |         |         |                |             |
| 1610-2  | DINING         |              |             |            |           |         |         |                |             |
| 1610-3  | KITCHEN        |              |             |            |           |         |         |                |             |
| 1610-4  | LIVING         |              |             |            |           |         |         |                |             |
| 1610-5  | HALL           |              |             |            |           |         |         |                |             |
| 1610-6  | MASTER BEDROOM |              |             |            |           |         |         |                |             |
| 1610-7  | CLOSET         |              |             |            |           |         |         |                |             |
| 1610-8  | MASTER BATH    |              |             |            |           |         |         |                |             |
| 1610-9  | HALL           |              |             |            |           |         |         |                |             |
| 1610-10 | CLOSET         |              |             |            |           |         |         |                |             |
| 1610-11 | BEDROOM        |              |             |            |           |         |         |                |             |
|         | CLOSET         |              |             |            |           |         |         |                |             |
| 1610-13 | A/C            |              |             |            |           |         |         |                |             |
| 1610-14 | BATH           |              |             |            |           |         |         |                |             |
| 1610-15 | LAUNDRY        |              |             |            |           |         |         |                |             |
| 1610-16 | CLOSET         |              |             |            |           |         |         |                |             |

CONDO 1610 ENLARGED PLAN
SCALE: 1/4" = 1'-0"

189 Maple Ridge Drive Metairie, LA 70001 (504)-885-4477 central@hbsaii.com :-: hbsaii.com SINCE 1961

1031 CANAL STREET NEW ORLEANS, LOUISIANA


THESE PLANS AND SPECIFICATIONS HAVE BEEN PREPARED BY ME OR UNDER MY CLOSE PERSONAL SUPERVISION AND TO THE BEST OF MY KNOWLEDGE AND BELIEF THEY COMPLY WITH ALL CITY, STATE AND FEDERAL REQUIREMENTS, AND I AM NOT PROVIDING CONTRACT ADMINISTRATION. CERTIFIED CORRECT



|  | II AIN                      |                              | .013                         | A FIX                        | OI L3                        | JIUNA                        |                              |  |
|--|-----------------------------|------------------------------|------------------------------|------------------------------|------------------------------|------------------------------|------------------------------|--|
|  |                             | R                            | EVIS                         | SION                         | HIS                          | STOR                         | Υ                            |  |
|  | 4/27/2018                   | 5/4/2018                     | 5/11/2018                    | 5/18/2018                    | 5/25/2018                    | 6/1/2018                     | 6/8/2018                     |  |
|  | LI.S. #2 - CLOUD REVISION 1 | L.i.S. #2 - CLOUD REVISION 2 | L.I.S. #2 - CLOUD REVISION 3 | L.I.S. #2 - CLOUD REVISION 4 | L.I.S. #2 - CLOUD REVISION 5 | L.I.S. #2 - CLOUD REVISION 6 | L.i.S. #2 - CLOUD REVISION 7 |  |

CONDO 1610

PROJECT#: 1709
PHASE: DD
TEAM: Author
CHECKER: Checker
SCALE: AS NOTED
ISSUED: 4/20/2018
SHEET#:
Al-1.33

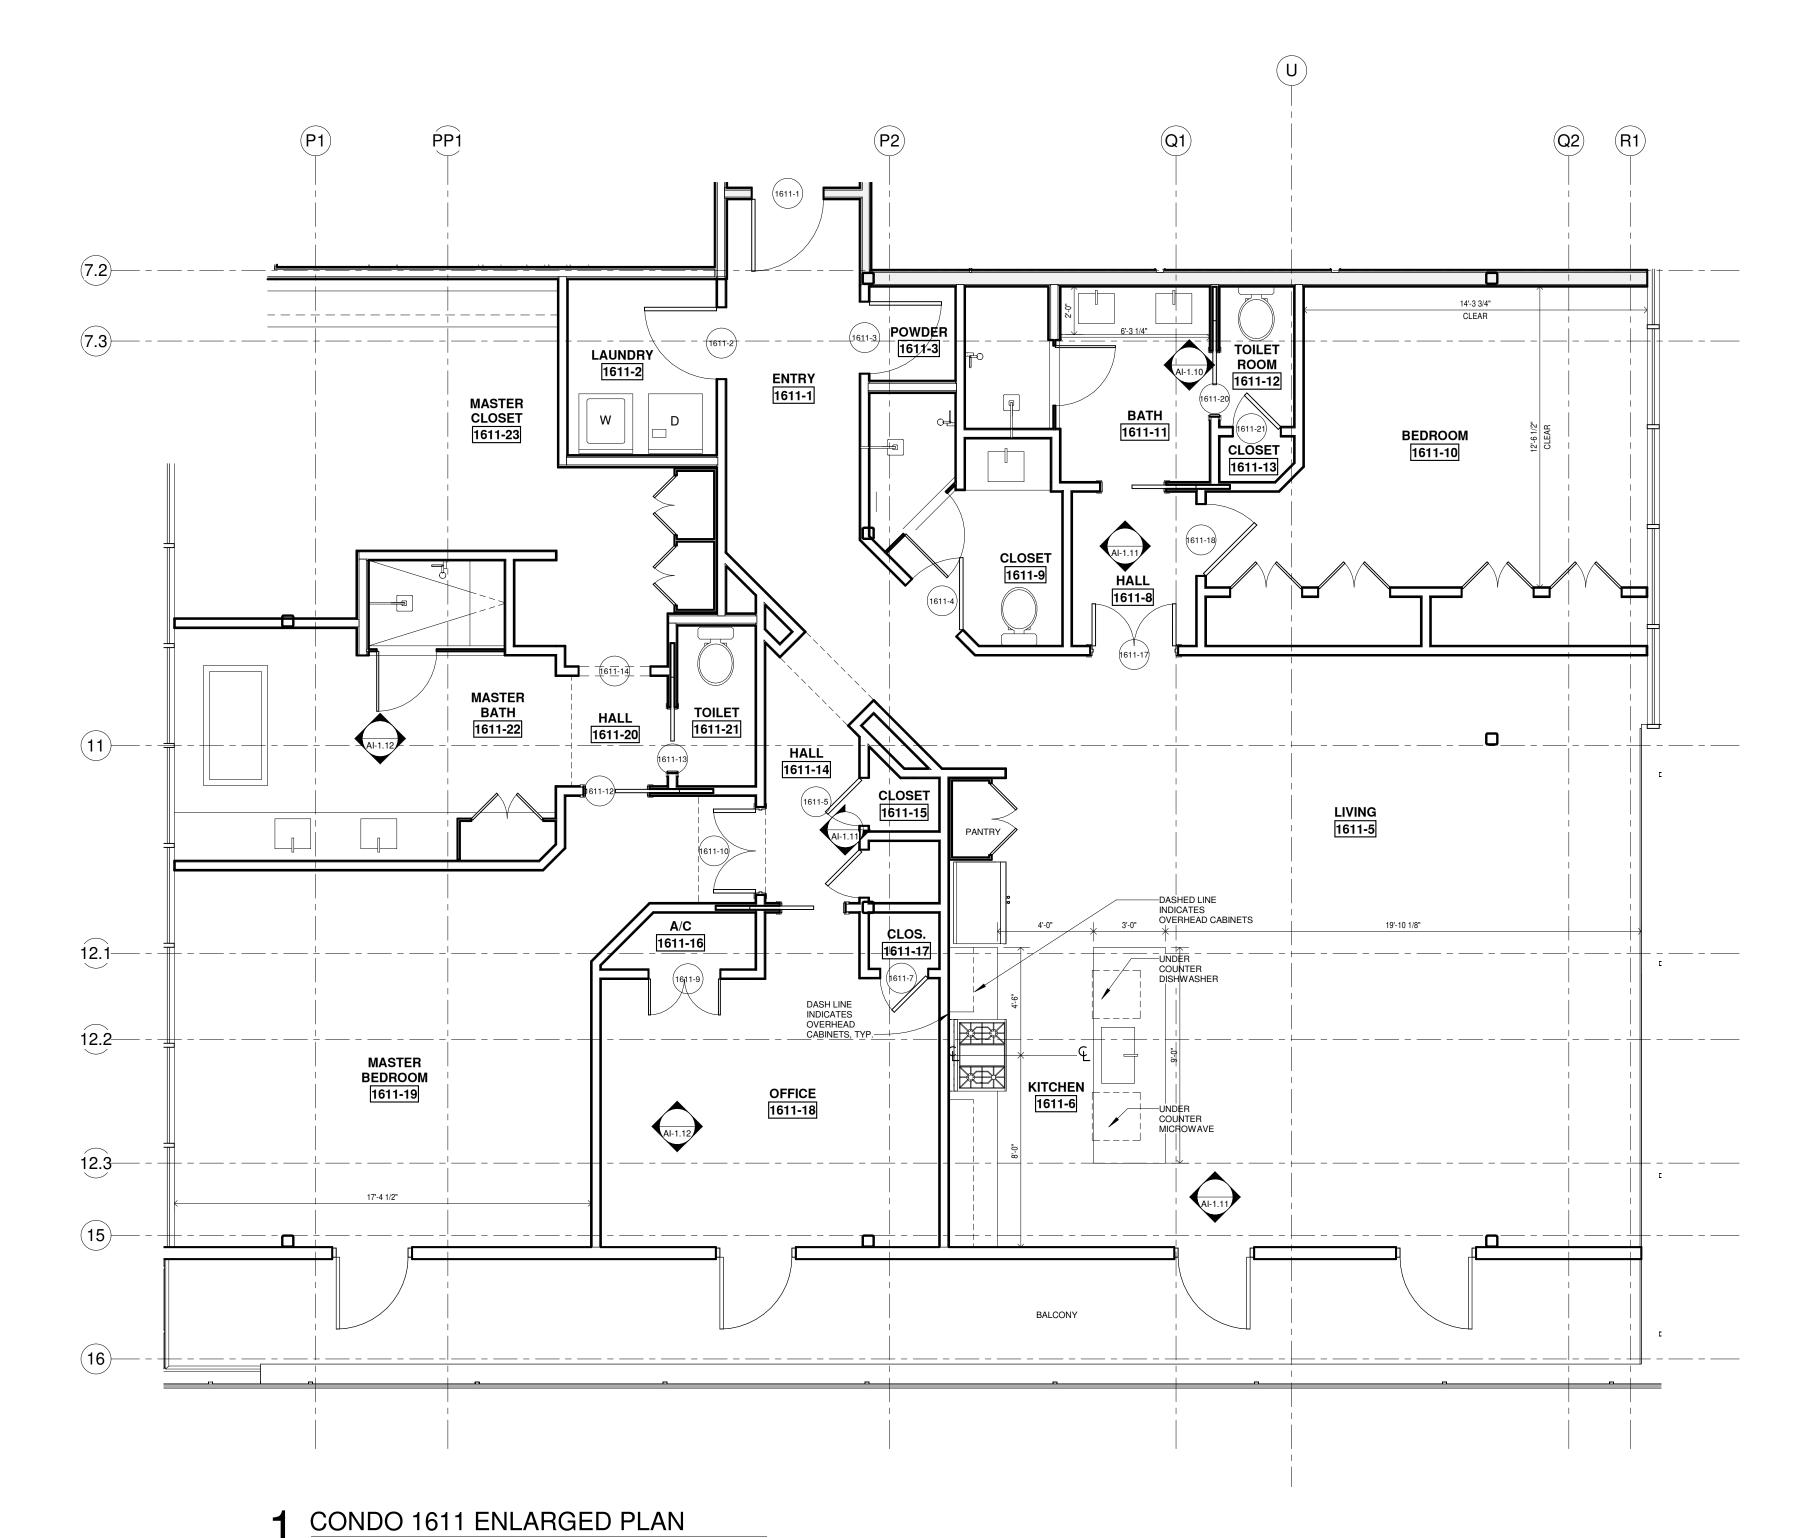

SCALE: 1/4" = 1'-0"

DOOR SCHEDULE - UNIT 1611 1611 BATH 2' - 6" 7' - 0" 0' - 1"

3' - 0" 8' - 0" 0' - 1 3/4" WD WD AA 1HR

3' - 0" 8' - 0" 0' - 1 3/4" WD WD AA

3' - 0" 8' - 0" 0' - 1 3/4" WD WD AA

3' - 0" 8' - 0" 0' - 1 3/4" WD WD AA

2' - 0" 8' - 0" 0' - 1 3/4" WD WD AA

2' - 0" 8' - 0" 0' - 1 3/4" WD WD CC

2' - 8" 8' - 0" 0' - 1 3/4" WD WD L **ENTRY** 1611-2 ENTRY LAUNDRY 1611-3 ENTRY POWDER 1611-4 CLOSET ENTRY 1611-5 CLOSET DOUBLE DOOR / PAIR 1611-6 OFFICE OFFICE 2' - 0" 8' - 0" 0' - 1 3/4" WD WD CC

A/C 3' - 0" 8' - 0" 0' - 1 3/4" WD WD CC

MASTER BEDROOM 3' - 6" 8' - 0" 0' - 1 3/4" WD WD CC

MASTER BEDROOM 2' - 8" 8' - 0" 0' - 1 3/4" WD WD L 1611-7 CLOS. 1611-9 OFFICE DOUBLE DOOR / PAIR 1611-10 HALL DOUBLE DOOR / PAIR 1611-12 HALL 2' - 8" 8' - 0" 0' - 1 3/4" WD WD TOILET 1611-13 HALL MASTER CLOSET 3' - 0" 8' - 0" 1611-14 HALL FRAMED OPENING 1611-17 LIVING 3' - 6" 8' - 0" 0' - 1 3/4" WD WD CC DOUBLE DOOR / PAIR 1611-18 HALL 3' - 0" 8' - 0" 0' - 1 3/4" WD WD AA BEDROOM 2' - 8" 8' - 0" 0' - 1 3/4" WD WD L 2' - 8" 8' - 0" 0' - 1 3/4" WD WD L 1611-19 BATH 1611-20 BATH TOILET ROOM 2' - 0" 8' - 0" 0' - 1 3/4" WD WD CC 1611-21 CLOSET TOILET ROOM

|         |                   |              | FINISH      | H SCHEDUI | _E - UNIT 1 | 611     |         |                |             |
|---------|-------------------|--------------|-------------|-----------|-------------|---------|---------|----------------|-------------|
| NUMBER  | NAME              | FLOOR FINISH | BASE FINISH | N. WALL   | S. WALL     | E. WALL | W. WALL | CEILING FINISH | CEILING HT. |
| 1611-1  | ENTRY             |              |             |           |             |         |         |                |             |
| 1611-2  | LAUNDRY           |              |             |           |             |         |         |                |             |
| 1611-3  | POWDER            |              |             |           |             |         |         |                |             |
| 1611-4  | WATER<br>HEATER   |              |             |           |             |         |         |                |             |
| 1611-5  | LIVING            |              |             |           |             |         |         |                |             |
| 1611-6  | KITCHEN           |              |             |           |             |         |         |                |             |
| 1611-7  | DINING            |              |             |           |             |         |         |                |             |
| 1611-8  | HALL              |              |             |           |             |         |         |                |             |
| 1611-9  | CLOSET            |              |             |           |             |         |         |                |             |
| 1611-10 | BEDROOM           |              |             |           |             |         |         |                |             |
| 1611-11 | BATH              |              |             |           |             |         |         |                |             |
| 1611-12 | TOILET<br>ROOM    |              |             |           |             |         |         |                |             |
| 1611-13 | CLOSET            |              |             |           |             |         |         |                |             |
| 1611-14 |                   |              |             |           |             |         |         |                |             |
|         | CLOSET            |              |             |           |             |         |         |                |             |
| 1611-16 | A/C               |              |             |           |             |         |         |                |             |
| 1611-17 |                   |              |             |           |             |         |         |                |             |
|         | OFFICE            |              |             |           |             |         |         |                |             |
| 1611-19 | MASTER<br>BEDROOM |              |             |           |             |         |         |                |             |
| 1611-20 |                   |              |             |           |             |         |         |                |             |
| 1611-21 | TOILET            |              |             |           |             |         |         |                |             |
| 1611-22 | MASTER<br>BATH    |              |             |           |             |         |         |                |             |
| 1611-23 | MASTER<br>CLOSET  |              |             |           |             |         |         |                |             |

1031 CANAL STREET NEW ORLEANS, LOUISIANA

189 Maple Ridge Drive Metairie, LA 70001 (504)-885-4477 central@hbsaii.com :-: hbsaii.com

SINCE 1961


BEEN PREPARED BY ME OR UNDER MY
CLOSE PERSONAL SUPERVISION AND TO
THE BEST OF MY KNOWLEDGE AND
BELIEF THEY COMPLY WITH ALL CITY,
STATE AND FEDERAL REQUIREMENTS, AND
I AM NOT PROVIDING CONTRACT CERTIFIED CORRECT

| 1 L.I.S. #2 - CLOUD REVISION 1 2 L.I.S. #2 - CLOUD REVISION 2 3 L.I.S. #2 - CLOUD REVISION 4 4 L.I.S. #2 - CLOUD REVISION 4 5 L.I.S. #2 - CLOUD REVISION 5 6 L.I.S. #2 - CLOUD REVISION 6 7 L.I.S. #2 - CLOUD REVISION 7 8 6/1/2018 8 |  |                              |                              |                              |                              |                              |                              |                              |   |
|---|--|------------------------------|------------------------------|------------------------------|------------------------------|------------------------------|------------------------------|------------------------------|---|
| L.I.S. #2 - CLOUD REVISION 1 L.I.S. #2 - CLOUD REVISION 2 L.I.S. #2 - CLOUD REVISION 3 L.I.S. #2 - CLOUD REVISION 4 L.I.S. #2 - CLOUD REVISION 6 L.I.S. #2 - CLOUD REVISION 6 L.I.S. #2 - CLOUD REVISION 7                            |  |                              | R                            | EVIS                         | NOI                          | HIS                          | TOR                          | Υ                            |   |
|   |  | 4/27/2018                    | 5/4/2018                     | 5/11/2018                    | 5/18/2018                    | 5/25/2018                    | 6/1/2018                     | 6/8/2018                     |   |
|   |  | L.I.S. #2 - CLOUD REVISION 1 | L.I.S. #2 - CLOUD REVISION 2 | L.I.S. #2 - CLOUD REVISION 3 | L.I.S. #2 - CLOUD REVISION 4 | L.I.S. #2 - CLOUD REVISION 5 | L.I.S. #2 - CLOUD REVISION 6 | L.I.S. #2 - CLOUD REVISION 7 |   |
|   |  | -                            | 2                            | က                            | 4                            | 2                            | 9                            | 7                            | ω |

CONDO 1611


PROJECT#: 1709 PHASE: DD TEAM: Author CHECKE<u>R: Check</u>er SCALE: AS NOTED

ISSUED: 4/20/2018

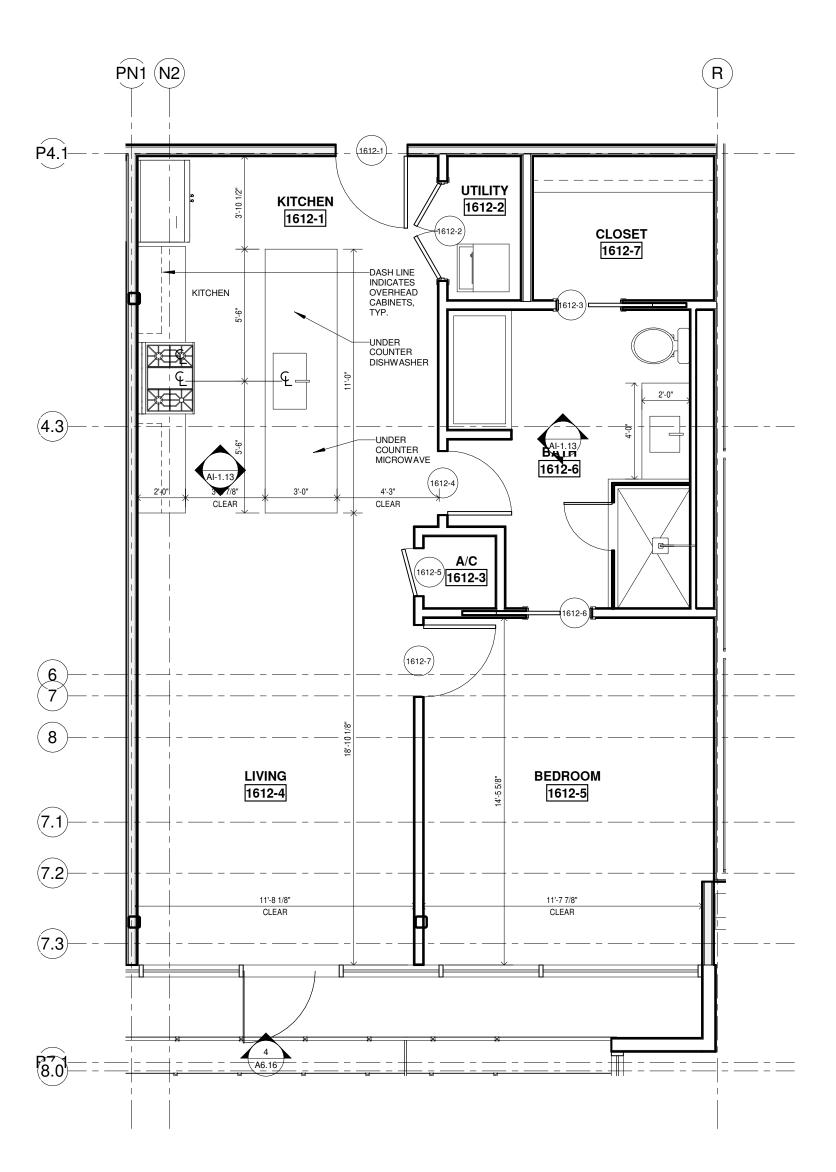

CONDO 1612 ENLARGED PLAN

SCALE: 1/4" = 1'-0"

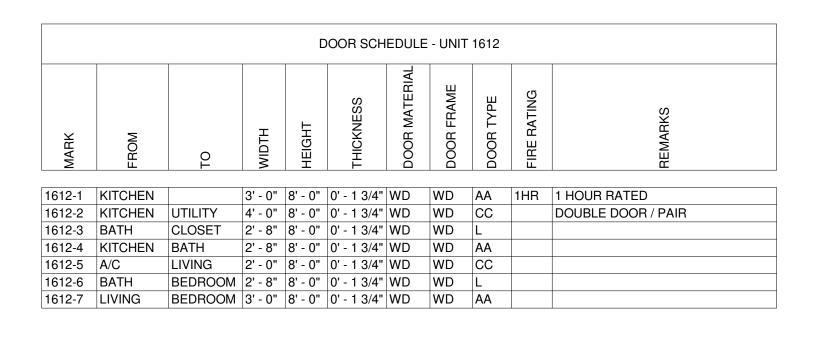

|        |         |              | FINISH      | SCHEDUL | E - UNIT 1 | 612     |         |                |             |
|--------|---------|--------------|-------------|---------|------------|---------|---------|----------------|-------------|
| NUMBER | NAME    | FLOOR FINISH | BASE FINISH | N. WALL | S. WALL    | E. WALL | W. WALL | CEILING FINISH | CEILING HT. |
| 1612-1 | KITCHEN |              |             |         |            |         |         |                |             |
| 1612-2 | UTILITY |              |             |         |            |         |         |                |             |
| 1612-3 | A/C     |              |             |         |            |         |         |                |             |
| 1612-4 | LIVING  |              |             |         |            |         |         |                |             |
| 1612-5 | BEDROOM |              |             |         |            |         |         |                |             |
| 1612-6 | BATH    |              |             |         |            |         |         |                |             |
| 1612-7 | CLOSET  |              |             |         |            |         |         |                |             |

HARRY
BAKER
SMITH
SMITH
ARCHITECTS II
P L C

189 Maple Ridge Drive Metairie, LA 70001
(504)-885-4477
central@hbsaii.com :: hbsaii.com
SINCE 1961

HARD ROCK HOTT 1031 CANAL STREET NEW ORLEANS, LOUISIANA

THESE PLANS AND SPECIFICATIONS HAVE BEEN PREPARED BY ME OR UNDER MY CLOSE PERSONAL SUPERVISION AND TO THE BEST OF MY KNOWLEDGE AND BELIEF THEY COMPLY WITH ALL CITY, STATE AND FEDERAL REQUIREMENTS, AND I AM NOT PROVIDING CONTRACT ADMINISTRATION.

CERTIFIED CORRECT



THIS DRAWING IS CONFIDENTIAL AND
NOT BE LOANED, REPRODUCED, COPIED,
EITHER WHOLLY OR IN PART, OR MADE
PUBLIC IN ANY MANNER WITHOUT THE
WRITTEN CONSENT OF HBSA II ARCHITECTS
A PROFESSIONAL L.L.C. ALL RIGHTS OF
DESIGN OR INVENTION ARE RESERVED AND
WILL REMAIN THE SOLE PROPERTY OF HBSA


| - | L.I.S. #2 - CLOUD REVISION 1 | 4/27/2018 |      | II ARI |
|---|------------------------------|-----------|------|--------|
| 2 | L.I.S. #2 - CLOUD REVISION 2 | 5/4/2018  | R    | JHIIE  |
| 3 | L.I.S. #2 - CLOUD REVISION 3 | 5/11/2018 | EVIS | .015   |
| 4 | L.I.S. #2 - CLOUD REVISION 4 | 5/18/2018 | SION | A FR   |
| 5 | L.I.S. #2 - CLOUD REVISION 5 | 5/25/2018 | HIS  | OI LJ. |
| 9 | L.I.S. #2 - CLOUD REVISION 6 | 6/1/2018  | TOR  | SIUNA  |
| 7 | L.I.S. #2 - CLOUD REVISION 7 | 6/8/2018  | Υ    | L L.L. |
| 8 |                              |           |      |        |

CONDO 1612

PROJECT#: 1709
PHASE: DD
TEAM: Author
CHECKER: Checker
SCALE: AS NOTED

ISSUED: 4/20/2018
SHEET#:

AI-1.35

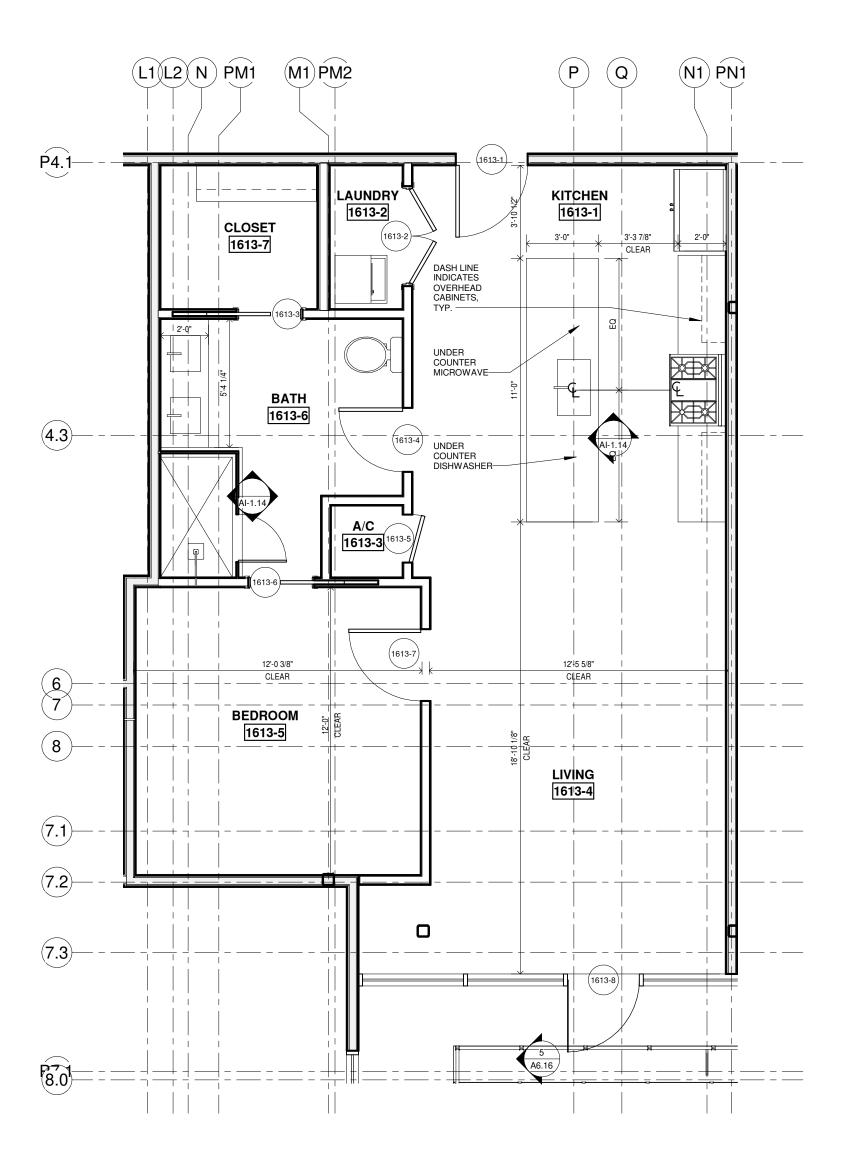

CONDO 1613 ENLARGED PLAN SCALE: 1/4" = 1'-0"

|        | DOOR SCHEDULE - UNIT 1613 |         |         |         |             |               |            |           |             |                    |  |  |  |
|--------|---------------------------|---------|---------|---------|-------------|---------------|------------|-----------|-------------|--------------------|--|--|--|
| MARK   | FROM                      | ОТ      | WIDTH   | неіднт  | THICKNESS   | DOOR MATERIAL | DOOR FRAME | DOOR TYPE | FIRE RATING | REMARKS            |  |  |  |
| 1613-1 |                           | KITCHEN | 0' 0"   | 0' 0"   | 0' - 1 3/4" | WD            | WD         | Δ.Δ.      | 1HR         | 1 HOUR DATED       |  |  |  |
|        |                           |         |         |         |             |               | WD         | AA        | IHK         | 1 HOUR RATED       |  |  |  |
| 1613-2 | LAUNDRY                   | KITCHEN | 4' - 0" | 8' - 0" | 0' - 1 3/4" | WD            | WD         | CC        |             | DOUBLE DOOR / PAIR |  |  |  |
| 1613-3 | CLOSET                    | BATH    | 2' - 8" | 8' - 0" | 0' - 1 3/4" | WD            | WD         | L         |             |                    |  |  |  |
| 1613-4 | KITCHEN                   | BATH    | 2' - 8" | 8' - 0" | 0' - 1 3/4" | WD            | WD         | AA        |             |                    |  |  |  |
| 1613-5 | A/C                       | KITCHEN | 2' - 0" | 8' - 0" | 0' - 1 3/4" | WD            | WD         | CC        |             |                    |  |  |  |
| 1613-6 | BATH                      | BEDROOM | 2' - 8" | 8' - 0" | 0' - 1 3/4" | WD            | WD         | L         |             |                    |  |  |  |
| 1613-7 | BEDROOM                   | LIVING  | 3' - 0" | 8' - 0" | 0' - 1 3/4" | WD            | WD         | AA        |             |                    |  |  |  |
| 1613-8 | LIVING                    |         | 3' - 0" | 8' - 2" | 0' - 1 1/2" | AL/GL         | AL         | K         |             |                    |  |  |  |

|        | FINISH SCHEDULE - UNIT 1613 |              |             |         |         |         |         |                |             |
|--------|-----------------------------|--------------|-------------|---------|---------|---------|---------|----------------|-------------|
| NUMBER | NAME                        | FLOOR FINISH | BASE FINISH | N. WALL | S. WALL | E. WALL | W. WALL | CEILING FINISH | CEILING HT. |
|        |                             |              |             |         |         |         |         |                |             |
| 1613-1 | KITCHEN                     |              |             |         |         |         |         |                |             |
| 1613-2 | LAUNDRY                     |              |             |         |         |         |         |                |             |
| 1613-3 | A/C                         |              |             |         |         |         |         |                |             |
| 1613-4 | LIVING                      |              |             |         |         |         |         |                |             |
| 1613-5 | BEDROOM                     |              |             |         |         |         |         |                |             |
| 1613-6 | BATH                        |              |             |         |         |         |         |                |             |
| 1613-7 | CLOSET                      |              |             |         |         |         |         |                |             |

189 Maple Ridge Drive Metairie, LA 70001 (504)-885-4477 central@hbsaii.com :-: hbsaii.com SINCE 1961


1031 CANAL STREET NEW ORLEANS, LOUISIANA

THESE PLANS AND SPECIFICATIONS HAVE BEEN PREPARED BY ME OR UNDER MY CLOSE PERSONAL SUPERVISION AND TO THE BEST OF MY KNOWLEDGE AND BELIEF THEY COMPLY WITH ALL CITY, STATE AND FEDERAL REQUIREMENTS, AND I AM NOT PROVIDING CONTRACT ADMINISTRATION. CERTIFIED CORRECT



| II ARG                       | ARCHITEC                    |                              |                              |                              |                              |                              |  |
|------------------------------|-----------------------------|------------------------------|------------------------------|------------------------------|------------------------------|------------------------------|--|
|                              | RE                          | VIS                          | ION                          | HIS                          | TOR                          | Y                            |  |
| 4/27/2018                    | 5/4/2018                    | 5/11/2018                    | 5/18/2018                    | 5/25/2018                    | 6/1/2018                     | 6/8/2018                     |  |
| L.I.S. #2 - CLOUD REVISION 1 | LI.S. #2 - CLOUD REVISION 2 | L.I.S. #2 - CLOUD REVISION 3 | L.I.S. #2 - CLOUD REVISION 4 | L.I.S. #2 - CLOUD REVISION 5 | L.I.S. #2 · CLOUD REVISION 6 | L.I.S. #2 - CLOUD REVISION 7 |  |

CONDO 1613

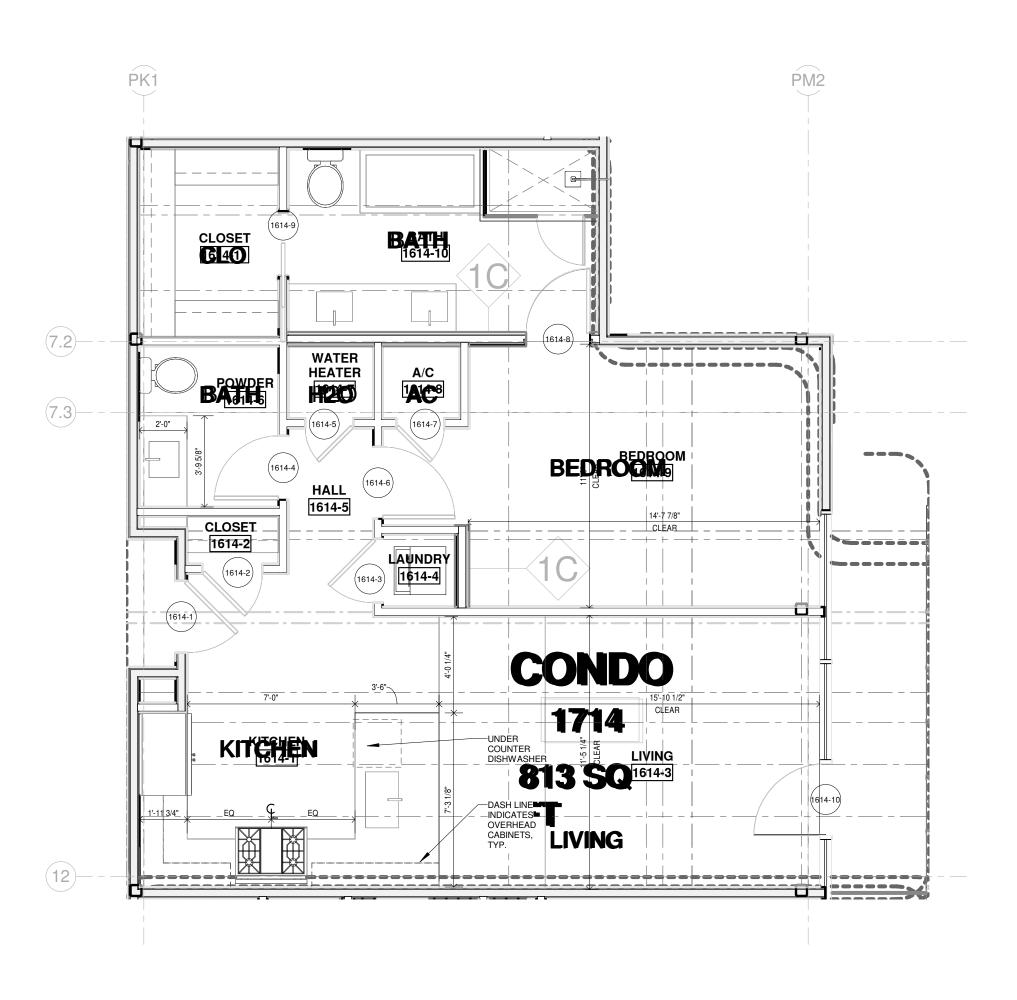

|         | DOOR SCHEDULE - UNIT 1614 |                 |         |         |             |               |            |           |             |         |
|---------|---------------------------|-----------------|---------|---------|-------------|---------------|------------|-----------|-------------|---------|
| MARK    | FROM                      | 40              | WIDTH   | HEIGHT  | THICKNESS   | DOOR MATERIAL | DOOR FRAME | DOOR TYPE | FIRE RATING | REMARKS |
|         | T                         |                 |         |         | Tax 4 0/40  |               | 1          |           | T           |         |
| 1614-1  |                           | KITCHEN         | 3' - 0" | 8' - 0" | 0' - 1 3/4" | WD            | НМ         | С         | 1HR         |         |
| 1614-2  | CLOSET                    | KITCHEN         | 2' - 6" | 8' - 0" | 0' - 1 3/4" | WD            | WD         | CC        |             |         |
| 1614-3  | LAUNDRY                   | HALL            | 2' - 8" | 8' - 0" | 0' - 1 3/4" | WD            | WD         | AA        |             |         |
| 1614-4  | HALL                      | POWDER          | 2' - 8" | 8' - 0" | 0' - 1 3/4" | WD            | WD         | AA        |             |         |
| 1614-5  | HALL                      | WATER<br>HEATER | 2' - 0" | 8' - 0" | 0' - 1 3/4" | WD            | WD         | CC        |             |         |
| 1614-6  | HALL                      | BEDROOM         | 3' - 0" | 8' - 0" | 0' - 1 3/4" | WD            | НМ         | AA        |             |         |
| 1614-7  | A/C                       | BEDROOM         | 2' - 0" | 8' - 0" | 0' - 1 3/4" | WD            | WD         | CC        |             |         |
| 1614-8  | BEDROOM                   | BATH            | 2' - 8" | 8' - 0" | 0' - 1 3/4" | WD            | WD         | AA        |             |         |
| 1614-9  | CLOSET                    | BATH            | 2' - 8" | 8' - 0" | 0' - 1 3/4" | WD            | WD         | L         |             |         |
| 1614-10 |                           | LIVING          | 3' - 0" | 8' - 2" | 0' - 1 1/2" | AL/GL         | AL         | K         |             |         |

|         | FINISH SCHEDULE - UNIT 1614 |              |             |         |         |         |         |                |             |
|---------|-----------------------------|--------------|-------------|---------|---------|---------|---------|----------------|-------------|
| NUMBER  | NAME                        | FLOOR FINISH | BASE FINISH | N. WALL | S. WALL | E. WALL | W. WALL | CEILING FINISH | CEILING HT. |
|         |                             |              |             |         |         |         |         |                |             |
| 1614-1  | KITCHEN                     |              |             |         |         |         |         |                |             |
| 1614-2  | CLOSET                      |              |             |         |         |         |         |                |             |
| 1614-3  | LIVING                      |              |             |         |         |         |         |                |             |
| 1614-4  | LAUNDRY                     |              |             |         |         |         |         |                |             |
| 1614-5  | HALL                        |              |             |         |         |         |         |                |             |
| 1614-6  | POWDER                      |              |             |         |         |         |         |                |             |
| 1614-7  | WATER<br>HEATER             |              |             |         |         |         |         |                |             |
| 1614-8  | A/C                         |              |             |         |         |         |         |                |             |
| 1614-9  | BEDROOM                     |              |             |         |         |         |         |                |             |
| 1614-10 | BATH                        |              |             |         |         |         |         |                |             |
| 1614-11 | CLOSET                      |              |             |         |         |         |         |                |             |

CONDO 1614 ENLARGED PLAN

SCALE: 1/4" = 1'-0"

ARCHITECTS II
PLLG

189 Maple Ridge Drive Metairie, LA 70001
(504)-885-4477
central@hbsaii.com :: hbsaii.com
SINCE 1961

1031 CANAL STREET
NEW ORLEANS, LOUISIANA

THESE PLANS AND SPECIFICATIONS HAVE
BEEN PREPARED BY ME OR UNDER MY
CLOSE PERSONAL SUPERVISION AND TO
THE BEST OF MY KNOWLEDGE AND
BELIEF THEY COMPLY WITH ALL CITY,
STATE AND FEDERAL REQUIREMENTS, AND
I AM NOT PROVIDING CONTRACT
ADMINISTRATION.
CERTIFIED CORRECT



THIS DRAWING IS CONFIDENTIAL AND NOT BE LOANED, REPRODUCED, COPIED, EITHER WHOLLY OR IN PART, OR MADE PUBLIC IN ANY MANNER WITHOUT THE WRITTEN CONSENT OF HBSA II ARCHITECTS, A PROFESSIONAL L.L.C. ALL RIGHTS OF DESIGN OR INVENTION ARE RESERVED AND WILL REMAIN THE SOLE PROPERTY OF HBSA II ARCHITECTS A PROFESSIONAL L.L.C.


|                              | R                            | EVIS                         | SION                         | HIS                          | TOR                          | Υ                            |   |
|------------------------------|------------------------------|------------------------------|------------------------------|------------------------------|------------------------------|------------------------------|---|
| 4/27/2018                    | 5/4/2018                     | 5/11/2018                    | 5/18/2018                    | 5/25/2018                    | 6/1/2018                     | 6/8/2018                     |   |
| L.I.S. #2 - CLOUD REVISION 1 | L.I.S. #2 - CLOUD REVISION 2 | L.I.S. #2 - CLOUD REVISION 3 | L.I.S. #2 - CLOUD REVISION 4 | L.I.S. #2 - CLOUD REVISION 5 | L.I.S. #2 - CLOUD REVISION 6 | L.I.S. #2 - CLOUD REVISION 7 |   |
| -                            | 2                            | ဇ                            | 4                            | 2                            | 9                            | 7                            | 8 |

CONDO 1614

PROJECT#: 1709
PHASE: DD
TEAM: Author
CHECKER: Checker
SCALE: AS NOTED

ISSUED: 4/20/2018
SHEET#:

AI-1.37

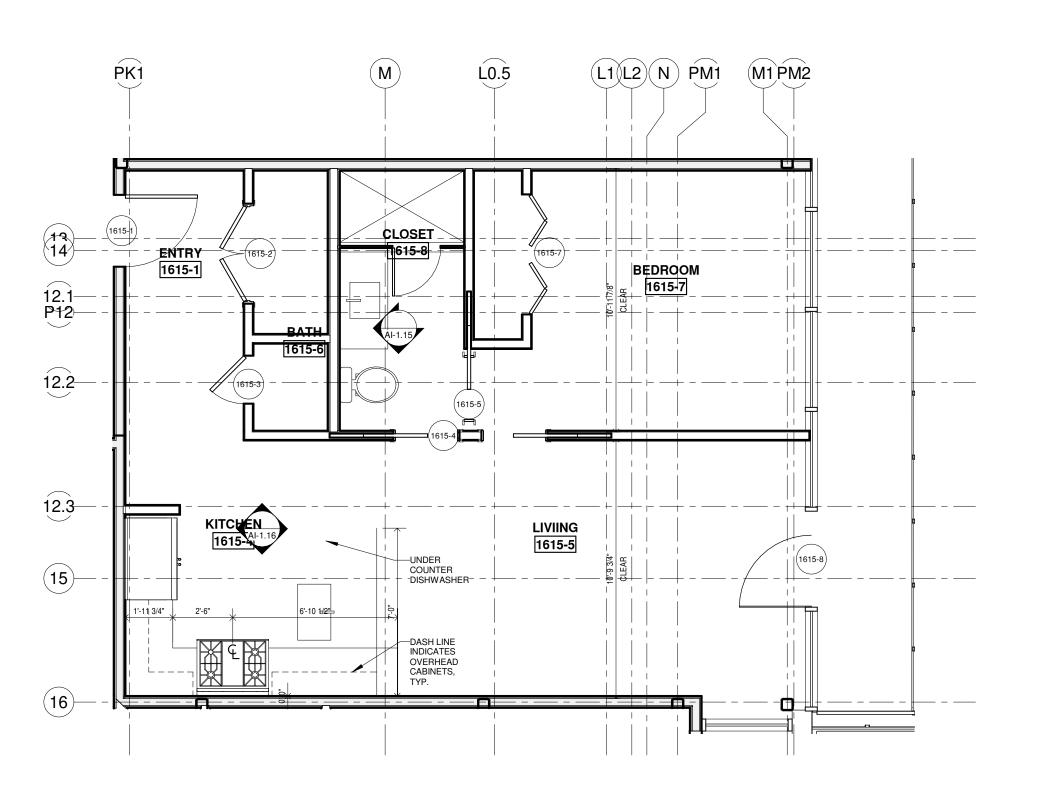

| DOOR SCHEDULE - UNIT 1615 |         |                    |                    |                    |                            |               |            |             |             |                    |
|---------------------------|---------|--------------------|--------------------|--------------------|----------------------------|---------------|------------|-------------|-------------|--------------------|
| MARK                      | FROM    | ТО                 | WIDTH              | неіднт             | THICKNESS                  | DOOR MATERIAL | DOOR FRAME | DOOR TYPE   | FIRE RATING | REMARKS            |
|                           |         |                    |                    |                    |                            |               |            |             |             |                    |
| 615-1                     |         | ENTRY              | 3' - 0"            | 8' - 0"            | 0' - 1 3/4"                | WD            | WD         | AA          | 1HR         |                    |
| 615-2 I                   | ENTRY   |                    | 4' - 0"            | 8' - 0"            | 0' - 1 3/4"                | WD            | WD         | CC          |             | DOUBLE DOOR / PAIR |
| 615-3 E                   | BATH    | ENTRY              | 2' - 0"            | 8' - 0"            | 0' - 1 3/4"                | WD            | WD         | CC          |             |                    |
| 615-4 l                   | LIVIING | BEDROOM            | 2' - 8"            | 8' - 0"            | 0' - 1 3/4"                | WD            | WD         | L           |             |                    |
| 615-5 E                   | BEDROOM | BEDROOM            | 2' - 8"            | 8' - 0"            | 0' - 1 3/4"                | WD            | WD         | L           |             |                    |
| 615-7                     |         | BEDROOM            | 5' - 0"            | 8' - 0"            | 0' - 1 1/2"                | WD            | WD         | L           |             |                    |
| 615-8                     |         | LIVIING            | 4' - 0"            | 8' - 2"            | 0' - 1 1/2"                | AL/GL         | AL         | K           |             |                    |
| 615-5 E                   |         | BEDROOM<br>BEDROOM | 2' - 8"<br>5' - 0" | 8' - 0"<br>8' - 0" | 0' - 1 3/4"<br>0' - 1 1/2" | WD<br>WD      | WD<br>WD   | L<br>L<br>K |             |                    |

|        | FINISH SCHEDULE - UNIT 1615 |              |             |         |         |         |         |                |             |
|--------|-----------------------------|--------------|-------------|---------|---------|---------|---------|----------------|-------------|
| NUMBER | NAME                        | FLOOR FINISH | BASE FINISH | N. WALL | S. WALL | E. WALL | W. WALL | CEILING FINISH | CEILING HT. |
| 1015 1 | ENTEN                       |              |             |         |         |         |         |                |             |
| 1615-1 | ENTRY                       |              |             |         |         |         |         |                |             |
| 1615-2 | UTILITY                     |              |             |         |         |         |         |                |             |
| 1615-3 | A/C                         |              |             |         |         |         |         |                |             |
| 1615-4 | KITCHEN                     |              |             |         |         |         |         |                |             |
| 1615-5 | LIVIING                     |              |             |         |         |         |         |                |             |
| 1615-6 | BATH                        |              |             |         |         |         |         |                |             |
| 1615-7 | BEDROOM                     |              |             |         |         |         |         |                |             |
| 1615-8 | CLOSET                      |              |             |         |         |         |         |                |             |

CONDO 1615 ENLARGED PLAN SCALE: 1/4" = 1'-0"

1031 CANAL STREET NEW ORLEANS, LOUISIANA

189 Maple Ridge Drive Metairie, LA 70001 (504)-885-4477 central@hbsaii.com :: hbsaii.com

SINCE 1961


THESE PLANS AND SPECIFICATIONS HAVE BEEN PREPARED BY ME OR UNDER MY CLOSE PERSONAL SUPERVISION AND TO THE BEST OF MY KNOWLEDGE AND BELIEF THEY COMPLY WITH ALL CITY, STATE AND FEDERAL REQUIREMENTS, AND I AM NOT PROVIDING CONTRACT ADMINISTRATION. CERTIFIED CORRECT



|                              | R                            | EVIS                         | SION                         | HIS                          | TOR                          | Υ                            |   |
|------------------------------|------------------------------|------------------------------|------------------------------|------------------------------|------------------------------|------------------------------|---|
| 4/27/2018                    | 5/4/2018                     | 5/11/2018                    | 5/18/2018                    | 5/25/2018                    | 6/1/2018                     | 6/8/2018                     |   |
|                              |                              |                              |                              |                              |                              |                              |   |
|                              |                              |                              |                              |                              |                              |                              |   |
| -                            | 8                            | ဇ                            | 4                            | 2                            | 9                            | 7                            |   |
| REVISION                     |   |
| L.I.S. #2 - CLOUD REVISION 1 | L.I.S. #2 - CLOUD REVISION 2 | L.I.S. #2 - CLOUD REVISION 3 | L.I.S. #2 - CLOUD REVISION 4 | L.I.S. #2 - CLOUD REVISION 5 | L.I.S. #2 - CLOUD REVISION 6 | L.I.S. #2 - CLOUD REVISION 7 |   |
| L.I.S. #                     | L.I.S.#                      | L.I.S. #                     |   |
| -                            | 2                            | က                            | 4                            | 2                            | 9                            | 7                            | 8 |

CONDO 1615

PROJECT#: 1709
PHASE: DD
TEAM: Author
CHECKER: Checker
SCALE: AS NOTED
ISSUED: 4/20/2018
SHEET#:
Al-1.38

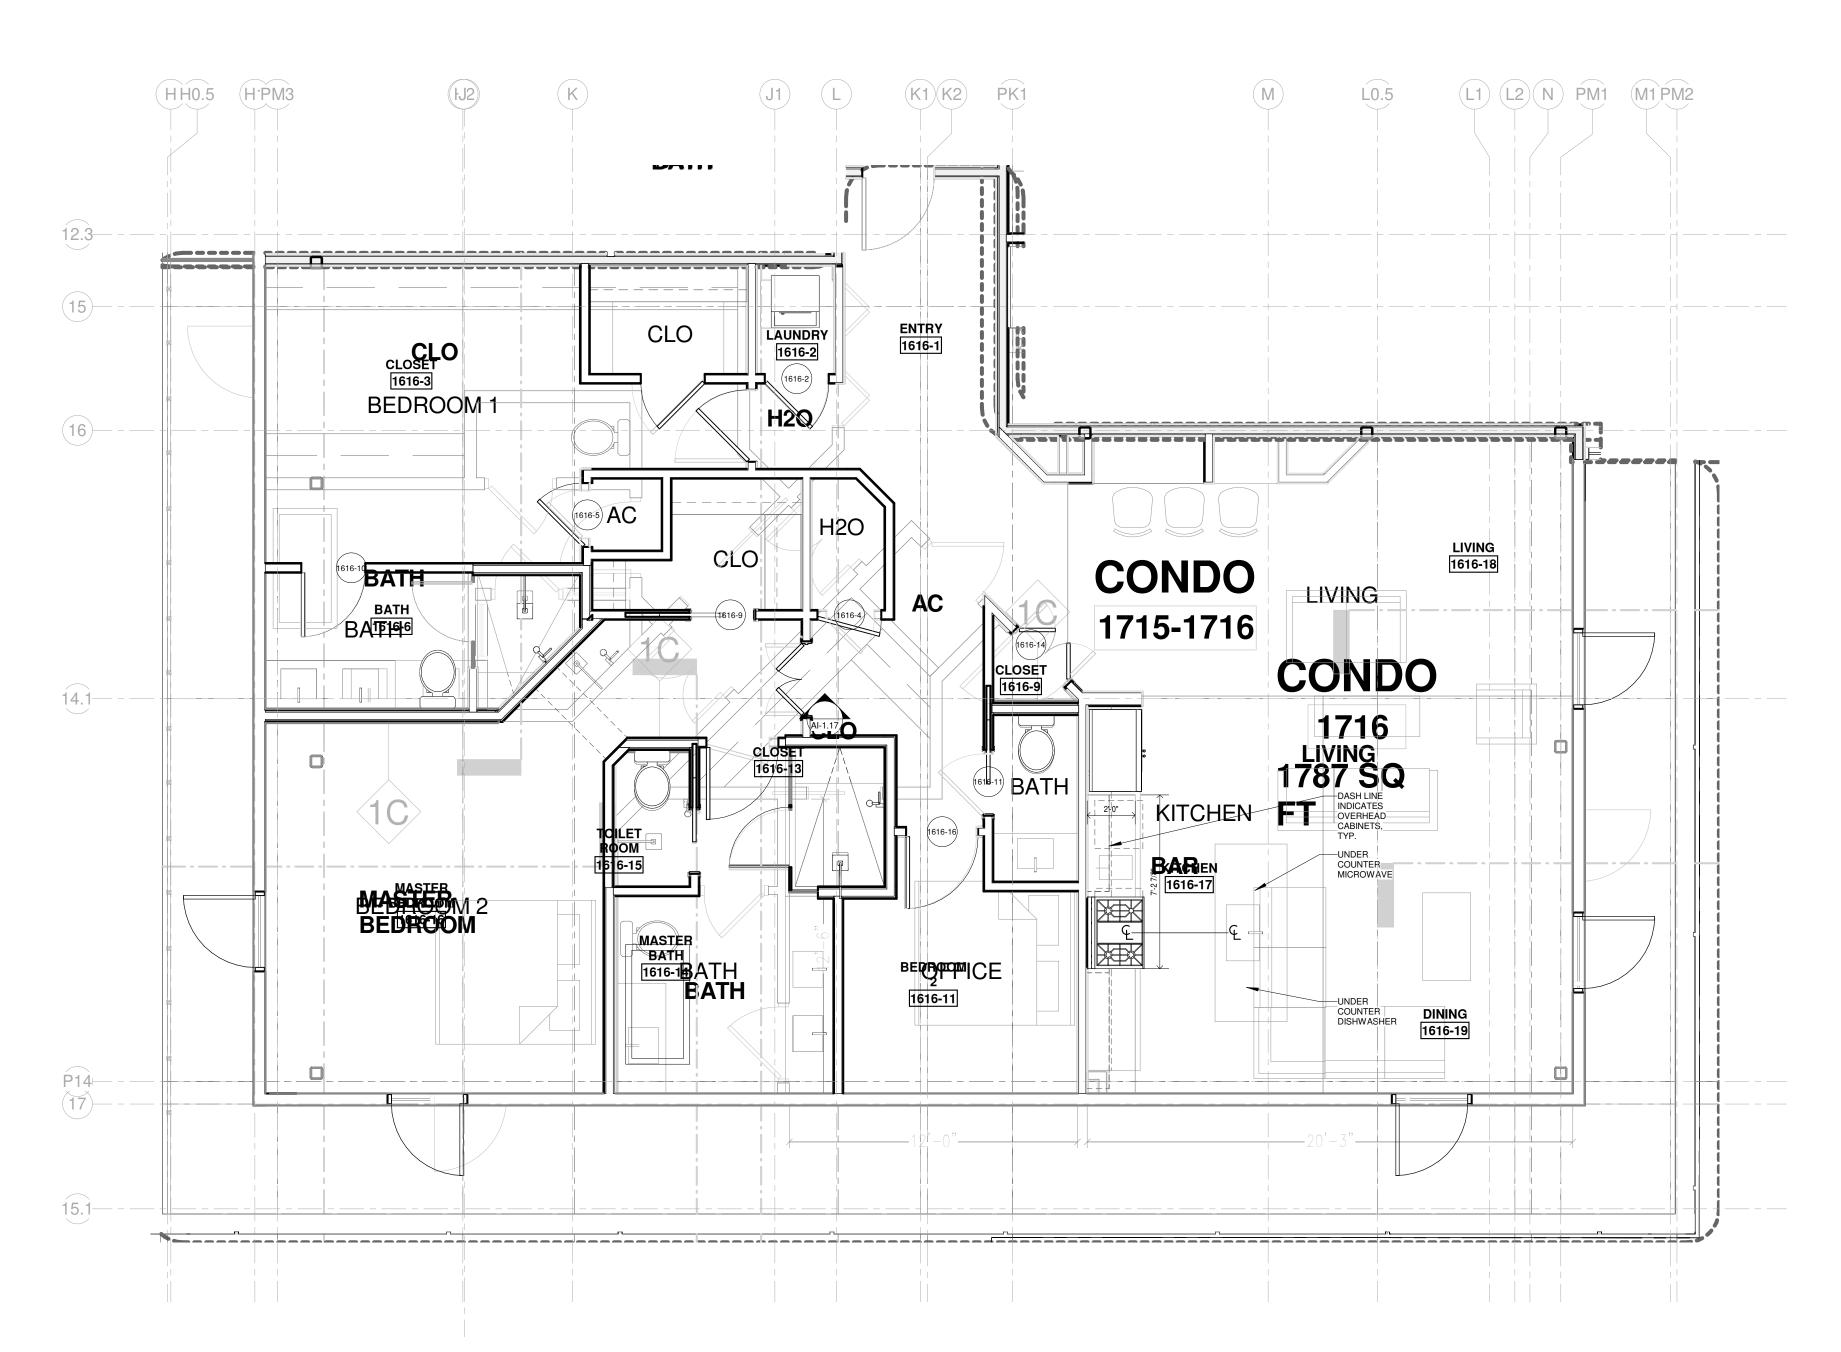

|  | DOOR SCHEDULE - UNIT 1616 |                |         |         |             |    |         |    |  |  |
|--|---------------------------|----------------|---------|---------|-------------|----|---------|----|--|--|
| MARK FROM TO TO THICKNESS DOOR FRAME DOOR TYPE FIRE RATING FIRE RATING |                           |                |         |         |             |    | REMARKS |    |  |  |
| 1616-2   | LAUNDRY                   | ENTRY          | 2' - 8" | 0' 0"   | 0' - 1 3/4" | WD | WD      | AA |  |  |
|  | LAUNDAT                   | ENINI          | 2' - 8" |         | 0' - 1 3/4" |    | WD      |    |  |  |
| 1616-4   |                           | OL OOFT        |         |         |             |    |         | AA |  |  |
| 1616-5   |                           | CLOSET         | 2' - 8" |         | 0' - 1 3/4" |    | WD      | CC |  |  |
| 1616-9   |                           | MASTER BEDROOM | 2' - 8" |         | 0' - 1 3/4" |    | WD      | CC |  |  |
| 1616-10  | BATH                      | CLOSET         | 2' - 8" | 8' - 0" | 0' - 1 3/4" | WD | WD      | L  |  |  |
| 1616-11  |                           |                | 2' - 8" | 8' - 0" | 0' - 1 3/4" | WD | WD      | AA |  |  |
| 1616-14  | CLOSET                    | ENTRY          | 3' - 0" | 8' - 0" | 0' - 1 3/4" | WD | WD      | CC |  |  |
| 1616-16  | BEDROOM 2                 |                | 3' - 0" | 8' - 0" | 0' - 1 3/4" | WD | WD      | AA |  |  |

|         | FINISH SCHEDULE - UNIT 1616 |              |             |         |         |         |         |                |             |
|---------|-----------------------------|--------------|-------------|---------|---------|---------|---------|----------------|-------------|
| NUMBER  | NAME                        | FLOOR FINISH | BASE FINISH | N. WALL | S. WALL | E. WALL | W. WALL | CEILING FINISH | CEILING HT. |
| 1616-1  | ENTRY                       |              |             | I       |         |         |         |                | 1           |
| 1616-2  | LAUNDRY                     |              |             |         |         |         |         |                |             |
| 1616-3  | CLOSET                      |              |             |         |         |         |         |                |             |
| 1616-4  | BEDROOM                     |              |             |         |         |         |         |                |             |
| 1616-5  | A/C                         |              |             |         |         |         |         |                |             |
| 1616-6  | BATH                        |              |             |         |         |         |         |                |             |
| 1616-7  | HALL                        |              |             |         |         |         |         |                |             |
| 1616-8  | WATER HEATER                |              |             |         |         |         |         |                |             |
| 1616-9  | CLOSET                      |              |             |         |         |         |         |                |             |
| 1616-10 | POWDER                      |              |             |         |         |         |         |                |             |
| 1616-11 | BEDROOM 2                   |              |             |         |         |         |         |                |             |
| 1616-12 | HALL                        |              |             |         |         |         |         |                |             |
| 1616-13 | CLOSET                      |              |             |         |         |         |         |                |             |
| 1616-14 | MASTER BATH                 |              |             |         |         |         |         |                |             |
| 1616-15 | TOILET ROOM                 |              |             |         |         |         |         |                |             |
|         | MASTER BEDROOM              |              |             |         |         |         |         |                |             |
|         | KITCHEN                     |              |             |         |         |         |         |                |             |
| 1616-18 |                             |              |             |         |         |         |         |                |             |
| 1616-19 | DINING                      |              |             |         |         |         |         |                |             |

1 CONDO 1616 ENLARGED PLAN
SCALE: 1/4" = 1'-0"

HARRY
BAKER
SMITH
SMITH
ARCHITECTS II
PLC

189 Maple Ridge Drive Metairie, LA 70001
(504)-885-4477
central@hbsaii.com :: hbsaii.com
SINCE 1961

2D ROCK HOTE 1031 CANAL STREET NEW ORLEANS, LOUISIANA

THESE PLANS AND SPECIFICATIONS HAVE
BEEN PREPARED BY ME OR UNDER MY
CLOSE PERSONAL SUPERVISION AND TO
THE BEST OF MY KNOWLEDGE AND
BELIEF THEY COMPLY WITH ALL CITY,
STATE AND FEDERAL REQUIREMENTS, AND
I AM NOT PROVIDING CONTRACT
ADMINISTRATION.
CERTIFIED CORRECT




THIS DRAWING IS CONFIDENTIAL AND
NOT BE LOANED, REPRODUCED, COPIED,
EITHER WHOLLY OR IN PART, OR MADE
PUBLIC IN ANY MANNER WITHOUT THE
WRITTEN CONSENT OF HBSA II ARCHITECTS,
A PROFESSIONAL L.L.C. ALL RIGHTS OF
DESIGN OR INVENTION ARE RESERVED AND
WILL REMAIN THE SOLE PROPERTY OF HBSA
III ARCHITECTS A PROFESSIONAL I.I.C.

|  |                              | R                            | EVIS                         | ION                          | HIS                          | TOR                          | Υ                            |  |
|--|------------------------------|------------------------------|------------------------------|------------------------------|------------------------------|------------------------------|------------------------------|--|
|  | 4/27/2018                    | 5/4/2018                     | 5/11/2018                    | 5/18/2018                    | 5/25/2018                    | 6/1/2018                     | 6/8/2018                     |  |
|  |                              |                              |                              |                              |                              |                              |                              |  |
|  |                              |                              |                              |                              |                              |                              |                              |  |
|  | EVISION 1                    | L.I.S. #2 - CLOUD REVISION 2 | EVISION 3                    | EVISION 4                    | L.I.S. #2 - CLOUD REVISION 5 | NOISINE                      | EVISION 7                    |  |
|  | L.I.S. #2 - CLOUD REVISION 1 | CLOUD RE                     | L.I.S. #2 - CLOUD REVISION 3 | L.I.S. #2 - CLOUD REVISION 4 | CLOUD RE                     | L.I.S. #2 - CLOUD REVISION 6 | L.I.S. #2 - CLOUD REVISION 7 |  |
|  | L.I.S. #2 -                  |  |
|  |                              |                              |                              |                              |                              |                              |                              |  |

CONDO 1616

PROJECT#: 1709
PHASE: DD
TEAM: Author
CHECKER: Checker
SCALE: AS NOTED

ISSUED: 4/20/2018
SHEET#:
Δ 1 3 9

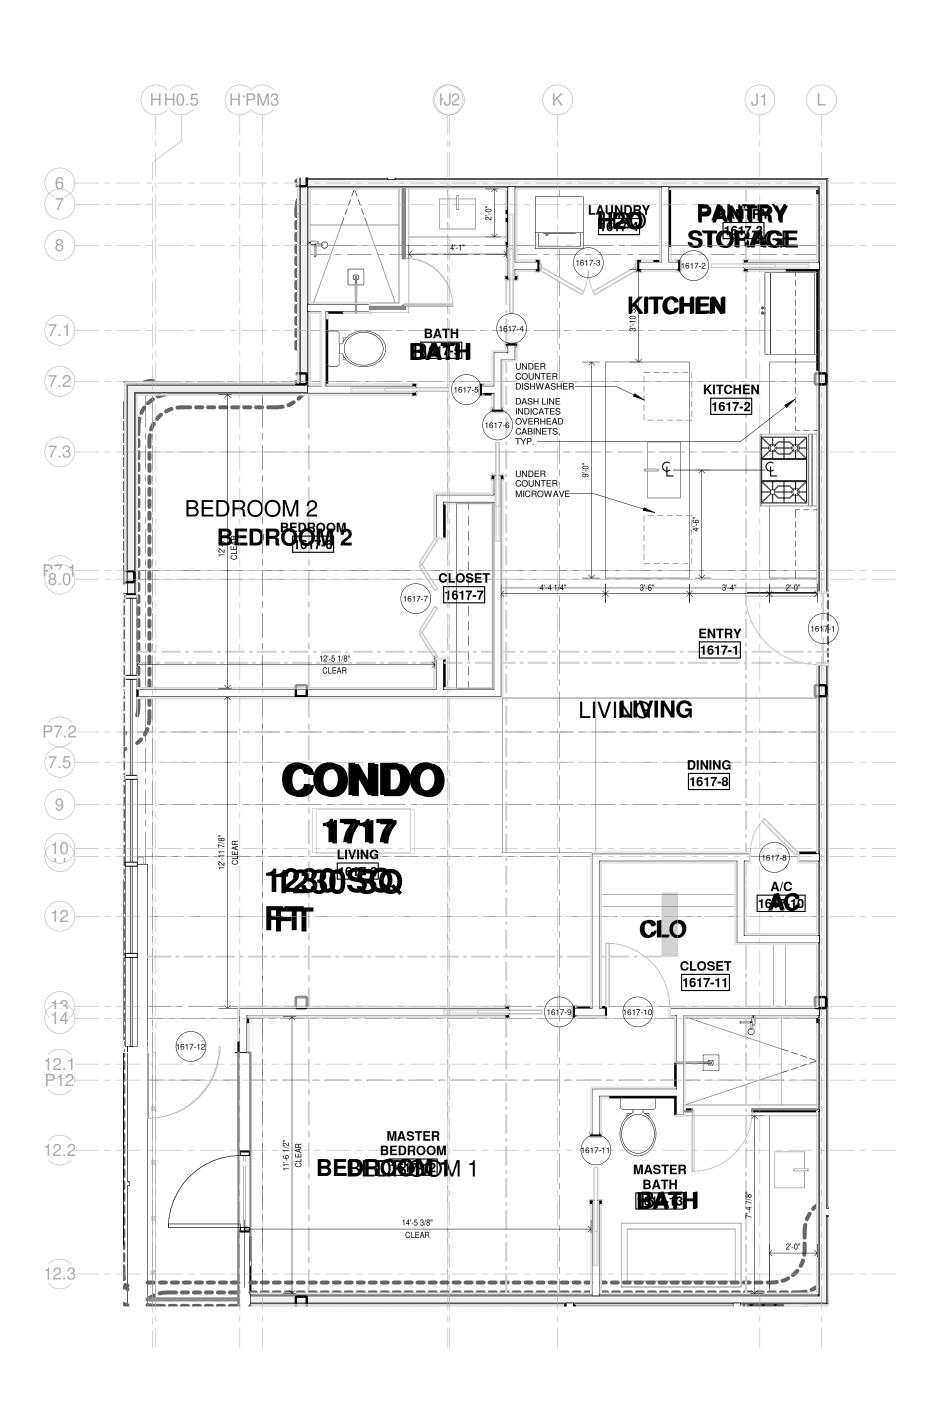

| 1 | CONDO 1617 ENLARGED PLAN |
|---|--------------------------|
| • | SCALE: 1/4" = 1'-0"      |

|         |                | 1              | DOOR S          | CHE     | DULE - UN   | IT 1617       |            |           |             |                    |
|---------|----------------|----------------|-----------------|---------|-------------|---------------|------------|-----------|-------------|--------------------|
| MARK    | FROM           | 10             | WIDTH           | HEIGHT  | THICKNESS   | DOOR MATERIAL | DOOR FRAME | DOOR TYPE | FIRE RATING | REMARKS            |
| 1617-1  | ENTRY          |                | 3' - 0" 8       | 3' - 0" | 0' - 1 3/4" | WD            | WD         | AA        | 1HR         |                    |
| 1617-2  | KITCHEN        | PANTRY         |                 |         | 0' - 1 3/4" |               | WD         | L         |             |                    |
| 1617-3  | LAUNDRY        | KITCHEN        |                 |         | 0' - 1 3/4" |               | WD         | CC        |             | DOUBLE DOOR / PAIR |
| 1617-4  | KITCHEN        | BATH           | 2' - 8" 8       | 3' - 0" | 0' - 1 3/4" | WD            | WD         | L         |             |                    |
| 1617-5  | BEDROOM        | BATH           | 2' - 8" 8       | 3' - 0" | 0' - 1 3/4" | WD            | WD         | L         |             |                    |
| 1617-6  | BEDROOM        | KITCHEN        | 2' - 8" 8       | 3' - 0" | 0' - 1 3/4" | WD            | WD         | L         |             |                    |
| 1617-7  | CLOSET         | BEDROOM        | 5' - 0" 8       | 3' - 0" | 0' - 1 1/2" | WD            | WD         | L         |             |                    |
| 1617-8  | A/C            | DINING         | 2' - 0" 8       | 3' - 0" | 0' - 1 3/4" | WD            | WD         | CC        |             |                    |
| 1617-9  | LIVING         | MASTER BEDROOM | 2' - 8" 8       | 3' - 0" | 0' - 1 3/4" | WD            | WD         | L         |             |                    |
| 1617-10 | MASTER BEDROOM | CLOSET         | 2' - 8" 8       | 3' - 0" | 0' - 1 3/4" | WD            | WD         | AA        |             |                    |
| 1617-11 | MASTER BEDROOM | MASTER BATH    | 2' - 8" 8       | 3' - 0" | 0' - 1 3/4" | WD            | WD         | L         |             |                    |
| 1617-12 | LIVING         |                | 3' - 7<br>15/32 | 3' - 2" | 0' - 1 1/2" | AL/GL         | AL         | K         |             |                    |

|         | FINISH SCHEDULE - UNIT 1617   |  |  |  |  |  |  |  |  |  |  |  |
|---------|---|--|--|--|--|--|--|--|--|--|--|--|
| NUMBER  | FLOOR FINISH BASE FINISH S. WALL W. WALL CEILING FINISH CEILING HT. |  |  |  |  |  |  |  |  |  |  |  |
| 1617-1  | ENTRY   |  |  |  |  |  |  |  |  |  |  |  |
| 1617-1  | KITCHEN   |  |  |  |  |  |  |  |  |  |  |  |
|         |   |  |  |  |  |  |  |  |  |  |  |  |
|         | PANTRY  |  |  |  |  |  |  |  |  |  |  |  |
| 1617-4  | LAUNDRY   |  |  |  |  |  |  |  |  |  |  |  |
| 1617-5  | BATH  |  |  |  |  |  |  |  |  |  |  |  |
| 1617-6  | BEDROOM   |  |  |  |  |  |  |  |  |  |  |  |
| 1617-7  | CLOSET  |  |  |  |  |  |  |  |  |  |  |  |
| 1617-8  | DINING  |  |  |  |  |  |  |  |  |  |  |  |
| 1617-9  | LIVING  |  |  |  |  |  |  |  |  |  |  |  |
| 1617-10 | A/C   |  |  |  |  |  |  |  |  |  |  |  |
| 1617-11 | CLOSET  |  |  |  |  |  |  |  |  |  |  |  |
| 1617-12 | MASTER BEDROOM  |  |  |  |  |  |  |  |  |  |  |  |
|         | MASTER BATH   |  |  |  |  |  |  |  |  |  |  |  |

HARRY
BAKER
SMITH
SMITH
ARCHITECTS II
P L C

189 Maple Ridge Drive Metairie, LA 70001
(504)-885-4477
central@hbsaii.com :: hbsaii.com
SINCE 1961

HARD ROCK HOTE 1031 CANAL STREET NEW ORLEANS, LOUISIANA

HESE PLANS AND SPECIFICATIONS HAVE BEEN PREPARED BY ME OR UNDER MY CLOSE PERSONAL SUPERVISION AND TO THE BEST OF MY KNOWLEDGE AND BELIEF THEY COMPLY WITH ALL CITY, ITATE AND FEDERAL REQUIREMENTS, AND I AM NOT PROVIDING CONTRACT ADMINISTRATION.

CERTIFIED CORRECT



THIS DRAWING IS CONFIDENTIAL AND NOT BE LOANED, REPRODUCED, COPIED, EITHER WHOLLY OR IN PART, OR MADE PUBLIC IN ANY MANNER WITHOUT THE WRITTEN CONSENT OF HBSA II ARCHITECTS, A PROFESSIONAL L.L.C. ALL RIGHTS OF DESIGN OR INVENTION ARE RESERVED AND WILL REMAIN THE SOLE PROPERTY OF HBSA


| II Al                        | CHILEC                       | IS A PR  |                              | SIONA                        |                              |  |
|------------------------------|------------------------------|--|------------------------------|------------------------------|------------------------------|--|
|                              | RE\                          | VISION   | HIS                          | TOR                          | Υ                            |  |
| 4/27/2018                    | 5/4/2018                     | 5/11/2018  | 5/25/2018                    | 6/1/2018                     | 6/8/2018                     |  |
| L.I.S. #2 - CLOUD REVISION 1 | L.I.S. #2 - CLOUD REVISION 2 | L.I.S. #2 - CLOUD REVISION 3<br>L.I.S. #2 - CLOUD REVISION 4 | L.I.S. #2 - CLOUD REVISION 5 | L.I.S. #2 - CLOUD REVISION 6 | L.I.S. #2 - CLOUD REVISION 7 |  |

CONDO 1617

PROJECT#: 1709
PHASE: DD
TEAM: Author
CHECKER: Checker
SCALE: AS NOTED

ISSUED: 4/20/2018
SHEET#:


Al-1.40

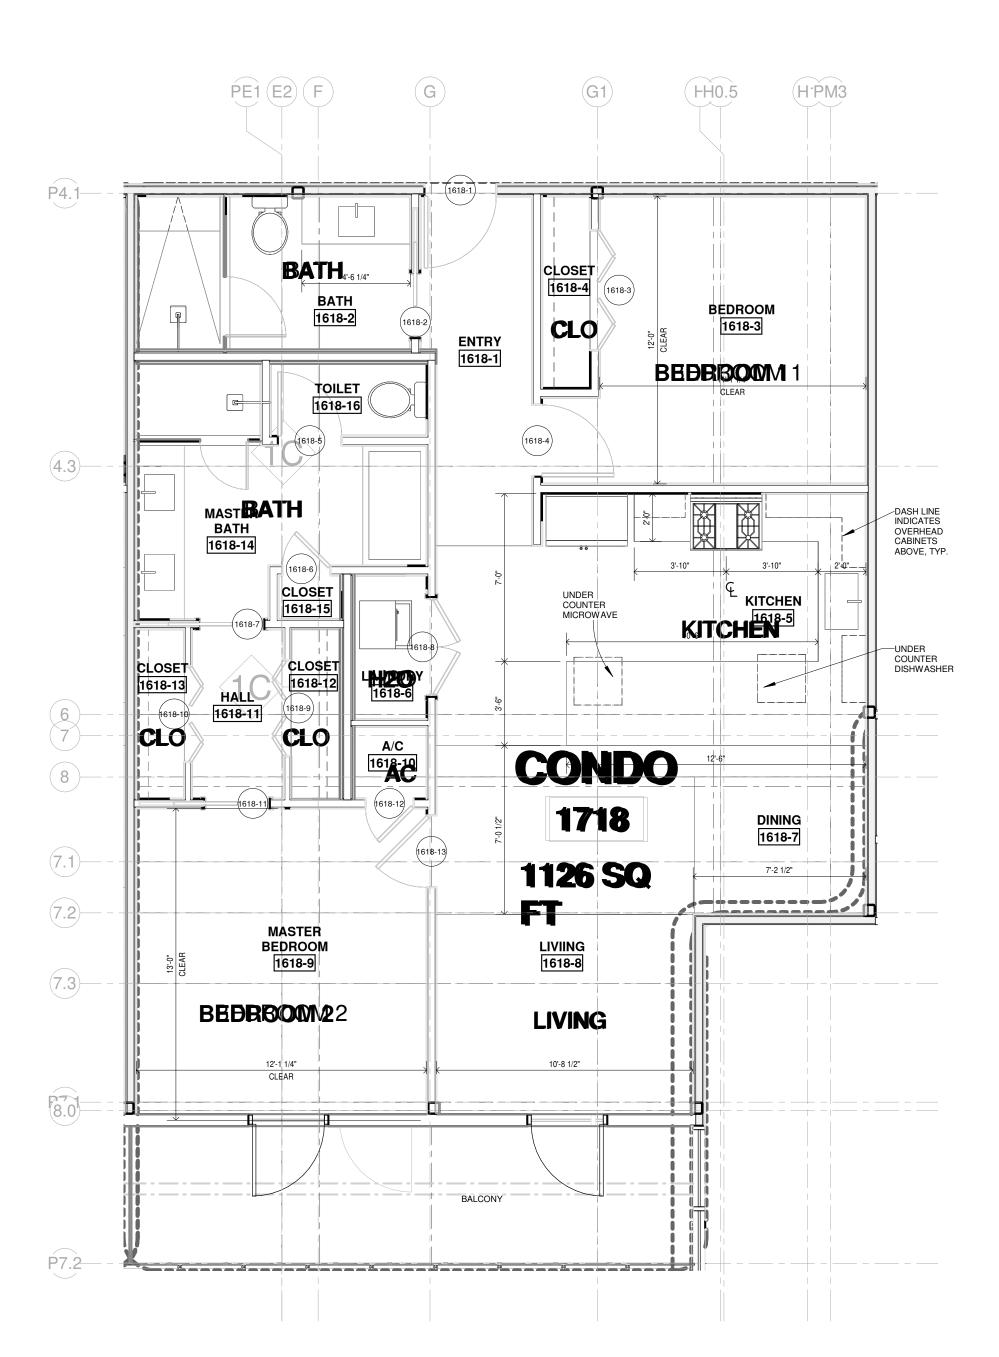

CONDO 1618 ENLARGED PLAN SCALE: 1/4" = 1'-0"

|                  | DOOR SCHEDULE - UNIT 1618  |                |                    |         |             |    |          |      |       |                    |  |  |  |  |
|------------------|--|----------------|--------------------|---------|-------------|----|----------|------|-------|--------------------|--|--|--|--|
| MARK             | MARK FROM TO THICKNESS DOOR FRAME DOOR FRAME FIRE RATING FIRE RATING |                |                    |         |             |    |          |      |       |                    |  |  |  |  |
| 1010.1           |  | ENTDY          | 01 011             | 01 01   | 01 1 0/4"   | WD | WD       | Δ.Δ. | 41.ID | 1 HOUD DATED       |  |  |  |  |
| 1618-1<br>1618-2 | BATH   | ENTRY<br>ENTRY | 3' - 0"<br>2' - 8" |         | 0' - 1 3/4" |    | WD<br>WD | AA   | 1HR   | 1 HOUR RATED       |  |  |  |  |
| 1618-3           | CLOSET   | BEDROOM        | 5' - 0"            |         | 0' - 1 1/2" |    | WD       | ı    |       |                    |  |  |  |  |
| 1618-4           | ENTRY  | BEDROOM        | 3' - 0"            | ļ       | 0' - 1 3/4" |    | HM       | AA   |       |                    |  |  |  |  |
| 1618-5           | TOILET   | MASTER BATH    | 2' - 8"            |         | 0' - 1 3/4" |    | WD       | AA   |       |                    |  |  |  |  |
| 1618-6           | CLOSET   | MASTER BATH    | 2' - 0"            |         | 0' - 1 3/4" |    | WD       | CC   |       |                    |  |  |  |  |
| 1618-7           | HALL   | MASTER BATH    | 2' - 8"            |         | 0' - 1 3/4" |    | WD       | L    |       |                    |  |  |  |  |
| 1618-8           | LAUNDRY  | KITCHEN        | 4' - 0"            |         | 0' - 1 3/4" |    | WD       | CC   |       | DOUBLE DOOR / PAIR |  |  |  |  |
| 1618-9           | CLOSET   | HALL           | 4' - 0"            | 8' - 0" | 0' - 1 1/2" | WD | WD       | L    |       |                    |  |  |  |  |
| 1618-10          | HALL   | CLOSET         | 4' - 0"            | 8' - 0" | 0' - 1 1/2" | WD | WD       | L    |       |                    |  |  |  |  |
| 1618-11          | HALL   | MASTER BEDROOM | 2' - 8"            | 8' - 0" | 0' - 1 3/4" | WD | WD       | L    |       |                    |  |  |  |  |
| 1618-12          | MASTER BEDROOM   | A/C            | 2' - 0"            | 8' - 0" | 0' - 1 3/4" | WD | WD       | CC   |       |                    |  |  |  |  |
| 1618-13          | MASTER BEDROOM   | LIVIING        | 3' - 0"            | 8' - 0" | 0' - 1 3/4" | WD | WD       | AA   |       |                    |  |  |  |  |

|         | EINIOU COLIEDUI E. LINIT 1010 |              |             |         |         |         |         |                |             |  |  |  |
|---------|-------------------------------|--------------|-------------|---------|---------|---------|---------|----------------|-------------|--|--|--|
|         | FINISH SCHEDULE - UNIT 1618   |              |             |         |         |         |         |                |             |  |  |  |
| NUMBER  | NAME                          | FLOOR FINISH | BASE FINISH | N. WALL | S. WALL | E. WALL | W. WALL | CEILING FINISH | CEILING HT. |  |  |  |
| 1618-1  | ENTRY                         |              |             |         |         |         |         |                |             |  |  |  |
| 1618-2  | BATH                          |              |             |         |         |         |         |                |             |  |  |  |
| 1618-3  | BEDROOM                       |              |             |         |         |         |         |                |             |  |  |  |
| 1618-4  | CLOSET                        |              |             |         |         |         |         |                |             |  |  |  |
| 1618-5  | KITCHEN                       |              |             |         |         |         |         |                |             |  |  |  |
| 1618-6  | LAUNDRY                       |              |             |         |         |         |         |                |             |  |  |  |
| 1618-7  | DINING                        |              |             |         |         |         |         |                |             |  |  |  |
| 1618-8  | LIVIING                       |              |             |         |         |         |         |                |             |  |  |  |
| 1618-9  | MASTER BEDROOM                |              |             |         |         |         |         |                |             |  |  |  |
| 1618-10 |                               |              |             |         |         |         |         |                |             |  |  |  |
| 1618-11 |                               |              |             |         |         |         |         |                |             |  |  |  |
| 1618-12 |                               |              |             |         |         |         |         |                |             |  |  |  |
| 1618-13 |                               |              |             |         |         |         |         |                |             |  |  |  |
| 1618-14 |                               |              |             |         |         |         |         |                |             |  |  |  |
| 1618-15 |                               |              |             |         |         |         |         |                |             |  |  |  |
| 1618-16 | TOILET                        |              |             |         |         |         |         |                |             |  |  |  |

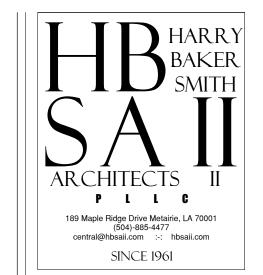

1031 CANAL STREET NEW ORLEANS, LOUISIANA

ADMINISTRATION. CERTIFIED CORRECT




| 5/4/2018                    | 5/11/2018                   | 5/18/2018                   | 5/25/2018                   | TOR 8/1/5018                | 6/8/2018                    |  |
|-----------------------------|-----------------------------|-----------------------------|-----------------------------|-----------------------------|-----------------------------|--|
| .i.s. #2 - CLOUD REVISION 2 | .i.s. #2 - cloud Revision 3 | .i.s. #2 - cLoub REvision 4 | .i.s. #2 - cLoub REvision 5 | .I.S. #2 - CLOUD REVISION 6 | .i.s. #2 - cLoub REvision 7 |  |

CONDO 1618

PROJECT#: 1709 PHASE: DD TEAM: Author CHECKER: Checker SCALE: AS NOTED

ISSUED: 4/20/2018

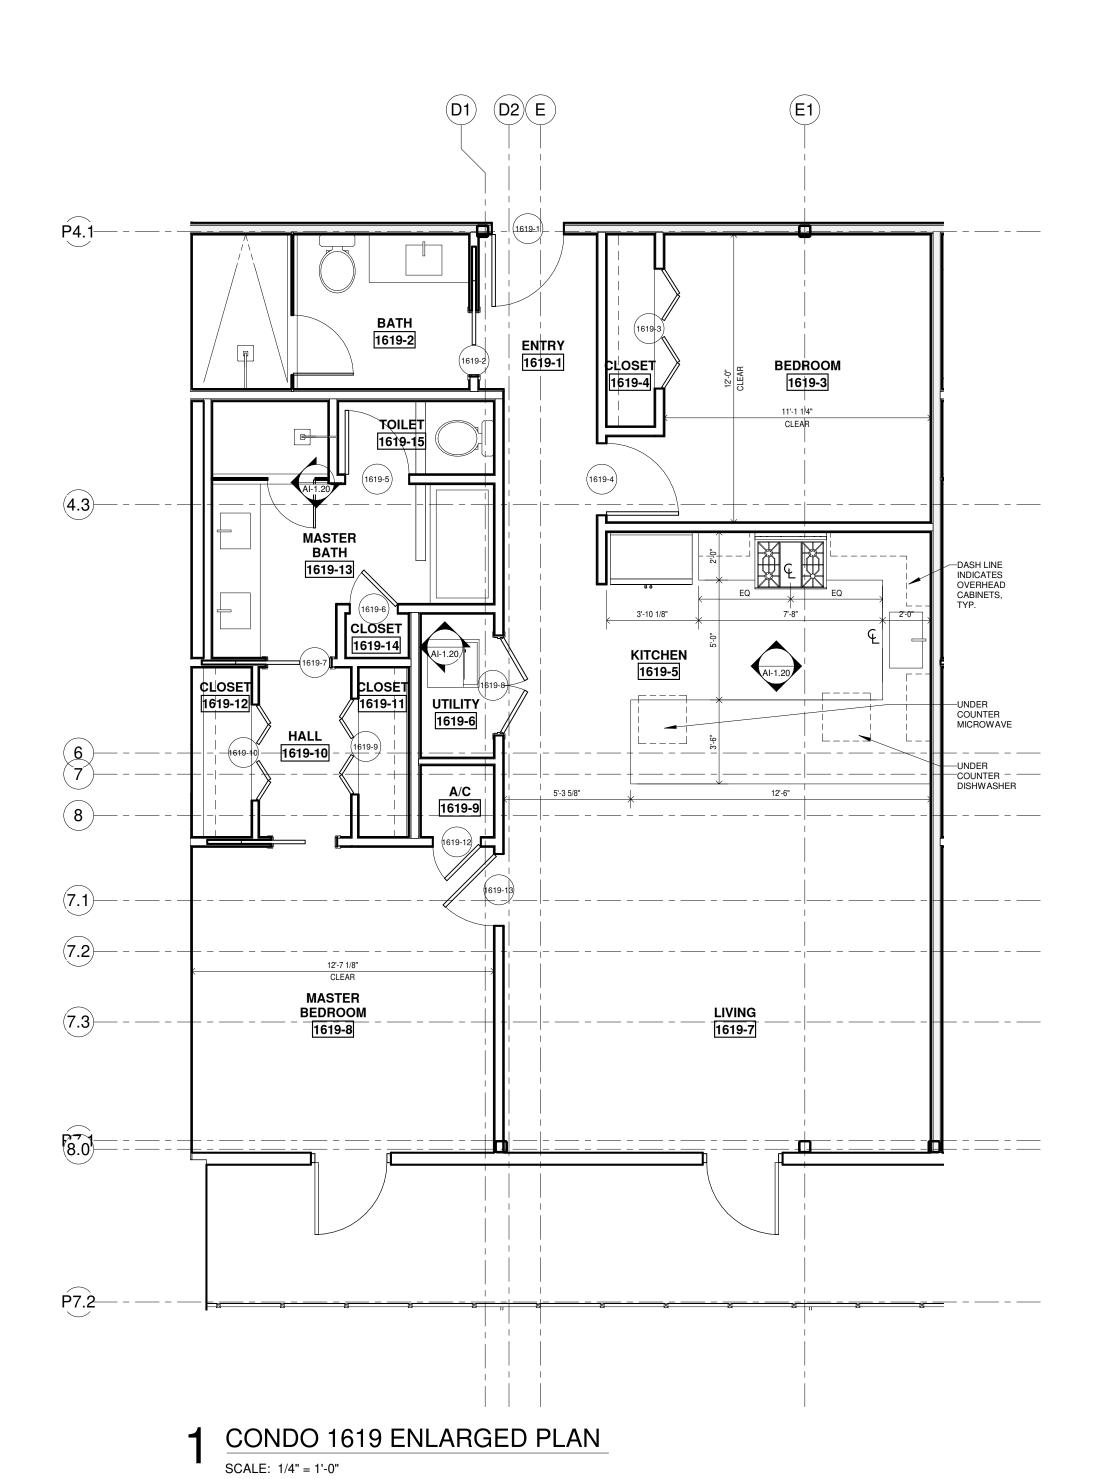

|         |                |                | DOOR S  | SCHED   | ULE - UNIT  | Г 1619        |            |           |             |                    |
|---------|----------------|----------------|---------|---------|-------------|---------------|------------|-----------|-------------|--------------------|
| MARK    | FROM           | 01             | WIDTH   | HEIGHT  | THICKNESS   | DOOR MATERIAL | DOOR FRAME | DOOR TYPE | FIRE RATING | REMARKS            |
|         | 1              |                |         |         |             |               |            |           |             | 1                  |
| 1619-1  |                | ENTRY          | 3' - 0" | ļ       | 0' - 1 3/4" |               | WD         | AA        | 1HR         | 1 HOUR RATED       |
| 1619-2  | BATH           | ENTRY          | 2' - 8" | 8' - 0" | 0' - 1 3/4" | WD            | WD         | L         |             |                    |
| 1619-3  | CLOSET         | BEDROOM        | 5' - 0" | 8' - 0" | 0' - 1 1/2" | WD            | WD         | L         |             |                    |
| 1619-4  | ENTRY          | BEDROOM        | 3' - 0" | 8' - 0" | 0' - 1 3/4" | WD            | WD         | AA        |             |                    |
| 1619-5  | TOILET         | MASTER BATH    | 2' - 8" | 8' - 0" | 0' - 1 3/4" | WD            | WD         | AA        |             |                    |
| 1619-6  | CLOSET         | MASTER BATH    | 2' - 0" | 8' - 0" | 0' - 1 3/4" | WD            | WD         | CC        |             |                    |
| 1619-7  | HALL           | MASTER BATH    | 2' - 8" | 8' - 0" | 0' - 1 3/4" | WD            | WD         | L         |             |                    |
| 1619-8  | UTILITY        | KITCHEN        | 4' - 0" | 8' - 0" | 0' - 1 3/4" | WD            | WD         | CC        |             | DOUBLE DOOR / PAIR |
| 1619-9  | CLOSET         | HALL           | 4' - 0" | 8' - 0" | 0' - 1 1/2" | WD            | WD         | L         |             |                    |
| 1619-10 | HALL           | CLOSET         | 4' - 0" | 8' - 0" | 0' - 1 1/2" | WD            | WD         | М         |             |                    |
| 1619-11 | HALL           | MASTER BEDROOM | 2' - 8" | 8' - 0" | 0' - 1 3/4" | WD            | WD         | L         |             |                    |
| 1619-12 | MASTER BEDROOM | A/C            | 2' - 0" | 8' - 0" | 0' - 1 3/4" | WD            | WD         | СС        |             |                    |
| 1619-13 | MASTER BEDROOM | LIVING         | 3' - 0" |         | 0' - 1 3/4" | WD            | WD         | AA        |             |                    |

|         | FINISH SCHEDULE - UNIT 1619   |  |  |  |  |  |  |  |  |  |  |  |  |
|---------|---|--|--|--|--|--|--|--|--|--|--|--|--|
| NUMBER  | NUMBER NAME ELOOR FINISH S. WALL W. WALL CEILING FINISH CEILING HT. |  |  |  |  |  |  |  |  |  |  |  |  |
| 1619-1  | ENTRY   |  |  |  |  |  |  |  |  |  |  |  |  |
| 1619-2  | BATH  |  |  |  |  |  |  |  |  |  |  |  |  |
| 1619-3  | BEDROOM   |  |  |  |  |  |  |  |  |  |  |  |  |
| 1619-4  | CLOSET  |  |  |  |  |  |  |  |  |  |  |  |  |
| 1619-5  | KITCHEN   |  |  |  |  |  |  |  |  |  |  |  |  |
| 1619-6  | UTILITY   |  |  |  |  |  |  |  |  |  |  |  |  |
| 1619-7  | LIVING  |  |  |  |  |  |  |  |  |  |  |  |  |
| 1619-8  | MASTER BEDROOM  |  |  |  |  |  |  |  |  |  |  |  |  |
| 1619-9  | A/C   |  |  |  |  |  |  |  |  |  |  |  |  |
| 1619-10 |   |  |  |  |  |  |  |  |  |  |  |  |  |
| 1619-11 | CLOSET  |  |  |  |  |  |  |  |  |  |  |  |  |
| 1619-12 |   |  |  |  |  |  |  |  |  |  |  |  |  |
| 1619-13 | MASTER BATH   |  |  |  |  |  |  |  |  |  |  |  |  |
| 1619-14 |   |  |  |  |  |  |  |  |  |  |  |  |  |
| 1619-15 | TOILET  |  |  |  |  |  |  |  |  |  |  |  |  |

189 Maple Ridge Drive Metairie, LA 70001 (504)-885-4477 central@hbsaii.com :-: hbsaii.com SINCE 1961

1031 CANAL STREET NEW ORLEANS, LOUISIANA


CERTIFIED CORRECT

THESE PLANS AND SPECIFICATIONS HAVE BEEN PREPARED BY ME OR UNDER MY CLOSE PERSONAL SUPERVISION AND TO THE BEST OF MY KNOWLEDGE AND BELIEF THEY COMPLY WITH ALL CITY, STATE AND FEDERAL REQUIREMENTS, AND I AM NOT PROVIDING CONTRACT ADMINISTRATION.

| L.I.S. #2 - CLOUD REVISION 1 | 4/27/2018 |      |  |
|------------------------------|-----------|------|--|
| L.I.S. #2 - CLOUD REVISION 2 | 5/4/2018  | R    |  |
| L.I.S. #2 - CLOUD REVISION 3 | 5/11/2018 | EVIS |  |
| L.I.S. #2 - CLOUD REVISION 4 | 5/18/2018 | SION |  |
| L.I.S. #2 - CLOUD REVISION 5 | 5/25/2018 | HIS  |  |
| L.I.S. #2 - CLOUD REVISION 6 | 6/1/2018  | TOR  |  |
| L.I.S. #2 - CLOUD REVISION 7 | 6/8/2018  | Υ    |  |
|                              |           |      |  |
|                              |           |      |  |

CONDO 1619

PROJECT#: 1709 PHASE: DD TEAM: Author CHECKER: Checker SCALE: AS NOTED <u>ISSUED: 4/20/20</u>18

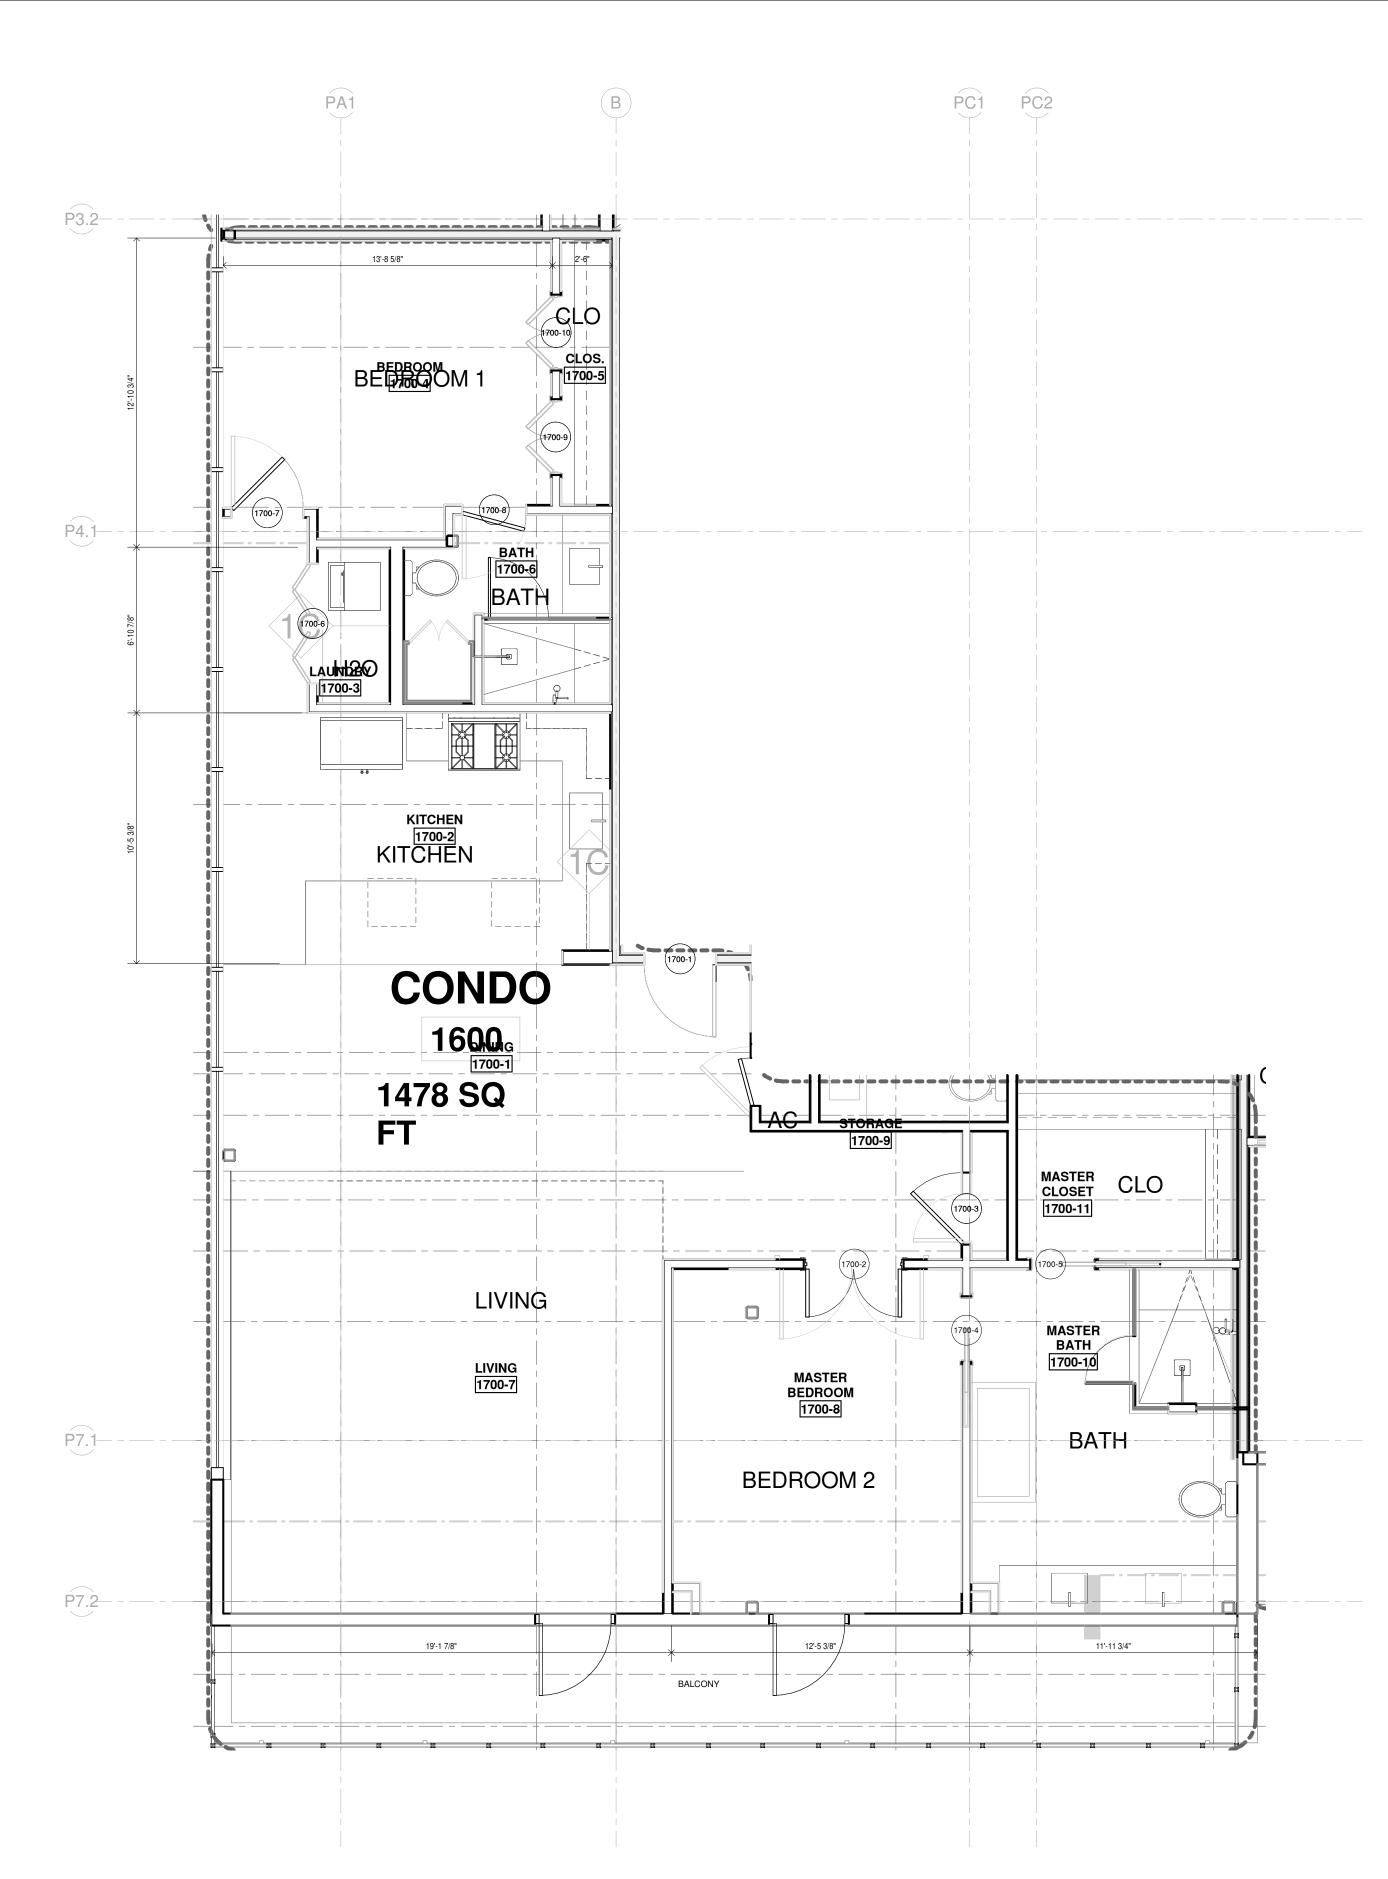

|         | DOOR SCHEDULE - UNIT 1700                                    |             |         |         |             |    |    |    |     |              |  |  |
|---------|--|-------------|---------|---------|-------------|----|----|----|-----|--------------|--|--|
| MARK    | FROM FROM TO TO DOOR FRAME DOOR TYPE FIRE RATING FIRE RATING |             |         |         |             |    |    |    |     |              |  |  |
|         |  |             |         |         |             |    |    |    |     |              |  |  |
| 1700-1  |  | LIVING      | 3' - 0" | 8' - 0" | 0' - 1 3/4" | WD | WD | AA | 1HR | 1 HOUR RATED |  |  |
| 1700-2  | MASTER BEDROOM   | LIVING      | 4' - 0" | 8' - 0" | 0' - 1 3/4" | WD | WD | CC |     |              |  |  |
| 1700-3  |  | LIVING      | 3' - 0" | 8' - 0" | 0' - 1 3/4" | WD | WD | AA |     |              |  |  |
| 1700-4  | MASTER BEDROOM   | MASTER BATH | 2' - 8" | 8' - 0" | 0' - 1 3/4" | WD | WD | М  |     |              |  |  |
| 1700-5  | MASTER CLOSET  | MASTER BATH | 2' - 8" | 8' - 0" | 0' - 1 3/4" | WD | WD | М  |     |              |  |  |
| 1700-6  | LAUNDRY  | KITCHEN     | 5' - 0" | 8' - 0" | 0' - 1 1/2" | WD | WD | L  |     |              |  |  |
| 1700-7  | KITCHEN  | BEDROOM     | 3' - 0" | 8' - 0" | 0' - 1 3/4" | WD | WD | AA |     |              |  |  |
| 1700-8  | BEDROOM  | BATH        | 2' - 8" | 8' - 0" | 0' - 1 3/4" | WD | WD | AA |     |              |  |  |
| 1700-9  | BEDROOM  | CLOS.       | 3' - 0" | 8' - 0" | 0' - 1 3/4" | WD | WD | CC |     |              |  |  |
| 1700-10 | CLOS.  | BEDROOM     | 3' - 0" | 8' - 0" | 0' - 1 3/4" | WD | WD | CC |     |              |  |  |

|         |                |              | FINISH SC   | HEDULE - l | JNIT 1700 |         |         |                |             |
|---------|----------------|--------------|-------------|------------|-----------|---------|---------|----------------|-------------|
| NUMBER  | NAME           | FLOOR FINISH | BASE FINISH | N. WALL    | S. WALL   | E. WALL | W. WALL | CEILING FINISH | CEILING HT. |
|         | - · · · · -    |              |             | T          | T         | T       | T       | Γ              | T           |
| 1700-1  | DINING         |              |             |            |           |         |         |                |             |
| 1700-2  | KITCHEN        |              |             |            |           |         |         |                |             |
| 1700-3  | LAUNDRY        |              |             |            |           |         |         |                |             |
| 1700-4  | BEDROOM        |              |             |            |           |         |         |                |             |
| 1700-5  | CLOS.          |              |             |            |           |         |         |                |             |
| 1700-6  | BATH           |              |             |            |           |         |         |                |             |
| 1700-7  | LIVING         |              |             |            |           |         |         |                |             |
| 1700-8  | MASTER BEDROOM |              |             |            |           |         |         |                |             |
| 1700-9  | STORAGE        |              |             |            |           |         |         |                |             |
| 1700-10 | MASTER BATH    |              |             |            |           |         |         |                |             |
| 1700-11 | MASTER CLOSET  |              |             |            |           |         |         |                |             |
| 1700-11 | BALCONY        |              |             |            |           |         |         |                |             |
| 1700-12 | BALCONY        |              |             |            |           |         |         |                |             |

PENTHOUSE 1700 ENLARGED PLAN

SCALE: 1/4" = 1'-0"

HARRY
BAKER
SMITH
SMITH
ARCHITECTS II
P L C

189 Maple Ridge Drive Metairie, LA 70001
(504)-885-4477
central@hbsaii.com :: hbsaii.com
SINCE 1961

ARD ROCK HOT 1031 CANAL STREET NEW ORI FANS LOLLISIANA

THESE PLANS AND SPECIFICATIONS HAVE BEEN PREPARED BY ME OR UNDER MY CLOSE PERSONAL SUPERVISION AND TO THE BEST OF MY KNOWLEDGE AND BELIEF THEY COMPLY WITH ALL CITY, STATE AND FEDERAL REQUIREMENTS, AND I AM NOT PROVIDING CONTRACT ADMINISTRATION.

CERTIFIED CORRECT




THIS DRAWING IS CONFIDENTIAL AND
NOT BE LOANED, REPRODUCED, COPIED,
EITHER WHOLLY OR IN PART, OR MADE
PUBLIC IN ANY MANNER WITHOUT THE
WRITTEN CONSENT OF HBSA II ARCHITECTS,
A PROFESSIONAL LL.C. ALL RIGHTS OF
DESIGN OR INVENTION ARE RESERVED AND
WILL REMAIN THE SOLE PROPERTY OF HBSA

|  | II AIN                       | CIIIIL                       | .013                         | A FI                         | OI LJ.                       | SIUNA                        | L L.L.                       |   |
|--|------------------------------|------------------------------|------------------------------|------------------------------|------------------------------|------------------------------|------------------------------|---|
|  |                              | R                            | EVIS                         | ION                          | HIS                          | TOR                          | Υ                            |   |
|  | 4/27/2018                    | 5/4/2018                     | 5/11/2018                    | 5/18/2018                    | 5/25/2018                    | 6/1/2018                     | 6/8/2018                     |   |
|  | L.I.S. #2 - CLOUD REVISION 1 | L.i.S. #2 - CLOUD REVISION 2 | L.i.s. #2 - CLOUD REVISION 3 | L.I.S. #2 - CLOUD REVISION 4 | L.i.S. #2 - CLOUD REVISION 5 | L.i.S. #2 - CLOUD REVISION 6 | L.i.S. #2 - CLOUD REVISION 7 |   |
|  | _                            | 0                            | က                            | 4                            | 2                            | 9                            | 7                            | 8 |
|  |                              |                              |                              |                              |                              |                              |                              |   |

CONDO 1700

PROJECT#: 1709
PHASE: DD
TEAM: Author
CHECKER: Checker
SCALE: AS NOTED
ISSUED: 4/20/2018

AI-1<sub>-</sub>44

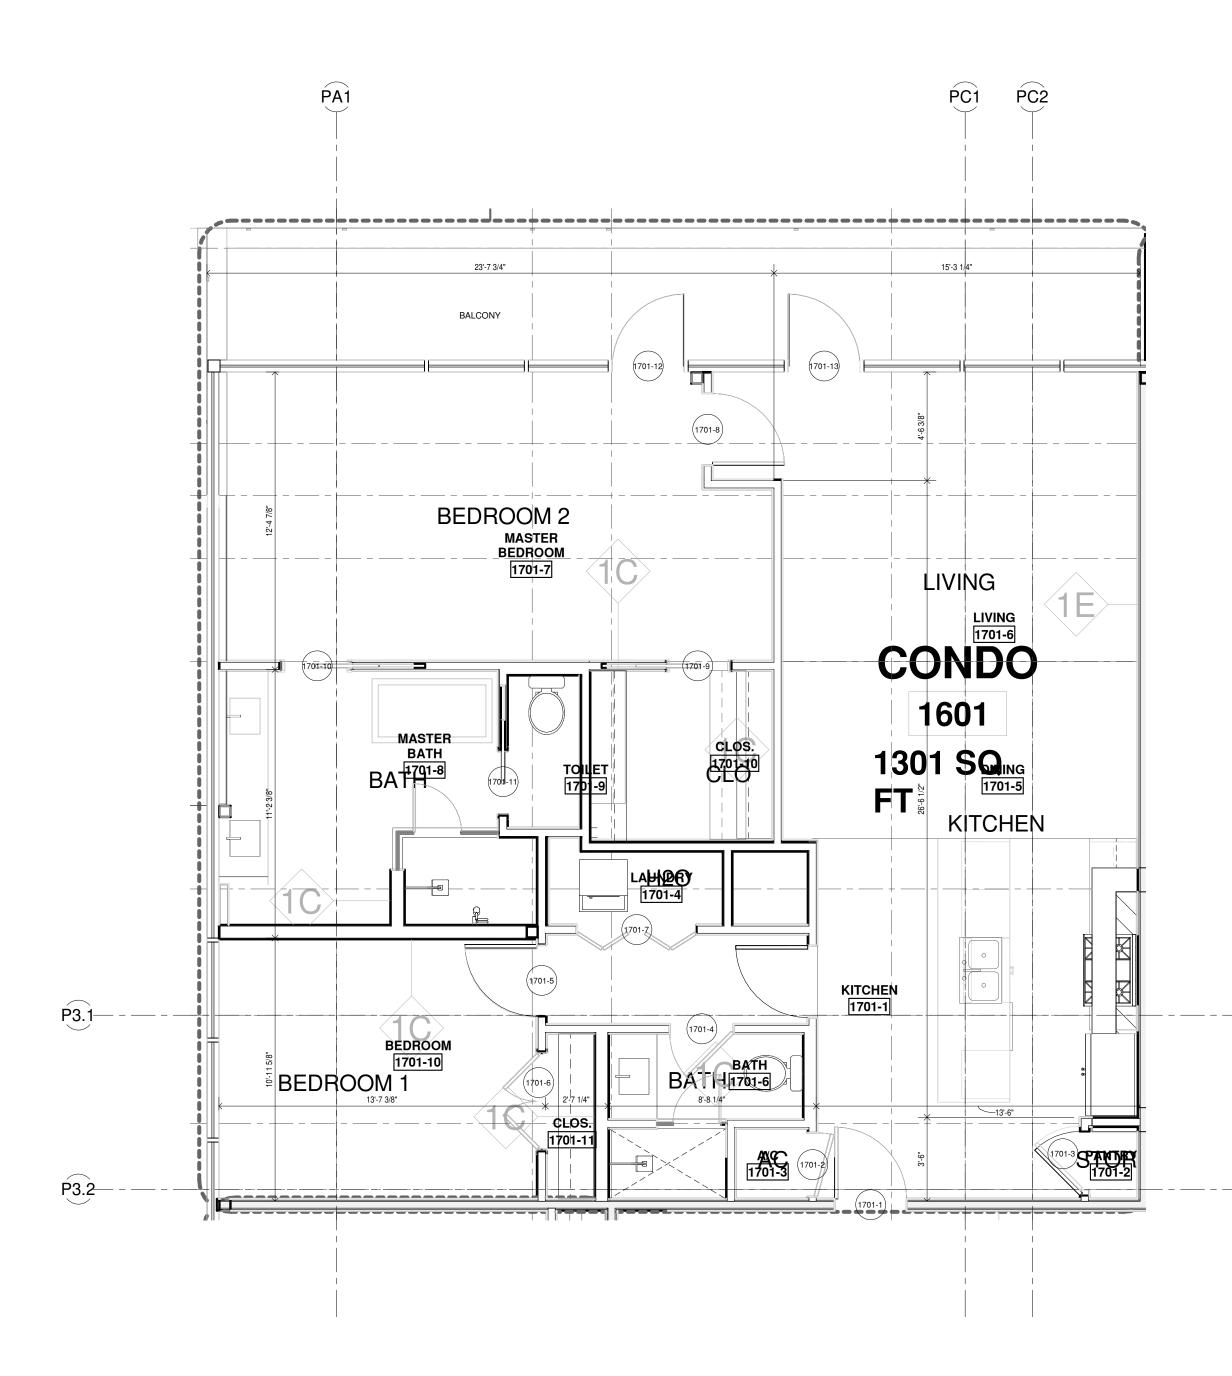

|         | DOOR SCHEDULE - UNIT 1701  |                |         |         |             |       |    |    |     |                    |  |  |
|---------|--|----------------|---------|---------|-------------|-------|----|----|-----|--------------------|--|--|
| MARK    | FROM TO TO THICKNESS DOOR MATERIAL DOOR TYPE FIRE RATING FIRE RATING |                |         |         |             |       |    |    |     |                    |  |  |
| 1701-1  |  | KITCHEN        | 3' - 0" | 8' - 0" | 0' - 1 3/4" | WD    | WD | AA | 1HR | 1 HOUR RATED       |  |  |
| 1701-2  | A/C  | KITCHEN        | 2' - 8" |         | 0' - 1 3/4" | WD    | WD | AA |     | 1110011101125      |  |  |
| 1701-3  | PANTRY   | KITCHEN        | 2' - 8" |         | 0' - 1 3/4" | WD    | WD | AA |     |                    |  |  |
| 1701-4  | BATH   |                | 2' - 8" | 8' - 0" | 0' - 1 3/4" | WD    | WD | AA |     |                    |  |  |
| 1701-5  |  | BEDROOM        | 3' - 0" | 8' - 0" | 0' - 1 3/4" | WD    | WD | AA |     |                    |  |  |
| 1701-6  | CLOS.  | BEDROOM        | 4' - 0" | 8' - 0" | 0' - 1 3/4" | WD    | WD | CC |     | DOUBLE DOOR / PAIR |  |  |
| 1701-7  | LAUNDRY  |                | 5' - 0" | 8' - 0" | 0' - 1 1/2" | WD    | WD | М  |     |                    |  |  |
| 1701-8  | MASTER BEDROOM   | LIVING         | 3' - 0" | 8' - 0" | 0' - 1 3/4" | WD    | WD | AA |     |                    |  |  |
| 1701-9  | MASTER BEDROOM   | CLOS.          | 2' - 8" | 8' - 0" | 0' - 1 3/4" | WD    | WD | М  |     |                    |  |  |
| 1701-10 | MASTER BATH  | MASTER BEDROOM | 3' - 0" |         | 0' - 1 3/4" | WD    | WD | М  |     |                    |  |  |
| 1701-11 |  | MASTER BATH    | 2' - 8" | 8' - 0" | 0' - 1 3/4" | WD    | WD | М  |     |                    |  |  |
| 1701-12 | MASTER BEDROOM   | BALCONY        | 3' - 0" | 8' - 2" | 0' - 1 1/2" | AL/GL | AL | K  |     |                    |  |  |
| 1701-13 | LIVING   | BALCONY        | 3' - 0" | 8' - 2" | 0' - 1 1/2" | AL/GL | AL | K  |     |                    |  |  |

|         |                |              | FINISH SC   | HEDULE - I | JNIT 1701 |         |         |                |             |
|---------|----------------|--------------|-------------|------------|-----------|---------|---------|----------------|-------------|
| NUMBER  | NAME           | FLOOR FINISH | BASE FINISH | N. WALL    | S. WALL   | E. WALL | W. WALL | CEILING FINISH | CEILING HT. |
| 1701-1  | KITCHEN        |              |             |            | 1         |         |         |                |             |
|         |                |              |             |            |           |         |         |                |             |
| 1701-2  | PANTRY         |              |             |            |           |         |         |                |             |
| 1701-3  | A/C            |              |             |            |           |         |         |                |             |
| 1701-4  | LAUNDRY        |              |             |            |           |         |         |                |             |
| 1701-5  | DINING         |              |             |            |           |         |         |                |             |
| 1701-6  | LIVING         |              |             |            |           |         |         |                |             |
| 1701-6  | BATH           |              |             |            |           |         |         |                |             |
| 1701-7  | MASTER BEDROOM |              |             |            |           |         |         |                |             |
| 1701-8  | MASTER BATH    |              |             |            |           |         |         |                |             |
| 1701-9  | TOILET         |              |             |            |           |         |         |                |             |
| 1701-10 | BEDROOM        |              |             |            |           |         |         |                |             |
| 1701-10 | CLOS.          |              |             |            |           |         |         |                |             |
| 1701-11 | CLOS.          |              |             |            |           |         |         |                |             |

PENTHOUSE 1701 ENLARGED PLAN

SCALE: 1/4" = 1'-0"

HARRY
BAKER
SMITH
SMITH
ARCHITECTS II
P L C

189 Maple Ridge Drive Metairie, LA 70001
(504)-885-4477
central@hbsaii.com :: hbsaii.com
SINCE 1961

HARD ROCK HOTE 1031 CANAL STREET NEW ORLEANS, LOUISIANA

THESE PLANS AND SPECIFICATIONS HAVE
BEEN PREPARED BY ME OR UNDER MY
CLOSE PERSONAL SUPERVISION AND TO
THE BEST OF MY KNOWLEDGE AND
BELIEF THEY COMPLY WITH ALL CITY,
STATE AND FEDERAL REQUIREMENTS, AND
I AM NOT PROVIDING CONTRACT
ADMINISTRATION.

CERTIFIED CORRECT



THIS DRAWING IS CONFIDENTIAL AND
NOT BE LOANED, REPRODUCED, COPIED,
EITHER WHOLLY OR IN PART, OR MADE
PUBLIC IN ANY MANNER WITHOUT THE
WRITTEN CONSENT OF HBSA II ARCHITECTS,
A PROFESSIONAL L.L.C. ALL RIGHTS OF
DESIGN OR INVENTION ARE RESERVED AND
WILL REMAIN THE SOLE PROPERTY OF HBSA


| -1.5. #2 - CCOO TREVISION                                    | 4/27/2018 |
|--|-----------|
| L.I.S. #2 - CLOUD REVISION 2<br>L.I.S. #2 - CLOUD REVISION 3 | 5/4/2018  |
| L.I.S. #2 - CLOUD REVISION 4                                 | 5/18/2018 |
| L.I.S. #2 - CLOUD REVISION 5                                 | 5/25/2018 |
| L.I.S. #2 - CLOUD REVISION 6                                 | 6/1/2018  |
| L.I.S. #2 - CLOUD REVISION 7                                 | 6/8/2018  |
|  |           |

CONDO 1701

PROJECT#: 1709
PHASE: DD
TEAM: Author
CHECKER: Checker
SCALE: AS NOTED

AI-1.45

IS<u>SUED: 4/20/20</u>18

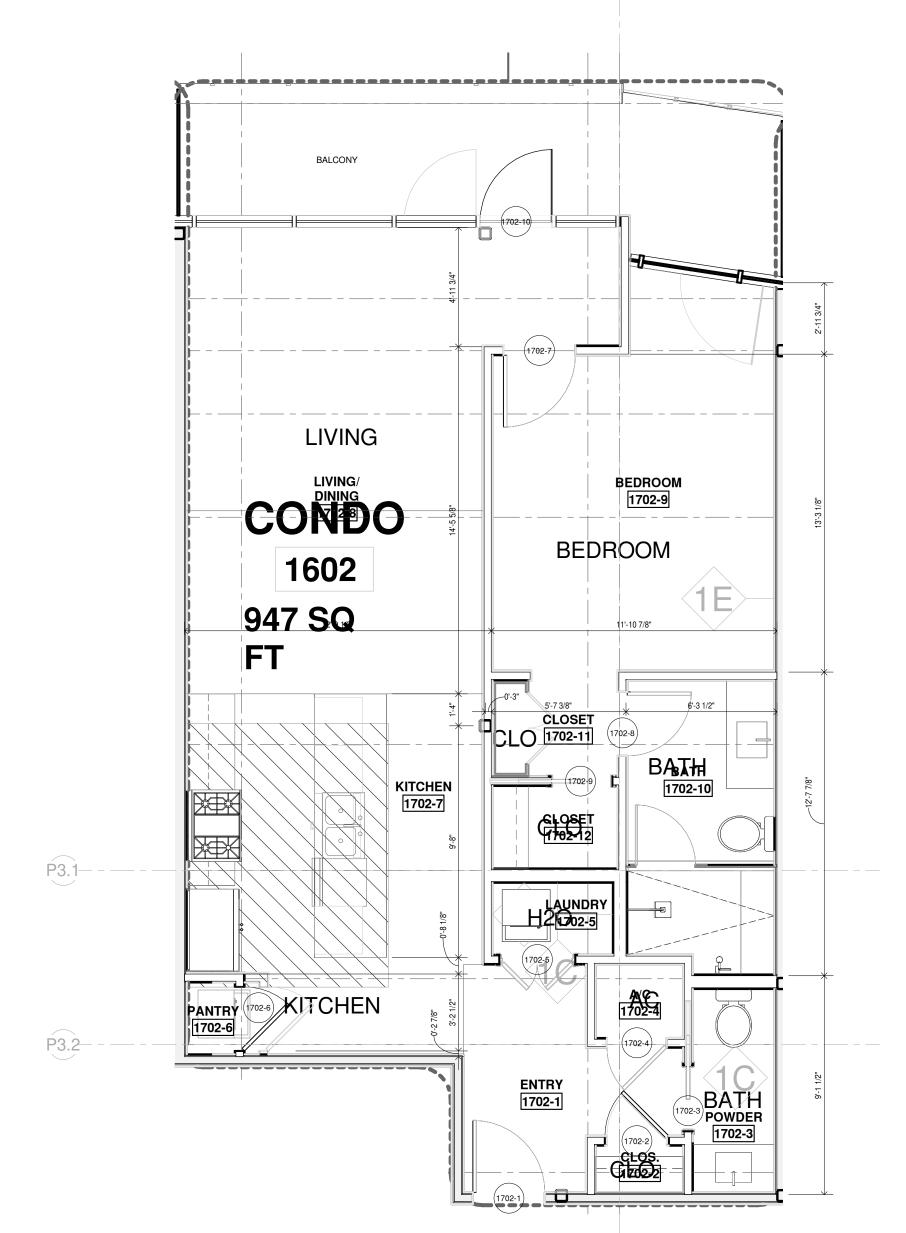

|         |                |         | DOOR    | SCHED   | ULE - UNI   | T 1702        |            |           |             |         |
|---------|----------------|---------|---------|---------|-------------|---------------|------------|-----------|-------------|---------|
| MARK    | FROM           | 01      | WIDTH   | НЕІСНТ  | THICKNESS   | DOOR MATERIAL | DOOR FRAME | DOOR TYPE | FIRE RATING | REMARKS |
|         |                |         |         |         |             | 1             | 1          |           |             |         |
| 1702-1  |                | ENTRY   | 3' - 0" | 8' - 0" | 0' - 1 3/4" | WD            | WD         | AA        | 1HR         |         |
| 1702-2  | ENTRY          | CLOS.   | 2' - 8" | 8' - 0" | 0' - 1 3/4" | WD            | WD         | AA        |             |         |
| 1702-3  | ENTRY          | POWDER  | 2' - 8" | 8' - 0" | 0' - 1 3/4" | WD            | WD         | M         |             |         |
| 1702-4  | A/C            | ENTRY   | 2' - 6" | 8' - 0" | 0' - 1 3/4" | WD            | WD         | AA        |             |         |
| 1702-5  | LAUNDRY        | KITCHEN | 3' - 0" | 8' - 0" | 0' - 1 3/4" | WD            | WD         | CC        |             |         |
| 1702-6  | KITCHEN        | PANTRY  | 2' - 8" | 8' - 0" | 0' - 1 3/4" | WD            | WD         | AA        |             |         |
| 1702-7  | LIVING/ DINING | BEDROOM | 3' - 0" | 8' - 0" | 0' - 1 3/4" | WD            | WD         | AA        |             |         |
| 1702-8  | CLOSET         | BATH    | 2' - 8" | 8' - 0" | 0' - 1 3/4" | WD            | WD         | AA        |             |         |
| 1702-9  | CLOSET         | CLOSET  | 2' - 6" | 8' - 0" | 0' - 1 3/4" | WD            | WD         | М         |             |         |
| 1702-10 | LIVING/ DINING | BALCONY | 3' - 0" | 8' - 2" | 0' - 1 1/2" | AL/GL         | AL         | K         |             |         |

|         |                |              | FINISH SC   | HEDULE - l | JNIT 1702 |         |         |                |             |
|---------|----------------|--------------|-------------|------------|-----------|---------|---------|----------------|-------------|
| NUMBER  | NAME           | FLOOR FINISH | BASE FINISH | N. WALL    | S. WALL   | E. WALL | W. WALL | CEILING FINISH | CEILING HT. |
|         |                |              |             |            |           |         |         |                |             |
| 1702-1  | ENTRY          |              |             |            |           |         |         |                |             |
| 1702-2  | CLOS.          |              |             |            |           |         |         |                |             |
| 1702-3  | POWDER         |              |             |            |           |         |         |                |             |
| 1702-4  | A/C            |              |             |            |           |         |         |                |             |
| 1702-5  | LAUNDRY        |              |             |            |           |         |         |                |             |
| 1702-6  | PANTRY         |              |             |            |           |         |         |                |             |
| 1702-7  | KITCHEN        |              |             |            |           |         |         |                |             |
| 1702-8  | LIVING/ DINING |              |             |            |           |         |         |                |             |
| 1702-9  | BEDROOM        |              |             |            |           |         |         |                |             |
| 1702-10 | BATH           |              |             |            |           |         |         |                |             |
| 1702-11 | CLOSET         |              |             |            |           |         |         |                |             |
| 1702-12 | CLOSET         |              |             |            |           |         |         |                |             |

PENTHOUSE 1702 ENLARGED PLAN

SCALE: 1/4" = 1'-0"

HARRY
BAKER
SMITH
SMITH
ARCHITECTS II
P L C

189 Maple Ridge Drive Metairie, LA 70001
(504)-885-4477
central@hbsaii.com :: hbsaii.com
SINCE 1961

HARD ROCK HOTE

1031 CANAL STREET

NEW ORLEANS, LOUISIANA

HESE PLANS AND SPECIFICATIONS HAVE
BEEN PREPARED BY ME OR UNDER MY
CLOSE PERSONAL SUPERVISION AND TO
THE BEST OF MY KNOWLEDGE AND
BELIEF THEY COMPLY WITH ALL CITY,
ITATE AND FEDERAL REQUIREMENTS, AND
I AM NOT PROVIDING CONTRACT
ADMINISTRATION.

CERTIFIED CORRECT



THIS DRAWING IS CONFIDENTIAL AND NOT BE LOANED, REPRODUCED, COPIED, EITHER WHOLLY OR IN PART, OR MADE PUBLIC IN ANY MANNER WITHOUT THE WRITTEN CONSENT OF HBSA II ARCHITECTS A PROFESSIONAL L.L.C. ALL RIGHTS OF DESIGN OR INVENTION ARE RESERVED AND WILL REMAIN THE SOLE PROPERTY OF HBSA


|                              | REVISION HISTORY             |                              |                              |                              |                              |                              |  |  |  |  |  |  |
|------------------------------|------------------------------|------------------------------|------------------------------|------------------------------|------------------------------|------------------------------|--|--|--|--|--|--|
| 4/27/2018                    | 5/4/2018                     | 5/11/2018                    | 5/18/2018                    | 5/25/2018                    | 6/1/2018                     | 6/8/2018                     |  |  |  |  |  |  |
| L.I.S. #2 - CLOUD REVISION 1 | L.I.S. #2 - CLOUD REVISION 2 | L.I.S. #2 - CLOUD REVISION 3 | L.I.S. #2 - CLOUD REVISION 4 | L.I.S. #2 - CLOUD REVISION 5 | L.I.S. #2 - CLOUD REVISION 6 | L.I.S. #2 - CLOUD REVISION 7 |  |  |  |  |  |  |

CONDO 1702

PROJECT#: 1709
PHASE: DD
TEAM: Author
CHECKER: Checker
SCALE: AS NOTED

ISSUED: 4/20/2018
SHEET#:

AI-1.46

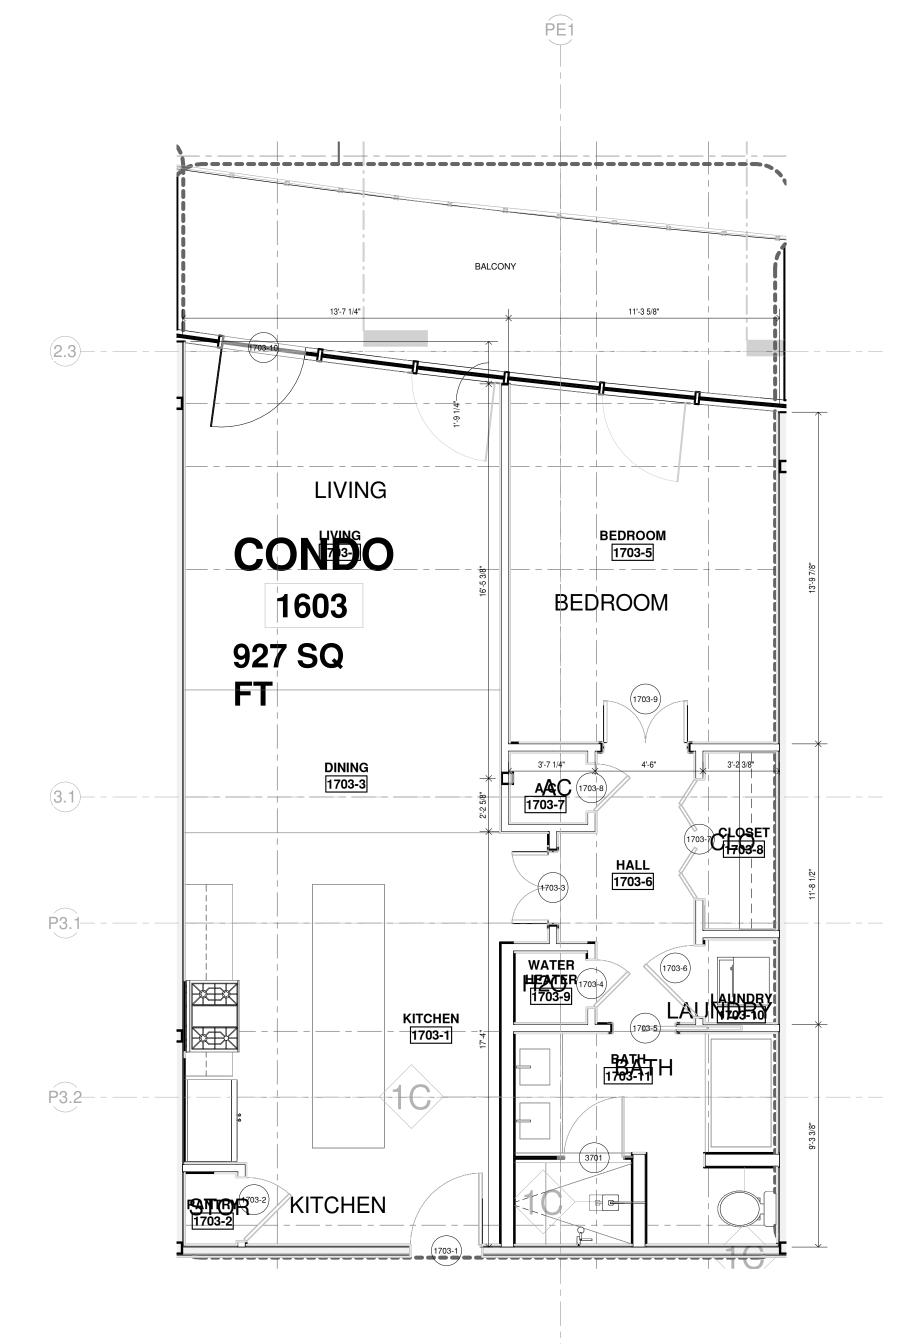

|         |         |              | DOOR S  | SCHED       | ULE - UNIT       | Г 1703        |            |           |             |              |
|---------|---------|--------------|---------|-------------|------------------|---------------|------------|-----------|-------------|--------------|
| MARK    | FROM    | ТО           | WIDTH   | HEIGHT      | THICKNESS        | DOOR MATERIAL | DOOR FRAME | DOOR TYPE | FIRE RATING | REMARKS      |
| 1700 1  | T       | KITOLIEN     | 01 01   | 01 011      | 01 4 0 / 4 11    | WD            | WD         | ۱ ۸ ۸     | ALID        | 4 HOUR DATED |
| 1703-1  |         | KITCHEN      | 3' - 0" | 8' - 0"     |                  |               | WD         | AA        | 1HR         | 1 HOUR RATED |
| 1703-2  | KITCHEN | PANTRY       | 2' - 8" |             | 0' - 1 3/4"      | WD            | WD         | AA        |             |              |
| 1703-3  | KITCHEN | HALL         | 3' - 0" | 8' - 0"     | 0' - 1 3/4"      | WD            | WD         | CC        |             |              |
| 1703-4  | HALL    | WATER HEATER | 2' - 0" | 8' - 0"     | 0' - 1 3/4"      | WD            | WD         | AA        |             |              |
| 1703-5  | HALL    | BATH         | 2' - 8" | 8' - 0"     | 0' - 1 3/4"      | WD            | WD         | М         |             |              |
| 1703-6  | LAUNDRY | HALL         | 3' - 0" | 8' - 0"     | 0' - 1 3/4"      | WD            | WD         | AA        |             |              |
| 1703-7  | HALL    | CLOSET       | 5' - 0" | 8' - 0"     | 0' - 1 1/2"      | WD            | WD         | L         |             |              |
| 1703-8  | HALL    | A/C          | 2' - 0" | 8' - 0"     | 0' - 1 3/4"      | WD            | WD         | AA        |             |              |
| 1703-9  | HALL    | BEDROOM      | 3' - 6" | 8' - 0"     | 0' - 1 3/4"      | WD            | WD         | СС        |             |              |
| 1703-10 | BALCONY | LIVING       | 3' - 6" | 7' -<br>10" | 0' - 0<br>15/32" | AL/GL         | AL         | K         |             |              |

|         | FINISH SCHEDULE - UNIT 1703 |              |             |         |         |         |         |                |             |  |  |
|---------|-----------------------------|--------------|-------------|---------|---------|---------|---------|----------------|-------------|--|--|
| NUMBER  | NAME                        | FLOOR FINISH | BASE FINISH | N. WALL | S. WALL | E. WALL | W. WALL | CEILING FINISH | CEILING HT. |  |  |
| 1700 1  | KITOLIENI                   | T T          |             |         |         |         |         | T              |             |  |  |
| 1703-1  | KITCHEN                     |              |             |         |         |         |         |                |             |  |  |
| 1703-2  | PANTRY                      |              |             |         |         |         |         |                |             |  |  |
| 1703-3  | DINING                      |              |             |         |         |         |         |                |             |  |  |
| 1703-4  | LIVING                      |              |             |         |         |         |         |                |             |  |  |
| 1703-5  | BEDROOM                     |              |             |         |         |         |         |                |             |  |  |
| 1703-6  | HALL                        |              |             |         |         |         |         |                |             |  |  |
| 1703-7  | A/C                         |              |             |         |         |         |         |                |             |  |  |
| 1703-8  | CLOSET                      |              |             |         |         |         |         |                |             |  |  |
| 1703-9  | WATER HEATER                |              |             |         |         |         |         |                |             |  |  |
| 1703-10 | LAUNDRY                     |              |             |         |         |         |         |                |             |  |  |
| 1703-11 | BATH                        |              |             |         |         |         |         |                |             |  |  |

1 PENTHOUSE 1703 ENLARGED PLAN

SCALE: 1/4" = 1'-0"

HARRY
BAKER
SMITH
SMITH
ARCHITECTS II
P L C

189 Maple Ridge Drive Metairie, LA 70001
(504)-885-4477
central@hbsaii.com :: hbsaii.com
SINCE 1961

HARD ROCK HOTE 1031 CANAL STREET NEW ORLEANS, LOUISIANA

THESE PLANS AND SPECIFICATIONS HAVE
BEEN PREPARED BY ME OR UNDER MY
CLOSE PERSONAL SUPERVISION AND TO
THE BEST OF MY KNOWLEDGE AND
BELIEF THEY COMPLY WITH ALL CITY,
STATE AND FEDERAL REQUIREMENTS, AND
I AM NOT PROVIDING CONTRACT
ADMINISTRATION.
CERTIFIED CORRECT



THIS DRAWING IS CONFIDENTIAL AND NOT BE LOANED, REPRODUCED, COPIED, EITHER WHOLLY OR IN PART, OR MADE PUBLIC IN ANY MANNER WITHOUT THE WRITTEN CONSENT OF HBSA II ARCHITECTS, A PROFESSIONAL L.L.C. ALL RIGHTS OF DESIGN OR INVENTION ARE RESERVED AND WILL REMAIN THE SOLE PROPERTY OF HBSA


|                              | R                            | EVIS                         | ION                          | HIS                          | TOR                          | Υ                            |  |
|------------------------------|------------------------------|------------------------------|------------------------------|------------------------------|------------------------------|------------------------------|--|
| 4/27/2018                    | 5/4/2018                     | 5/11/2018                    | 5/18/2018                    | 5/25/2018                    | 6/1/2018                     | 6/8/2018                     |  |
| L.I.S. #2 - CLOUD REVISION 1 | L.I.S. #2 - CLOUD REVISION 2 | L.I.S. #2 - CLOUD REVISION 3 | L.I.S. #2 - CLOUD REVISION 4 | L.I.S. #2 - CLOUD REVISION 5 | L.I.S. #2 - CLOUD REVISION 6 | L.I.S. #2 - CLOUD REVISION 7 |  |
| L.I.S. #2 - 0                | L.I.S. #2 - (                | L.I.S. #2 - 0                | L.I.S. #2 - (                |  |
|                              |                              |                              |                              |                              |                              |                              |  |

CONDO 1703

PROJECT#: 1709
PHASE: DD
TEAM: Author
CHECKER: Checker
SCALE: AS NOTED

<u>ISSUED: 4/20/20</u>18

AI-1 47

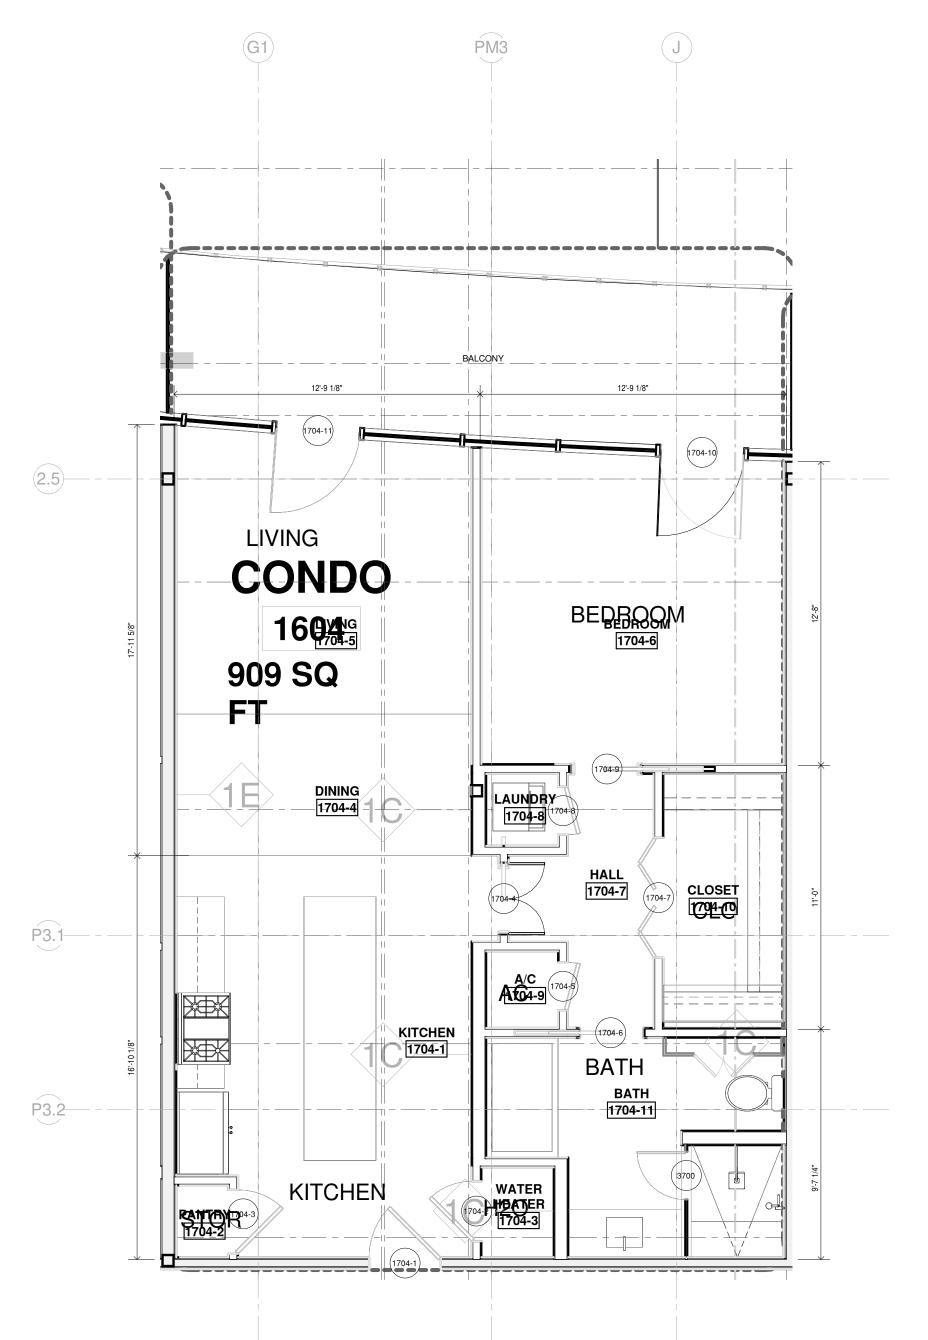

|         |              |         | DOOR S  | SCHED       | ULE - UNIT       | Г 1704        |            |           |             |              |
|---------|--------------|---------|---------|-------------|------------------|---------------|------------|-----------|-------------|--------------|
| MARK    | FROM         | 01      | WIDTH   | HEIGHT      | THICKNESS        | DOOR MATERIAL | DOOR FRAME | DOOR TYPE | FIRE RATING | REMARKS      |
| 1704-1  |              | KITCHEN | 3' - 0" | יי חיי      | 0' - 1 3/4"      | WD            | WD         | AA        | 1HR         | 1 HOUR RATED |
| 1704-1  | WATER HEATER | KITCHEN | 2' - 6" |             | 0' - 1 3/4"      | WD            | WD         | AA        | IIIIN       | I HOUR RATED |
|         |              |         |         |             |                  |               |            |           |             |              |
| 1704-3  | KITCHEN      | PANTRY  | 2' - 8" |             | 0' - 1 3/4"      | WD            | WD         | AA        |             |              |
| 1704-4  | HALL         | KITCHEN | 3' - 0" | 8' - 0"     | 0' - 1 3/4"      | WD            | WD         | CC        |             |              |
| 1704-5  | A/C          | HALL    | 2' - 0" | 8' - 0"     | 0' - 1 3/4"      | WD            | WD         | AA        |             |              |
| 1704-6  | HALL         | BATH    | 2' - 8" | 8' - 0"     | 0' - 1 3/4"      | WD            | WD         | М         |             |              |
| 1704-7  | CLOSET       | HALL    | 5' - 0" | 8' - 0"     | 0' - 1 1/2"      | WD            | WD         | L         |             |              |
| 1704-8  | HALL         | LAUNDRY | 2' - 0" | 8' - 0"     | 0' - 1 3/4"      | WD            | WD         | AA        |             |              |
| 1704-9  | HALL         | BEDROOM | 3' - 0" | 8' - 0"     | 0' - 1 3/4"      | WD            | WD         | М         |             |              |
| 1704-10 | BALCONY      | BEDROOM | 3' - 6" | 7' -<br>10" | 0' - 0<br>15/32" | AL/GL         | AL         | K         |             |              |
| 1704-11 | BALCONY      | LIVING  | 3' - 6" | 7' -<br>10" | 0' - 0<br>15/32" | AL/GL         | AL         | K         |             |              |

|         |              |              | FINISH SCI  | HEDULE - l | JNIT 1704 |         |         |                |             |
|---------|--------------|--------------|-------------|------------|-----------|---------|---------|----------------|-------------|
| NUMBER  | NAME         | FLOOR FINISH | BASE FINISH | N. WALL    | S. WALL   | E. WALL | W. WALL | CEILING FINISH | CEILING HT. |
|         |              |              |             |            |           |         |         |                |             |
| 1704-1  | KITCHEN      |              |             |            |           |         |         |                |             |
| 1704-2  | PANTRY       |              |             |            |           |         |         |                |             |
| 1704-3  | WATER HEATER |              |             |            |           |         |         |                |             |
| 1704-4  | DINING       |              |             |            |           |         |         |                |             |
| 1704-5  | LIVING       |              |             |            |           |         |         |                |             |
| 1704-6  | BEDROOM      |              |             |            |           |         |         |                |             |
| 1704-7  | HALL         |              |             |            |           |         |         |                |             |
| 1704-8  | LAUNDRY      |              |             |            |           |         |         |                |             |
| 1704-9  | A/C          |              |             |            |           |         |         |                |             |
| 1704-10 | CLOSET       |              |             |            |           |         |         |                |             |
| 1704-11 | BATH         |              |             |            |           |         |         |                |             |

PENTHOUSE 1704 ENLARGED PLAN

SCALE: 1/4" = 1'-0"

HARRY
BAKER
SMITH
SMITH
ARCHITECTS II
P 1 1 C

189 Maple Ridge Drive Metairie, LA 70001
(504)-885-4477
central@hbsail.com :: hbsail.com
SINCE 1961

HARD ROCK HOTE

1031 CANAL STREET

NEW ORLEANS, LOUISIANA

THESE PLANS AND SPECIFICATIONS HAVE
BEEN PREPARED BY ME OR UNDER MY
CLOSE PERSONAL SUPERVISION AND TO
THE BEST OF MY KNOWLEDGE AND
BELIEF THEY COMPLY WITH ALL CITY,
STATE AND FEDERAL REQUIREMENTS, AND
I AM NOT PROVIDING CONTRACT
ADMINISTRATION.

CERTIFIED CORRECT



THIS DRAWING IS CONFIDENTIAL AND
NOT BE LOANED, REPRODUCED, COPIED,
EITHER WHOLLY OR IN PART, OR MADE
PUBLIC IN ANY MANNER WITHOUT THE
WRITTEN CONSENT OF HBSA II ARCHITECTS,
A PROFESSIONAL L.L.C. ALL RIGHTS OF
DESIGN OR INVENTION ARE RESERVED AND
WILL REMAIN THE SOLE PROPERTY OF HBSA
II ARCHITECTS A PROFESSIONAL L.L.C.


|                              | R                            | EVIS                          | ION                          | HIS                           | TOR                          | Υ                            |  |
|------------------------------|------------------------------|-------------------------------|------------------------------|-------------------------------|------------------------------|------------------------------|--|
| 4/27/2018                    | 5/4/2018                     | 5/11/2018                     | 5/18/2018                    | 5/25/2018                     | 6/1/2018                     | 6/8/2018                     |  |
| L.i.S. #2 - CLOUD REVISION 1 | L.i.S. #2 - CLOUD REVISION 2 | L.i.s., #2 - CLOUD REVISION 3 | L.i.S. #2 - CLOUD REVISION 4 | L.i.s., #2 - CLOUD REVISION 5 | L.i.s. #2 - CLOUD REVISION 6 | L.i.S. #2 - CLOUD REVISION 7 |  |

CONDO 1704

PROJECT#: 1709
PHASE: DD
TEAM: Author
CHECKER: Checker
SCALE: AS NOTED

ISSUED: 4/20/2018
SHEET#:

AI-1.48

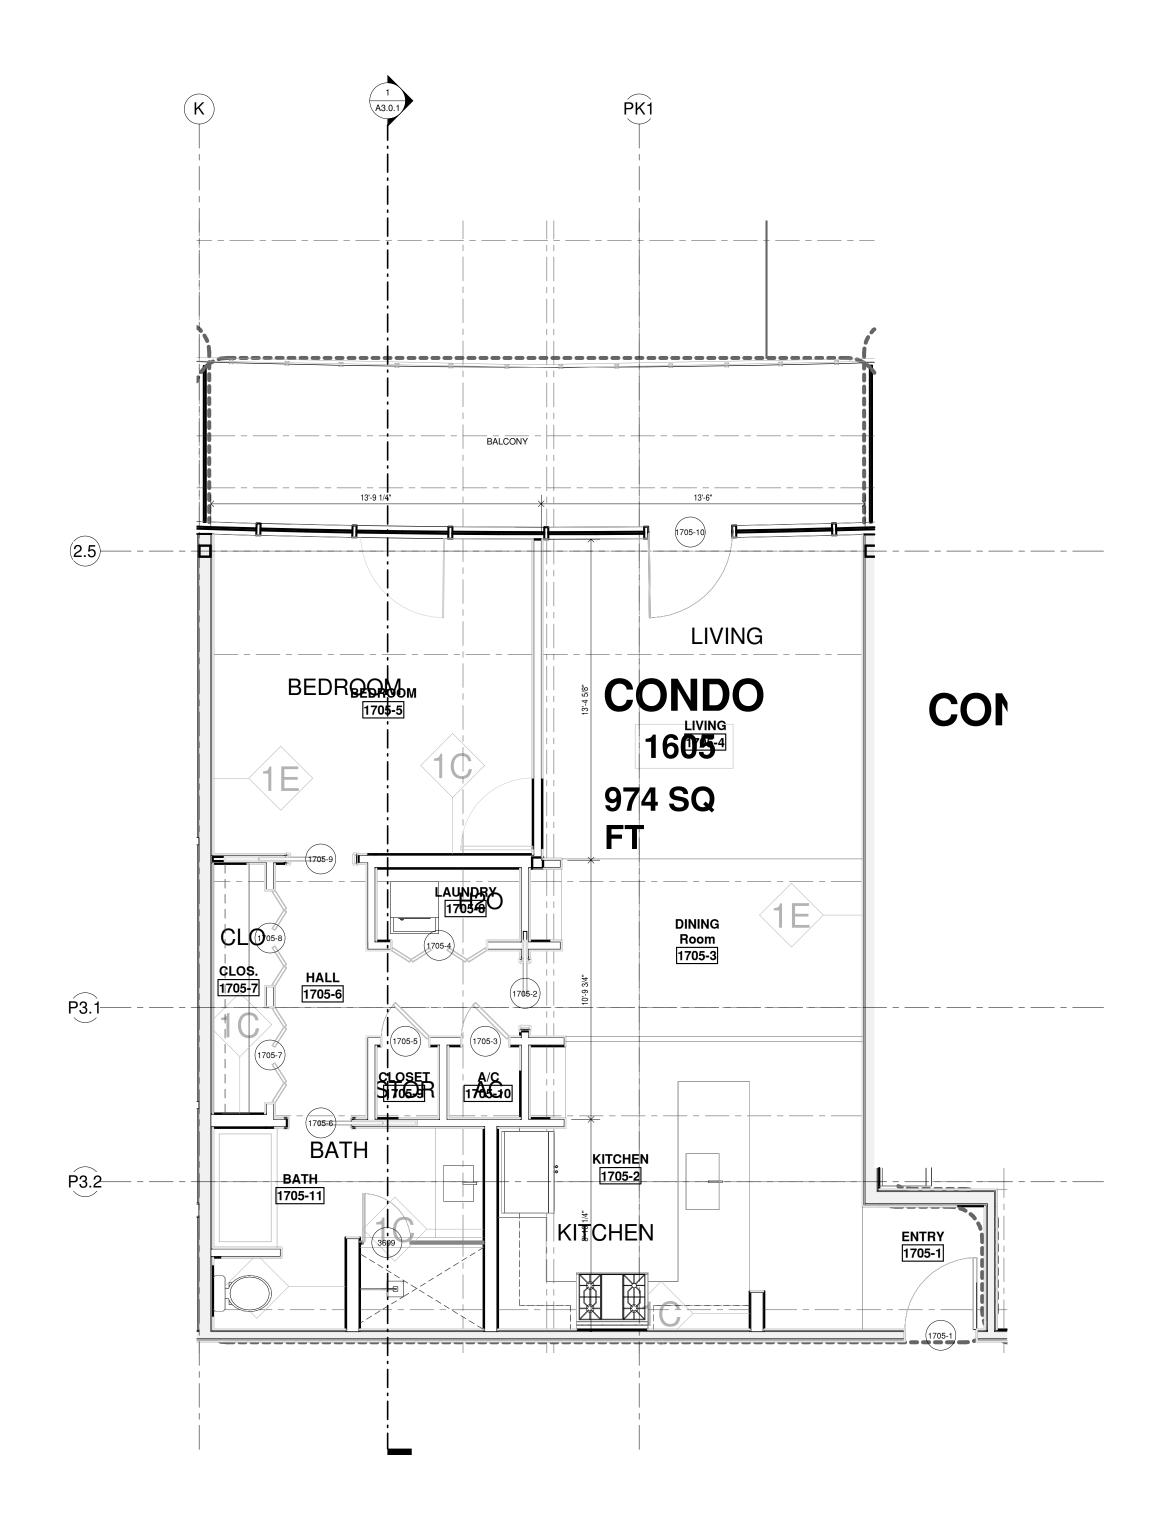

|         |             |        | DOOR    | SCHED    | ULE - UNIT 1  | 705           |            |           |             |         |
|---------|-------------|--------|---------|----------|---------------|---------------|------------|-----------|-------------|---------|
| MARK    | FROM        | 01     | WIDTH   | НЕІСНТ   | THICKNESS     | DOOR MATERIAL | DOOR FRAME | DOOR TYPE | FIRE RATING | REMARKS |
| 1705 1  | T           | ENTEN  | 01 01   | 01 011   | 01 1 0/4"     | WD            | WD         | Δ Δ       | 1110        |         |
| 1705-1  |             | ENTRY  | 3' - 0" | 8' - 0"  | 0' - 1 3/4"   | WD            | WD         | AA        | 1HR         |         |
| 1705-2  | DINING Room | HALL   | 3' - 0" | 8' - 0"  | 0' - 1 3/4"   | WD            | WD         | M         |             |         |
| 1705-3  | HALL        | A/C    | 2' - 0" | 8' - 0"  | 0' - 1 3/4"   | WD            | WD         | AA        |             |         |
| 1705-4  | LAUNDRY     | HALL   | 4' - 0" | 8' - 0"  | 0' - 1 1/2"   | WD            | WD         | L         |             |         |
| 1705-5  | HALL        | CLOSET | 2' - 0" | 8' - 0"  | 0' - 1 3/4"   | WD            | WD         | AA        |             |         |
| 1705-6  | BATH        | HALL   | 2' - 8" | 8' - 0"  | 0' - 1 3/4"   | WD            | WD         | М         |             |         |
| 1705-7  | CLOS.       | HALL   | 4' - 0" | 8' - 0"  | 0' - 1 1/2"   | WD            | WD         | L         |             |         |
| 1705-8  | HALL        | CLOS.  | 4' - 0" | 8' - 0"  | 0' - 1 1/2"   | WD            | WD         | L         |             |         |
| 1705-9  | BEDROOM     | HALL   | 3' - 0" | 8' - 0"  | 0' - 1 3/4"   | WD            | WD         | М         |             |         |
| 1705-10 | BALCONY     | LIVING | 3' - 6" | 7' - 10" | 0' - 0 15/32" | AL/GL         | AL         | K         |             |         |

|         |             |              | FINISH SC   | HEDULE - I | JNIT 1705 |         |         |                |             |
|---------|-------------|--------------|-------------|------------|-----------|---------|---------|----------------|-------------|
| NUMBER  | NAME        | FLOOR FINISH | BASE FINISH | N. WALL    | S. WALL   | E. WALL | W. WALL | CEILING FINISH | CEILING HT. |
| 1705 1  | ENTEN       | T            | I           |            |           |         |         | I              |             |
| 1705-1  | ENTRY       |              |             |            |           |         |         |                |             |
| 1705-2  | KITCHEN     |              |             |            |           |         |         |                |             |
| 1705-3  | DINING Room |              |             |            |           |         |         |                |             |
| 1705-4  | LIVING      |              |             |            |           |         |         |                |             |
| 1705-5  | BEDROOM     |              |             |            |           |         |         |                |             |
| 1705-6  | HALL        |              |             |            |           |         |         |                |             |
| 1705-7  | CLOS.       |              |             |            |           |         |         |                |             |
| 1705-8  | LAUNDRY     |              |             |            |           |         |         |                |             |
| 1705-9  | CLOSET      |              |             |            |           |         |         |                |             |
| 1705-10 | A/C         |              |             |            |           |         |         |                |             |
| 1705-11 | BATH        |              |             |            |           |         |         |                |             |
| 1705-12 | BALCONY     |              |             |            |           |         |         |                |             |

PENTHOUSE 1705 ENLARGED PLAN

SCALE: 1/4" = 1'-0"



INSTITUTE TO THE STREET NEW ORLEANS, LOUISIANA

THESE PLANS AND SPECIFICATIONS HAVE BEEN PREPARED BY ME OR UNDER MY CLOSE PERSONAL SUPERVISION AND TO THE BEST OF MY KNOWLEDGE AND BELIEF THEY COMPLY WITH ALL CITY, STATE AND FEDERAL REQUIREMENTS, AND I AM NOT PROVIDING CONTRACT ADMINISTRATION.

CERTIFIED CORRECT



THIS DRAWING IS CONFIDENTIAL AND
NOT BE LOANED, REPRODUCED, COPIED,
EITHER WHOLLY OR IN PART, OR MADE
PUBLIC IN ANY MANNER WITHOUT THE
WRITTEN CONSENT OF HBSA II ARCHITECTS,
A PROFESSIONAL LL.C. ALL RIGHTS OF
DESIGN OR INVENTION ARE RESERVED AND
WILL REMAIN THE SOLE PROPERTY OF HBSA


|                              | R                            | EVIS                         | ION                          | HIS                          | TOR                          | Υ                            |  |
|------------------------------|------------------------------|------------------------------|------------------------------|------------------------------|------------------------------|------------------------------|--|
| 4/27/2018                    | 5/4/2018                     | 5/11/2018                    | 5/18/2018                    | 5/25/2018                    | 6/1/2018                     | 6/8/2018                     |  |
|                              |                              |                              |                              |                              |                              |                              |  |
|                              |                              |                              |                              |                              |                              |                              |  |
| N 1                          | 2 N 2                        | S N G                        | N 4                          | 2N 5                         | 9 N C                        | 2 NC                         |  |
| REVISIO                      | REVISION                     | REVISIO                      | REVISIO                      | REVISIO                      | REVISIO                      | REVISIO                      |  |
| L.I.S. #2 - CLOUD REVISION 1 | L.I.S. #2 - CLOUD REVISION 2 | L.I.S. #2 - CLOUD REVISION 3 | L.I.S. #2 - CLOUD REVISION 4 | L.I.S. #2 - CLOUD REVISION 5 | L.I.S. #2 - CLOUD REVISION 6 | L.I.S. #2 - CLOUD REVISION 7 |  |
| L.I.S. #2                    |  |

CONDO 1705

PROJECT#: 1709
PHASE: DD
TEAM: Author
CHECKER: Checker
SCALE: AS NOTED

ISSUED: 4/20/2018
SHEET#:

AI-1.49

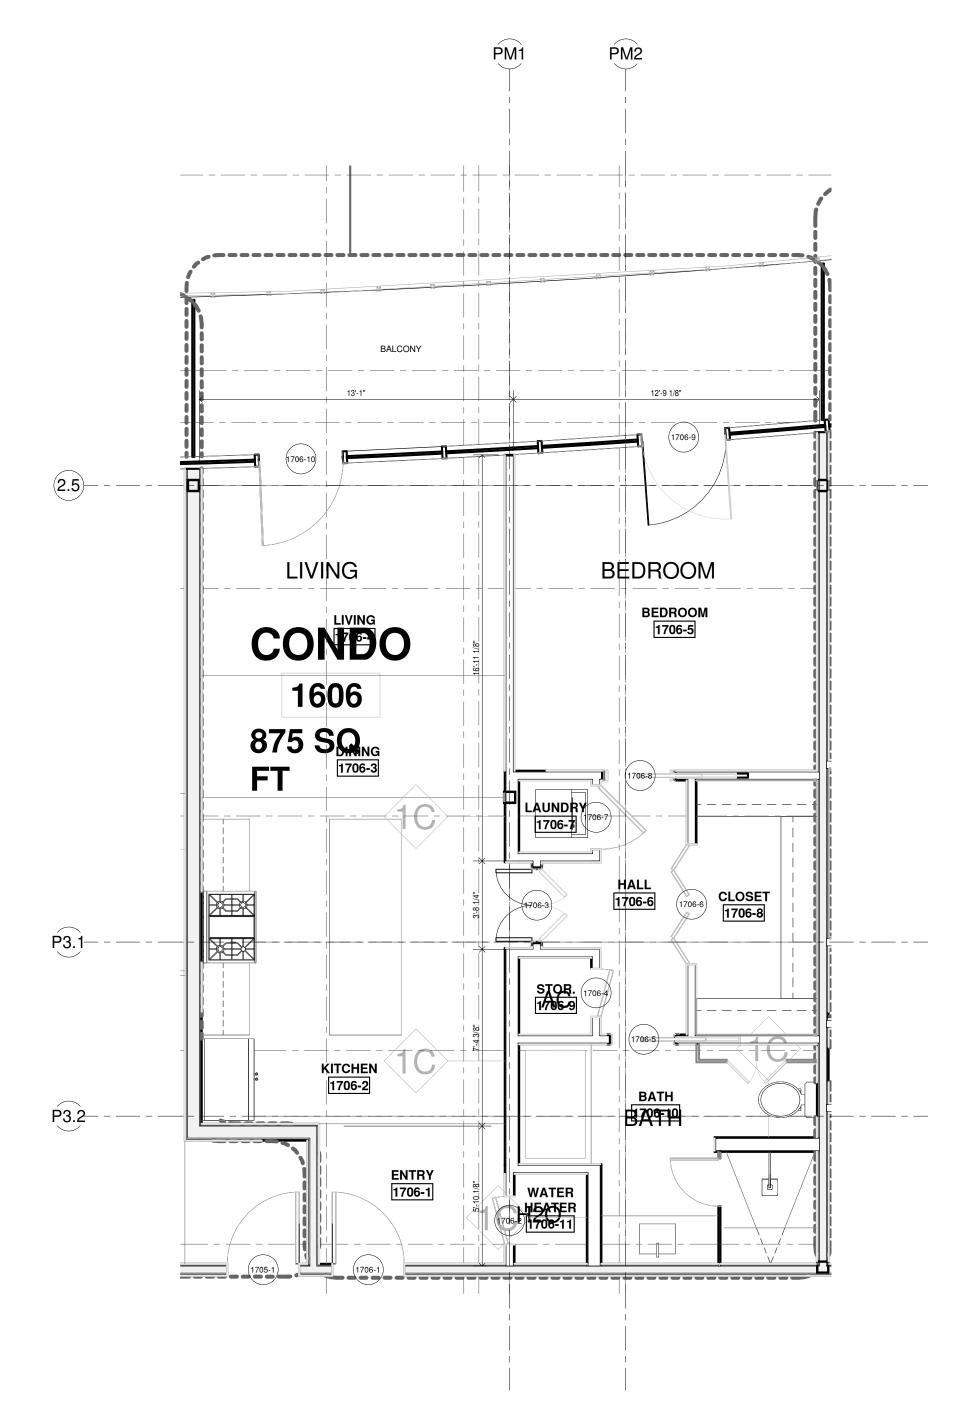

|         | DOOR SCHEDULE - UNIT 1706 |         |         |             |                  |               |            |           |             |         |  |  |
|---------|---------------------------|---------|---------|-------------|------------------|---------------|------------|-----------|-------------|---------|--|--|
| MARK    | FROM                      | TO      | WIDTH   | неіднт      | THICKNESS        | DOOR MATERIAL | DOOR FRAME | DOOR TYPE | FIRE RATING | REMARKS |  |  |
|         |                           |         |         |             |                  |               |            |           |             |         |  |  |
| 1706-1  |                           | ENTRY   | 3' - 0" | 8' - 0"     | 0' - 1 3/4"      | WD            | WD         | AA        | 1HR         |         |  |  |
| 1706-2  | WATER HEATER              | ENTRY   | 2' - 0" | 8' - 0"     | 0' - 1 3/4"      | WD            | WD         | AA        |             |         |  |  |
| 1706-3  | HALL                      | KITCHEN | 3' - 0" | 8' - 0"     | 0' - 1 3/4"      | WD            | WD         | CC        |             |         |  |  |
| 1706-4  | STOR.                     | HALL    | 2' - 0" | 8' - 0"     | 0' - 1 3/4"      | WD            | WD         | AA        |             |         |  |  |
| 1706-5  | BATH                      | HALL    | 2' - 8" | 8' - 0"     | 0' - 1 3/4"      | WD            | WD         | М         |             |         |  |  |
| 1706-6  | CLOSET                    | HALL    | 5' - 0" | 8' - 0"     | 0' - 1 1/2"      | WD            | WD         | L         |             |         |  |  |
| 1706-7  | HALL                      | LAUNDRY | 2' - 8" | 8' - 0"     | 0' - 1 3/4"      | WD            | WD         | AA        |             |         |  |  |
| 1706-8  | HALL                      | BEDROOM | 3' - 0" | 8' - 0"     | 0' - 1 3/4"      | WD            | WD         | М         |             |         |  |  |
| 1706-9  | BALCONY                   | BEDROOM | 3' - 6" | 7' -<br>10" | 0' - 0<br>15/32" | AL/GL         | AL         | K         |             |         |  |  |
| 1706-10 | BALCONY                   | LIVING  | 3' - 6" | 7' -<br>10" | 0' - 0<br>15/32" | AL/GL         | AL         | K         |             |         |  |  |

|         |              |              | FINISH SC   | HEDULE - I | JNIT 1706 |         |         |                |             |
|---------|--------------|--------------|-------------|------------|-----------|---------|---------|----------------|-------------|
| NUMBER  | NAME         | FLOOR FINISH | BASE FINISH | N. WALL    | S. WALL   | E. WALL | W. WALL | CEILING FINISH | CEILING HT. |
| 1706-1  | ENTRY        |              |             |            |           |         |         |                |             |
|         | KITCHEN      |              |             |            |           |         |         |                |             |
| 1706-2  |              |              |             |            |           |         |         |                |             |
| 1706-3  | DINING       |              |             |            |           |         |         |                |             |
| 1706-4  | LIVING       |              |             |            |           |         |         |                |             |
| 1706-5  | BEDROOM      |              |             |            |           |         |         |                |             |
| 1706-6  | HALL         |              |             |            |           |         |         |                |             |
| 1706-7  | LAUNDRY      |              |             |            |           |         |         |                |             |
| 1706-8  | CLOSET       |              |             |            |           |         |         |                |             |
| 1706-9  | STOR.        |              |             |            |           |         |         |                |             |
| 1706-9  | BALCONY      |              |             |            |           |         |         |                |             |
| 1706-10 | BATH         |              |             |            |           |         |         |                |             |
| 1706-11 | WATER HEATER |              |             |            |           |         |         |                |             |

1 17TH FLOOR PENTHOUSE

SCALE: 1/4" = 1'-0"

HARRY
BAKER
SMITH
SMITH
ARCHITECTS
II
P L C

189 Maple Ridge Drive Metairie, LA 70001
(504)-885-4477
central@hbsaii.com :: hbsaii.com
SINCE 1961

HARD ROCK HOTE

1031 CANAL STREET

NEW ORLEANS, LOUISIANA

THESE PLANS AND SPECIFICATIONS HAVE BEEN PREPARED BY ME OR UNDER MY CLOSE PERSONAL SUPERVISION AND TO THE BEST OF MY KNOWLEDGE AND BELIEF THEY COMPLY WITH ALL CITY, STATE AND FEDERAL REQUIREMENTS, AND I AM NOT PROVIDING CONTRACT ADMINISTRATION.

CERTIFIED CORRECT



THIS DRAWING IS CONFIDENTIAL AND
NOT BE LOANED, REPRODUCED, COPIED,
EITHER WHOLLY OR IN PART, OR MADE
PUBLIC IN ANY MANNER WITHOUT THE
WRITTEN CONSENT OF HBSA II ARCHITECTS
A PROFESSIONAL L.L.C. ALL RIGHTS OF
DESIGN OR INVENTION ARE RESERVED AND
WILL REMAIN THE SOLE PROPERSIONAL


| ARA 4/27/2018                | 8102/4/2018                  | EVIS                         | A PR SIO2/81/9               | H S H S S S S S S S S S S S S S S S S S | TOR 8102/1/9                 | 6/8/2018                     |  |
|------------------------------|------------------------------|------------------------------|------------------------------|---|------------------------------|------------------------------|--|
| L.I.S. #2 - CLOUD REVISION 1 | L.I.S. #2 - CLOUD REVISION 2 | L.I.S. #2 - CLOUD REVISION 3 | L.I.S. #2 - CLOUD REVISION 4 | L.I.S. #2 - CLOUD REVISION 5            | L.I.S. #2 - CLOUD REVISION 6 | L.I.S. #2 - CLOUD REVISION 7 |  |

CONDO 1706

PROJECT#: 1709
PHASE: DD
TEAM: Author
CHECKER: Checker
SCALE: AS NOTED

ISSUED: 4/20/2018
SHEET#:

Al-1.50

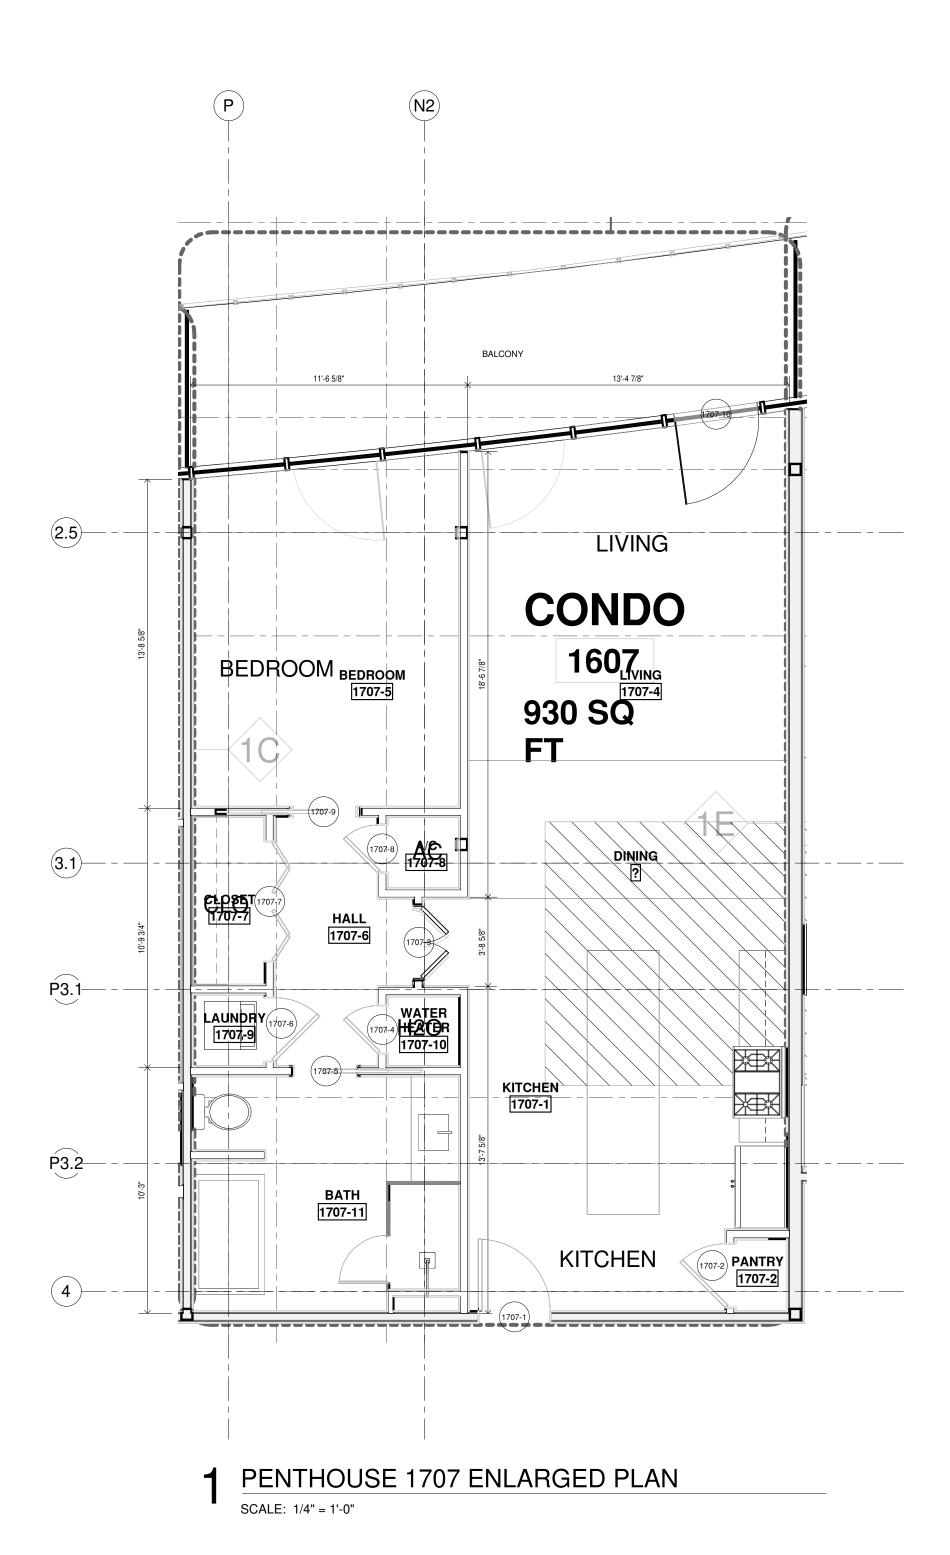

|         |         |              | DOOR S  | CHEDI       | JLE - UNIT 17 | 707           |            |           |             |         |
|---------|---------|--------------|---------|-------------|---------------|---------------|------------|-----------|-------------|---------|
| MARK    | FROM    | ОТ           | WIDTH   | HEIGHT      | THICKNESS     | DOOR MATERIAL | DOOR FRAME | DOOR TYPE | FIRE RATING | REMARKS |
| 1707-1  |         | KITCHEN      | 3' - 0" | Q' N"       | 0' - 1 3/4"   | WD            | WD         | AA        | 1HR         |         |
| 1707-1  | PANTRY  | KITCHEN      | 2' - 8" |             | 0' - 1 3/4"   | WD            | WD         | AA        | HIIN        |         |
|         |         |              |         | ļ ·         |               | -             |            | CC        |             |         |
| 1707-3  | DINING  | HALL         | 3' - 0" |             | 0' - 1 3/4"   | WD            | WD         |           |             |         |
| 1707-4  | HALL    | WATER HEATER | 2' - 0" |             | 0' - 1 3/4"   | WD            | WD         | AA        |             |         |
| 1707-5  | BATH    | HALL         | 2' - 8" |             | 0' - 1 3/4"   | WD            | WD         | M         |             |         |
| 1707-6  | LAUNDRY | HALL         | 2' - 8" | 8' - 0"     | 0' - 1 3/4"   | WD            | WD         | AA        |             |         |
| 1707-7  | CLOSET  | HALL         | 5' - 0" | 8' - 0"     | 0' - 1 1/2"   | WD            | WD         | L         |             |         |
| 1707-8  | HALL    | A/C          | 2' - 0" | 8' - 0"     | 0' - 1 3/4"   | WD            | WD         | AA        |             |         |
| 1707-9  | BEDROOM | HALL         | 3' - 0" | 8' - 0"     | 0' - 1 3/4"   | WD            | WD         | М         |             |         |
| 1707-10 | LIVING  |              | 3' - 6" | 7' -<br>10" | 0' - 0 15/32" | AL/GL         | AL         | K         |             |         |

|         |              |              | FINISH SC   | HEDULE - I | JNIT 1707 |         |         |                |             |
|---------|--------------|--------------|-------------|------------|-----------|---------|---------|----------------|-------------|
| NUMBER  | NAME         | FLOOR FINISH | BASE FINISH | N. WALL    | S. WALL   | E. WALL | W. WALL | CEILING FINISH | CEILING HT. |
|         |              |              |             |            |           |         |         |                |             |
| 1707-1  | KITCHEN      |              |             |            |           |         |         |                |             |
| 1707-2  | PANTRY       |              |             |            |           |         |         |                |             |
| 1707-4  | LIVING       |              |             |            |           |         |         |                |             |
| 1707-5  | BEDROOM      |              |             |            |           |         |         |                |             |
| 1707-6  | HALL         |              |             |            |           |         |         |                |             |
| 1707-7  | CLOSET       |              |             |            |           |         |         |                |             |
| 1707-8  | A/C          |              |             |            |           |         |         |                |             |
| 1707-9  | LAUNDRY      |              |             |            |           |         |         |                |             |
| 1707-10 | WATER HEATER |              |             |            |           |         |         |                |             |
| 1707-11 | BATH         |              |             |            |           |         |         |                |             |

HARRY
BAKER
SMITH
SMITH
ARCHITECTS II
P L L C

189 Maple Ridge Drive Metairie, LA 70001
(504)-885-4477
central@hbsaii.com :: hbsaii.com
SINCE 1961

HARD ROCK HOTE

1031 CANAL STREET

NEW ORLEANS, LOUISIANA

HESE PLANS AND SPECIFICATIONS HAVE
BEEN PREPARED BY ME OR UNDER MY
CLOSE PERSONAL SUPERVISION AND TO
THE BEST OF MY KNOWLEDGE AND
BELIEF THEY COMPLY WITH ALL CITY,
ITATE AND FEDERAL REQUIREMENTS, AND
I AM NOT PROVIDING CONTRACT
ADMINISTRATION.

CERTIFIED CORRECT




THIS DRAWING IS CONFIDENTIAL AND NOT BE LOANED, REPRODUCED, COPIED, EITHER WHOLLY OR IN PART, OR MADE PUBLIC IN ANY MANNER WITHOUT THE WRITTEN CONSENT OF HBSA II ARCHITECTS, A PROFESSIONAL L.L.C. ALL RIGHTS OF DESIGN OR INVENTION ARE RESERVED AND WILL REMAIN THE SOLE PROPERTY OF HBSA

| II AR                        | CHITE                        | CTS                          | A PR                         | OFES:                        | SIONA                        | L L.L.                       | .C . |
|------------------------------|------------------------------|------------------------------|------------------------------|------------------------------|------------------------------|------------------------------|------|
|                              | R                            | EVIS                         | ION                          | HIS                          | TOR                          | Υ                            |      |
| 4/27/2018                    | 5/4/2018                     | 5/11/2018                    | 5/18/2018                    | 5/25/2018                    | 6/1/2018                     | 6/8/2018                     |      |
| L.I.S. #2 - CLOUD REVISION 1 | L.I.S. #2 - CLOUD REVISION 2 | L.I.S. #2 - CLOUD REVISION 3 | L.I.S. #2 - CLOUD REVISION 4 | L.I.S. #2 - CLOUD REVISION 5 | L.i.s. #2 - CLOUD REVISION 6 | L.I.S. #2 - CLOUD REVISION 7 |      |

CONDO 1707

PROJECT#: 1709
PHASE: DD
TEAM: Author
CHECKER: Checker
SCALE: AS NOTED
ISSUED: 4/20/2018

AI-1.51

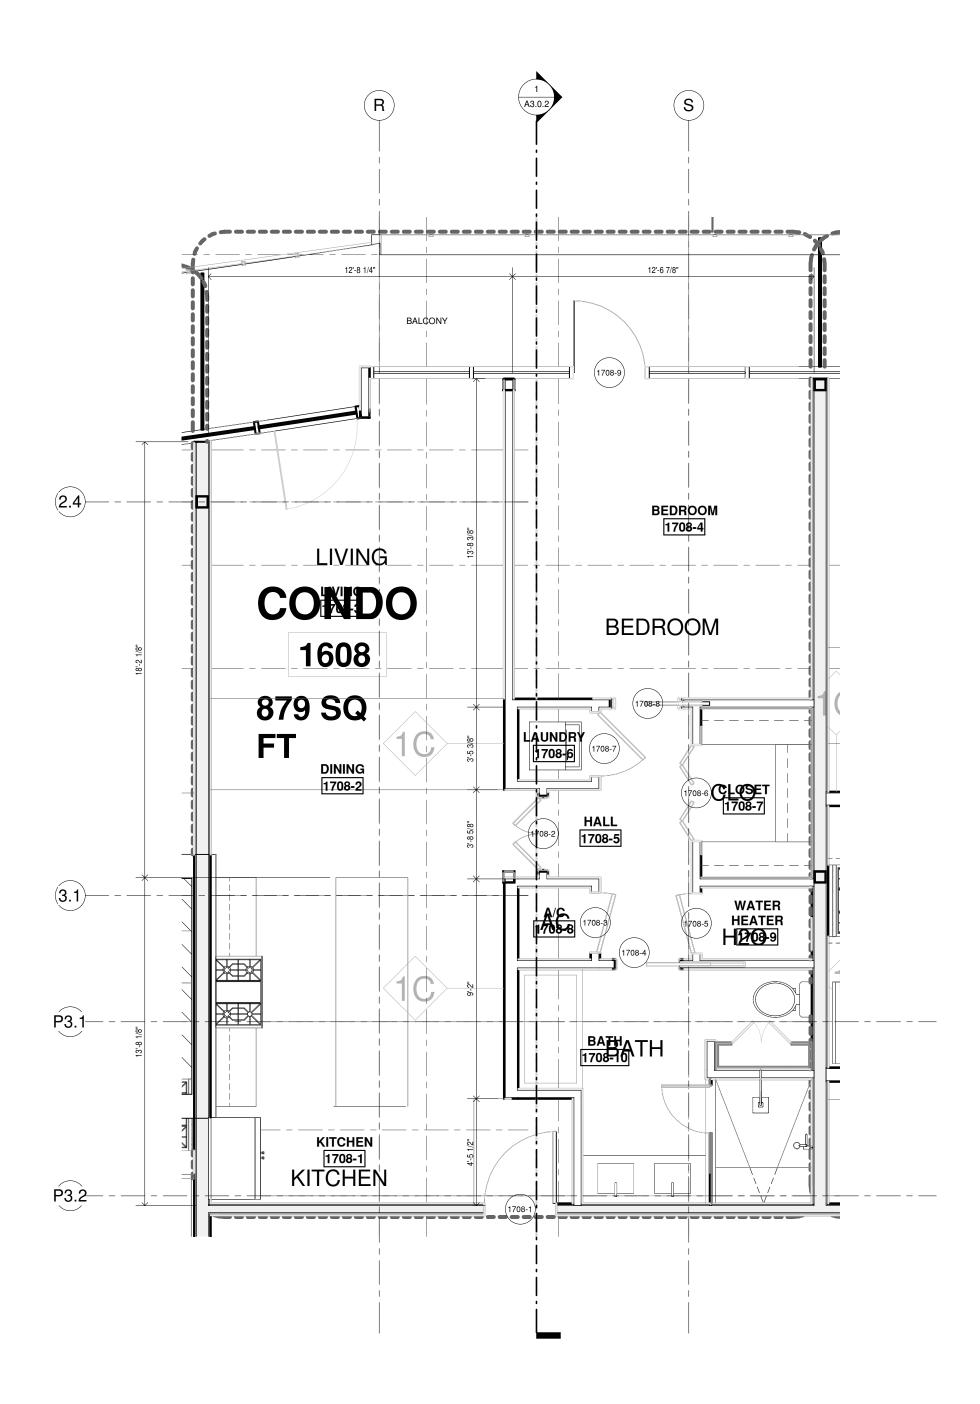

PENTHOUSE 1708 ENLARGED PLAN

SCALE: 1/4" = 1'-0"

|        |              |         | DOOR S  | CHEDU   | JLE - UNIT  | 1708          |            |           |             |         |
|--------|--------------|---------|---------|---------|-------------|---------------|------------|-----------|-------------|---------|
| MARK   | FROM         | ТО      | WIDTH   | HEIGHT  | THICKNESS   | DOOR MATERIAL | DOOR FRAME | DOOR TYPE | FIRE RATING | REMARKS |
|        |              |         |         |         |             |               |            |           |             |         |
| 1708-1 |              | KITCHEN | 3' - 0" | 8' - 0" | 0' - 1 3/4" | WD            | WD         | AA        | 1HR         |         |
| 1708-2 | HALL         | DINING  | 3' - 0" | 8' - 0" | 0' - 1 3/4" | WD            | WD         | CC        |             |         |
| 1708-3 | HALL         | A/C     | 2' - 6" | 8' - 0" | 0' - 1 3/4" | WD            | НМ         | AA        |             |         |
| 1708-4 | HALL         | BATH    | 2' - 8" | 8' - 0" | 0' - 1 3/4" | WD            | WD         | М         |             |         |
| 1708-5 | WATER HEATER | HALL    | 2' - 6" | 8' - 0" | 0' - 1 3/4" | WD            | НМ         | AA        |             |         |
| 1708-6 | HALL         | CLOSET  | 4' - 0" | 8' - 0" | 0' - 1 1/2" | WD            | WD         | L         |             |         |
| 1708-7 | HALL         | LAUNDRY | 2' - 8" | 8' - 0" | 0' - 1 3/4" | WD            | WD         | AA        |             |         |
| 1708-8 | HALL         | BEDROOM | 3' - 0" | 8' - 0" | 0' - 1 3/4" | WD            | WD         | М         |             |         |
| 1708-9 | BEDROOM      |         | 3' - 0" | 8' - 2" | 0' - 1 1/2" | AL/GL         | AL         | K         |             |         |

|         |              |              | FINISH SC   | HEDULE - I | JNIT 1708 |         |         |                |             |
|---------|--------------|--------------|-------------|------------|-----------|---------|---------|----------------|-------------|
| NUMBER  | NAME         | FLOOR FINISH | BASE FINISH | N. WALL    | S. WALL   | E. WALL | W. WALL | CEILING FINISH | CEILING HT. |
| 1708-1  | KITCHEN      |              |             | Τ          |           | 1       |         |                |             |
| 1708-1  | DINING       |              |             |            |           |         |         |                |             |
| 1708-2  | LIVING       |              |             |            |           |         |         |                |             |
| 1708-3  | BEDROOM      |              |             |            |           |         |         |                |             |
| 1708-4  | HALL         |              |             |            |           |         |         |                |             |
| 1708-5  | LAUNDRY      |              |             |            |           |         |         |                |             |
|         |              |              |             |            |           |         |         |                |             |
| 1708-7  | CLOSET       |              |             |            |           |         |         |                |             |
| 1708-8  | A/C          |              |             |            |           |         |         |                |             |
| 1708-9  | WATER HEATER |              |             |            |           |         |         |                |             |
| 1708-10 | BATH         |              |             |            |           |         |         |                |             |

189 Maple Ridge Drive Metairie, LA 70001 (504)-885-4477 central@hbsaii.com :-: hbsaii.com SINCE 1961

1031 CANAL STREET NEW ORLEANS, LOUISIANA


THESE PLANS AND SPECIFICATIONS HAVE BEEN PREPARED BY ME OR UNDER MY CLOSE PERSONAL SUPERVISION AND TO THE BEST OF MY KNOWLEDGE AND BELIEF THEY COMPLY WITH ALL CITY, STATE AND FEDERAL REQUIREMENTS, AND I AM NOT PROVIDING CONTRACT ADMINISTRATION. CERTIFIED CORRECT



CONDO 1708

PROJECT#: 1709 PHASE: DD TEAM: Author CHECKER: Checker SCALE: AS NOTED

<u>ISSUED: 4/20/20</u>18

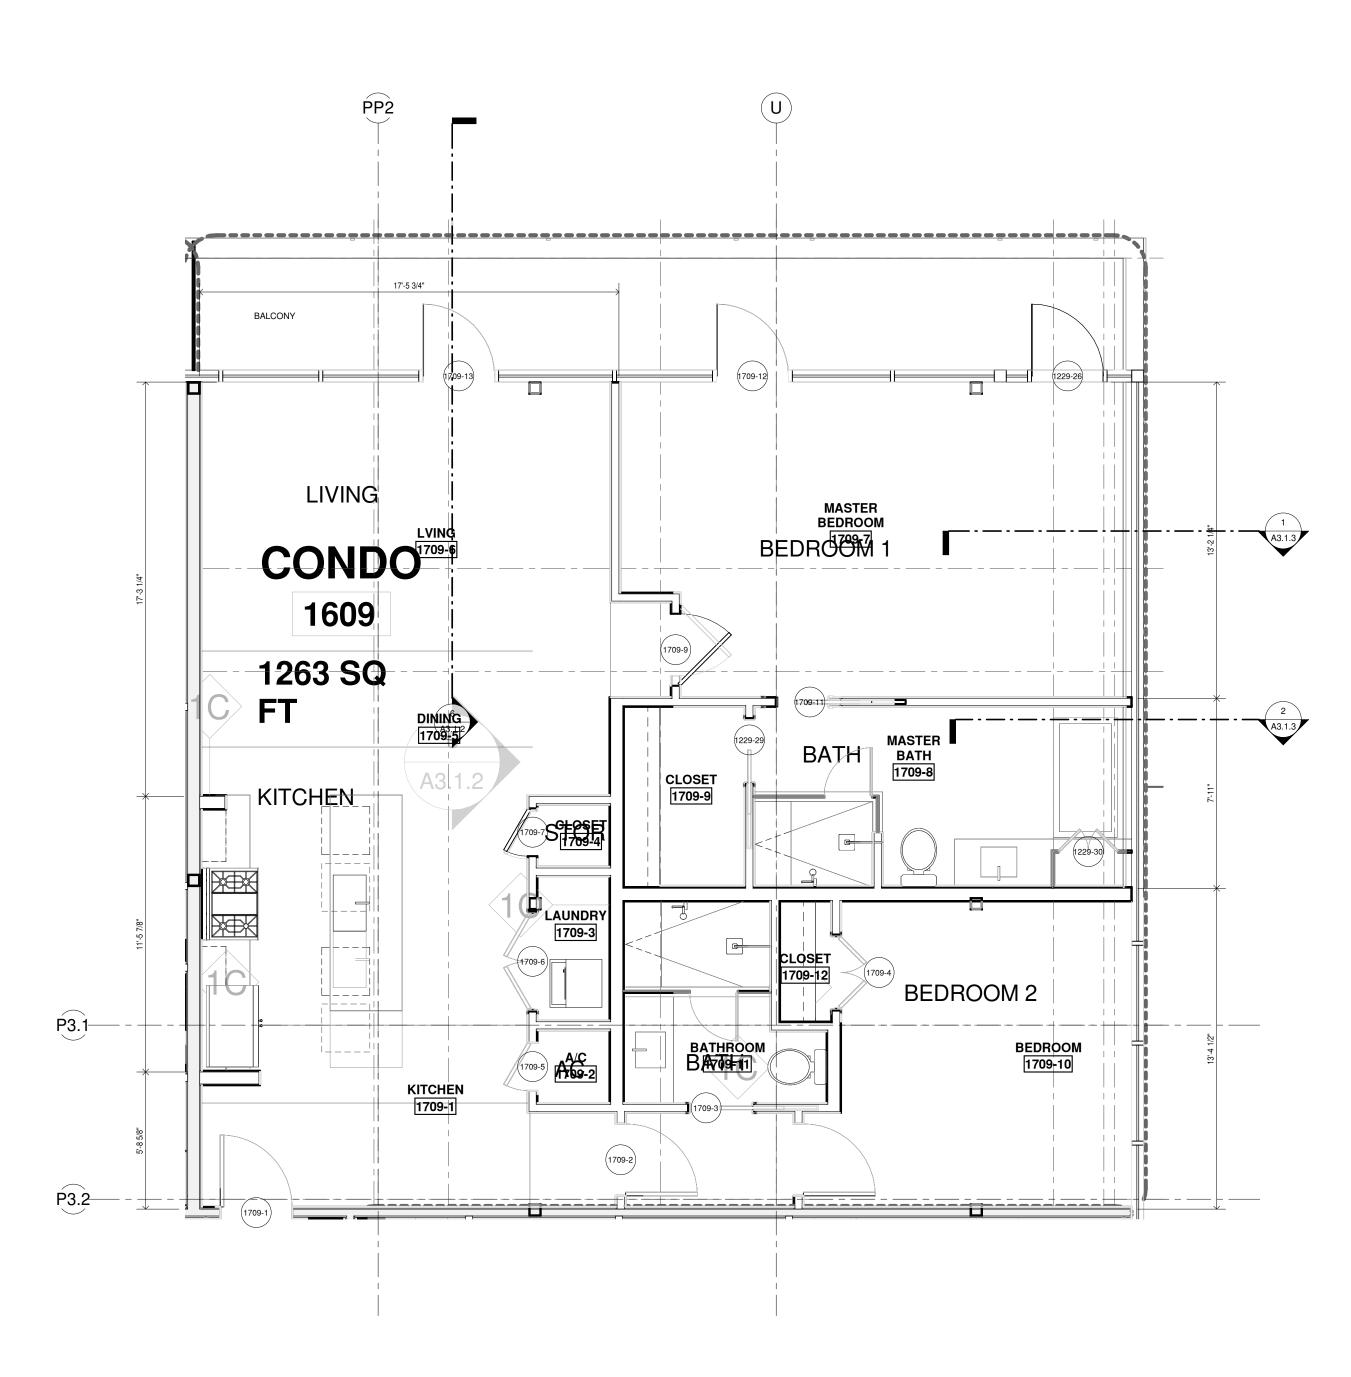

| 1 | PENTHOUSE 1709 ENLARGED PLAN |
|---|------------------------------|
| I | SCALE: 1/4" = 1'-0"          |

|         | DOOR SCHEDULE - UNIT 1709 |                |         |         |             |               |            |           |             |                    |  |  |  |
|---------|---------------------------|----------------|---------|---------|-------------|---------------|------------|-----------|-------------|--------------------|--|--|--|
| MARK    | FROM                      | ТО             | WIDTH   | HEIGHT  | THICKNESS   | DOOR MATERIAL | DOOR FRAME | DOOR TYPE | FIRE RATING | REMARKS            |  |  |  |
|         |                           |                |         |         |             |               |            |           |             |                    |  |  |  |
| 1709-1  |                           | KITCHEN        | 3' - 0" |         | 0' - 1 3/4" | WD            | WD         | AA        | 1HR         |                    |  |  |  |
| 1709-2  | KITCHEN                   |                | 3' - 0" | 8' - 0" | 0' - 1 3/4" | WD            | WD         | AA        |             |                    |  |  |  |
| 1709-3  | BATHROOM                  |                | 2' - 8" | 8' - 0" | 0' - 1 3/4" | WD            | WD         | M         |             |                    |  |  |  |
| 1709-4  | CLOSET                    | BEDROOM        | 3' - 0" | 8' - 0" | 0' - 1 3/4" | WD            | WD         | CC        |             |                    |  |  |  |
| 1709-5  | A/C                       | KITCHEN        | 2' - 0" | 8' - 0" | 0' - 1 3/4" | WD            | WD         | AA        |             |                    |  |  |  |
| 1709-6  | LAUNDRY                   | KITCHEN        | 4' - 0" | 8' - 0" | 0' - 1 3/4" | WD            | WD         | CC        |             | DOUBLE DOOR / PAIR |  |  |  |
| 1709-7  | CLOSET                    | KITCHEN        | 2' - 0" | 8' - 0" | 0' - 1 3/4" | WD            | WD         | CC        |             | DOUBLE DOOR / PAIR |  |  |  |
| 1709-9  | LVING                     | MASTER BEDROOM | 3' - 0" | 8' - 0" | 0' - 1 3/4" | WD            | WD         | М         |             |                    |  |  |  |
| 1709-11 | MASTER BATH               | MASTER BEDROOM | 2' - 8" | 8' - 0" | 0' - 1 3/4" | WD            | WD         | М         |             |                    |  |  |  |
| 1709-12 | MASTER BEDROOM            |                | 3' - 0" | 8' - 2" | 0' - 1 1/2" | AL/GL         | AL         | K         |             |                    |  |  |  |
| 1709-13 | LVING                     |                | 3' - 0" | 8' - 2" | 0' - 1 1/2" | AL/GL         | AL         | K         |             |                    |  |  |  |

|         | FINISH SCHEDULE - UNIT 1709 |              |             |         |         |         |         |                |             |  |  |  |  |
|---------|-----------------------------|--------------|-------------|---------|---------|---------|---------|----------------|-------------|--|--|--|--|
| NUMBER  | NAME                        | FLOOR FINISH | BASE FINISH | N. WALL | S. WALL | E. WALL | W. WALL | CEILING FINISH | CEILING HT. |  |  |  |  |
| 1700 1  | KITOLIEN                    |              |             |         |         |         |         |                |             |  |  |  |  |
| 1709-1  | KITCHEN                     |              |             |         |         |         |         |                |             |  |  |  |  |
|         | A/C                         |              |             |         |         |         |         |                |             |  |  |  |  |
| 1709-3  | LAUNDRY                     |              |             |         |         |         |         |                |             |  |  |  |  |
| 1709-4  | CLOSET                      |              |             |         |         |         |         |                |             |  |  |  |  |
| 1709-5  | DINING                      |              |             |         |         |         |         |                |             |  |  |  |  |
| 1709-6  | LVING                       |              |             |         |         |         |         |                |             |  |  |  |  |
| 1709-7  | MASTER BEDROOM              |              |             |         |         |         |         |                |             |  |  |  |  |
| 1709-8  | MASTER BATH                 |              |             |         |         |         |         |                |             |  |  |  |  |
| 1709-9  | CLOSET                      |              |             |         |         |         |         |                |             |  |  |  |  |
| 1709-10 | BEDROOM                     |              |             |         |         |         |         |                |             |  |  |  |  |
|         | BATHROOM                    |              |             |         |         |         |         |                |             |  |  |  |  |
| 1709-12 | CLOSET                      |              |             |         |         |         |         |                |             |  |  |  |  |

189 Maple Ridge Drive Metairie, LA 70001 (504)-885-4477 central@hbsaii.com :-: hbsaii.com SINCE 1961


1031 CANAL STREET NEW ORLEANS, LOUISIANA

STATE AND FEDERAL REQUIREMENTS, AND I AM NOT PROVIDING CONTRACT ADMINISTRATION. CERTIFIED CORRECT

| II AR                        | CHITE                        | CTS                          | A PR                         | OFES:                        | SIONA                        | L L.L.                       | .C . |
|------------------------------|------------------------------|------------------------------|------------------------------|------------------------------|------------------------------|------------------------------|------|
|                              | R                            | EVIS                         | ION                          | HIS                          | TOR                          | Υ                            |      |
| 4/27/2018                    | 5/4/2018                     | 5/11/2018                    | 5/18/2018                    | 5/25/2018                    | 6/1/2018                     | 6/8/2018                     |      |
| L.I.S. #2 - CLOUD REVISION 1 | L.I.S. #2 - CLOUD REVISION 2 | L.I.S. #2 - CLOUD REVISION 3 | L.I.S. #2 - CLOUD REVISION 4 | L.I.S. #2 - CLOUD REVISION 5 | L.i.s. #2 - CLOUD REVISION 6 | L.I.S. #2 - CLOUD REVISION 7 |      |

CONDO 1709

PROJECT#: 1709 PHASE: DD TEAM: Author CHECKER: Checker SCALE: AS NOTED <u>ISSUED: 4/20/20</u>18

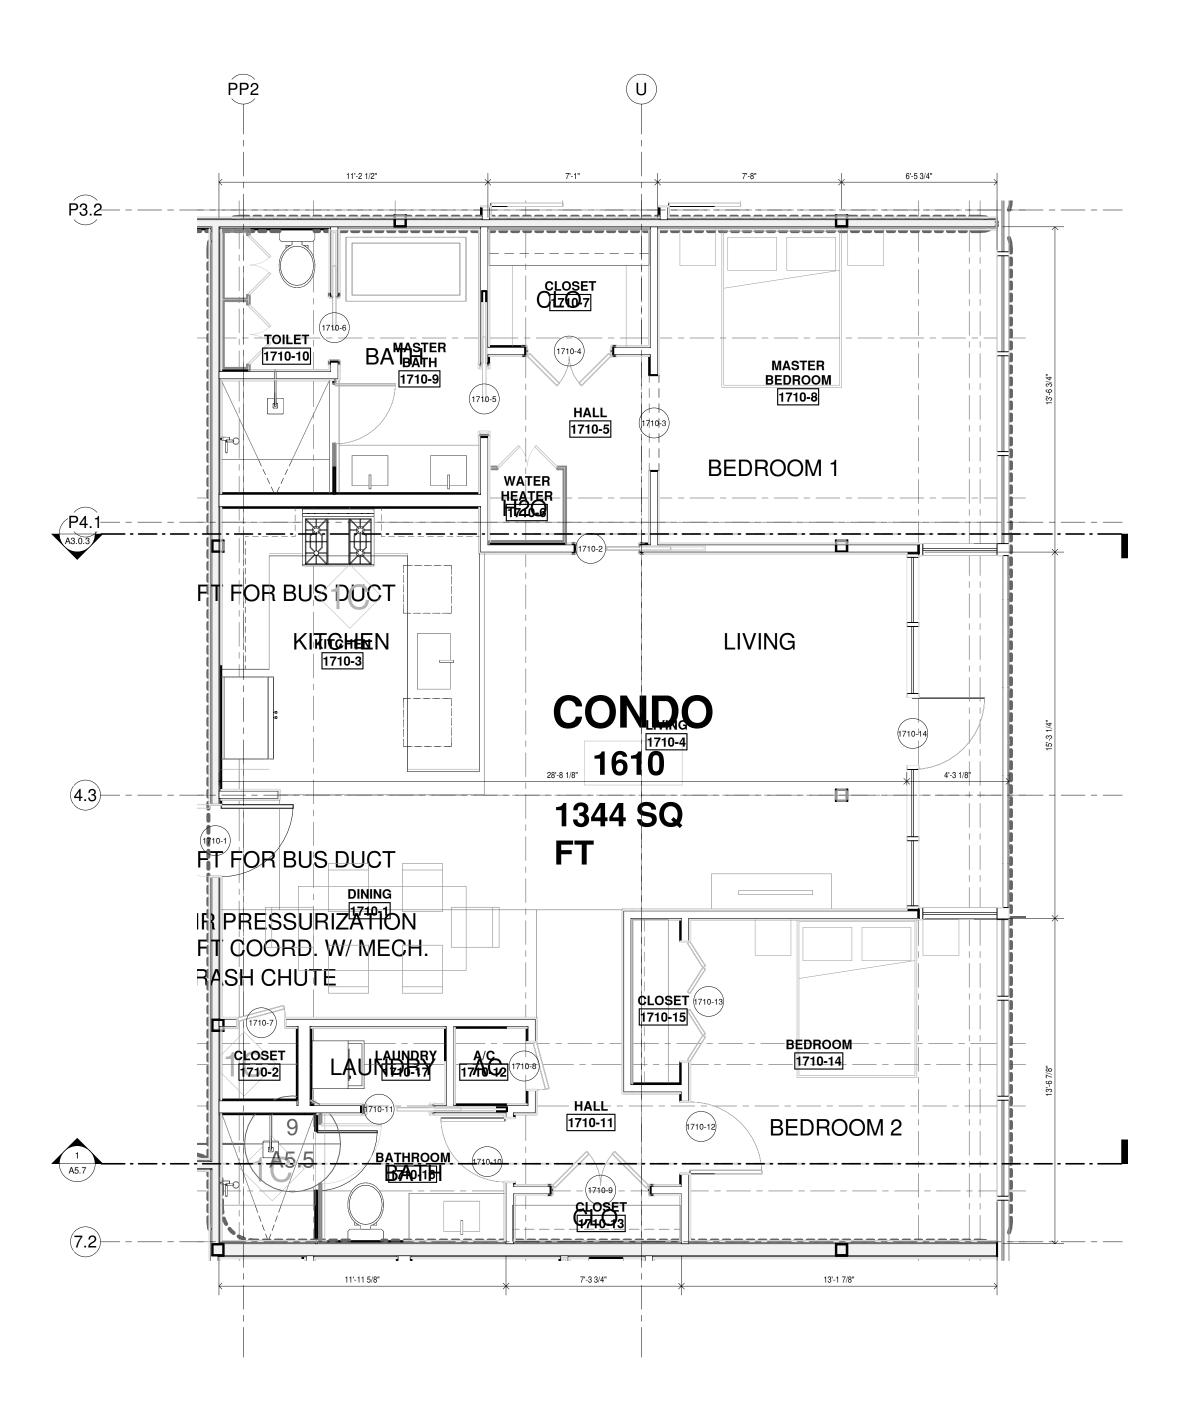

PENTHOUSE 1710 ENLARGED PLAN SCALE: 1/4" = 1'-0"

|         |              | ı              | DOOR S   | CHEDI   | JLE - UNIT  | 1710          |            |           |             |                    |
|---------|--------------|----------------|----------|---------|-------------|---------------|------------|-----------|-------------|--------------------|
| MARK    | FROM         | 01             | WIDTH    | НЕІСНТ  | THICKNESS   | DOOR MATERIAL | DOOR FRAME | DOOR TYPE | FIRE RATING | REMARKS            |
| 1710 1  | I            | DIMINIO        | 01 011   | 01 011  | 01 4 0/411  | WD            | WD         |           | 4115        |                    |
| 1710-1  |              | DINING         | 3' - 0"  |         | 0' - 1 3/4" |               | WD         | AA        | 1HR         |                    |
| 1710-2  | LIVING       | WATER HEATER   | 2' - 8"  | -       | 0' - 1 3/4" | WD            | WD         | М         |             |                    |
| 1710-3  | WATER HEATER | MASTER BEDROOM | 4' - 0"  | 7' - 0" |             | N/A           | WD         | N/A       |             | FRAMED OPENING     |
| 1710-4  | CLOSET       | WATER HEATER   | 3' - 6"  | 8' - 0" | 0' - 1 3/4" | WD            | WD         | CC        |             |                    |
| 1710-5  | MASTER BATH  | WATER HEATER   | 3' - 0"  | 8' - 0" | 0' - 1 3/4" | WD            | WD         | М         |             |                    |
| 1710-6  | MASTER BATH  | TOILET         | 2' - 8"  | 8' - 0" | 0' - 1 3/4" | WD            | WD         | М         |             |                    |
| 1710-7  | DINING       | CLOSET         | 2' - 0"  | 8' - 0" | 0' - 1 3/4" | WD            | WD         | AA        |             |                    |
| 1710-8  | HALL         | A/C            | 2' - 0"  | 8' - 0" | 0' - 1 3/4" | WD            | WD         | AA        |             |                    |
| 1710-9  | CLOSET       | HALL           | 4' - 0"  | 8' - 0" | 0' - 1 3/4" | WD            | WD         | CC        |             | DOUBLE DOOR / PAIR |
| 1710-10 | HALL         | BATHROOM       | 2' - 8"  | 8' - 0" | 0' - 1 3/4" | WD            | WD         | AA        |             |                    |
| 1710-11 | LAUNDRY      | BATHROOM       | 3' - 0"  | 8' - 0" | 0' - 1 3/4" | WD            | WD         | М         |             |                    |
| 1710-12 | BEDROOM      | HALL           | 3' - 0"  | 8' - 0" | 0' - 1 3/4" | WD            | WD         | AA        |             |                    |
| 1710-13 | CLOSET       | BEDROOM        | 5' - 0"  | 8' - 0" | 0' - 1 1/2" | WD            | WD         | L         |             |                    |
| 1710-14 |              | LIVING         | 2' - 10" | 8' - 2" | 0' - 1 1/2" | AL/GL         | AL         | K         |             |                    |

|         | FINISH SCHEDULE - UNIT 1710 |              |             |            |           |         |         |                |             |  |  |  |  |
|---------|-----------------------------|--------------|-------------|------------|-----------|---------|---------|----------------|-------------|--|--|--|--|
|         |                             |              | FINISH SC   | HEDULE - ( | 1/10 וואע |         |         |                |             |  |  |  |  |
| NUMBER  | NAME                        | FLOOR FINISH | BASE FINISH | N. WALL    | S. WALL   | E. WALL | W. WALL | CEILING FINISH | CEILING HT. |  |  |  |  |
| 1710-1  | DINING                      |              |             |            |           |         |         |                |             |  |  |  |  |
| 1710-2  | CLOSET                      |              |             |            |           |         |         |                |             |  |  |  |  |
| 1710-3  | KITCHEN                     |              |             |            |           |         |         |                |             |  |  |  |  |
| 1710-4  | LIVING                      |              |             |            |           |         |         |                |             |  |  |  |  |
| 1710-5  | HALL                        |              |             |            |           |         |         |                |             |  |  |  |  |
| 1710-6  | WATER HEATER                |              |             |            |           |         |         |                |             |  |  |  |  |
| 1710-7  | CLOSET                      |              |             |            |           |         |         |                |             |  |  |  |  |
| 1710-8  | MASTER BEDROOM              |              |             |            |           |         |         |                |             |  |  |  |  |
| 1710-9  | MASTER BATH                 |              |             |            |           |         |         |                |             |  |  |  |  |
|         | TOILET                      |              |             |            |           |         |         |                |             |  |  |  |  |
|         | HALL                        |              |             |            |           |         |         |                |             |  |  |  |  |
| 1710-12 |                             |              |             |            |           |         |         |                |             |  |  |  |  |
|         | CLOSET                      |              |             |            |           |         |         |                |             |  |  |  |  |
|         | BEDROOM                     |              |             |            |           |         |         |                |             |  |  |  |  |
|         | CLOSET                      |              |             |            |           |         |         |                |             |  |  |  |  |
|         | BATHROOM                    |              |             |            |           |         |         |                |             |  |  |  |  |
| 1710-17 | LAUNDRY                     |              |             |            |           |         |         |                |             |  |  |  |  |

189 Maple Ridge Drive Metairie, LA 70001 (504)-885-4477 central@hbsaii.com :-: hbsaii.com SINCE 1961


1031 CANAL STREET NEW ORLEANS, LOUISIANA

ADMINISTRATION. CERTIFIED CORRECT



|                              | R                            | EVIS                         |                              |                              | TOR                          | Υ                            |   |
|------------------------------|------------------------------|------------------------------|------------------------------|------------------------------|------------------------------|------------------------------|---|
| 4/27/2018                    | 5/4/2018                     | 5/11/2018                    | 5/18/2018                    | 5/25/2018                    | 6/1/2018                     | 6/8/2018                     |   |
| L.i.S. #2 - CLOUD REVISION 1 | L.I.S. #2 - CLOUD REVISION 2 | L.I.S. #2 - CLOUD REVISION 3 | L.I.S. #2 - CLOUD REVISION 4 | L.I.S. #2 - CLOUD REVISION 5 | L.I.S. #2 - CLOUD REVISION 6 | L.I.S. #2 - CLOUD REVISION 7 |   |
| -                            | 2                            | 3                            | 4                            | 5                            | 9                            | 7                            | 8 |

CONDO 1710

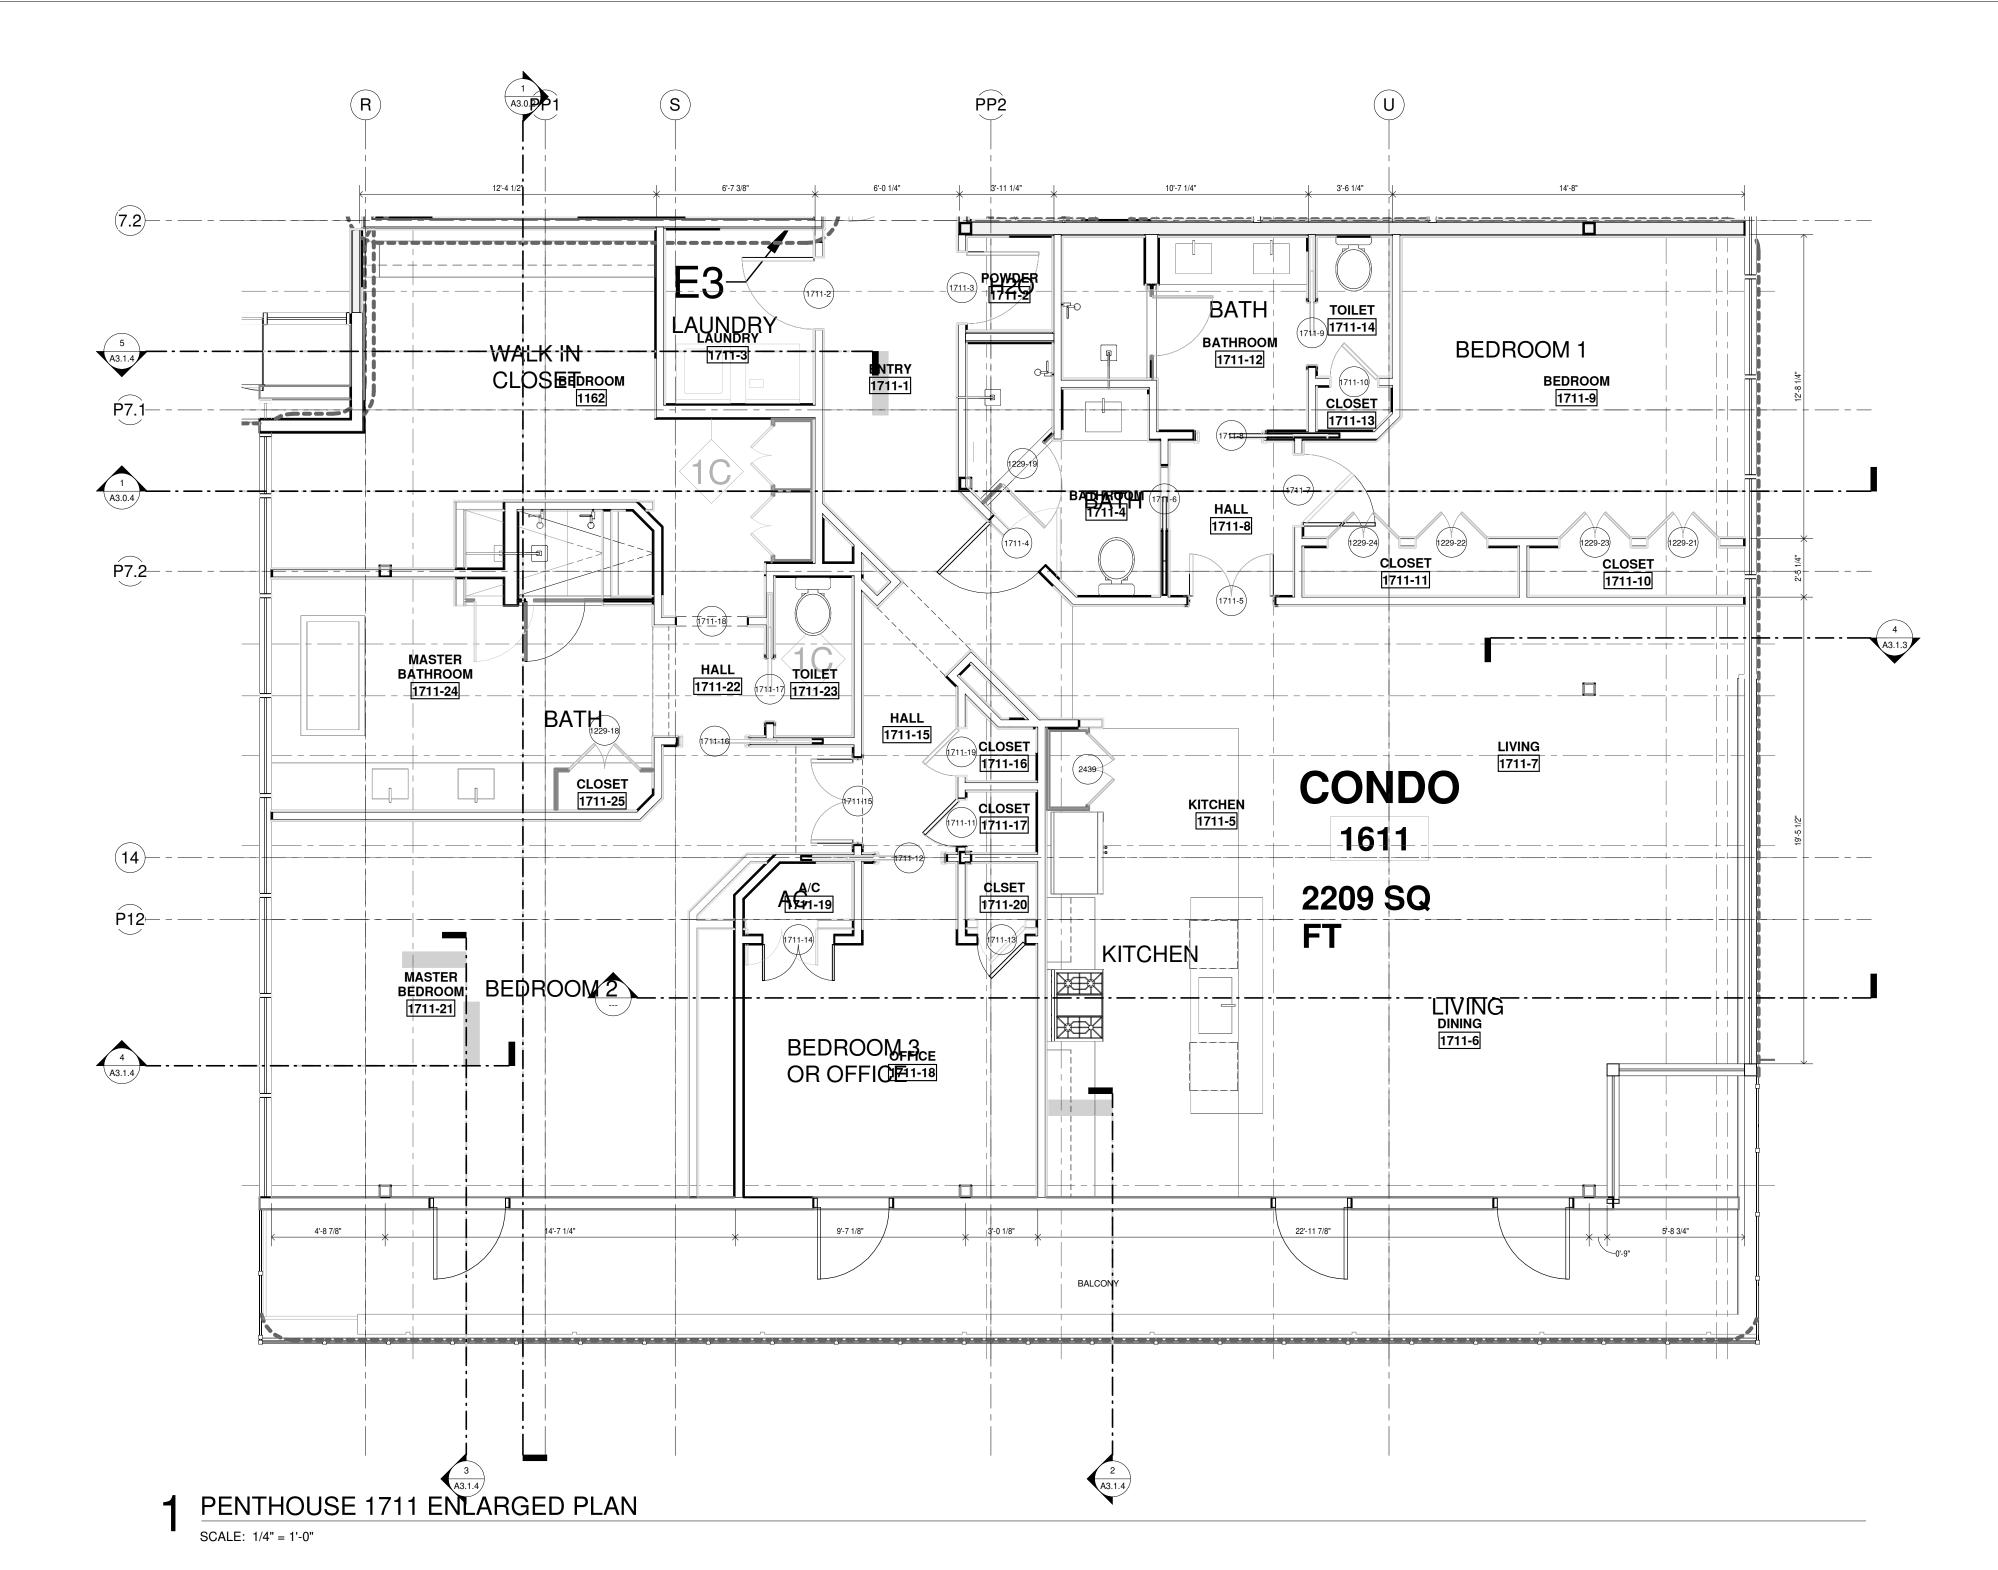

|         |              |                | DOOR :  | SCHED   | ULE - UNI   | Γ 1711        |            |           |             |                    |
|---------|--------------|----------------|---------|---------|-------------|---------------|------------|-----------|-------------|--------------------|
| MARK    | FROM         | Q.             | WIDTH   | HEIGHT  | THICKNESS   | DOOR MATERIAL | DOOR FRAME | DOOR TYPE | FIRE RATING | REMARKS            |
| 1711-1  |              | ENTRY          | 3' - 0" | 8' - N" | 0' - 1 3/4" | WD            | WD         | AA        | 1HR         |                    |
| 1711-2  | ENTRY        | LAUNDRY        | 3' - 0" |         | 0' - 1 3/4" |               | WD         | AA        | 11111       |                    |
| 1711-3  | ENTRY        | POWDER         | 3' - 0" |         | 0' - 1 3/4" |               | WD         | AA        |             |                    |
| 1711-4  | BATHROOM     | ENTRY          | 3' - 0" |         | 0' - 1 3/4" |               | WD         | CC        |             |                    |
| 1711-5  | 271111100111 | HALL           | 3' - 6" |         | 0' - 1 3/4" |               | WD         | CC        |             |                    |
| 1711-6  | HALL         | BATHROOM       | 2' - 8" |         | 0' - 1 3/4" |               | WD         | M         |             |                    |
| 1711-7  | HALL         | BEDROOM        | 3' - 0" |         | 0' - 1 3/4" |               | WD         | AA        |             |                    |
| 1711-8  | BATHROOM     | HALL           | 3' - 0" | 8' - 0" | 0' - 1 3/4" | WD            | WD         | М         |             |                    |
| 1711-9  | BATHROOM     | TOILET         | 2' - 8" | 8' - 0" | 0' - 1 3/4" | WD            | WD         | М         |             |                    |
| 1711-10 | CLOSET       | TOILET         | 2' - 0" | 8' - 0" | 0' - 1 3/4" | WD            | WD         | AA        |             |                    |
| 1711-11 | CLOSET       | HALL           | 2' - 0" | 8' - 0" | 0' - 1 3/4" | WD            | WD         | CC        |             |                    |
| 1711-12 | OFFICE       | HALL           | 3' - 0" | 8' - 0" | 0' - 1 3/4" | WD            | WD         | М         |             |                    |
| 1711-13 | CLSET        | OFFICE         | 2' - 0" | 8' - 0" | 0' - 1 3/4" | WD            | WD         | AA        |             |                    |
| 1711-14 | OFFICE       | A/C            | 3' - 0" | 8' - 0" | 0' - 1 3/4" | WD            | WD         | AA        |             |                    |
| 1711-15 | HALL         | MASTER BEDROOM | 3' - 6" | 8' - 0" | 0' - 1 3/4" | WD            | WD         | CC        |             |                    |
| 1711-16 | HALL         | MASTER BEDROOM | 3' - 0" | 8' - 0" | 0' - 1 3/4" | WD            | WD         | М         |             |                    |
| 1711-17 | HALL         | TOILET         | 2' - 8" | 8' - 0" | 0' - 1 3/4" | WD            | WD         | М         |             |                    |
| 1711-18 | HALL         | BEDROOM        | 3' - 0" | 8' - 0" |             | N/A           | WD         | N/A       |             | FRAMED OPENING     |
| 1711-19 | CLOSET       | HALL           | 2' - 0" | 8' - 0" | 0' - 1 3/4" | WD            | WD         | CC        |             | DOUBLE DOOR / PAIR |

|         | FINISH SCHEDULE - UNIT 1711 |              |             |         |         |         |         |                |             |  |  |  |  |
|---------|-----------------------------|--------------|-------------|---------|---------|---------|---------|----------------|-------------|--|--|--|--|
| NUMBER  | NAME                        | FLOOR FINISH | BASE FINISH | N. WALL | S. WALL | E. WALL | W. WALL | CEILING FINISH | CEILING HT. |  |  |  |  |
| 1711    | ENTD)/                      |              |             |         |         |         |         | T              |             |  |  |  |  |
| 1711-1  | ENTRY                       |              |             |         |         |         |         |                |             |  |  |  |  |
| 1711-2  | POWDER                      |              |             |         |         |         |         |                |             |  |  |  |  |
| 1711-3  | LAUNDRY                     |              |             |         |         |         |         |                |             |  |  |  |  |
|         | BATHROOM                    |              |             |         |         |         |         |                |             |  |  |  |  |
|         | KITCHEN                     |              |             |         |         |         |         |                |             |  |  |  |  |
| 1711-6  | DINING                      |              |             |         |         |         |         |                |             |  |  |  |  |
| 1711-7  | LIVING                      |              |             |         |         |         |         |                |             |  |  |  |  |
|         | HALL                        |              |             |         |         |         |         |                |             |  |  |  |  |
|         | BEDROOM                     |              |             |         |         |         |         |                |             |  |  |  |  |
|         | CLOSET<br>CLOSET            |              |             |         |         |         |         |                |             |  |  |  |  |
|         | BATHROOM                    |              |             |         |         |         |         |                |             |  |  |  |  |
|         | CLOSET                      |              |             |         |         |         |         |                |             |  |  |  |  |
| 1711-13 |                             |              |             |         |         |         |         |                |             |  |  |  |  |
| 1711-14 |                             |              |             |         |         |         |         |                |             |  |  |  |  |
|         | CLOSET                      |              |             |         |         |         |         |                |             |  |  |  |  |
|         | CLOSET                      |              |             |         |         |         |         |                |             |  |  |  |  |
| 1711-17 |                             |              |             |         |         |         |         |                |             |  |  |  |  |
| 1711-18 |                             |              |             |         |         |         |         |                |             |  |  |  |  |
| 1711-19 |                             |              |             |         |         |         |         |                |             |  |  |  |  |
|         | MASTER BEDROOM              |              |             |         |         |         |         |                |             |  |  |  |  |
| 1711-21 |                             |              |             |         |         |         |         |                |             |  |  |  |  |
| 1711-22 |                             |              |             |         |         |         |         |                |             |  |  |  |  |
|         | MASTER<br>BATHROOM          |              |             |         |         |         |         |                |             |  |  |  |  |
| 1711-25 | CLOSET                      |              |             |         |         |         |         |                |             |  |  |  |  |

189 Maple Ridge Drive Metairie, LA 70001 (504)-885-4477 central@hbsaii.com ∷ hbsaii.com SINCE 1961

1031 CANAL STREET NEW ORLEANS, LOUISIANA


CERTIFIED CORRECT



|  |                              | R                            | EVIS                         | ION                          | HIS                          | TOR                          | Υ                            |  |
|--|------------------------------|------------------------------|------------------------------|------------------------------|------------------------------|------------------------------|------------------------------|--|
|  | 4/27/2018                    | 5/4/2018                     | 5/11/2018                    | 5/18/2018                    | 5/25/2018                    | 6/1/2018                     | 6/8/2018                     |  |
|  | L.I.S. #2 - CLOUD REVISION 1 | L.I.S. #2 - CLOUD REVISION 2 | L.i.S. #2 - CLOUD REVISION 3 | L.I.S. #2 - CLOUD REVISION 4 | L.I.S. #2 - CLOUD REVISION 5 | L.I.S. #2 - CLOUD REVISION 6 | L.I.S. #2 - CLOUD REVISION 7 |  |
|  |                              |                              |                              |                              |                              |                              |                              |  |

CONDO 1711

PROJECT#: 1709 PHASE: DD TEAM: Author CHECKER: Checker SCALE: AS NOTED <u>ISSUED: 4/20/20</u>18

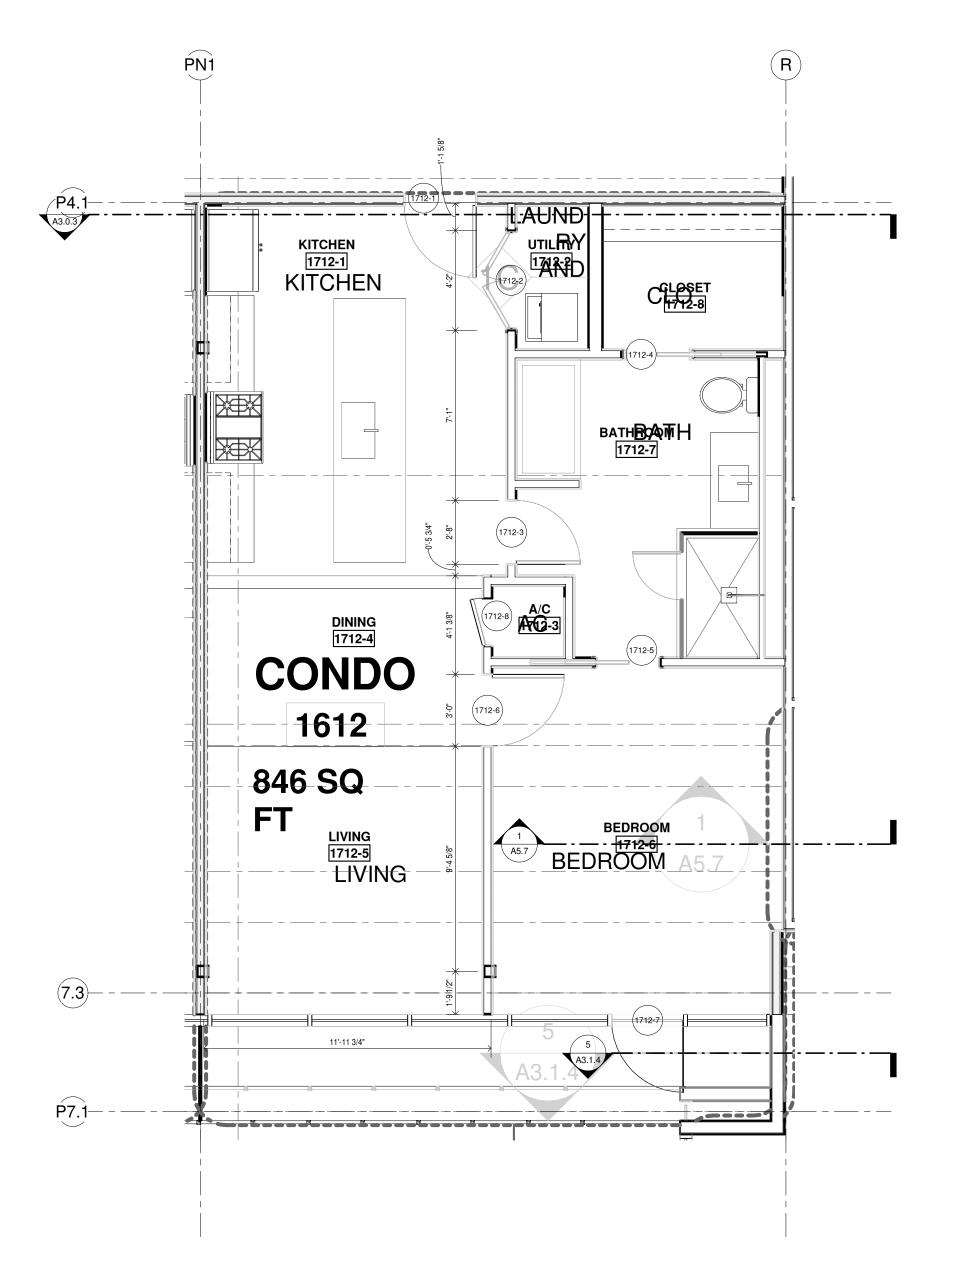

|        | DOOR SCHEDULE - UNIT 1712 |          |         |         |             |               |            |           |             |                    |  |  |  |  |
|--------|---------------------------|----------|---------|---------|-------------|---------------|------------|-----------|-------------|--------------------|--|--|--|--|
| MARK   | FROM                      | 10       | WIDTH   | HEIGHT  | THICKNESS   | DOOR MATERIAL | DOOR FRAME | DOOR TYPE | FIRE RATING | REMARKS            |  |  |  |  |
|        |                           |          |         |         | 1           |               |            |           |             |                    |  |  |  |  |
| 1712-1 | KITCHEN                   |          | 3' - 0" | 8' - 0" | 0' - 1 3/4" | WD            | WD         | AA        | 1HR         |                    |  |  |  |  |
| 1712-2 | KITCHEN                   | UTILITY  | 4' - 0" | 8' - 0" | 0' - 1 3/4" | WD            | WD         | CC        |             | DOUBLE DOOR / PAIR |  |  |  |  |
| 1712-3 | KITCHEN                   | BATHROOM | 2' - 8" | 8' - 0" | 0' - 1 3/4" | WD            | WD         | AA        |             |                    |  |  |  |  |
| 1712-4 | BATHROOM                  | CLOSET   | 3' - 0" | 8' - 0" | 0' - 1 3/4" | WD            | WD         | М         |             |                    |  |  |  |  |
| 1712-5 | BATHROOM                  | BEDROOM  | 2' - 8" | 8' - 0" | 0' - 1 3/4" | WD            | WD         | М         |             |                    |  |  |  |  |
| 1712-6 | DINING                    | BEDROOM  | 3' - 0" | 8' - 0" | 0' - 1 3/4" | WD            | WD         | AA        |             |                    |  |  |  |  |
| 1712-7 | BEDROOM                   |          | 3' - 0" | 8' - 2" | 0' - 1 1/2" | AL/GL         | AL         | K         |             |                    |  |  |  |  |
| 1712-8 | DINING                    | A/C      | 2' - 0" | 8' - 0" | 0' - 1 3/4" | WD            | WD         | CC        |             |                    |  |  |  |  |
| 1712-9 |                           | BEDROOM  | 3' - 0" | 8' - 0" | 0' - 1 3/4" | WD            | WD         | AA        |             |                    |  |  |  |  |

|        |          |              | FINISH SC   | HEDULE - U | JNIT 1712 |         |         |                |             |
|--------|----------|--------------|-------------|------------|-----------|---------|---------|----------------|-------------|
| NUMBER | NAME     | FLOOR FINISH | BASE FINISH | N. WALL    | S. WALL   | E. WALL | W. WALL | CEILING FINISH | CEILING HT. |
|        |          |              |             |            |           |         |         |                |             |
| 1712-1 | KITCHEN  |              |             |            |           |         |         |                |             |
| 1712-2 | UTILITY  |              |             |            |           |         |         |                |             |
| 1712-3 | A/C      |              |             |            |           |         |         |                |             |
| 1712-4 | DINING   |              |             |            |           |         |         |                |             |
| 1712-5 | LIVING   |              |             |            |           |         |         |                |             |
| 1712-6 | BEDROOM  |              |             |            |           |         |         |                |             |
| 1712-7 | BATHROOM |              |             |            |           |         |         |                |             |
| 1712-8 | CLOSET   |              |             |            |           |         |         |                |             |

PENTHOUSE 1712 ENLARGED PLAN

SCALE: 1/4" = 1'-0"

HARRY
BAKER
SMITH
SMITH
ARCHITECTS II
P L C

189 Maple Ridge Drive Metairie, LA 70001
(504)-885-4477
central@hbsaii.com :: hbsaii.com
SINCE 1961

HARD ROCK HOTE

1031 CANAL STREET

NEW ORLEANS, LOUISIANA

THESE PLANS AND SPECIFICATIONS HAVE BEEN PREPARED BY ME OR UNDER MY CLOSE PERSONAL SUPERVISION AND TO THE BEST OF MY KNOWLEDGE AND BELIEF THEY COMPLY WITH ALL CITY, STATE AND FEDERAL REQUIREMENTS, AND I AM NOT PROVIDING CONTRACT ADMINISTRATION.

CERTIFIED CORRECT



THIS DRAWING IS CONFIDENTIAL AND NOT BE LOANED, REPRODUCED, COPIED, EITHER WHOLLY OR IN PART, OR MADE PUBLIC IN ANY MANNER WITHOUT THE WRITTEN CONSENT OF HBSA II ARCHITECTS, A PROFESSIONAL L.L.C. ALL RIGHTS OF DESIGN OR INVENTION ARE RESERVED AND WILL REMAIN THE SOLE PROPERTY OF HBSA


| 80                           |                              | EVIS                         |                              |                              | TOR                          |                              |  |
|------------------------------|------------------------------|------------------------------|------------------------------|------------------------------|------------------------------|------------------------------|--|
| 4/27/2018                    | 5/4/2018                     | 5/11/2018                    | 5/18/2018                    | 5/25/2018                    | 6/1/2018                     | 6/8/2018                     |  |
| L.I.S. #2 - CLOUD REVISION 1 | L.I.S. #2 - CLOUD REVISION 2 | L.I.S. #2 - CLOUD REVISION 3 | L.I.S. #2 - CLOUD REVISION 4 | L.I.S. #2 - CLOUD REVISION 5 | L.I.S. #2 - CLOUD REVISION 6 | L.I.S. #2 - CLOUD REVISION 7 |  |
| L.I.S. #                     | L.I.S.#                      | L.I.S.#                      | L.I.S.#                      | L.I.S.#                      | L.I.S.#                      | L.I.S.#                      |  |

CONDO 1712

PROJECT#: 1709
PHASE: DD
TEAM: Author
CHECKER: Checker
SCALE: AS NOTED

ISSUED: 4/20/2018
SHEET#:

AI-1.56

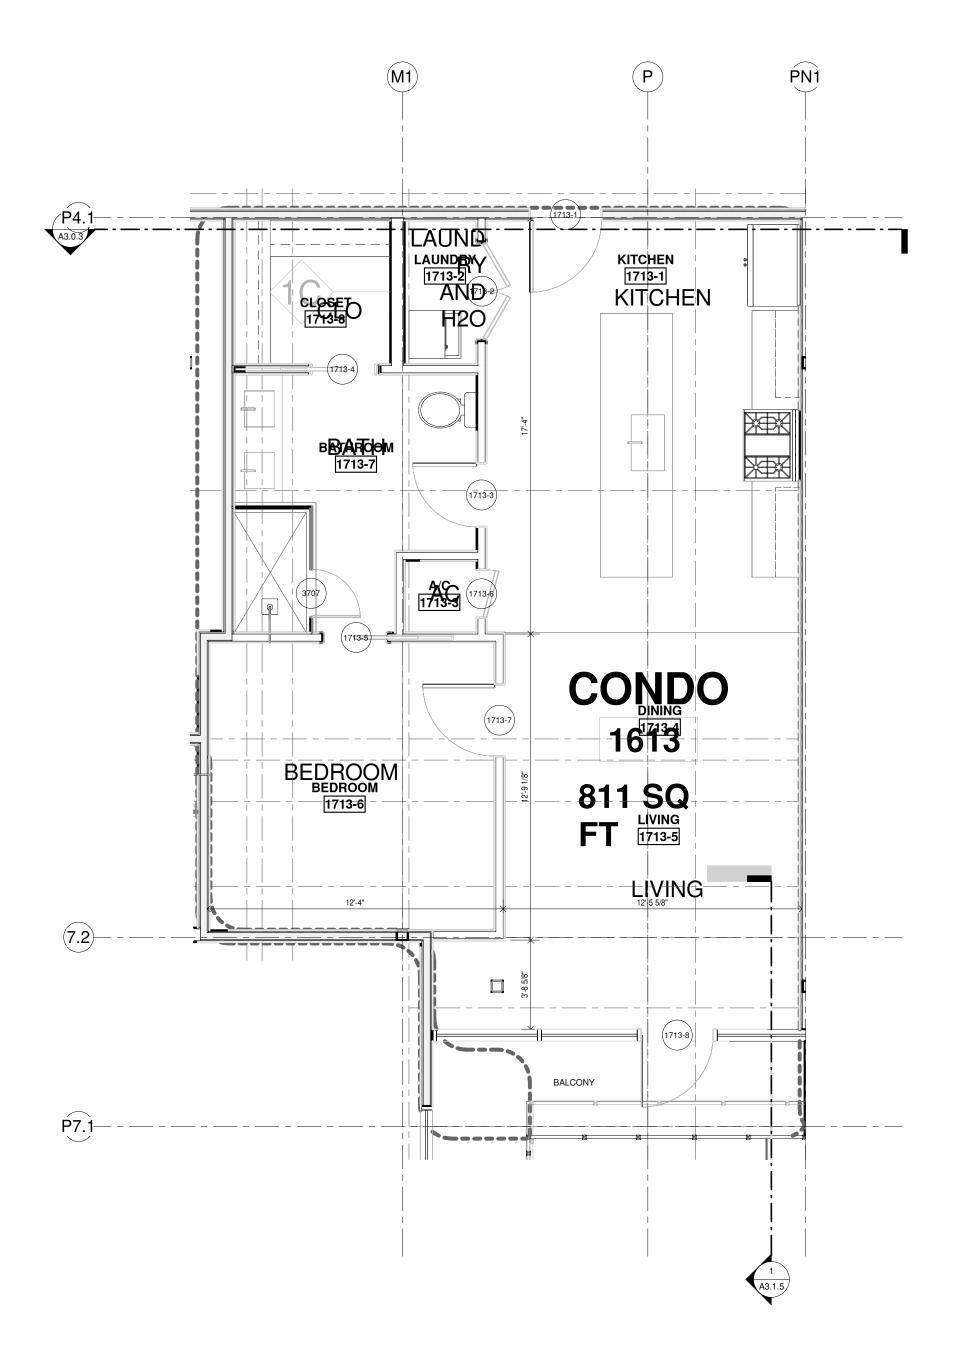

|        |          | 1        | DOOR S  | CHEDU   | JLE - UNIT  | 1713          |            |           |             |                    |
|--------|----------|----------|---------|---------|-------------|---------------|------------|-----------|-------------|--------------------|
| MARK   | FROM     | 01       | WIDTH   | НЕІСНТ  | THICKNESS   | DOOR MATERIAL | DOOR FRAME | DOOR TYPE | FIRE RATING | REMARKS            |
|        |          |          |         |         |             |               |            |           |             |                    |
| 1713-1 |          | KITCHEN  | 3' - 0" | 8' - 0" | 0' - 1 3/4" | WD            | WD         | AA        | 1HR         |                    |
| 1713-2 | LAUNDRY  | KITCHEN  | 4' - 0" | 8' - 0" | 0' - 1 3/4" | WD            | WD         | CC        |             | DOUBLE DOOR / PAIR |
| 1713-3 | KITCHEN  | BATHROOM | 2' - 8" | 8' - 0" | 0' - 1 3/4" | WD            | WD         | AA        |             |                    |
| 1713-4 | CLOSET   | BATHROOM | 3' - 0" | 8' - 0" | 0' - 1 3/4" | WD            | WD         | М         |             |                    |
| 1713-5 | BATHROOM | BEDROOM  | 2' - 8" | 8' - 0" | 0' - 1 3/4" | WD            | WD         | М         |             |                    |
| 1713-6 | A/C      | KITCHEN  | 2' - 0" | 8' - 0" | 0' - 1 3/4" | WD            | WD         | AA        |             |                    |
| 1713-7 | BEDROOM  | DINING   | 3' - 0" | 8' - 0" | 0' - 1 3/4" | WD            | WD         | AA        |             |                    |
| 1713-8 | LIVING   |          | 3' - 0" | 8' - 2" | 0' - 1 1/2" | AL/GL         | AL         | K         |             |                    |

|        |          |              | FINISH SC   | HEDULE - l | JNIT 1713 |         |         |                |             |
|--------|----------|--------------|-------------|------------|-----------|---------|---------|----------------|-------------|
| NUMBER | NAME     | FLOOR FINISH | BASE FINISH | N. WALL    | S. WALL   | E. WALL | W. WALL | CEILING FINISH | CEILING HT. |
|        |          |              |             |            |           |         |         |                |             |
| 1713-1 | KITCHEN  |              |             |            |           |         |         |                |             |
| 1713-2 | LAUNDRY  |              |             |            |           |         |         |                |             |
| 1713-3 | A/C      |              |             |            |           |         |         |                |             |
| 1713-4 | DINING   |              |             |            |           |         |         |                |             |
| 1713-5 | LIVING   |              |             |            |           |         |         |                |             |
| 1713-6 | BEDROOM  |              |             |            |           |         |         |                |             |
| 1713-7 | BATHROOM |              |             |            |           |         |         |                |             |
| 1713-8 | CLOSET   |              |             |            |           |         |         |                |             |

## PENTHOUSE 1713 ENLARGED PLAN

SCALE: 1/4" = 1'-0"

189 Maple Ridge Drive Metairie, LA 70001 (504)-885-4477 central@hbsaii.com :-: hbsaii.com SINCE 1961

1031 CANAL STREET NEW ORLEANS, LOUISIANA

STATE AND FEDERAL REQUIREMENTS, AND I AM NOT PROVIDING CONTRACT ADMINISTRATION. CERTIFIED CORRECT




|                              | R                            | EVIS                         | ION                          | HIS                          | TOR                          | Υ                            |   |
|------------------------------|------------------------------|------------------------------|------------------------------|------------------------------|------------------------------|------------------------------|---|
| 4/27/2018                    | 5/4/2018                     | 5/11/2018                    | 5/18/2018                    | 5/25/2018                    | 6/1/2018                     | 6/8/2018                     |   |
|                              |                              |                              |                              |                              |                              |                              |   |
|                              |                              |                              |                              |                              |                              |                              |   |
| VISION 1                     | VISION 2                     | VISION 3                     | VISION 4                     | VISION 5                     | VISION 6                     | VISION 7                     |   |
| L.I.S. #2 - CLOUD REVISION 1 | L.I.S. #2 - CLOUD REVISION 2 | L.I.S. #2 - CLOUD REVISION 3 | L.I.S. #2 - CLOUD REVISION 4 | L.I.S. #2 - CLOUD REVISION 5 | L.I.S. #2 - CLOUD REVISION 6 | L.I.S. #2 - CLOUD REVISION 7 |   |
| # Tries.                     | FI.S. #                      | #'S'I'S                      | #'S'I'S                      | #'S'I'S                      | #'S'I'S                      | #'S'I'S                      |   |
| -                            | 8                            | က                            | 4                            | 2                            | 9                            | _                            | 8 |

CONDO 1713

PROJECT#: 1709 PHASE: DD TEAM: Author CHECKER: Checker SCALE: AS NOTED

ISSUED: 4/20/2018
SHEET#:

Al-1.57

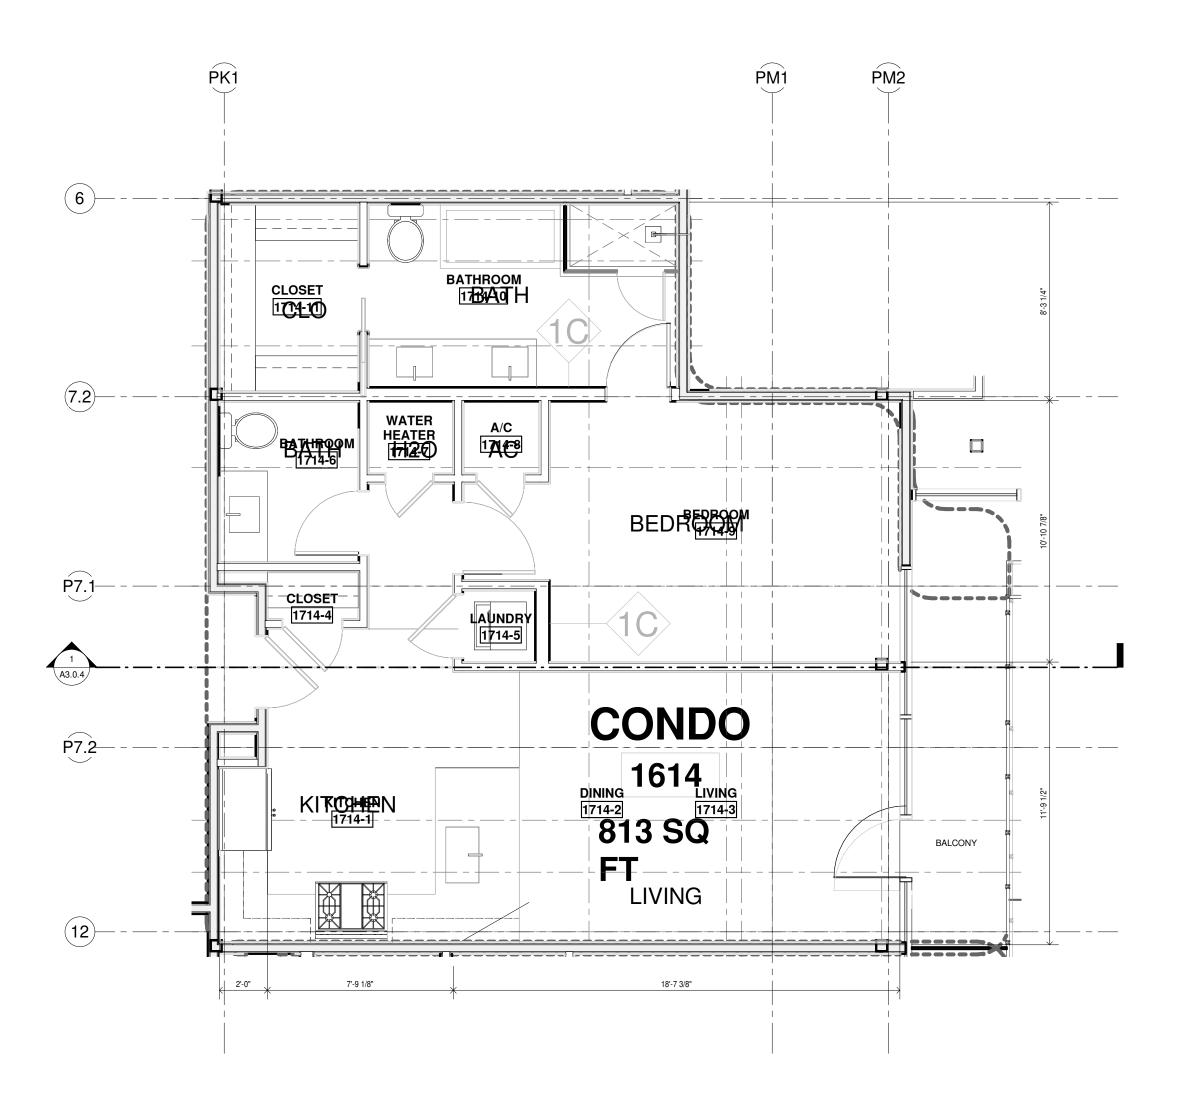

|         |         |              | DOOR S         | SCHED   | JLE - UNIT  | 1714          |            |           |             |         |
|---------|---------|--------------|----------------|---------|-------------|---------------|------------|-----------|-------------|---------|
| MARK    | FROM    | 70           | WIDTH          | HEIGHT  | THICKNESS   | DOOR MATERIAL | DOOR FRAME | DOOR TYPE | FIRE RATING | REMARKS |
| 1714-1  |         | KITCHEN      | 3' - 0"        | 8' - 0" | 0' - 1 3/4" | WD            | WD         | AA        |             |         |
| 1714-2  | CLOSET  | KITCHEN      | 2' - 6"        |         |             |               | НМ         | AA        |             |         |
| 1714-3  | LAUNDRY | KITCHEN      | 2' - 8"        | 8' - 0" | 0' - 1 3/4" | WD            | WD         | AA        |             |         |
| 1714-4  | KITCHEN | BATHROOM     | 2' - 8"        | 8' - 0" | 0' - 1 3/4" | WD            | WD         | AA        |             |         |
| 1714-5  | KITCHEN | WATER HEATER | 2' - 0"        | 8' - 0" | 0' - 1 3/4" | WD            | WD         | AA        |             |         |
| 1714-6  | KITCHEN | BEDROOM      | 3' - 0"        | 8' - 0" | 0' - 1 3/4" | WD            | WD         | AA        |             |         |
| 1714-7  | A/C     | BEDROOM      | 2' - 0"        | 8' - 0" | 0' - 1 3/4" | WD            | WD         | AA        |             |         |
| 1714-8  | BEDROOM | BATHROOM     | 2' - 8"        | 8' - 0" | 0' - 1 3/4" | WD            | WD         | AA        |             |         |
| 1714-9  | CLOSET  | BATHROOM     | 2' - 8"        | 8' - 0" | 0' - 1 3/4" | WD            | WD         | М         |             |         |
| 1714-10 |         | LIVING       | 2' - 5<br>1/2" | 8' - 2" | 0' - 1 1/2" | AL/GL         | AL         | K         |             |         |

|         |              |              | FINISH SCI  | HEDULE - l | JNIT 1714 |         |         |                |             |
|---------|--------------|--------------|-------------|------------|-----------|---------|---------|----------------|-------------|
| NUMBER  | NAME         | FLOOR FINISH | BASE FINISH | N. WALL    | S. WALL   | E. WALL | W. WALL | CEILING FINISH | CEILING HT. |
|         |              |              |             |            |           |         |         |                |             |
| 1714-1  | KITCHEN      |              |             |            |           |         |         |                |             |
| 1714-2  | DINING       |              |             |            |           |         |         |                |             |
| 1714-3  | LIVING       |              |             |            |           |         |         |                |             |
| 1714-4  | CLOSET       |              |             |            |           |         |         |                |             |
| 1714-5  | LAUNDRY      |              |             |            |           |         |         |                |             |
| 1714-6  | BATHROOM     |              |             |            |           |         |         |                |             |
| 1714-7  | WATER HEATER |              |             |            |           |         |         |                |             |
| 1714-8  | A/C          |              |             |            |           |         |         |                |             |
| 1714-9  | BEDROOM      |              |             |            |           |         |         |                |             |
| 1714-10 | BATHROOM     |              |             |            |           |         |         |                |             |
| 1714-11 | CLOSET       |              |             |            |           |         |         |                |             |

PENTHOUSE 1714 ENLARGED PLAN

OROCK HOTEL

189 Maple Ridge Drive Metairie, LA 70001 (504)-885-4477 central@hbsaii.com :-: hbsaii.com

SINCE 1961

THESE PLANS AND SPECIFICATIONS HAVE BEEN PREPARED BY ME OR UNDER MY CLOSE PERSONAL SUPERVISION AND TO THE BEST OF MY KNOWLEDGE AND BELIEF THEY COMPLY WITH ALL CITY, STATE AND FEDERAL REQUIREMENTS, AND I AM NOT PROVIDING CONTRACT ADMINISTRATION.

CERTIFIED CORRECT




THIS DRAWING IS CONFIDENTIAL AND NOT BE LOANED, REPRODUCED, COPIED, EITHER WHOLLY OR IN PART, OR MADE PUBLIC IN ANY MANNER WITHOUT THE WRITTEN CONSENT OF HBSA II ARCHITECTS, A PROFESSIONAL L.L.C. ALL RIGHTS OF DESIGN OR INVENTION ARE RESERVED AND WILL REMAIN THE SOLE PROPERTY OF HBSA

| 4/27/2018                    | 8/4/2018                     | 5/11/2018                    | 5/18/2018                    | 5/25/2018                    | STOR 8107/1/9                | 6/8/2018                     |   |  |
|------------------------------|------------------------------|------------------------------|------------------------------|------------------------------|------------------------------|------------------------------|---|--|
| L.I.S. #2 - CLOUD REVISION 1 | L.I.S. #2 - CLOUD REVISION 2 | L.I.S. #2 - CLOUD REVISION 3 | L.I.S. #2 - CLOUD REVISION 4 | L.I.S. #2 - CLOUD REVISION 5 | L.I.S. #2 - CLOUD REVISION 6 | L.I.S. #2 - CLOUD REVISION 7 |   |  |
| -                            | 2                            | င                            | 4                            | 5                            | 9                            | 7                            | 8 |  |

CONDO 1714

PROJECT#: 1709
PHASE: DD
TEAM: Author
CHECKER: Checker
SCALE: AS NOTED
ISSUED: 4/20/2018

AI-1.58

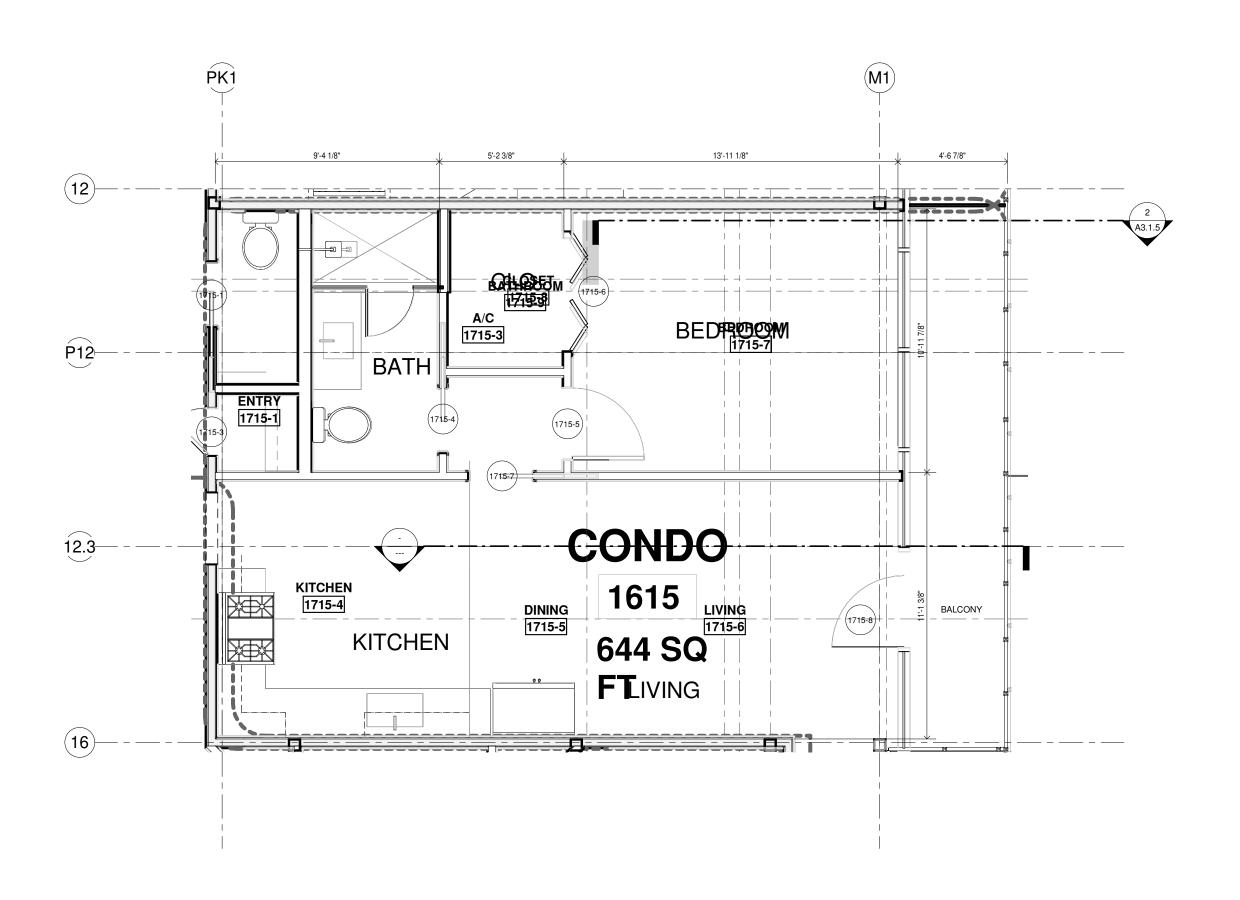

|        |  | Γ       | OOR SCHE | DULE -  | UNIT 1715   | 5     |    |     |  |  |  |  |  |
|--------|--|---------|----------|---------|-------------|-------|----|-----|--|--|--|--|--|
| MARK   | MARK FROM TO TO THICKNESS DOOR FRAME DOOR TYPE FIRE RATING REMARKS |         |          |         |             |       |    |     |  |  |  |  |  |
| 1715 1 | ENTDY  |         | 01 011   | 01 01   | 01 1 0/4"   | MD    | WD | Δ.Δ |  |  |  |  |  |
| 1715-1 | ENTRY  |         | 2' - 8"  |         | 0' - 1 3/4" |       | WD | AA  |  |  |  |  |  |
| 1715-3 | ENTRY  | ENTRY   | 2' - 0"  | 8' - 0" | 0' - 1 3/4" | WD    | WD | AA  |  |  |  |  |  |
| 1715-4 |  |         | 2' - 8"  | 8' - 0" | 0' - 1 3/4" | WD    | WD | M   |  |  |  |  |  |
| 1715-5 | BEDROOM  |         | 3' - 0"  | 8' - 0" | 0' - 1 3/4" | WD    | WD | М   |  |  |  |  |  |
| 1715-6 | BATHROOM   | BEDROOM | 5' - 0"  | 8' - 0" | 0' - 1 1/2" | WD    | WD | L   |  |  |  |  |  |
| 1715-7 | DINING   |         | 2' - 8"  | 8' - 0" | 0' - 1 3/4" | WD    | WD | М   |  |  |  |  |  |
| 1715-8 |  | LIVING  | 4' - 0"  | 8' - 2" | 0' - 1 1/2" | AL/GL | AL | K   |  |  |  |  |  |

|        |          |              | FINISH SC   | HEDULE - l | JNIT 1715 |         |         |                |             |
|--------|----------|--------------|-------------|------------|-----------|---------|---------|----------------|-------------|
| NUMBER | NAME     | FLOOR FINISH | BASE FINISH | N. WALL    | S. WALL   | E. WALL | W. WALL | CEILING FINISH | CEILING HT. |
|        |          |              |             |            | 1         |         |         |                |             |
| 1715-1 | ENTRY    |              |             |            |           |         |         |                |             |
| 1715-3 | A/C      |              |             |            |           |         |         |                |             |
| 1715-4 | KITCHEN  |              |             |            |           |         |         |                |             |
| 1715-5 | DINING   |              |             |            |           |         |         |                |             |
| 1715-6 | LIVING   |              |             |            |           |         |         |                |             |
| 1715-7 | BEDROOM  |              |             |            |           |         |         |                |             |
| 1715-8 | CLOSET   |              |             |            |           |         |         |                |             |
| 1715-9 | BATHROOM |              |             |            |           |         |         |                |             |

PENTHOUSE 1715 ENLARGED PLAN

SCALE: 1/4" = 1'-0"

189 Maple Ridge Drive Metairie, LA 70001 (504)-885-4477 central@hbsaii.com :-: hbsaii.com SINCE 1961


1031 CANAL STREET NEW ORLEANS, LOUISIANA

STATE AND FEDERAL REQUIREMENTS, AN I AM NOT PROVIDING CONTRACT ADMINISTRATION. CERTIFIED CORRECT



|      |           |                              | ω |
|------|-----------|------------------------------|---|
| Y    | 6/8/2018  | L.I.S. #2 - CLOUD REVISION 7 | 7 |
| TOR  | 6/1/2018  | L.I.S. #2 - CLOUD REVISION 6 | 9 |
| HIS  | 5/25/2018 | L.I.S. #2 - CLOUD REVISION 5 | 2 |
| ION  | 5/18/2018 | L.I.S. #2 - CLOUD REVISION 4 | 4 |
| EVIS | 5/11/2018 | L.I.S. #2 - CLOUD REVISION 3 | ဧ |
| R    | 5/4/2018  | L.I.S.,#2 - CLOUD REVISION 2 | 2 |
|      | 4/27/2018 | L.I.S.,#2 - CLOUD REVISION 1 | - |
|      |           |                              |   |
|      |           |                              |   |

CONDO 1715

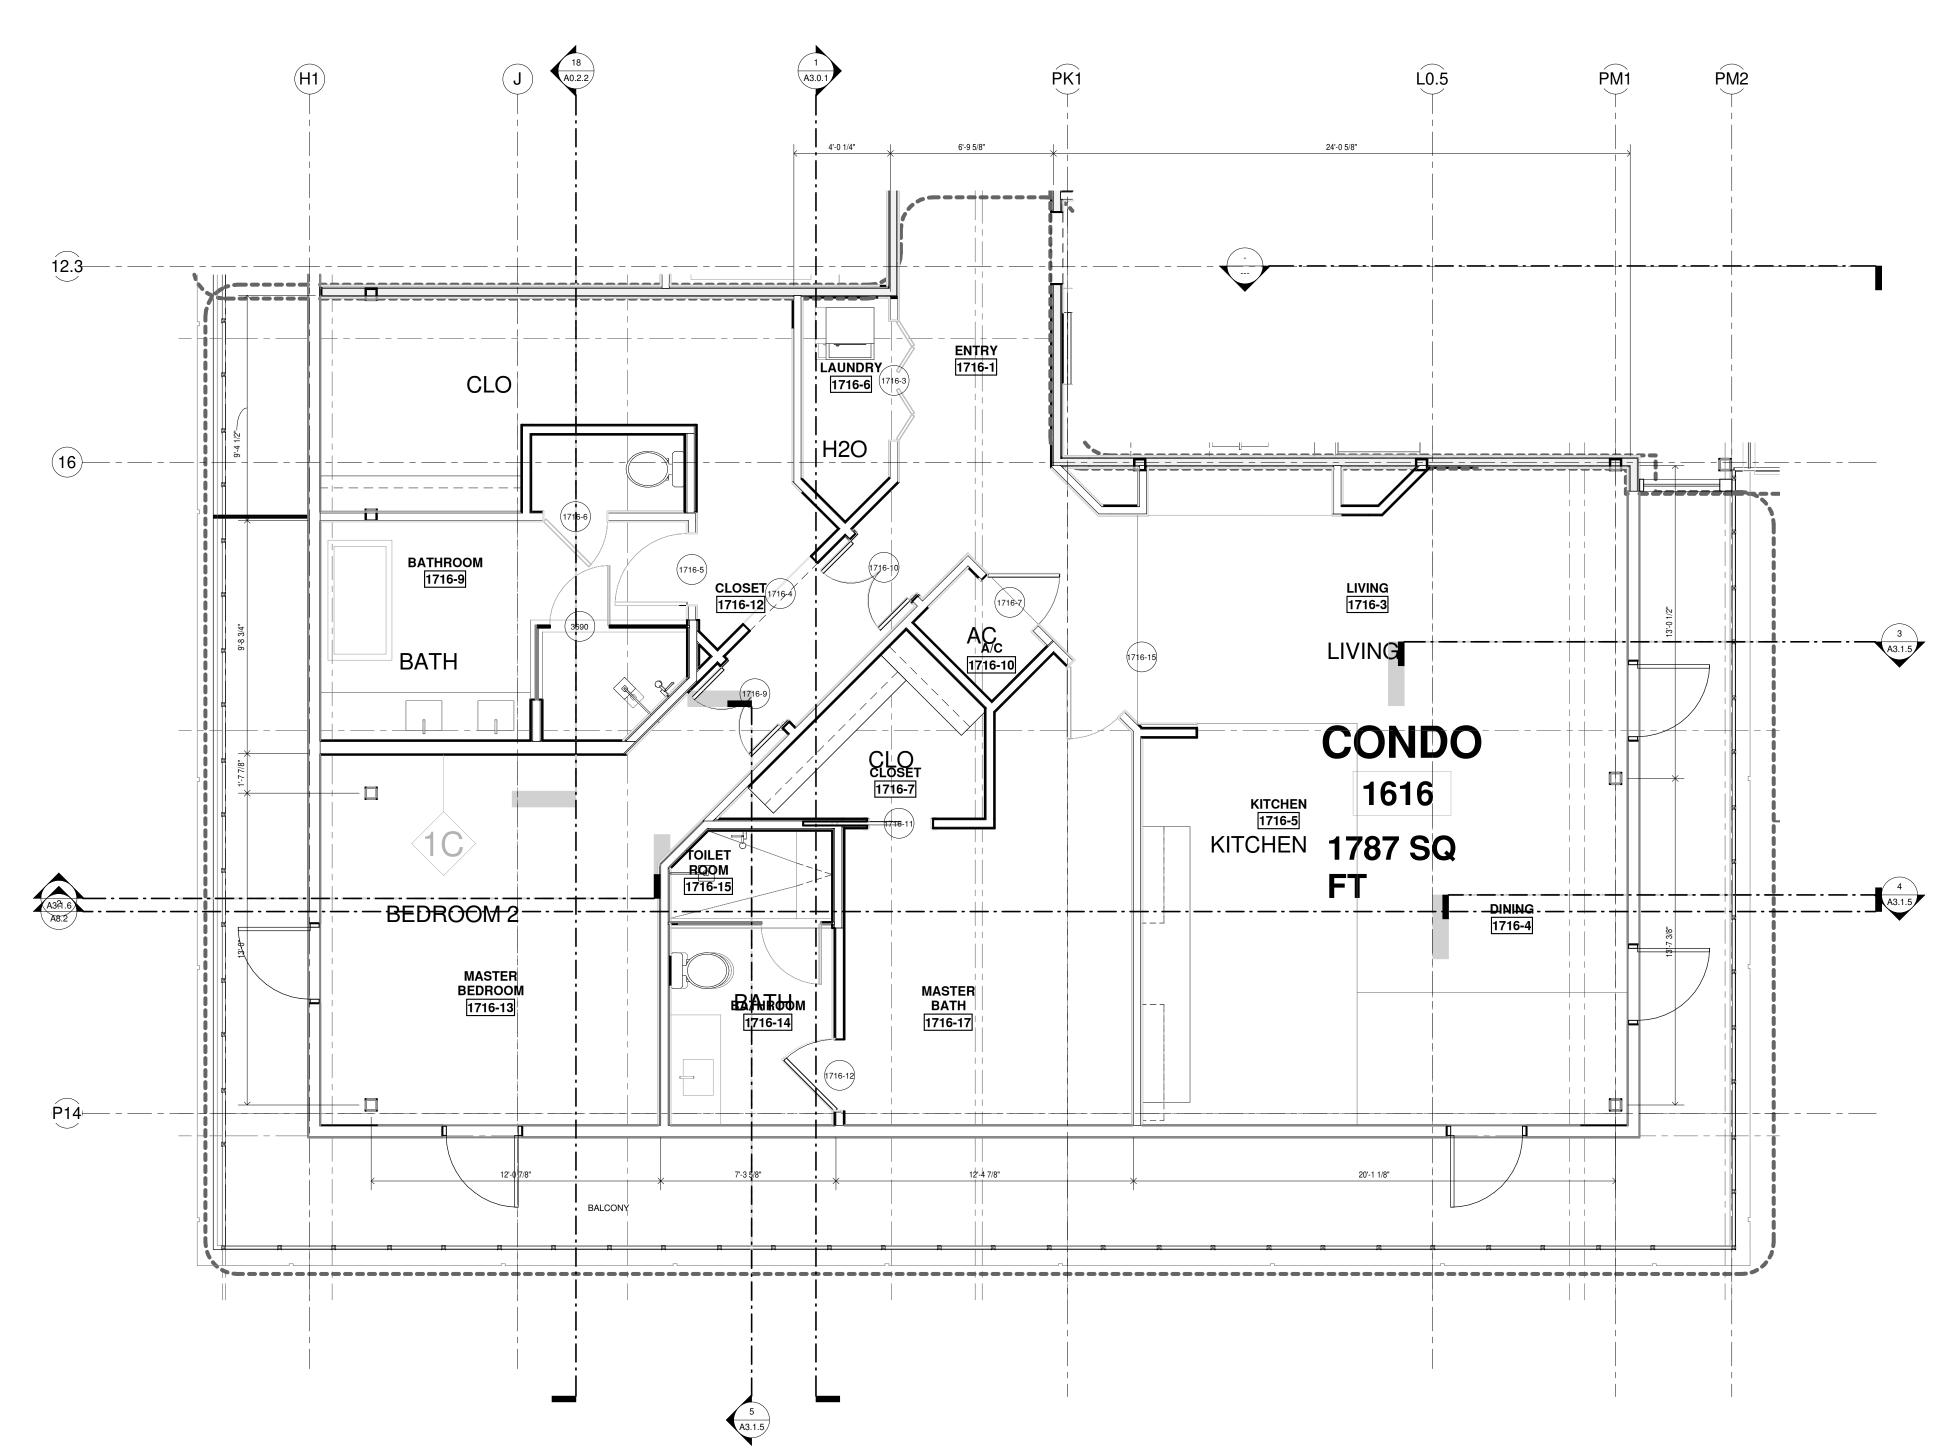

|         |             |                | DOOR :  | SCHED   | ULE - UNI   | T 1716        |            |           |             |              |
|---------|-------------|----------------|---------|---------|-------------|---------------|------------|-----------|-------------|--------------|
| MARK    | FROM        | 10             | WIDTH   | HEIGHT  | THICKNESS   | DOOR MATERIAL | DOOR FRAME | DOOR TYPE | FIRE RATING | REMARKS      |
| 1716-1  |             | ENTRY          | 3' - 0" | 8' - 0" | 0' - 1 3/4" | WD            | WD         | AA        | 1HR         | 1 HOUR RATED |
| 1716-3  | LAUNDRY     | ENTRY          | 5' - 0" |         | 0' - 1 1/2" | WD            | WD         | AA        |             |              |
| 1716-4  |             | CLOSET         | 4' - 0" | 7' - 0" |             | WD            | WD         | AA        |             |              |
| 1716-5  | CLOSET      | BATHROOM       | 3' - 0" | 8' - 0" | 0' - 1 3/4" | WD            | WD         | AA        | 1HR         |              |
| 1716-6  |             | BATHROOM       | 2' - 8" | 8' - 0" | 0' - 1 3/4" | WD            | WD         | AA        |             |              |
| 1716-7  | A/C         | ENTRY          | 3' - 0" | 8' - 0" | 0' - 1 3/4" | WD            | WD         | AA        | 1HR         |              |
| 1716-9  |             | MASTER BEDROOM | 3' - 6" | 8' - 0" | 0' - 1 3/4" | WD            | WD         | CC        |             |              |
| 1716-10 |             | ENTRY          | 3' - 6" | 8' - 0" | 0' - 1 3/4" | WD            | WD         | М         |             |              |
| 1716-11 | CLOSET      | MASTER BATH    | 2' - 8" | 8' - 0" | 0' - 1 3/4" | WD            | WD         | AA        |             |              |
| 1716-12 | BATHROOM    | MASTER BATH    | 3' - 0" | 8' - 0" | 0' - 1 3/4" | WD            | WD         | М         |             |              |
| 1716-15 | MASTER BATH | ENTRY          | 3' - 0" | 8' - 0" | 0' - 1 3/4" | WD            | WD         | CC        | 1HR         |              |

|         |             |              | FINISH SC   | HEDULE - U | JNIT 1716 |         |         |                |             |
|---------|-------------|--------------|-------------|------------|-----------|---------|---------|----------------|-------------|
| NUMBER  | NAME        | FLOOR FINISH | BASE FINISH | N. WALL    | S. WALL   | E. WALL | W. WALL | CEILING FINISH | CEILING HT. |
| 1716-1  | ENTRY       |              |             |            |           |         |         |                |             |
| 1716-3  | LIVING      |              |             |            |           |         |         |                |             |
| 1716-4  | DINING      |              |             |            |           |         |         |                |             |
| 1716-5  | KITCHEN     |              |             |            |           |         |         |                |             |
| 1716-6  | LAUNDRY     |              |             |            |           |         |         |                |             |
| 1716-7  | CLOSET      |              |             |            |           |         |         |                |             |
| 1716-9  | BATHROOM    |              |             |            |           |         |         |                |             |
|         |             |              |             |            |           |         |         |                |             |
| 1716-12 | CLOSET      |              |             |            |           |         |         |                |             |
|         |             |              |             |            |           |         |         |                |             |
| 1716-14 | BATHROOM    |              |             |            |           |         |         |                |             |
| 1716-15 | TOILET ROOM |              |             |            |           |         |         |                |             |
| 1716-17 | MASTER BATH |              |             |            |           |         |         |                |             |

PENTHOUSE 1716 ENLARGED PLAN

SCALE: 1/4" = 1'-0"

1031 CANAL STREET
NEW ORLEANS, LOUISIANA

189 Maple Ridge Drive Metairie, LA 70001 (504)-885-4477 central@hbsaii.com :-: hbsaii.com

SINCE 1961

THESE PLANS AND SPECIFICATIONS HAVE
BEEN PREPARED BY ME OR UNDER MY
CLOSE PERSONAL SUPERVISION AND TO
THE BEST OF MY KNOWLEDGE AND
BELIEF THEY COMPLY WITH ALL CITY,
STATE AND FEDERAL REQUIREMENTS, AND
I AM NOT PROVIDING CONTRACT
ADMINISTRATION.
CERTIFIED CORRECT




THIS DRAWING IS CONFIDENTIAL AND NOT BE LOANED, REPRODUCED, COPIED, EITHER WHOLLY OR IN PART, OR MADE PUBLIC IN ANY MANNER WITHOUT THE WRITTEN CONSENT OF HBSA II ARCHITECTS A PROFESSIONAL L.L.C. ALL RIGHTS OF DESIGN OR INVENTION ARE RESERVED AND WILL REMAIN THE SOLE PROPERTY OF HBS

|                              | R                            | EVIS                         | SION                         | HISTORY                      |                              |                              |  |  |  |
|------------------------------|------------------------------|------------------------------|------------------------------|------------------------------|------------------------------|------------------------------|--|--|--|
| 4/27/2018                    | 5/4/2018                     | 5/11/2018                    | 5/18/2018                    | 5/25/2018                    | 6/1/2018                     | 6/8/2018                     |  |  |  |
|                              |                              |                              |                              |                              |                              |                              |  |  |  |
|                              |                              |                              |                              |                              |                              |                              |  |  |  |
| Z .                          | 2 N                          | ε N                          | 4 N                          | N 5                          | 9 No                         | 7 No                         |  |  |  |
| L.I.S. #2 - CLOUD REVISION 1 | L.I.S. #2 - CLOUD REVISION 2 | L.I.S. #2 - CLOUD REVISION 3 | L.I.S. #2 - CLOUD REVISION 4 | L.I.S. #2 - CLOUD REVISION 5 | L.I.S. #2 - CLOUD REVISION 6 | L.I.S. #2 - CLOUD REVISION 7 |  |  |  |
| 72 - CLOUI                   | R - CLOUI                    | R - CLOUI                    | R - CLOUI                    | R - CLOUI                    | R - CLOUI                    | R - CLOUI                    |  |  |  |
| L.I.S. #                     | L.I.S.#                      | L.I.S. #                     |  |  |  |

CONDO 1716

PROJECT#: 1709
PHASE: DD
TEAM: Author
CHECKER: Checker
SCALE: AS NOTED
ISSUED: 4/20/2018

AI-1.60

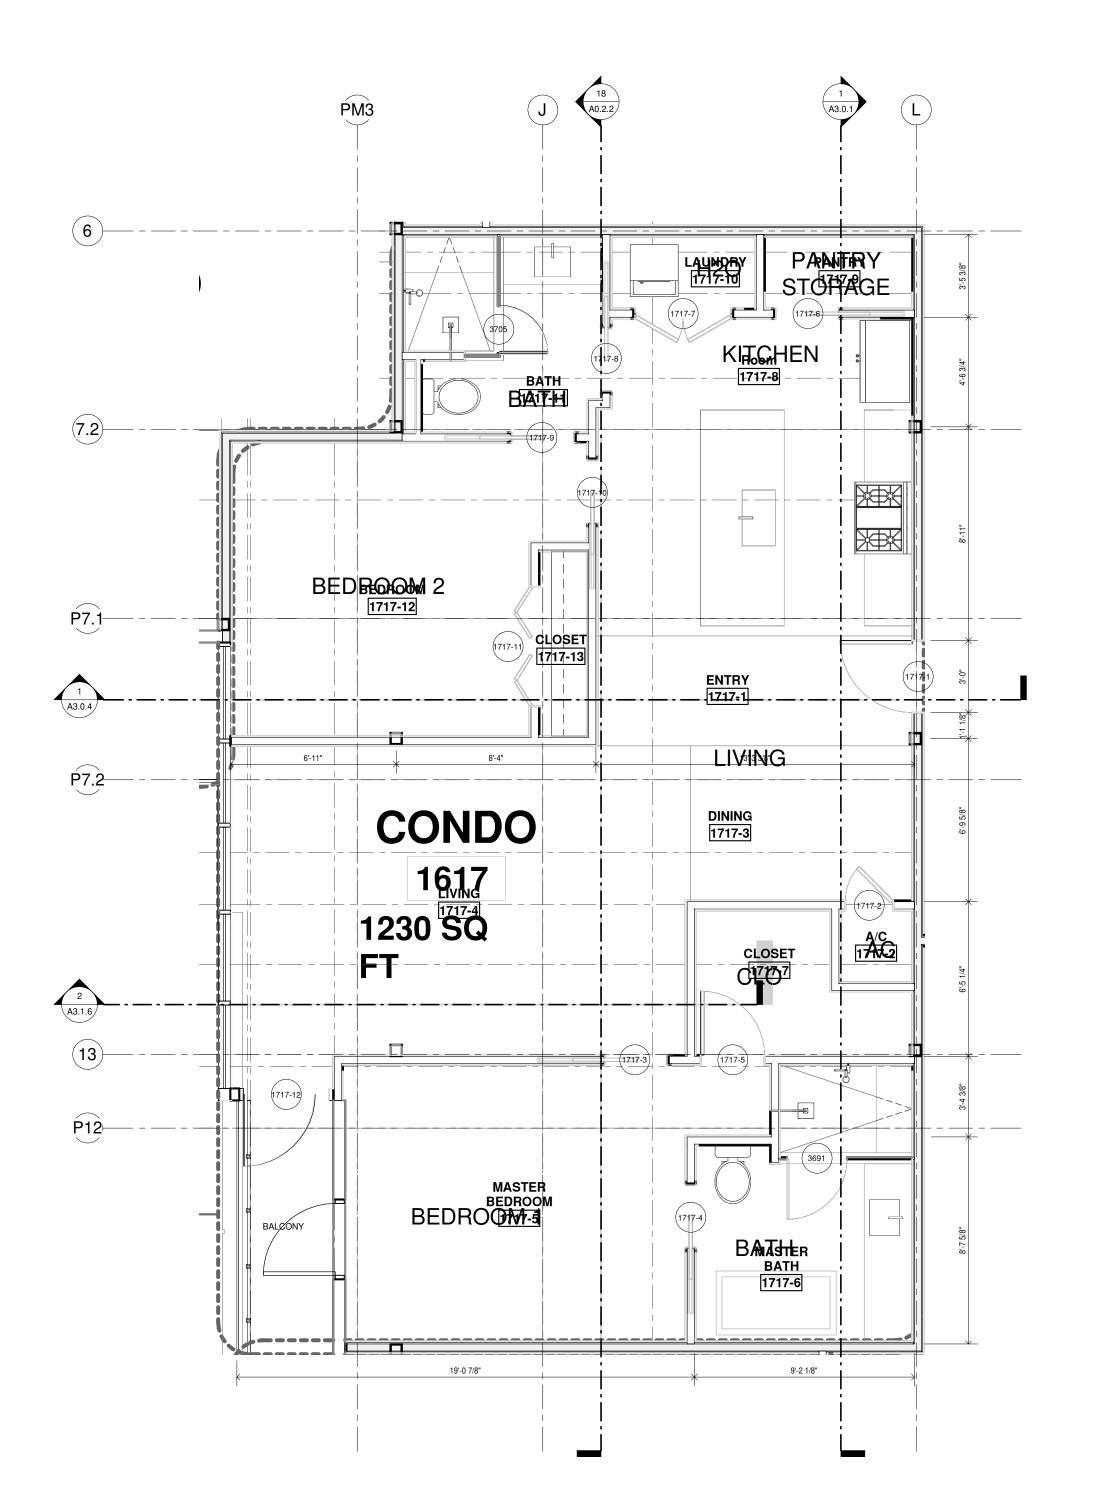

|         |                | D              | OOR SO           | CHEDU   | LE - UNIT    | 1717          |            |           |             |                    |
|---------|----------------|----------------|------------------|---------|--------------|---------------|------------|-----------|-------------|--------------------|
| MARK    | FROM           | ТО             | WIDTH            | HEIGHT  | THICKNESS    | DOOR MATERIAL | DOOR FRAME | DOOR TYPE | FIRE RATING | REMARKS            |
| 47474   | ENTDY          |                | 01 011           | 01 011  | 01 4 0 /4 !! | WD            | WD         | Δ.Δ.      | 4110        |                    |
| 1717-1  | ENTRY          |                | 3' - 0"          |         | 0' - 1 3/4"  |               | WD         | AA        | 1HR         |                    |
| 1717-2  | A/C            | DINING         | 2' - 0"          |         | 0' - 1 3/4"  |               | WD         | AA        |             |                    |
| 1717-3  | LIVING         | MASTER BEDROOM | 2' - 8"          | 8' - 0" | 0' - 1 3/4"  | WD            | WD         | M         |             |                    |
| 1717-4  | MASTER BEDROOM | MASTER BATH    | 2' - 8"          | 8' - 0" | 0' - 1 3/4"  | WD            | WD         | М         |             |                    |
| 1717-5  | MASTER BEDROOM | CLOSET         | 2' - 8"          | 8' - 0" | 0' - 1 3/4"  | WD            | WD         | AA        |             |                    |
| 1717-6  | Room           | PANTRY         | 2' - 8"          | 8' - 0" | 0' - 1 3/4"  | WD            | WD         | М         |             |                    |
| 1717-7  | LAUNDRY        | Room           | 4' - 0"          | 8' - 0" | 0' - 1 3/4"  | WD            | WD         | CC        |             | DOUBLE DOOR / PAIR |
| 1717-8  | Room           | BATH           | 2' - 8"          | 8' - 0" | 0' - 1 3/4"  | WD            | WD         | М         |             |                    |
| 1717-9  | BEDROOM        | BATH           | 2' - 8"          | 8' - 0" | 0' - 1 3/4"  | WD            | WD         | М         |             |                    |
| 1717-10 | BEDROOM        | Room           | 2' - 8"          | 8' - 0" | 0' - 1 3/4"  | WD            | WD         | М         |             |                    |
| 1717-11 | CLOSET         | BEDROOM        | 5' - 0"          | 8' - 0" | 0' - 1 1/2"  | WD            | WD         | L         |             |                    |
| 1717-12 | LIVING         |                | 3' - 6<br>31/32" | 8' - 2" | 0' - 1 1/2"  | AL/GL         | AL         | K         |             |                    |

|         |                |              | FINISH SC   | HEDULE - l | JNIT 1717 |         |         |                |             |
|---------|----------------|--------------|-------------|------------|-----------|---------|---------|----------------|-------------|
| NUMBER  | NAME           | FLOOR FINISH | BASE FINISH | N. WALL    | S. WALL   | E. WALL | W. WALL | CEILING FINISH | CEILING HT. |
| 1717-1  | ENTRY          |              |             |            |           |         |         |                |             |
| 1717-2  | A/C            |              |             |            |           |         |         |                |             |
| 1717-3  | DINING         |              |             |            |           |         |         |                |             |
| 1717-4  | LIVING         |              |             |            |           |         |         |                |             |
| 1717-5  | MASTER BEDROOM |              |             |            |           |         |         |                |             |
| 1717-6  | MASTER BATH    |              |             |            |           |         |         |                |             |
| 1717-7  | CLOSET         |              |             |            |           |         |         |                |             |
| 1717-8  | Room           |              |             |            |           |         |         |                |             |
| 1717-9  | PANTRY         |              |             |            |           |         |         |                |             |
| 1717-10 | LAUNDRY        |              |             |            |           |         |         |                |             |
| 1717-11 | BATH           |              |             |            |           |         |         |                |             |
| 1717-11 | HALL           |              |             |            |           |         |         |                |             |
| 1717-12 |                |              |             |            |           |         |         |                |             |
| 1717-13 | CLOSET         |              |             |            |           |         |         |                |             |

PENTHOUSE 1717 ENLARGED PLAN

SCALE: 1/4" = 1'-0"

HARRY
BAKER
SMITH
SMITH
ARCHITECTS II
P L C

189 Maple Ridge Drive Metairie, LA 70001
(504)-885-4477
central@hbsaii.com :: hbsaii.com
SINCE 1961

HARD ROCK HOTE 1031 CANAL STREET NEW ORLEANS, LOUISIANA

THESE PLANS AND SPECIFICATIONS HAVE BEEN PREPARED BY ME OR UNDER MY CLOSE PERSONAL SUPERVISION AND TO THE BEST OF MY KNOWLEDGE AND BELIEF THEY COMPLY WITH ALL CITY, STATE AND FEDERAL REQUIREMENTS, AND I AM NOT PROVIDING CONTRACT ADMINISTRATION.

CERTIFIED CORRECT



THIS DRAWING IS CONFIDENTIAL AND
NOT BE LOANED, REPRODUCED, COPIED,
EITHER WHOLLY OR IN PART, OR MADE
PUBLIC IN ANY MANNER WITHOUT THE
WRITTEN CONSENT OF HBSA II ARCHITECTS
A PROFESSIONAL L.L.C. ALL RIGHTS OF
DESIGN OR INVENTION ARE RESERVED AND
WILL REMAIN THE SOLE PROPERTY OF HBSA


| L.I.S. #2 - CLOUD REVISION 1 | 4/27/2018 |      |
|------------------------------|-----------|------|
| L.I.S. #2 - CLOUD REVISION 2 | 5/4/2018  | R    |
| L.I.S. #2 - CLOUD REVISION 3 | 5/11/2018 | EVIS |
| L.I.S. #2 - CLOUD REVISION 4 | 5/18/2018 | SION |
| L.I.S. #2 - CLOUD REVISION 5 | 5/25/2018 | HIS  |
| L.I.S. #2 - CLOUD REVISION 6 | 6/1/2018  | STOR |
| L.I.S. #2 - CLOUD REVISION 7 | 6/8/2018  | Υ    |
|                              |           |      |

CONDO 1717

PROJECT#: 1709
PHASE: DD
TEAM: Author
CHECKER: Checker
SCALE: AS NOTED

ISSUED: 4/20/2018
SHEET#:

Al-1.61

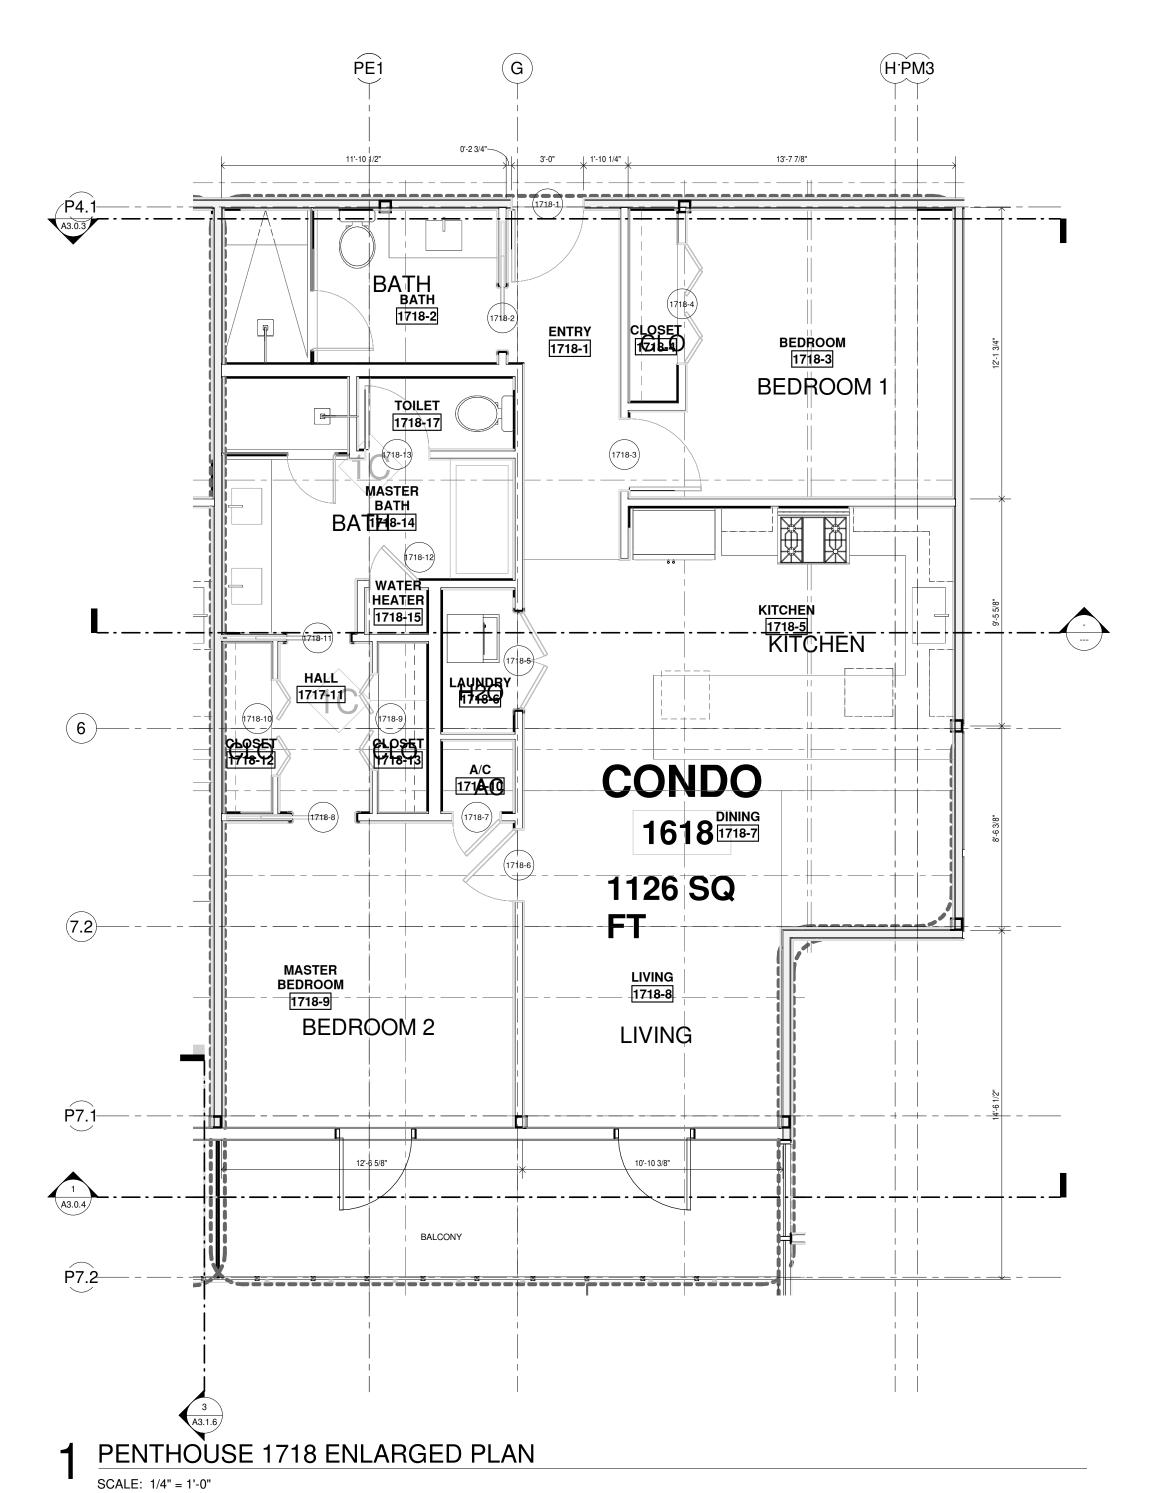

|         |                | D              | OOR S   | CHEDU   | LE - UNIT   | 1718          |            |           |             |                    |
|---------|----------------|----------------|---------|---------|-------------|---------------|------------|-----------|-------------|--------------------|
| MARK    | FROM           | ОТ             | WIDTH   | HEIGHT  | THICKNESS   | DOOR MATERIAL | DOOR FRAME | DOOR TYPE | FIRE RATING | REMARKS            |
| 1718-1  |                | ENTRY          | 3' - 0" | ט טי    | 0' - 1 3/4" | WD            | WD         | AA        | 1HR         | 1 HOUR RATED       |
| 1718-1  | BATH           | ENTRY          | 2' - 8" |         |             |               | WD         | M         | INN         | I HOUR RATED       |
| 1718-3  | ENTRY          | BEDROOM        | 3' - 0" |         | 0' - 1 3/4" | WD            | WD         | AA        |             |                    |
| 1718-4  | CLOSET         | BEDROOM        | 5' - 0" |         | 0' - 1 1/2" | WD            | WD         | ı         |             |                    |
| 1718-5  | LAUNDRY        | KITCHEN        | 4' - 0" |         | 0' - 1 3/4" | WD            | WD         | CC        |             | DOUBLE DOOR / PAIR |
| 1718-6  | MASTER BEDROOM | DINING         | 3' - 0" |         | 0' - 1 3/4" | WD            | WD         | AA        |             | BOOBLE BOOM, 17411 |
| 1718-7  |                | A/C            | 2' - 0" |         |             |               | WD         | AA        |             |                    |
| 1718-8  | HALL           | MASTER BEDROOM |         |         |             |               | WD         | М         |             |                    |
| 1718-9  | CLOSET         | HALL           | 4' - 0" |         | 0' - 1 1/2" | WD            | WD         | L         |             |                    |
| 1718-10 | HALL           | CLOSET         | 4' - 0" | 8' - 0" | 0' - 1 1/2" | WD            | WD         | L         |             |                    |
| 1718-11 | HALL           | MASTER BATH    | 2' - 8" | 8' - 0" | 0' - 1 3/4" | WD            | WD         | М         |             |                    |
| 1718-12 | WATER HEATER   | MASTER BATH    | 2' - 0" | 8' - 0" | 0' - 1 3/4" | WD            | WD         | AA        |             |                    |
| 1718-13 | TOILET         | MASTER BATH    | 2' - 8" | 8' - 0" | 0' - 1 3/4" | WD            | WD         | AA        |             |                    |

|         |                |              | FINISH SC   | HEDULE - l | JNIT 1718 |         |         |                |             |
|---------|----------------|--------------|-------------|------------|-----------|---------|---------|----------------|-------------|
| NUMBER  | NAME           | FLOOR FINISH | BASE FINISH | N. WALL    | S. WALL   | E. WALL | W. WALL | CEILING FINISH | CEILING HT. |
| 1718-1  | ENTRY          |              |             |            |           |         |         |                |             |
| 1718-2  | BATH           |              |             |            |           |         |         |                |             |
| 1718-3  | BEDROOM        |              |             |            |           |         |         |                |             |
| 1718-4  | CLOSET         |              |             |            |           |         |         |                |             |
| 1718-5  | KITCHEN        |              |             |            |           |         |         |                |             |
| 1718-6  | LAUNDRY        |              |             |            |           |         |         |                |             |
| 1718-7  | DINING         |              |             |            |           |         |         |                |             |
| 1718-8  | LIVING         |              |             |            |           |         |         |                |             |
| 1718-9  | MASTER BEDROOM |              |             |            |           |         |         |                |             |
| 1718-10 | A/C            |              |             |            |           |         |         |                |             |
| 1718-12 | CLOSET         |              |             |            |           |         |         |                |             |
| 1718-13 | CLOSET         |              |             |            |           |         |         |                |             |
| 1718-14 | MASTER BATH    |              |             |            |           |         |         |                |             |
| 1718-15 | WATER HEATER   |              |             |            |           |         |         |                |             |
| 1718-17 | TOILET         |              |             |            |           |         |         |                |             |


189 Maple Ridge Drive Metairie, LA 70001 (504)-885-4477 central@hbsaii.com :-: hbsaii.com SINCE 1961

1031 CANAL STREET NEW ORLEANS, LOUISIANA

STATE AND FEDERAL REQUIREMENTS, A I AM NOT PROVIDING CONTRACT ADMINISTRATION. CERTIFIED CORRECT

REVISION HISTORY

1 L.I.S. #2 - CLOUD RE
2 L.I.S. #2 - CLOUD RE
3 L.I.S. #2 - CLOUD RE
5 L.I.S. #2 - CLOUD RE
6 L.I.S. #2 - CLOUD RE
7 L.I.S. #2 - CLOUD RE
8 CONDO 1718

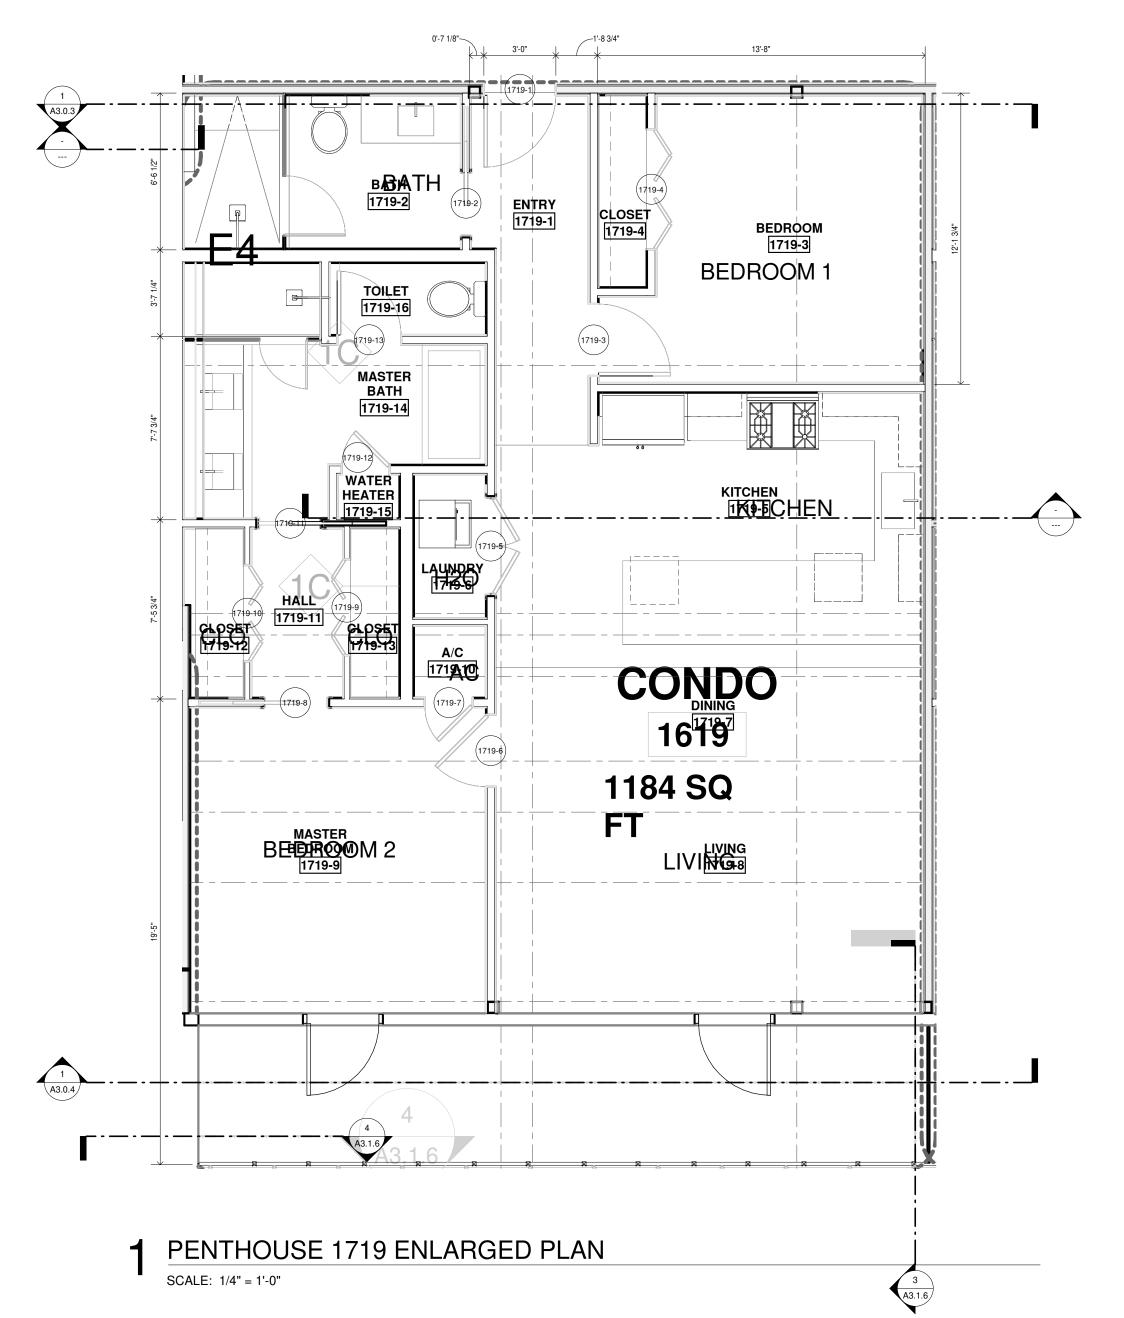

|         |                | С              | OOR S   | CHEDL   | JLE - UNIT  | 1719          |            |           |             |   |
|---------|----------------|----------------|---------|---------|-------------|---------------|------------|-----------|-------------|---|
| MARK    | FROM           | 10             | WIDTH   | НЕІСНТ  | THICKNESS   | DOOR MATERIAL | DOOR FRAME | DOOR TYPE | FIRE RATING | REMARKS                                 |
| 1719-1  |                | ENTRY          | 3' - 0" | 8' - 0" | 0' - 1 3/4" | WD            | WD         | AA        | 1HR         | 1 HOUR RATED                            |
| 1719-2  | BATH           | ENTRY          | 2' - 8" |         | 0' - 1 3/4" | WD            | WD         | M         |             | THOOTHWILD                              |
| 1719-3  | ENTRY          | BEDROOM        | 3' - 0" |         | 0' - 1 3/4" | WD            | WD         | AA        |             |   |
| 1719-4  | CLOSET         | BEDROOM        | 5' - 0" |         | 0' - 1 1/2" | WD            | WD         | 1         |             |   |
| 1719-5  | LAUNDRY        | KITCHEN        | 4' - 0" |         | 0' - 1 3/4" | WD            | WD         | CC        |             | DOUBLE DOOR / PAIR                      |
| 1719-6  |                | DINING         | 3' - 0" |         | 0' - 1 3/4" | WD            | WD         | AA        |             | 2 |
| 1719-7  | MASTER BEDROOM |                | 2' - 0" |         | 0' - 1 3/4" | WD            | WD         | AA        |             |   |
| 1719-8  | HALL           | MASTER BEDROOM |         |         | 0' - 1 3/4" | WD            | WD         | M         |             |   |
| 1719-9  | CLOSET         | HALL           | 4' - 0" |         | 0' - 1 1/2" | WD            | WD         | L         |             |   |
| 1719-10 | HALL           | CLOSET         | 4' - 0" |         | 0' - 1 1/2" | WD            | WD         | L         |             |   |
| 1719-11 | HALL           | MASTER BATH    | 2' - 8" |         | 0' - 1 3/4" | WD            | WD         | M         |             |   |
| 1719-12 | WATER HEATER   | MASTER BATH    | 2' - 0" |         | 0' - 1 3/4" | WD            | WD         | AA        |             |   |
| 1719-13 | TOILET         | MASTER BATH    | 2' - 8" |         | 0' - 1 3/4" | WD            | WD         | AA        |             |   |

|         |                |              | FINISH SO   | CHEDULE - I | UNIT 1719 |         |         |                |             |
|---------|----------------|--------------|-------------|-------------|-----------|---------|---------|----------------|-------------|
| NUMBER  | NAME           | FLOOR FINISH | BASE FINISH | N. WALL     | S. WALL   | E. WALL | W. WALL | CEILING FINISH | CEILING HT. |
| 1719-1  | ENTRY          |              |             |             |           |         |         |                |             |
| 1719-2  | BATH           |              |             |             |           |         |         |                |             |
| 1719-3  | BEDROOM        |              |             |             |           |         |         |                |             |
| 1719-4  | CLOSET         |              |             |             |           |         |         |                |             |
| 1719-5  | KITCHEN        |              |             |             |           |         |         |                |             |
| 1719-6  | LAUNDRY        |              |             |             |           |         |         |                |             |
| 1719-7  | DINING         |              |             |             |           |         |         |                |             |
| 1719-8  | LIVING         |              |             |             |           |         |         |                |             |
| 1719-9  | MASTER BEDROOM |              |             |             |           |         |         |                |             |
| 1719-10 | A/C            |              |             |             |           |         |         |                |             |
| 1719-11 | HALL           |              |             |             |           |         |         |                |             |
| 1719-12 | CLOSET         |              |             |             |           |         |         |                |             |
| 1719-13 | CLOSET         |              |             |             |           |         |         |                |             |
| 1719-14 | MASTER BATH    |              |             |             |           |         |         |                |             |
| 1719-15 | WATER HEATER   |              |             |             |           |         |         |                |             |
| 1719-16 | TOILET         |              |             |             |           |         |         |                |             |

HARRY
BAKER
SMITH
SMITH
ARCHITECTS II
P L C

189 Maple Ridge Drive Metairie, LA 70001
(504)-885-4477
central@hbsaii.com :: hbsaii.com
SINCE 1961

HARD ROCK HOTI 1031 CANAL STREET NEW ORLEANS, LOUISIANA

THESE PLANS AND SPECIFICATIONS HAVE BEEN PREPARED BY ME OR UNDER MY CLOSE PERSONAL SUPERVISION AND TO THE BEST OF MY KNOWLEDGE AND BELIEF THEY COMPLY WITH ALL CITY, STATE AND FEDERAL REQUIREMENTS, AND I AM NOT PROVIDING CONTRACT ADMINISTRATION.

CERTIFIED CORRECT



THIS DRAWING IS CONFIDENTIAL AND
NOT BE LOANED, REPRODUCED, COPIED,
EITHER WHOLLY OR IN PART, OR MADE
PUBLIC IN ANY MANNER WITHOUT THE
WRITTEN CONSENT OF HBSA II ARCHITECTS
A PROFESSIONAL L.L.C. ALL RIGHTS OF
DESIGN OR INVENTION ARE RESERVED AND
WILL REMAIN THE SOLE PROPERTY OF HBSA

| II ARCHITECTS A PROFESSIONAL L.L.C. |                              |                              |                              |                              |                              |                              |   |  |  |  |
|-------------------------------------|------------------------------|------------------------------|------------------------------|------------------------------|------------------------------|------------------------------|---|--|--|--|
|                                     | R                            | EVIS                         | NOI                          | HIS                          | TOR                          | Υ                            |   |  |  |  |
| 4/27/2018                           | 5/4/2018                     | 5/11/2018                    | 5/18/2018                    | 5/25/2018                    | 6/1/2018                     | 6/8/2018                     |   |  |  |  |
| L.I.S. #2 - CLOUD REVISION 1        | L.I.S. #2 - CLOUD REVISION 2 | L.I.S. #2 - CLOUD REVISION 3 | L.I.S. #2 - CLOUD REVISION 4 | L.I.S. #2 - CLOUD REVISION 5 | L.I.S. #2 - CLOUD REVISION 6 | L.I.S. #2 - CLOUD REVISION 7 |   |  |  |  |
| 1                                   | 2                            | 3                            | 4                            | 5                            | 9                            | 7                            | 8 |  |  |  |

CONDO 1719

PROJECT#: 1709
PHASE: DD
TEAM: Author
CHECKER: Checker
SCALE: AS NOTED
ISSUED: 4/20/2018

AI-1.63